

4597F10-WW PLAN
102 SEATS (6 ACCESSIBLE SEATS)
THIS DRAWING IS FOR SEATING REFERENCE ONLY
(SEATING LAYOUT NOT FOR CONSTRUCTION)


SEATING LAYOUT IS SCHEMATIC, THE FINAL SEATING LAYOUT TO BE PROVIDED BY DECOR, UNDER SEPARATE COVER BY OTHERS

OCCUPANCY ALLOWANCE:

INTERNATIONAL BUILDING CODE 2012

FUNCTION OF SPACE	TABLE 1004.1.2 MAXIMUM FLOOR AREA ALLOWANCES PER OCCUPANT		
	ALLOWANCE	AREA	OCCUPANTS
ACCESSORY STORAGE AREAS, MECHANICAL EQUIPMENT ROOM	300 GROSS	575 SF	2
ASSEMBLY WITH FIXED SEATS	SEE PLAN	—	102
ASSEMBLY W/OUT FIXED SEATS, STANDING SPACE	5 NET	173 SF	35
BUSINESS AREAS	100 GROSS	60 SF	1
KITCHENS, COMMERCIAL (BASED ON FULL KITCHEN STAFF)	200 GROSS	—	17
TOTAL OCCUPANCY ALLOWANCE			157

SYMBOL LEGEND:

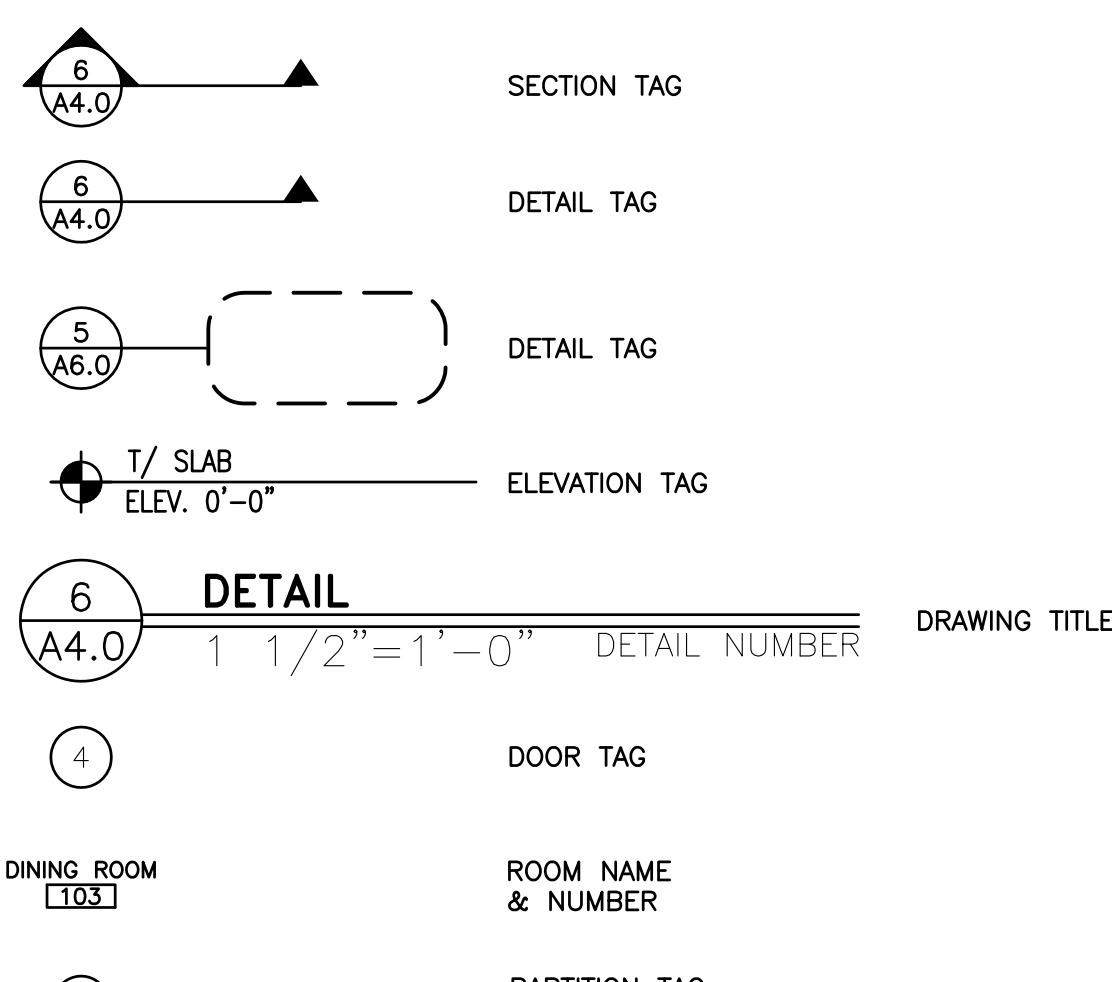

DESIGNER OF RECORD

DISCIPLINE:	NAME:	ADDRESS:	LICENSE #
ARCHITECT:	Reprise Design Brian Johnson (952) 252-4042	12400 Portland Avenue Burnsville, MN 55337	5420
STRUCTURAL:	Voigt & Associates Paul W. Voigt (952) 686-7727	4635 Nicols Road Eagan, MN 55122	19893
MECHANICAL:	Emanuelson-Podas, Inc Michael A. Webert (952) 930-0050	7705 Bush Lake Road Edina, MN 55439	17648
PLUMBING:	Emanuelson-Podas, Inc Michael A. Webert (952) 930-0050	7705 Bush Lake Road Edina, MN 55439	17648
ELECTRICAL:	Emanuelson-Podas, Inc Matthew W. Fuhs (952) 930-0050	7705 Bush Lake Road Edina, MN 55439	17667

McDONALD'S CONSTRUCTION PROJECT MANAGER

MANAGER:	NAME:	ADDRESS:	PHONE #
	Carter Mann	4643 Ulster Street Suite 1300 Denver, CO 80237	(952) 300-5504

IF YOU HAVE ANY QUESTIONS REGARDING THESE PLANS,
PLEASE CONTACT THE ARCHITECTURAL PROJECT MANAGER:
Kristi Donahue
PHONE: 952-562-3730
EMAIL: kdonahue@reprisedesign.com

2019 4597F10-WW BUILDING BB20

DENVER FIELD OFFICE BUILDING INFORMATION:

ADDRESS:

STATE SITE CODE: 015-0071
STREET ADDRESS: 605 SOUTH 7TH STREET
CITY: KANSAS CITY
COUNTY: WYANDOTTE
STATE: KANSAS

STRUCTURE:

WOOD LOAD BEARING WALLS, WOOD ROOF FRAMING

UTILITIES:

ELECTRIC GRILLS & ELECTRIC FRYERS
ELECTRIC HVAC & ELECTRIC WATER HEATER

BUILDING CODE:

BUILDING CODE EDITION: 2012 INTERNATIONAL BUILDING CODE
MECHANICAL CODE EDITION: 2012 INTERNATIONAL MECHANICAL CODE
ELECTRICAL CODE EDITION: 2011 NATIONAL ELECTRICAL CODE
PLUMBING CODE EDITION: 2012 UNIFORM PLUMBING CODE
ENERGY CODE EDITION: 2009 INTERNATIONAL ENERGY CONSERVATION CODE

FIRE CODE EDITION: 2012 INTERNATIONAL FIRE CODE
LIFE SAFETY CODE EDITION: 2012 NFPA 101 LIFE SAFETY CODE
FUEL/GAS CODE EDITION: 2012 INTERNATIONAL FUEL GAS CODE
HEALTH CODE EDITION: 2012 KANSAS FOOD CODE
ACCESSIBILITY CODE EDITION: 2010 ADAAG & 2012 IBC

BUILDING DATA:

OCCUPANCY: USE GROUP A2
CONSTRUCTION TYPE: VB
NUMBER OF STORIES: 1
BUILDING HEIGHT: 18'-9 1/2" (MAIN BLDG. PARAPET)


BASE BUILDING GROSS AREA: 4,902 S.F.
BASE BUILDING NET AREA: 4,550 S.F.

LIFE SAFETY SYSTEM:

EMERGENCY LIGHTING:	X	YES	NO
EXIT SIGNS:	X	YES	NO
FIRE ALARM:	YES	X	NO
DUCT SMOKE DETECTORS	X	YES	NO
W/ AUDIBLE/VISIBLE DEVICE:	X	YES	NO
FIRE SPRINKLERS:	X	YES	NO
SPRINKLER FLOW/TAMPER SWITCH	X	YES	NO
W/ AUDIBLE/VISIBLE DEVICE:	X	YES	NO
CO2 DETECTION SYSTEM	X	YES	NO
W/ AUDIBLE/VISIBLE DEVICE:	X	YES	NO
PANIC HARDWARE:	X	YES	NO

DESIGN LOADS:

SEE GENERAL STRUCTURAL NOTES ON SHEET S4.0

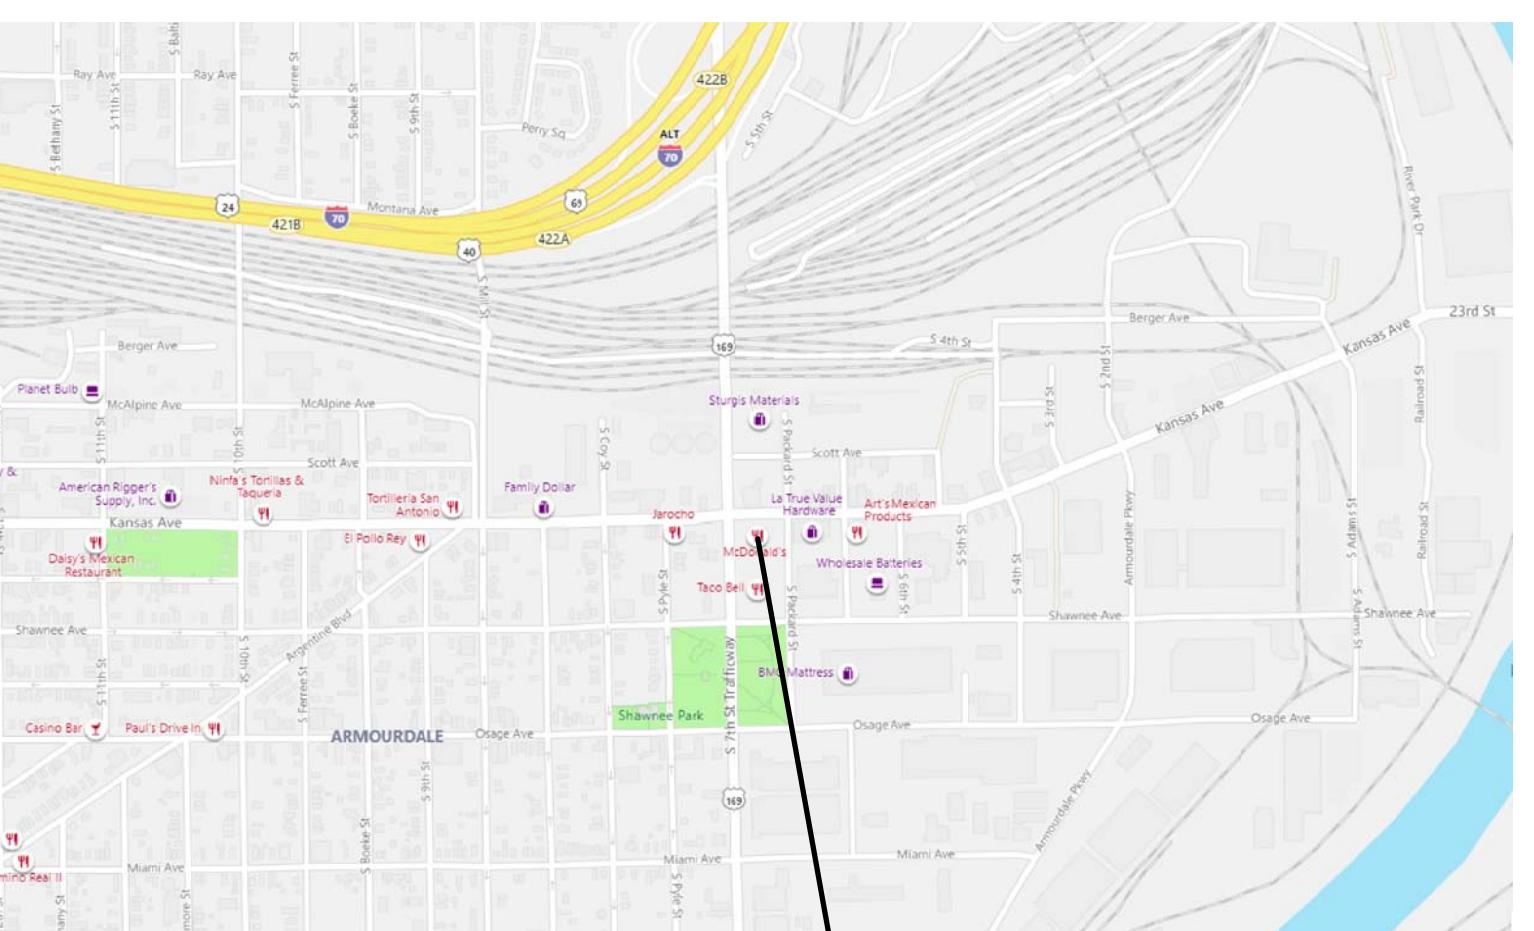

VICINITY MAP:



SITE

DRAWING INDEX

T1.0 Cover Sheet
GN1.0 General Notes

DRIVE-THRU (FOR REFERENCE ONLY)

DT1.0 Drive-Thru Plan & Details

TRASH CORRAL

TC1.0 Trash Corral Plan & Details

CIVIL

SEE CIVIL FOR SPECIFIC SHEETS

ARCHITECTURAL

- A1.0 Partial Floor Plan & Details
- A1.1 Partial Floor Plan
- A1.2 Reflected Ceiling Plan & Details
- A1.3 Roof Plan & Details
- A2.0 Exterior Elevations
- A2.1 Exterior Elevations & Details
- A2.2 Delivery POD Details
- A3.1 Service POD Details
- A4.0 Enlarged Restroom Plan & Details
- A4.1 Enlarged Plan Details
- A4.2 Enlarged Front Counter Plan & Details
- A5.0 Wall Sections & Details
- A5.1 Wall Sections & Details
- A5.2 Wall Sections & Details
- A5.3 Wall Sections & Details
- A6.0 Door & Hardware Schedules
- A6.1 Finish Schedules

STRUCTURAL

- S1.0 Foundation Plan
- S1.2 Roof Framing Plan
- S2.0 Foundation Sections
- S3.0 Framing Sections
- S3.1 Steel Details
- S3.2 Framing Details
- S4.0 General Structural Notes

MECHANICAL

- M1.0 Mechanical Roof Plan
- M1.2 Ductwork Plan
- M1.4 Refrigerant & Gas Piping Plan
- M2.0 Exhaust Hoods
- M3.0 Mechanical Details
- M4.0 General Mechanical Notes
- M4.1 Mechanical Schedules

FIRE PROTECTION

FIRE PROTECTION PLAN – Provided by Others

PLUMBING

- P1.0 Domestic Water Piping Plan
- P1.2 Waste, Vent & Storm Piping Plan
- P1.4 Underground Rough-in Plan
- P1.6 Overhead Rough-in Plan
- P2.0 Domestic Water Isometric
- P2.1 Waste & Vent Isometric
- P2.2 Storm Isometric
- P3.0 Plumbing Details
- P4.0 General Plumbing Notes
- P4.1 Plumbing Schedules
- P4.2 Check Valve Detail

ELECTRICAL

- E1.0 POS Electrical Riser Diagram
- E1.1 Rough-In Floor Plan
- E2.0 Partial Lighting Plan & Schedule
- E2.1 Partial Lighting Plan
- E2.2 Electrical Roof Plan
- E3.0 Rough-In Electrical Schedule
- E3.1 Electrical & Lighting Notes and Details
- E3.2 Interlock Wiring Diagrams
- E4.0 Wiring Details
- E4.1 Lighting Controls
- E4.2 Split Utility Distribution Schedules

KITCHEN EQUIPMENT

- K1.0 Kitchen Cover Sheet
- K2.0 Kitchen Equipment Plan
- K2.1 Kitchen Equipment Schedule

PREPARED BY:	DIA	STD ISSUE DATE	DIA	STD ISSUE DATE	DIA
McDonald's USA, LLC					
12400 PORTLAND AVENUE, SUITE 100 BURNSVILLE, MN 55337 EMAIL: DATAREPRESSEDIGN.COM PHONE: (952) 252-4042 FAX: (952) 252-4943					
REPRESENTATIVE, INC.					
DESIGN					
PREPARED FOR:					
McDonald's USA, LLC					
12400 PORTLAND AVENUE, SUITE 100 BURNSVILLE, MN 55337 EMAIL: DATAREPRESSEDIGN.COM PHONE: (952) 252-4042 FAX: (952) 252-4943					
These drawings and specifications are the confidential and proprietary property of McDonald's USA, LLC and shall not be reproduced or distributed outside of this specific project without the express written consent of McDonald's USA, LLC. These drawings and specifications are prepared for use on this specific project only. They are not to be used for any other purpose or for any other project. Any unauthorized use of these drawings and specifications may result in criminal prosecution under the U.S. Copyright Laws.					
DRAWN BY	DIA	STD ISSUE DATE	DIA	STD ISSUE DATE	DIA
DIA	2019-11	2019-11	KO	01/23/20	01/23/20
REVIEWED BY					
DIA					
DATE ISSUED					
SITE ADDRESS					
SITE ID					
015-0071	605 SOUTH 7TH STREET, KANSAS CITY, KS	015-0071	015-0071	015-0071	015-0071
RD#19175					
PREPARED BY:					
McDonald's USA, LLC					
12400 PORTLAND AVENUE, SUITE 100 BURNSVILLE, MN 55337 EMAIL: DATAREPRESSEDIGN.COM PHONE: (952) 252-4042 FAX: (952) 252-4943					
These drawings and specifications are the confidential and proprietary property of McDonald's USA, LLC and shall not be reproduced or distributed outside of this specific project without the express written consent of McDonald's USA, LLC. These drawings and specifications are prepared for use on this specific project only. They are not to be used for any other purpose or for any other project. Any unauthorized use of these drawings and specifications may result in criminal prosecution under the U.S. Copyright Laws.					
DRAWN BY	DIA	STD ISSUE DATE	DIA	STD ISSUE DATE	DIA
DIA	2019-11	2019-11	KO	01/23/20	01/23/20
REVIEWED BY					
DIA					
DATE ISSUED					
SITE ADDRESS					
SITE ID					
T1.0					
COVER					

GENERAL NOTES

1. ALL WORK SHALL BE IN COMPLIANCE WITH APPLICABLE FEDERAL, STATE AND LOCAL BUILDING CODES, REGULATIONS, ORDINANCES AND STANDARDS INCLUDING ADA AND OR OTHER HANDICAP ACCESSIBILITY CODES.
2. GENERAL CONTRACTOR IS RESPONSIBLE FOR COORDINATING WITH THE OWNER'S VENDORS REGARDING SCHEDULING ON SITE DURING CONSTRUCTION AND SEQUENCING OF THE WORK.
3. THE CONSTRUCTION NOTES AND DRAWINGS ARE SUPPLIED TO ILLUSTRATE THE DESIGN INTENT AND GENERAL TYPE OF CONSTRUCTION DESIRED AND ARE INTENDED TO IMPLY THE FINEST QUALITY OF CONSTRUCTION, MATERIAL AND WORKMANSHIP THROUGHOUT.
4. THE DRAWINGS ARE NOT TO BE SCALED. FOR INFORMATION CONCERNING EXISTING CONDITIONS, ETC., VERIFICATION MUST BE DONE IN THE FIELD. LARGE SCALE DRAWINGS HAVE PRECEDENCE OVER SMALL SCALE DRAWINGS.
5. PRIOR TO COMMENCEMENT OF ANY CONSTRUCTION, CONTRACTOR SHALL VERIFY EXISTENCE AND LOCATION OF ALL EXISTING ABOVE AND BELOW GRADE, UTILITIES, INCLUDING SANITARY SEWER, STORM SEWER, WATER, GAS, ELECTRICAL, TELEPHONE, ETC. ANY DISCREPANCIES IN UTILITY LOCATIONS SHALL BE BROUGHT TO THE IMMEDIATE ATTENTION OF THE ARCHITECT.
6. GENERAL CONTRACTOR SHALL BE RESPONSIBLE FOR VERIFICATION OF ALL BUILDING DIMENSIONS PRIOR TO BEGINNING CONSTRUCTION AND SHALL IMMEDIATELY NOTIFY THE ARCHITECT OF ANY VARIANCE OR DISCREPANCY AFFECTING NEW CONSTRUCTION PRIOR TO PROCEEDING WITH WORK.
7. CONTRACTOR SHALL PROVIDE ALL NECESSARY BLOCKING IN WALLS FOR SUPPORT OF ALL EQUIPMENT, SHELVING, ACCESSORIES, SIGNAGE, AND OTHER DEVICES REQUIRED.
8. ALL PENETRATIONS SHALL RECEIVE CAULKING TO SEAL ANY TYPE OF ENERGY LOSS.
9. THE CONTRACTOR SHALL VERIFY AND COORDINATE ALL APPLICABLE DIMENSIONS OF FIXTURES AND EQUIPMENT SUPPLIED AND/OR INSTALLED BY OTHERS.
10. UPON COMPLETION OF PROJECT, G.C. TO OBTAIN ALL FINAL INSPECTIONS AS REQUIRED BY LOCAL JURISDICTIONS AND FURNISH OWNER WITH EVIDENCE OF ALL SUCH INSPECTIONS AND CERTIFICATES OF OCCUPANCY.
11. SIGNS, UNLESS NOTED OTHERWISE, ARE PROVIDED BY OWNER'S SIGN CONTRACTOR. OWNER'S SIGN VENDOR WILL PROVIDE MONUMENT SIGN BASE (CONCRETE, STONE, BRICK, ETC.) IF PROJECT REQUIRES DECORATIVE BASE. SEE SHEET L-1 TO VERIFY IF REQUIRED. GENERAL CONTRACTOR TO PROVIDE ROUGH-IN & FINAL CONNECTION AND BRAILLE EXIT SIGN.
12. GENERAL CONTRACTOR TO PROVIDE FOUR (4) 30 YARD DUMPSTERS DURING McDONALD RETAIL MOVE-IN.
13. GENERAL CONTRACTOR SHALL PROVIDE ONE SKILLED LABORER FOR ONE WEEK DURING McDONALD RETAIL MOVE-IN. (40 HOURS)
14. GENERAL CONTRACTOR SHALL BE RESPONSIBLE FOR SET-UP AND COORDINATION OF ALL THE UTILITY SERVICES FOR THE PROJECT.
15. ALL EXTERIOR FLOOR PLAN DIMENSIONS ARE TO EXTERIOR FACE OF MASONRY UNLESS OTHERWISE NOTED. ALL INTERIOR FLOOR PLAN DIMENSIONS ARE TO FACE OF FINISH UNLESS OTHERWISE NOTED.
16. FINAL KEYING TO BE COORDINATED WITH McDONALD FACILITY MANAGER AND PAID FOR BY McDONALD.
17. REFER TO "PROJECT MANUAL" FOR ALL OTHER INSTRUCTIONS & DIRECTIVES NOT SHOWN IN DRAWINGS.

ABBREVIATIONS

GENERAL ABBREVIATIONS


A	ANNEALED	INSUL	INSULATION
AC	AIR CONDITIONING	MAX	MATERIAL
ACT	ACOUSTIC CEILING TILE	MECH	MECHANICAL
AFF	ABOVE FINISH FLOOR	MFR	MANUFACTURER
AHU	AIR HANDLING UNIT	MIN	MINIMUM
AL	ALUMINUM	MO	MASONRY OPENING
ASPH	ASPHALT	MR	MOISTURE RESISTANT
CJ	CONTROL JOINT	MTL	METAL
CLNG	CEILING	NA	NOT APPLICABLE
CMU	CONCRETE MASONRY UNIT	NIC	NOT IN CONTRACT
COL	COLUMN	NOM	NOMINAL
CONC	CONTINUOUS	NTS	NOT TO SCALE
CONT	CONTINUOUS	OC	ON CENTER
CP	CONCRETE PAD	OPP	OPPOSITE
CT	CEMERIC TILE	OPT	OPTIONAL
CL	CENTERLINE	PF	PREFABRICATED
DBL	DOUBLE	PSF	POUNDS PER SQUARE FOOT
DF	DRINKING FOUNTAIN	PT	PRESSURE TREATED
DIA	DIAMETER	PTD	PAINTED
DIM	DIMENSION	QT	QUARRY TILE
DN	DOWN	R	RADIUS
DS	DOWNSPOUT	REBAR	REINFORCING BAR
EA	EACH	REF	REFERENCE
EJ	EXPANSION JOINT	REQD.	REQUIRED
ELEC	ELECTRICAL	RO	ROUGH OPENING
ELEV	ELEVATION	SB	SPLASHBLOCK
EQ	EQUAL	SIM	SIMILAR
EXIST	EXISTING	SPEC	SPECIFICATION
FD	FLOOR DRAIN	SS	STAINLESS STEEL
FE	FIRE EXTINGUISHER	STL	STEEL
FEC	FIRE EXTINGUISHER CABINET	STOR	STORAGE
FF	FINISH FLOOR	SUSP	SUSPENDED
FR	FIRE RATED	TEMP	TEMPERATURE
FRP	FIBERGLASS REINFORCED PLASTIC	TYP	Typical
GALV	GALVANIZED	UNO	UNLESS NOTED OTHERWISE
GYP BD	GYPSUM BOARD	VCT	VINYL COMPOSITION TILE
HC	HANDICAP	VERT	VERTICAL
HDW	HARDWARE	WD	WOOD
HM	HOLLOW METAL	WP	WATERPROOF
HT	HEIGHT	WWF	WELDED WIRE FABRIC
HVAC	HEATING, VENTILATION, AIR CONDITIONING		

McDONALD'S ABBREVIATIONS

AP	APOLIC MENTAL PANEL	LAM	LAMINATE
BM	BRAKE METAL	LE	ACCENT LIGHTING
C	ALUMINUM CANOPY	LP	LOW POINT
CG	CORNER GUARD	LL	LEVEL LANDING
CT	WALL TILE	MACHINE	
DE	DECOR ELEMENT	MANAGER	
DEVICE		MF	METAL FASCIA
DMB	DIGITAL MENU BOARD	MS	MOP SINK
DS	DROP SOFFIT	PB	PIPE BILLARD
D/T	DRIVE-THRU	PT	RMHC COIN COLLECTOR
FB	FILL BOX	RL	ROOF LADDER
F/C	FREEZER/COOLER	ROOM	
GC	GENERAL CONTRACTOR	S	McDONALD'S SIGNAGE
HP	HIGH POINT	SCH	SHLUTER
KIOSK		SSBB	SELF SERVE BEVERAGE BAR
L	LIGHT FIXTURE	UN	ALUMINUM CANOPY underscore

DRAWN BY		PREPARED BY:		REVIEWED BY:		DATE ISSUED	
 McDonald's USA, LLC		12400 ARCHITECTURE & PLANNING 12400 PORTLAND AVENUE SOUTH BURNSVILLE, MN 55337 EMAIL: DATA@REPRISEDI.S.COM PHONE: (952) 252-4042 FAX: (952) 252-4943		KOD 01/23/20		01/23/20	
TITLE: 2019 STANDARD BUILDING - BB20 015-0071.00.00		STD ISSUE DATE: 2019_11		DATE ISSUED: 01/23/20		REV'D DATE: 01/23/20	
DESCRIPTION: 459-F10-WOOD/WOOD		DESCRIPTION: WOOD BEARING WALLS W/FIBER CEMENT SIDING & CI WOOD ROOF TRUSS FRAMING FIBER CEMENT PANEL/BATTEN/APOLIC PANEL/BRICK EXT. FINISH		DESCRIPTION: SITE ADDRESS: 605 SOUTH 7TH STREET, KANSAS CITY, KS		DESCRIPTION: SITE ADDRESS: 605 SOUTH 7TH STREET, KANSAS CITY, KS	
SHEET NO.	015-0071	015-0071	015-0071	015-0071	015-0071	015-0071	015-0071
GENERAL NOTES							
I hereby certify that this drawing, specification or report was prepared under my direction and supervision, and was drawn by me or under the direct supervision of a registered architect, engineer or surveyor duly registered with the State of Minnesota.							
Signature:  Brian Abner, AIA, LEED AP Title: Architect Registration Number: 01234567 Date: 01/23/20							
BY:  Brian Abner, AIA, LEED AP Title: Architect Registration Number: 01234567 Date: 01/23/20							

THE LAYOUT OF THE DRIVE-THRU LANES SHOWN IN THIS DETAIL ILLUSTRATES DRIVE-THRU DESIGN PRINCIPLES.

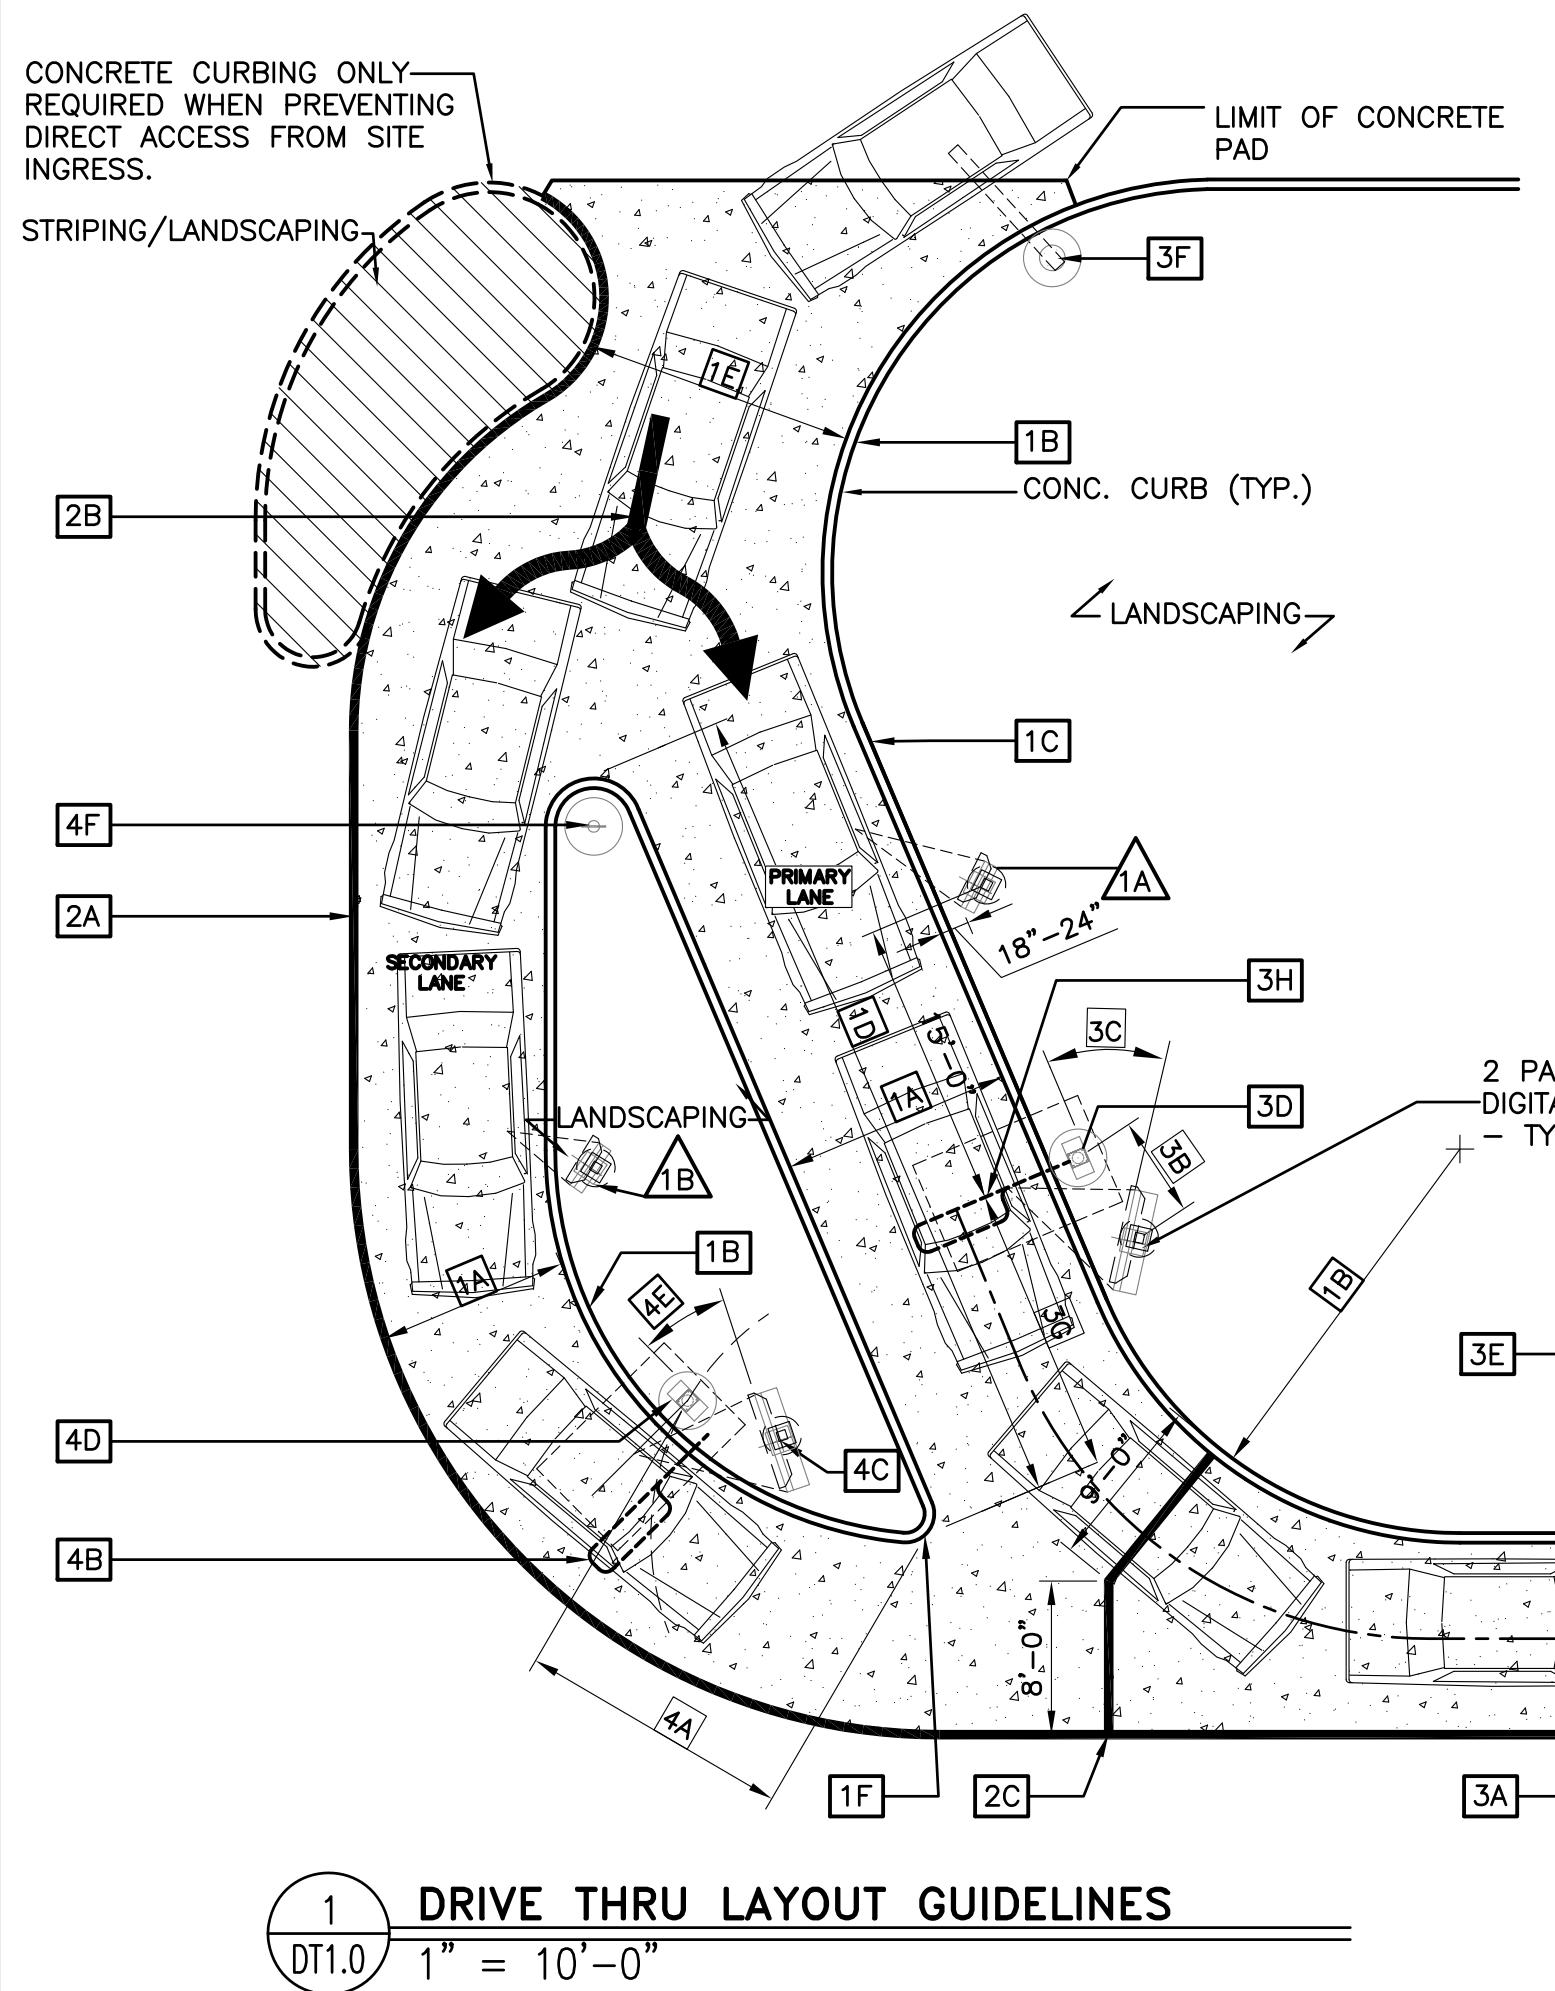


1 DRIVE THRU LAYOUT GUIDELINES

DT1.0 1" = 10'-0"

NOTES

- VERIFY CONDUIT SIZES AND LAYOUT WITH DETECTOR LOOP MANUFACTURER.
- CENTER VEHICLE DETECTOR LOOP IN DRIVE THRU LANE. INSTALL PER MFR. RECOMMENDATIONS.
- NO STEEL (REBAR OR ELECTRICAL WIRE) SHALL BE USED WITHIN 2' OF LOOP.
- DETECTOR LOOP MANUFACTURERS:
DETECTOR LOOPS MAY BE BY ONE OF THE FOLLOWING COMPANIES OR EQUAL.
3M: 1-800-328-0033
HME: 1-800-848-4468
- DETECTOR LOOP MATERIAL:
PVC TUBING 1/2" I.D. 100 PSI LOOP MADE FROM ONE LENGTH OF THIN FOURTEEN GAUGE STRANDED WIRE. LEAD-IN IS PRE-TWISTED AT FACTORY.
- DETECTOR LOOP CONSTRUCTION:
FORMED WITH ONE CONTINUOUS LENGTH OF PVC WITH NO SHARP CORNERS AS DETAILED. WIRE LOOPED, FORMED, & PIGTAILED AS DETAILED.

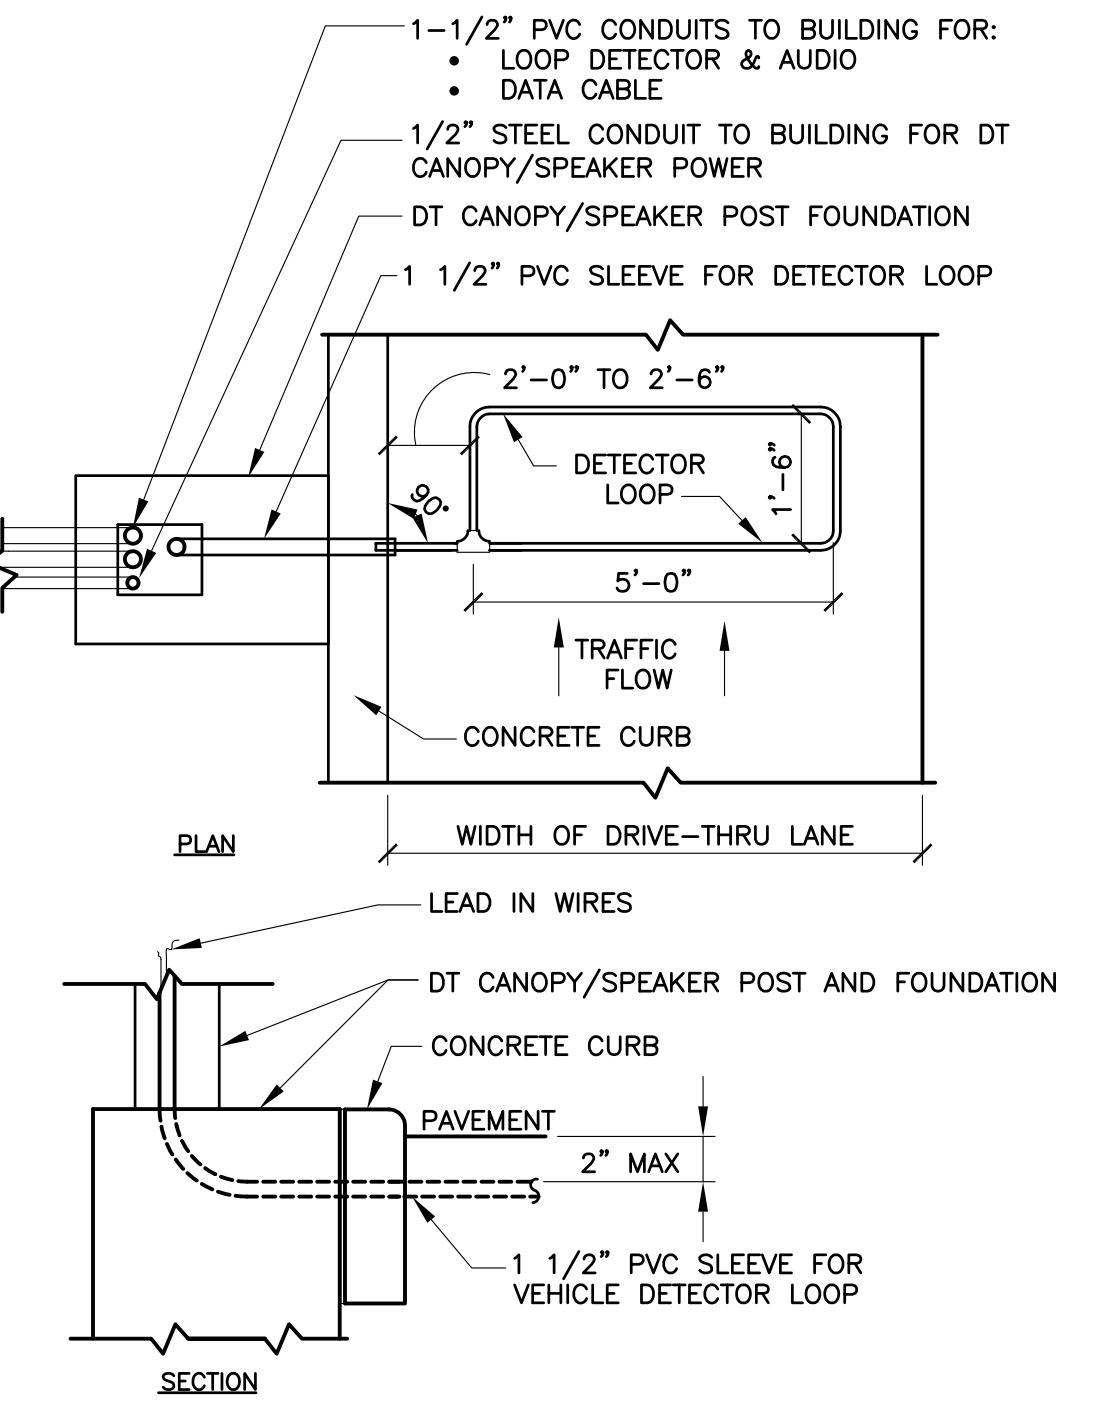

2 DETECTOR LOOP DETAILS

DT1.0 NOT TO SCALE

SIDE BY SIDE DRIVE-THRU STANDARD 1.0

- SIDE BY SIDE DRIVE-THRU STANDARD 1.0 CURBING DETAILS:**
 - DRIVE-THRU LANES BOUND BY CURB ON BOTH SIDES ARE TO BE 12'-0". LANES BOUND BY CURB ON ONE SIDE AND PAINTED STRIPING ON THE OTHER SIDE ARE TO BE A MIN. OF 10'-0".
 - THE MIN. RADIUS FOR ALL INSIDE/DRIVER'S SIDE DRIVE-THRU CURBING IS 20'-0".
 - PRIMARY LANE CURBING SHOULD BE AS STRAIGHT AS POSSIBLE. (LESS CURVING, THE BETTER).
 - THE OVERALL LENGTH OF THE CURBED ISLAND SHOULD BE 35'-45'. THE LENGTH OF THE ISLAND FROM THE DT CANOPY/SPEAKER ALLOWS FOR THREE CARS IN THE SECONDARY LANE, TWO IN THE PRIMARY LANE AND ONE AT THE COMMITMENT POINT.
 - ENTRANCE LANE ENTERING THE SIDE BY SIDE DRIVE-THRU IS TO BE 14'-0" MIN.
 - THE RADIUS FOR THE ISLAND TIP SHALL BE 1'-6".
- SIDE BY SIDE DRIVE-THRU STANDARD 1.0 PAVEMENT MARKINGS:**
 - 6" WIDE YELLOW PAINT STRIPE TO SPAN OUTER EDGE OF THE ENTIRE DRIVE-THRU LANE. LANE STARTS AT DRIVE-THRU ENTRANCE WHERE "McDONALD'S GATEWAY" SIGN IS LOCATED.
 - DOUBLE-HEADED ARROW PAVEMENT MARKING. STANDARD STRIPING MARKINGS ARE 7"-0" SHAFT, 7'-0" ARROW STEM AND 3"-0" FOR THE ARROW HEAD. TIP OF ARROW HEAD TO BE LOCATED AT CENTER OF EACH LANE.
 - MERGE POINT IS LOCATED WHERE TWO VEHICLES LEAVING EACH DT CANOPY/SPEAKER SIMULTANEOUSLY MEET. THE MERGE POINT STRIPING IS TO BE LOCATED BY OFFSETTING THE INNER PRIMARY LANE BACK OF CURB 9'-0" AND OFFSETTING THE OUTER LANE STRIPING 8'-0". AT THE INTERSECTION OF THESE OFFSETS, A 6" YELLOW STRIPE IS TO BE MARKED PERPENDICULAR TO THE OUTER LANE AS WELL AS THE INNER PRIMARY LANE.
 - THE WORDS "THANK YOU" ARE TO BE PLACED 8" FROM THE EDGE OF THE YELLOW STRIPE TO THE BOTTOM OF THE WORD "YOU".
 - THE 8" YELLOW STRIPE IS TO BE PLACED 40'-0" FROM THE CENTER LINE OF THE OPEN PRESENT WINDOW AND IS FOR PARKING CARS THAT ARE WAITING FOR ORDERS.
 - A CIRCLE DIRECTIONAL ARROW CENTERED ABOVE THE WORD "DRIVE THRU" USED TO INDICATE THE DRIVE THRU ENTRY POINT.

- SIDE BY SIDE DRIVE-THRU STANDARD 1.0 EQUIPMENT POSITIONING FOR PRIMARY LANE:**
 - MIN. 60'-0" (+5', 60'-65') LINEAR DISTANCE BETWEEN THE CENTER LINE OF THE PRIMARY DT CANOPY/SPEAKER AND THE CENTER LINE OF THE OPEN ORDER BOOTH WINDOW AS MEASURED ALONG THE CENTER LINE OF THE LANE. THIS MAY ONLY BE INCREASED IN 20'-0" INCREMENTS (+5' FOR 80', 100', AND 120') TO A MAX OF 120'. 100'-0" IS OPTIMAL.
 - THE CENTER OF THE PRIMARY MENU BOARD FOUNDATION IS TO BE 5'-9" (5'-6" MIN. AND 6'-0" MAX.) FROM THE CENTER OF THE DT CANOPY/SPEAKER FOUNDATION WITH THE END CAP OF THE PRIMARY MENU BOARD 15" PREFERRED BUT NOT LESS THAN 12" FROM THE FACE OF CURB.
 - THE PRIMARY MENU BOARD SHOULD BE AT AN ANGLE OF APPROXIMATELY 25° TO 35° ANGLE (35° PREFERRED) FROM A CAR POSITIONED AT THE DT CANOPY/SPEAKER AND WITH 100% VISIBILITY.
 - AUGER "McDONALD'S ORDER HERE CANOPY" CANOPY FOUNDATION TIGHT AGAINST BACK OF CURB. SEE MANUFACTURER/LOCAL SPECIFICATIONS FOR DETAILS.
 - A SINGLE BOLLARD SHOULD BE POSITIONED AT THE CORNER OF THE BUILDING ON THE DRIVE-THRU SIDE. IT SHOULD BE FLUSH AGAINST THE BUILDING AND FACE OF THE BOLLARD SHOULD BE TIGHT AGAINST THE BACK OF THE CURB.
 - AUGER "McDONALD'S GATEWAY" SIGN FOUNDATION TIGHT AGAINST BACK OF CURB. SEE MANUFACTURER/LOCAL SPECIFICATIONS FOR DETAILS.
 - THE DISTANCE BETWEEN THE TIP OF THE CURBED ISLAND AND THE CENTER LINE OF THE PRIMARY DT CANOPY/SPEAKER MUST BE 15'-0". THIS MEASUREMENT IS TAKEN PARALLEL TO THE INSIDE CURB FACE OF THE PRIMARY LANE.
 - THE PRIMARY LANE DETECTOR LOOP SHOULD BE PERPENDICULAR TO THE CENTER OF THE PRIMARY DT CANOPY/SPEAKER.
- SIDE BY SIDE DRIVE-THRU STANDARD 1.0 EQUIPMENT POSITIONING FOR SECONDARY LANE:**
 - TO POSITION THE SECONDARY DT CANOPY/SPEAKER, DRAW AN ARC WITH A 14' RADIUS THAT IS CENTERED FROM THE MIDPOINT OF THE ISLAND TIP. THEN OFFSET THE FACE OF THE CURB BY 24" TO DETERMINE THE LOCATION OF CENTER OF FOUNDATION OF THE SECONDARY DT CANOPY/SPEAKER.
 - WHEN THE SECONDARY DT CANOPY/SPEAKER IS LOCATED AT 14'-0" FROM THE TIP OF THE CURBED ISLAND, THE LOOP DETECTOR IS TO BE 2'-0" FORWARD OF THE DT CANOPY/SPEAKER CENTER LINE WITH THE LOOP FACING FORWARD AND THE DETECTOR LOOP PERPENDICULAR TO THE SECONDARY DT CANOPY/SPEAKER WHEN POSSIBLE.
 - THE CENTER OF THE SECONDARY MENU BOARD FOUNDATION SHALL BE 5'-9" (5'-6" MIN. AND 6'-0" MAX.) FROM CENTER OF THE DT CANOPY/SPEAKER FOUNDATION WITH THE END CAP OF THE SECONDARY MENU BOARD 15" PREFERRED BUT NOT LESS THAN 12" FROM FACE OF CURB.
 - AUGER "McDONALD'S ORDER HERE" DT CANOPY/SPEAKER FOUNDATION TIGHT AGAINST BACK OF CURB. SEE MANUFACTURER/LOCAL SPECIFICATIONS FOR DETAILS.
 - THE SECONDARY MENU BOARD SHOULD BE AT AN ANGLE OF APPROXIMATELY 25° FROM A VEHICLE POSITIONED AT THE DT CANOPY/SPEAKER AND WITH 100% VISIBILITY.
 - "ANY LANE, ANY TIME" BOLLARD SIGN MUST BE A MIN. OF 1'-6" FROM FACE OF CURB AT THE BEGINNING OF THE LANDSCAPE ISLAND. BOLLARD SIGN IS TO BE ORIENTED AT AN ANGLE OF 90° FROM THE CURB.
- SIDE BY SIDE DRIVE-THRU STANDARD 1.0 DETECTOR LOOP:**
 - DETECTOR LOOPS SHALL BE LOCATED AT THE CENTER OF THE OPENING WINDOW AT THE CASH AND PRESENTER BOOTHS.


SIDE BY SIDE DRIVE-THRU STANDARD 1.0 FEATURES:

- SIDE BY SIDE DRIVE-THRU STANDARD 1.0 EQUIPMENT:**
 - PRE-BROWSE BOARD MUST BE 18"-24" FROM FACE OF CURB. THE DISTANCE AS MEASURED ALONG THE FACE OF CURB. THIS IS MEASURED FROM THE CENTER OF THE PRE-BROWSE BOARD FOUNDATION TO THE CENTER OF THE DT CANOPY/SPEAKER FOUNDATION. THE ANGLE (APPROXIMATELY 50°) OF THE PRE-BROWSE BOARD SHOULD MAXIMIZE VISIBILITY TO THE SECOND CAR FROM DT CANOPY/SPEAKER.
 - PRE-BROWSE BOARD MUST BE MIN. 12" FROM FACE OF CURB. THE DISTANCE AS MEASURED ALONG FACE OF CURB. THIS IS MEASURED FROM THE POINT PERPENDICULAR TO THE CENTER OF THE PRE-BROWSE BOARD FOUNDATION TO THE POINT PERPENDICULAR TO THE CENTER OF THE DT CANOPY/SPEAKER FOUNDATION. THE ANGLE OF THE PRE-BROWSE BOARD SHOULD MAXIMIZE VISIBILITY TO THE SECOND CAR FROM DT CANOPY/SPEAKER (PREFERRED 35°).

GENERAL NOTES


- DRIVE-THRU ELEMENTS:**
DT CANOPY/SPEAKER DRIVE-THRU PYLON/CLEARANCE POLE AND BOLLARD SIGN SHALL BE CONSISTENT WITH THE STANDARD BUILDING DESIGN DRIVE-THRU ELEMENTS.
OTHER DESIGNS MAY NOT BE USED.
- CONTRACTOR SHALL COORDINATE WITH APPLICABLE PLANS, McDONALD'S AREA CONSTRUCTION MANAGER, CONTENT SUPPLIER AND SIGNAGE SUPPLIER TO DETERMINE EXACT LOCATION, ORIENTATION, MOUNTING HEIGHTS, AND NUMBER OF BOARDS AND OTHER DRIVE-THRU ELEMENTS TO BE INSTALLED AT THIS SITE. ALL WORK TO BE COORDINATED WITH OTHER TRADES.
- CONTACT McDONALD'S AREA CONSTRUCTION MANAGER FOR DRIVE-THRU ELEMENT FOOTING AND WIRING REQUIREMENTS NOT SHOWN. (INFORMATION ALSO AVAILABLE THROUGH VENDOR WEBSITES) SIGNAGE MANUFACTURER TO PROVIDE FOOTING ANCHORS & TEMPLATES TO G.C. PRIOR TO FOUNDATION POURING.
- SEE DETAIL 2/DT1.0 FOR DETECTOR LOOP INFORMATION, ELECTRICAL SHEETS FOR LOW VOLTAGE CONDUIT DIAGRAM AND FOR DRIVE THRU POWER DIAGRAM; VENDOR'S SPECIFICATIONS SHALL GOVERN UPON ANY DISCREPANCIES.
- CONTRACTOR TO COORDINATE THE RESPONSIBILITIES OF THE ELECTRICAL CONTRACTOR, CONTENT SUPPLIER AND THE SIGN SUPPLIER.
- CONTRACTOR TO INSTALL PRE-FORMED, PRE-WIRED VEHICLE DETECTOR LOOP.
- CONTRACTOR SHALL VERIFY CONDUIT SIZES REQUIRED BY VEHICLE LOOP DETECTOR SUPPLIER.

PREPARED BY:		McDonald's USA, LLC	
© 2019 McDonald's USA, LLC These drawings and specifications are the confidential and proprietary property of McDonald's USA, LLC and shall not be copied or reproduced without the express written consent of McDonald's USA, LLC. Use of these drawings and specifications in conjunction with other plans and/or for use on a different site or at a later time, or for any other purpose, requires the services of properly licensed architects and engineers. Reproduction of these drawings and specifications or any portion thereof, without the express written consent of McDonald's USA, LLC, is unauthorized.			
DRAWN BY	-	STD ISSUE DATE	REVIEWED BY
		2019-11	RH
DESCRIPTION	2019 STANDARD BUILDING - BB20	DATE ISSUED	11 15 2019
ITEM NO.	015-0071.00	SITE ID	ELTS/BATTEN/STEEL PANEL/BRICK EXTERIOR FINISH
	015-0071.00	ADDRESS	605 South 7th St, Kansas City, KS
SHEET NO.	DT1.0	DRIVE-THRU DETAILS	

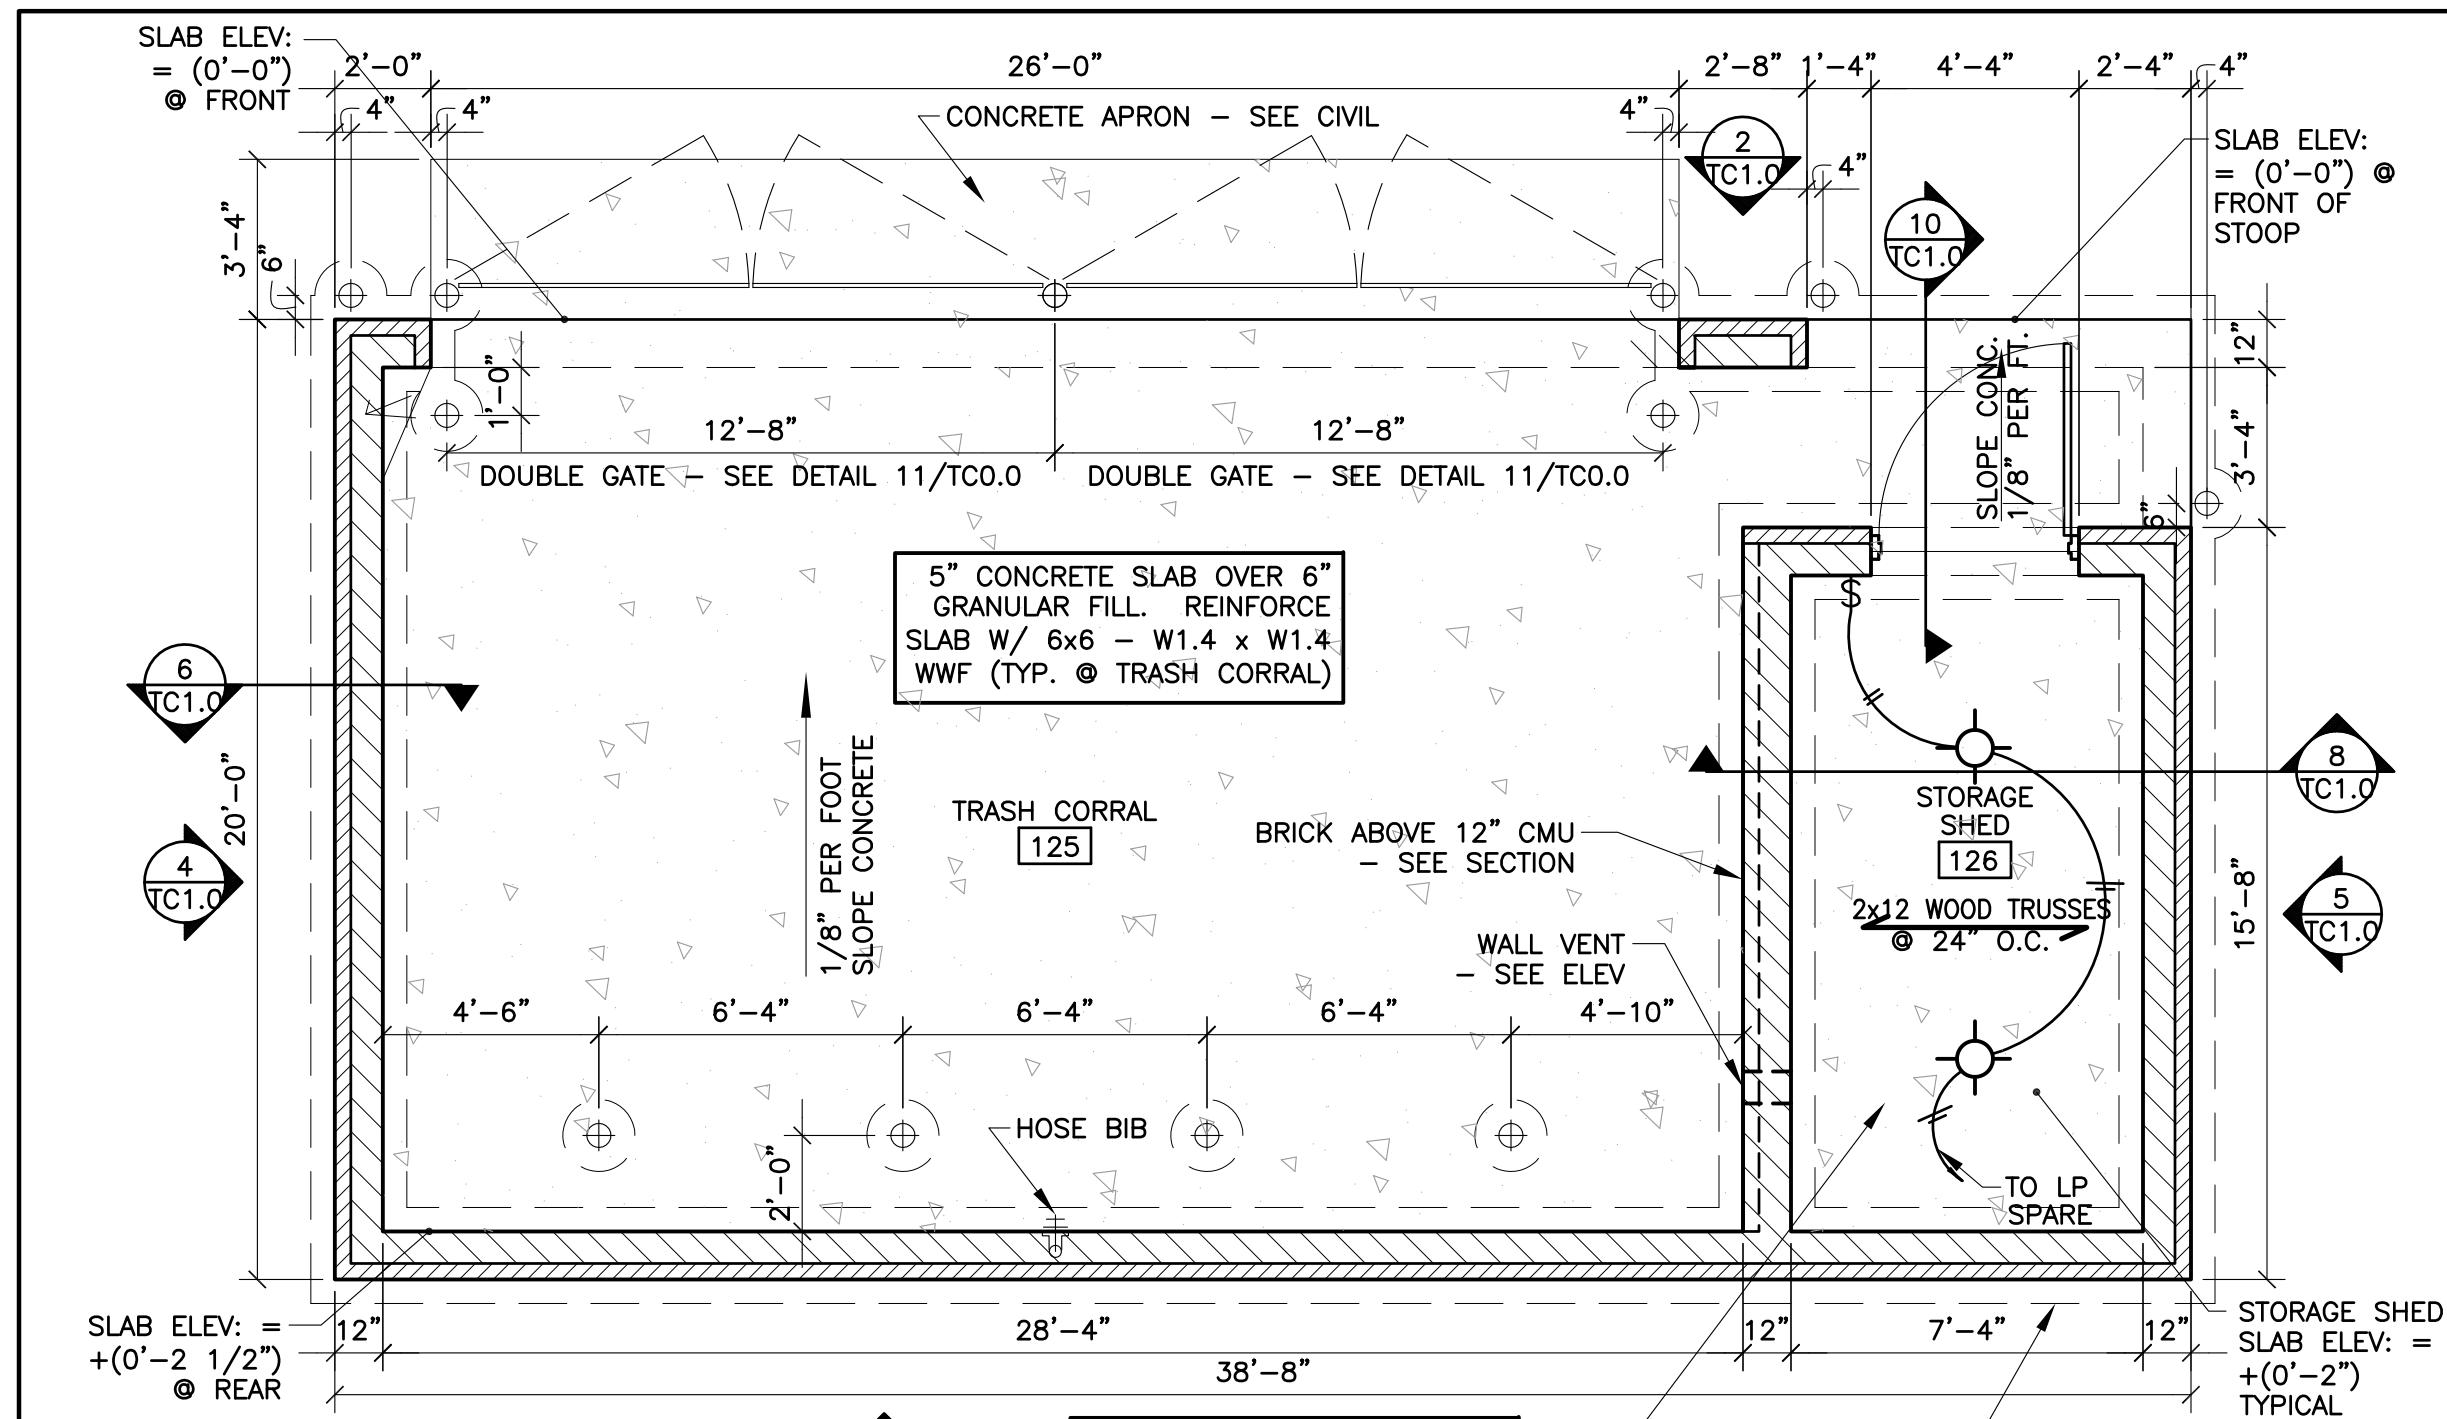


TRASH CORRAL PLAN W/ SHED

NOTE:
1. HOLLOW METAL DOOR SHALL BE 4' 0" x 7' 0" x 1 3/4" WITH FRAME, THRESHOLD, CONTINUOUS SINGE, LEVER HANDLE AND STOREROOM LOCKSET.
2. INCANDESCENT LIGHT FIXTURE SHALL BE FURNISHED, WIRE GUARD, 40 WATT LAMP, AND SURFACE MOUNT, PASS & SEMORE-#44 OR LIGHTING LTD #1742-2000 AWG

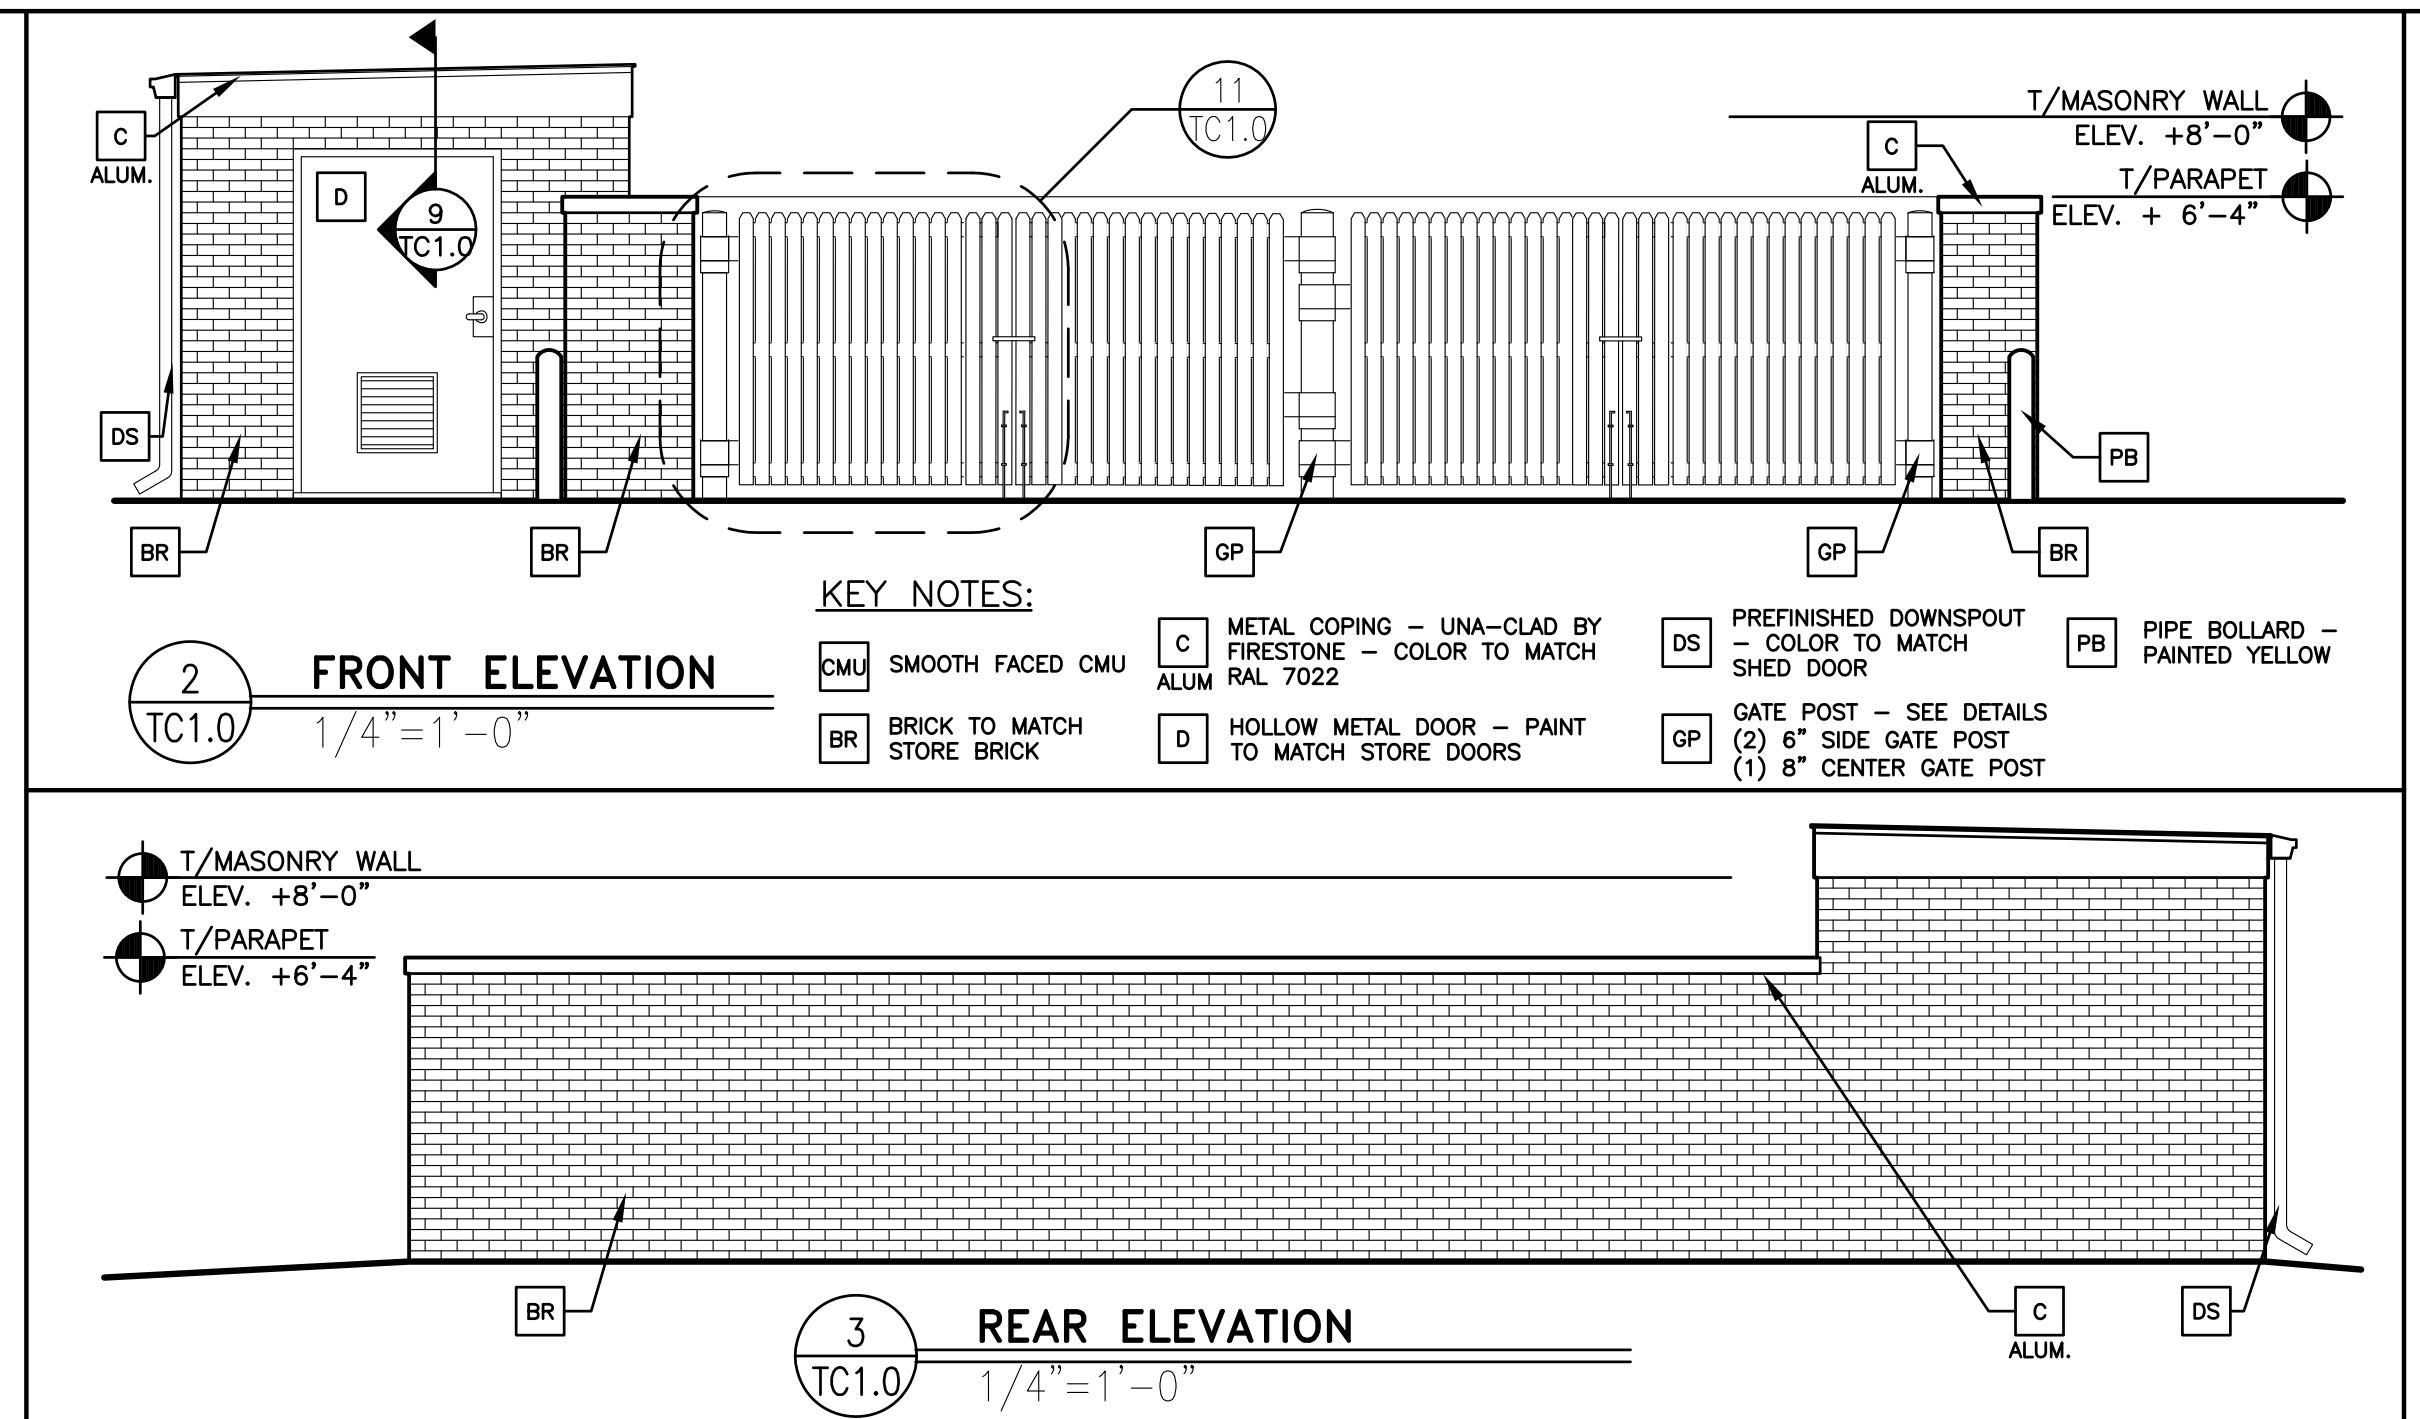

FRONT ELEVATION

REAR ELEVATION

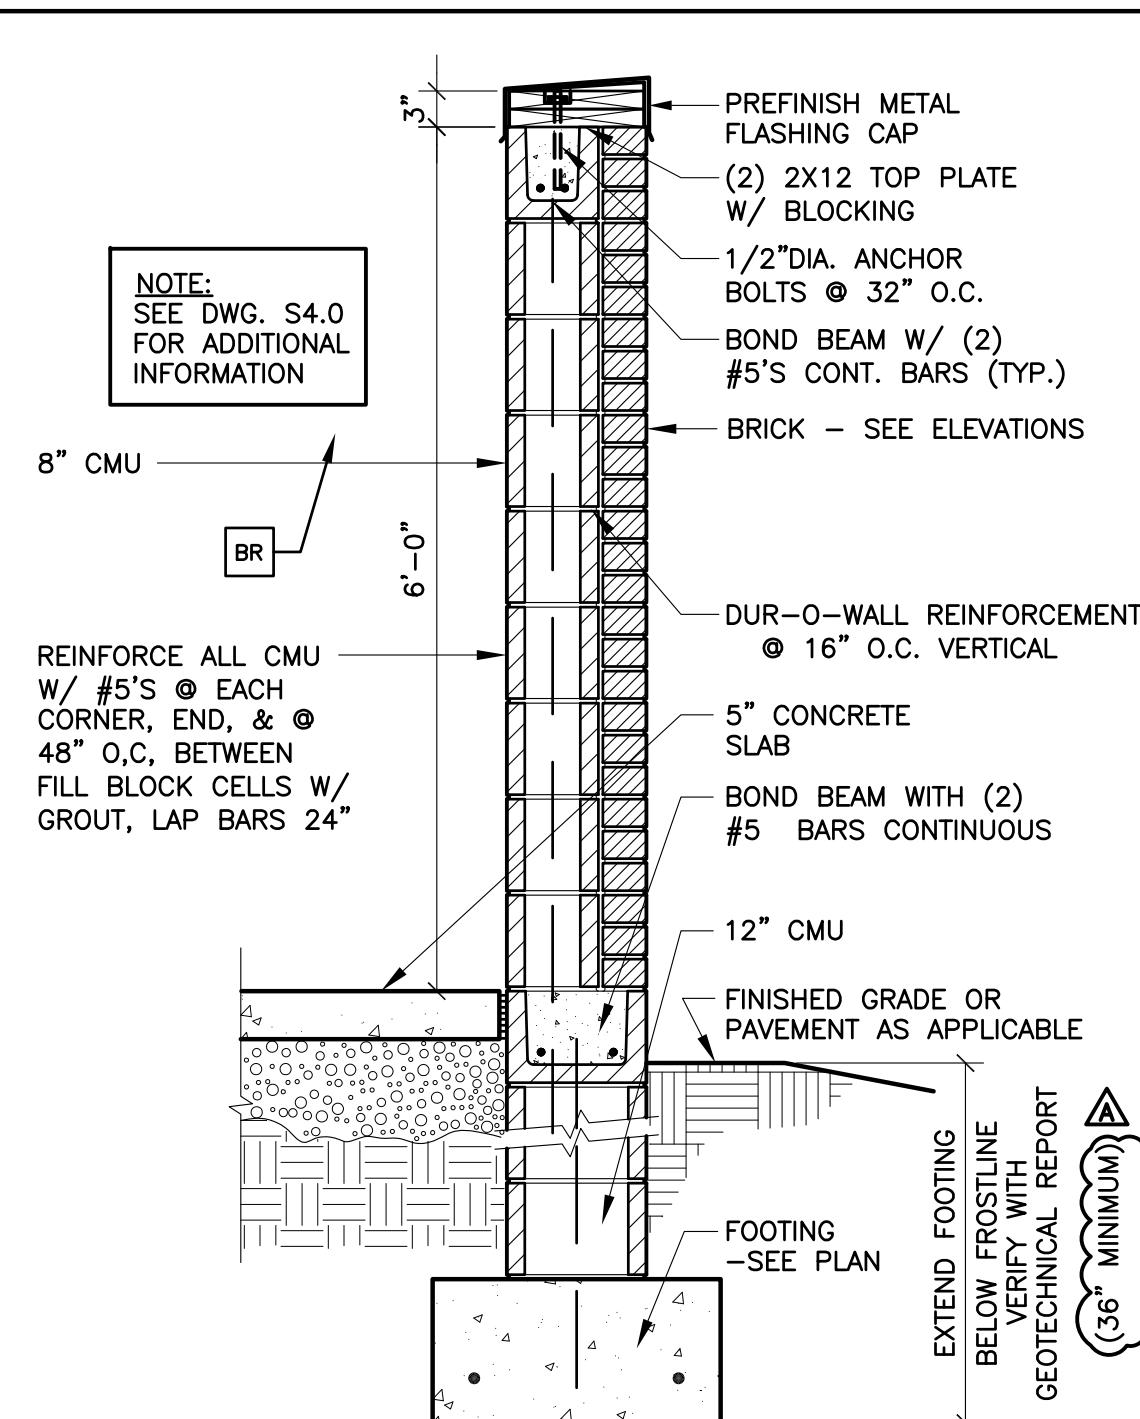



TYPICAL WALL SECTION

SHEET NO.	TITLE	DRAWN BY	REV.	DATE	DESCRIPTION	BY
015-0071.00.A	2019 STANDARD BUILDING - BB20	KO	11	05/05/20	CIVIL & PLAN REVIEW COMMENTS	
015-0071.00.A	459-F10-WOOD/WOOD	KO	11	01/23/20	FEMIT SET	
015-0071.00.A	WOOD BEARING WALLS W/FIBER CEMENT SIDING & CI	KO	11	01/13/20	USD PROGRESS SET REVIEW	
015-0071.00.A	WOOD ROOF TRUSS FRAMING	KO	11	01/13/20	GEOTECHNICAL REPORT	
015-0071.00.A	FIBER CEMENT PANEL/BATTEN/ALPOLIC PANEL/BRICK EXT. FINISH	KO	11	01/13/20	DESIGN	
015-0071.00.A	SITE ADDRESS	KO	11	01/13/20	Registration Number	


I hereby certify that the above specification or report was prepared under my direct supervision and control and is my original work. I am registered Architect of the State of Kansas.

Signature: ERIN ARCHITECTURE INC. Date: 05/05/2020


Design: 05/05/2020

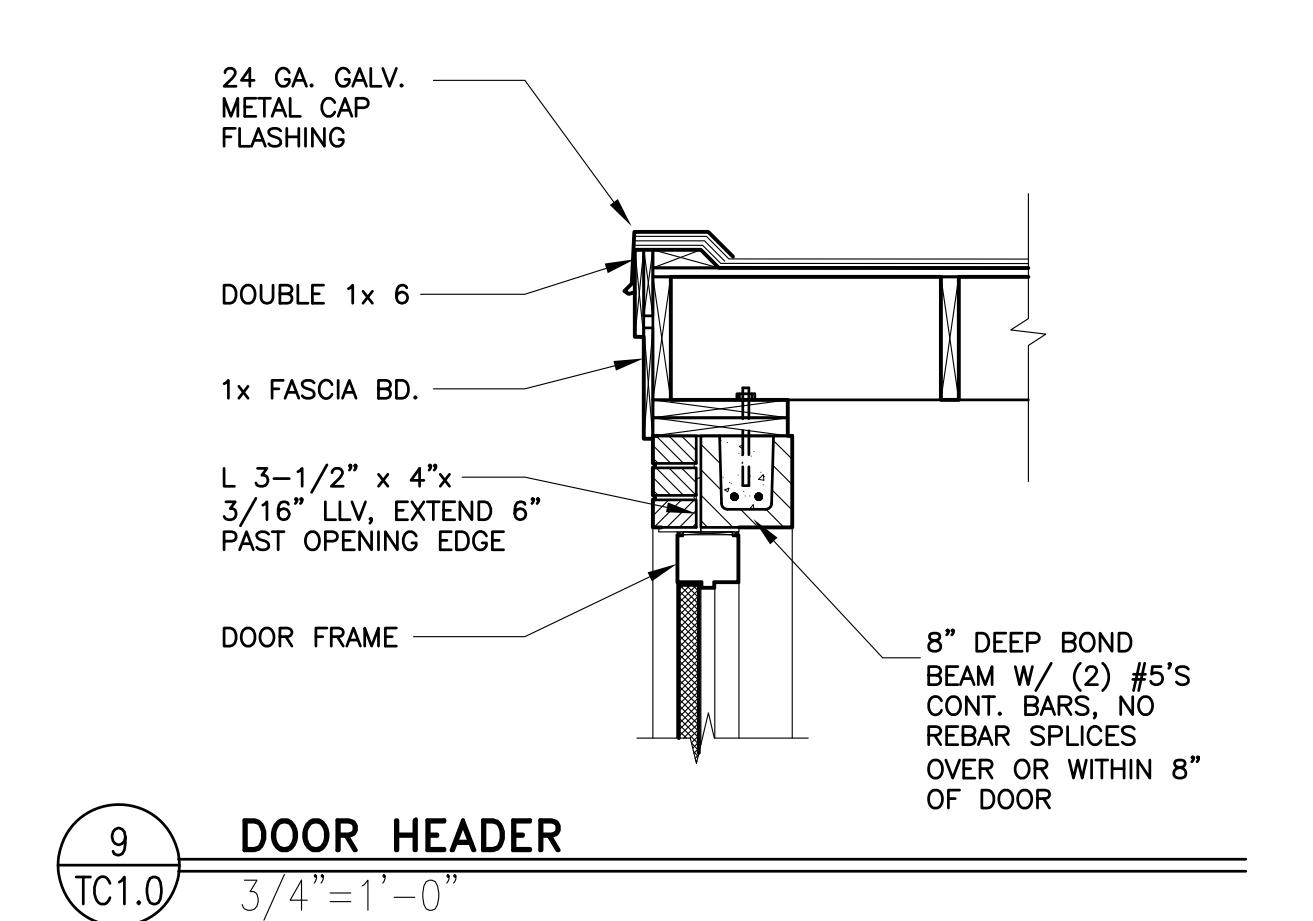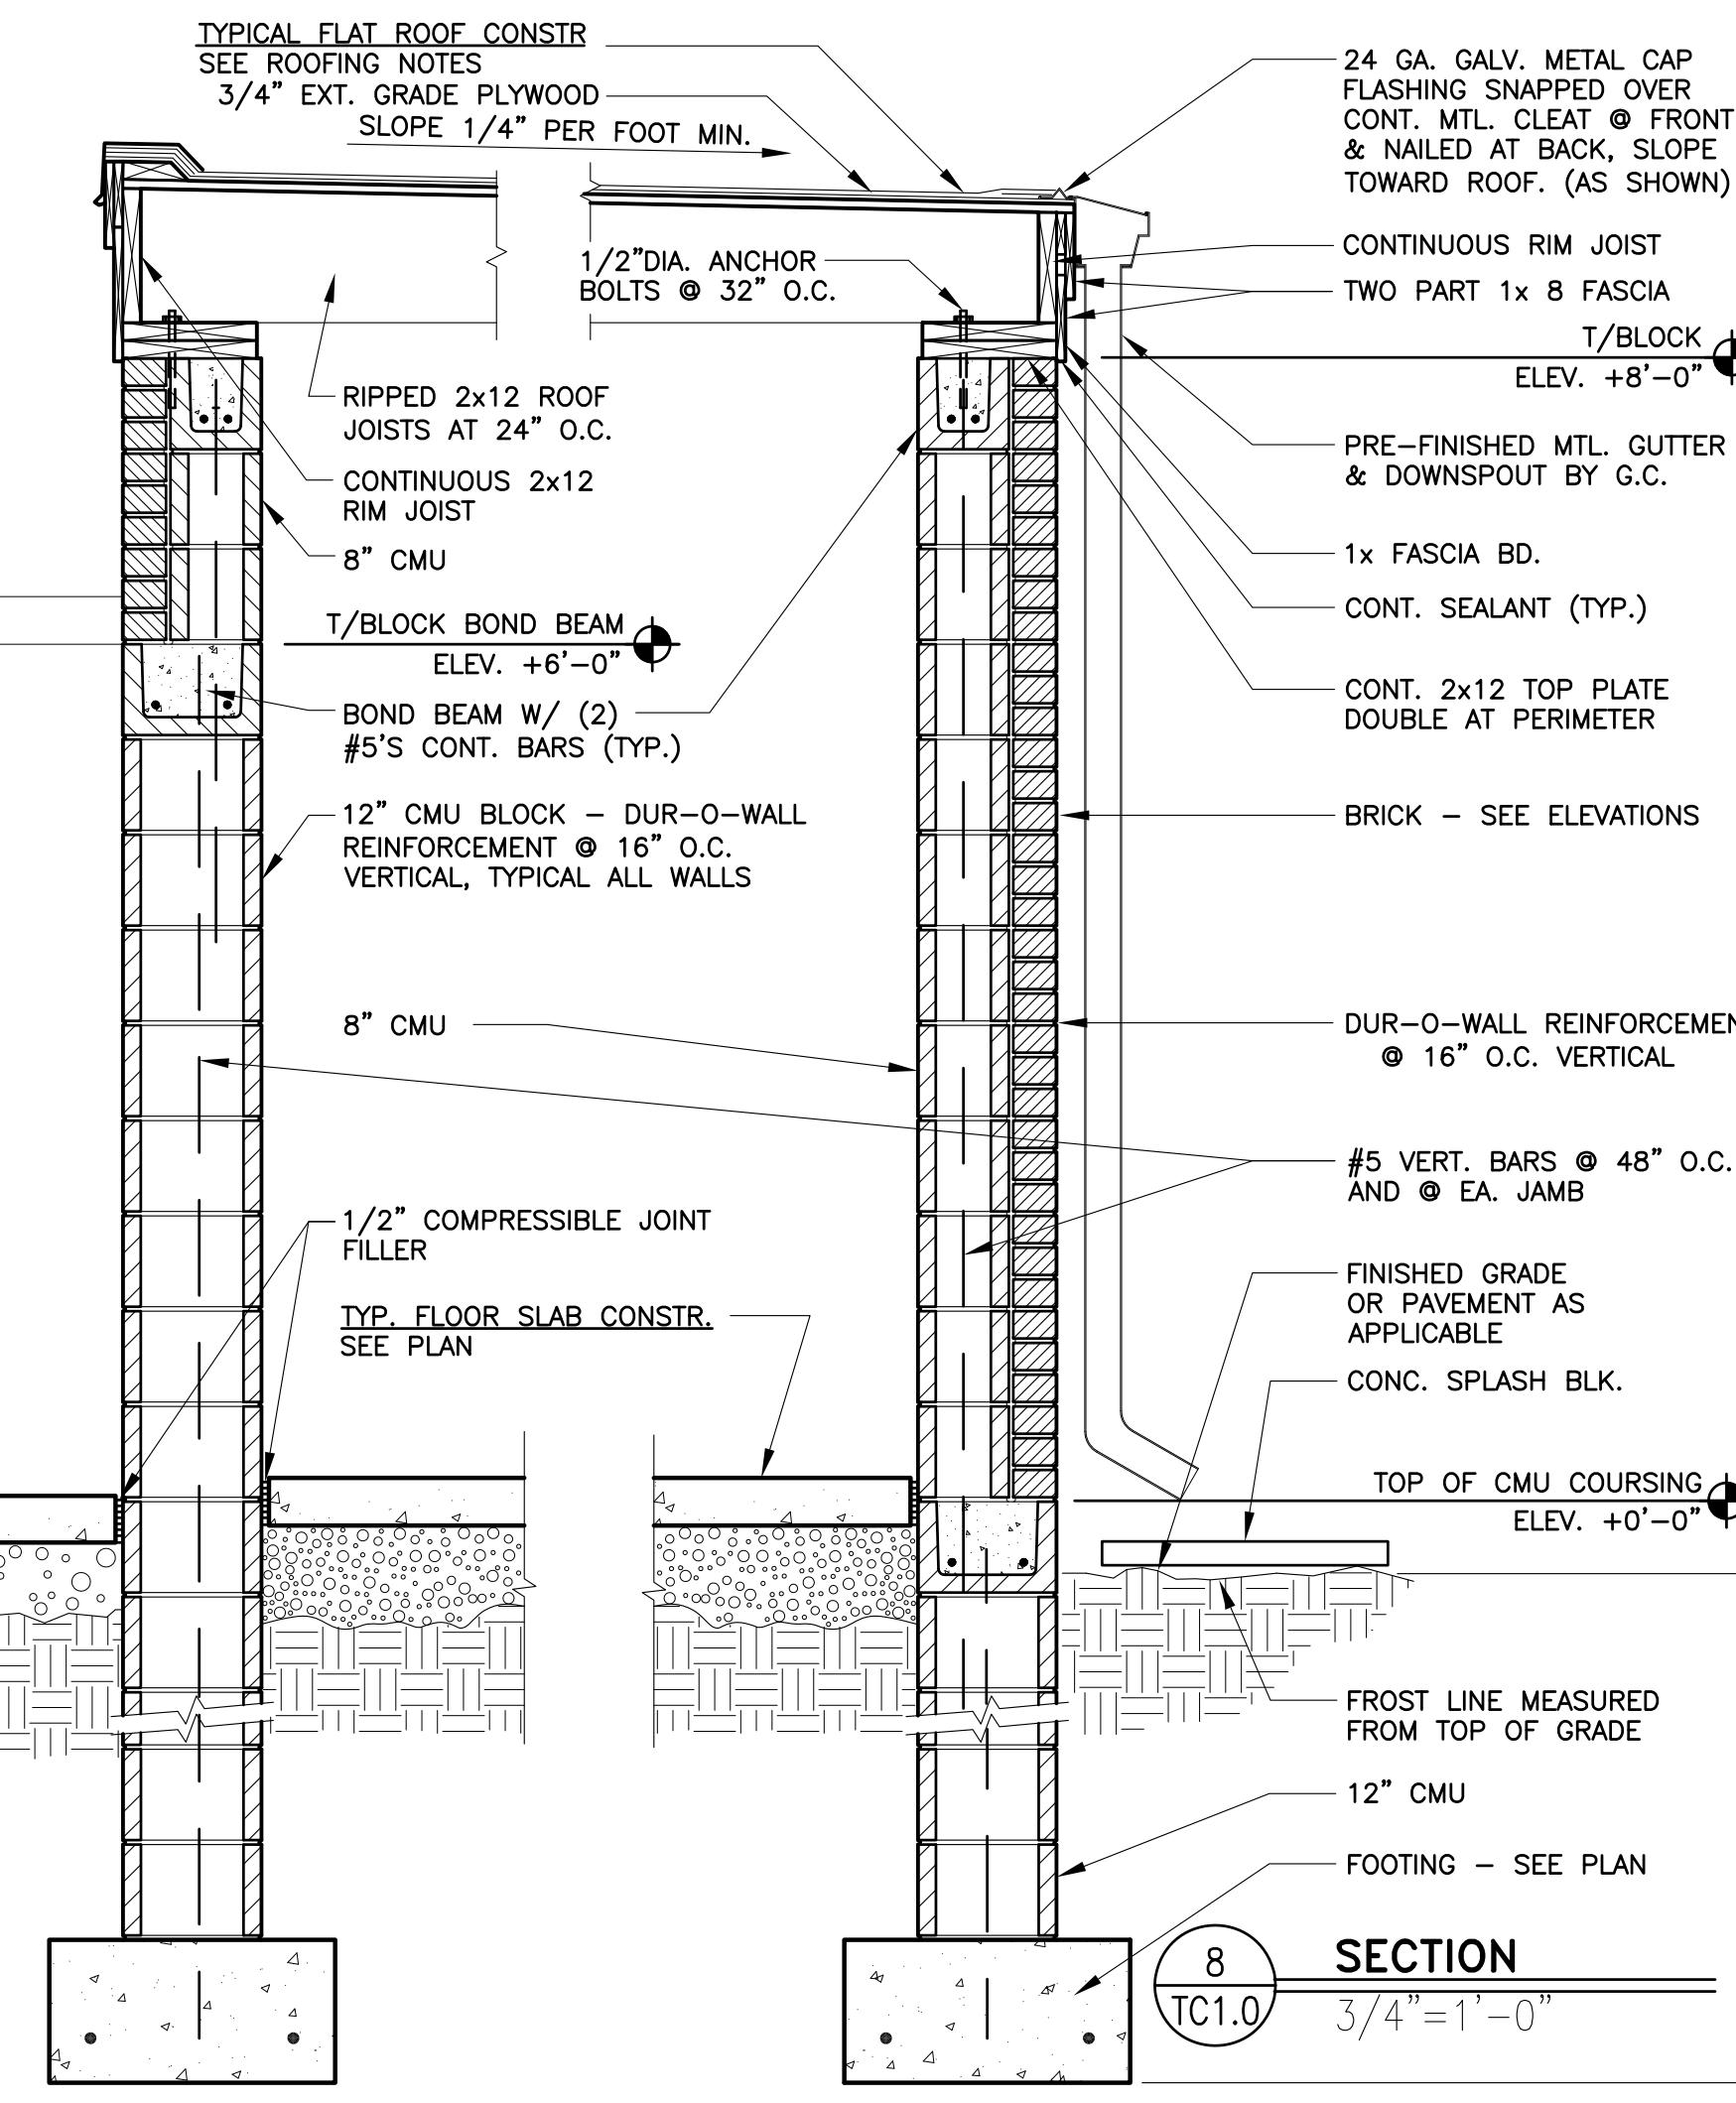


DOOR HEADER

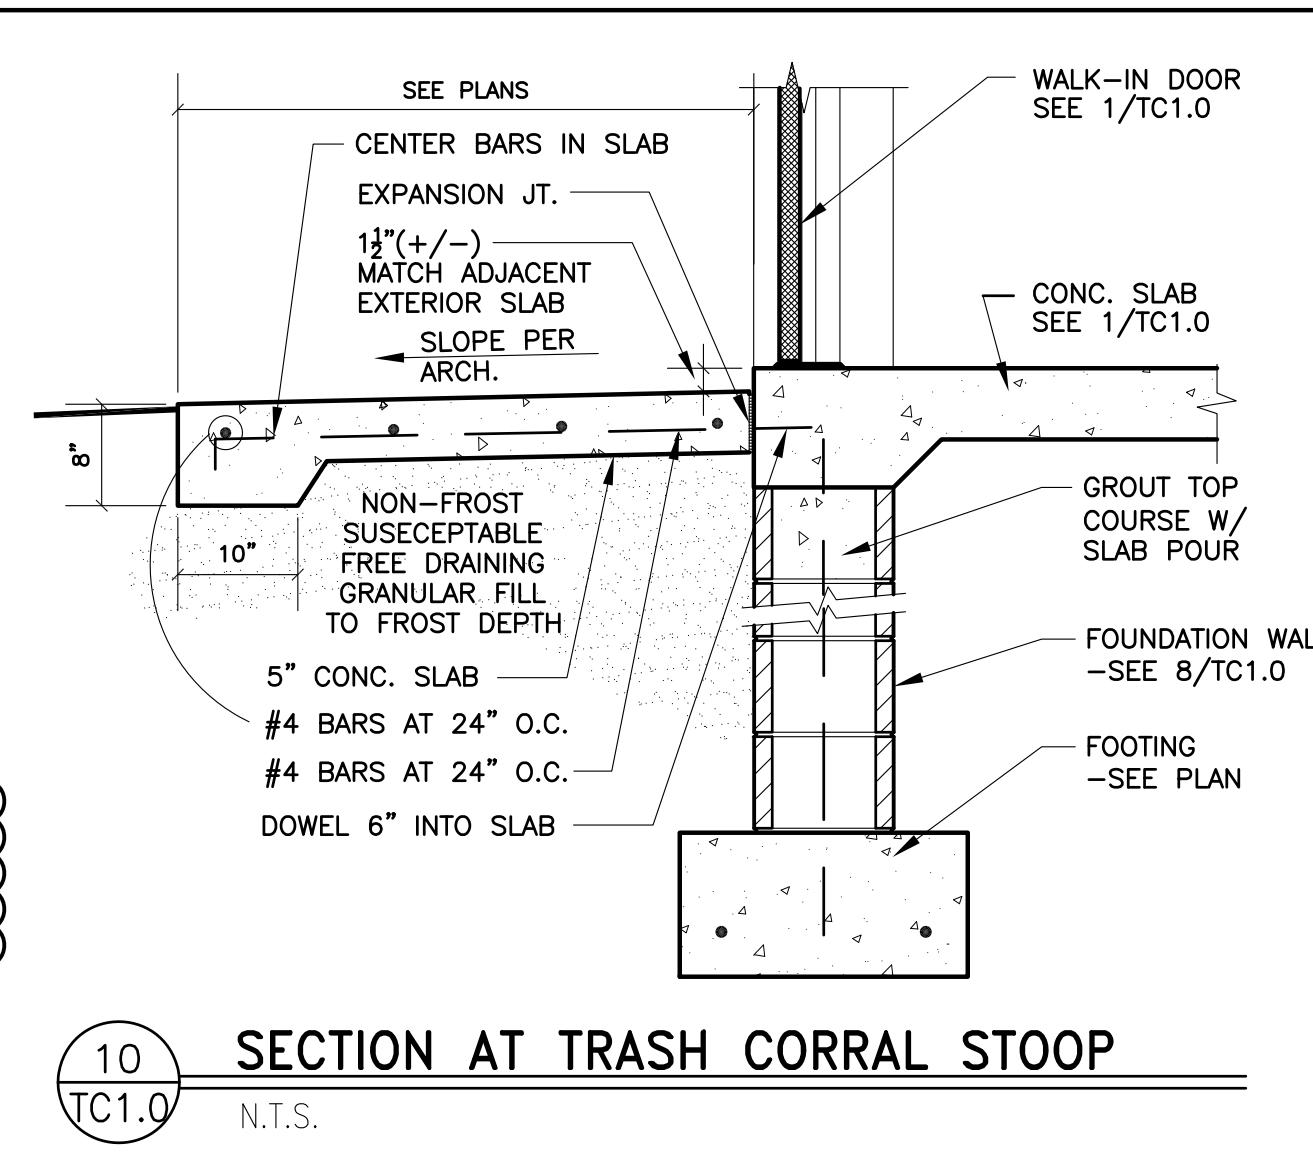




SECTION AT TRASH CORRAL STOOP

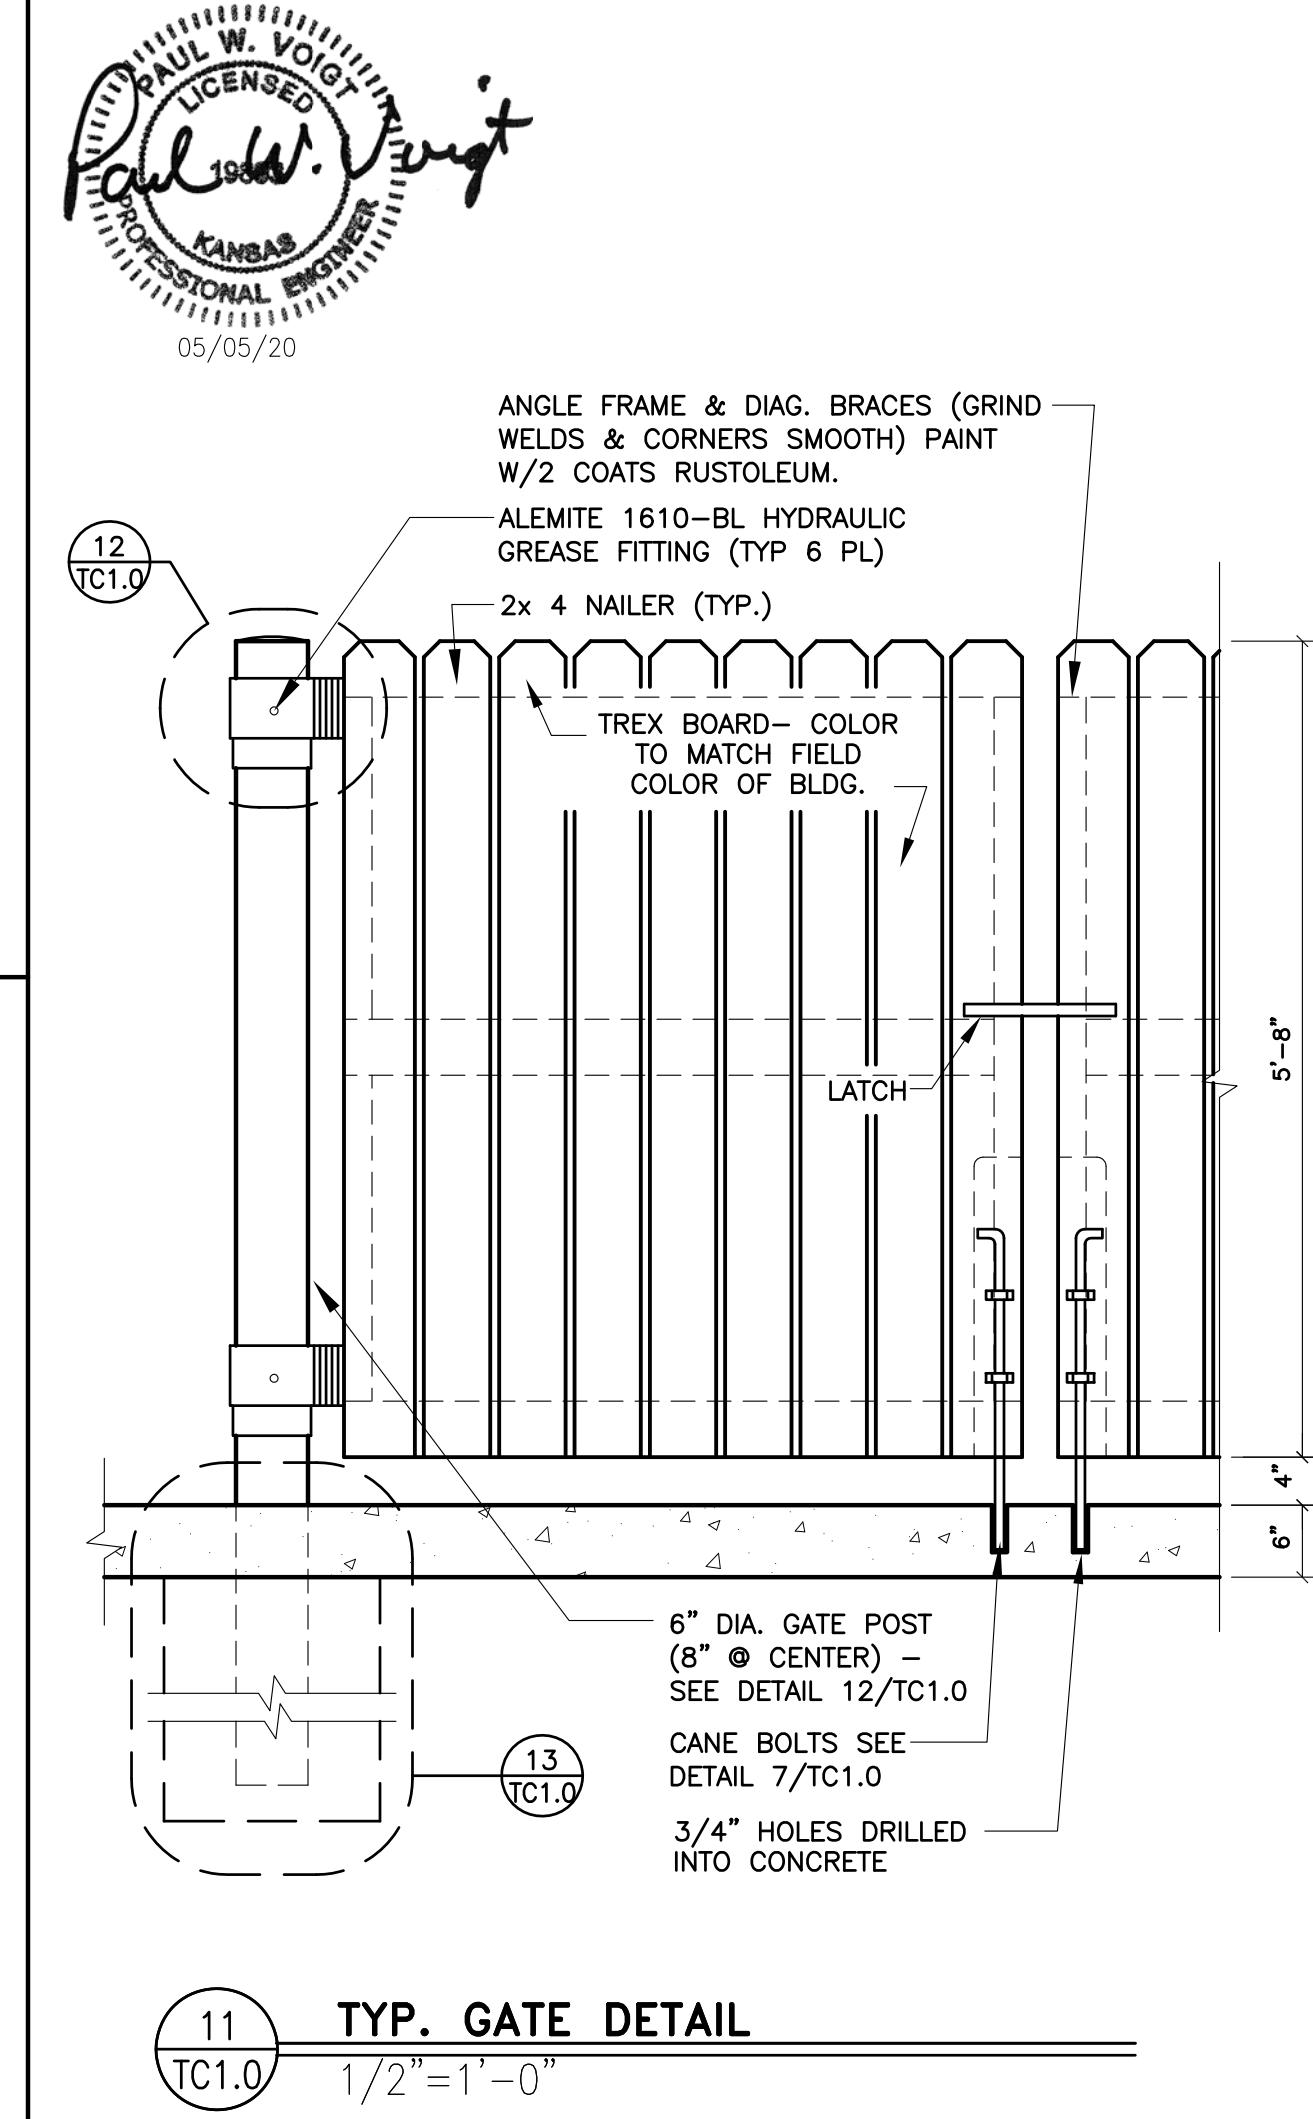

TYP. GATE DETAIL

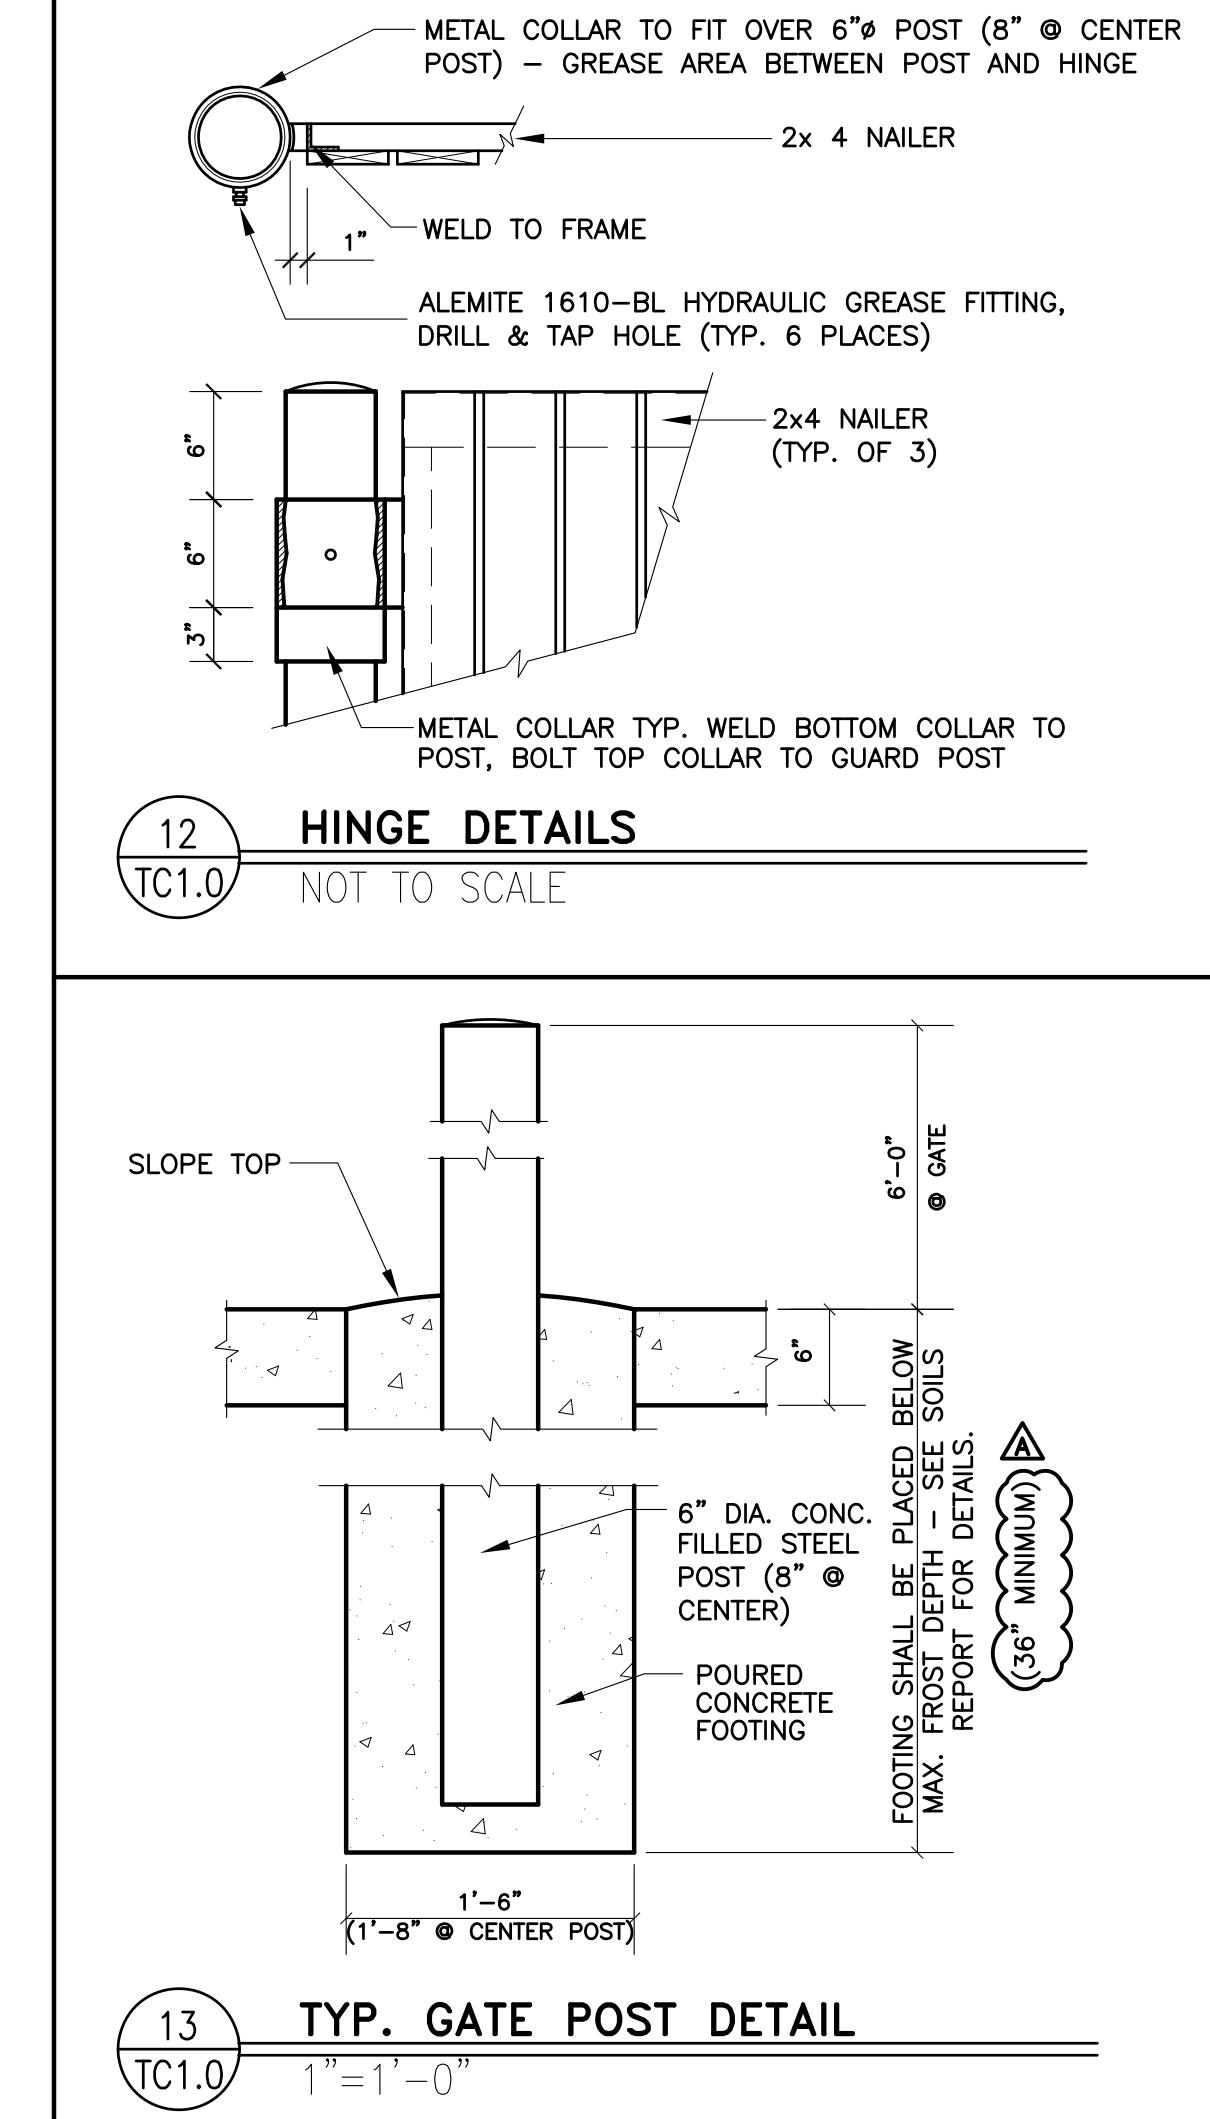

TYP. GATE POST DETAIL

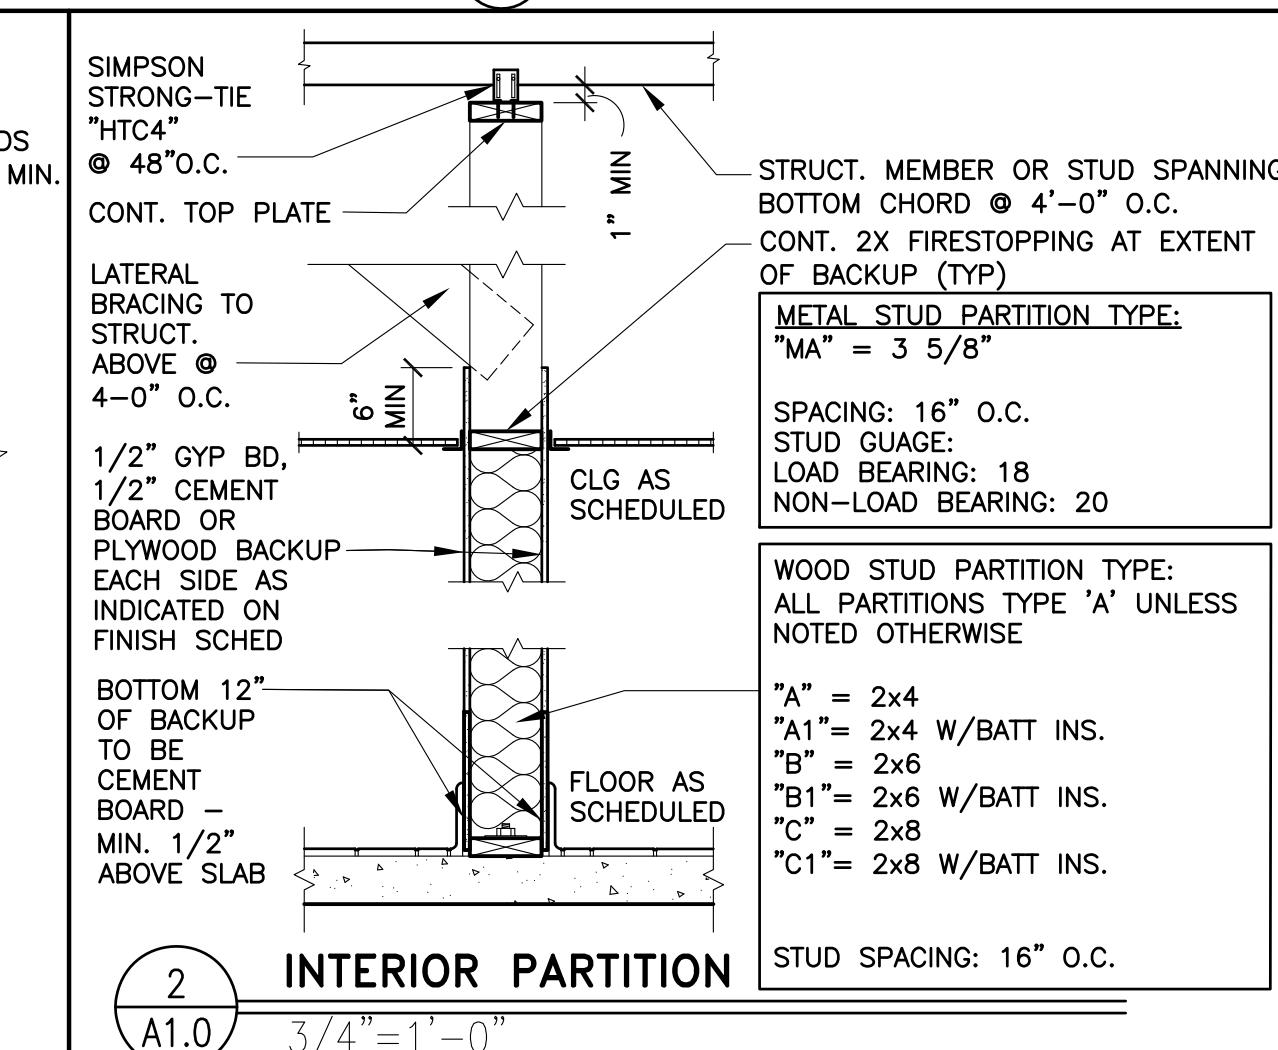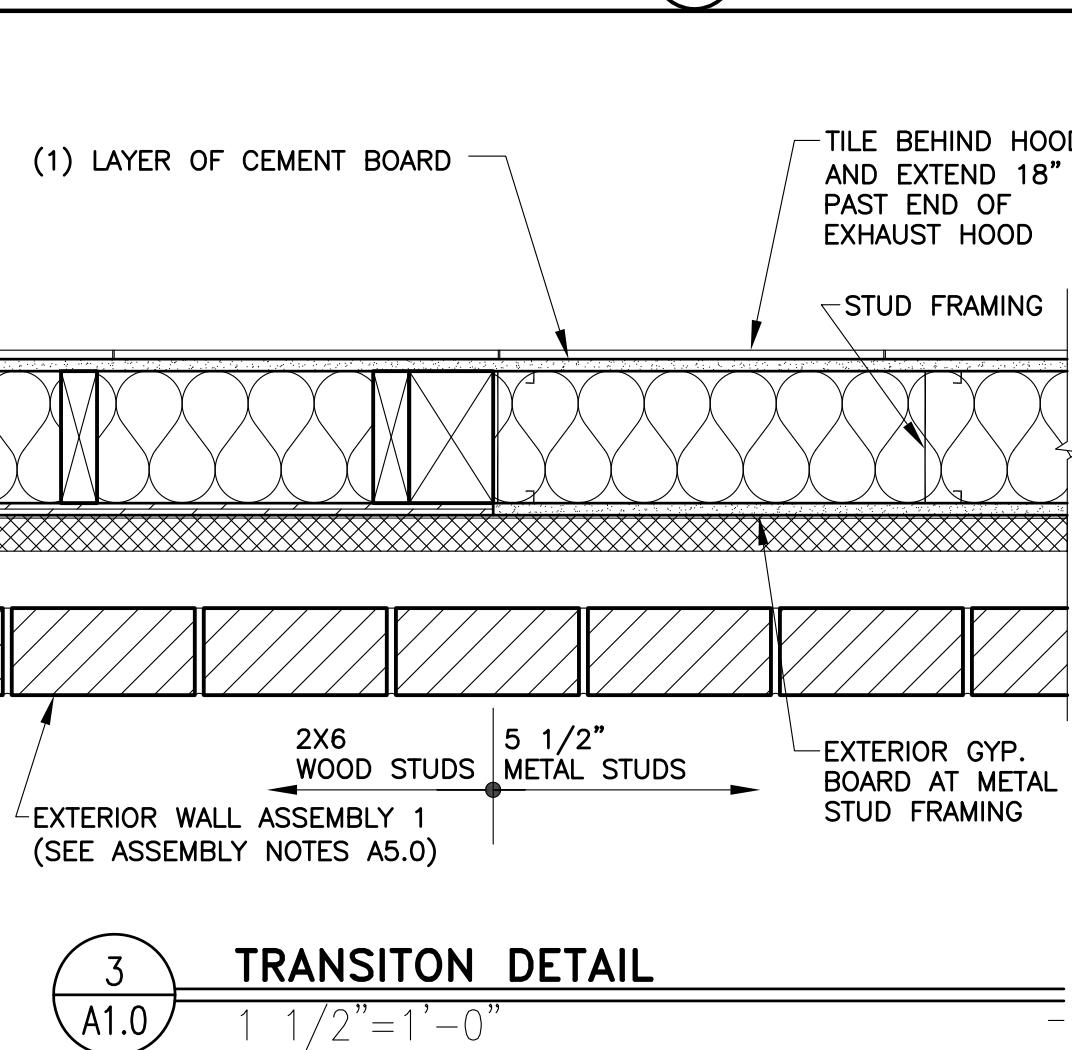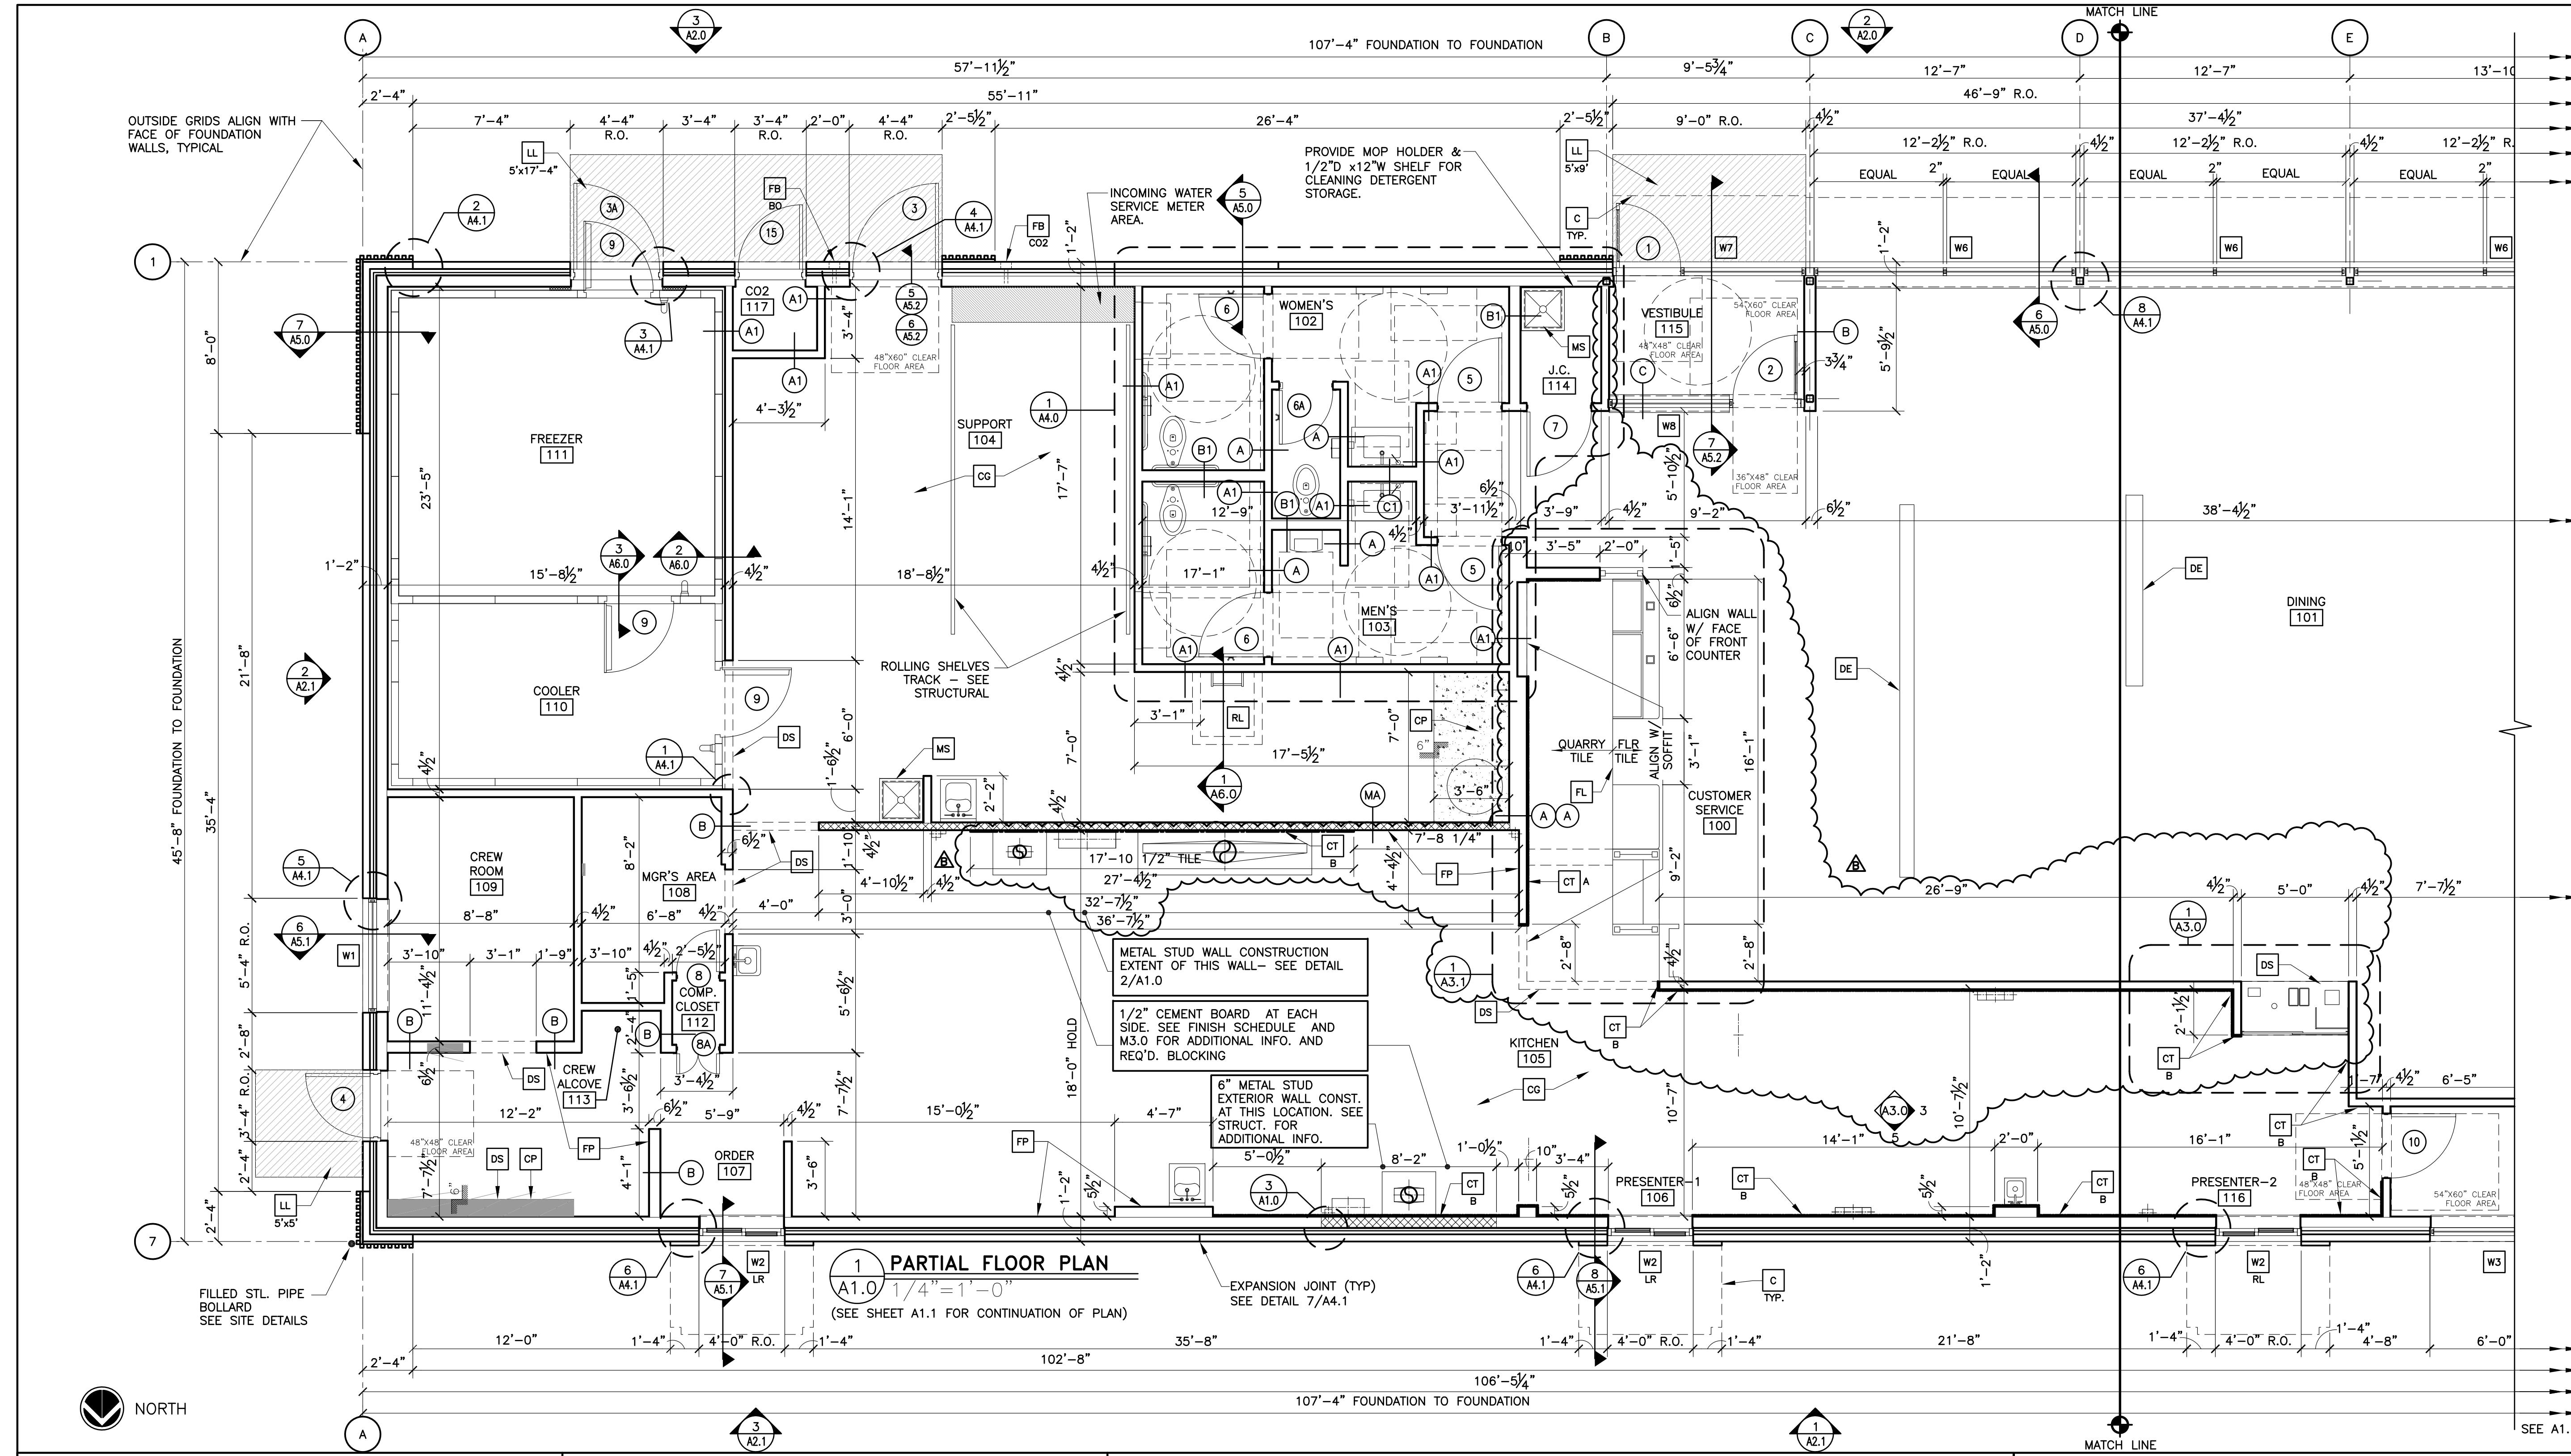

KEY NOTES

- C** ALUMINUM CANOPY SYSTEM ABOVE – SEE 4/A5.0 FOR NOTES – SEE ROOF PLAN FOR DIMENSIONS, SEE ELEVATION FOR COLORS AND FASCIA LOCATIONS
 - CG** G.C. TO PROVIDE 4"x4"x5'-0" HIGH STAINLESS STEEL CORNER GUARDS AT ALL EXPOSED LOCATIONS IN KITCHEN/SUPPORT AREA. CORNER GUARDS TO START AT FINISH FLOOR. ATTACH WITH WOOD SCREWS INTO WOOD BLOCKING BULLNOSE COVE BASE WHERE TILE MEETS STAINLESS STEEL CORNER – SEE DETAIL 4/A6.0
 - CP** CONCRETE EQMT PAD – SEE STRUCTURAL & DETAIL 5/A6.0
 - CT** WALL TILE: CERAMIC WALL TILE,
SIZE: 4"x12", PATTERN: STACK BOND,
A GROUT: MAPEI ULTRACOLOR PLUS – JOINT TO BE $\frac{1}{16}$ " MAX.
SEE DECOR DRAWINGS FOR TILE AND GROUT COLOR SPEC
 - CT** WALL TILE: CROSSVILLE – COLOR BY NUMBERS,
COLOR: INTUITIVE GRAY, SIZE: 4"x12", PATTERN: RUNNING BOND
B GROUT: MAPEI O2 PEWTER – JOINT TO BE $\frac{1}{16}$ " MAX.
USE THIS TILE WHEN HIGH LRV IS REQUIRED
COORDINATE WITH McDONALD'S AREA CONSTRUCTION MANAGER
 - DE** DECOR ELEMENT– VERIFY SIZE AND PLACEMENT WITH DECOR PLANS
 - DS** DROPPED SOFFIT ABOVE – SEE REFLECTED CEILING PLAN
 - FB** CO2 FILL BOX (EQUIPMENT SCHEDULE ITEM 49.00)
CO2
 - FB** OPTIONAL BULK OIL FILL BOX (EQPM SCHEDULE ITEM 700.18)
BO CONFIRM USE WITH McDONALD'S AREA CONSTRUCTION MANAGER


- FL** FLOOR LINE – CHANGE IN MATERIAL – SEE DECOR DRAWINGS
 - FP** FIBERGLASS REINFORCED PLASTIC (FRP) – PANOLAM,
GRAY SMOOTH, CLASS C, .075. REFER TO ROOM FINISH
SCHEDULE SHEET A6.1 FOR INSTALLATION LOCATIONS.
FOR ORDERING, CONTACT KIMBERLY LAWSON
Kimberly_Lawson@panolam.com 1-866-925-4377
 - LL** LEVEL LANDING @ EXT. DOOR W/ MAX. 2%
RUNNING/CROSS SLOPE AWAY FROM BUILDING
5'x5'
SIZE OF LANDING
 - MS** MOP SINK – SEE DETAIL 8/A6.1 AND PLUMBING DRAWINGS.
 - RL** ROOF ACCESS LADDER W/HATCH ABOVE SEE
STRUCTURAL FRAMING PLAN FOR LOCATING DIMENSIONS
 - Wx** EXTERIOR WINDOW ASSEMBLY – SEE A2.0,
A2.1 & 4/A5.0 FOR ADDITIONAL NOTES

SYMBOL LEGEND

- A** — PARTITION TYPE TAG SEE 2/A1.0 **7** DOOR TAG - SEE DOOR SCHEDULE ON
— — EXTENT OF WALL TILE **X** KEY NOTE

GENERAL NOTES

1. EXTERIOR DIMENSIONS ARE TO COLUMN REFERENCE LINES AND EXTERIOR FACE OF MASONRY UNLESS OTHERWISE NOTED. INTERIOR DIMENSIONS ARE TO FACE OF INTERIOR WALL BOARD
 2. SEE 4/A5.0 FOR EXTERIOR WALL ASSEMBLY TYPES. SEE 2/A1.0 FOR INTERIOR PARTITION TYPES. INTERIOR PARTITIONS ARE TYPE 'A' UNLESS NOTED OTHERWISE.
 3. SEE EXTERIOR ELEVATIONS FOR WINDOW TYPES
 4. SEE SHEET A6.0 FOR DOOR SCHEDULE AND SHEET A6.1 FOR ROOM FINISH SCHEDULES
 5. SEE SITE PLAN FOR SIDEWALKS, RAMPS, ETC.
 6. GC TO PROVIDE ADA SIGNAGE PACKAGE AND INSTALL SIGNS AT LOCATIONS AND POSITIONS INDICATED IN PACKAGE OR AS REQUIRED BY LOCAL CODES. SIGNAGE PACKAGE SUPPLIED BY: FORREST PERMA-SIGN 1-800-214-8765; 9292 1ST ST., BOX 588, NEW ROCHELLE, NY 10802; www.forrestpermesigns.com
 7. MAXIMUM OCCUPANCY SIGN TO BE POSTED PER LOCAL CODE. SIGN FURNISHED AND INSTALLED BY GENERAL CONTRACTOR.
 8. ALL HANDSINK LOCATIONS SHALL HAVE CEMENT BOARD BACKING 48" IN HEIGHT A.F.F.
 9. GC TO COORDINATE ALL REQUIRED BLOCKING FOR WALL HUNG EQUIPMENT, SHELVES, ETC. FOR PROPER INSTALLATION HEIGHTS.
 10. KNOX BOX TO BE INSTALLED BY GENERAL CONTRACTOR PER LOCAL CODE AS REQUIRED. MODEL AND LOCATION TO BE COORDINATED WITH FIRE MARSHALL.
 11. DASHED LINES @ DOORS, RESTROOMS, & FIXTURES REPRESENT CLEAR FLOOR MANEUVERING CLEARANCES AS REQUIRED BY THE ACCESSIBILITY CODE. CLEARANCES MUST BE MAINTAINED WITHOUT EXCEPTION. IF CONDITIONS PREVENT ANY CLEAR FLOOR SPACE FROM BEING MAINTAINED, CONTACT THE ARCHITECT FOR RESOLUTION.

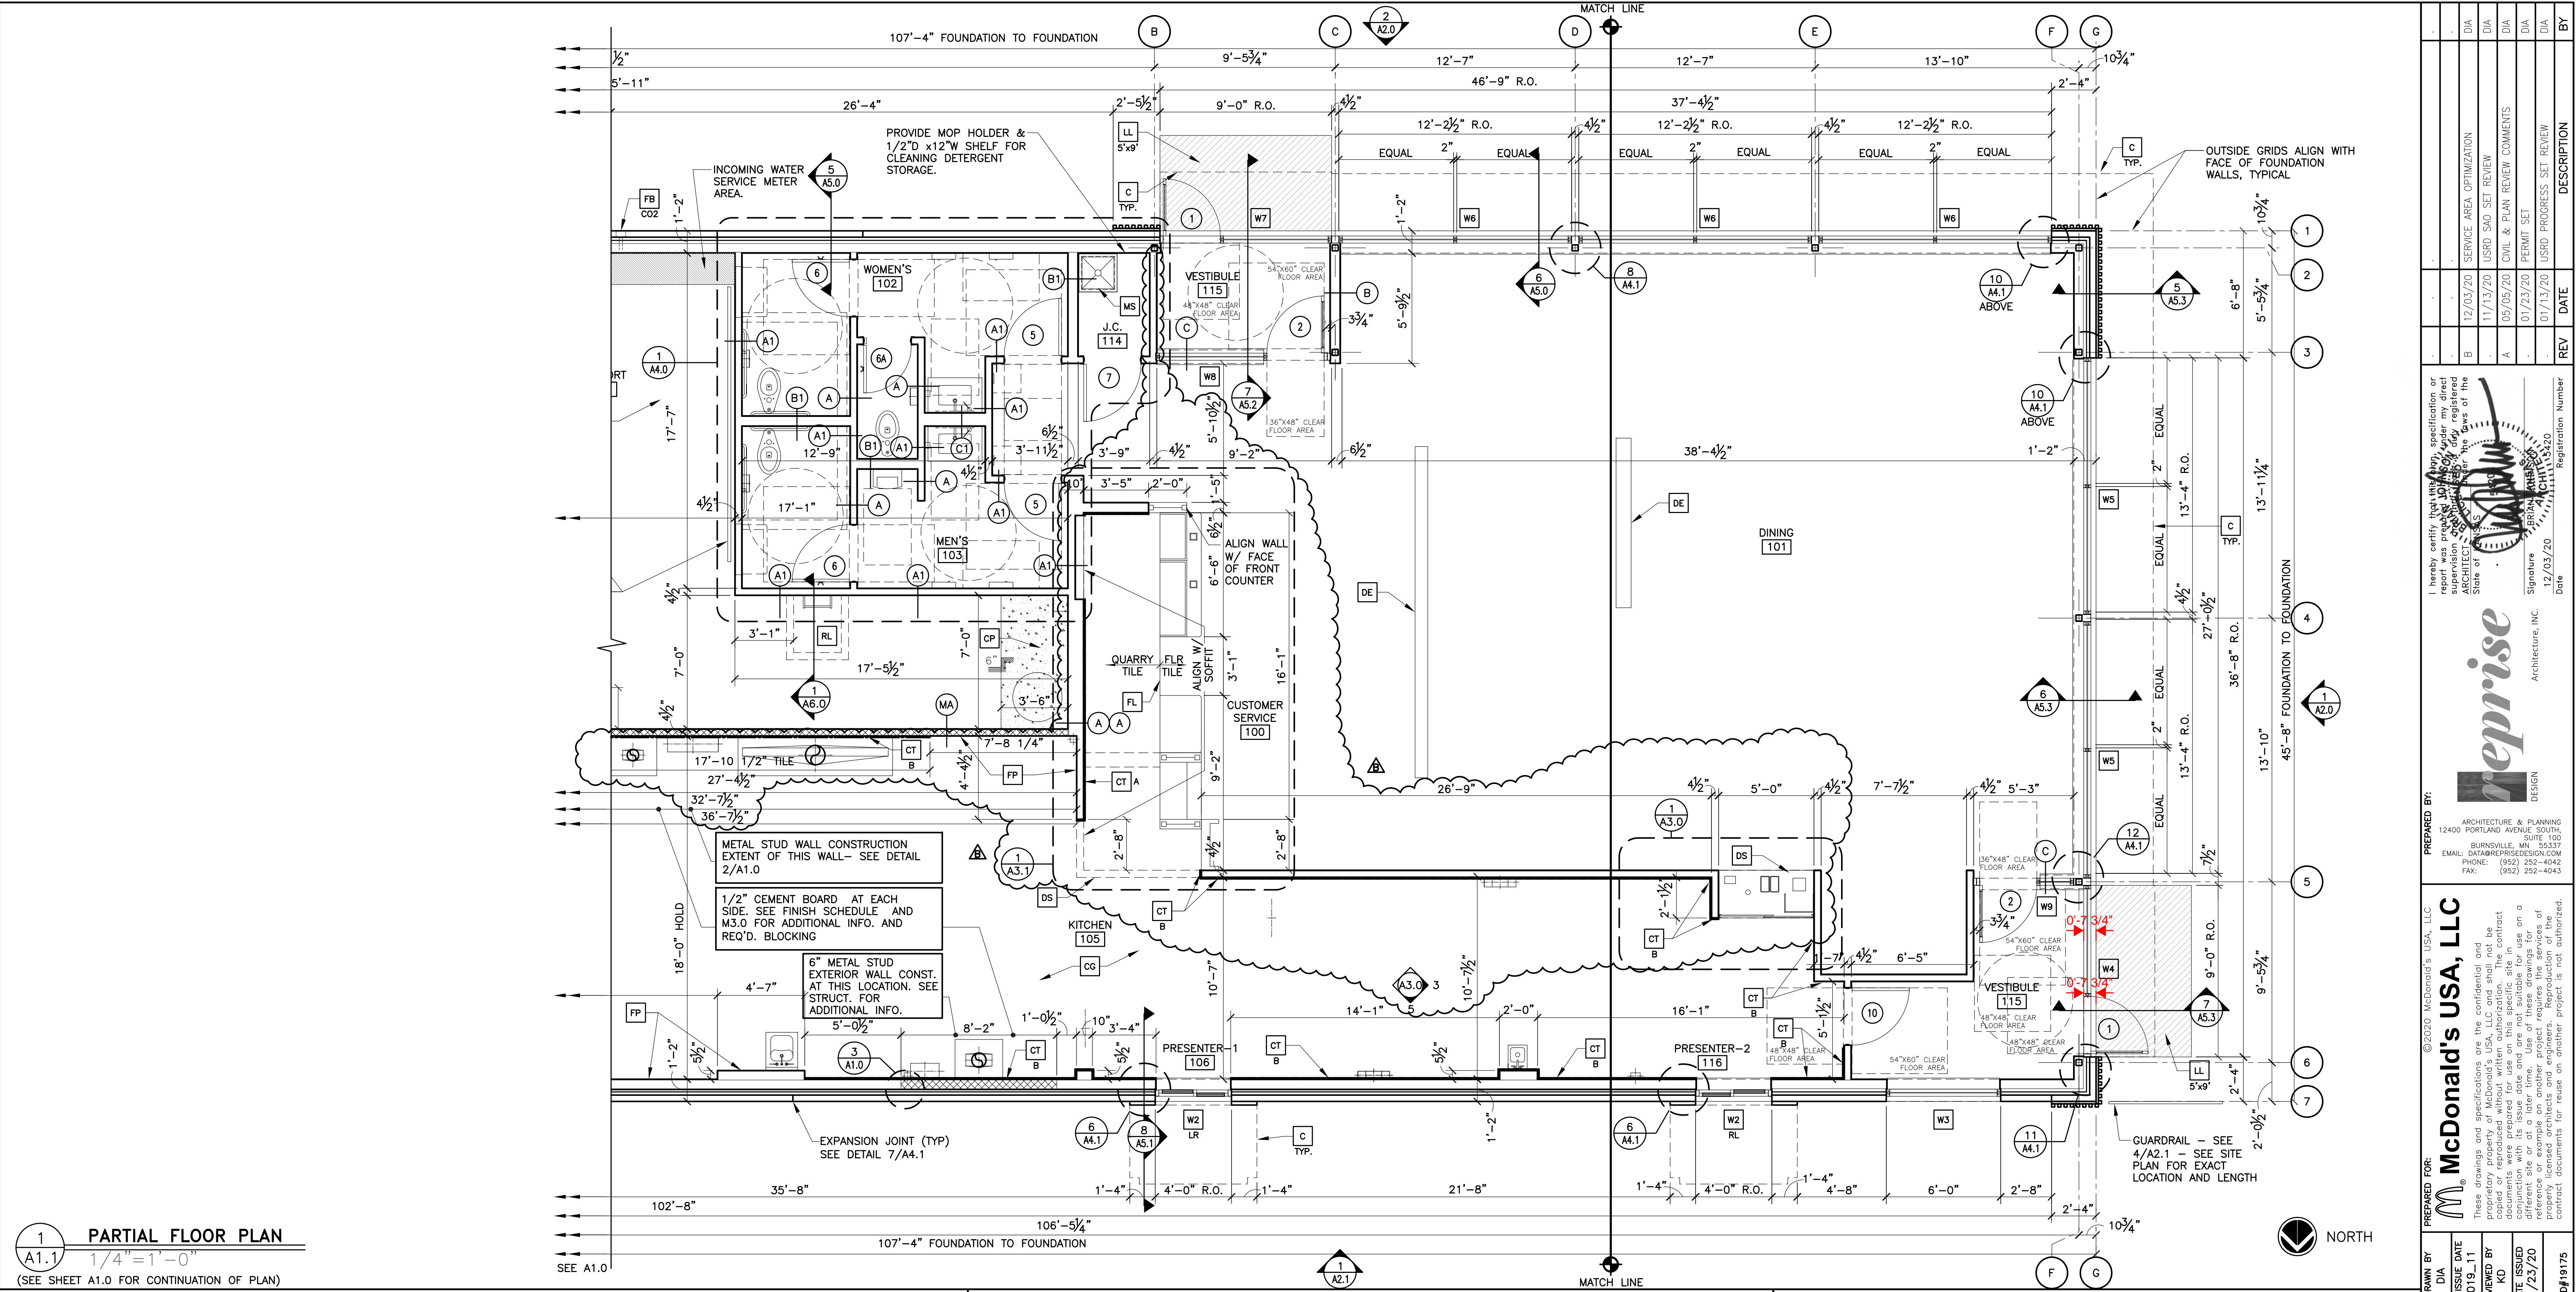

reprise
Architecture, INC.
DESIGN

Signature: *[Signature]*
Title: ARCHITECT
Date: 12/03/20
Registration Number: 55372
Date: 12/03/20

Design

Date:

12/03/20

By:

BY

11/15/20

CIVIL & PLAN REVIEW COMMENTS

DA

01/23/20

PERMIT SET

DA

01/13/20

USD PROGRESS SET REVIEW

DA

01/13/20

DESCRIPTION

REV

DATE

BY

12/03/20

DA

12/03/20

SERVICE AREA OPTIMIZATION

DA

11/15/20

USD SAO SET REVIEW

DA

05/05/20

CIVIL & PLAN REVIEW COMMENTS

DA

01/23/20

PERMIT SET

DA

01/13/20

USD PROGRESS SET REVIEW

DA

01/13/20

DESCRIPTION

REV


DATE

BY

12/03/20

DA

12/03/20

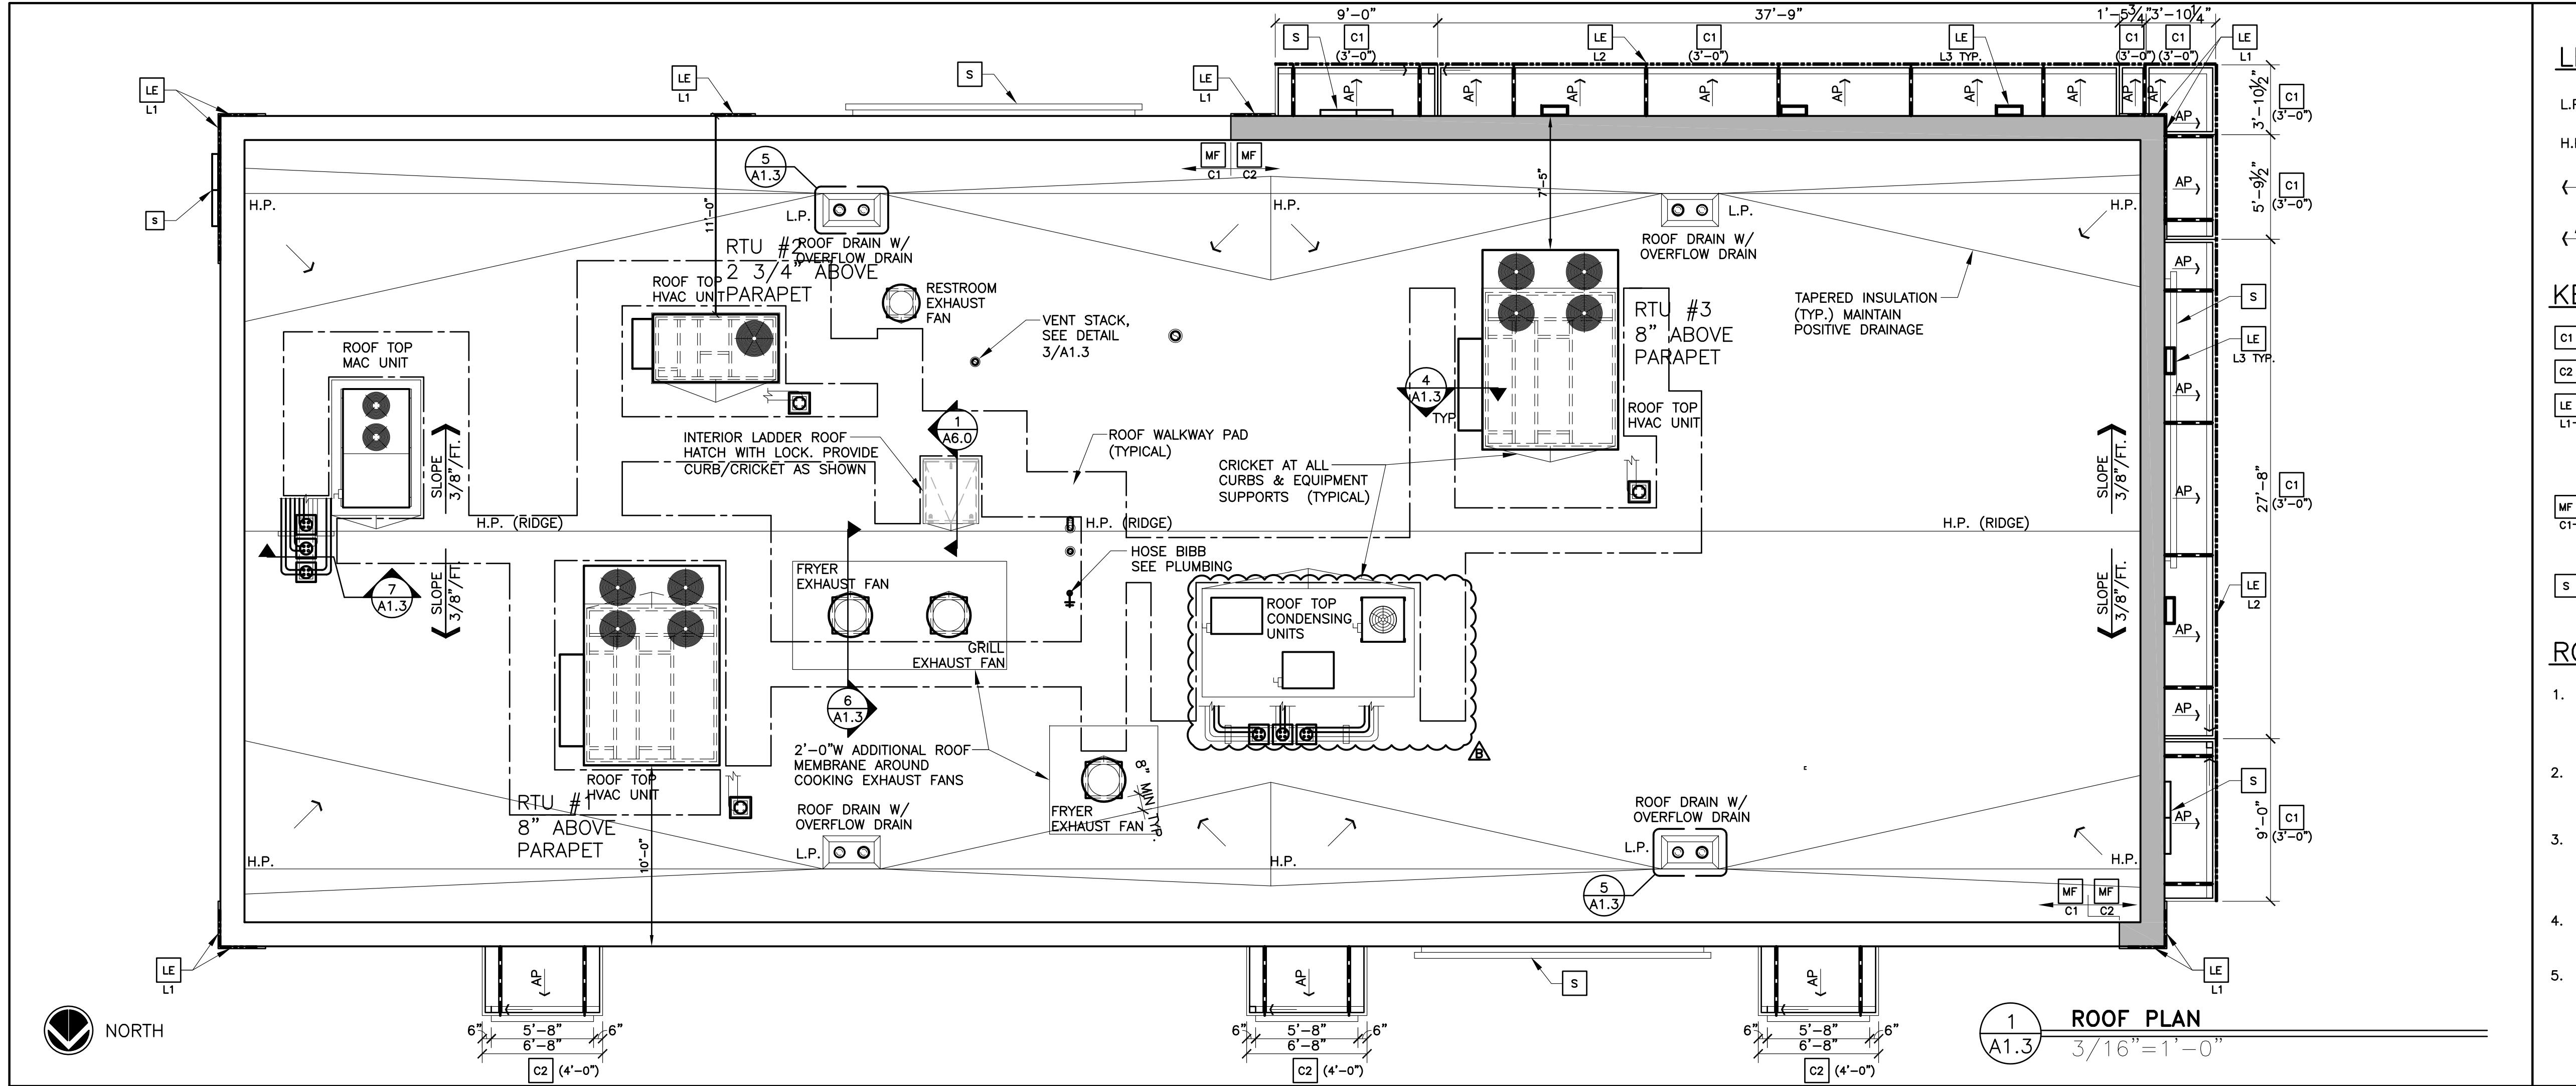

SHEET NO.	TITLE	REV	DATE	DESCRIPTION
	2019 STANDARD BUILDING - BB20	B	12/03/20	SERVICE AREA OPTIMIZATION
	459/F10-WOOD/WOOD	A	05/15/20	USFD SA SET REVIEW
			11/15/20	CIVIL & PLAN REVIEW COMMENTS
			01/23/20	PERMIT SET
			01/13/20	USD PROGRESS SET REVIEW
				BY

reprise
Architecture, Inc.
DESIGN

©2020 McDonald's USA, LLC
McDonald's USA, LLC

PREPARED BY:
ARCHITECTURE & PLANNING
12400 AVENUE SOUTH, SUITE 100
BURNSVILLE, MN 55337
EMAIL: DATAREPRISERED.COM
PHONE: (952) 252-4042
FAX: (952) 252-4943

PREPARED FOR:
McDonald's USA, LLC

NOTE: These drawings and specifications are the confidential and proprietary property of McDonald's USA, LLC and shall not be reproduced or distributed outside the contract documents without the express written consent of McDonald's USA, LLC. These drawings and specifications are prepared for use on this specific project and are not suitable for use on another project, reference or example. Any unauthorized use of these drawings and specifications is prohibited.

ROOFING SYSTEM

1. MANUFACTURERS AND PRODUCTS:
A REFER TO JOHNS MANVILLE WEBSITE (www.jm.com) FOR MOST UP-TO-DATE INFORMATION.
JM-TPO

NO SUBSTITUTIONS ALLOWED

2. SPECIFIED ROOFING SYSTEMS (AS SHOWN):
HEAT-WELDABLE SINGLE-PLY 60 MIL TPO ROOFING SYSTEM, INSTALLED OVER RIGID INSULATION ON WOOD ROOF DECK HAVING A SLOPE OF 3/8"/FT. MATERIALS SHALL BE AS FOLLOWS:
A. TPO ROOFING SYSTEM AS MANUFACTURED BY MANUFACTURER LISTED ABOVE TO COMPLY WITH ASTM E 108 OR UL 790, ASTM D-6878, AND FMG I-90 FOR WIND UPLIFT.
B. FASTENERS: METAL FASTENERS AND PLATES AS PER MANUFACTURER.
C. ACCESSORIES: PRE-FABRICATED CURBS, FLASHING, CORNERS, TERMINATION BARS, PIPE FLASHING, VENT FLASHING ETC. AS PER MANUFACTURER.
D. PLEASE SEE SINGLE PLY FLASHING SPECIFICATIONS FOR A FULL DESCRIPTION OF INSTALLATION INSTRUCTIONS AND REQUIREMENTS WHICH ARE CONSIDERED A PART OF THIS DETAIL.
E. ANY CARPENTRY OR METAL WORK SHOULD BE DESIGNED AND CONSTRUCTED IN ACCORDANCE WITH LOCAL CODE REQUIREMENTS AND/OR PROJECT SPECIFICATIONS. THESE COMPONENTS SHOULD BE REVIEWED AND APPROVED BY A LICENSED DESIGN PROFESSIONAL. CONTACT JM TECHNICAL FOR METAL OPTIONS TO BE INCLUDED WITHIN THE JM NDL GUARANTEE.
F. JM TPO EDGE SEALANT IS REQUIRED ON ALL CUT OR NON-ENCAPSULATED EDGES OF REINFORCED MEMBRANE. THIS INCLUDES FACTORY CUT REINFORCEMENT (SEE DETAIL T-MS-01).

3. WALKWAYS:
A. 30" WIDE WALKWAY ROLL, HOT AIR WELDED TO MEMBRANE.
B. PROVIDE WALKWAY FROM ROOF LADDER EXIT TO ALL ROOF TOP EQUIPMENT AS PER ROOF PLAN ABOVE.
C. INSTALL WALKWAY ACCORDING TO WALKWAY PAD MANUFACTURER'S WRITTEN INSTRUCTION.

4. RIGID INSULATION:
PROVIDE REQUIRED LAYERS OF POLYISOCYANURATE INSULATION W/ 1/2" "DENSEDECK" COVER BOARD TO MEET A MINIMUM CONTINUOUS R-30 VALUE - THICKNESS AS REQUIRED. PROVIDE POSITIVE SLOPE TO ALL ROOF DRAINS. SEE ROOF PLAN. PROVIDE TOP LAYER PROTECTION MATERIAL AS PER MANUFACTURER'S RECOMMENDATIONS. BOTTOM LAYER OF INSULATION TO HAVE INTEGRAL THERMAL BARRIER OR APPROVED ROOFING MANUFACTURER'S THERMAL UNDERLAYMENT SHEET. ASSEMBLY SHALL COMPLY WITH UL 1256 OR FMG 4450 AND ASTM C 1289, TYPE I OR II.

5. TAPERED INSULATION:
PROVIDE TAPERED INSULATION AS REQUIRED FOR POSITIVE DRAINAGE TO ROOF DRAINS AS INDICATED PER ROOF PLAN ABOVE. 1/4" PER FOOT MIN. REQUIRED.

6. EXHAUST FANS:
PROVIDE ADDITIONAL LAYER OF ROOF MEMBRANE AROUND EXHAUST FANS AS INDICATED PER ROOF PLAN ABOVE.

SEE PLUMBING DRAWINGS

3 TYPICAL VENT PENETRATION

4 HVAC UNIT ROOF CURB DETAIL



5 ROOF DRAIN DETAIL

6 DETAIL @ EXHAUST FAN

7 PIPE PORTAL DETAIL

8 SECTION @ ROOF DRAIN



DRAWN BY
DIA
STD ISSUE DATE
2019-11
REVIEWED BY
KID
DATE ISSUED
01/23/20
SITE ADDRESS
605 SOUTH 7TH STREET, KANSAS CITY, KS
SITE ID
015-0071
ITEM
015-0071.00.B
DESCRIPTION
WOOD BEARING WALLS W/ FIBER CEMENT SIDING & CI
WOOD ROOF TRUSS FRAMING
FIBER CEMENT PANEL/BATTEN/AUPOIC PANEL/BRICK EXT. FINISH
SECTION
A1.3
ROOF PLAN

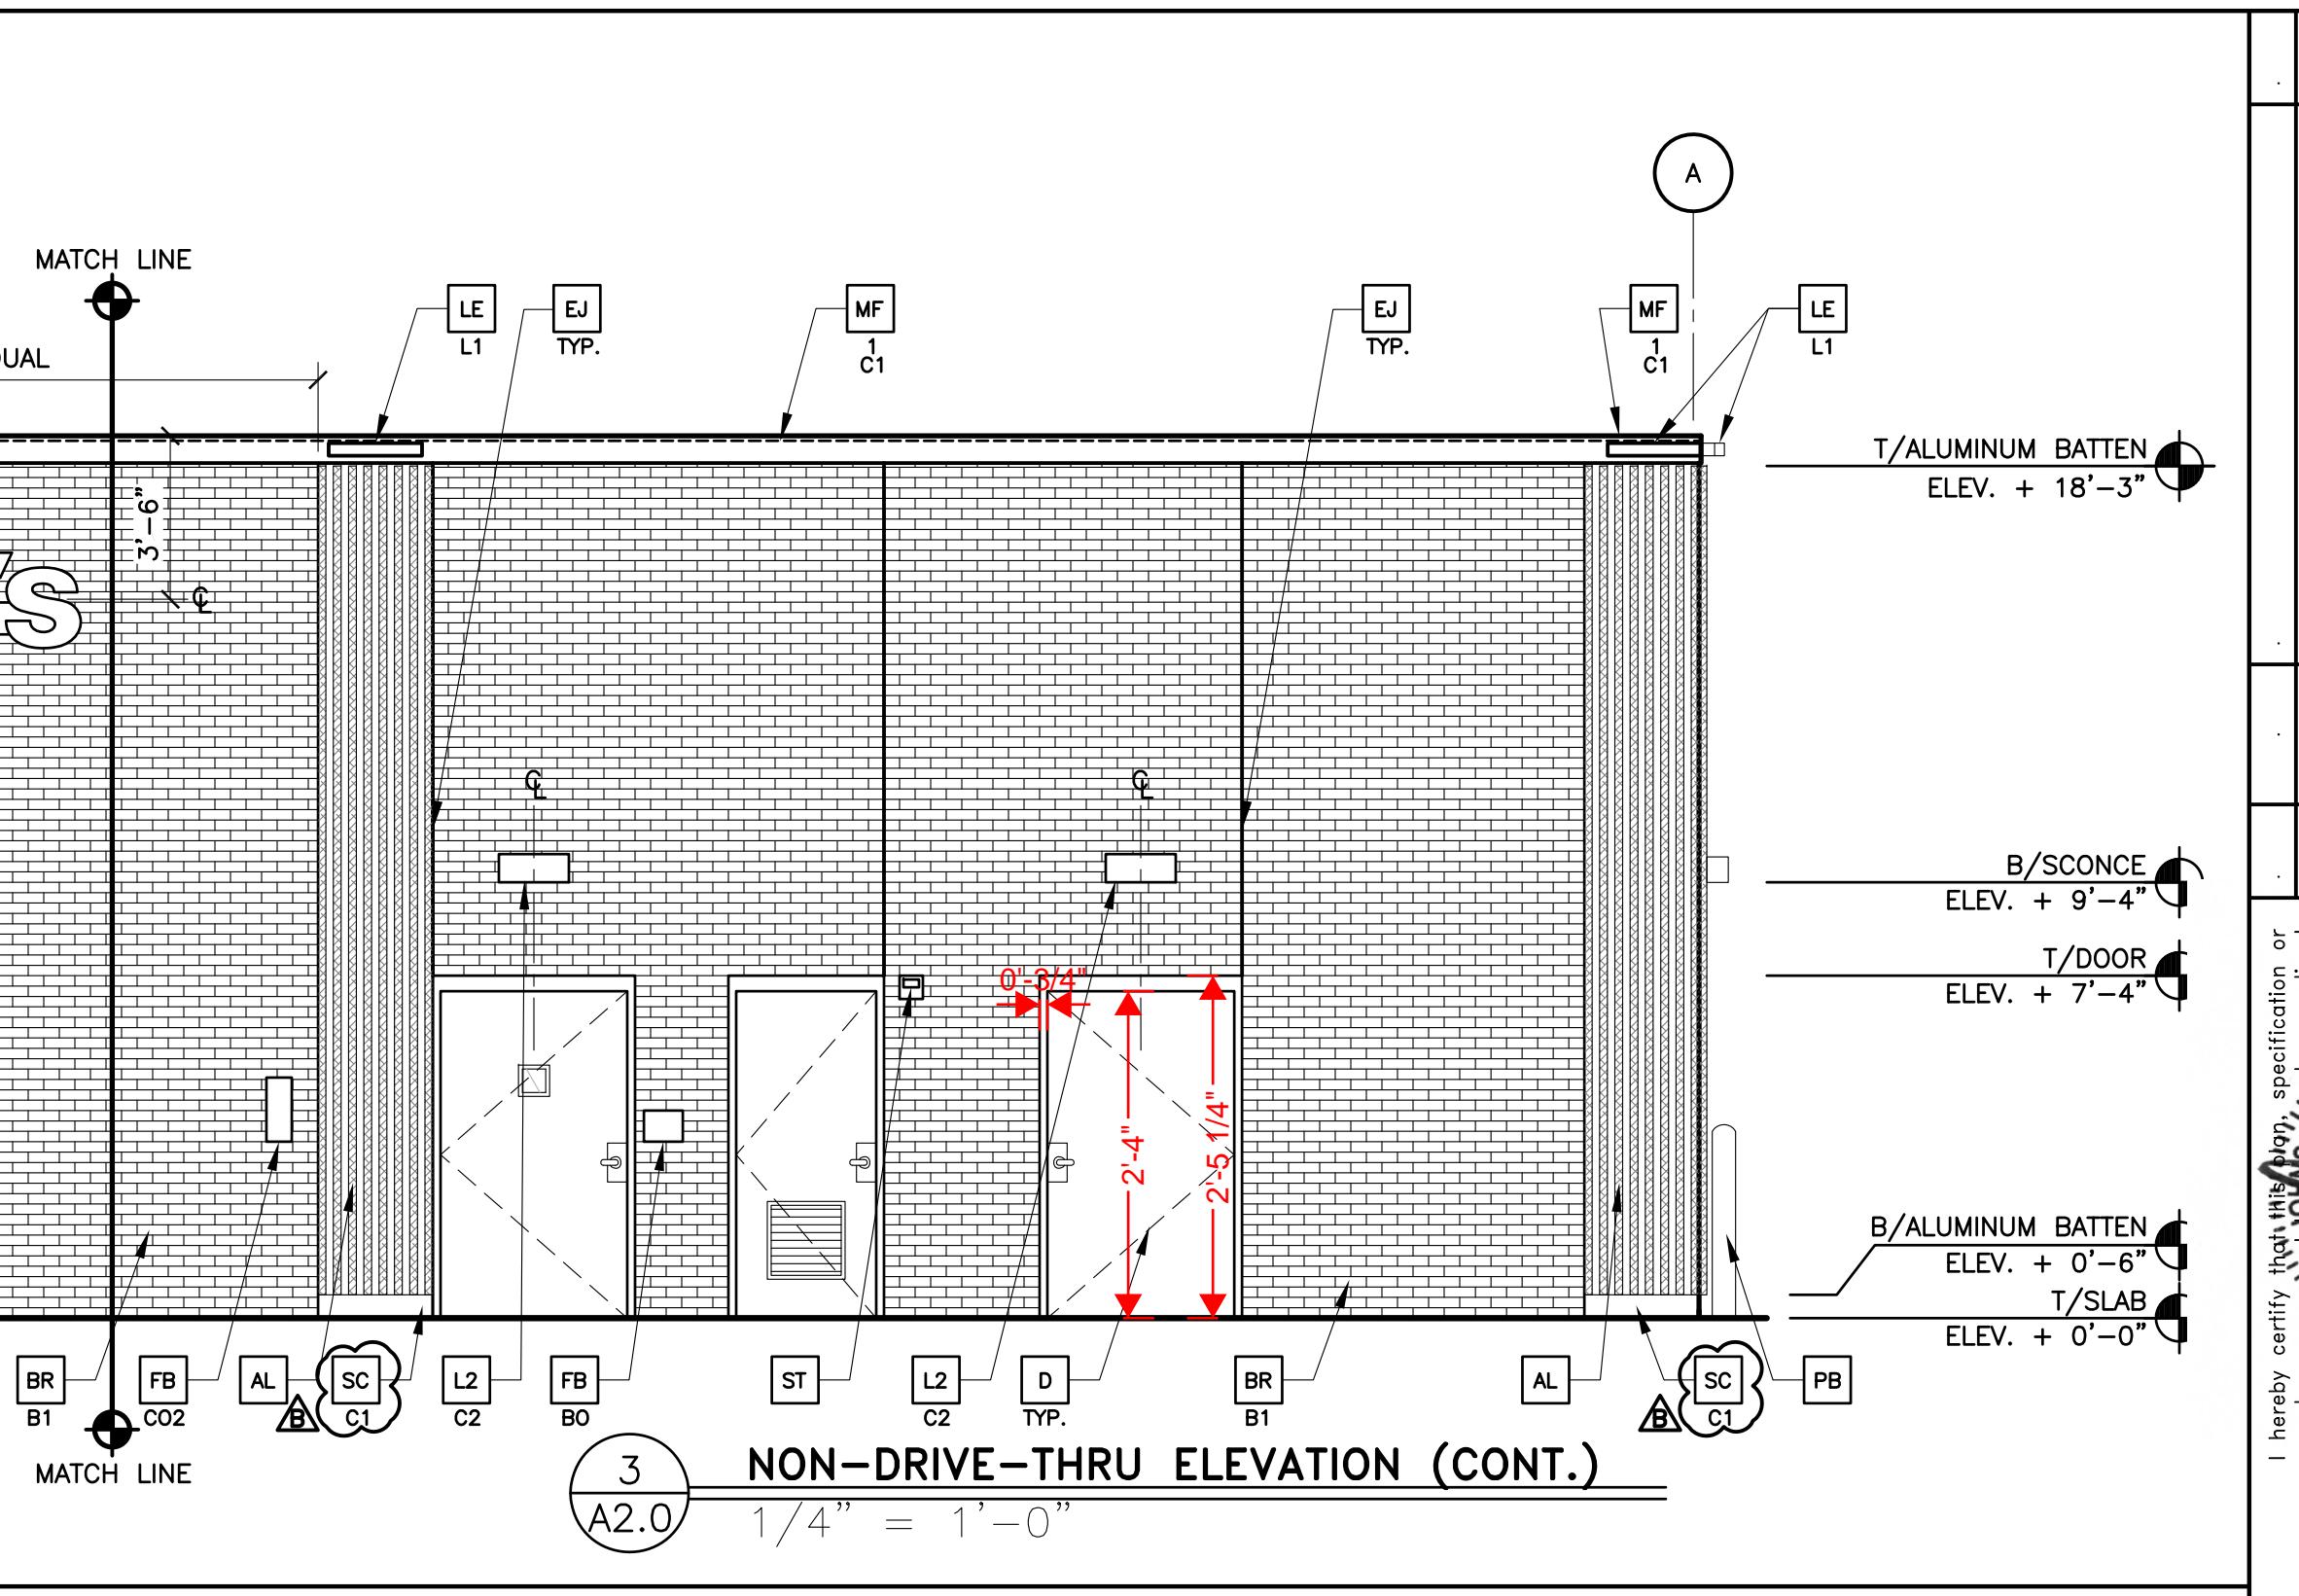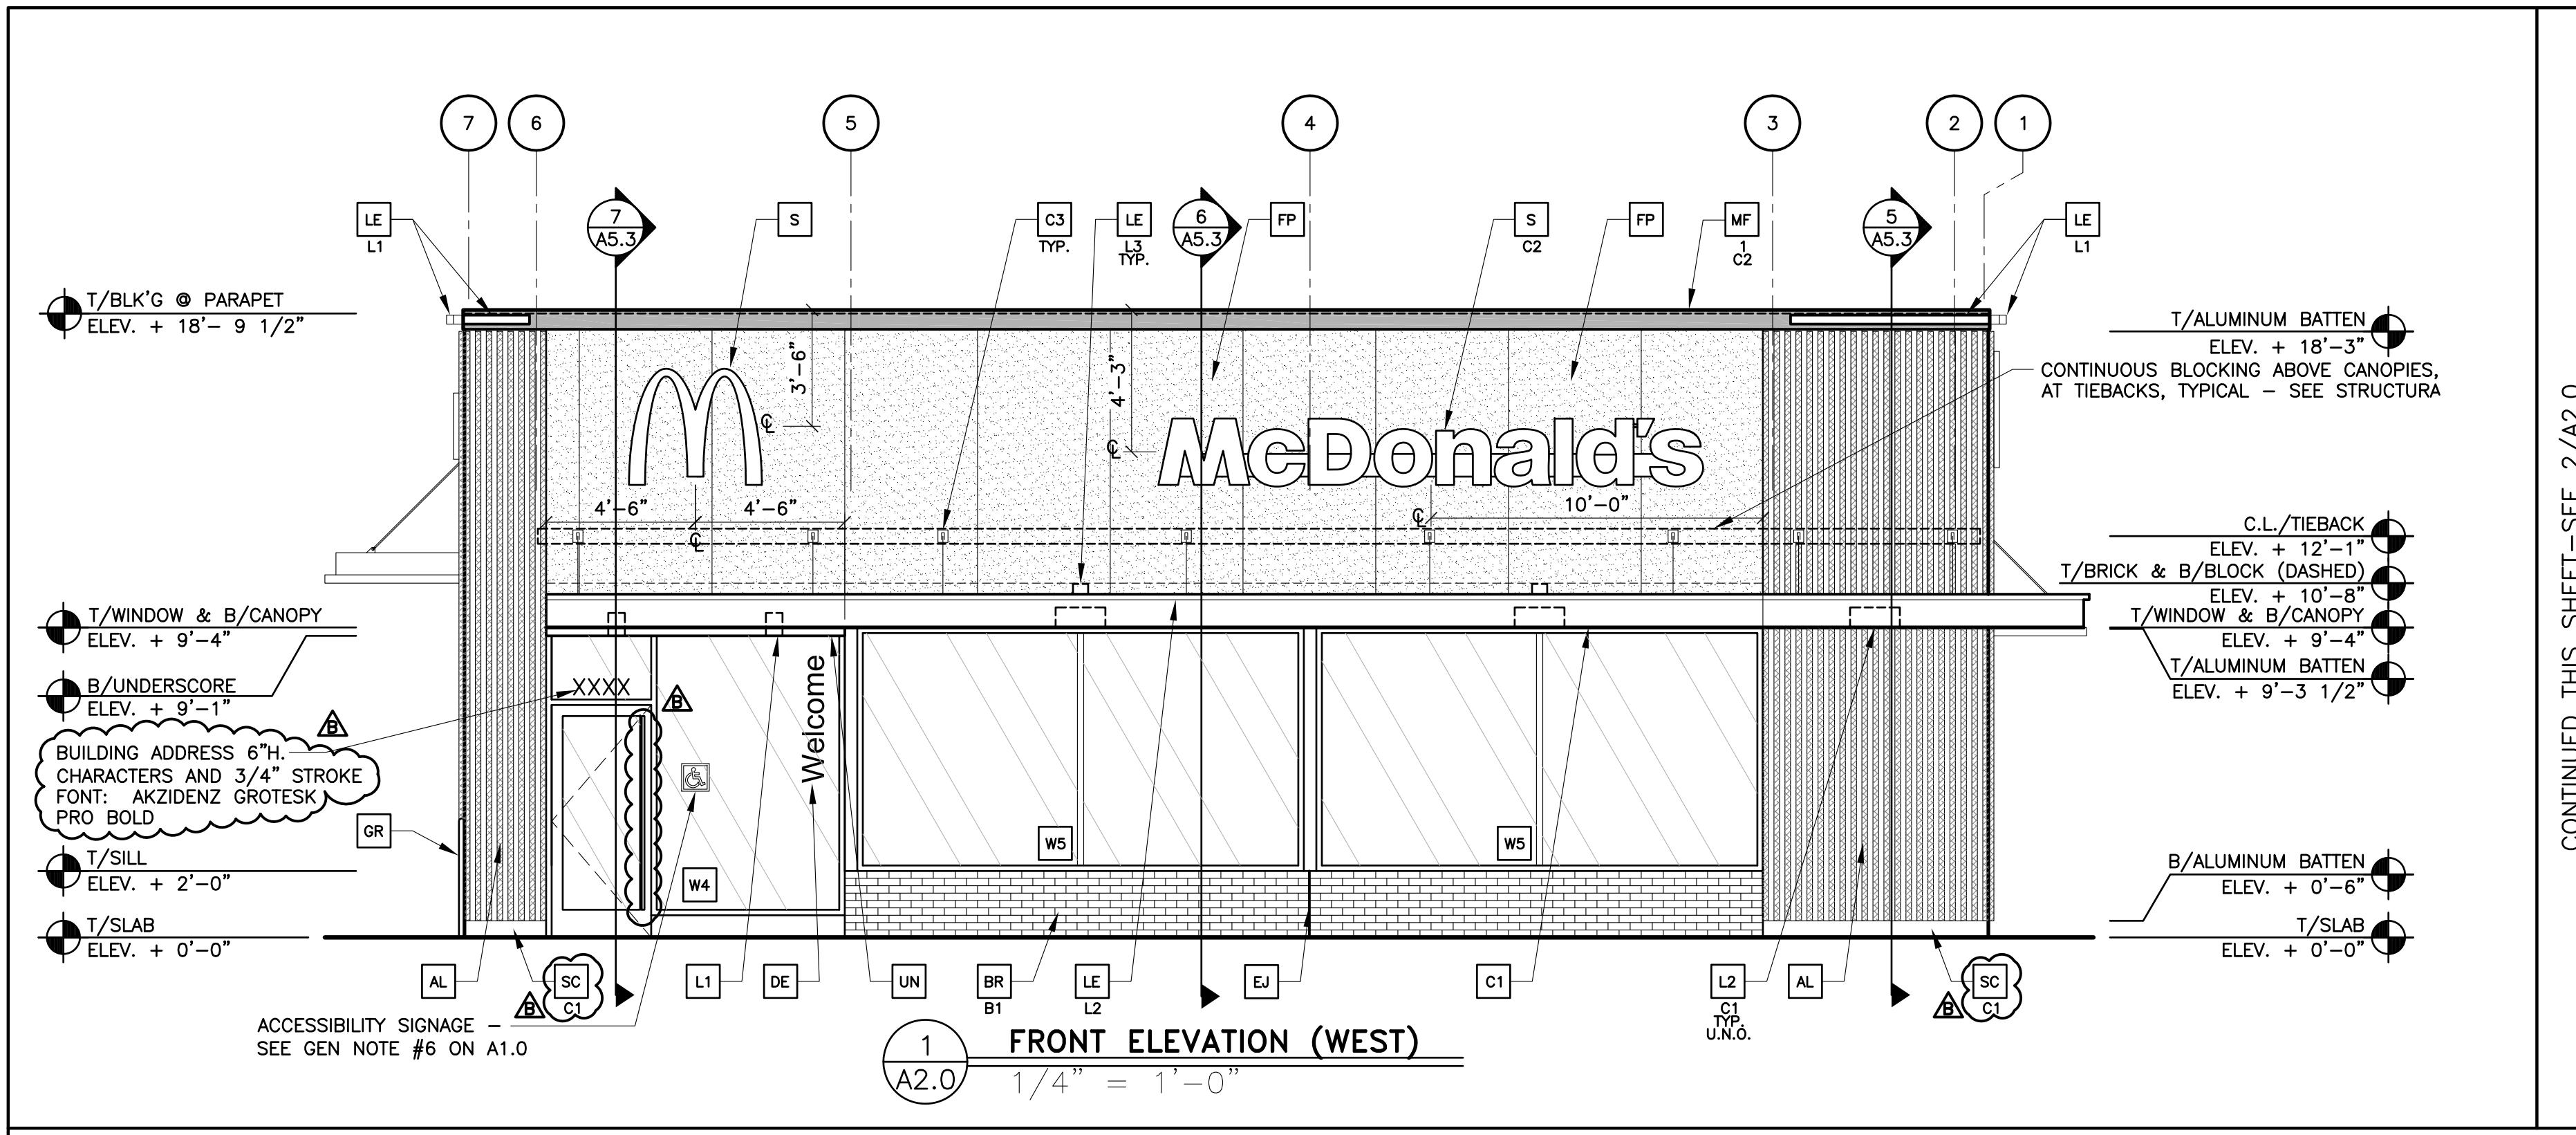

REVISION	DATE	DESCRIPTION
B	12/03/20	USED S&O SET REVIEW
A	05/05/20	CIVIL & PLAN REVIEW COMMENTS
	01/23/20	PERMIT SET
	01/13/20	USED PROGRESS SET REVIEW

Enterprise
Architecture, Inc.
DESIGN

Registration Number
Date

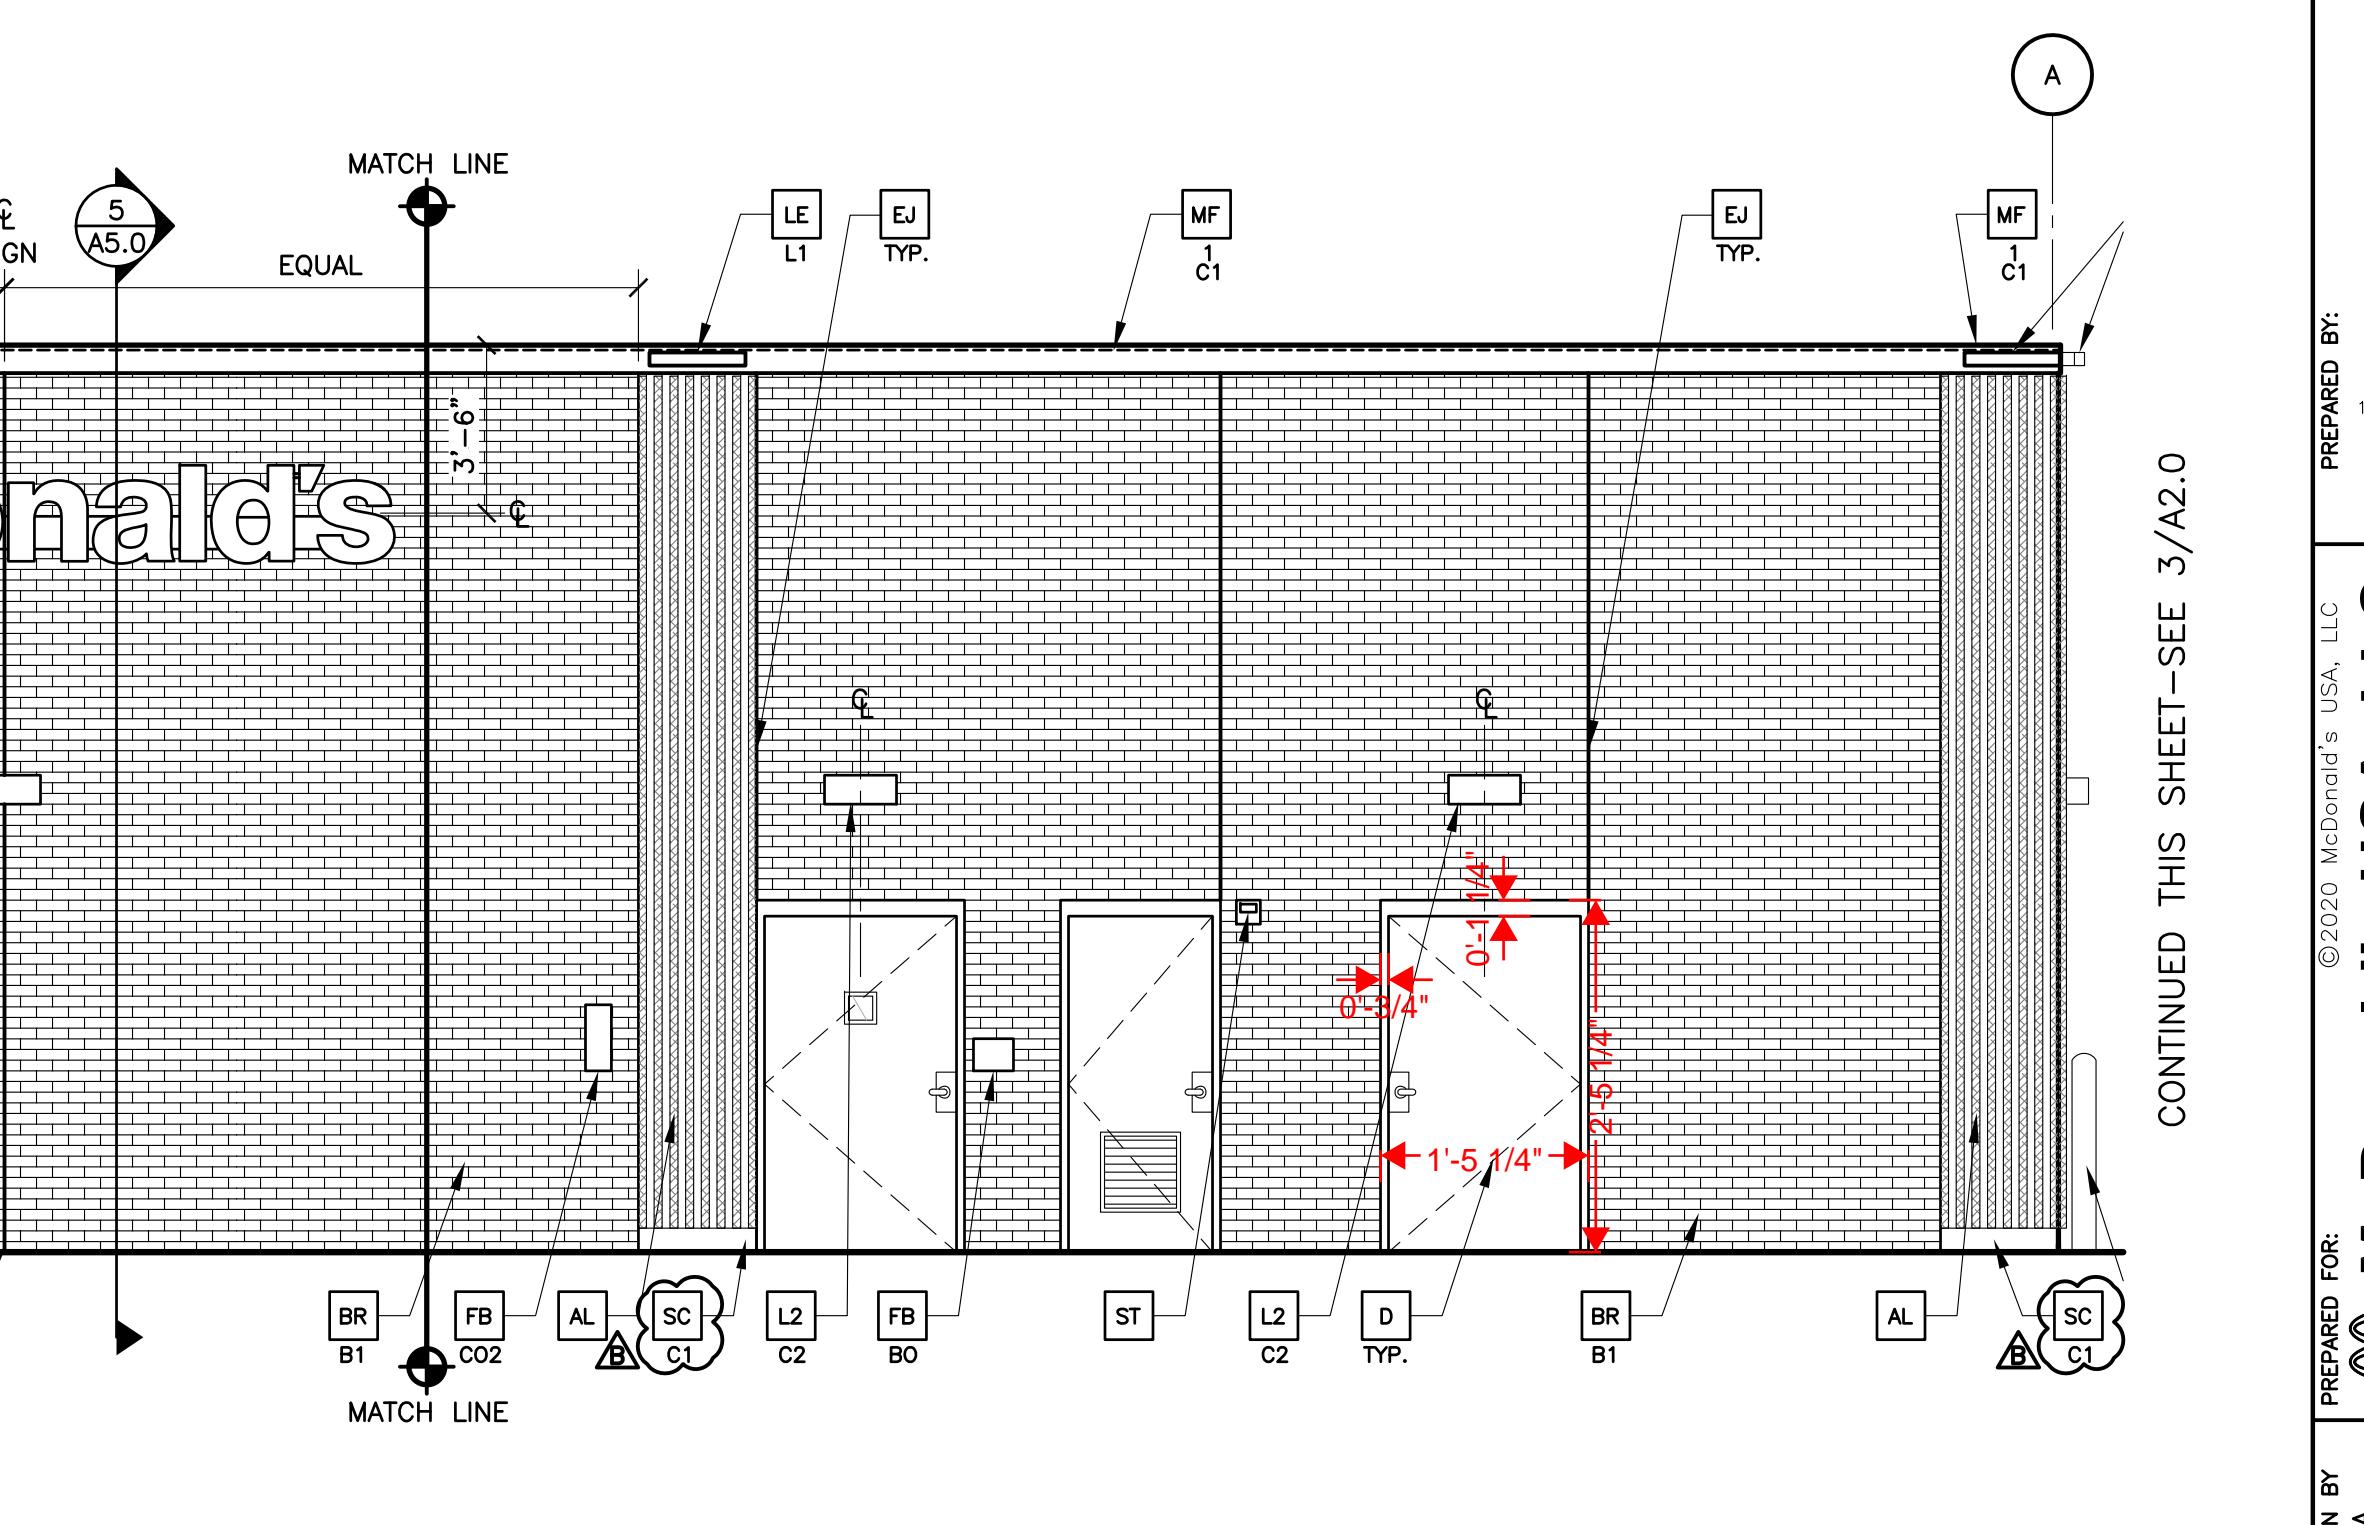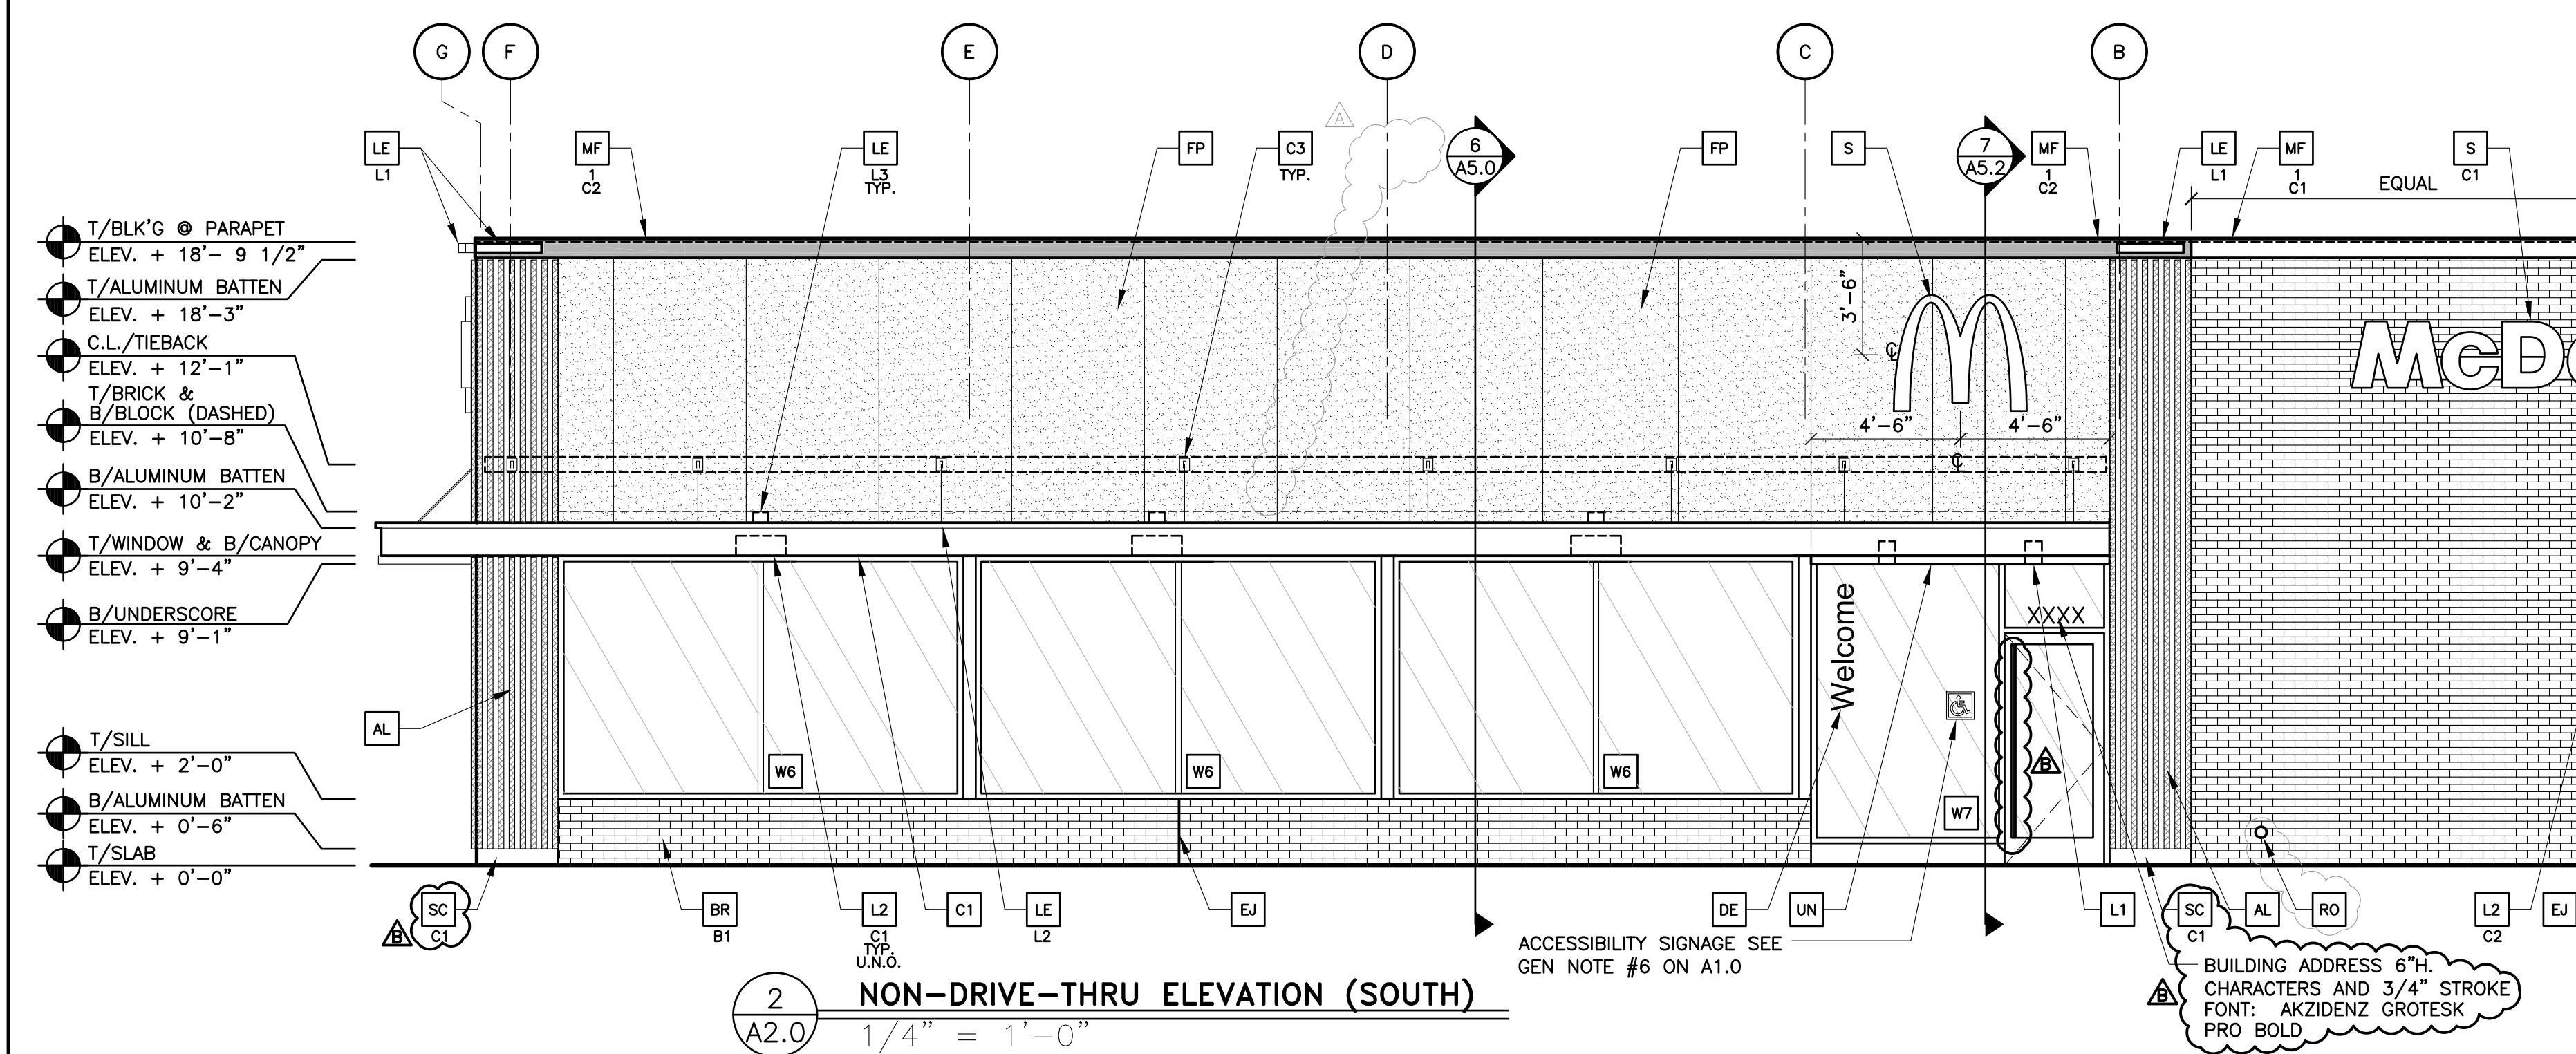


PREPARED BY:	McDonald's USA, LLC
12400 ARCHITECTURE & PLANNING 12400 PORTLAND AVENUE SOUTH, SUITE 100 BURNSVILLE, MN 55337 EMAIL: DATAREPRESENTER@GMAIL.COM PHONE: (952) 252-4042 FAX: (952) 252-4943	
These drawings and specifications are the confidential and proprietary of McDonald's USA, LLC and shall not be reproduced or distributed outside the contract documents without the express written consent of McDonald's USA, LLC. These drawings and specifications are prepared for use on this specific project only and are not suitable for use on a reference or example another project. Reproduction, services, or other unauthorized use of these drawings and documents for reuse on another project is not authorized.	
©2020 McDonald's USA, LLC	
PREPARED FOR:	



KEY NOTES:	DE	MF
[AL] ALUMINUM BATTEN SYSTEM COLOR: WOOD GRAIN BACKRAIL UNFINISHED, ENDCAP PAINTED TO MATCH SUBSTRATE SUBSTRATE: 1/2" EXTERIOR HIGH DENSITY OVERLAY (HDO) PLYWOOD, BB GROUP 1, HDO BOTH FACES APA TRADEMARKED COLOR: WOOD GRAIN BACKRAIL UNFINISHED, ENDCAP PAINTED TO MATCH SUBSTRATE COLOR: "IRON ORE" SW7069 BY SHERWIN WILLIAMS (SEE 16/A4.1 FOR ADDITIONAL INFORMATION)	[LE] DECAL BY GRAPHICS SUPPLIER SURFACE APPLIED, FIELD INSTALLED, PRE CUT, PRE SPACED. SUPPLIERS: VOMELA (865) 330-7337, ann.bowen@vormela.com GFX INTERNATIONAL (847) 543-4600, mcdonaldsdesign@gfx.com	METAL FASCIA C1= PRE-FAB ANCHOR-TIE FASCIA C2= NOT USED
[BR] MODULAR FACE BRICK BT-COLOR: BT = "SLATE GRAY" SMOOTH BY HEBRON BRICK COMPANY	[FB] FILL BOX C02 = C02 CO2 FILL BOX (EQPM SCHEDULE ITEM 49.00) BO = BULK OIL FILL BOX (EQPM SCHEDULE ITEM 700.18)	C1= WEATHERED ZINC C2= RAL 7022
[C1] ALUMINUM CANOPY SYSTEM W/FASCIA COLOR: WHITE	[FP] FIBER CEMENT PANELS: BY HARDEIPANEL VERTICAL SIDING, 48" WIDTH, H25, PRE-PRIMED, COLOR: "IRON ORE" SW 7069 BY SHERWIN WILLIAMS	ROOF DRAIN OVERFLOW PIPE PAINT TO MATCH SURROUNDING MATERIAL
[C2] ALUMINUM CANOPY SYSTEM COLOR: RAL 7022	[GR] GUARD RAIL -SEE SITE PLAN FOR EXACT LOCATION AND LENGTHSEE 4/A2.1 FOR DETAILS PAINT: "IRON ORE" SW 7069 BY SHERWIN WILLIAMS	S McDONALD'S SIGNAGE BY OTHERS - UNDER SEPARATE PERMIT. C1= WEATHERED ZINC RACEWAY C2= RAL 7022 RACEWAY
[C3] ALUMINUM CANOPY TIEBACK COLOR: RAL 7022 GC TO PROVIDE CONTINUOUS BLOCKING ON WALL BEHIND TIEBACKS, WHEN TIEBACKS ARE INSTALLED ON METAL PANELING. SEE DETAIL 3/A5.0	[L1] RECESSED DOWN LIGHT FIXTURE - SEE ELECTRICAL C1-COLOR: C1 = WHITE C2 = PLATINUM SILVER	[SC] STUCCO (@ BASE OF BATTEN SYSTEM) C1 = PAINT "IRON ORE" SW7069 BY SHERWIN WILLIAMS C2 = STROBE/ALARM. SEE MECHANICAL DRAWINGS FOR SPECIFICATION.
[D] HOLLOW METAL DOOR PAINT: "GAUNTLET GREY" SW7019 BY SHERWIN WILLIAMS	[L2] RADIAL SCONCE LIGHT FIXTURE - SEE ELECTRICAL C1-COLOR: C1 = WHITE	[ST] METAL UNDERSCORE COLOR: GOLD
[EJ] EXPANSION JOINT, SEE DETAIL 7/A4.1	[L3] LED LIGHT: L1 = SLIM LED (DOWN ONLY) L2 = INTEGRAL CANOPY FIXTURE L3 = UP ONLY FLOOD FIXTURE	[UN] METAL UNDERSCORE COLOR: GOLD
	[LE] ACCENT LIGHTING - SEE ELECTRICAL L1-LED LIGHT: L1 = SLIM LED (DOWN ONLY) L2 = INTEGRAL CANOPY FIXTURE L3 = UP ONLY FLOOD FIXTURE	[W1] EXTERIOR WINDOW ASSEMBLY - TEMPERED GLASS COLOR: DARK BRONZE - SEE ASSEMBLY NOTES ON 4/A5.0 & FRAME TYPES ON SHEET A6.0 WOOD BEARING WALLS W/FIBER CEMENT FRAMING WOOD ROOF TRUSS, 36" SERVICE HEIGHT WITH XX TRANSOM, MANUAL OPEN; ELECTRONIC RELEASE COLOR: DEEP BRONZE SLIDE DIRECTION: RL = RIGHT TO LEFT LR = LEFT TO RIGHT
	[PB] PIPE BOLLARD - PAINTED YELLOW	[W2] DRIVE-THRU WINDOW BY READY ACCESS MODEL: 600 SERIES, 36" SERVICE HEIGHT WITH XX TRANSOM, MANUAL OPEN; ELECTRONIC RELEASE COLOR: DEEP BRONZE SLIDE DIRECTION: RL = RIGHT TO LEFT LR = LEFT TO RIGHT
	[PT] (RMHC) COIN COLLECTOR UNIT: APERTURE WPT, #DTA2013 CALL 1-877-766-7642 TO ORDER	

SHEET NO.	TITLE	DIA	STD ISSUE DATE	REVIEWED BY	DATE ISSUED	SLIDE DIRECTION:
015-0071.00.B	2019 STANDARD BUILDING - BB20 4597F10-WOOD/WOOD	KO	2019-11	KO	01/29/20	RL = RIGHT TO LEFT LR = LEFT TO RIGHT
A2.0	ELEVATIONS					

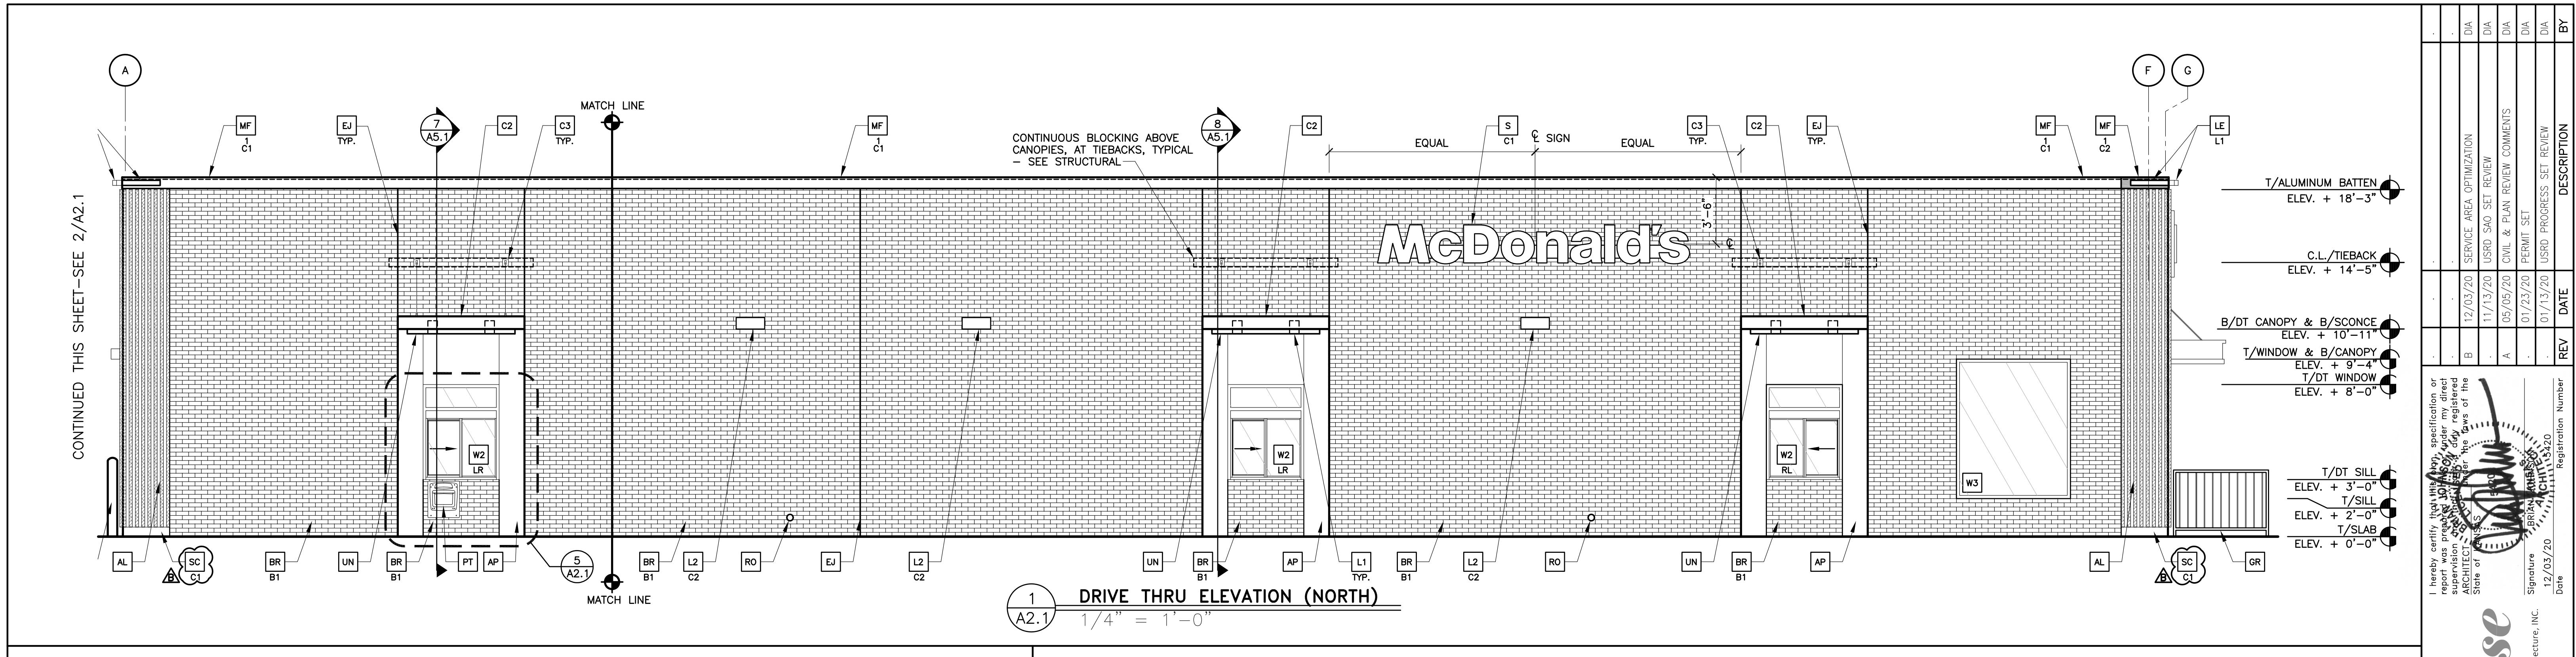

Architect, INC.

DESIGN




reprise

Signature

ARCHITECTURE, INC.


Date


Registration Number

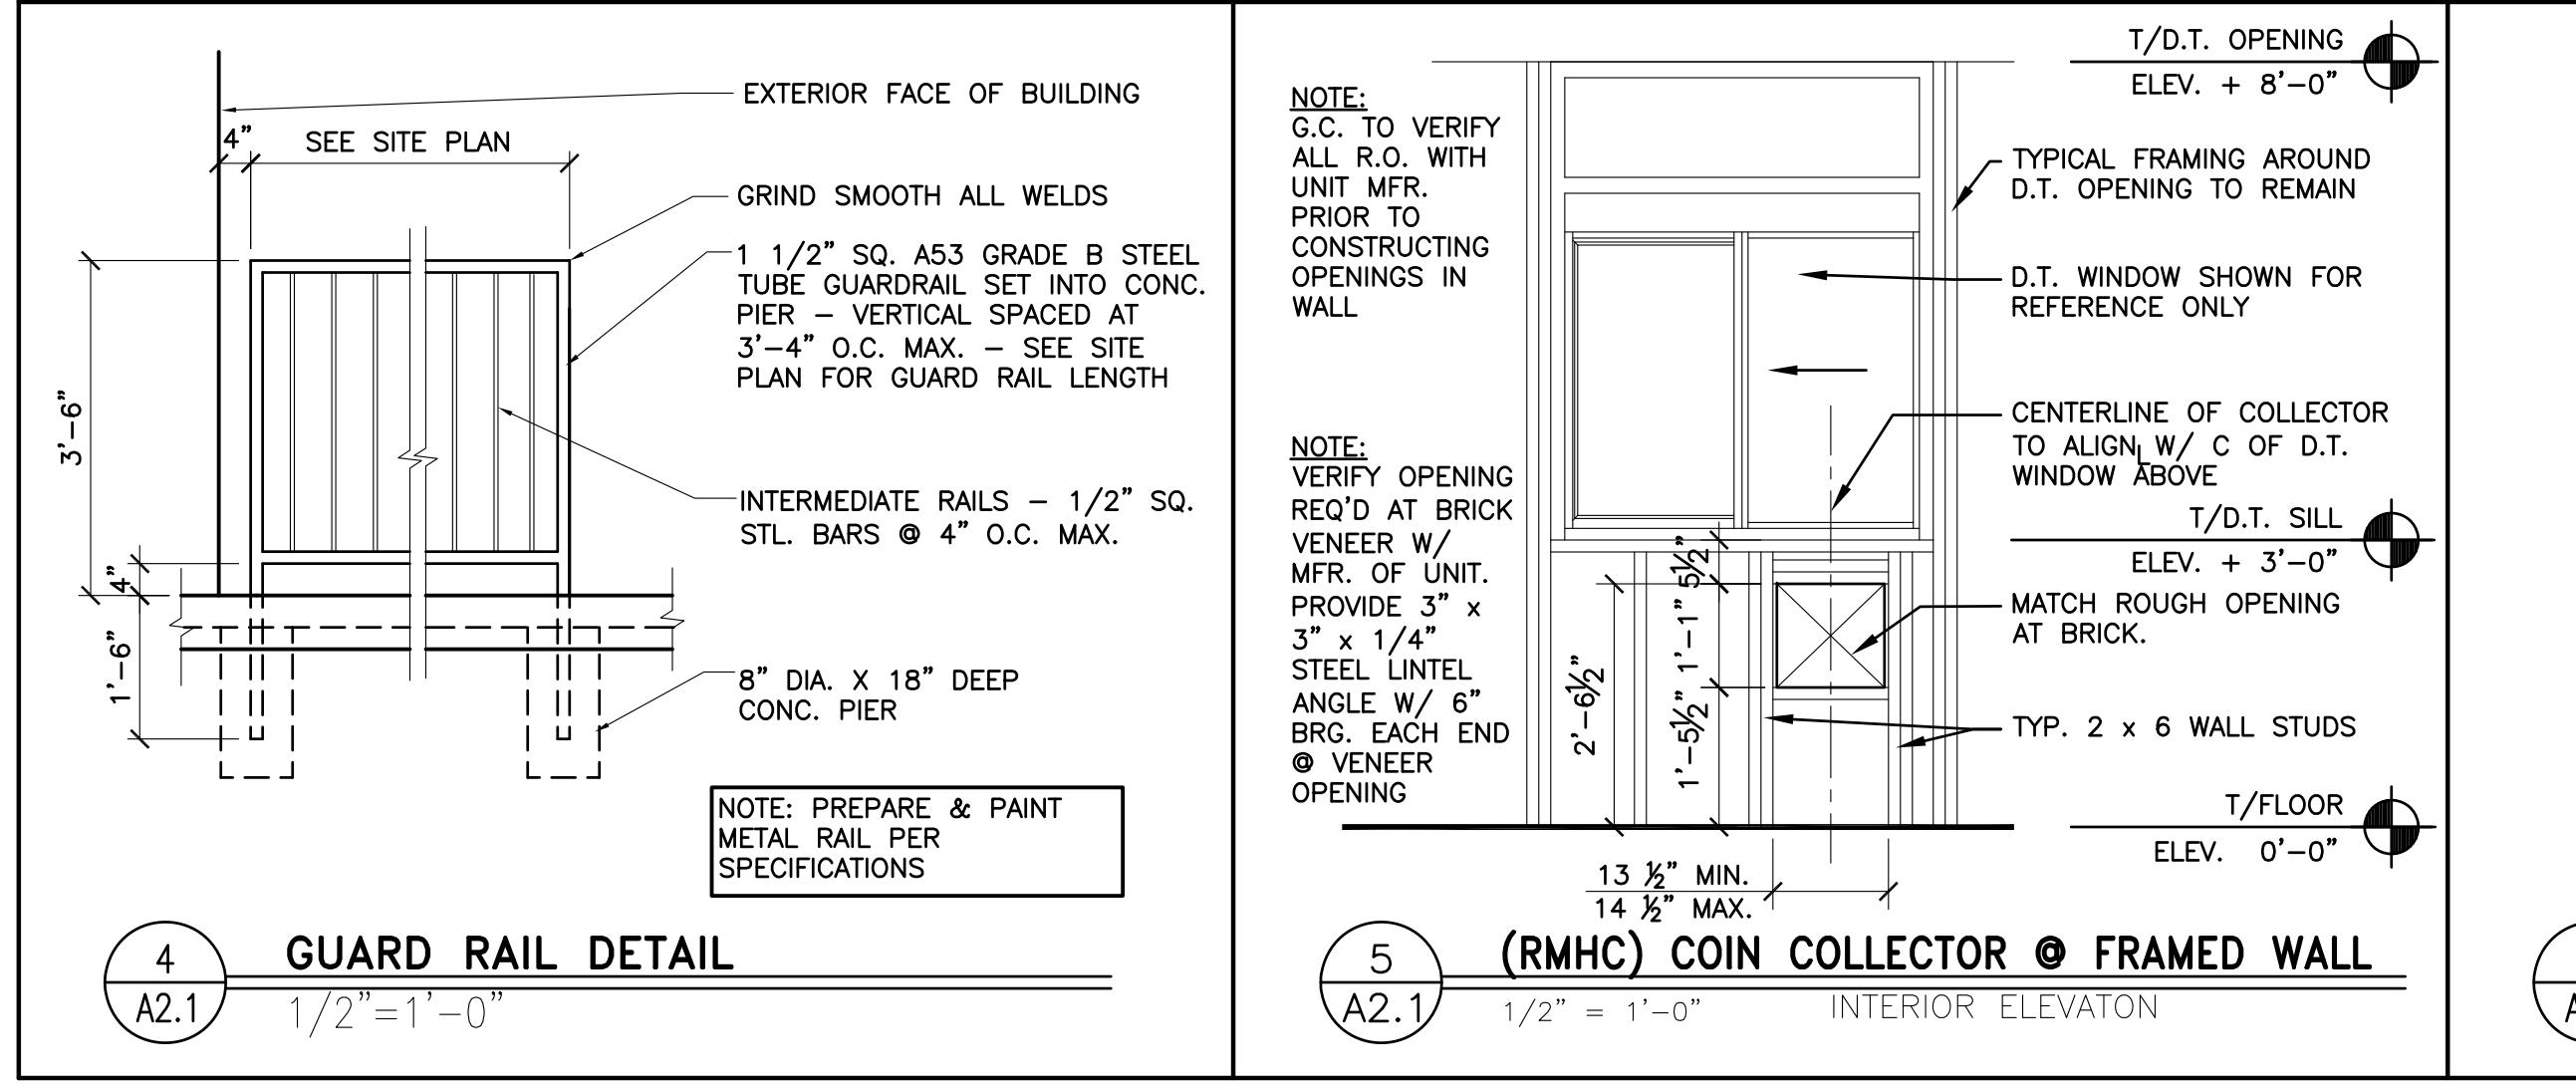
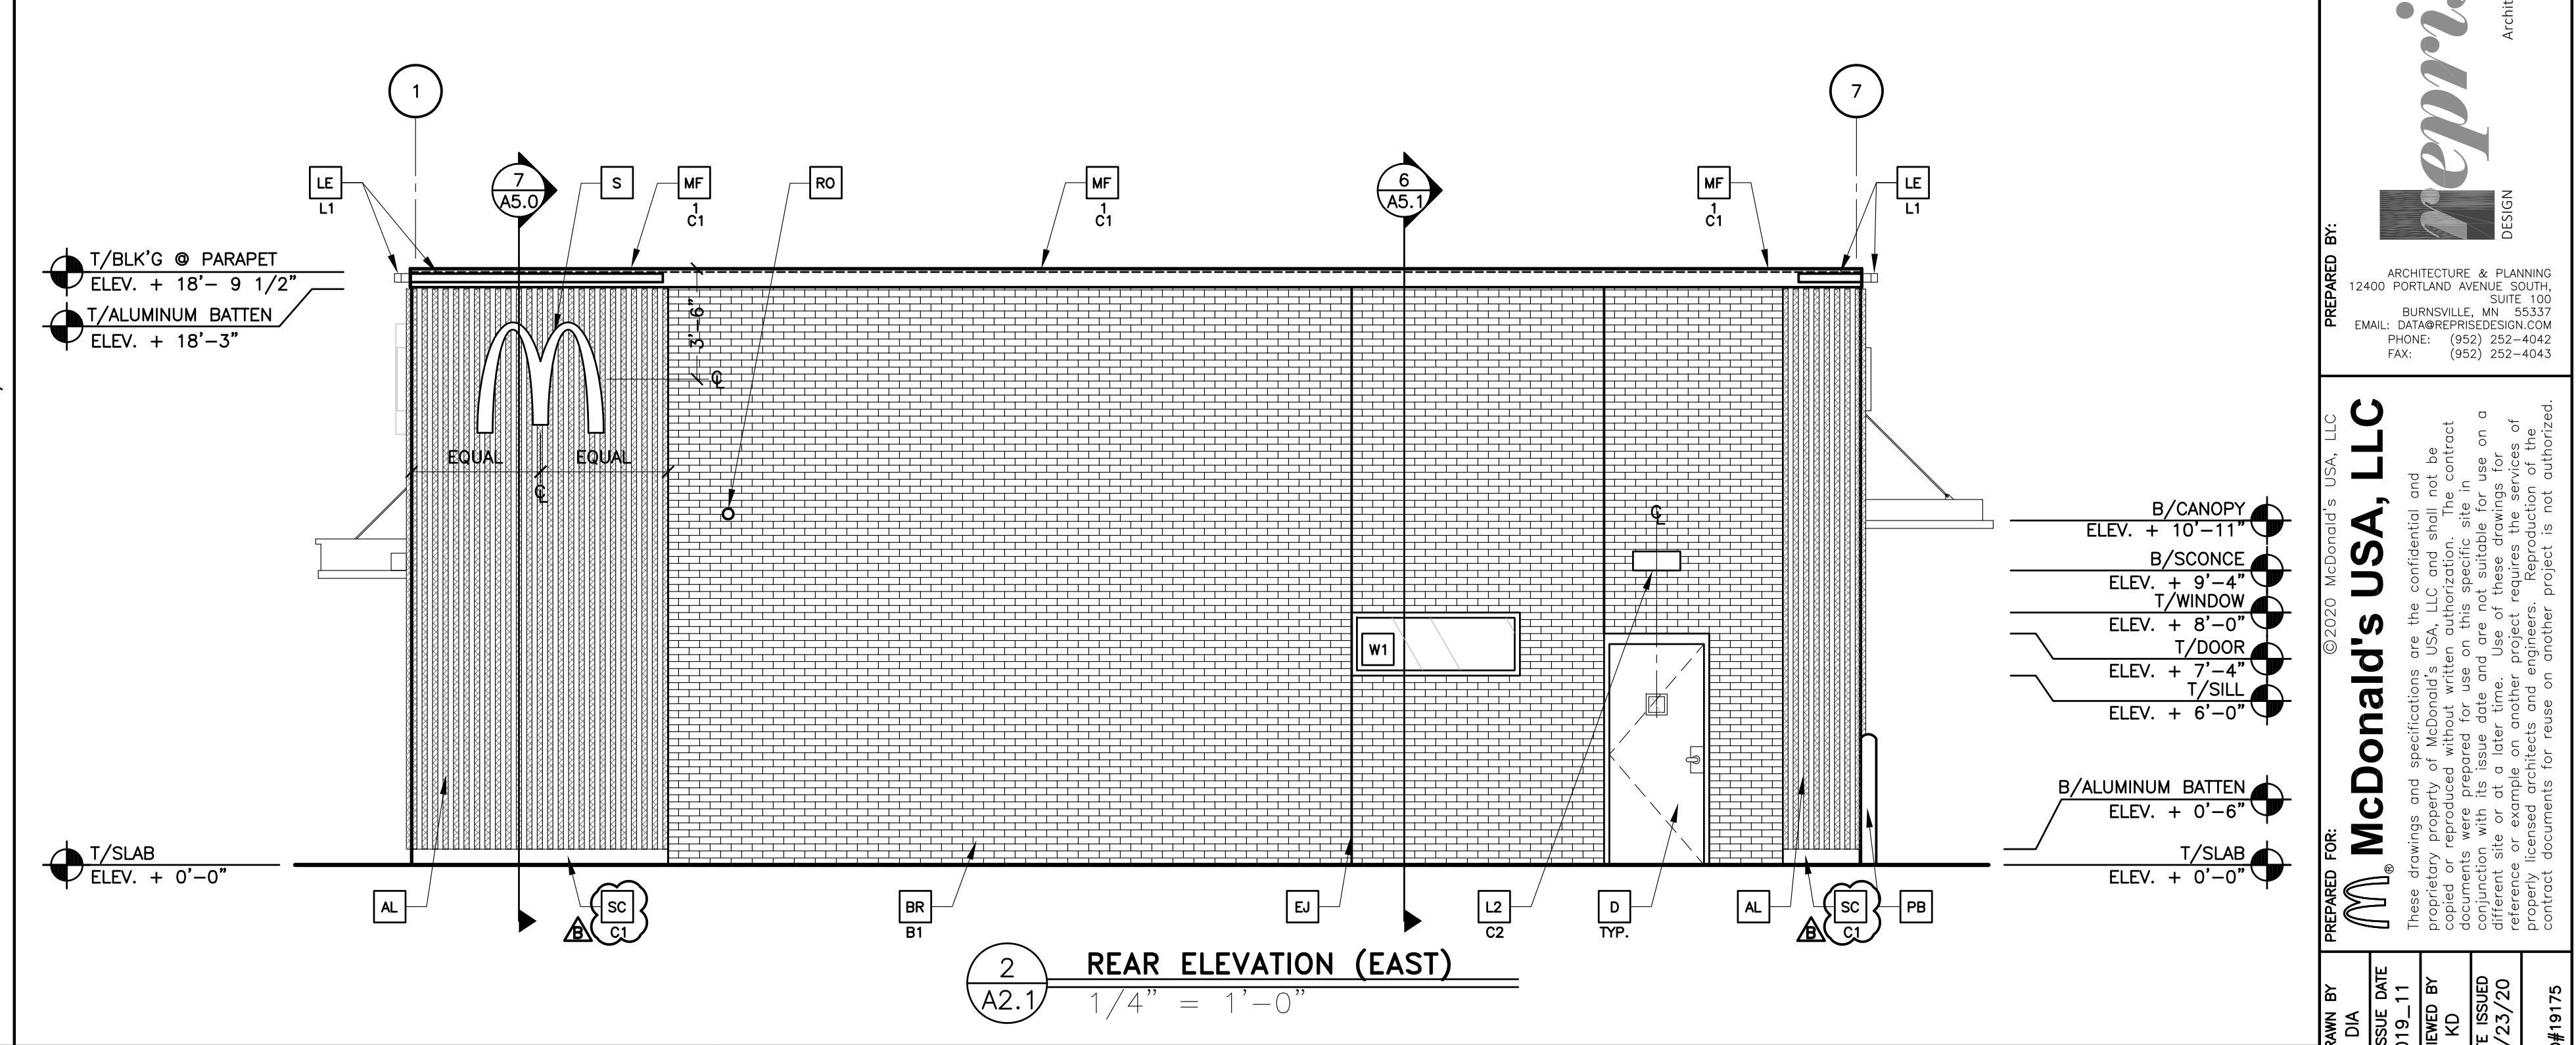
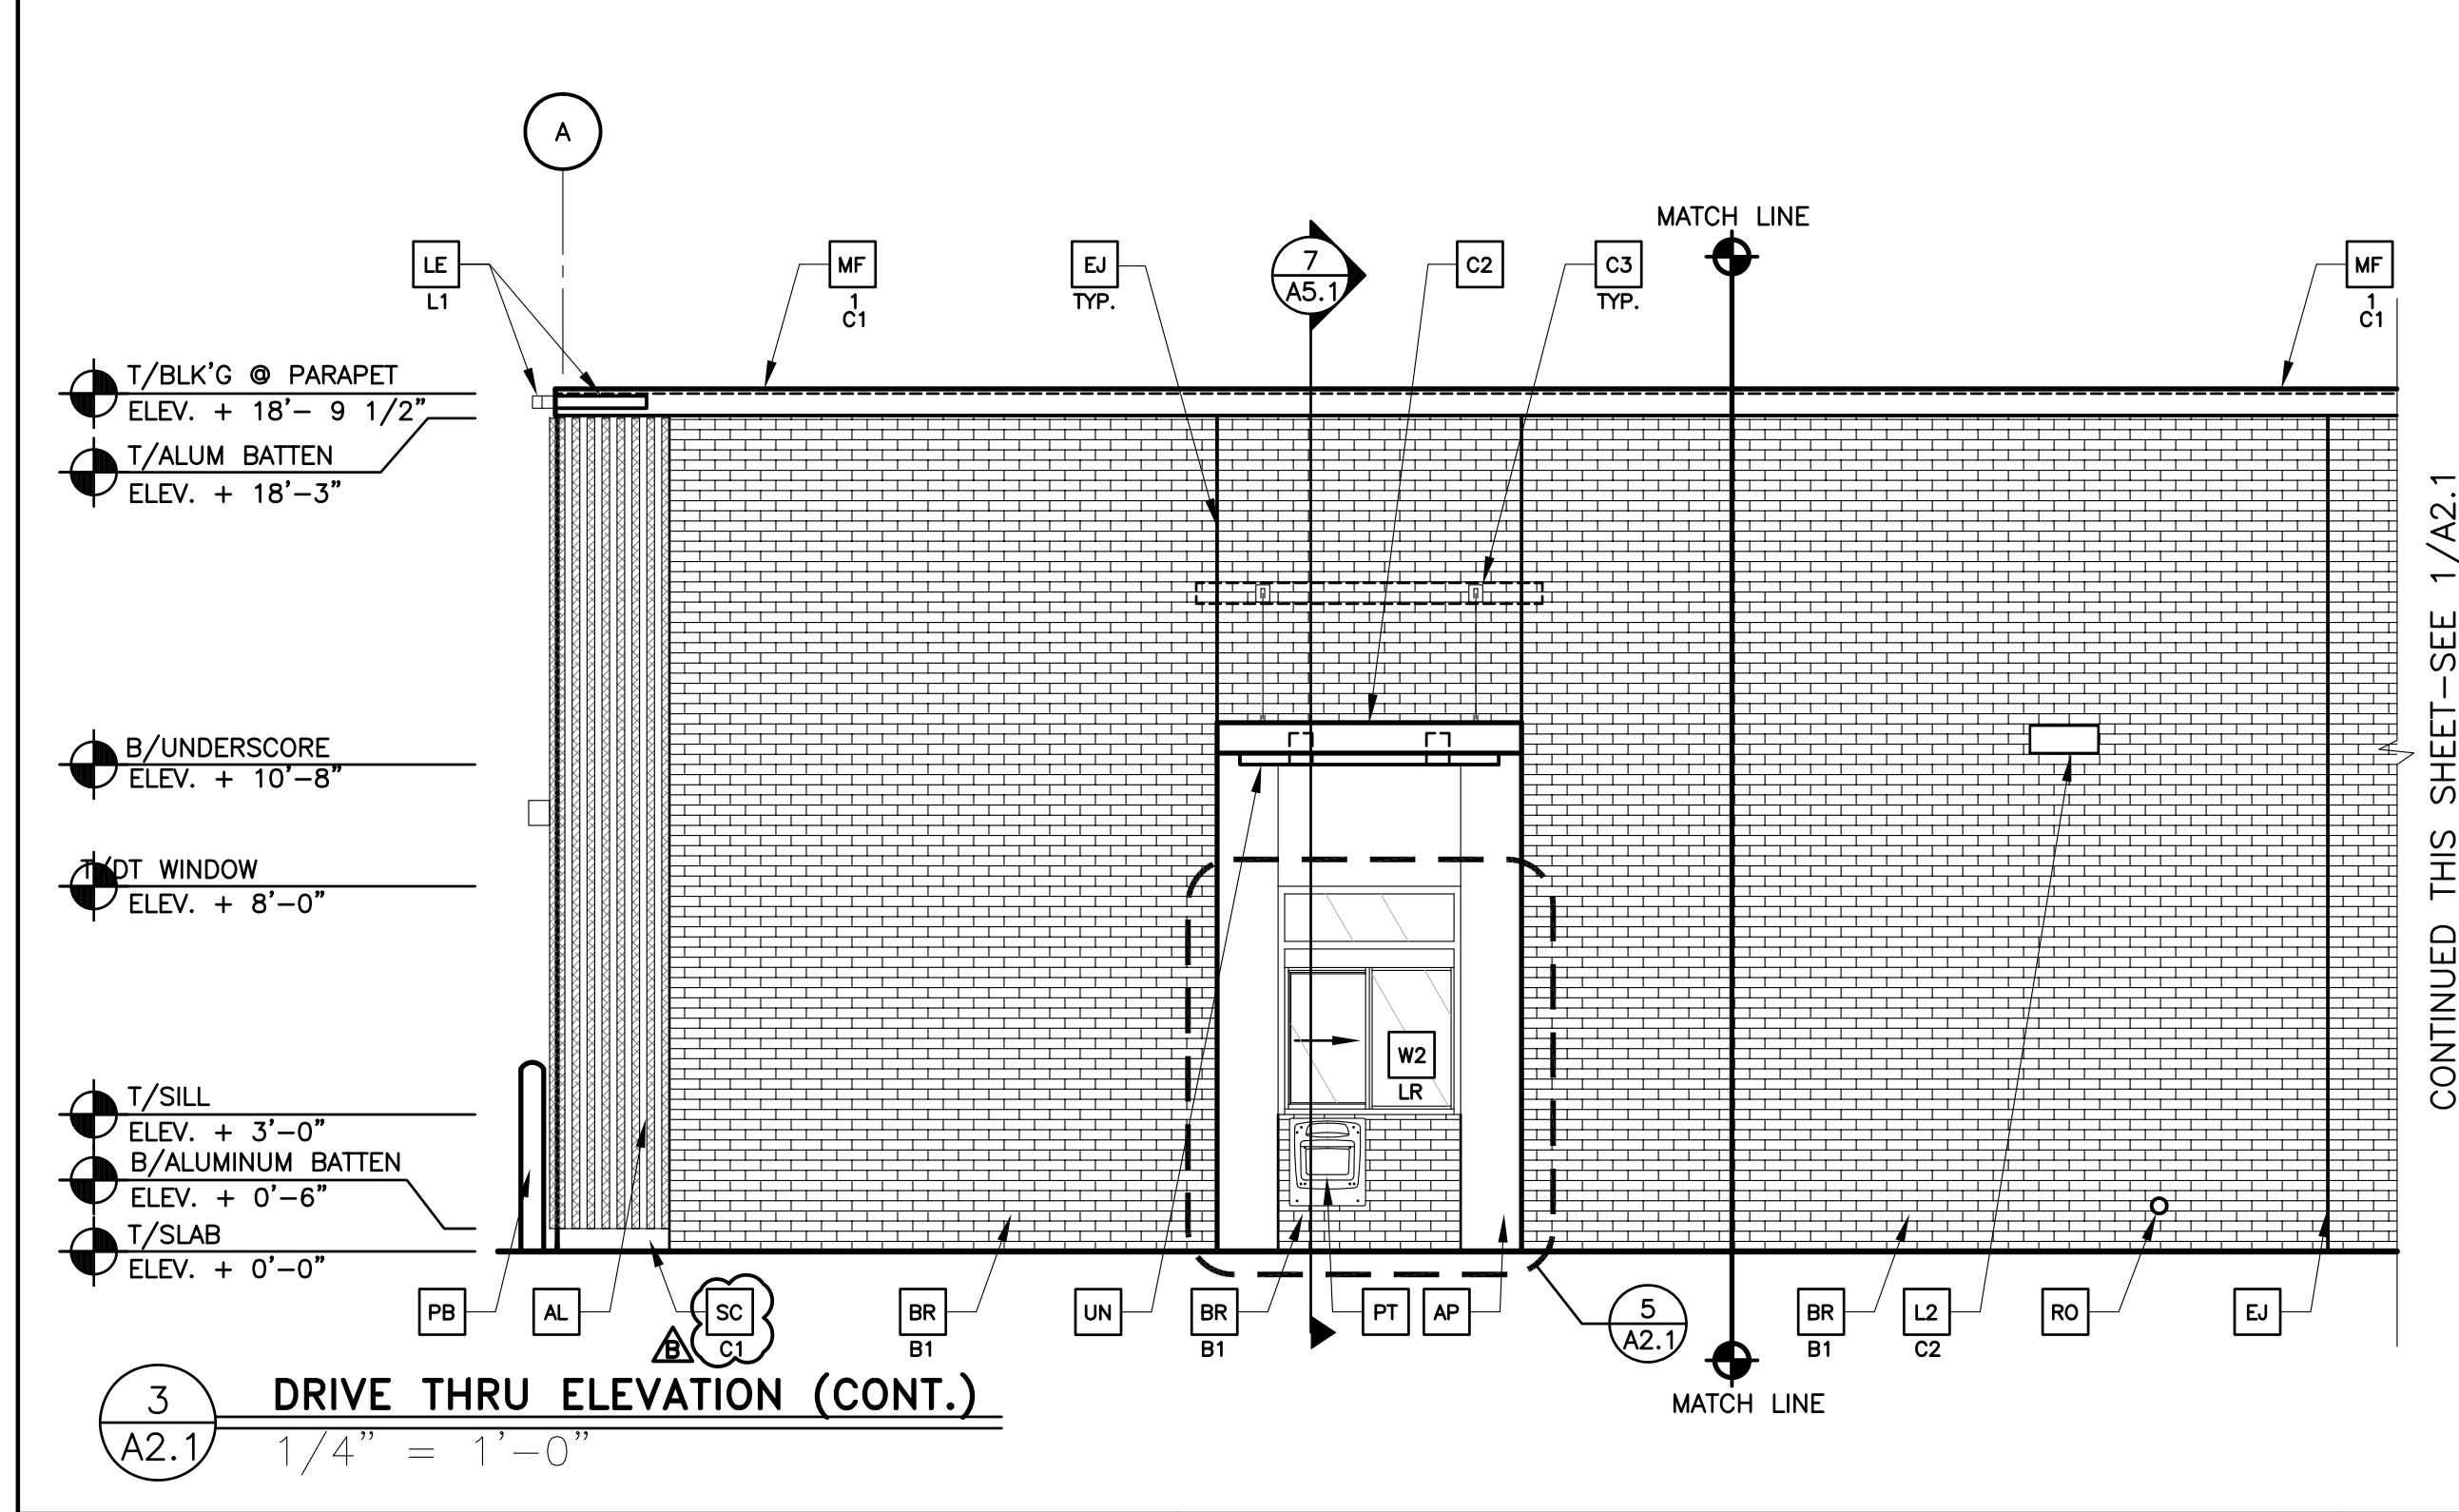


KEY NOTES:	
DE	DECAL BY GRAPHICS SUPPLIER SURFACE APPLIED, FIELD INSTALLED, PRE CUT, PRE SPACED. SUPPLIERS: VONELA (865) 330-7337, ann.bowen@vornela.com GFX INTERNATIONAL (847) 543-4600, mcdonaldsigns@grfx.com
AL	ALUMINUM BATTE SYSTEM COLOR: WEATHERED ZINC
FB	FIBER CEMENT PANELS: BY HARDEPANEL VERTICAL SIDING, AND LENGTHSEE 4/A2.1 FOR DETAILS COLOR: "IRON ORE" SW 7069 BY SHERWIN WILLIAMS
C01	C02 = BULK CO2 FILL BOX (EQPM SCHEDULE ITEM 49.00) B0 = BULK OIL FILL BOX (EQPM SCHEDULE ITEM 700.18)
RO	ROOF DRAIN OVERFLOW PIPE PAINT TO MATCH SURROUNDING MATERIAL
S	MCDONALD'S SIGNAGE BY OTHERS - UNDER SEPARATE PERMIT. C1 = WEATHERED ZINC RACEWAY C2 = RAL 7022 RACEWAY
SC	SC STUCCO (BASE OF BATTE SYSTEM) C1 = PAINT "IRON ORE" SW7069 BY SHERWIN WILLIAMS
ST	C02 STROBE/ALARM. SEE MECHANICAL DRAWINGS FOR SPECIFICATION.
UN	METAL UNDERSCORE COLOR: GOLD
W1	W1 EXTERIOR WINDOW ASSEMBLY - TEMPERED GLASS COLOR: DARK BRONZE SEE ASSEMBLY NOTES ON 4/A5.0 & FRAME TYPES ON SHEET A.6.0
W2	W2 DRIVE-THRU WINDOW BY READY ACCESS MODEL: 600 SERIES, 36" SERVICE HEIGHT WITH XX TRANSOM, MANUAL OPEN; ELECTRONIC RELEASE COLOR: DEEP BRONZE
PB	PB PIPE BOLLARD - PAINTED YELLOW
PT	PT (RMHC) COIN COLLECTOR UNIT: APERTURE WPT, #DTA2013 CALL 1-877-766-7642 TO ORDER

A2.1 ELEVATIONS

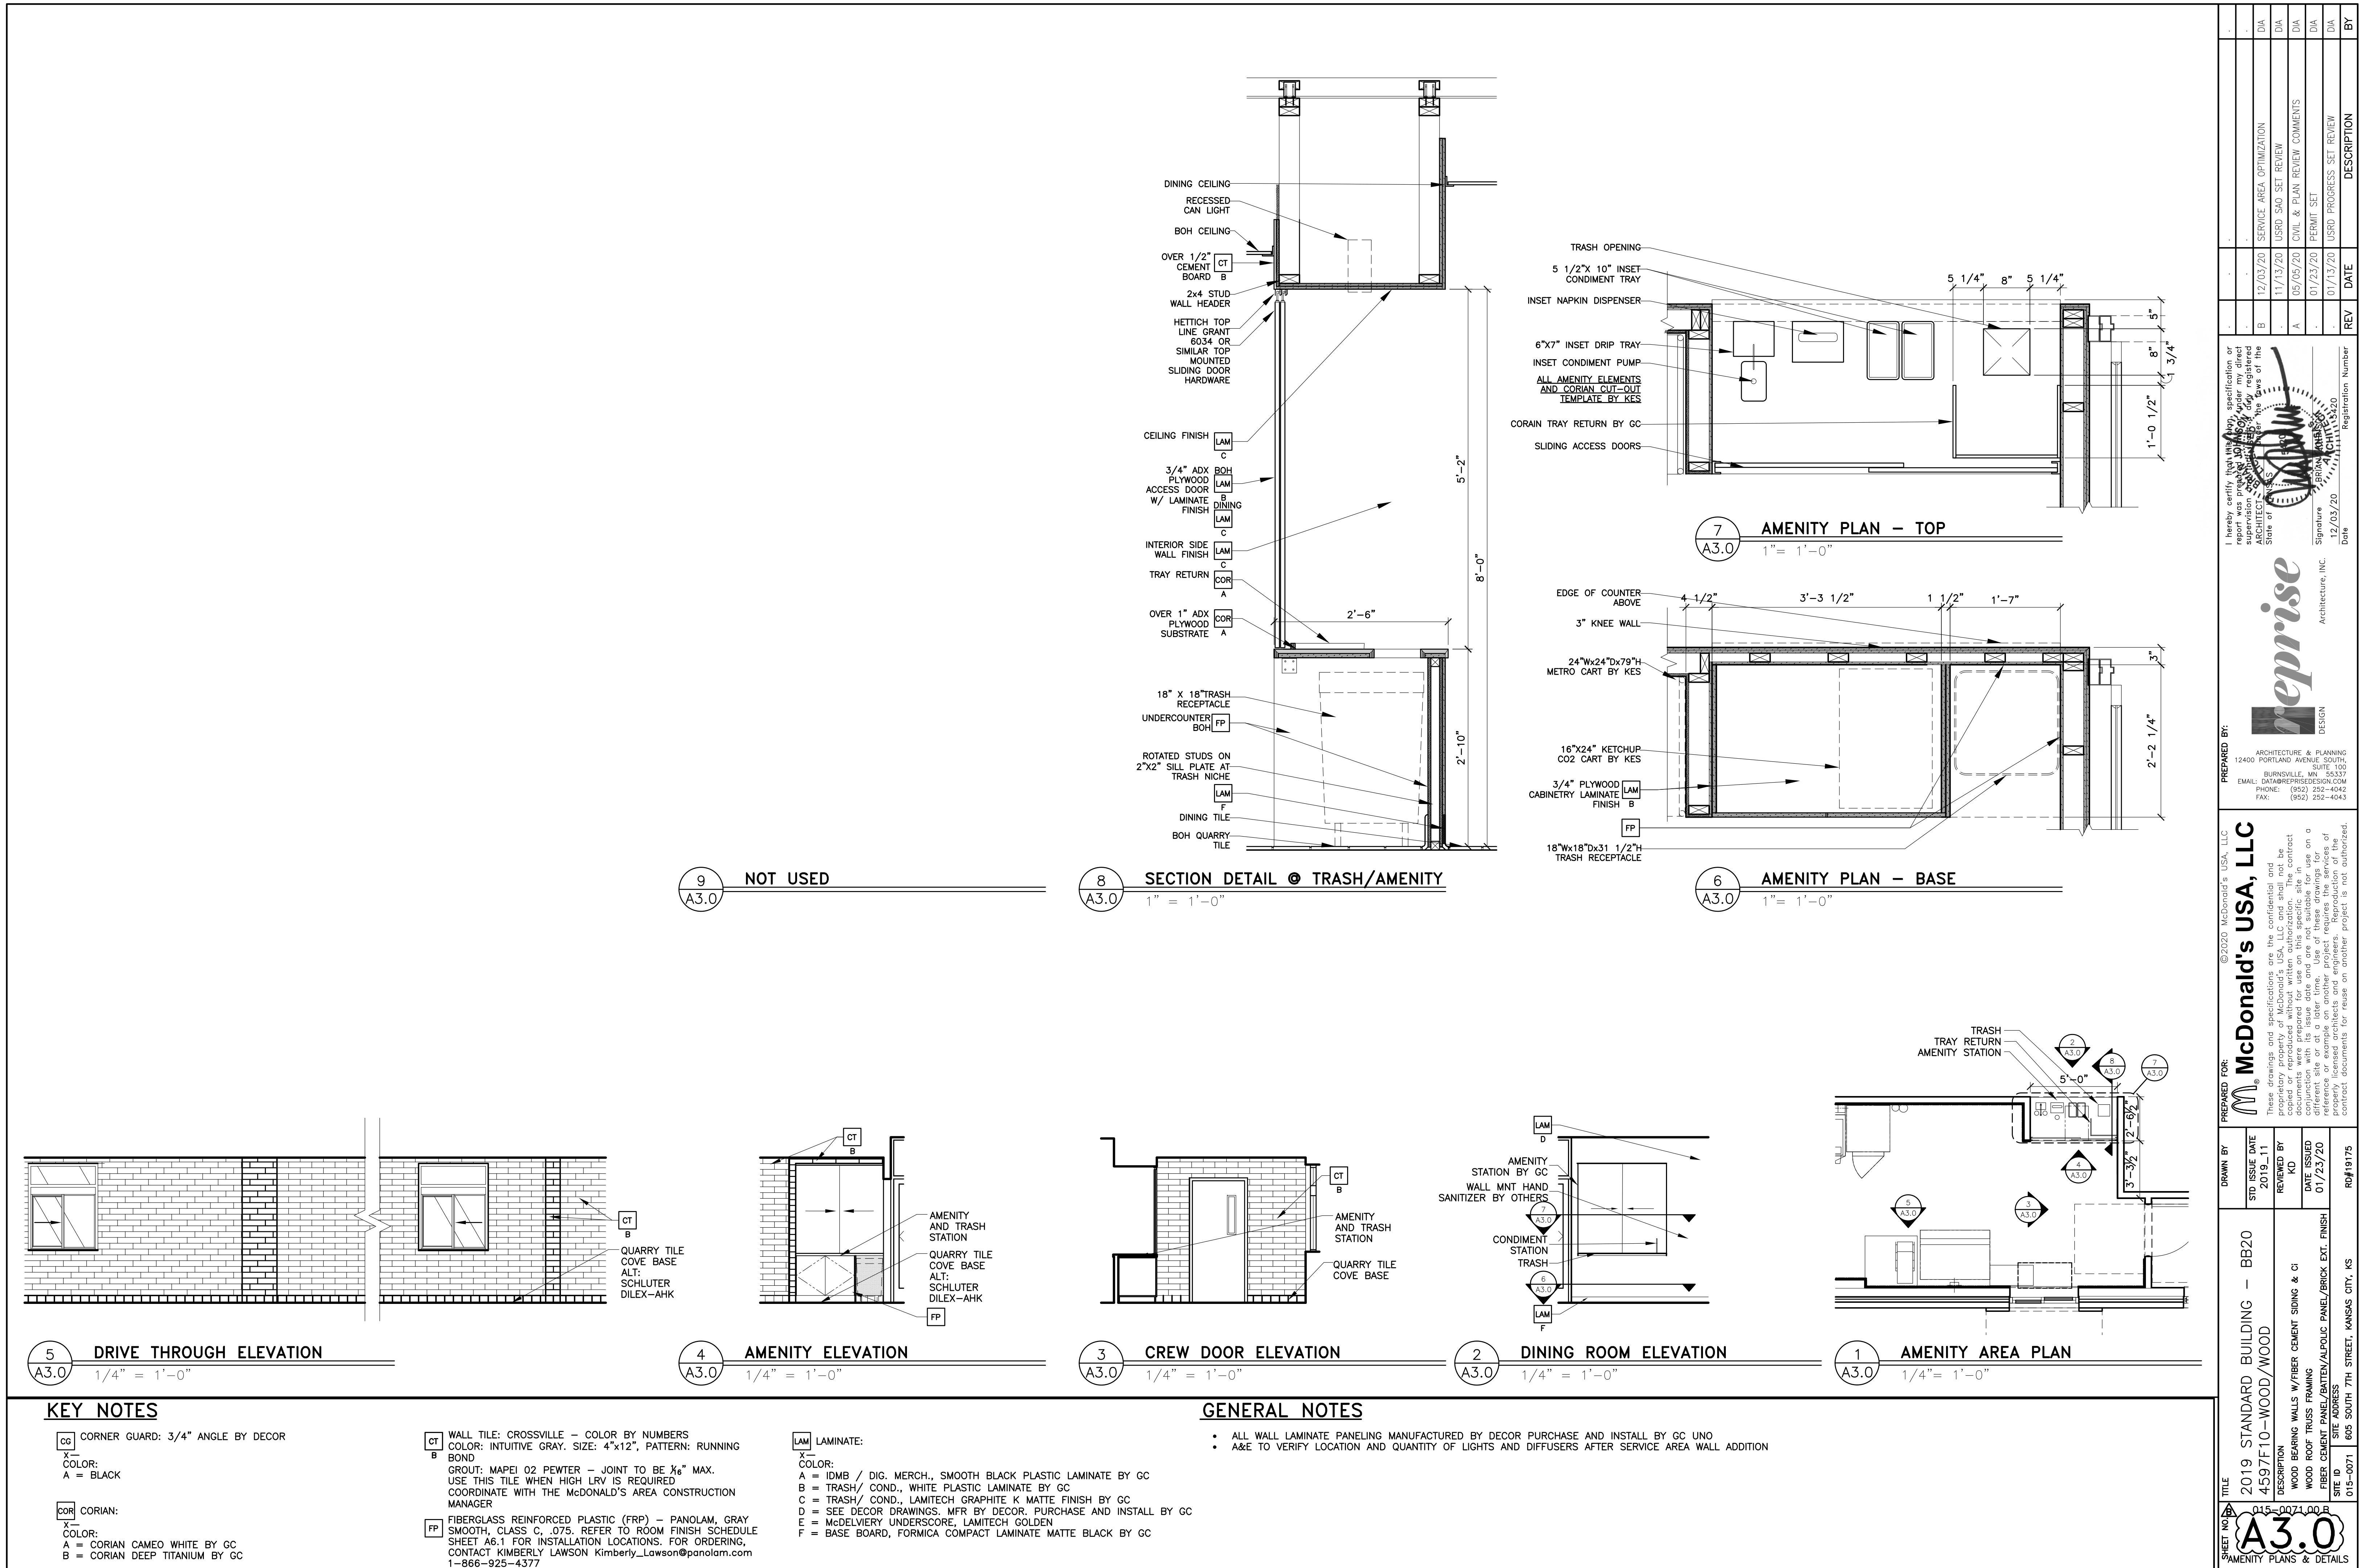

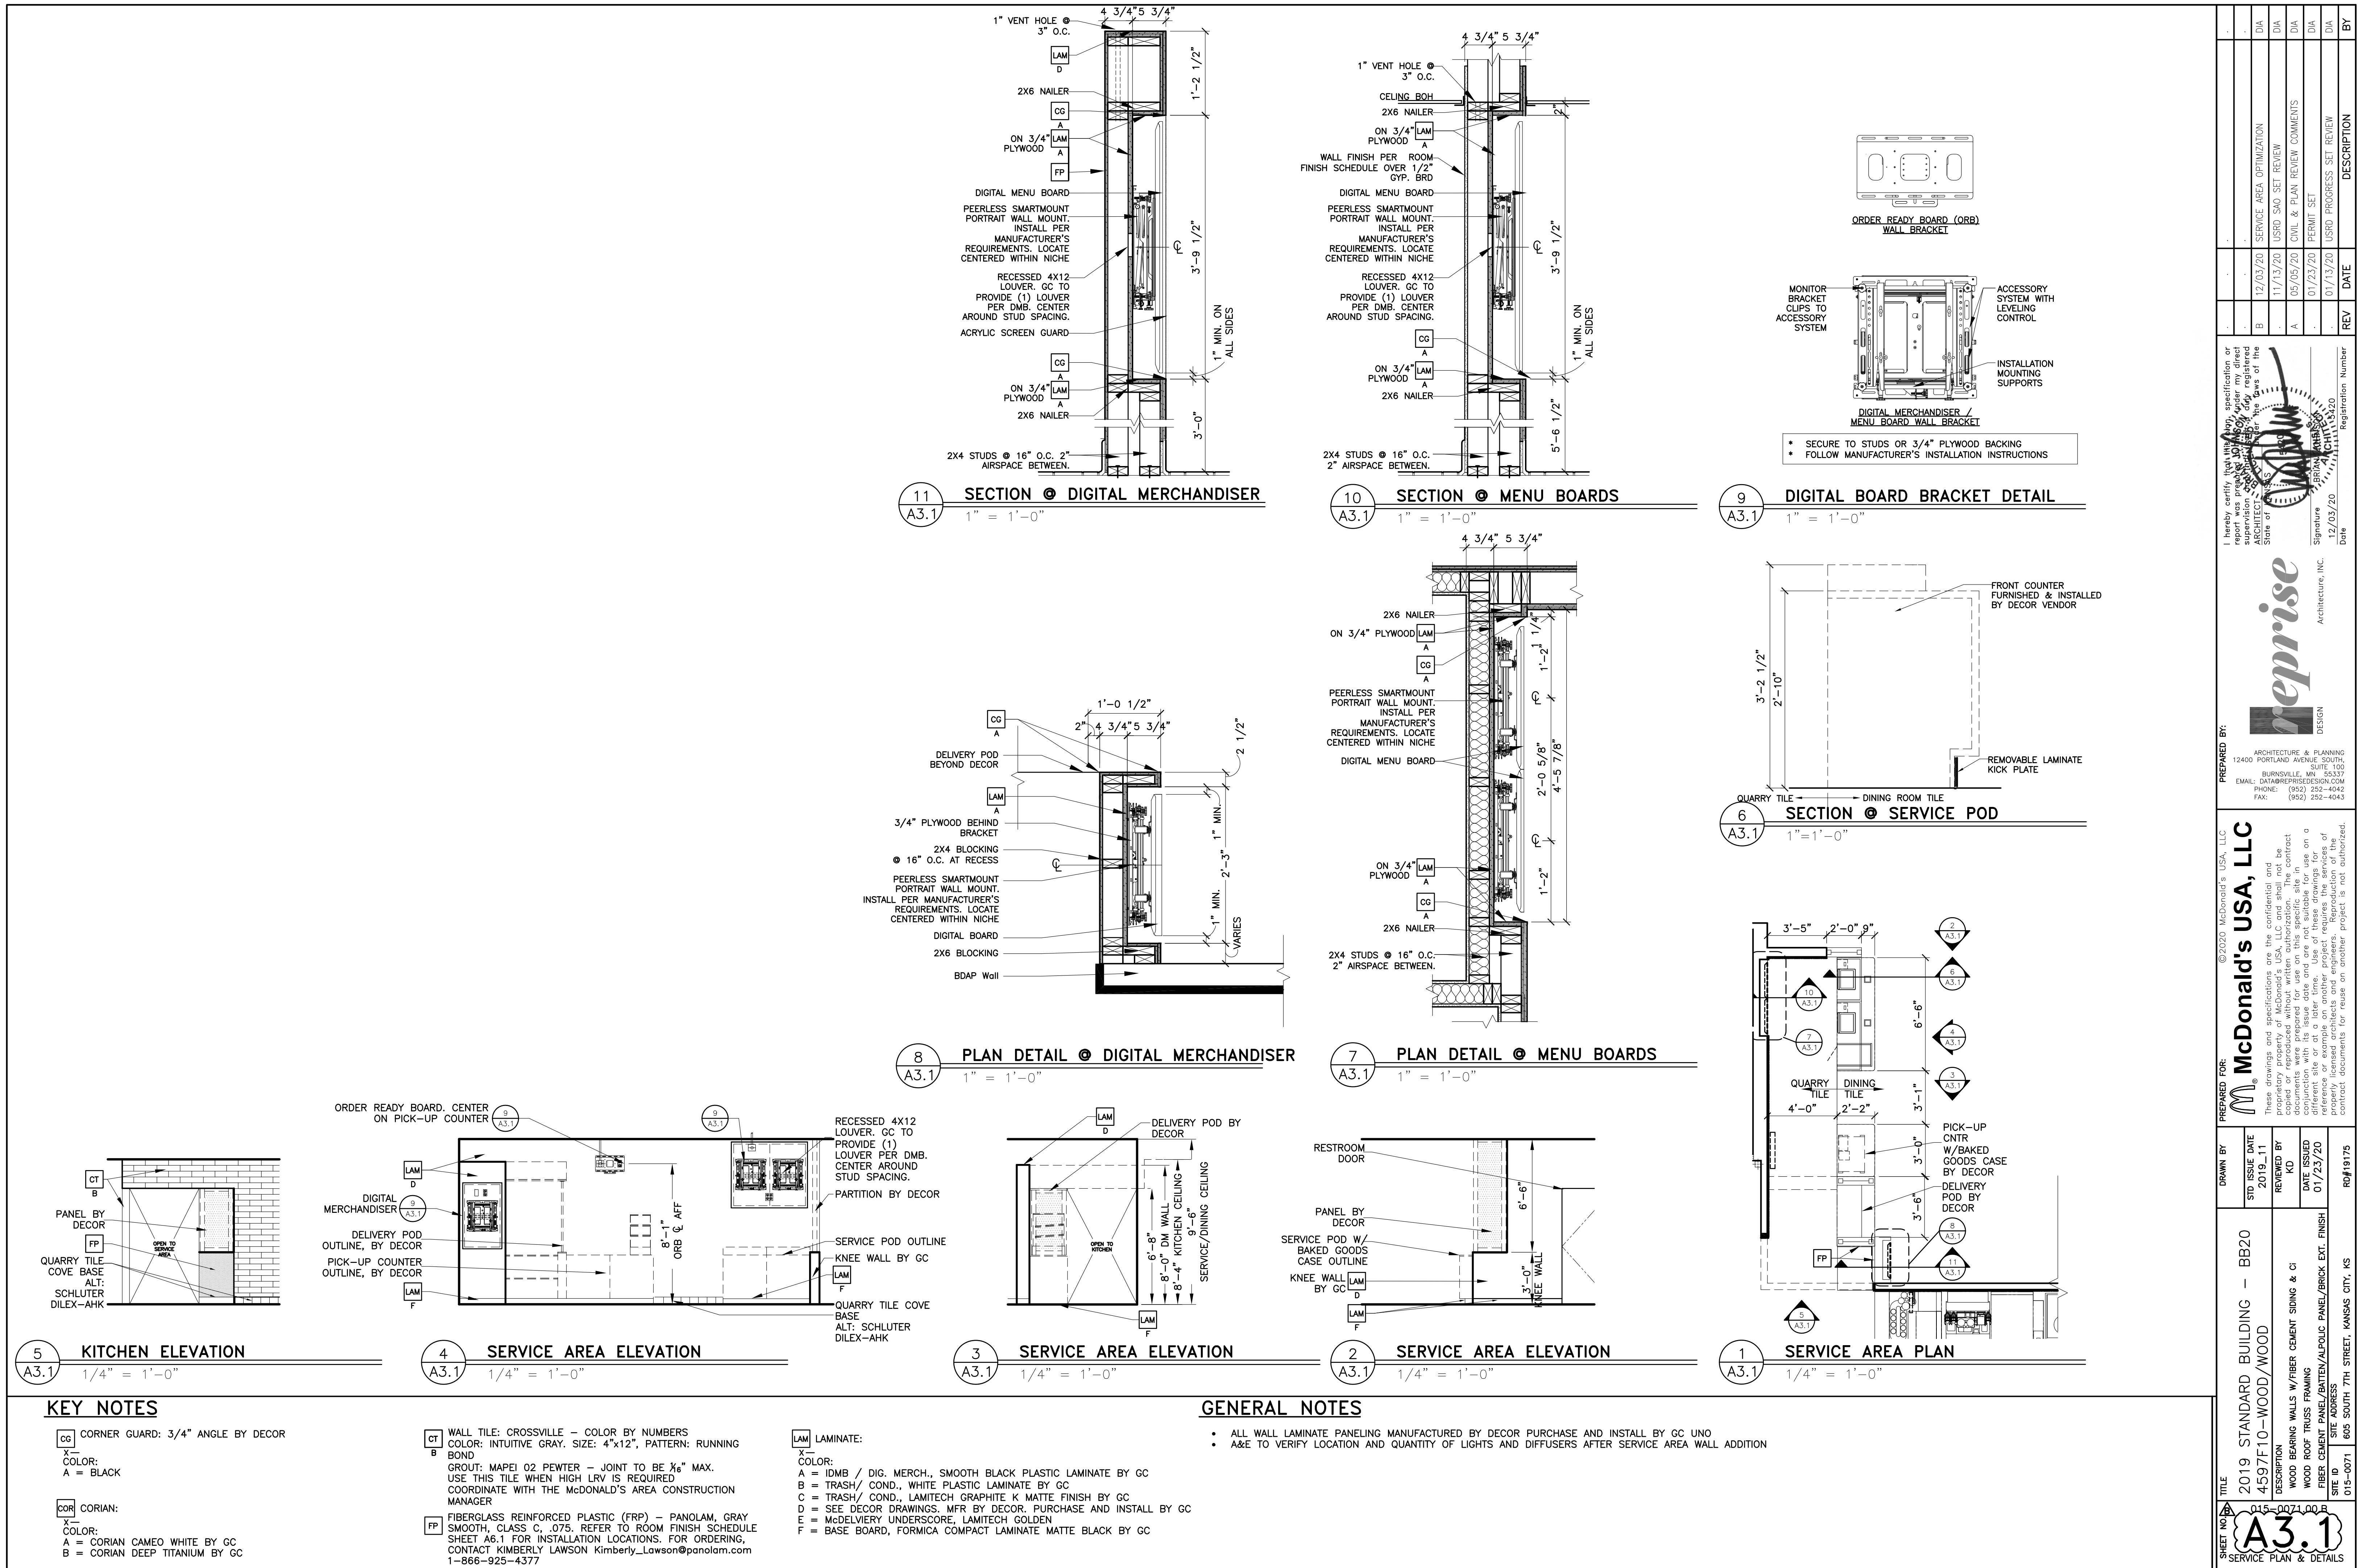

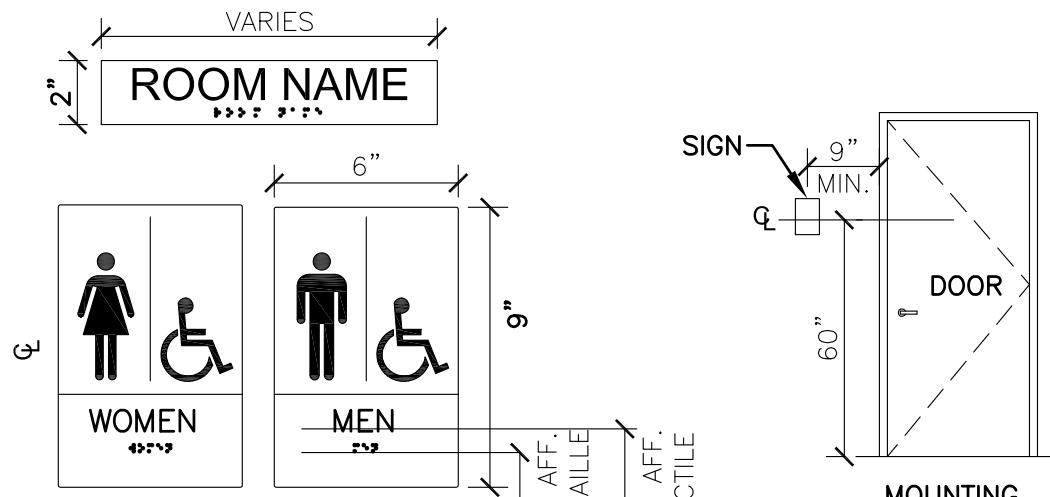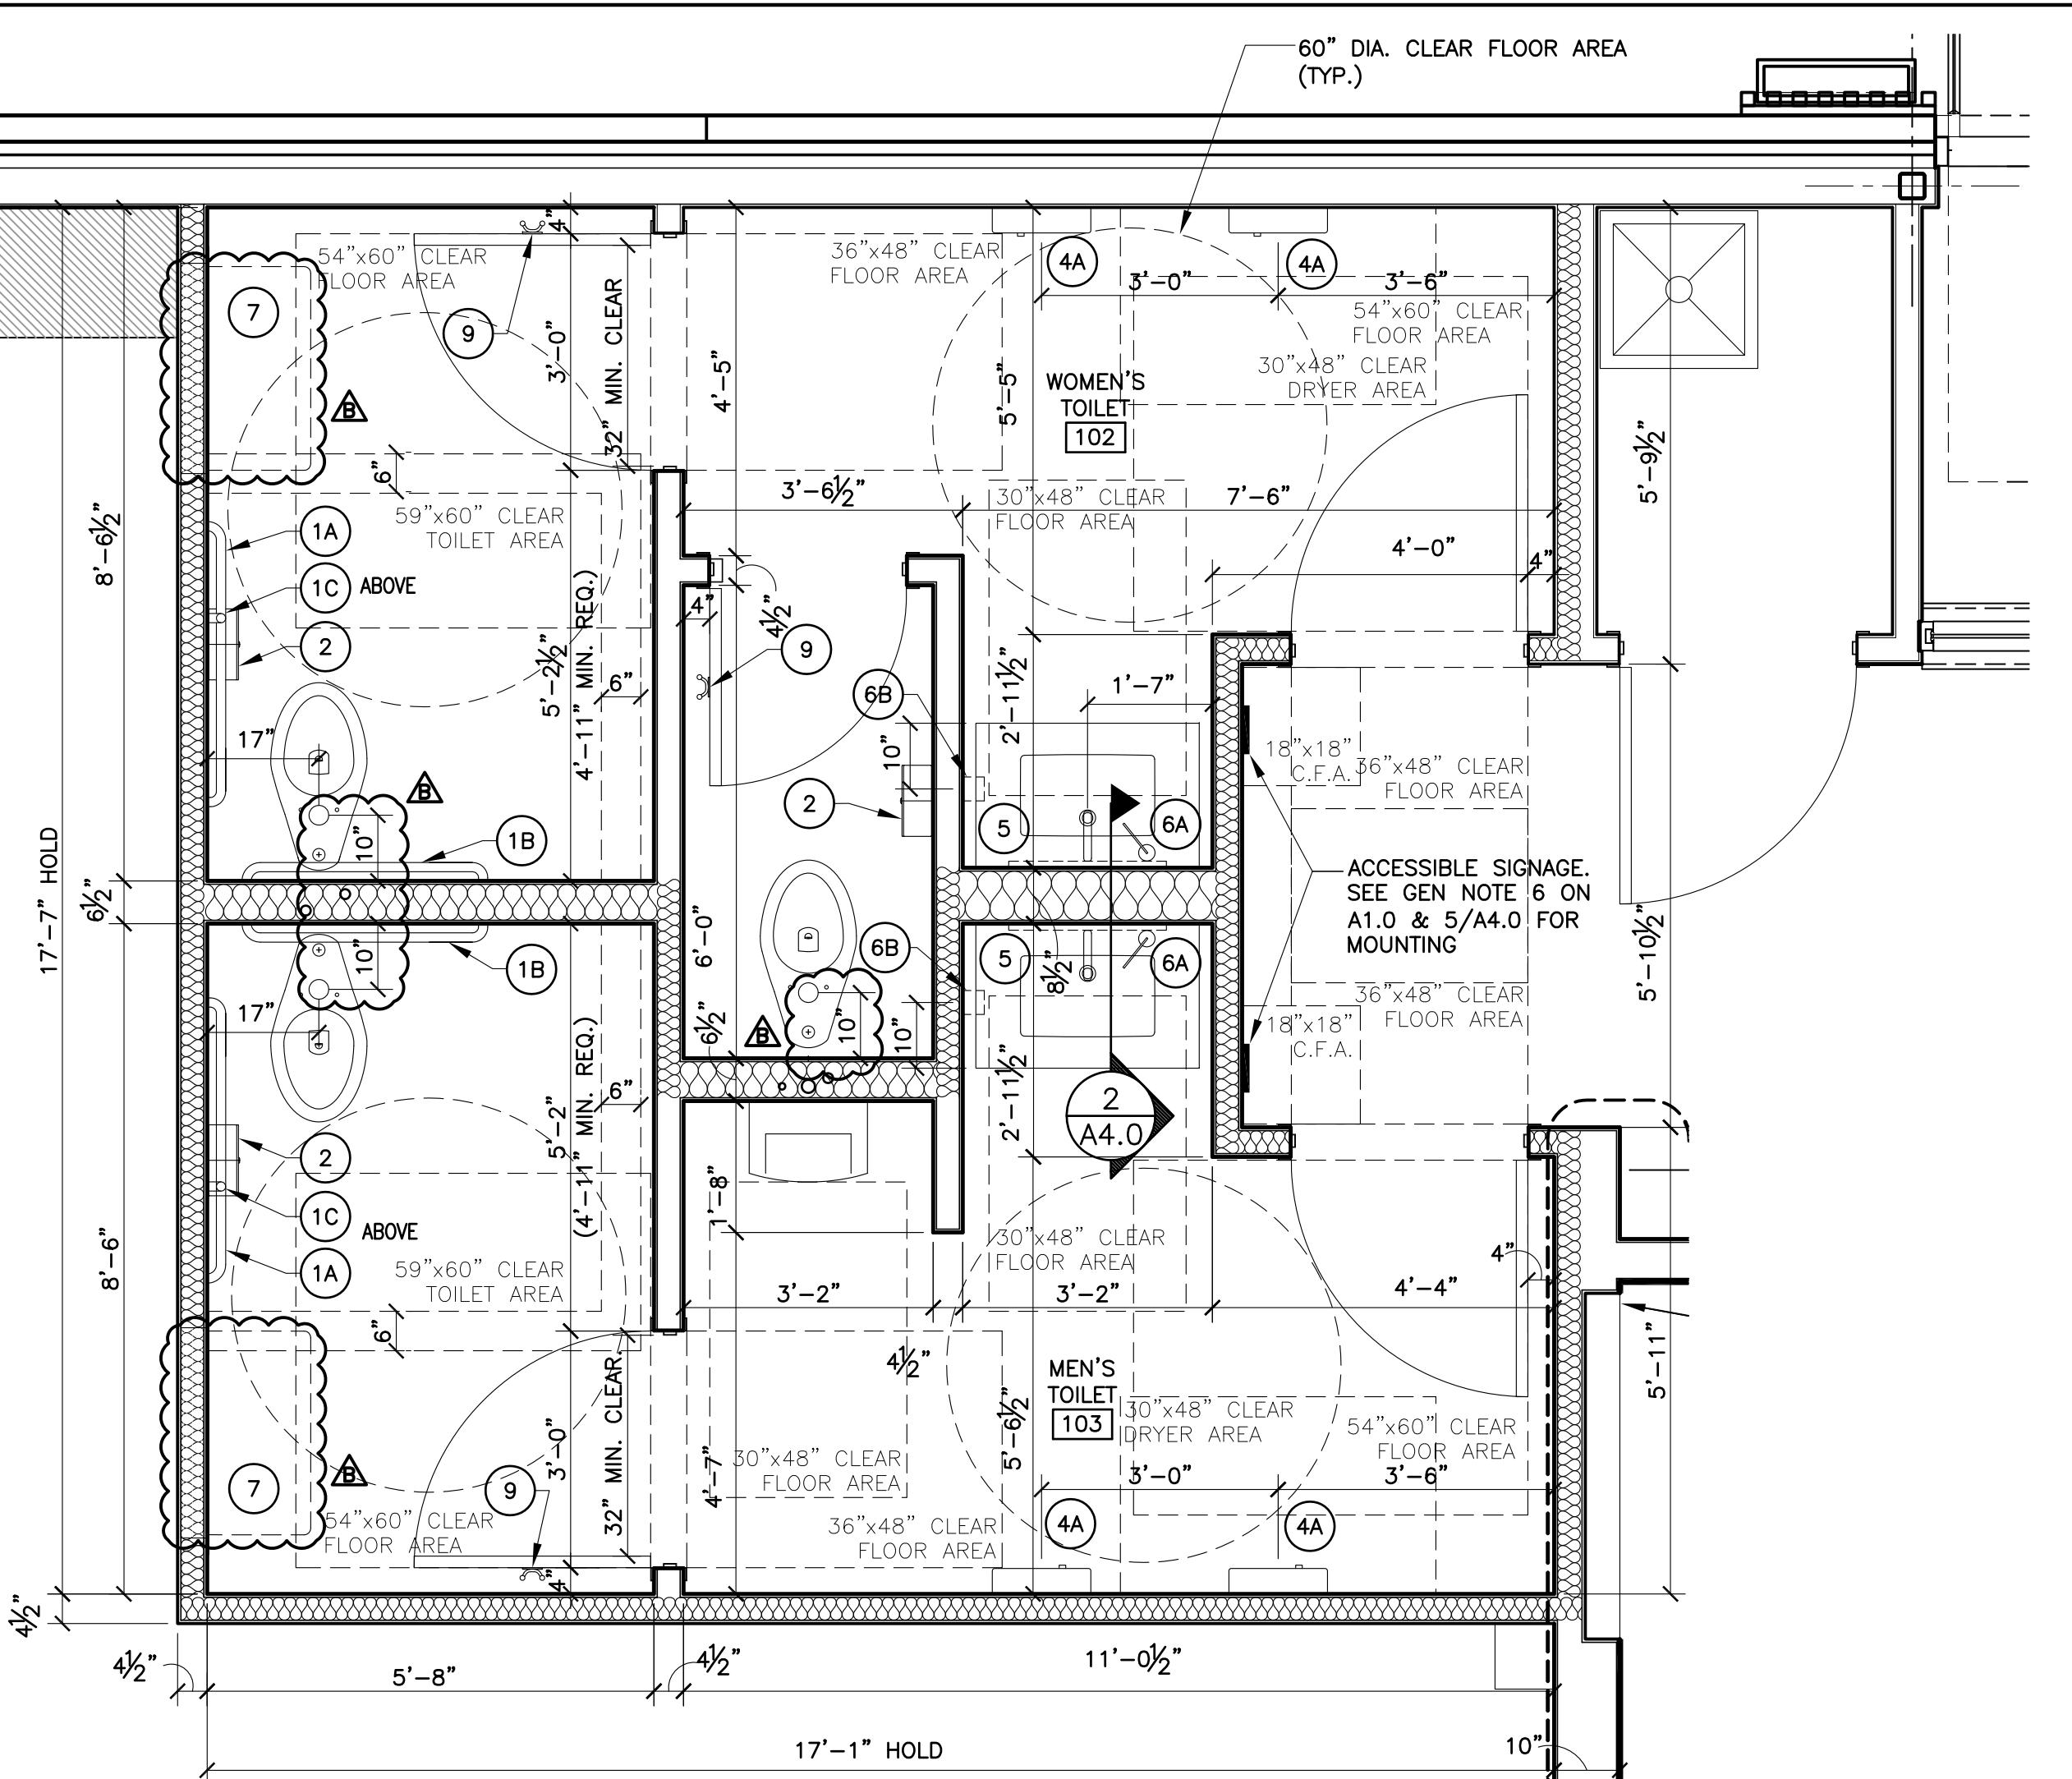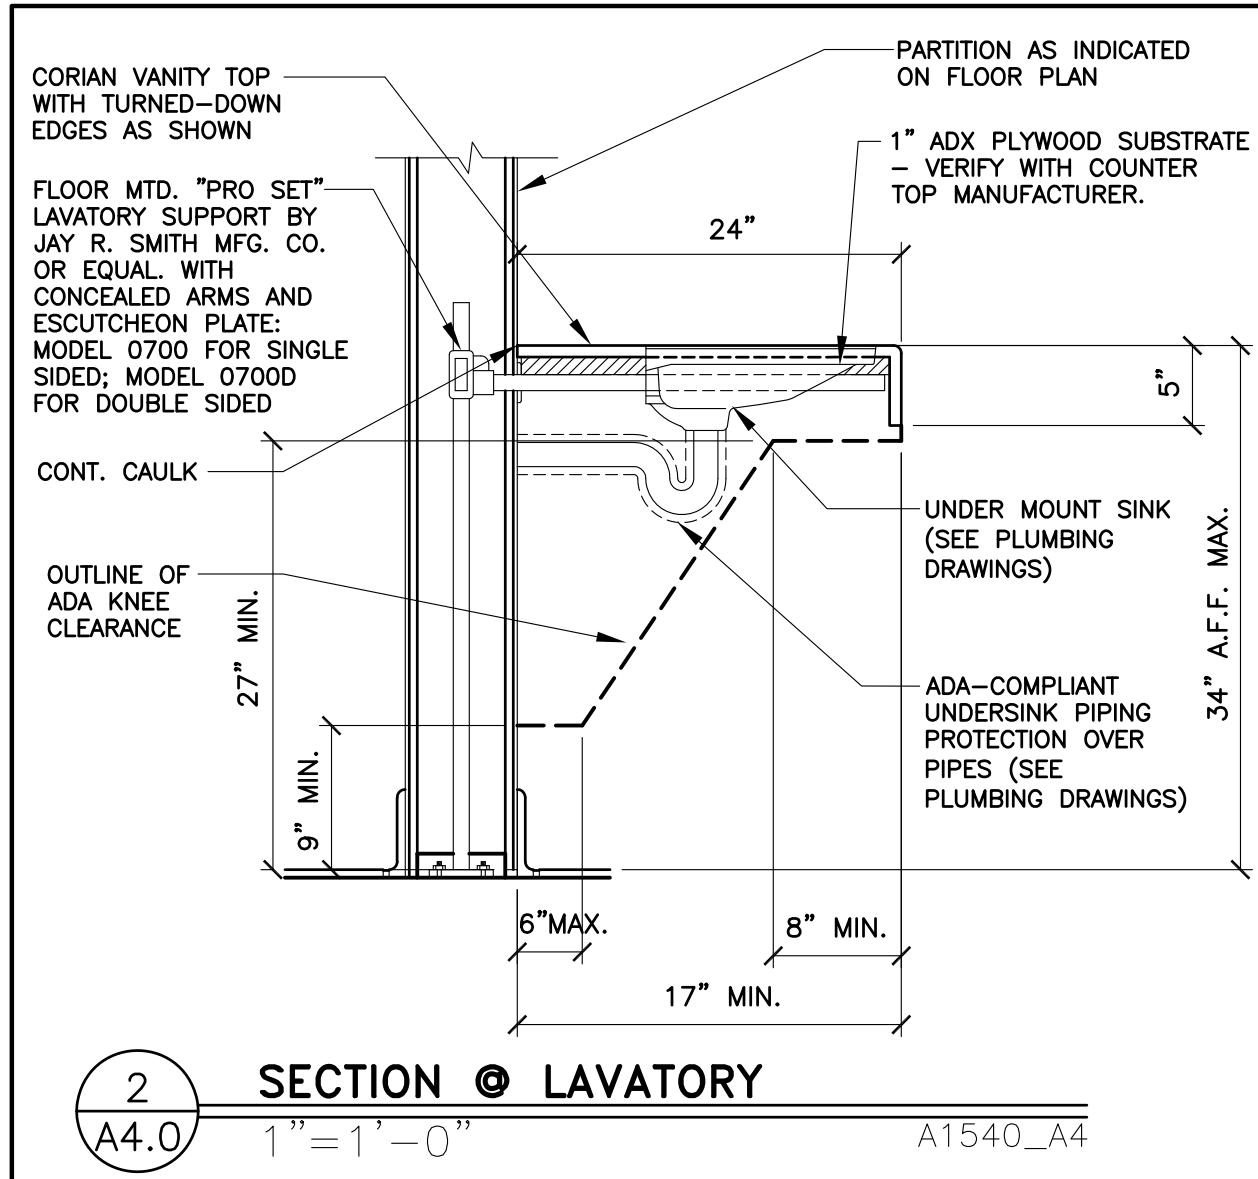


GRAPHICS SHOWN ARE FOR REFERENCE ONLY.
GC TO PROVIDE ADA SIGNAGE PACKAGE AND INSTALL SIGNS AT LOCATIONS AND POSITIONS INDICATED IN PACKAGE OR AS REQUIRED BY LOCAL CODES. SIGNAGE PACKAGE SUPPLIED BY:

FORREST PERMA-SIGN
9292 1ST ST. BOX 588
NEW ROCHELLE, NY 10802
www.forsigns.com
1-800-214-8765

SIGNAGE NOTES:

- EACH EXIT DOOR SHALL HAVE A TAUCLE SIGN, INCLUDING RAISED LETTERS AND BRAILLE, STATING "EXIT" AND SHALL COMPLY WITH CHAPTER 7. ALL SIGNAGE SHALL CONFORM WITH ACCESSIBILITY GUIDELINES AND LOCAL GUIDELINES INCLUDING BUT NOT LIMITED TO PROPORTION, COLOR CONTRAST AND RELIEF AND GRADE 2 BRAILLE REQUIREMENTS.
- WHEN PERMANENT IDENTIFICATION IS PROVIDED FOR ROOMS AND SPACES, RAISED LETTERS SHALL BE PROVIDED AND SHALL BE ACCOMPANIED BY BRAILLE IN CONFORMANCE WITH CHAPTER 7. SIGNS SHALL BE INSTALLED ON THE WALL ADJACENT TO THE LATCH SIDE OF THE DOOR. WHERE THERE IS NO WALL SPACE ON THE LATCH SIDE, INCLUDING AT DOUBLE LEAF DOORS, SIGNS SHALL BE PLACED ON THE NEAREST ADJACENT WALL, PREFERABLY ON THE RIGHT. MOUNTING HEIGHT SHALL BE 60" ABOVE THE FINISHED FLOOR TO THE CENTERLINE OF THE SIGN. MOUNTING LOCATION SHALL BE DETERMINED SO THAT A PERSON MAY APPROACH WITHIN 3" OF SIGNAGE WITHOUT ENCOUNTERING PROTRUDING OBJECTS OR STANDING WITHIN THE SWING OF A DOOR.

ACCESSIBLE SIGNAGE
N.T.S.

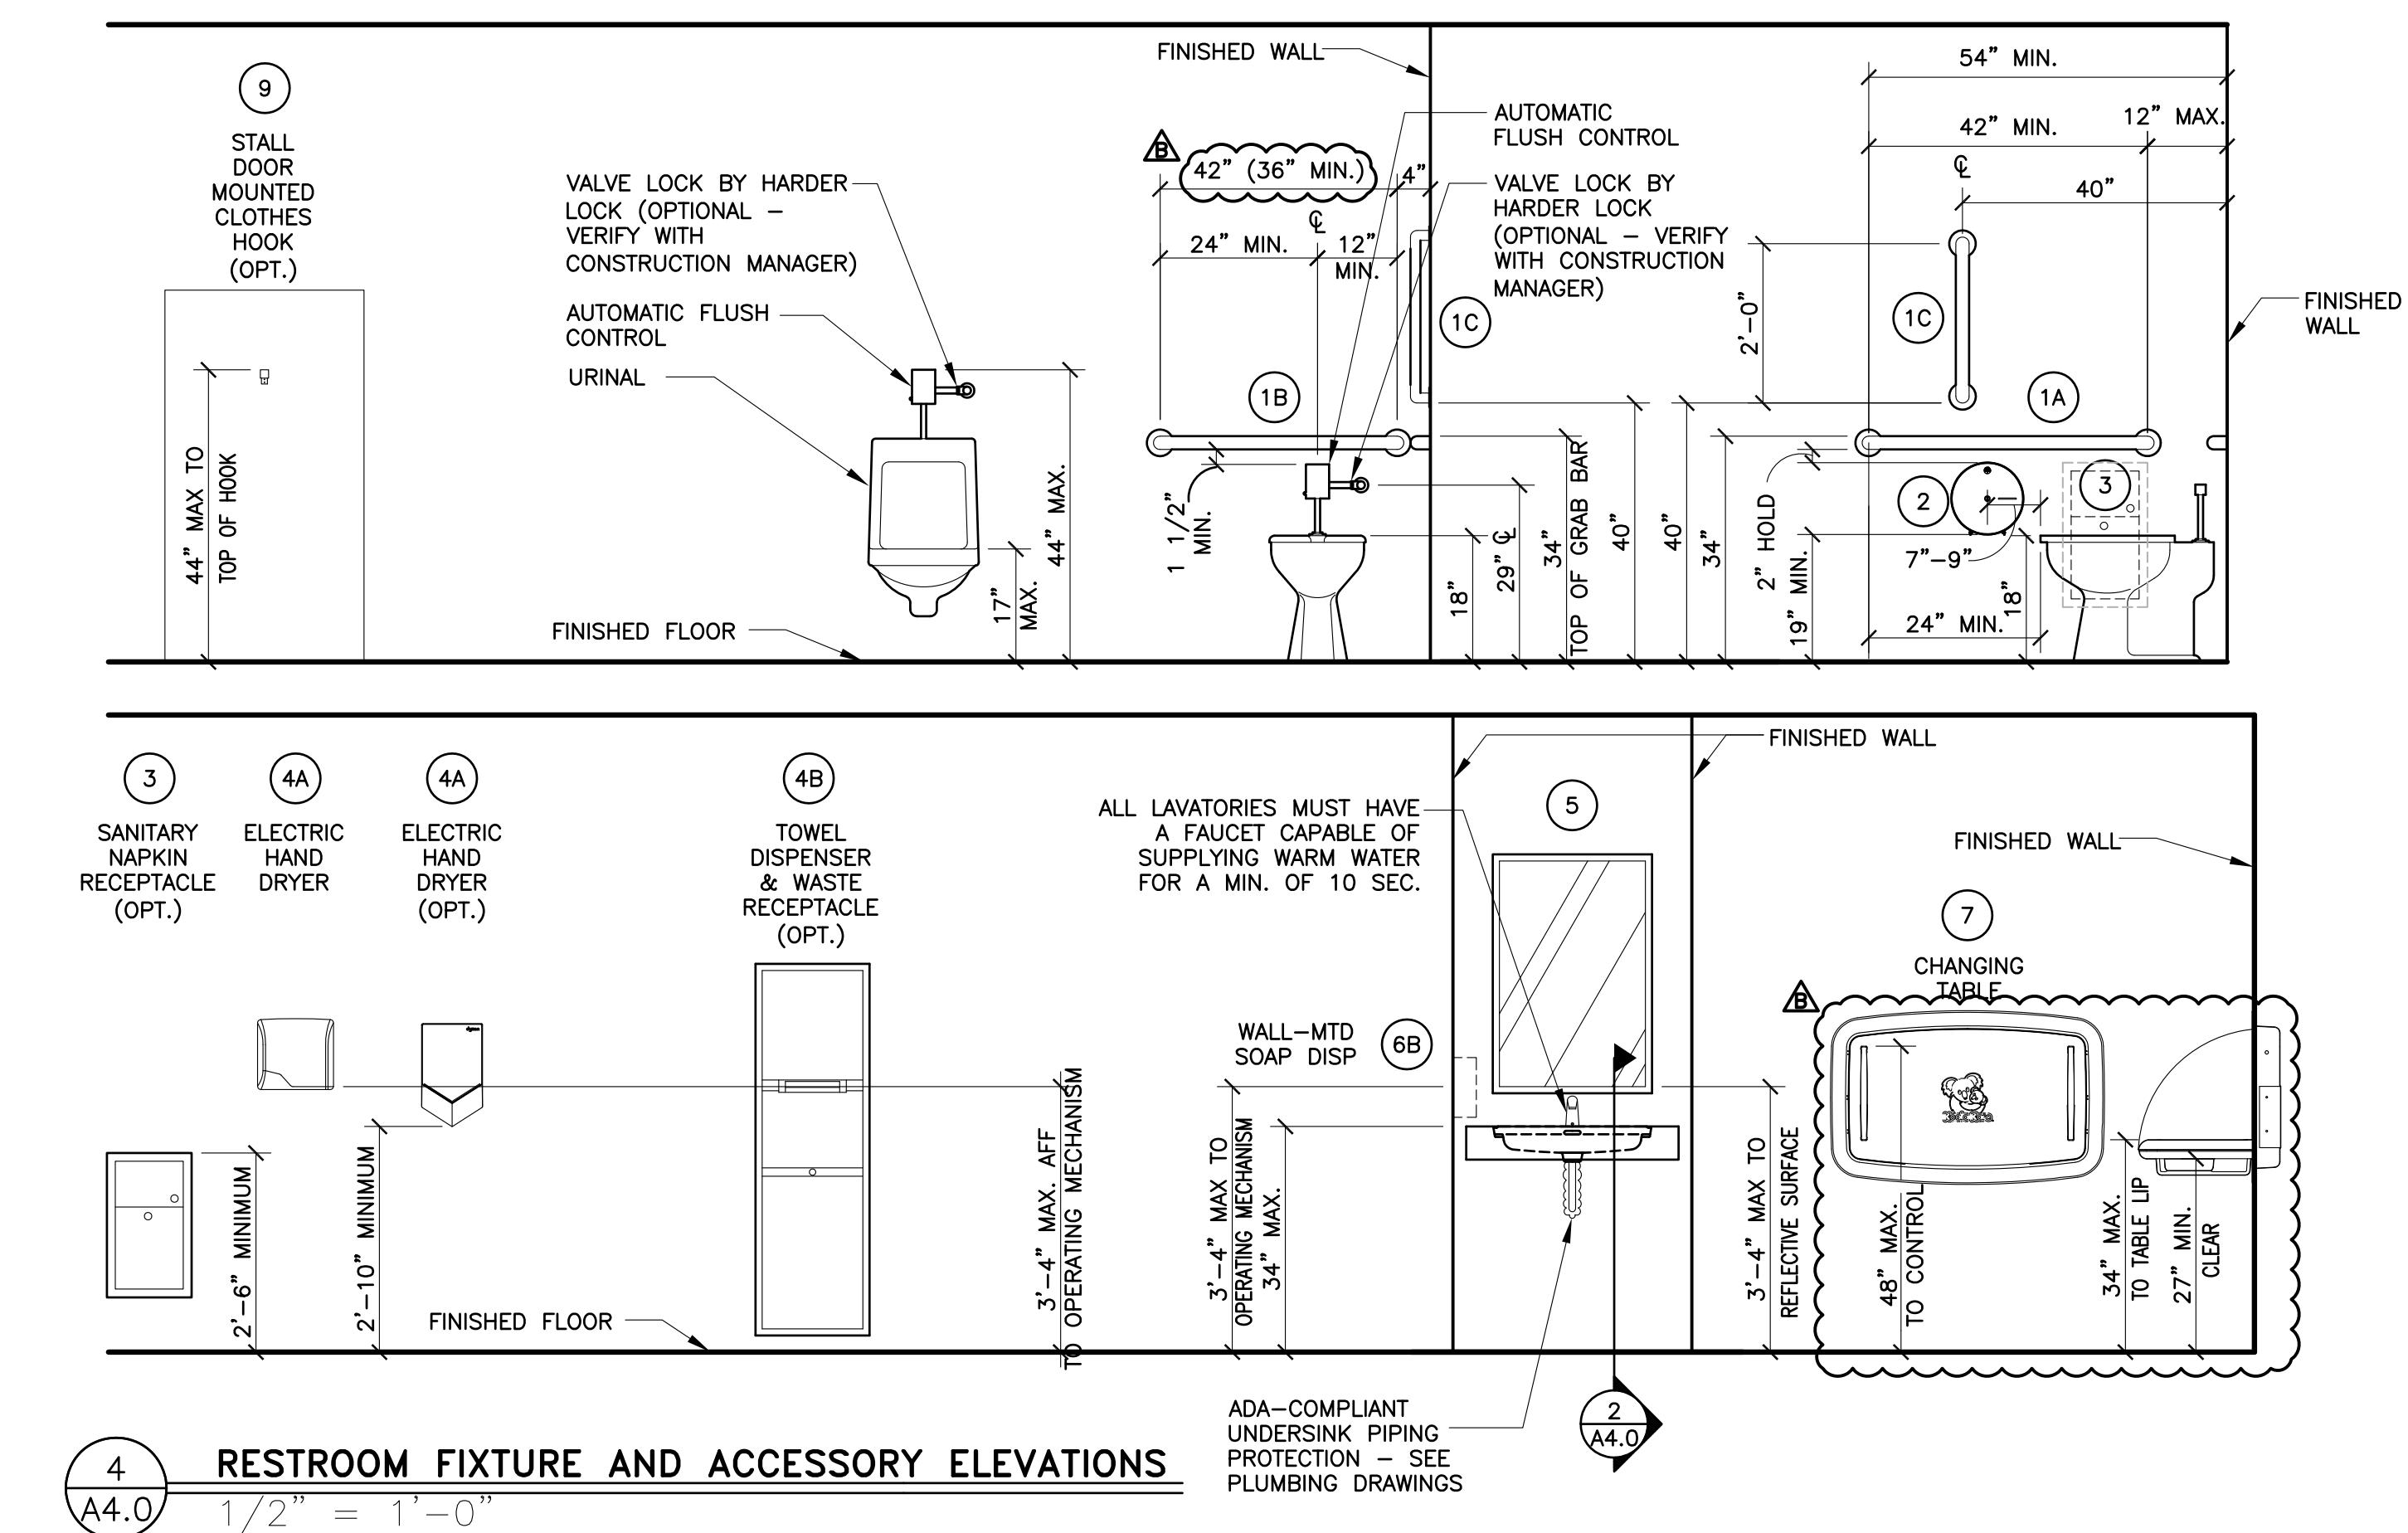

ITEM (SEE NOTE 2)	MFR MODEL #	SUPPLIER	BACKUP SUPPORT (SEE NOTE 3)
1A 1B 1C	GRAB BAR 42" GRAB BAR 42" GRAB BAR 24"	HUGHES SUPPLY (866) 310-3576 MDCCOORD@HAJOCACOM	(1)2x6 4'-0" LONG CENTER MOUNTED
2	TOILET TISSUE DISPENSER, JUMBO, SURFACE MOUNTED	BRADLEY B-5242	FRAME WALL OPENING PER MANUFACTURER'S RECOMMENDATIONS
3	SANITARY NAPKIN RECEPTACLE, RECESSED (OPTIONAL)	BOBRICK B-354	
4A 4A OPTION	HAND DRYER, ENERGY EFFICIENT MODEL, ADA, ALUMINUM BRUSHED HAND DRYER, ENERGY EFFICIENT MODEL ADA, SPRAYED NICKEL	WORLD DRYER L-971 SlimDri DYSON AIRBLADE V	FRAME WALL OPENING PER MANUFACTURER'S RECOMMENDATIONS
4B 4B OPTION	TOWEL DISPENSER & WASTE RECEPTACLE, COMBINATION, RECESSED (OPTIONAL)	BOBRICK B-3974	HUGHES SUPPLY (866) 310-3576 MDCCOORD@HAJOCACOM
5	MIRROR, CHANNEL FRAME	BOBRICK B-165 2436	
6A 6B	SOAP DISPENSER, COUNTER MOUNTED, 6" SPOUT (OPTIONAL) SOAP DISPENSER, WALL-MOUNTED	BOBRICK B-82216 BOBRICK B-2112	HUGHES SUPPLY (866) 310-3576 MDCCOORD@HAJOCACOM
7 7 OPTION	BABY CHANGING TABLE, HORIZONTAL, RECESSED, ADA COMPLIANT, STAINLESS STEEL BABY CHANGING TABLE, HORIZONTAL, SURFACE MOUNT, ADA COMPLIANT, STAINLESS STEEL	KOALA KARE KB310-SRSE KOALA KARE KB310-SWMM	INSTALL PER MANUFACTURER'S RECOMMENDATIONS
8	DIAPER CONTAINER (OPTIONAL)	-	BY OWNER
9	CLOTHES HOOK	BRADLEY 917	HUGHES SUPPLY (866) 310-3576 MDCCOORD@HAJOCACOM

ITEM	DESCRIPTION	STD ISSUE DATE	REV'D BY	DATE ISSUED	SITE ADDRESS
2019 STANDARD BUILDING - BB20 4597E10-WOOD/WOOD	WOOD BEARING WALLS W/FIBER CEMENT SIDING & CI WOOD ROOF TRUSS FRAMING FIBER CEMENT PANEL/BATTEN/AUPOVIC PANEL/BRICK EXTER. FINISH	2019-11	KO	01/23/20	605 SOUTH 7TH STREET, KANSAS CITY, KS

McDonald's USA, LLC
Architect, Inc.
DESIGN

12400 ARCHITECTURE & PLANNING,
LANDSCAPE AVENUE SOUTH,
BURNSVILLE, MN 55337
EMAIL: DATARESPONSES.COM
PHONE: (952) 252-4042
FAX: (952) 252-4043

©2020 McDonald's USA, LLC
These drawings and specifications are the confidential and proprietary documents of McDonald's USA, LLC and shall not be reproduced or distributed outside the specific contract documents without the express written consent of McDonald's USA, LLC. These drawings and specifications are intended for use on this specific project only. They are not to be used for any other purpose or reference, or exemplified on another project. Reproduction, services or distribution of these drawings and specifications, or any portion thereof, without the express written consent of McDonald's USA, LLC, is unauthorized and is prohibited.

PREPARED BY:
McDonald's USA, LLC
12400 ARCHITECTURE & PLANNING,
LANDSCAPE AVENUE SOUTH,
BURNSVILLE, MN 55337
EMAIL: DATARESPONSES.COM
PHONE: (952) 252-4042
FAX: (952) 252-4043

DRAWN BY:
McDonald's USA, LLC
12400 ARCHITECTURE & PLANNING,
LANDSCAPE AVENUE SOUTH,
BURNSVILLE, MN 55337
EMAIL: DATARESPONSES.COM
PHONE: (952) 252-4042
FAX: (952) 252-4043

STD ISSUE DATE:
2019-11
REVIEWED BY:
KO

DATE ISSUED:
01/23/20
BY:
OWNER

RD#19175
015-0071.00.B

SHEET NO. 3
A4.0
RESTROOM PLAN
Title
Description
Site ID
Site Address
Registration Number
Date
By

<p>CLOSURE DETAIL @ COOLER A4.1 1 1/2"=1'-0"</p>	<p>BATTEN TO BRICK TRANSITION A4.1 1 1/2"=1'-0"</p>	<p>DOOR JAMB @ F/C DOOR A4.1 1 1/2"=1'-0"</p>	<p>EXT.DORR JAMB DETAIL A4.1 1 1/2"=1'-0"</p>	<p>CREW WINDOW JAMB DETAIL A4.1 1 1/2"=1'-0"</p>
<p>ORDER WINDOW JAMB DETAIL A4.1 1 1/2"=1'-0"</p>	<p>EXPANSION JOINT DETAILS A4.1 1 1/2"=1'-0"</p>	<p>DETAIL @ COLUMN A4.1 1 1/2"=1'-0"</p>	<p>NOT USED A4.1 -</p>	<p>BATTEN TO FIBER CEMENT PANEL TRANSITION A4.1 1 1/2"=1'-0" 4597 ONLY</p>
<p>CORNER DETAIL @ ENTRY A4.1 1 1/2"=1'-0" 4597 ONLY</p>	<p>DETAIL @ COLUMN A4.1 1 1/2"=1'-0" 4597 ONLY</p>	<p>NOT USED A4.1 -</p>	<p>NOT USED A4.1 -</p>	<p>NOT USED A4.1 -</p>
<p>ALUMINUM BATTEN DETAIL A4.1 1/4"=1'-0"</p>	<p>SECTION A: PLAN DETAIL AT BATTENS SCALE: 3'=1'-0" ALL SUBSTRATE, HAT CHANNELS AND TRIM BY GC.</p>	<p>ELEVATION DETAIL AT BATTEN JOINTS SCALE: 1 1/2"=1'-0" PRIME AND PAINT ALL SIDES AND EDGES PRIOR TO INSTALLING</p>	<p>NOT USED A4.1 -</p>	<p>NOT USED A4.1 -</p>

I hereby certify that the above specification or drawing was prepared under my direct supervision and control by me, a registered Architect, and was registered with the State of Kansas Board of Architecture and Engineering.



Signature: Brian A. McDonald, AIA
Title: Architect
Registration Number: 01/23/20
Date: 01/23/20




DESIGN
12400 PORTLAND AVENUE SOUTH
BURNSVILLE, MN 55337
PHONE: (952) 252-4042
FAX: (952) 252-4943

©2020 McDonald's USA, LLC
McDonald's USA, LLC

DRAWN BY: DIA STD ISSUE DATE: REVIEWED BY:
DRAWN BY: DIA STD ISSUE DATE: REVIEWED BY:
TITLE: 2019 STANDARD BUILDING - BB20 STD ISSUE DATE: 2019-11 REVIEWED BY:
DESCRIPTION: 4597F10-WOOD/WOOD DIA STD ISSUE DATE: 01/23/20 REVIEWED BY:
WOOD BEARING WALLS W/FIBER CEMENT SIDING & CI STD ISSUE DATE: 01/23/20 REVIEWED BY:
WOOD ROOF TRUSSES FRAMING STD ISSUE DATE: 01/23/20 REVIEWED BY:
FIBER CEMENT PANEL/BATTEN/AUPOIC PANEL/BRICK EXT. FINISH STD ISSUE DATE: 01/23/20 REVIEWED BY:
SITE ID: 015-0071 SITE ADDRESS: 605 SOUTH 7TH STREET, KANSAS CITY, KS
SHEET NO. 015-0071.000 DRAWN BY: DIA STD ISSUE DATE: 01/23/20 REVIEWED BY:
PLAN DETAILS A4.1

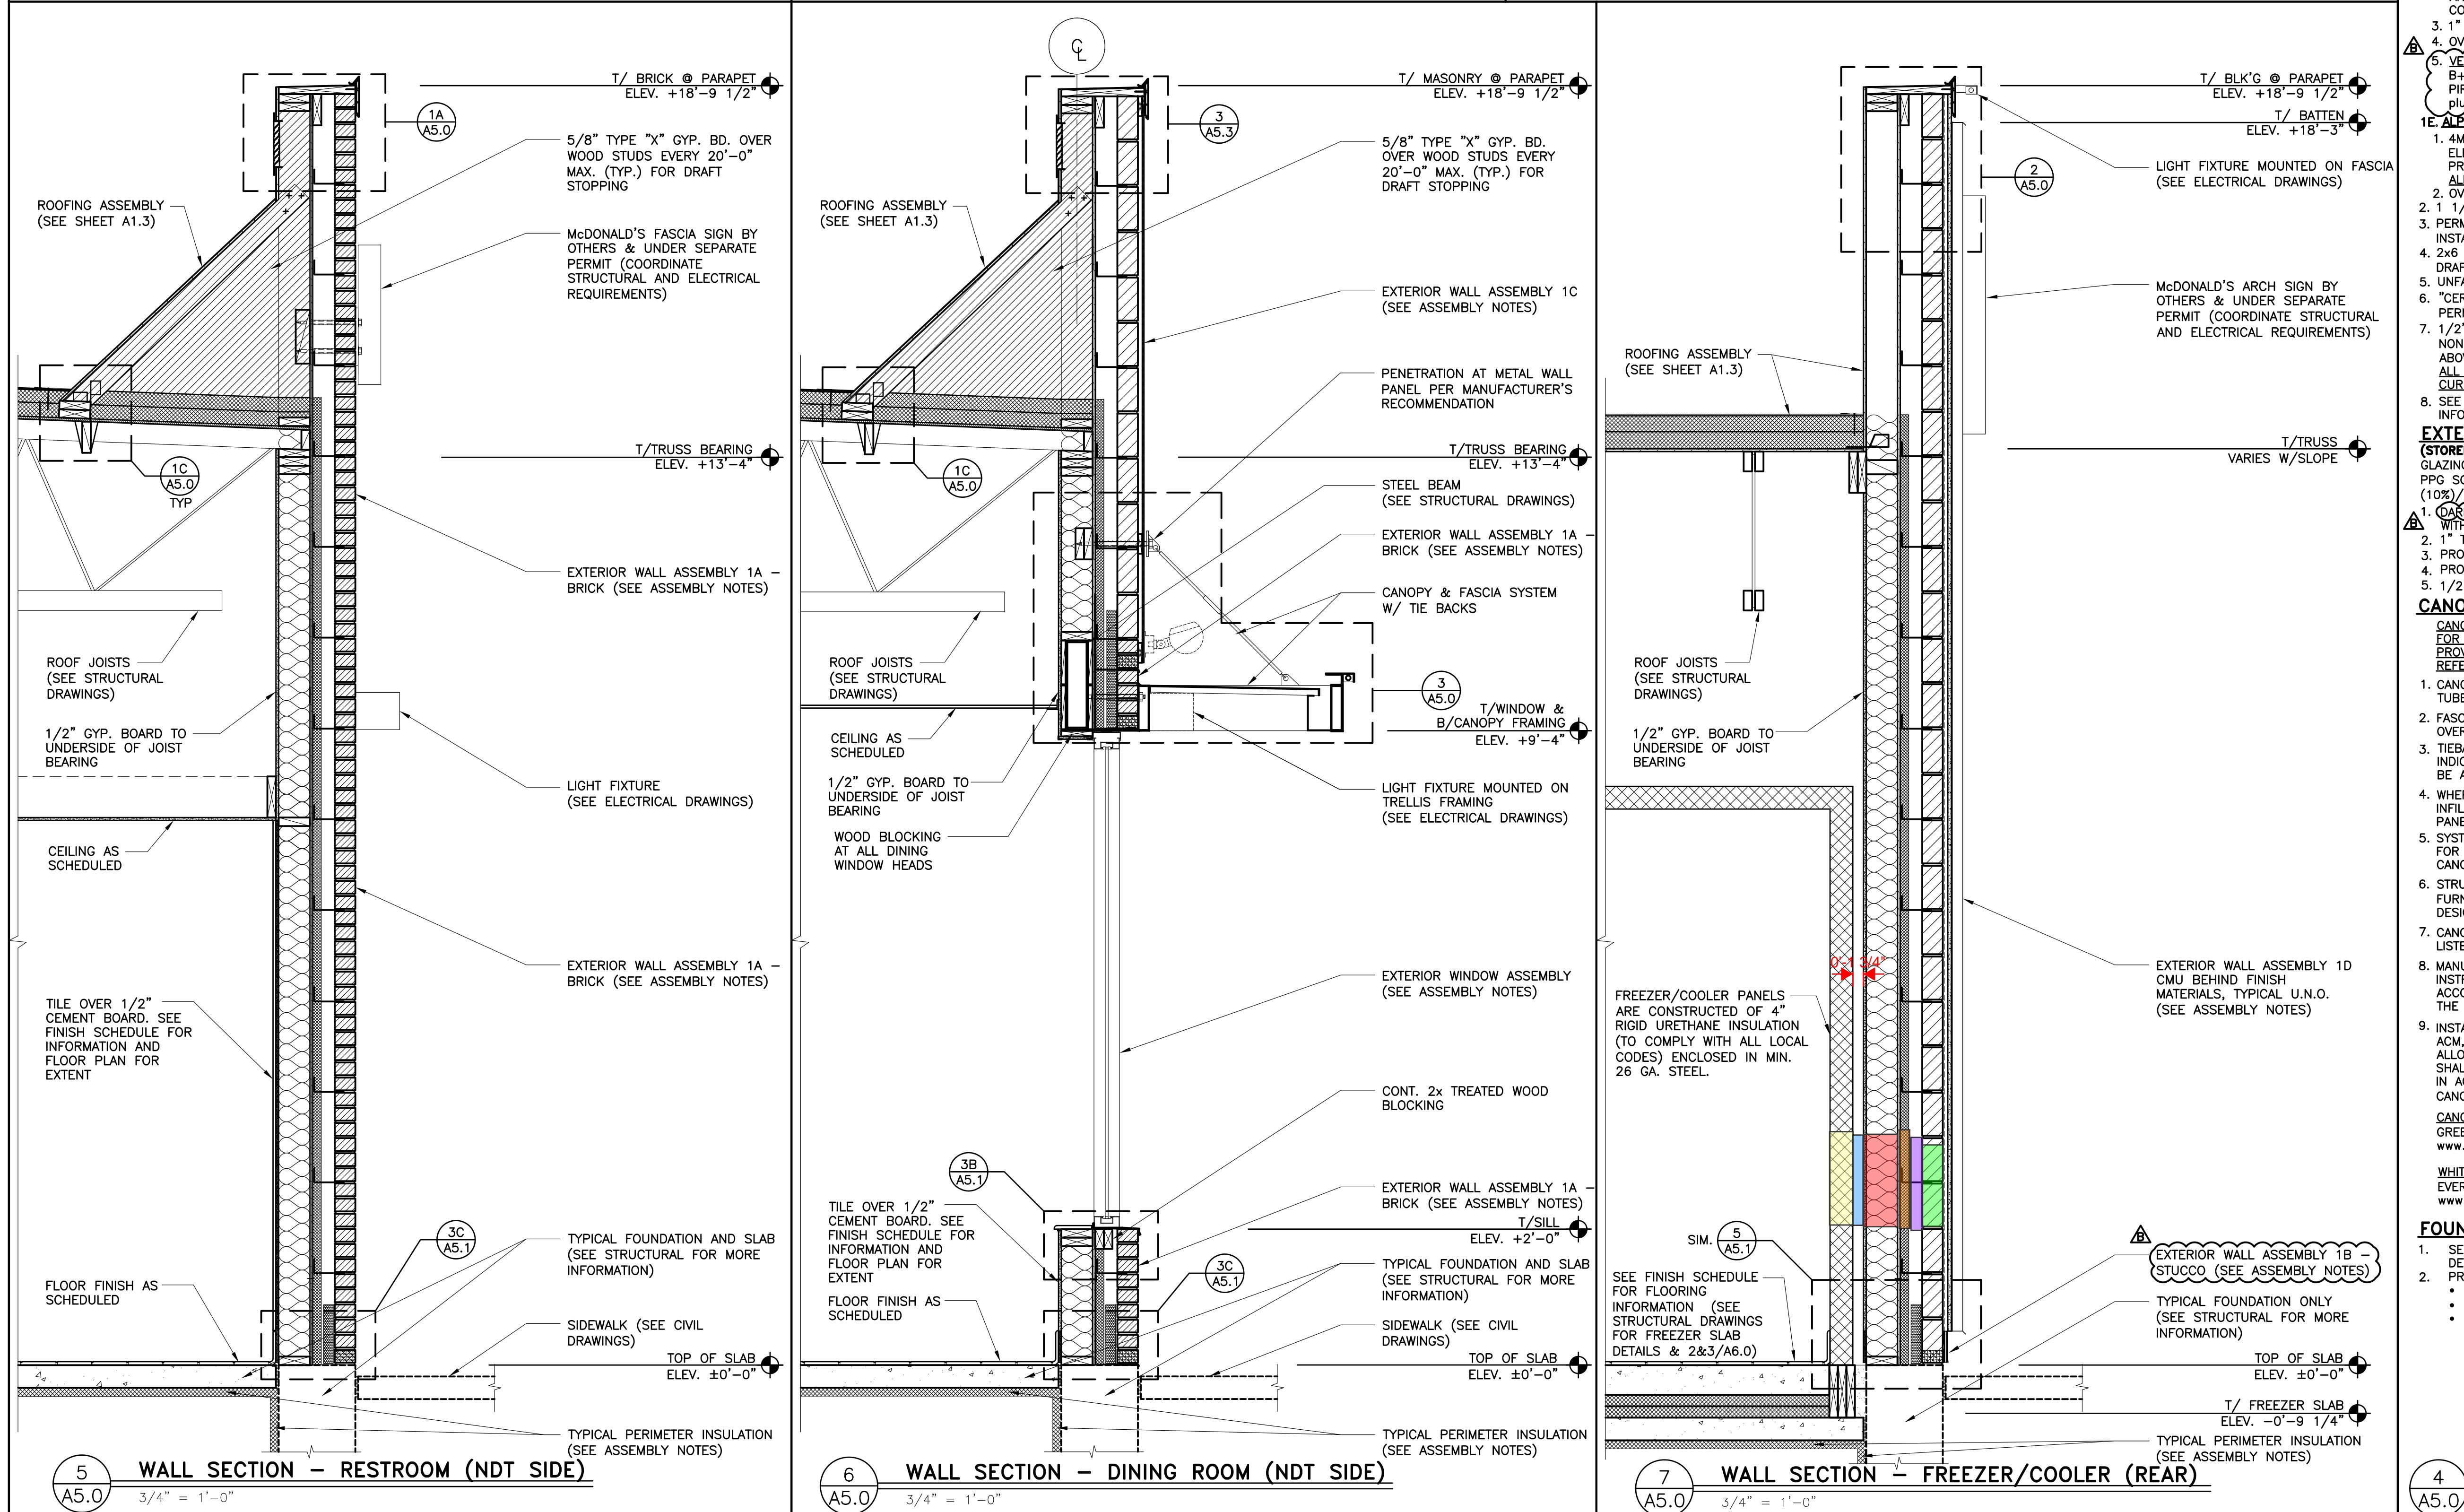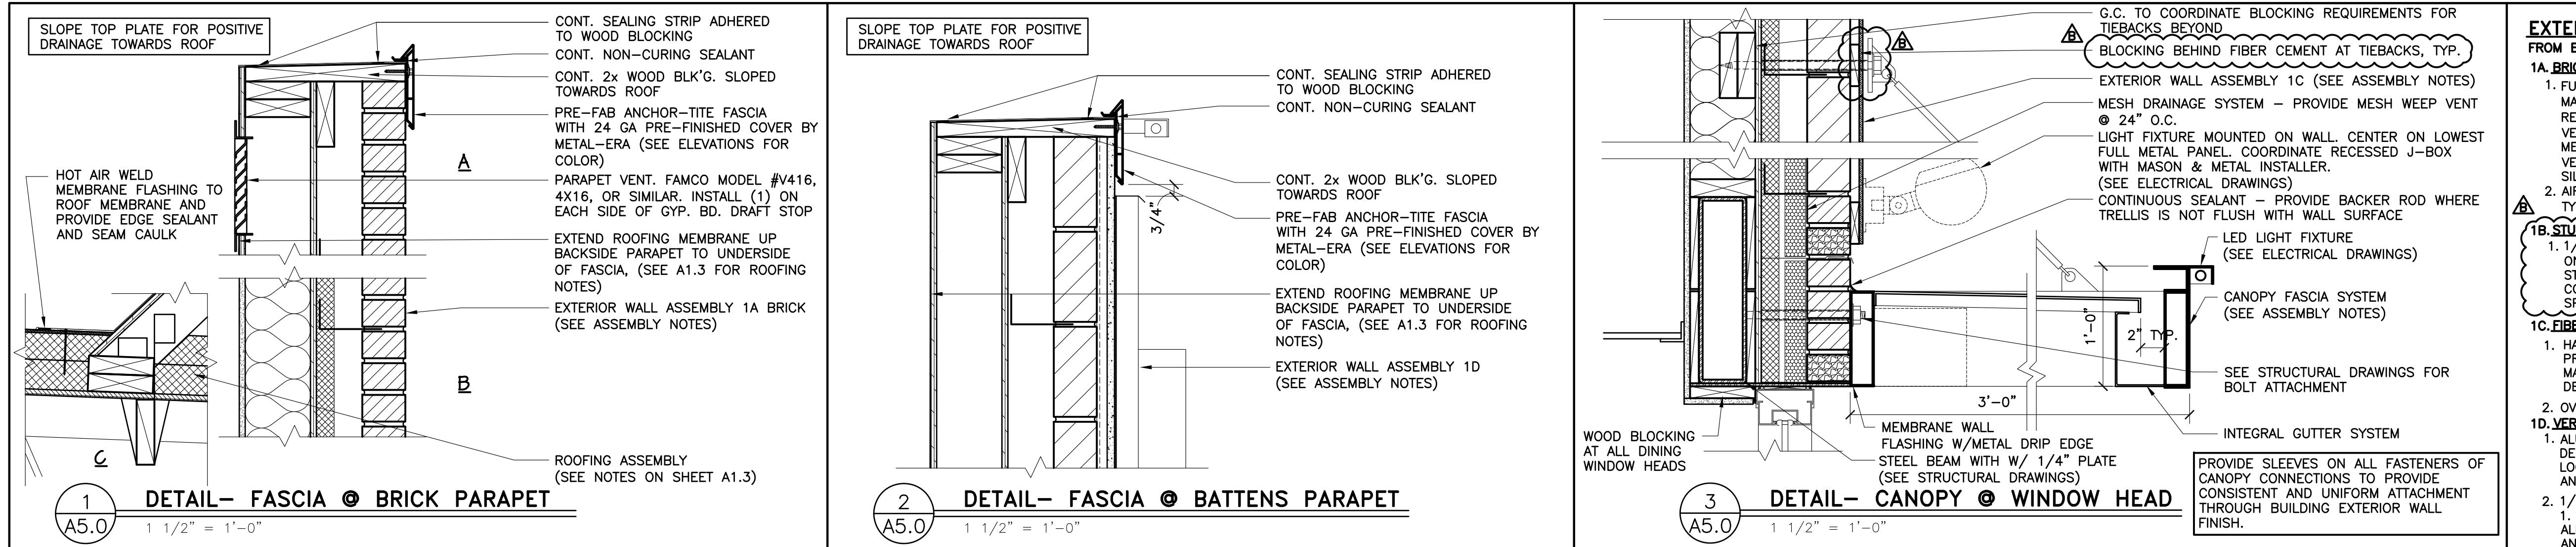

SHEET NO.	TITLE	DRAWN BY	REV'D BY	STD ISSUE DATE	DATE ISSUED	SITE ID	DESCRIPTION	BY
015-0071.00.B	2019 STANDARD BUILDING - BB20	DIA	KD	2019-11	01/23/20	015-0071	WOOD BEARING WALLS W/FIBER CEMENT SIDING & CI WOOD ROOF TRUSS FRAMING FIBER CEMENT PANEL/BATTEN/ALPOLIC PANEL/BRICK EXT. FINISH	REPRENISE

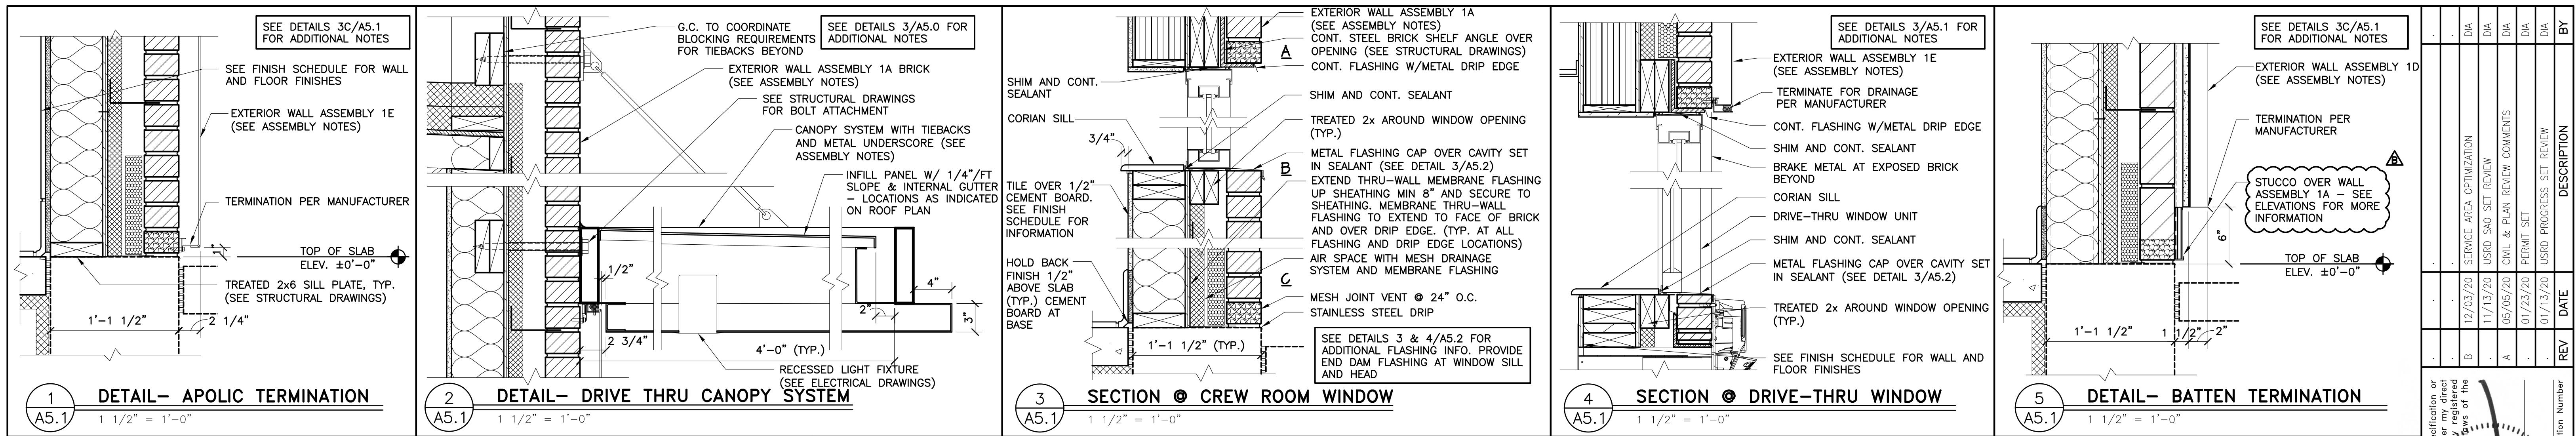

Registration Number

Date

Signature

Architect, Inc.

DESIGN

McDonald's USA, LLC

PREPARED BY:

DIA

12/03/20

12/03/20



12/03/20

12/03/20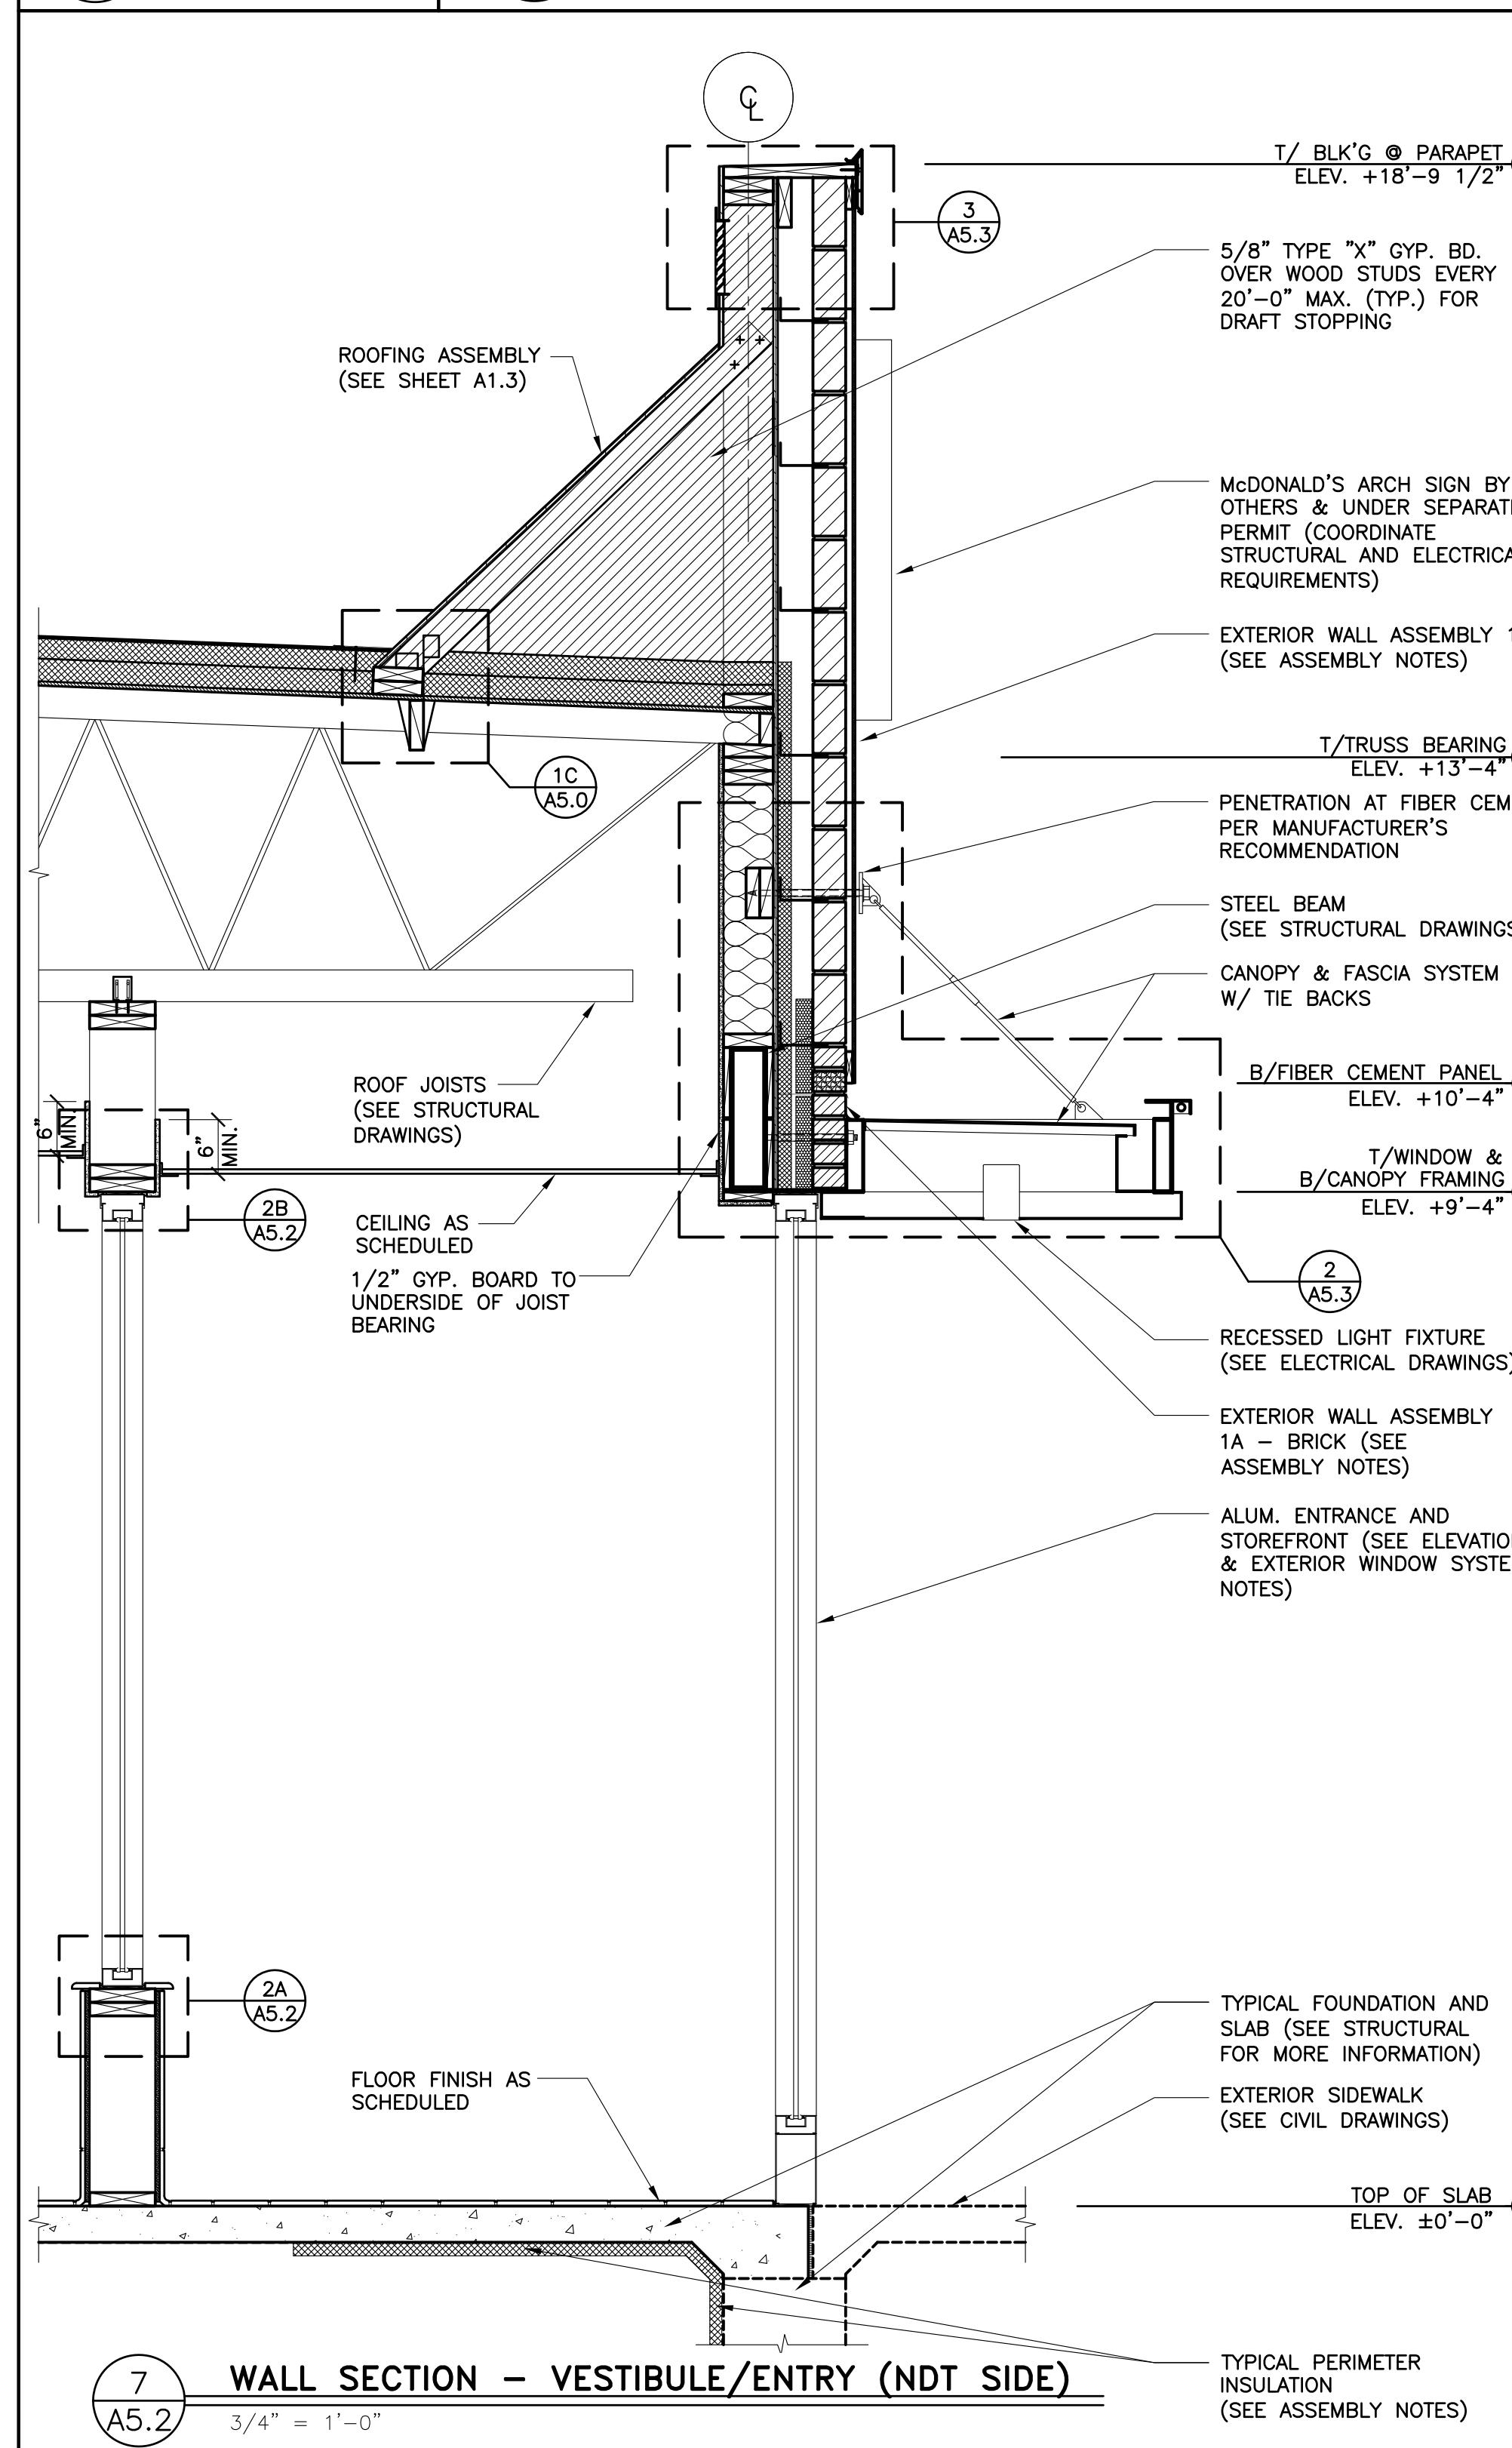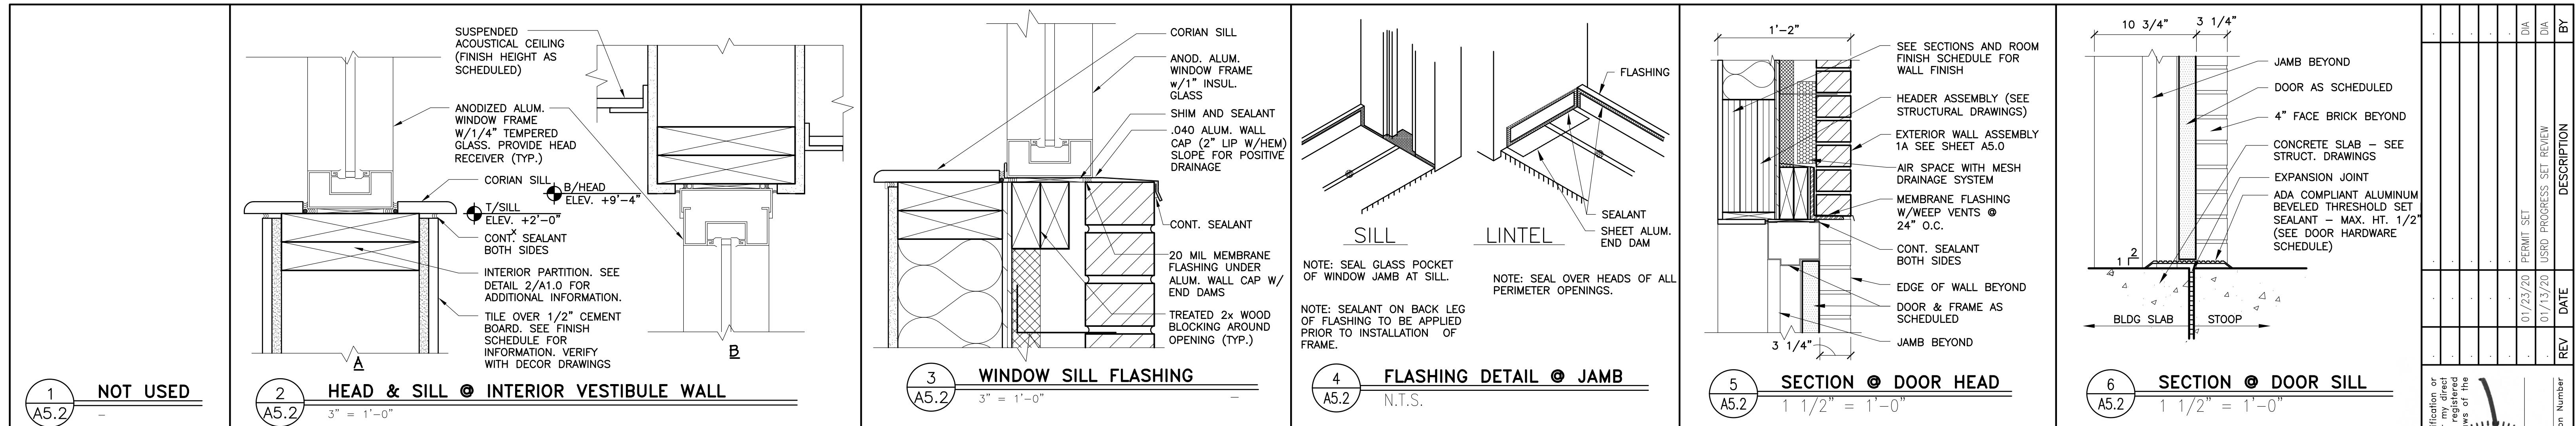

DESIGN	Architecture, INC.	Signature	BRIAN JONATHAN	Registration Number	REV	DATE	DESCRIPTION	BY
	Reprise DESIGN		J. B. JONES ARCHITECT State of KANSAS	5420	01/23/20	01/23/20	PERMIT SET	DIA
					01/13/20	01/13/20	USRD PROGRESS SET REVIEW	DIA
								BY


I hereby certify that this plan, specification or report was prepared under my direct supervision and direction and is duly registered under the laws of the State of KANSAS.



ARCHITECTURE & PLANNING
12400 PORTLAND AVENUE SOUTH,
SUITE 100
BURNSVILLE, MN 55337
EMAIL: DATA@REPRISEDESIGN.COM

2019 STANDARD BUILDING – BB20		4597F10-WOOD/WOOD	
DESCRIPTION		DIA	STD ISSUE DATE
WOOD BEARING WALLS W/FIBER CEMENT SIDING & Ci WOOD ROOF TRUSS FRAMING FIBER CEMENT PANEL/BATTEN/ALPOLIC PANEL/BRICK EXT. FINISH		REVIEWED BY KD	DATE ISSUED 01/23/20
SITE ID	SITE ADDRESS	RD#19175	
015-0071	605 SOUTH 7TH STREET, KANSAS CITY, KS		
015-0071.00.0			
A5.2			
WALL SECTIONS			

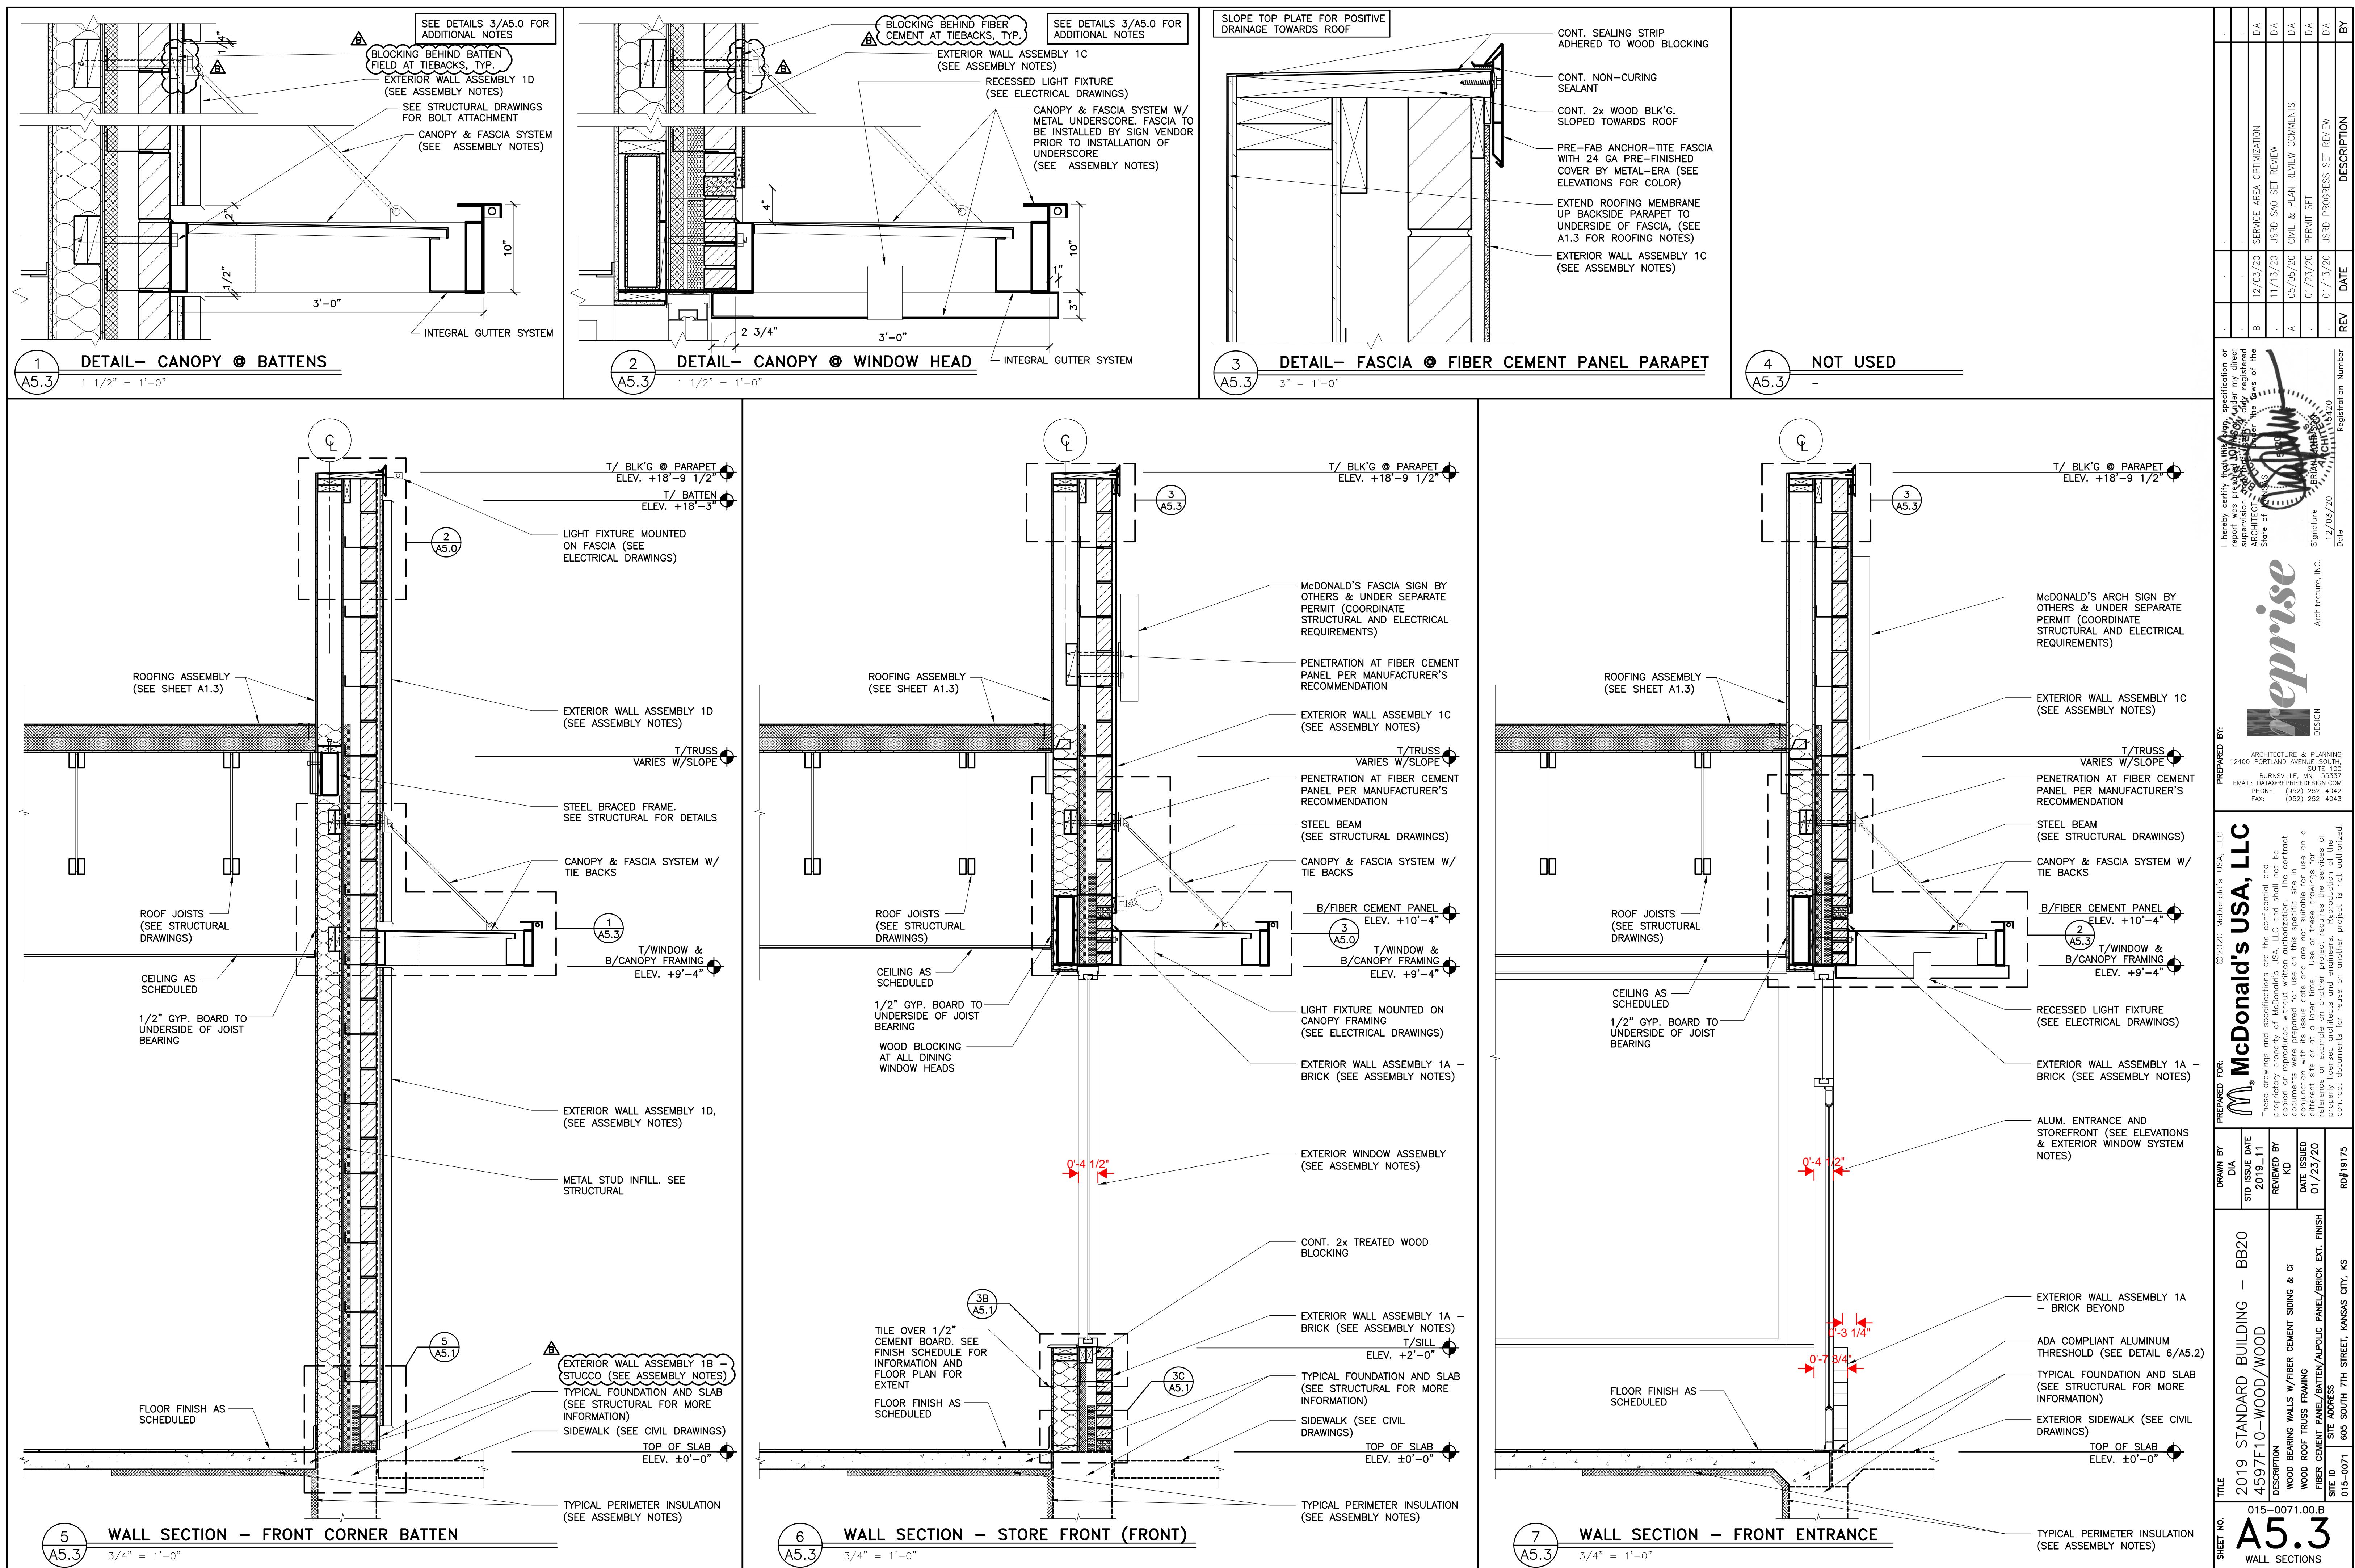

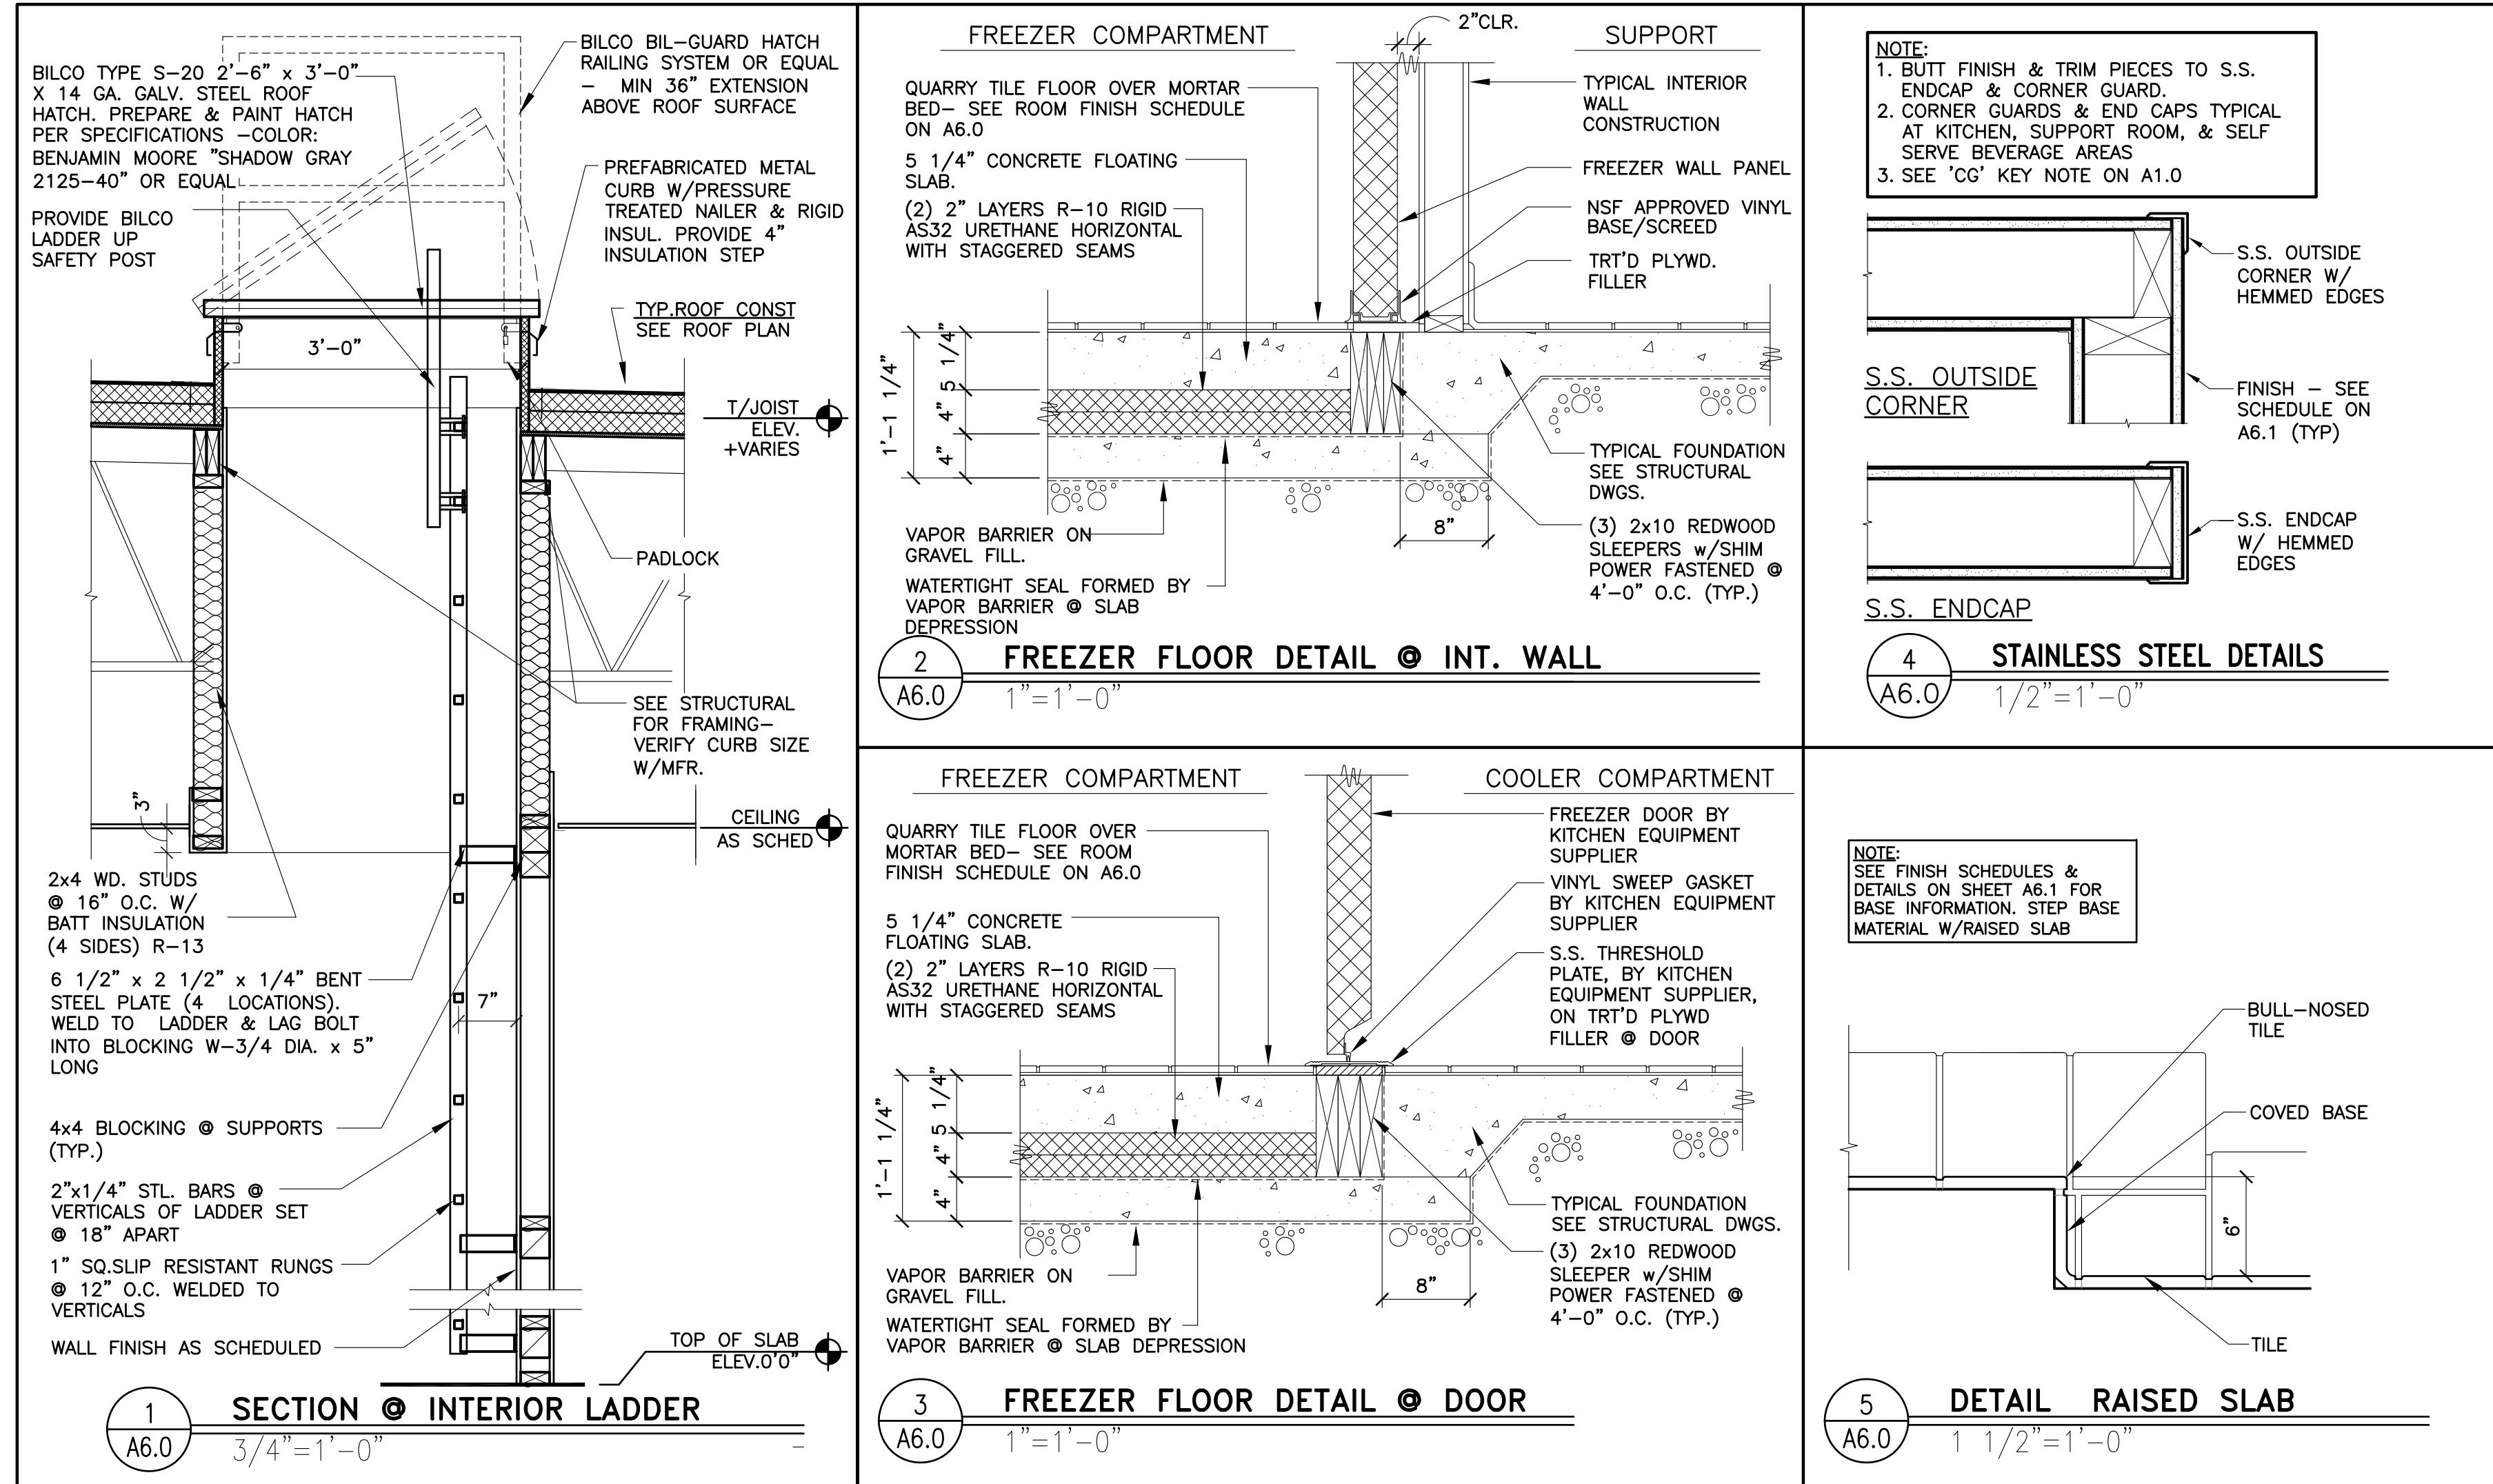

DOOR HARDWARE

GENERAL NOTES:

1. ALL EXIT DOORS SHALL BE KEYLESS IN THE DIRECTION OF EGRESS.
2. THE OPENING FORCE OF ALL EXT. PUSH/PULL DOORS SHALL NOT EXCEED 8 1/2 LBS.
3. THE OPENING FORCE OF ALL INTERIOR PUSH/PULL DOORS SHALL NOT EXCEED 5 LBS.
4. PROVIDE PANIC HARDWARE FOR ALL EXTERIOR DOORS AS NOTED ON THE DOOR SCHEDULE.
5. ALL DOOR HARDWARE SHALL NOT REQUIRE TIGHT GRASPING, TIGHT PINCHING OR TWISTING OF THE WRIST TO OPERATE.

DOOR #1 A – ENTRY DOOR/EMERGENCY EXIT (1A NOT USED)

- 1 EA CLOSER LCN 4021 x 18
2. 3 EA HINGES OFFSET PIVOT ANSI -A-156.4 GRADE 1; PROVIDE EXPOSED PARTS OF CAST ALUMINUM ALLOY, AS SUPPLIED BY DOOR MANUFACTURER.
3. 1 EA (DOOR #1 ONLY) PULL HANDLE ROCKWOOD MFG. MODEL: RM3301. SIZE: 1-1/4" DIAMETER FINISH: TO MATCH STOREFRONT DOOR. OFFSET MOUNTING: TYPE 1XHD – THRU BOLT HEAVY DUTY
4. 1 EA PANIC HARDWARE ADAMS RITE MFG. CO. 8800 SERIES WITH OUTSIDE CYLINDER (FINISH TO MATCH STOREFRONT DOOR)
5. 1 EA THRESHOLD NATIONAL GUARD PRODUCTS, INC. SADDLE TYPE THRESHOLD 325, 36" WIDE x 1/2" RISE (ADA ACCESSIBLE).
6. 1 EA WEATHER STRIPPING: PROVIDE COMPRESSION WEATHER STRIPPING AGAINST FIXED STOPS. AT OTHER EDGES PROVIDE SLIDING WEATHER STRIPPING RETAINED IN ADJUSTABLE STRIP MORTISED INTO DOOR EDGE. PROVIDE EPDM OR VINYL GASKET WEATHER STRIPPING IN BOTTOM DOOR RAIL ADJUSTABLE FOR CONTACT W/ THRESHOLD.
7. 1 EA SIGN MOUNT ONTO DOOR, TO READ "THIS DOOR MUST REMAIN UNLOCKED WHENEVER THE BUILDING IS OCCUPIED/DURING BUSINESS HOURS."

DOOR #2 – VESTIBULE

- 1 EA CLOSER LCN 4041 x 18
2. 3 EA HINGES OFFSET PIVOT ANSI -A-156.4 GRADE 1; BY DOOR MANUFACTURER.
3. 1 EA PUSH/PULL HANDLE HAGER PUSH/PULL SET 164D/V/B.

DOOR #3 – STORAGE DELIVERY

- 1 EA HINGE 780-112HD 83" ALUM HAGER
2. 1 EA CLOSER 4111 H-CUSH ALUM LCN
3. 1 EA PANIC 9975EO-LD 48" SP28 V.DUPRIN
4. 1 EA TRIM 990DT US26D V.DUPRIN
5. 1 EA EXIT ALARM EAX2500 FLUSH DETEX
6. 1 EA LOCKGUARD CLP110 US32D DON-JO
7. 1 EA TREADPLATE 24 X 46 UMCO
8. 1 EA WTH/STP160V 48 X 84 N.GUARD
9. 1 EA THRESHOLD 325HD 48" N.GUARD
10. 1 EA SWEEP 101VA 48" N.GUARD
11. 1 EA VIEW FRAME LVGLFMD 9 X 9 DKB W/FLAP ON INSIDE N.GUARD

DOOR #3A – FREEZER DELIVERY

- 1 EA HINGE780-112HD 83" ALUM HAGER
2. 1 EA DEADBOLT B661P 626 SCHLAGE
3. 1 EA PULL H3E US28 HAGER
4. 1 EA LOCKGUARD CLP110 US32D DON-JO
5. 1 EA TREADPLATE 24 X 46 UMCO
6. 1 EA WTH/STP 160V 48 X 84 N.GUARD
7. 1 EA THRESHOLD 325HD 48" N.GUARD
8. 1 EA SWEEP 101VA 48" N.GUARD

DOOR #4 – REAR EXIT

- 1 EA HINGE 780-112HD 83" ALUM HAGER
2. 1 EA CLOSER 4111 H-CUSH ALUM LCN
3. 1 EA PANIC 9975EO-LD 36" SP28 V.DUPRIN
4. 1 EA TRIM 990DT US26D V.DUPRIN
5. 1 EA EXIT ALARM EAX2500 FLUSH DETEX
6. 1 EA LOCKGUARD CLP110 US32D DON-JO
7. 1 EA TREADPLATE 24 X 34 UMCO
8. 1 EA WTH/STP160V 36 X 84 N.GUARD
9. 1 EA THRESHOLD 325HD 36" N.GUARD
10. 1 EA SWEEP 101VA 36" N.GUARD
11. 1 EA VIEW FRAME LVGLFMD 9 X 9 DKB W/FLAP ON INSIDE N.GUARD

DOOR #5 – RESTROOM ENTRY

1. 3 EA HINGE BB1279 4 ½ X 4 ½ US26D HAGER
2. 1 EA CLOSER LDPA4031 SNB ALUM LCN
3. 1 EA PUSH PLATE 30S 4 X 32 US32D 40" AFF MOUNTED TO CENTER OF PLATE
4. 1 EA PULL PLATE LADDER PULL HANDLE WITH DECORATIVE FIXING, 32" L 1" DIA
#S-32-1000 – UMCO 32D. 40" AFF MOUNTED CENTER OF PULL
ALT. OPTION: 1 EA PULLPLATE SANITGRASP
5. 2 EA KICKPLATE 190S 8 X 34 US32D HAGER
6. 1 EA DOOR STOP 236W US32D HAGER
7. 1 EA FINGER GRD MKIA PUSH SIDE BRN F.SAFE
8. 1 EA FINGER GRD MKIB PULL SIDE BRN F.SAFE
9. 1 EA STEPNPULL PULL SIDE (OPTIONAL)

DOOR #6 – ADA STALL

5'-10".

1. 2 EA HINGE 1250 4 ½ X 4 ½ US26D HAGER
2. 1 EA HINGE BB1279 4 ½ X 4 ½ US26D HAGER
3. 1 EA DEADBOLT B571 X 10-087 214EE X 12 X 291 X 626
4. 2 EA BACK TO BACK LADDER PULL HANDLE, 16" L, 1" DIA #S-16-1000 BTB-UMCO 32D
MOUNTED 6" FROM EDGE OF DOOR TO CENTER OF SCREWS – 28½"
MOUNTED 28½" FROM TOP OF DOOR TO C/L OF PULL
5. 1 EA ROBE HOOK 917 BRADLEY
6. 1 EA DOOR STOP 236W US32D HAGER

DOOR #6A – STANDARD STALL

1. 2 EA HINGE 1250 4 ½ X 4 ½ US26D HAGER
2. 1 EA HINGE BB1279 4 ½ X 4 ½ US26D HAGER
3. 1 EA DEADBOLT B571 X 10-087 214EE X 12 X 291 X 626
4. 2 EA BACK TO BACK LADDER PULL HANDLE, 16" L, 1" DIA #S-16-1000 BTB-UMCO 32D
MOUNTED 6" FROM EDGE OF DOOR TO CENTER OF SCREWS – 28½"
MOUNTED 28½" FROM TOP OF DOOR TO C/L OF PULL
5. 1 EA ROBE HOOK 917 BRADLEY
6. 1 EA DOOR STOP 236W US32D HAGER

DOOR #7 – DINING ROOM JANITORS CLOSET

1. 3 EA HINGE BB1279 4 ½ X 4 ½ US26D HAGER
2. 1 EA LOCK ND80PD RHO 626 SCHLAGE

DOOR #8 – COMPUTER CLOSET

1. 4 EA HINGE BB1279 4 ½ X 4 ½ US26D HAGER
2. 1 EA LOCK ND80PD RHO 626 SCHLAGE
3. 1 EA LOUVER L700RX DKB 12 X 18 N.GUARD

DOOR #8A – COMPUTER CLOSET

1. 8 EA HINGE BB1279 4 ½ X 4 ½ US26D HAGER

R #10 CREW

1 EA HINGE 780-112HD 83" ALUM HAGER
1 EA CLOSER 1461 RW/PA ALUM LCN
1 EA PANIC 9975EO-LD 36" SP28 V.DUPRIN 
1 EA ELEC STRIKE 621T 24V DC FSE US32D SCHLAGE
1 EA PWR SUPPLY PS902 SCHLAGE
1 EA DOOR BELL BSV-24P SURFACE MOUNTED
3 EA PUSH BUTTON 621-RD-DA HDP 626 SCHLAGE
1 EA TREADPLATE 24 X 34 UMCO
1 EA VIEW FRAME LFRA100 6 X 27 DKB N.GUARD
1 EA GLASS 5 X 26 X 1/4 UMCO

R #14 (NOT USED) MANAGERS OFFICE

3 EA HINGE BB1279 4 1/2 X 4 1/2 US26D HAGER
1 EA LOCK ND53PD RHO 626 SCHLAGE
1 EA VIEW FRAME LFRA100 24 X 30 DKB N.GUARD
1 EA GLASS 23 X 29 X 1/4 CLEAR UMCO


R #15 CO2

1 EA HINGE 780-112HD 83" ALUM HAGER
1 EA LOCK ND80PD RHO 626 SCHLAGE
1 EA LOCK GUARD CLP110 US32D DON JO
1 EA WTH/STP 160V 36 X 84 N.GUARD
1 EA THRESHOLD 425E 36" N.GUARD
1 EA SWEEP 101VA 36" N.GUARD
1 EA SEC. LOUVER LVRSG-3 DKB 18 X 18 N.GUARD

R #16 (NOT USED) CREW ROOM


3 EA HINGE BB1279 4 1/2 X 4 1/2 US26D HAGER
1 EA LOCK ND10S RHO 626 SCHLAGE
1 EA VIEW FRAME LFRA100 24 X 30 DKB N.GUARD
1 EA GLASS 23 X 29 X 1/4 CLEAR UMCO

DOOR SCHEDULE

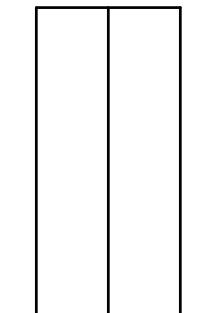

E

DOOR TYPES

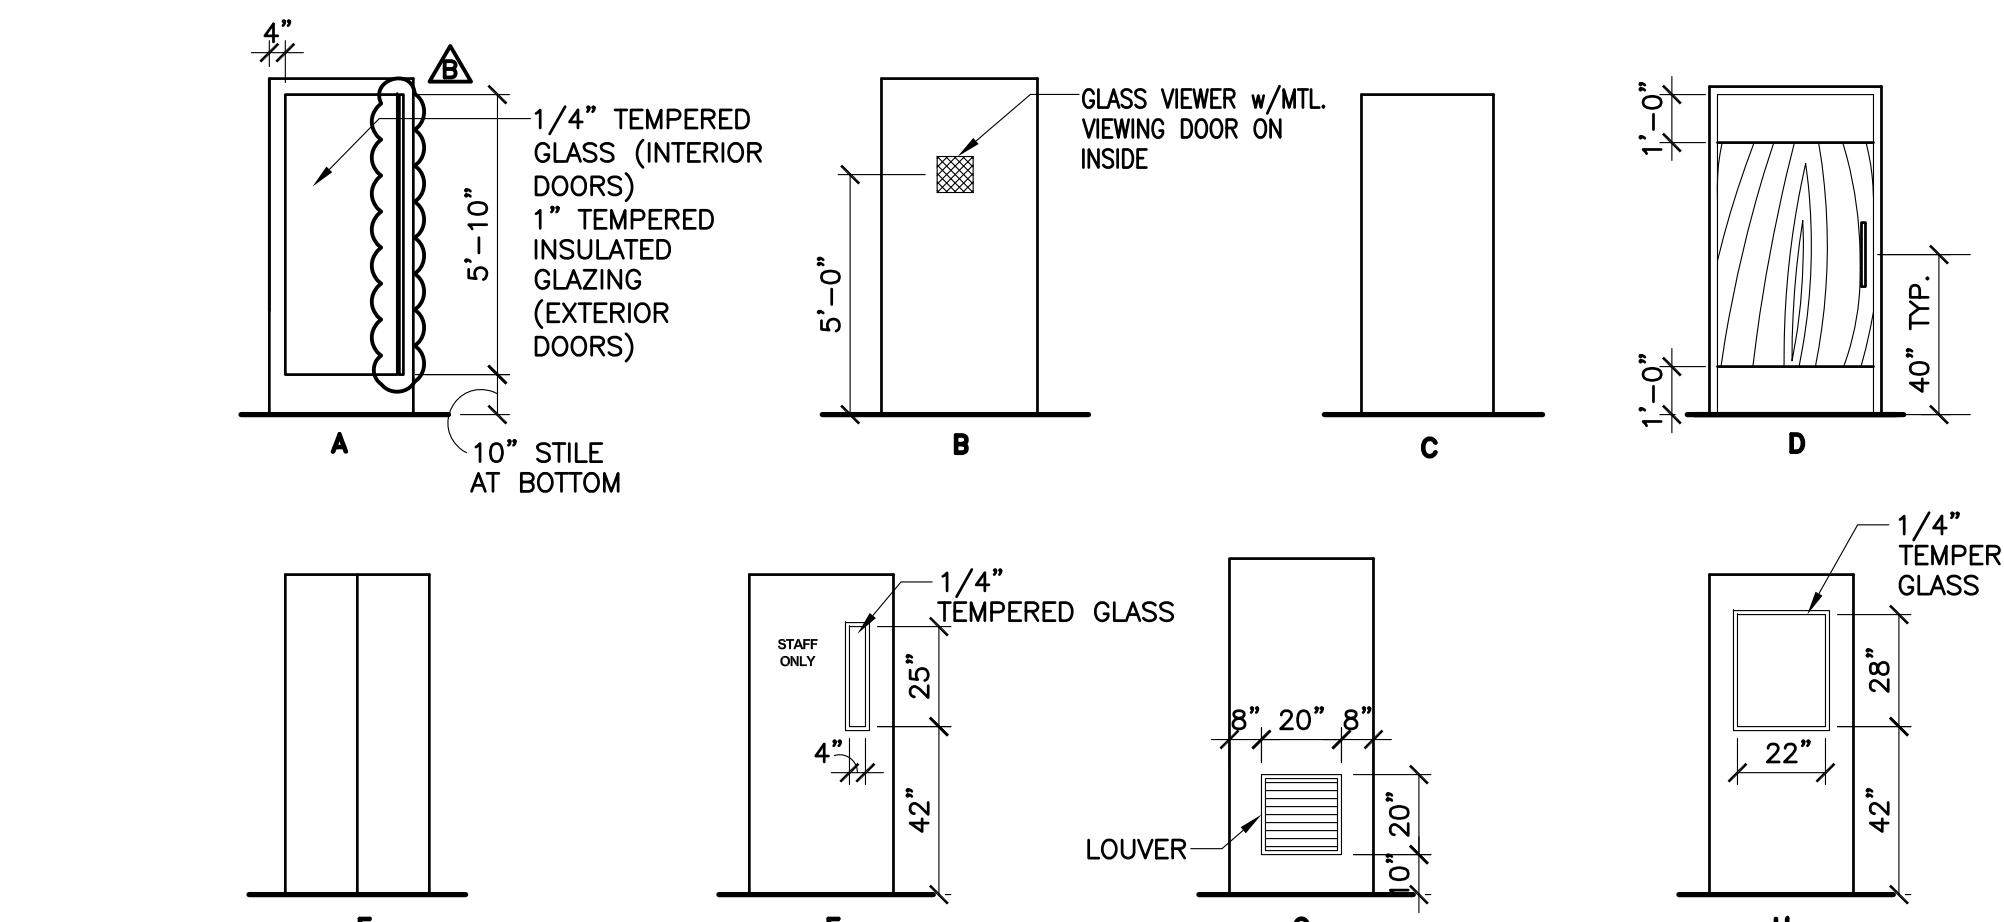

FRAME TYPES

DOOR SCHEDULE

MARK	DOOR			FRAME		
	MATERIAL	SIZE	TYPE	MATL	SIZE	
1	ALUM.	3'-0"x7'-0"x1 3/4"	A	ALUM.	(NOTE 5)	
1A		NOT USED				
2	ALUM.	3'-0"x7'-0"x1 3/4"	A	ALUM.	(NOTE 5)	
3	H.M.	4'-0"x7'-0"x1 3/4"	B	H.M.	2"JAMB 4"HEAD	
3A	H.M.	4'-0"x7'-0"x1 3/4"	C	H.M.	2"JAMB 4"HEAD	
4	H.M.	3'-0"x7'-0"x1 3/4"	B	H.M.	2"JAMB 4"HEAD	
5	S.C. WOOD W/ LAM.	3'-0"x6'-8"x1 3/4"	C	H.M.	2"JAMB 4"HEAD	
6	S.C. WOOD W/ LAM.	3'-0"x4'-8"x1 3/4"	D	H.M.	2"JAMB 4"HEAD	
6A	S.C. WOOD W/ LAM.	2'-6"x4'-8"x1 3/4"	D	H.M.	2"JAMB 4"HEAD	
7	S.C. WOOD W/ LAM.	3'-0"x6'-8"x1 3/4"	C	H.M.	2"JAMB 4"HEAD	(B)
8	S.C. WOOD W/ LAM.	2'-0"x8'-0"x1 3/4"	C	H.M.	2"JAMB 4"HEAD	
8A	S.C. WOOD W/ LAM.	(2) 1'-0"x8'-0"x1 3/4"	E	H.M.	2"JAMB 4"HEAD	
9	INSULATED METAL	3'-0"x6'-6"x4"	C	N/A	N/A	
10	H.M.	3'-0"x7'-0"x1 3/4"	F	H.M.	2"JAMB 4"HEAD	
11		NOT USED				
12		NOT USED				
13		NOT USED				(B)
14	S.C. WOOD W/ LAM.	3'-0"x6'-8"x1 3/4"	H	H.M.	2"JAMB 4"HEAD	(NOT USED)
15	H.M.	3'-0"x7'-0"x1 3/4"	G	H.M.	2"JAMB 4"HEAD	
16	S.C. WOOD W/ LAM.	3'-0"x6'-8"x1 3/4"	H	H.M.	2"JAMB 4"HEAD	(NOT USED)

GENERAL DOOR NOTES:

1. GC TO INSTALL ACCESSIBILITY DOOR SIGNS WHERE REQ'D BY LOCAL CODES – SEE GENERAL NOTE 6, SHEET A1.0
2. DETEX ALARM CONTACT SWITCHES SHALL BE RECESSED INTO THE TOP OF THE DOOR & HOLLOW METAL FRAME ABOVE.
3. DOORS, DOOR FRAMES, & HARDWARE FOR DOORS 3, 3A, 4, 5, 6, 6A, 7, 8, 8A, 10, 14, 15, 16 SUPPLIED BY: UNIVERSAL MANUFACTURING 1-800-821-1414.
4. DOOR 9 SUPPLIED BY FREEZER/COOLER MANUFACTURER
5. SEE ELEVATIONS AND WALL SECTIONS
6. ALL INTERIOR SOLID CORE WOOD DOORS TO HAVE A LAMINATED FINISH, AS INDICATED PER DECOR DWGS
7. DOOR 8 & 8A – LAMINATED FINISH – "WILSONART DOVE GREY" D92-60
8. DOOR 3 3A 4 & 15 TO HAVE MAXIMUM U VALUE = 0.37

b's USA, LLC are the confidential and USA, LLC and shall not be used without authorization. The contract is on this specific site in and are not suitable for use on a Use of these drawings for project requires the services of engineers. Reproduction of the another project is not authorized.

Signature		REV	DATE	DESCRIPTION
BRIAN MCFARLON	12/03/20	11/13/20	USRD SAO SET REVIEW	SERVICE AREA OPTIMIZATION
ARCHITECT		A	05/05/20	CIVIL & PLAN REVIEW COMMENTS
State of KANSAS			01/23/20	PERMIT SET
			01/13/20	USRD PROGRESS SET REVIEW
				Registration Number
				Date

[Handwritten signature over the signature line]

Enterprise
DESIGN

Architecture, INC.

b's USA, LLC are the confidential and USA, LLC and shall not be used without authorization. The contract is on this specific site in and are not suitable for use on a Use of these drawings for project requires the services of engineers. Reproduction of the another project is not authorized.

Signature		REV	DATE	DESCRIPTION
BRIAN A. JOHNSON ARCHITECT 5420	Registration Number			
12/03/20	Date			
<p>report was prepared under my direct supervision and I act as a duly registered architect under the laws of the State of KANSAS</p> 				
<p>Enterprise DESIGN</p> <p>Architecture, INC.</p>				
<p>State of KANSAS BRIAN A. JOHNSON 5420 12/03/20</p>				
<p>report was prepared under my direct supervision and I act as a duly registered architect under the laws of the State of KANSAS</p>				
<p>Enterprise DESIGN</p> <p>Architecture, INC.</p>				
<p>State of KANSAS BRIAN A. JOHNSON 5420 12/03/20</p>				

b's USA, LLC are the confidential and USA, LLC and shall not be used without authorization. The contract is on this specific site in and are not suitable for use on a Use of these drawings for project requires the services of engineers. Reproduction of the another project is not authorized.

Signature		REV	DATE	DESCRIPTION
BRIAN MCFARLON	12/03/20	11/13/20	USRD SAO SET REVIEW	SERVICE AREA OPTIMIZATION
ARCHITECT		A	05/05/20	CIVIL & PLAN REVIEW COMMENTS
State of KANSAS			01/23/20	PERMIT SET
			01/13/20	USRD PROGRESS SET REVIEW
				Registration Number
				Date

[Handwritten signature over the signature line]

Enterprise
DESIGN

Architecture, INC.

b's USA, LLC are the confidential and USA, LLC and shall not be used without authorization. The contract is on this specific site in and are not suitable for use on a Use of these drawings for project requires the services of engineers. Reproduction of the another project is not authorized.

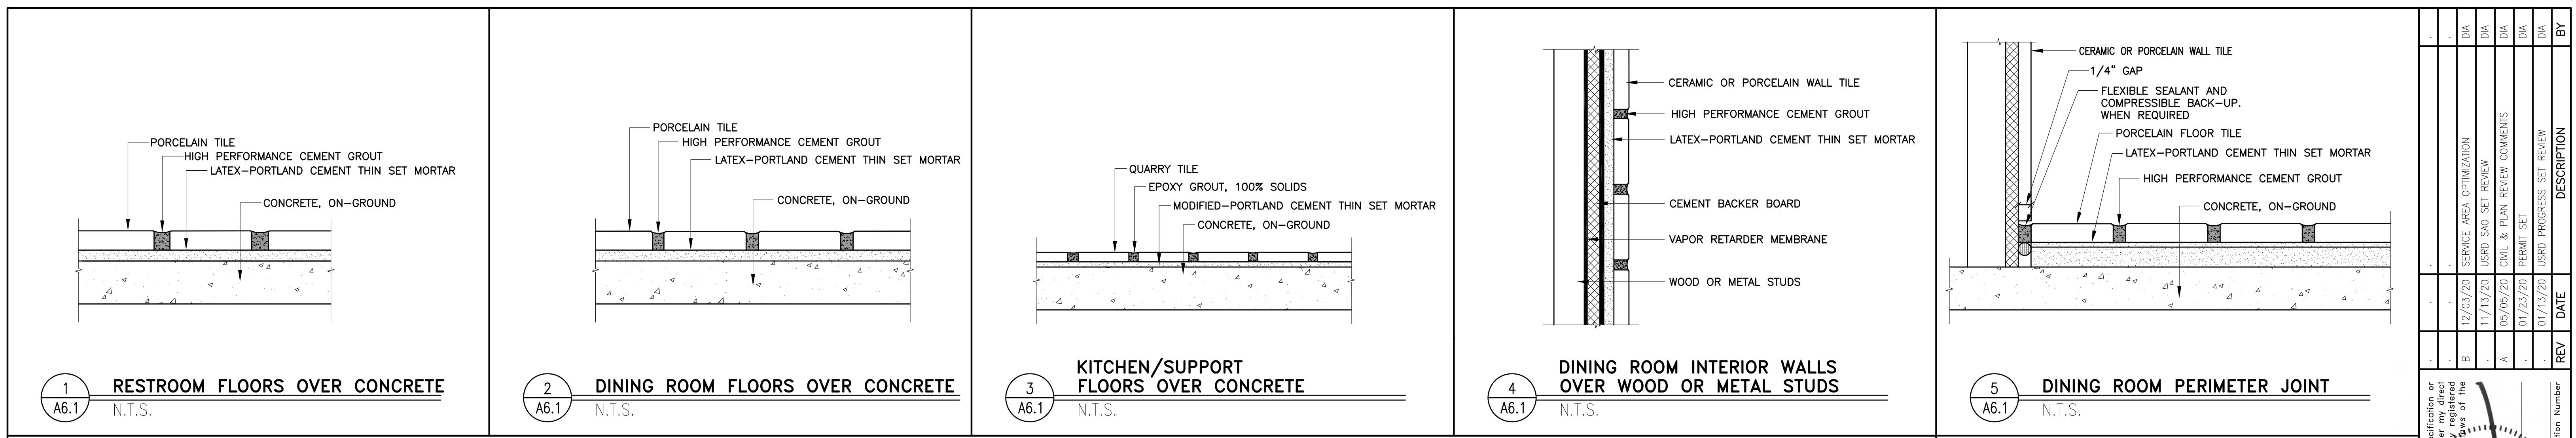

WALL TILE SCHEDULE					
MARK	ROOM NAME	WALL	MORTAR SETTING BED	GROUT	
100	CUSTOMER SERVICE	CERAMIC OR PORCELAIN WALL TILE (NOTE 4C)	LATEX-PORTLAND CEMENT THIN SET (MEDIUM BED)	HIGH PERFORMANCE CEMENT GROUT	GENERAL TILE NOTES: 1. REFERENCE: 2017 MCDONALD'S PROJECT MANUAL - SECTION 093000
101	DINING	CERAMIC OR PORCELAIN WALL TILE (NOTE 4B & 4C)	LATEX-PORTLAND CEMENT THIN SET (MEDIUM BED)	HIGH PERFORMANCE CEMENT GROUT	2. KITCHEN FLOOR TILE: TILE: CROSSVILLE 6"x6" "METROPOLITAN QUARRY BASICS ABRASIVE" GROUT: CHARCOAL #47 BY MAPEI KERAPOXY IEG BLACK #10 BY MAPEI (FOR OPTIONAL GREY TILE) COLOR: PURITAN GRAY EXTRA ABRASIVE 57XA (STANDARD) MAYFLOWER RED 31XA (OPTIONAL) - VERIFY W/ MCDONALD'S ACM
102	WOMEN'S TOILET	CERAMIC OR PORCELAIN WALL TILE (NOTE 4B)	LATEX-PORTLAND CEMENT THIN SET (MEDIUM BED)	HIGH PERFORMANCE CEMENT GROUT	3. DINING ROOM FLOOR TILE: MAIN & ACCENT: USE ONLY APPROVED TILE SERIES AND COLORS BY CROSSVILLE AND EUROWEST. VERIFY COLOR AND PATTERN PER INTERIOR DECOR DRAWINGS. A) MUST BE PER MCDONALD'S USA, LLC: STANDARDS FOR INTERIOR FLOOR TILE AND APPROVED TILE LIST. B) MUST MEET THE FOLLOWING: STATIC COEFFICIENT OF FRICTION (PER ASTM F1667-96) LEVEL SURFACES: MINIMUM 0.50 DRY AND WET (MCDONALD'S STANDARD) DYNAMIC COEFFICIENT OF FRICTION (PER ANSI A137.1 2012) LEVEL SURFACES: MINIMUM 0.5 DRY AND WET (MCDONALD'S STANDARD)
103	MEN'S TOILET	CERAMIC OR PORCELAIN WALL TILE (NOTE 4B)	LATEX-PORTLAND CEMENT THIN SET (MEDIUM BED)	HIGH PERFORMANCE CEMENT GROUT	4. TILE TRANSITION AND EDGE PROTECTION: A) TILE BASE (RESTROOM ONLY): SCHLUTER DILEX-AHK SERIES, BRUSHED STAINLESS STEEL. B) TILE EDGE PROTECTION (WALL TRANSITION): SCHLUTER-RONDEC-DB, SATIN ANODIZED ALUMINUM. C) TILE CORNER PROTECTION (OUTSIDE CORNER): SCHLUTER-RONDEC-AE, SATIN ANODIZED ALUMINUM. D) SEE INTERIOR DECOR DRAWINGS FOR ALL LOCATIONS.
104	SUPPORT	QUARRY TILE (NOTE 2)	COVED QUARRY TILE	MODIFIED-PORTLAND CEMENT THIN SET MORTAR (MEDIUM BED)	BEFORE FINAL INSPECTION, REMOVE PROTECTIVE COVERINGS AND PERFORM FINAL CLEANING.
105	KITCHEN	QUARRY TILE (NOTE 2)	COVED QUARRY TILE	MODIFIED-PORTLAND CEMENT THIN SET MORTAR (MEDIUM BED)	5. TILE CLEANER: DETERDEK, BY FILA SURFACE CARE PRODUCTS - NO SUBSTITUTIONS ALLOWED CAN BE ORDERED BY EUROWEST, CROSSVILLE, OR DIRECT FROM MANUFACTURER: FILA/DETREK POST INSTALLATION CLEANING REQUIRED ON ALL FLOOR TILE INSTALLATIONS PRIOR TO RESTAURANT TURN OVER.
106	PRESENTER-1	QUARRY TILE (NOTE 2)	COVED QUARRY TILE	MODIFIED-PORTLAND CEMENT THIN SET MORTAR (MEDIUM BED)	APPLY CLEANER PER MANUFACTURER'S WRITTEN INSTRUCTIONS. REFERENCE: MCDONALD'S PROJECT MANUAL - SECTION 09300 TILING INTERIOR.
107	ORDER	QUARRY TILE (NOTE 2)	COVED QUARRY TILE	MODIFIED-PORTLAND CEMENT THIN SET MORTAR (MEDIUM BED)	6. GROUT COLOR AND MANUFACTURER AS INDICATED ON SHEET A1.0 AND INTERIOR DECOR DRAWINGS.
108	MANAGER'S AREA	QUARRY TILE (NOTE 2)	COVED QUARRY TILE	MODIFIED-PORTLAND CEMENT THIN SET MORTAR (MEDIUM BED)	
109	CREW ROOM	QUARRY TILE (NOTE 2)	COVED QUARRY TILE	MODIFIED-PORTLAND CEMENT THIN SET MORTAR (MEDIUM BED)	
110	COOLER	QUARRY TILE (NOTE 2)	4" ALUM. COVED BASE	MODIFIED-PORTLAND CEMENT THIN SET MORTAR (MEDIUM BED)	
111	FREEZER	QUARRY TILE (NOTE 2)	4" ALUM. COVED BASE	MODIFIED-PORTLAND CEMENT THIN SET MORTAR (MEDIUM BED)	
112	COMPUTER CLOSET	QUARRY TILE (NOTE 2)	COVED QUARRY TILE	MODIFIED-PORTLAND CEMENT THIN SET MORTAR (MEDIUM BED)	
113	CREW ALCOVE	QUARRY TILE (NOTE 2)	COVED QUARRY TILE	MODIFIED-PORTLAND CEMENT THIN SET MORTAR (MEDIUM BED)	
114	JANITOR'S CLOSET	PORCELAIN FLOOR TILE (NOTE 3)	COVED QUARRY TILE	LATEX-PORTLAND CEMENT THIN SET (MEDIUM BED)	
115	VESTIBULE	PORCELAIN FLOOR TILE (NOTE 3)	NONE - WALL TILE	LATEX-PORTLAND CEMENT THIN SET (MEDIUM BED)	
116	PRESENTER-2	PORCELAIN FLOOR TILE (NOTE 3)	COVED QUARRY TILE	LATEX-PORTLAND CEMENT THIN SET (MEDIUM BED)	
117	CO2	N/A - SEE ROOM FINISH SCHEDULE	---	MODIFIED-PORTLAND CEMENT THIN SET MORTAR (MEDIUM BED)	

ROOM FINISH SCHEDULE					
MARK	ROOM NAME	WALLS	CEILING *	REMARKS	
100	CUSTOMER SERVICE	CEMENT BOARD	TILE **	SEE DECOR DRAWINGS, TILE AS NOTED ON A1.0	GENERAL FINISH NOTES: 1. ALL FINISH SURFACES OF WALL AND CEILING MATERIALS SHALL BE CLASS B AND SHALL HAVE A FLAME SPREAD RATING OF 26 TO 75 AND A SMOKE DENSITY OF 450 MAX. (PER IBC TABLE 803.9). 2. DECORATIVE MATERIALS SHALL BE FLAME RETARDANT AND MEET THE CRITERIA OF NFPA 701. 3. DECORATIVE MATERIAL SHALL NOT CONCEAL EXITS, EXIT LIGHTS, ALARM STATIONS, HOSE CABINETS, AND EXTINGUISHER LOCATIONS. 4. WHEN BUILDING TYPE IS A NON-COMBUSTIBLE CATEGORY, ALL PLYWOOD SHALL BE FIRE RETARDANT TREATED. 5. A. FRP OVER CEMENT BD BEHIND 3-COMP SINK TO HGT OF BACK SPLASH. B. TILE WAINTSCOT TO 6' A.F.F. OVER CEMENT BD. OVER EXT GRADE PLYWOOD (NOTE 4) AT MOP SINKS 6. PROVIDE CEMENT BOARD BACKER OR EQUIVALENT AT ALL TILE LOCATIONS. 7. PROVIDE VAPOR BARRIER BEHIND PLYWOOD AT WALLS AND BEHIND GYP. AT CEILING * SEE CEILING PLAN FOR HEIGHTS & LAYOUTS ** WVC ON EXTERIOR WALL ASSEMBLIES TO BE PERFORATED
101	DINING	CEM BD/GYP BD	TILE/V.W.C. **	SEE DECOR DRAWINGS FOR EXTENT	
102	WOMEN'S TOILET	CEMENT BOARD	TILE	SEE DECOR DRAWINGS FOR EXTENT	
103	MEN'S TOILET	CEMENT BOARD	TILE	SEE DECOR DRAWINGS FOR EXTENT	
104	SUPPORT	1/2" PLYWD (NOTE 4)	FRP	STAINLESS STEEL CORNERS	SEE SHEET A1.0 FOR EXTENT OF CEMENT BOARD, SS OR CT
105	KITCHEN	1/2" PLYWD (NOTE 4)	FRP	STAINLESS STEEL CORNERS, TILE OVER CEM BD AS NOTED ON A1.0	
106	PRESENTER-1	CEM BD, 1/2" PLYWD (NOTE 4)	TILE	TILE AS NOTED ON A1.0	
107	ORDER	1/2" PLYWD (NOTE 4)	FRP	2'x2' VINYL-FACED LAY-IN	
108	MANAGER'S AREA	1/2" PLYWD (NOTE 4)	FRP	2'x2' VINYL-FACED LAY-IN	
109	CREW ROOM	CEM BD/GYP BD	TILE/V.W.C. **	SEE DECOR DRAWINGS FOR EXTENT	SEE A1.0 FOR PARTITION TYPE AND ROOM FINISH SCHEDULE FOR WALL FINISH
110	COOLER	N/A	PRE-FAB METAL SKIN PANEL	PRE-FAB METAL SKIN PANEL	COVED QUARRY TILE BASE 1 1/2" x 1 1/2" x 3/16" ALUMINUM FRAME AROUND PERIMETER 1 1/4" x 1 1/4" x 3/16" ALUMINUM BAR GRATE W/ 1" X 1/8" CROSS GRATE
111	FREEZER	N/A	PRE-FAB METAL SKIN PANEL	PRE-FAB METAL SKIN PANEL	QUARRY TILED INTERIOR
112	COMPUTER CLOSET	1/2" PLYWD (NOTE 4)	FRP	STAINLESS STEEL CORNERS, TILE OVER CEM BD AS NOTED ON A1.0	RECESSED MOP SINK. SEE STRUCTURAL DRAWINGS FOR SIZE AND LOCATION
113	CREW ALCOVE	1/2" PLYWD (NOTE 4)	FRP	2'x2' VINYL-FACED LAY-IN	WATERPROOF MEMBRANE TO BE APPLIED AT SUMP AREA AND 1'-0" PERIMETER AT ADJOINING FLOOR AND WALL AREAS
114	JANITOR'S CLOSET	1/2" PLYWD (NOTE 4)	FRP	PAINTED GYP. BD.	NOTE: PROVIDE POSITIVE SLOPE TO DRAIN
115	VESTIBULE	CEM BD/GYP BD	TILE/V.W.C. **	SEE DECOR DRAWINGS FOR EXTENT	PRE-FAB MOP SINK BY ADVANCE TABCO AVAILABLE AS AN ALTERNATE OPTION. SEE P4.1 WHERE PRE-FAB MOP SINK USED. (DEPTH TO BE 8-7/8" TO ACCOMMODATE FACTORY BUILT MOP SINK DIMENSIONS.)
116	PRESENTER-2	CEM BD, 1/2" PLYWD (NOTE 4)	TILE	TILE AS NOTED ON A1.0	
117	CO2	1/2" PLYWD (NOTE 4)	FRP	PAINTED GYP. BD.	

PREPARED BY: **McDonald's USA, LLC**
12400 ARCHITECTURE & PLANNING,
PORTLAND AVENUE SOUTH,
BURNSVILLE, MN 55337
EMAIL: DATAREP@DESIGN.COM
PHONE: (952) 252-4042
FAX: (952) 252-4943

DESIGN

© 2020 McDonald's USA, LLC
These drawings and specifications are the confidential and
proprietary property of McDonald's USA, LLC and shall not be
copied or otherwise reproduced without the express written
conjunction with its issue date and are not suitable for use on a
construction project. These drawings are prepared for use on this specific
project and are not to be used at a later time. Use of these drawings for
reference or example on another project requires the services of an
authorized McDonald's representative. Any unauthorized
use or copying of these drawings is prohibited.

PREPARED FOR: **McDonald's USA, LLC**
12400 ARCHITECTURE & PLANNING,
PORTLAND AVENUE SOUTH,
BURNSVILLE, MN 55337
EMAIL: DATAREP@DESIGN.COM
PHONE: (952) 252-4042
FAX: (952) 252-4943

CONTACT: NATIONAL
ACCOUNTS DIVISION
PHONE: (888) 424-6287
FAX: (908) 849-4295
NATIONALACCOUNTS
@SGROUP.COM

OPTIONAL: VERIFY WITH
MCDONALD'S CONSTRUCTION
MANAGER

DRAWN BY: **DIA**
STD ISSUE DATE: 2019-11
REVISED BY: **KO**
DATE ISSUED: 01/23/20
TITLE: 2019 STANDARD BUILDING - BB20
DESCRIPTION: 459710-WOOD/WOOD
SHEET NO. 015-0071.00.B
FINISH SCHEDULES
A6.1
1 1/2" = 1'-0"

PREPARED BY: **McDonald's USA, LLC**
12400 ARCHITECTURE & PLANNING,
PORTLAND AVENUE SOUTH,
BURNSVILLE, MN 55337
EMAIL: DATAREP@DESIGN.COM
PHONE: (952) 252-4042
FAX: (952) 252-4943

DESIGN

PREPARED FOR: **McDonald's USA, LLC**
12400 ARCHITECTURE & PLANNING,
PORTLAND AVENUE SOUTH,
BURNSVILLE, MN 55337
EMAIL: DATAREP@DESIGN.COM
PHONE: (952) 252-4042
FAX: (952) 252-4943

CONTACT: NATIONAL
ACCOUNTS DIVISION
PHONE: (888) 424-6287
FAX: (908) 849-4295
NATIONALACCOUNTS
@SGROUP.COM

OPTIONAL: VERIFY WITH
MCDONALD'S CONSTRUCTION
MANAGER

DRAWN BY: **DIA**
STD ISSUE DATE: 2019-11
REVISED BY: **KO**
DATE ISSUED: 01/23/20
TITLE: 2019 STANDARD BUILDING - BB20
DESCRIPTION: 459710-WOOD/WOOD
SHEET NO. 015-0071.00.B
FINISH SCHEDULES
A6.1
1 1/2" = 1'-0"

PREPARED BY: **McDonald's USA, LLC**
12400 ARCHITECTURE & PLANNING,
PORTLAND AVENUE SOUTH,
BURNSVILLE, MN 55337
EMAIL: DATAREP@DESIGN.COM
PHONE: (952) 252-4042
FAX: (952) 252-4943


DESIGN

PREPARED FOR: **McDonald's USA, LLC**
12400 ARCHITECTURE & PLANNING,
PORTLAND AVENUE SOUTH,
BURNSVILLE, MN 55337
EMAIL: DATAREP@DESIGN.COM
PHONE: (952) 252-4042
FAX: (952) 252-4943

CONTACT: NATIONAL
ACCOUNTS DIVISION
PHONE: (888) 424-6287
FAX: (908) 849-4295
NATIONALACCOUNTS
@SGROUP.COM

OPTIONAL: VERIFY WITH
MCDONALD'S CONSTRUCTION
MANAGER

DRAWN BY: **DIA**
STD ISSUE DATE: 2019-11
REVISED BY: **KO**
DATE ISSUED: 01/23/20
TITLE: 2019 STANDARD BUILDING - BB20
DESCRIPTION: 459710-WOOD/WOOD
SHEET NO. 015-0071.00.B
FINISH SCHEDULES
A6.1
1 1/2" = 1'-0"

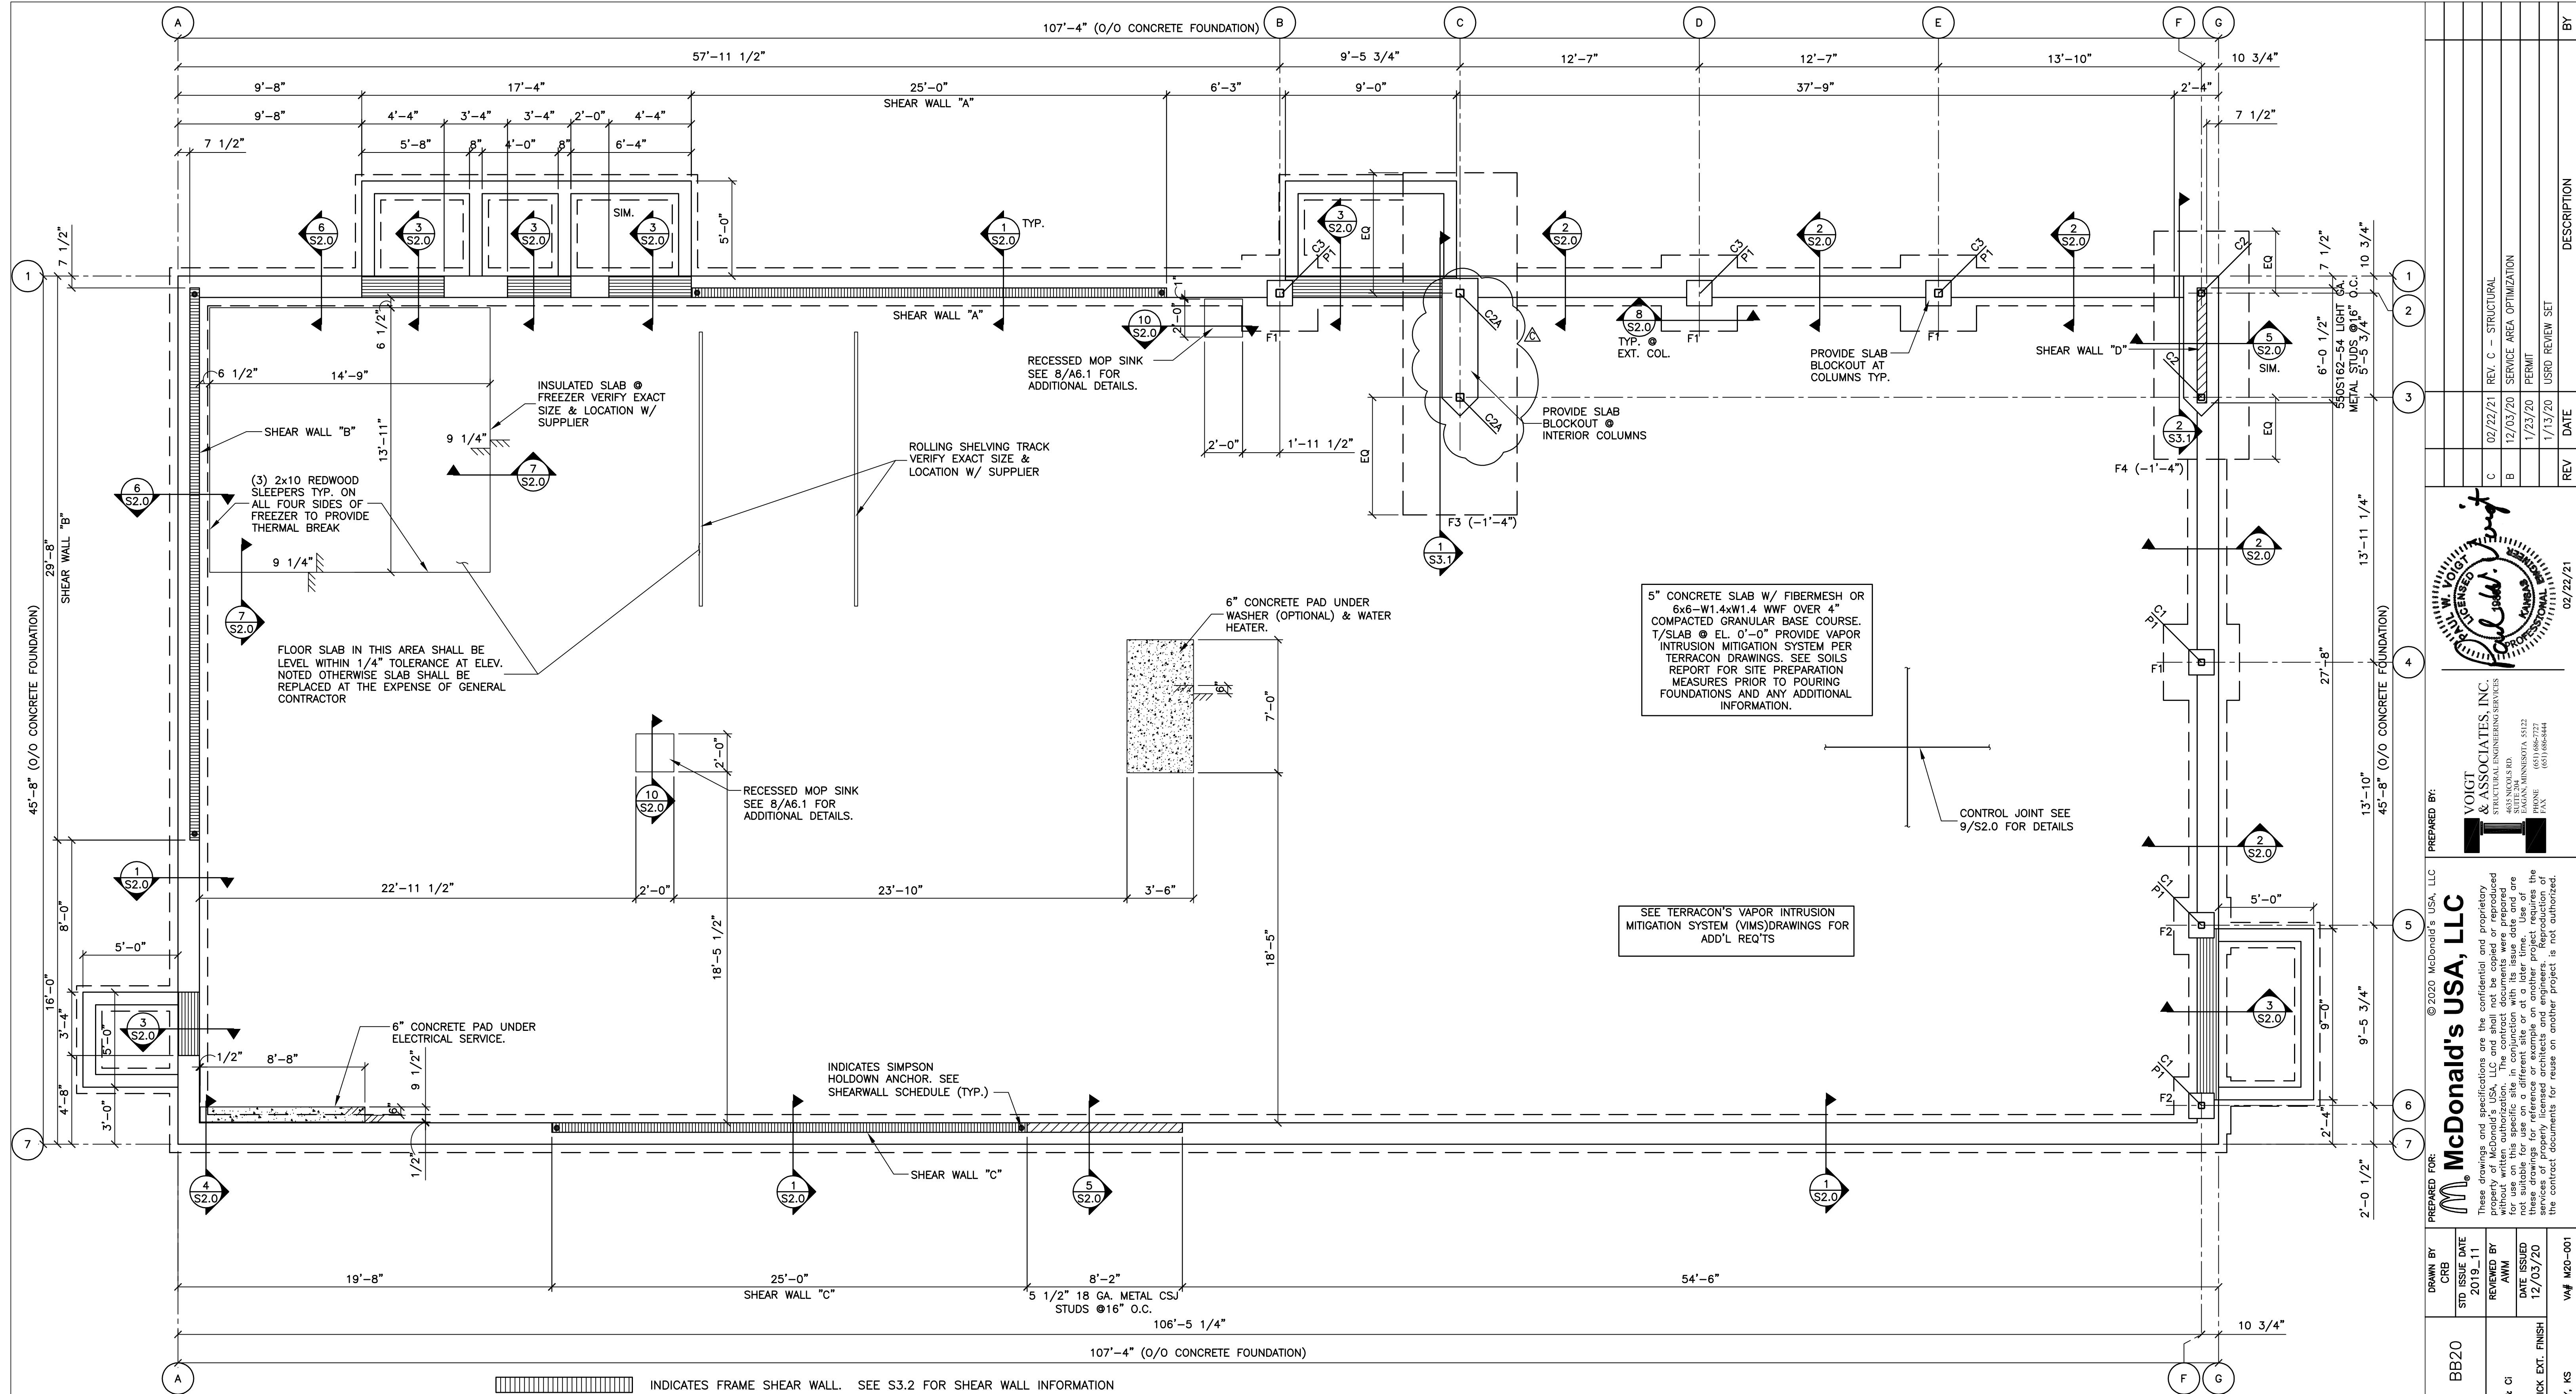

1 FOUNDATION PLAN

S1.0 $1/4'' = 1'$

- NOTES:

 1. TOP OF FOOTING @ EL. (-2'-6") UNLESS NOTED OTHERWISE.
 2. TOP OF PIER @ EL. (-0'-8") UNLESS NOTED OTHERWISE.
 3. SEE SHEET S4.0 FOR GENERAL STRUCTURAL NOTES.
 4. PROVIDE POSITIVE DRAINAGE TO ALL FLOOR DRAINS/SINKS (MIN 6") BEYOND DRAIN) SEE PLUMBING DRAWINGS FOR EXACT LOCATIONS
 5. SEE SHEET S2.0 FOR TYPICAL CORNER BAR DETAILS.
 6. MINIMUM REQUIREMENTS FOR SILL PLATE CONNECTION TO FOUNDATION:
MINIMUM # OF BOLTS = 2 PER PIECE OF SILL
MAXIMUM DISTANCE FROM END OF SILL TO ANCHOR = 12"
MINIMUM DISTANCE FROM END OF SILL TO ANCHOR = 4"
 7. WHERE SILL PLATES ARE NOT CONTINUOUS AT ALL LOCATIONS EXCEPT SHEAR WALLS, USE SIMPSON "RPS22Z" TIE FOR NOTCH < 5 1/2", USE SIMPSON "RPS28Z" FOR NOTCH < 12", W/ 16d NAILS INTO SILL PLATE ENDS. (MAX. SPACING BETWEEN STUDS = 16" O.C.)
 8. WHERE SILL PLATES ARE NOT CONTINUOUS AT SHEAR WALLS, CONTACT ENGINEER OF RECORD FOR RESPONSE.

FOOTING SCHEDULE

MARK	SIZE	REINFORCING
F1	4'-0" x 4'-0" x 1'-0"	5-#5 E.W.-B.
F2	3'-0" x 3'-0" x 1'-0"	4-#5 E.W.-B.
F3	6'-0" x 16'-0" x 3'-0"	7-#7 L.W.-T&B #6 @ 12" O.C. S.W.-T&B
F4	5'-0" x 12'-0" x 3'-0"	6-#7 L.W.-T&B #6 @ 12" O.C. S.W.-T&B

PIER SCHEDULE

MARK	SIZE	REINFORCING	REMARKS
P1	1'-4" x 1'-4"	4-#6 VERT. #4 TIES @ 12" O.C.	SEE DETAIL 8/S2.0

COLUMN & BASE PLATE SCHEDULE

K	MEMBER	SHAPE	BASE PLATE	REMARKS
	HSS4x4x3/8	⊕	A	EXTEND TO ROOF
	HSS4x4x3/8	⊕	B	BRACED FRAME
A	HSS5x5x3/8	⊕	B	BRACED FRAME
	HSS5x5x3/8	⊕	A	EXTEND TO ROOF

SEE DETAIL 3/S3.1 FOR BASE PLATE AND ANCHOR ROD DETAILS

© 2020 McDonald's USA, LLC

PREPARED FOR:

VOIG & ASSOCIATES
STRUCTURE


4635 NICOLAS
SUITE 204
EAGAN, MN 55330

PHONE: 651-942-1000
FAX: 651-942-1001

PREPARED BY:

These drawings and specifications are the confidential and proprietary property of McDonald's USA, LLC and shall not be copied or reproduced without written authorization. The contract documents were prepared for use on this specific site in conjunction with its issue date and are not suitable for use on a different site or at a later time. Use of these drawings for reference or example on another project requires the services of properly licensed architects and engineers. Reproduction of the contract documents for reuse on another project is not authorized.

SHEET NO.	2019 STANDARD BUILDING – BB20		DRAWN BY CRB
	015-0071.00.0	STD ISSUE DATE 2019_11	REVIEWED BY AWM
DESCRIPTION	WOOD BEARING WALLS W/FIBER CEMENT SIDING & Ci WOOD ROOF TRUSS FRAMING FIBER CEMENT PANEL/BATTEN/ALPOLIC PANEL/BRICK EXT. FINISH		
SITE ID	SITE ADDRESS 015-0071 605 SOUTH 7TH STREET, KANSAS CITY, KS		
S 1 ® FOUNDATION PLAN		VA# M20-001	

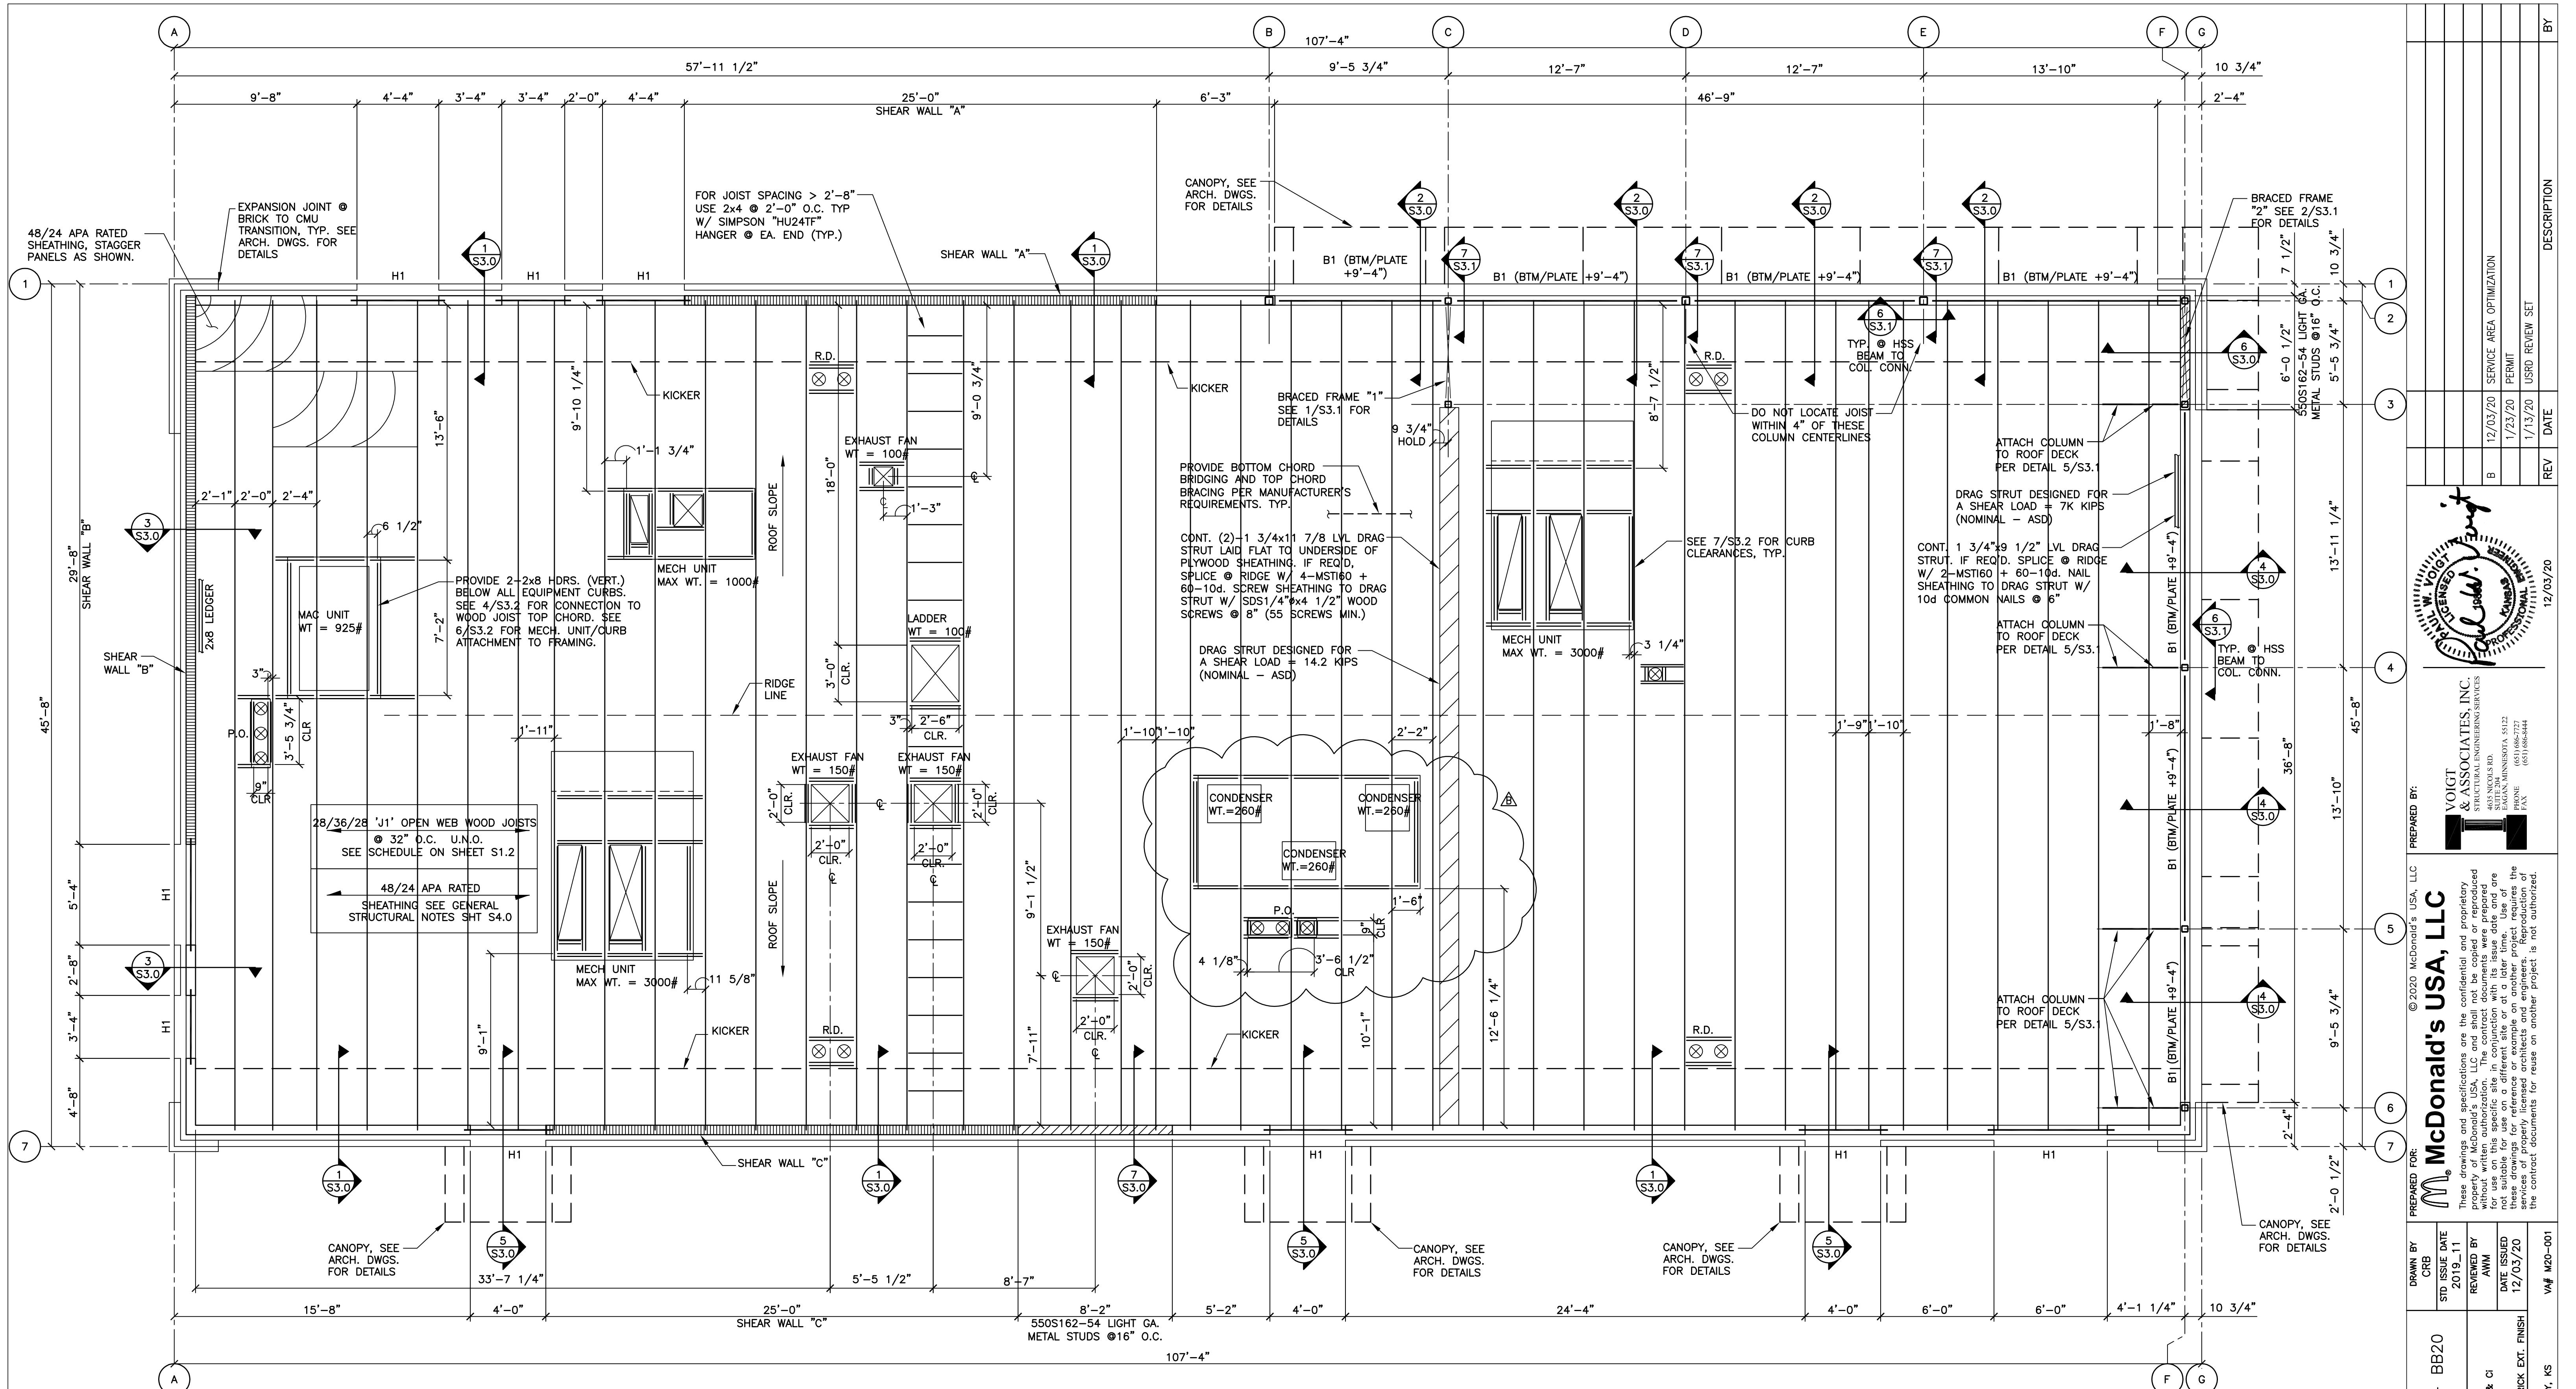

1 FRAMING PLAN

1/4" = 1' - 0

 INDICATES METAL STUD FRAME WALL

NOTES:

- NOTES:

 1. SEE SHEET S4.0 FOR GENERAL STRUCTURAL NOTES.
 2. R.D.: ROOF DRAINS
 3. P.O.: ROOF CURB PORTAL OPENING – COORDINATE WITH MECHANICAL DRAWINGS.
 4. WHEN TOP PLATES ARE NOT CONTINUOUS, USE SIMPSON "RPS22" TIE FOR NOTCH < 5 1/2", USE SIMPSON "RPS28" TIES FOR NOTCH < 12", W/ 16d NAILS INTO TOP PLATE ENDS. (MAX. SPACING BETWEEN STUDS = 16" O.C.)
 5. TOP PLATE SPLICING SHALL BE MINIMUM LENGTH OF 48" WITH 2 ROWS (2 1/2" APART) OF 6-16d COMMON NAILS SPACED @ 2" ON CENTER (12 TOTAL).
 6. SEE 2/S4.0 FOR VENEER TIES REQUIREMENTS.
 7. SEE 5/S3.2 FOR SNOW DRIFT DIAGRAM.

BEAM SCHEDULE				
MARK	MEMBER	SHAPE	SUPPORT	REMARKS
B1	HSS16x4x1/4 LLV + 5/16" PLATE	I	1/2" END PLATE	SEE DETAIL 6/S3.1


HEADER SCHEDULE			
MARK	MEMBER	SHAPE	BEARING
H1	5 1/4" x 9 1/2" LVL + L5x3 1/2x5/16 LLV	XL	SEE DETAIL 2/S3.2 6" @ BRG. ANGLE

JOIST SCHEDULE			
ARK	LIVE/ROOF SNOW LOAD	DEPTH	MANUFACTURER & SERIES
J1	20/20	28"/36"/28"	REDBUILT "RED-S"




E: SEE DETAIL 4/S3.2 FOR JOIST DETAILS AND SUPPLIER INFORMATION

These drawings and specifications are the confidential and proprietary property of McDonald's USA, LLC and shall not be copied or reproduced without written authorization. The contract documents were prepared for use on this specific site in conjunction with its issue date and are not suitable for use on a different site or at a later time. Use of these drawings for reference or example on another project requires the services of properly licensed architects and engineers. Reproduction of the contract documents for reuse on another project is not authorized.

VOIG
& ASSOCIATES
STRUCTURAL
4635 NICOLLE
SUITE 204
EAGAN, MINNESOTA
PHONE 651-492-1100
FAX 651-492-1101

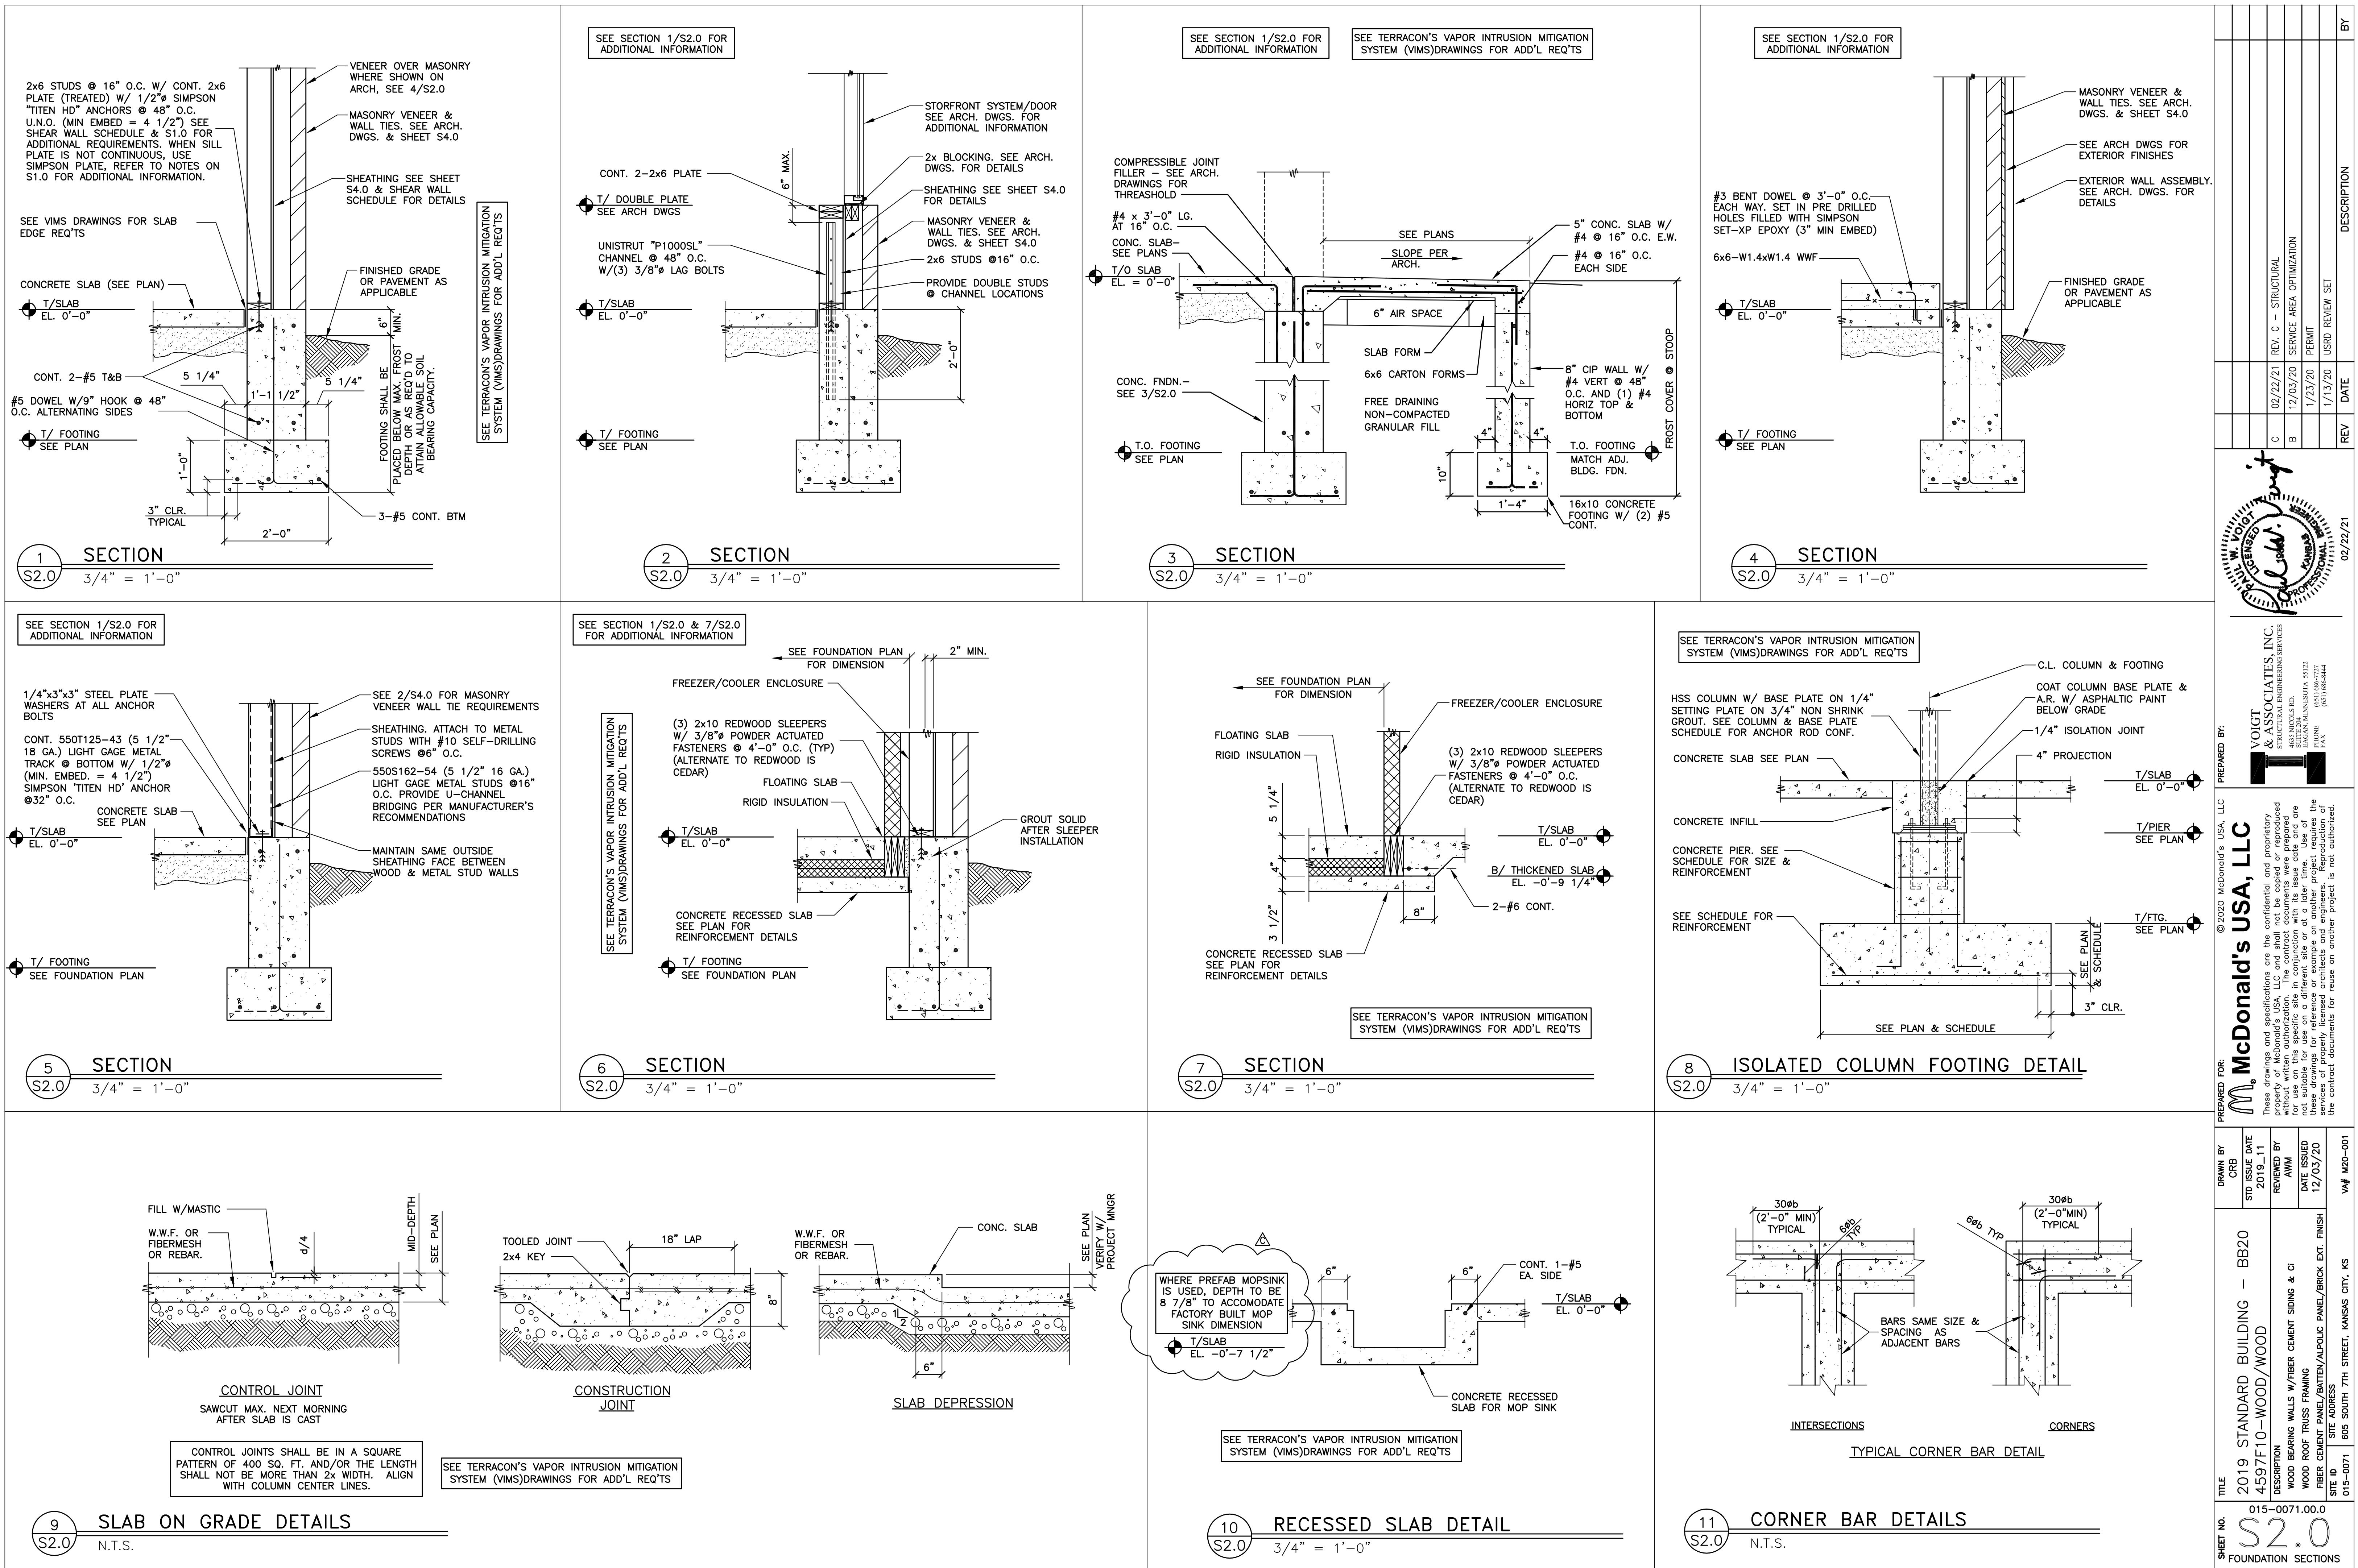

SHEET NO.	TITLE	DRAWN BY	PREPARED BY:
015-0071.00.0	2019 STANDARD BUILDING - BB20 459-7F10-WOOD/WOOD	CRB	VOIGHT & ASSOCIATES, INC. STRUCTURAL ENGINEERING SERVICES 4035 NICOLIS RD. ELLIPTICAL MINNESOTA A 58122 (651) 686-2722 (651) 686-4444
	DESCRIPTION	STD ISSUE DATE	REVISED BY
1	SECTION S3.0	3/4" = 1'-0"	1/23/20 PERMIT
2	SECTION S3.0	3/4" = 1'-0"	1/13/20 USD/R/REVIEW SET
3	SECTION S3.0	3/4" = 1'-0"	1/23/20 REV DATE
4	SECTION S3.0	3/4" = 1'-0"	1/23/20 BY
5	SECTION S3.0	3/4" = 1'-0"	1/23/20
6	SECTION S3.0	3/4" = 1'-0"	1/23/20
7	SECTION S3.0	3/4" = 1'-0"	1/23/20
1	 SEE SECTION 1/S3.0 FOR ADDITIONAL INFORMATION	3/4" = 1'-0"	 SEE SECTION 1/S3.0 FOR ADDITIONAL INFORMATION
2	 SEE SECTION 1/S3.0 FOR ADDITIONAL INFORMATION	3/4" = 1'-0"	 SEE SECTION 1/S3.0 FOR ADDITIONAL INFORMATION
3	 SEE SECTION 1/S3.0 FOR ADDITIONAL INFORMATION	3/4" = 1'-0"	 SEE SECTION 1/S3.0 FOR ADDITIONAL INFORMATION
4	 SEE SECTION 2/S3.0 & 3/S3.0 FOR ADDITIONAL INFORMATION	3/4" = 1'-0"	 SEE SECTION 1/S3.0 FOR ADDITIONAL INFORMATION
5	 SEE SECTION 1/S3.0 FOR ADDITIONAL INFORMATION	3/4" = 1'-0"	 SEE SECTION 4/S3.0 FOR ADDITIONAL INFORMATION
6	 SEE SECTION 1/S3.0 FOR ADDITIONAL INFORMATION	3/4" = 1'-0"	 SEE SECTION 1/S3.0 FOR ADDITIONAL INFORMATION
7	 SEE SECTION 1/S3.0 FOR ADDITIONAL INFORMATION	3/4" = 1'-0"	 SEE SECTION 1/S3.0 FOR ADDITIONAL INFORMATION

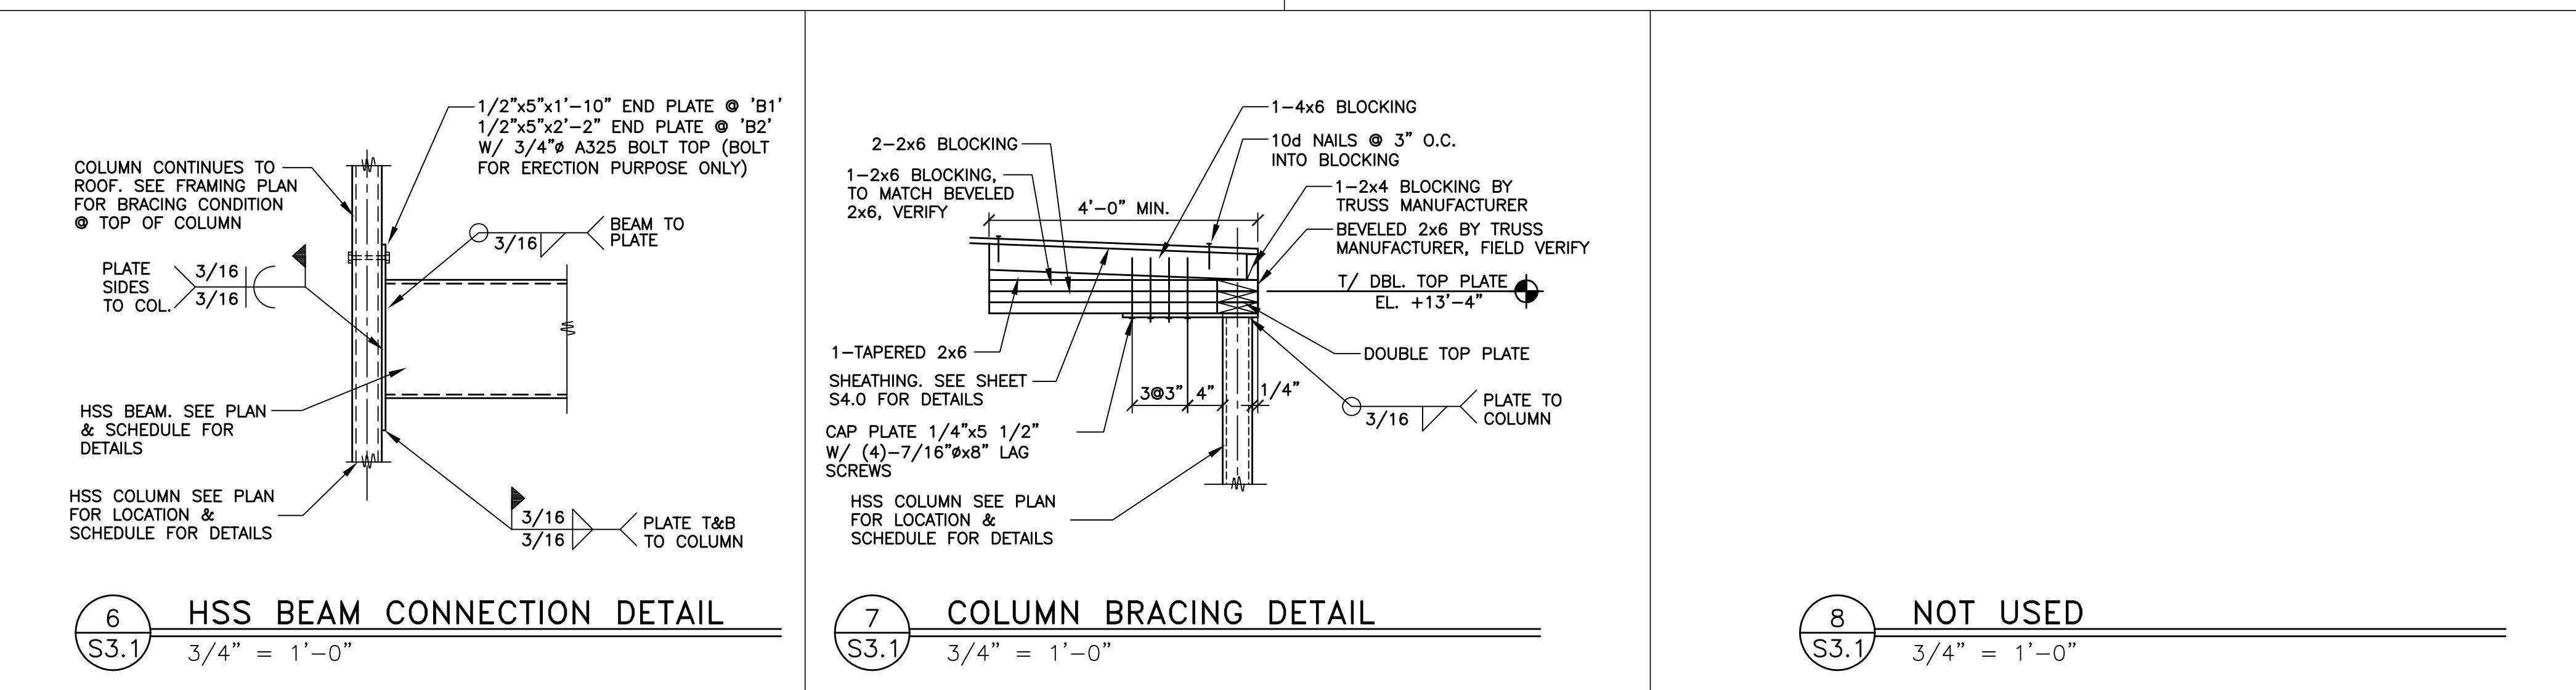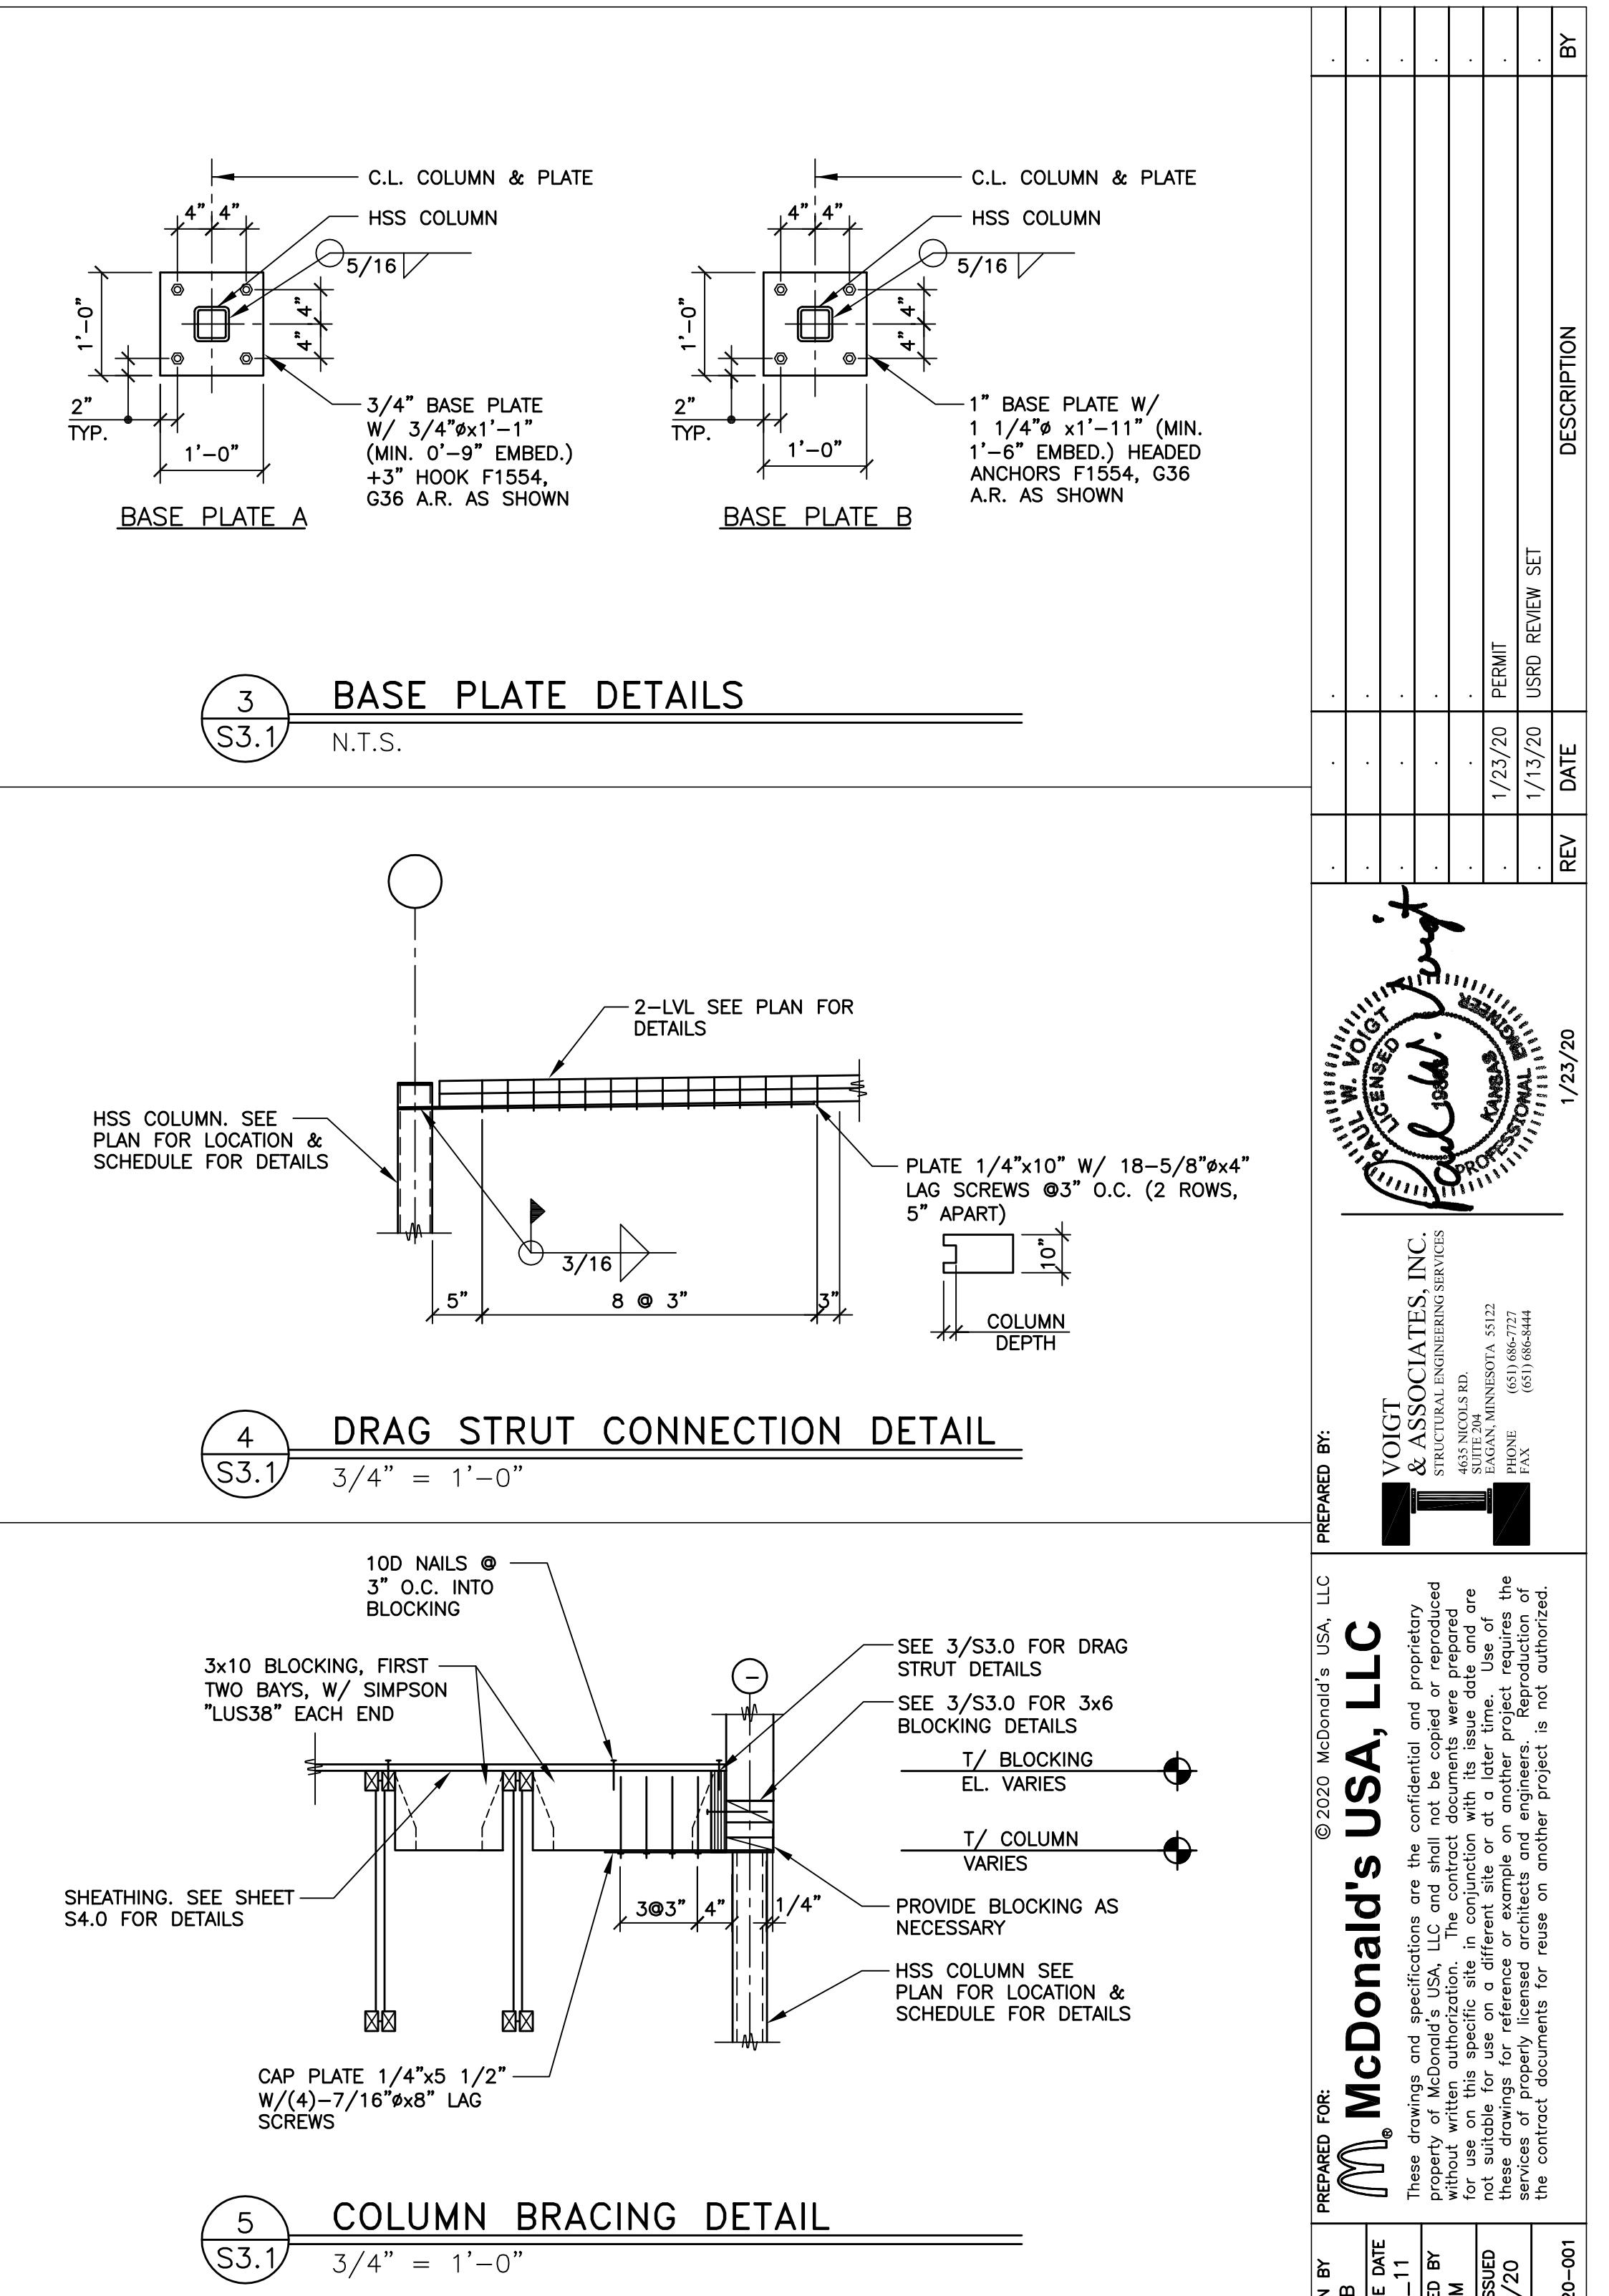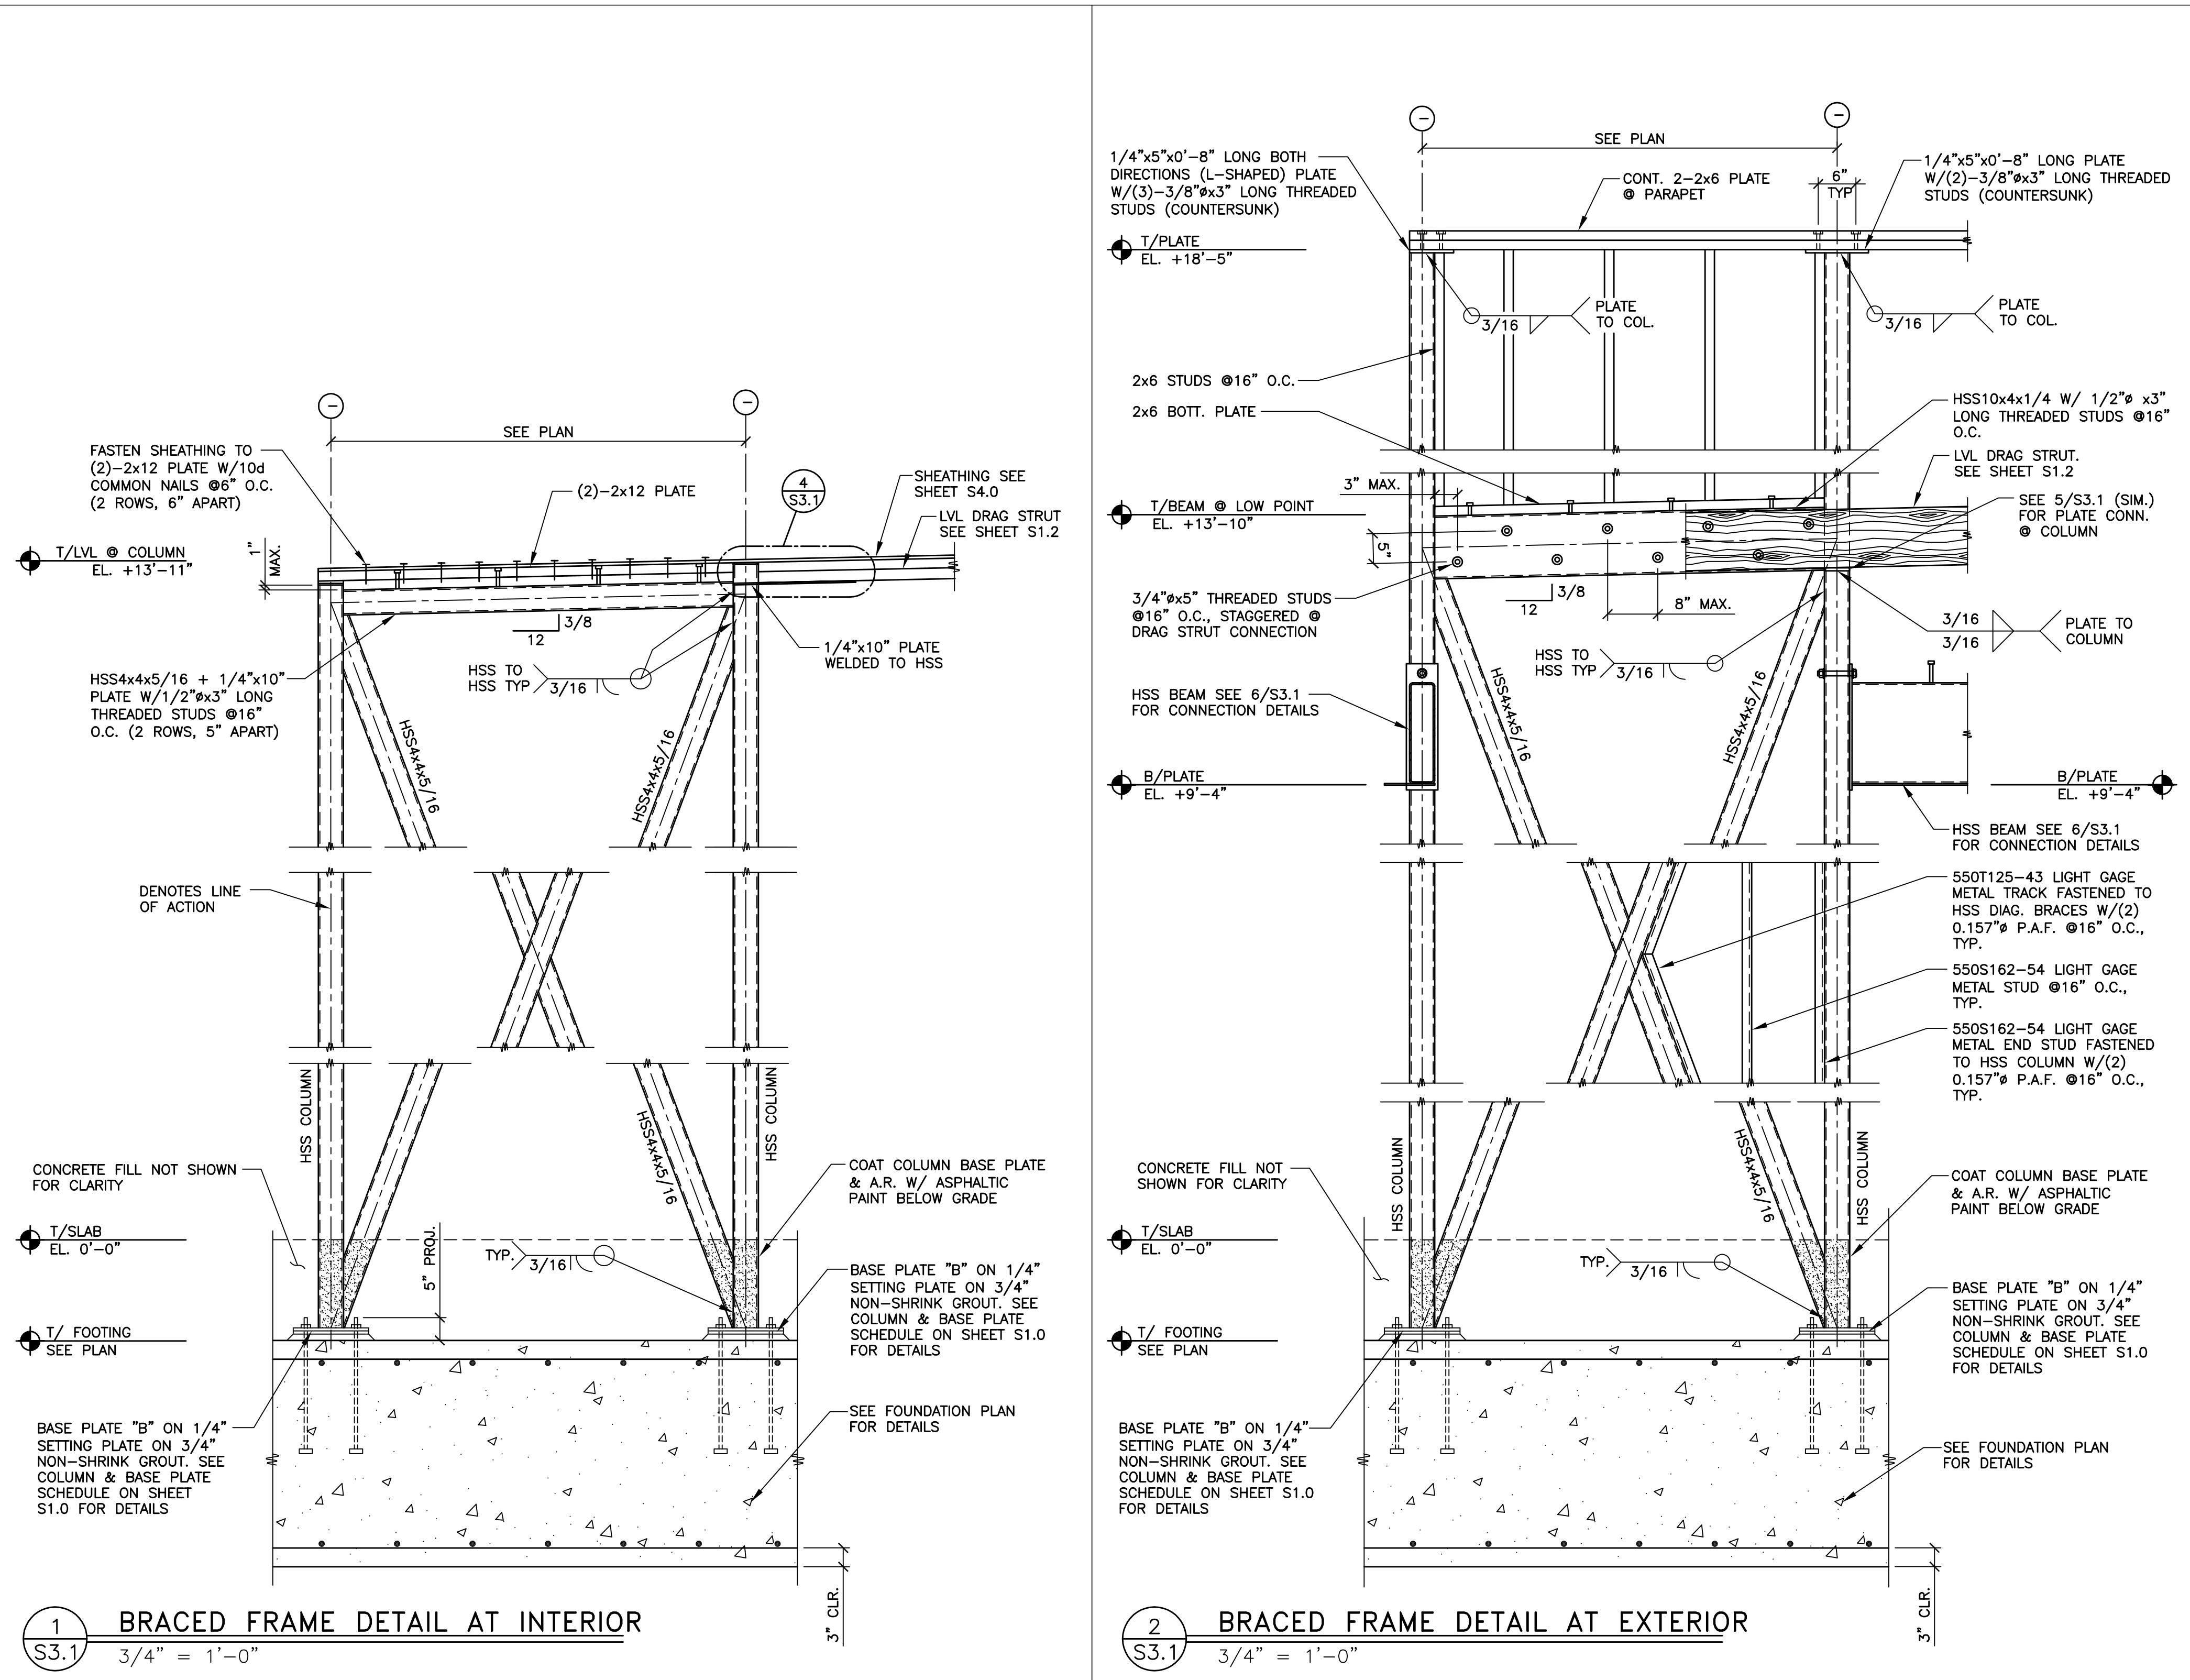

SHEET NO.	TITLE	DRAWN BY	CRB	STD ISSUE DATE	2019-11	REVIEWED BY	AVW	DATE ISSUED	1/23/20	PERMIT
015-0071.00.0	2019 STANDARD BUILDING - BB20 459-7E10-WOOD/WOOD									

McDonald's USA, LLC


PREPARED BY: W. Voigt & Associates, Inc.

STRUCTURAL ENGINEERING SERVICES

4635 NICOLIS RD.
EAST MINNEAPOLIS, MN 55422
(612) 295-1222
PHONE: (612) 867-4444
FAX:

©2020 McDonald's USA, LLC

These drawings are the confidential and proprietary property of McDonald's USA, LLC and shall not be copied or reproduced without written authorization. In the event these drawings are used on another project, reference shall be made to the original drawings for the correct use of these drawings. These drawings are not suitable for use on a different site or for reference or example on other projects. Reproduction of these drawings by licensed architects and engineers, or otherwise, without the contract documents for reuse on another project, is not authorized.

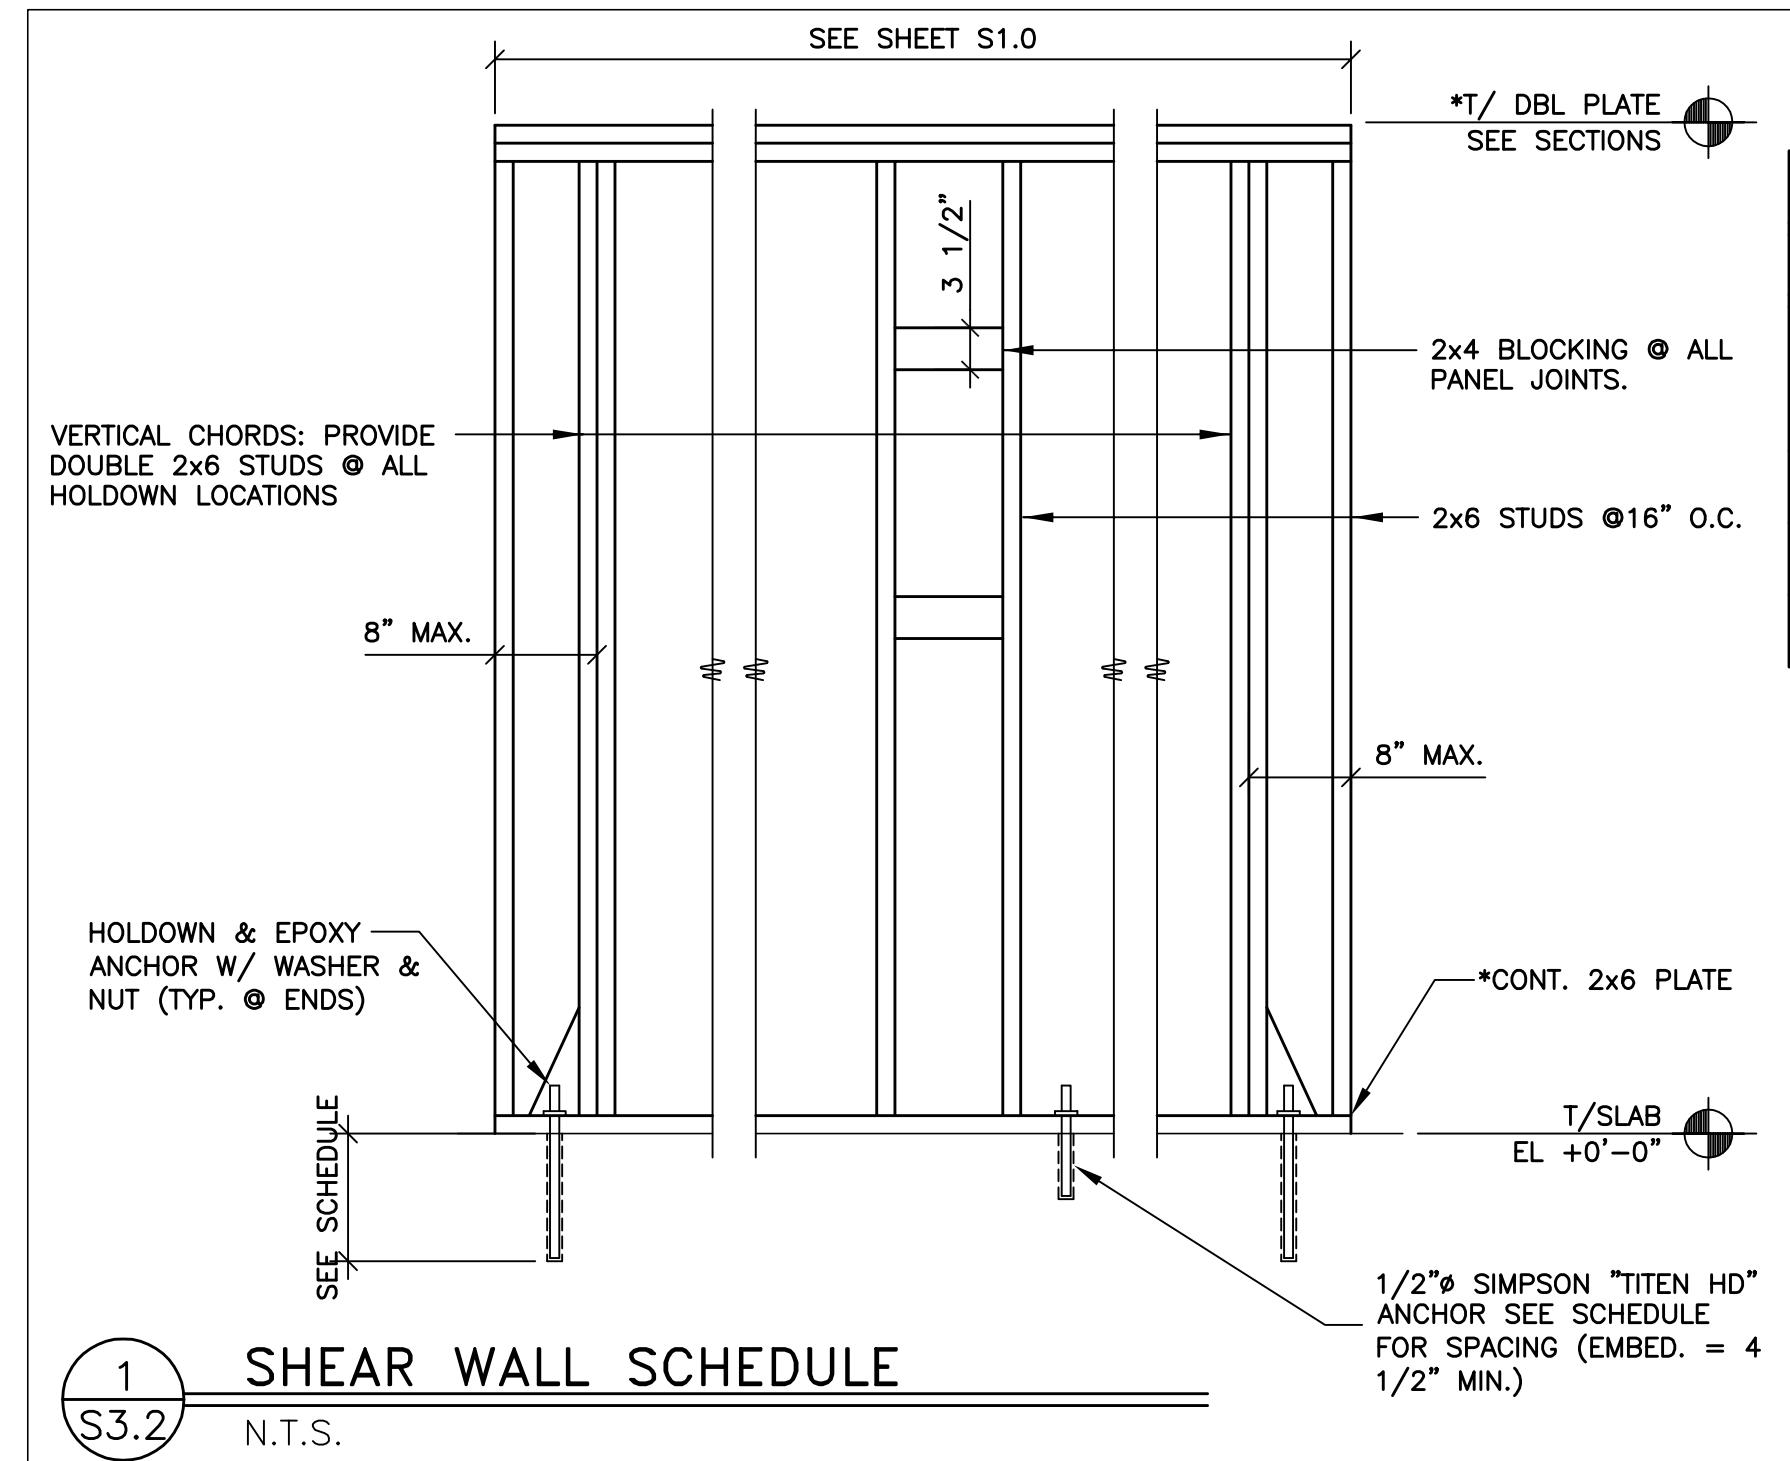

1 SHEAR WALL SCHEDULE

N.T.S.

<p>1. FOR NATIONAL ACCOUNT PACKAGE & PRICING CONTACT REDBUILT @ 1-866-859-6757 2. JOIST MFGR. TO VERIFY SIZE AT HVAC ROOF TOP UNITS.</p> <table border="1"> <thead> <tr> <th>HEADER</th> <th>HANGER</th> </tr> </thead> <tbody> <tr> <td>2x6</td> <td>LUS26</td> </tr> <tr> <td>2-2x6</td> <td>LUS26-2</td> </tr> <tr> <td>2x8</td> <td>LUS28</td> </tr> <tr> <td>2-2x8</td> <td>LUS28-2</td> </tr> <tr> <td>2x10</td> <td>LUS210</td> </tr> <tr> <td>2-2x10</td> <td>LUS210-2</td> </tr> </tbody> </table> <p>FOR OPENINGS < 1'-4" USE 1-2x6 FOR OPENINGS > 1'-4" AND < 4'-0" USE 2-2x8 FOR OPENINGS > 4'-0" AND < 6'-0" USE 2-2x10 3. ALL JOISTS SHALL BE DESIGNED FOR THE FOLLOWING NET UPLIFT. 115 MPH 3 SEC GUST - EXPOSURE C, UNFACTORED ASCE 7-10 LOADS WIND UPLIFT: INTERIOR = 26.4 PSF ULTIMATE PERIMETER = 31.4 PSF (ULTIMATE WITHIN 5 FT. OF OUTSIDE WALLS) DEAD LOAD RESISTANCE = 8 PSF</p>	HEADER	HANGER	2x6	LUS26	2-2x6	LUS26-2	2x8	LUS28	2-2x8	LUS28-2	2x10	LUS210	2-2x10	LUS210-2	<p>JOIST J1 PROFILE</p> <p>HEADER & HANGER SEE SCHED. WEBS TO BE DESIGNED TO ALLOW FOR 16" DUCT TO PASS THROUGH.</p> <p>LOAD TRANSFER BLOCKS CONCENTRATED LOADS</p> <p>SNOW DRIFT LOAD (PSF) WIDTH (FT)</p> <table border="1"> <thead> <tr> <th>DRAFT</th> <th>SHORt DIRECTION</th> <th>26</th> <th>6.1</th> </tr> </thead> <tbody> <tr> <th>LONG DIRECTION</th> <th>41</th> <th>9.8</th> </tr> </tbody> </table> <p>NOTE: SNOW DRIFT LOADS BASED ON NOMINAL, UNFACTORED GROUND SNOW LOADS. SEE SHEET S4.0 FOR ADDITIONAL INFORMATION.</p>	DRAFT	SHORt DIRECTION	26	6.1	LONG DIRECTION	41	9.8	<p>JOIST NOTES</p> <p>4 N.T.S.</p> <p>ROOF TOP UNIT CLEARANCES</p> <p>7 N.T.S.</p> <p>1/4" = 1'-0"</p> <p>JOIST DETAIL @ POINT LOADS</p> <p>3 N.T.S.</p> <p>NOT USED</p> <p>6 N.T.S.</p> <p>3/4" = 1'-0"</p> <p>NOT USED</p> <p>8 N.T.S.</p> <p>NOT USED</p> <p>9 N.T.S.</p>
HEADER	HANGER																						
2x6	LUS26																						
2-2x6	LUS26-2																						
2x8	LUS28																						
2-2x8	LUS28-2																						
2x10	LUS210																						
2-2x10	LUS210-2																						
DRAFT	SHORt DIRECTION	26	6.1																				
LONG DIRECTION	41	9.8																					
<p>ROOF TOP UNIT CLEARANCES</p> <p>7 N.T.S.</p> <p>1/4" = 1'-0"</p>	<p>OUTLINE OF CURB</p> <p>CONDENSER</p> <p>MAC UNIT</p> <p>OUTLINE OF CURB</p>	<p>NOT USED</p> <p>8 N.T.S.</p> <p>NOT USED</p> <p>9 N.T.S.</p>																					

SHEET NO.	TITLE	DRAWN BY	PREPARED FOR:
015-0071.00-0	2019 STANDARD BUILDING - BB20	CRB	McDonald's USA, LLC
	4597-10-WOOD/WOOD	STD ISSUE DATE	2019-11
		REVIEWED BY	AWM
		DATE ISSUED	1/23/20
		PERMIT	1/23/20
		USRD REVIEW SET	
		REV DATE	
		DESCRIPTION	
		STRUCTURAL ENGINEERING SERVICES	
		4635 NICOL RD.	
		MINNEAPOLIS, MN 55422	
		PHONE: (612) 296-2722	
		FAX: (612) 296-4444	
		voigt & associates, inc.	
		STRUCTURAL ENGINEERING SERVICES	
		4635 NICOL RD.	
		MINNEAPOLIS, MN 55422	
		PHONE: (612) 296-2722	
		FAX: (612) 296-4444	
		voigt & associates, inc.	
		STRUCTURAL ENGINEERING SERVICES	
		4635 NICOL RD.	
		MINNEAPOLIS, MN 55422	
		PHONE: (612) 296-2722	
		FAX: (612) 296-4444	

STRUCTURAL GENERAL NOTES:

DESIGN AND LOADING	
1.	THE STRUCTURAL DESIGN OF THIS BUILDING WAS BASED ON THE DESIGN CRITERIA:
A.	BUILDING CODE: 2012 INTERNATIONAL BUILDING CODE
B.	FLOOR: LIVE LOAD: 125 PSF
C.	ROOF: LIVE LOAD: 20 PSF DEAD LOAD: 20 PSF
D.	SNOW: GROUND LOAD: 20 PSF FLAT ROOF LOAD: 20 PSF SNOW EXPOSURE FACTOR, CE: 1.0 IMPORTANCE FACTOR, I: 1.0 THERMAL COEFFICIENT, CT: 1.0
E.	WIND: BASIC WIND SPEED: 115 MPH (3-SECOND GUST ULTIMATE) IMPORTANCE FACTOR: 1.00 BUILDING OCCUPANCY CATEGORY: II WIND EXPOSURE: C PRESSURES PER ASCE7
F.	SEISMIC: OCCUPANCY CATEGORY: II IMPORTANCE FACTOR: 1.00 SITE CLASS: D SS = 0.111G, S1= 0.063G SDS = 0.118, SD1 = 0.101 DESIGN CATEGORY: B PLYWOOD SHEAR WALLS (R = 6.5) OSCBF (R = 3.25) Cs1: 0.018 Cs2: 0.036 DESIGN BASE SHEAR = SEE CALCULATIONS ANALYSIS PROCEDURE: EQUIVALENT LATERAL FORCE PROCEDURE
G.	FLOOD LOAD: N/A
H.	SPECIAL LOADS: N/A

FOUNDATION NOTES	
1.	THE FOUNDATION DESIGN OF THIS BUILDING WAS BASED ON THE FOLLOWING CRITERIA:
A.	MINIMUM ALLOWABLE SOIL BEARING CAPACITY = 2000 PSF.
B.	RECOMMENDED BY OLSSON, INC - IN THEIR REPORT #019-1175 DATED 5-22-19, ANY FILL REQUIRED BELOW SLABS ON GRADE OR FOOTINGS SHALL BE COMPACTED AS REQUIRED BY THE SOILS REPORT NOTED IN ITEM #2.
2.	ALL EXTERIOR FOOTINGS SHALL EXTEND BELOW THE MAXIMUM ANTICIPATED DEPTH OF FROST.
3.	THE CONTRACTOR SHALL NOTIFY THE ARCHITECT OR ENGINEER OF RECORD IMMEDIATELY IN THE EVENT THAT THE SOILS CONDITIONS ENCOUNTERED VARY FROM THOSE SHOWN ON THE BORING LOGS.
4.	ALL FOUNDATION EXCAVATIONS SHALL BE INSPECTED BY A SOILS TESTING LABORATORY PRIOR TO PLACEMENT OF CONCRETE.

CONCRETE AND REINFORCING	
1.	ALL CONCRETE SHALL BE IN ACCORDANCE WITH THE "AMERICAN CONCRETE INSTITUTE BUILDING CODE" (ACI 318) AND WITH "SPECIFICATIONS FOR STRUCTURAL CONCRETE FOR BUILDINGS" (ACI 301) LATEST EDITIONS.
2.	ALL NORMAL WEIGHT CONCRETE (145 PCF) SHALL OBTAIN A MINIMUM 28 DAY COMPRESSIVE STRENGTH OF 3000 PSI (3500 PSI FOR SLABS).
3.	ALL CONCRETE SUBJECT TO EXTERIOR EXPOSURE SHALL BE AIR ENTRAINED AS RECOMMENDED BY ACI 318.
4.	TEST CYLINDERS SHALL BE MADE AND TESTED AS OUTLINED IN CHAPTER 16 OF ACI-301.
5.	REINFORCING BARS SHALL BE DEFORMED BARS OF NEW BILLET STEEL CONFORMING TO ASTM A-615, GRADE 60. WELDED WIRE FABRIC SHALL CONFORM TO ASTM A-185. ALL REINFORCING AND ACCESSORIES SHALL BE DETAILED AND PLACED IN ACCORDANCE WITH ACI STANDARD 315 AND 315R.
6.	PROVIDE ALL ACCESSORIES NECESSARY TO SUPPORT REINFORCEMENT AT POSITIONS SHOWN ON THE PLANS AND DETAILS. PLASTIC COATED ACCESSORIES SHALL BE USED IN ALL EXPOSED CONCRETE WORK.
7.	THE GENERAL CONTRACTOR SHALL CHECK WITH ARCHITECTURAL, MECHANICAL AND ELECTRICAL DRAWINGS AND THE SUB-CONTRACTORS FOR OPENINGS, SLEEVES, ANCHORS, HANGERS, INSERTS, SLAB DEPRESSIONS AND OTHER ITEMS RELATED TO THE CONCRETE WORK AND SHALL ASSUME RESPONSIBILITY FOR THEIR PROPER LOCATION.

STRUCTURAL STEEL	
1.	STRUCTURAL STEEL SHALL BE DETAILED, FABRICATED AND ERECTED IN CONFORMANCE WITH THE AISC360 "SPECIFICATION FOR STRUCTURAL STEEL". SEISMIC DESIGN OF STRUCTURAL STEEL STRUCTURES SHALL CONFORM TO AISC 341.
2.	STRUCTURAL STEEL SHALL CONFORM TO THE FOLLOWING ASTM SPECIFICATIONS:
A.	ANCHOR RODS F1554, GRADE 36
B.	HIGH STRENGTH STRUCTURAL BOLTS A325-N U.N.O.
C.	STRUCTURAL SHAPES (W) A992
D.	STRUCTURAL SHAPES (M, S, C, MC, PLATES) A36
E.	STRUCTURAL SHAPES (HP) A572
F.	STRUCTURAL TUBING (HSS) A500 GRADE B
G.	STRUCTURAL ANGLES A36
3.	ALL WELDING ELECTRODES SHALL BE E70-XX. ALL SHOP AND FIELD WELDING SHALL BE MADE IN ACCORDANCE WITH A.W.S. D1.1 "CODE FOR WELDING IN BUILDING CONSTRUCTION" AND SHALL BE MADE BY CERTIFIED WELDERS.

LAMINATED VENEER LUMBER (LVL)	
1.	ALL BEAMS SHALL BE MANUFACTURED WITH LAMINATED VENEER LUMBER AND WATERPROOF ADHESIVES.
2.	SIZE, MANUFACTURER & SERIES OF ALL LVL MEMBERS SHALL BE AS SHOWN ON DRAWINGS.
3.	ANY SUBSTITUTIONS MUST BE APPROVED IN WRITING BY ENGINEER OR ARCHITECT OF RECORD.
4.	PROVIDE 3" MINIMUM BEARING OR AS SPECIFIED ON PLANS. REFER TO PLANS FOR FASTENING OF MULTIPLE PIECE BEAMS.

OPEN WEB WOOD JOISTS	
1.	OPEN WEB WOOD JOISTS SHALL BE MANUFACTURED WITH MACHINE STRESS RATED TOP AND BOTTOM CHORDS. WEBS SHALL BE TUBULAR STEEL MEMBERS PER MANUFACTURERS' SPECIFICATIONS.
2.	SIZE, MANUFACTURER & SERIES OF ALL OPEN WEB JOISTS SHALL BE AS SHOWN ON DRAWINGS. ANY SUBSTITUTIONS MUST BE APPROVED IN WRITING BY ENGINEER OR ARCHITECT OF RECORD.
3.	PROVIDE 3 1/2" MINIMUM BEARING OR AS SPECIFIED ON PLANS. SHIM AS REQUIRED TO PROVIDE FULL BEARING AND LEVEL SUPPORT.
4.	DO NOT CUT TOP OR BOTTOM CHORDS.
5.	ALL HANGERS AND FRAMING CONNECTORS SHOWN ARE MANUFACTURED BY SIMPSON STRONG TIE. ANY SUBSTITUTIONS MUST BE APPROVED IN WRITING BY ENGINEER OR ARCHITECT OF RECORD.
6.	REFER TO PLANS FOR WEB STIFFENER AND CONCENTRATED LOAD REQUIREMENTS.
7.	REFER TO MANUFACTURERS' INSTALLATION GUIDE FOR JOIST BRACING DURING ERECTION. REFER TO MANUFACTURERS' INSTALLATION GUIDE FOR JOIST BRIDGING REQUIREMENTS.

SAWN LUMBER	
1.	ALL GRADES OF LUMBER INDICATED ON STRUCTURAL DRAWINGS SHALL BE RATED BY THE SOUTHERN PINE INSPECTION BUREAU (SPIB), OR THE WESTERN WOOD PRODUCTS ASSOCIATION (WWPA). LUMBER GRADES SHALL BE AS FOLLOWS, WITH A MAXIMUM MOISTURE CONTENT OF 19%:
A.	SOUTHERN PINE NO. 1.
B.	DOUGLAS FIR-LARCH NO. 1.
C.	HEM-FIR NORTH NO. 1
2.	BOLT HEADS AND NUTS BEARING ON WOOD SHALL BE PROVIDED WITH STANDARD CUT WASHERS. ALL WOOD IN CONTACT WITH CONCRETE OR MASONRY SHALL BE PRESSURE TREATED.
3.	MINIMUM NAILED CONNECTIONS FOR WOOD FRAMING MEMBERS SHALL BE IN ACCORDANCE WITH THE LOCAL BUILDING CODE OR TABLE 2304.9.1 OF THE INTERNATIONAL BUILDING CODE IF NO OTHER CRITERIA IS GIVEN.
4.	CONNECTORS SHOWN ON THE DETAILS ARE MANUFACTURED BY SIMPSON. WRITTEN APPROVAL BY ENGINEER REQUIRED FOR SUBSTITUTIONS.

ROOF & WALL SHEATHING	
1.	ALL SHEATHING SHALL CONFORM TO AMERICAN PLYWOOD ASSOCIATION (APA) DESIGN SPECIFICATIONS, LATEST EDITION. SHEATHING SHALL BE CONTINUOUS OVER THREE ADJACENT SPANS MINIMUM.
2.	WALL SHEATHING SHALL BE 15/32" (1/2" NOMINAL) APA RATED SHEATHING, EXPOSURE 1, 32/16. ALL WALL SHEATHING SHALL BE FASTENED TO SUPPORTING MEMBERS W/ 8d COMMON NAILS @ 6" O.C. AT PANEL EDGES AND 12" O.C. AT INTERMEDIATE SUPPORTS, U.N.O.
3.	ROOF SHEATHING SHALL BE 23/32" (3/4" NOMINAL) APA RATED SHEATHING, EXPOSURE 1, 48/24. ALL ROOF SHEATHING SHALL BE FASTENED TO SUPPORTING MEMBERS W/ 10d COMMON NAILS @ 6" O.C. AT PANEL EDGES, AND 12" O.C. AT INTERMEDIATE SUPPORTS. U.N.O.

CONCRETE BLOCK JOINT REINFORCEMENT:
ALL CONCRETE BLOCK WALLS TO RECEIVE THE FOLLOWING JOINT REINFORCEMENT:
LADDER TYPE JOINT REINFORCING WITH SIDE AND CROSS RODS WITH WIRE SIZE (W2.8 OR 3/16") SPACED 16" O.C. VERTICALLY. (HOHMANN & BARNARD 220 "SUPER HEAVY DUTY" OR EQUAL) SIMILAR FOR CONCRETE BRICK PRODUCTS.

1 CONCRETE BLOCK JOINT REINFORCEMENT

VENEER TIE REQUIREMENTS:

1. USE THE FOLLOWING:
VENEER TIES W/ WIRE SIZE (W2.8 OR 3/16") SPACED 16" O.C. VERTICALLY AND 32" HORIZONTALLY. ADDITIONAL TIES ALONG ALL OPENINGS GREATER THAN 16" ARE REQUIRED TO BE LOCATED WITHIN 12" OF OPENING AND SPACED 36" O.C. MAX. AROUND OPENING PERIMETER. (HOHMANN & BARNARD VBT-VEE-BYNA TIE WITH DW10-HS ANCHOR PLATE OR EQUAL).

2 VENEER TIE REQUIREMENTS

SHOP DRAWINGS

1. SHOP DRAWING SUBMITTALS SHALL BE SUBMITTED ELECTRONICALLY.
2. SHOP DRAWINGS SHALL BE REVIEWED BY CONTRACTOR TO VERIFY THAT SUBMITTAL IS COMPLETE PRIOR TO SUBMITTING TO ARCHITECT/ENGINEER.
3. DRAWINGS CREATED BY THE ENGINEER OF RECORD CANNOT BE REPRODUCED AND/OR USED AS A SHOP DRAWING SUBMITTAL. SHOP DRAWING SUBMITTALS SHALL INCLUDE THE FOLLOWING:
 - A. CONCRETE MIX DESIGN
 - B. FOUNDATION REINFORCING BARS
 - C. STRUCTURAL STEEL
 - D. OPEN WEB JOISTS AND CALCULATIONS
 - E. ROOF SHEATHING
 - F. TRELLIS SYSTEM & CALCULATIONS
 - G. LAMINATED VENEER LUMBER (LVL)
 - H. SAWN LUMBER AND CONNECTORS


SPECIAL INSPECTIONS

1. SPECIAL INSPECTIONS SHALL BE PERFORMED IN ACCORDANCE WITH SECTION 1705 OF IBC AND THE OWNER SHALL EMPLOY ONE OR MORE SPECIAL INSPECTORS TO PROVIDE INSPECTIONS DURING CONSTRUCTION ON THE TYPES OF WORK LISTED UNDER SECTION 1705. THE FOLLOWING AREAS OF WORK REQUIRE SPECIAL INSPECTIONS IN ACCORDANCE WITH THE LISTED 2012 INTERNATIONAL BUILDING CODE SECTIONS/LOCATIONS:
 - A. SOILS – SECTION 1705.6 PER TABLE 1705.6
 - B. CONCRETE – SECTION 1705.3 PER TABLE 1705.3
 - C. STEEL – SECTION 1705.2 (SEE AISC 360.10)


MISCELLANEOUS

1. ALL DIMENSIONS ON STRUCTURAL DRAWINGS TO BE CHECKED AGAINST ARCHITECTURAL, MECHANICAL AND ELECTRICAL DRAWINGS BY THE GENERAL CONTRACTOR AND ANY DISCREPANCIES ARE TO BE REPORTED TO THE ARCHITECT IMMEDIATELY.
2. THE CONTRACTOR SHALL ASSUME RESPONSIBILITY, UNRELIEVED BY REVIEW OF SHOP DRAWINGS OR PERIODIC OBSERVATION OF CONSTRUCTION, FOR COMPLIANCE WITH THE CONTRACT DOCUMENTS, FOR FABRICATION PROCESSES AND CONSTRUCTION TECHNIQUES, AND FOR SAFE CONDITIONS ON THE JOB SITE.
3. DO NOT SCALE THE DRAWINGS.


PREPARED BY:	McDonald's USA, LLC		
©2020 McDonald's USA, LLC			
DRAWN BY:	CRB	STD ISSUE DATE:	2019-11
REVIEWED BY:	AVM	DATE ISSUED:	1/23/20
DESCRIPTION:		WOOD BEARING WALLS W/FIBER CEMENT SIDING & CI	
SHEET NO.:		015-0071.00.0	
TITLE:		2019 STANDARD BUILDING - BB20	
DESCRIPTION:		4597-10-WOOD/WOOD	
SITE ID:		015-0071	
SITE ADDRESS:		605 SOUTH 7TH STREET, KANSAS CITY, KS	
REV. DATE:		V&F M20-001	
PERMIT DATE:		1/23/20	
USRD REVIEW SET:		1/23/20	
DESCRIPTION:		STRUCTURAL NOTES	

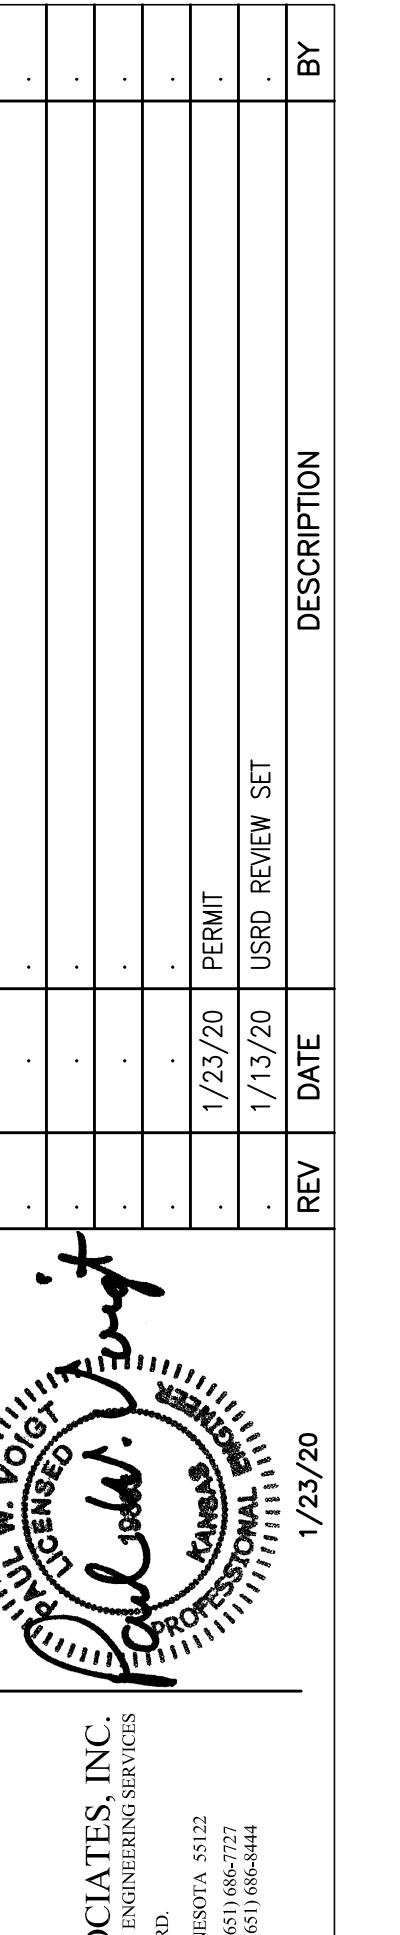

W. VOIGT & ASSOCIATES, INC.
STRUCTURAL ENGINEERING SERVICES
4035 NICOLLS RD.
ELLIOTTSBURG, MINNESOTA 55122
PHONE: (651) 686-2727
FAX: (651) 686-8444

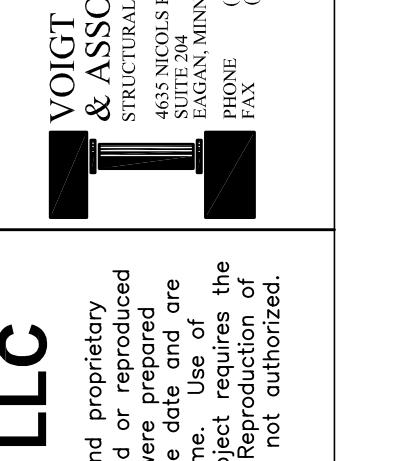

K. JOHNSON & ASSOCIATES, INC.
PROFESSIONAL SERVICES
1000 1/2 AVENUE
MINNEAPOLIS, MN 55402
PHONE: (612) 332-1200
FAX: (612) 332-1201

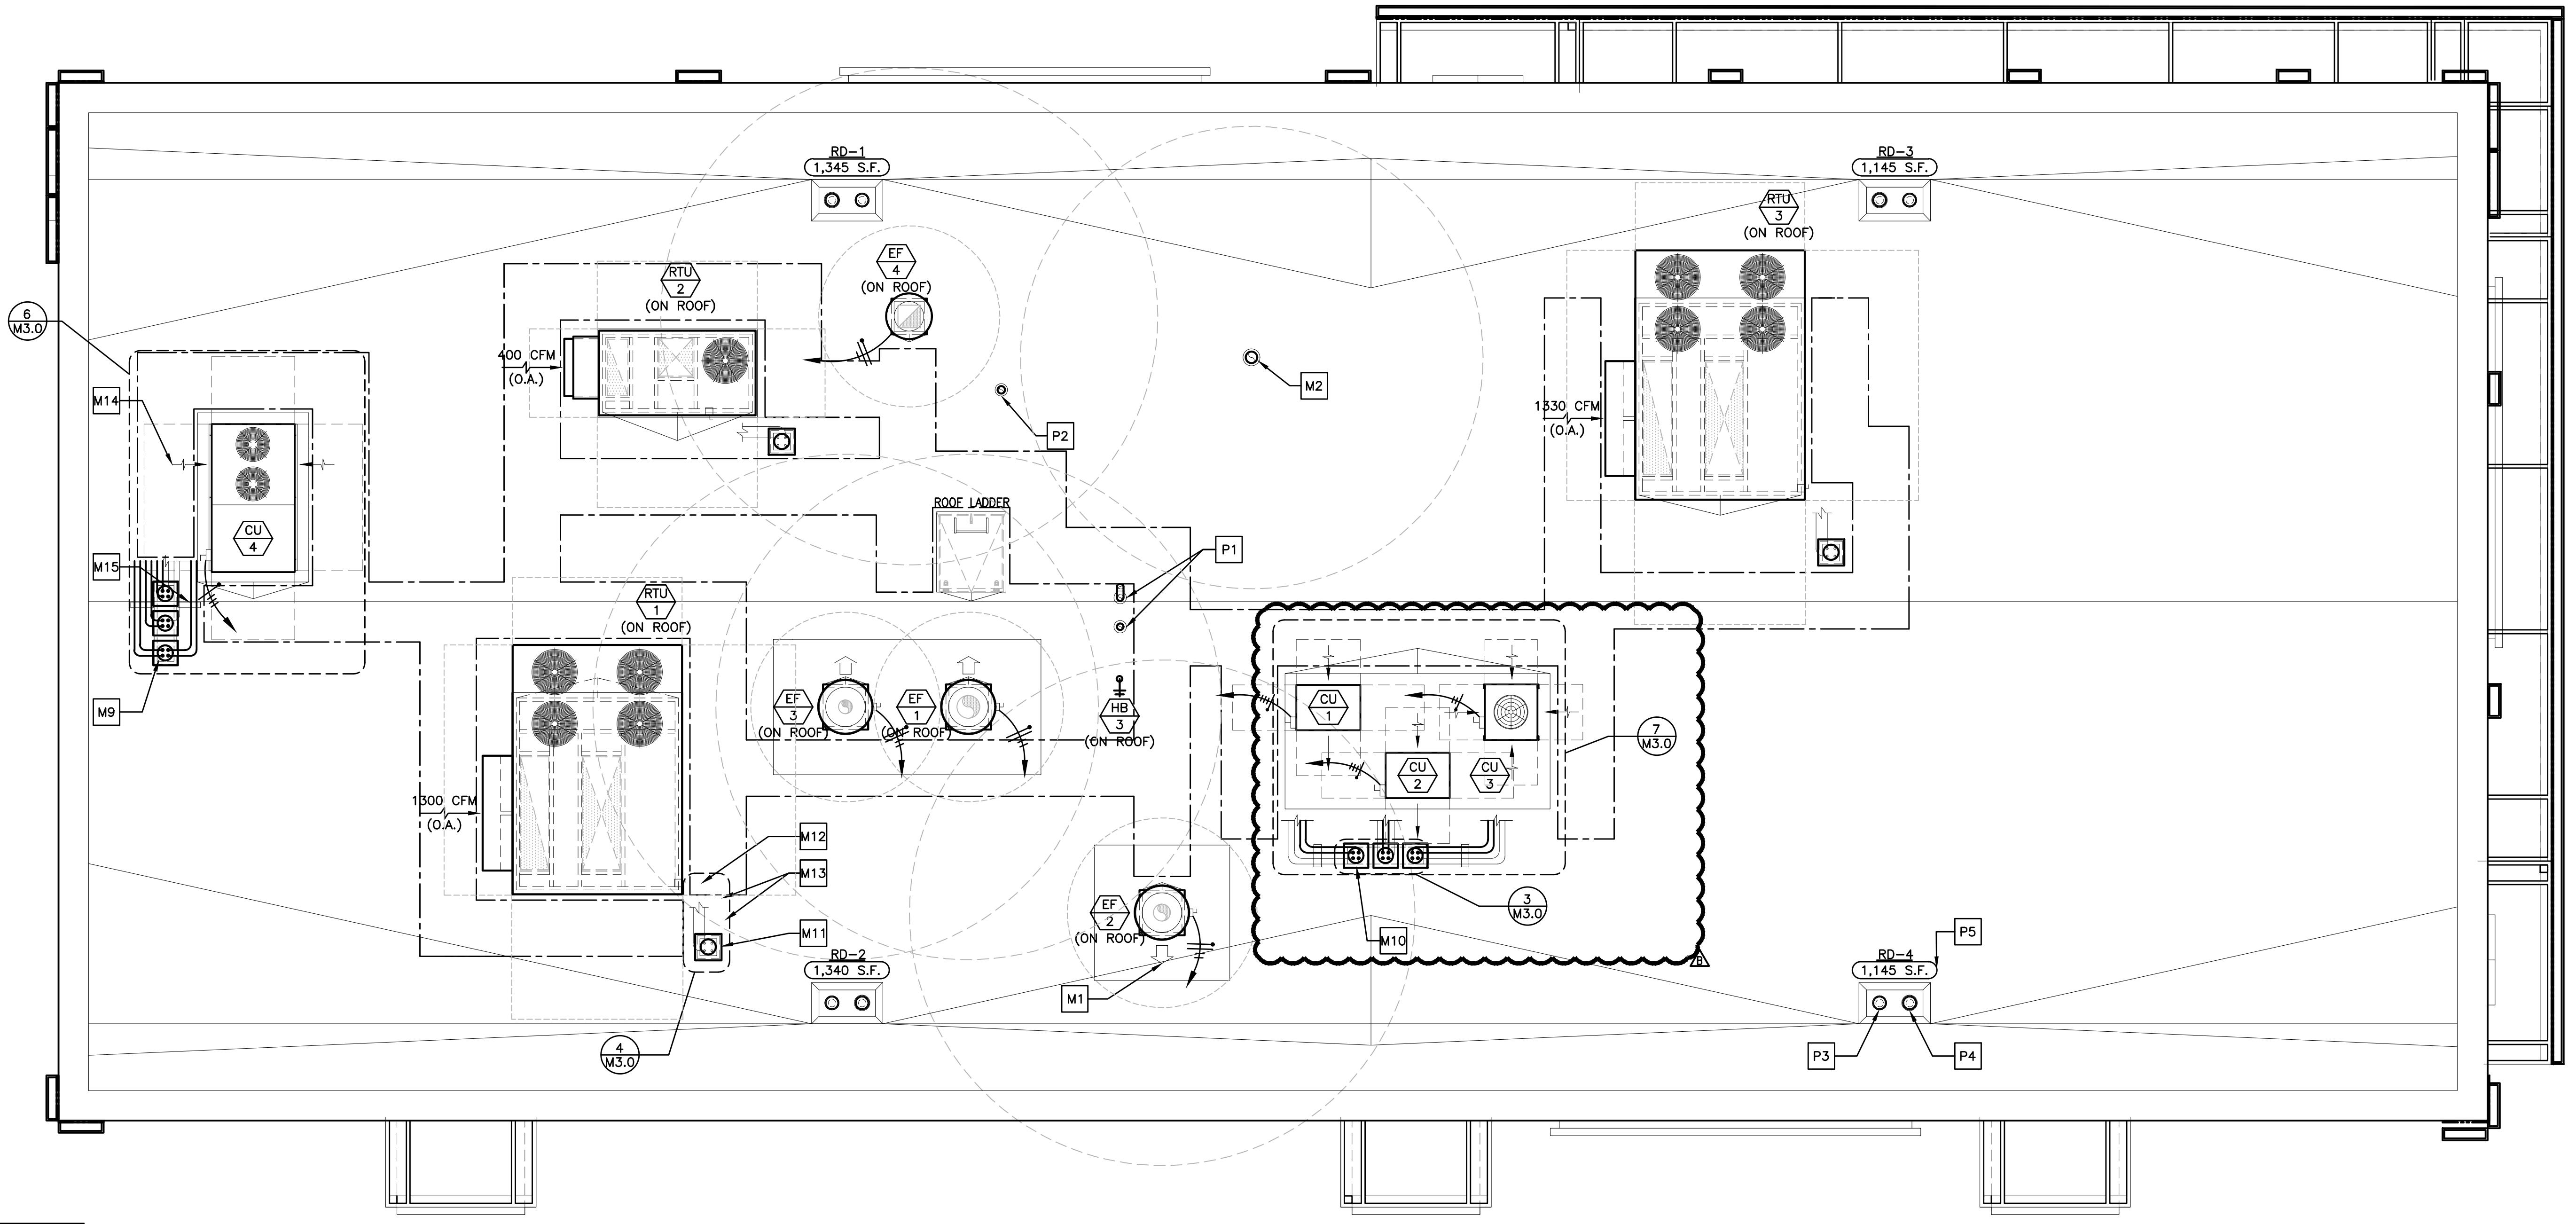

1 ROOF PLAN
M1.0 1/4"=1'-0"

DRAWING NOTES

- ROOFTOP EQUIPMENT LOCATIONS SHOWN ARE GENERAL. ACTUAL LOCATIONS SHALL BE COORDINATED WITH THE STRUCTURAL DRAWINGS.
- ROOF OPENINGS FOR ROOFTOP UNITS AND EXHAUST FANS SHALL BE COORDINATED WITH THE MANUFACTURER.
- ROOF OPENINGS FOR PIPE PORTALS SHALL ONLY BE LARGE ENOUGH TO ALLOW PIPE AND CONDUIT PENETRATIONS. PIPE PORTAL CURB SHALL BE FILLED WITH AS MUCH BATT INSULATION AS POSSIBLE.
- PRIOR TO INSTALLING THE TOP OF THE EQUIPMENT PLATFORM, INSIDE OF THE PLATFORM SHALL BE INSULATED WITH AS MUCH BATT INSULATION AS POSSIBLE.

DRAWINGS AND SPECIFICATIONS ARE TO BE CONSIDERED AS SUPPLEMENTING EACH OTHER. WORK SPECIFIED BUT NOT SHOWN ON DRAWINGS, OR SHOWN ON DRAWINGS BUT NOT SPECIFIED, SHALL BE PERFORMED OR FURNISHED AS THOUGH MENTIONED IN BOTH SPECIFICATIONS AND DRAWINGS, IF NOT OTHERWISE DIRECTED. INSTALLATION OF ALL SYSTEMS AND EQUIPMENT SHALL BE IN ACCORDANCE WITH APPLICABLE CODES AND IN ACCORDANCE WITH MANUFACTURER'S INSTALLATION INSTRUCTIONS. WHERE WORK DESCRIBED IN THE SPECIFICATIONS IS IN CONFLICT WITH THE WORK SHOWN ON THE DRAWINGS, THE CONTRACTOR SHALL SUPPLY THE GREATER QUANTITY, QUALITY AND COST VIA THE BID AND CONTACT THE ENGINEER FOR CLARIFICATION ON DIRECTION PRIOR TO INSTALLATION.

PRIOR TO BD, THE CONTRACTOR SHALL REVIEW THE MECHANICAL, ELECTRICAL AND KITCHEN EQUIPMENT DRAWINGS. THE CONTRACTOR SHALL INCLUDE IN HIS BID ALL RELEVANT WORK IN THE ENTIRE SET OF DOCUMENTS AND REPORT ALL DISCREPANCIES BETWEEN THESE DRAWINGS TO THE ENGINEER PRIOR TO BIDDING FOR CLARIFICATION. IF DISCREPANCIES REMAIN UNRESOLVED DUE TO A SHORT TIME FRAME, THE CONTRACTOR SHALL INCLUDE THE MOST WORK AND THE HIGHER COSTS IN THE BID. SOLUTIONS TO UNREPORTED DISCREPANCIES WILL BE DETERMINED BY THE ARCHITECT/ENGINEER, WITH NO ADDITIONAL COMPENSATION DUE TO THE CONTRACTOR.

KEYED NOTES

M1 ARROW INDICATES DIRECTION OF EXHAUST FAN HINGE SWING (TYP.)
 M2 6"Ø ALUMINUM EXHAUST DUCT FROM EXHAUST FAN (EF-5). PROVIDE PORTALS PLUS PLASTI-FLASH WITH C-126 CAP (OR EQUAL) FOR ROOF PENETRATION.

M3 NOT USED

M4 NOT USED

M5 NOT USED

M6 NOT USED

M7 NOT USED

M8 NOT USED

M9 ROOF PIPE PORTAL FOR MAC UNIT

M10 ROOF PIPE PORTAL FOR CONDENSING UNITS

M11 ROOF PIPE PORTAL FOR ROOFTOP UNITS (TYP. 3 PLACES)

M12 GAS PIPING FROM ROOF PORTAL TO ROOFTOP UNIT SHALL BE COATED WITH A CORROSION RESISTANT PAINT (SEE GAS PIPING NOTES)

M13 GAS PRESSURE REGULATOR AND SHUT-OFF VALVE (TYP.)

M14 ARROW INDICATES DIRECTION OF AIRFLOW FOR CONDENSING OR ROOFTOP UNIT AIR INTAKE (TYP.)

M15 REFRIGERANT PIPING SUPPORT AS REQUIRED. PROVIDE ROOFTOP BLOX MODEL RTB-01 (OR EQUAL) AND ALL NECESSARY ACCESSORIES FOR PROPER PIPE AND CONDUIT SUPPORT. PROVIDE GALVANIZED PIPE SHIELD TO PROTECT INSULATION AT ALL SUPPORTS.

P1 COMBUSTION AIR INTAKE AND EXHAUST VENT FOR SEALED COMBUSTION WATER HEATER (SEE PLUMBING DRAWINGS). PROVIDE PORTALS PLUS PLASTIFLASH WITH C-126 CAP (OR EQUAL) FOR ROOF PENETRATION.

P2 PLUMBING VENT THROUGH ROOF (SEE PLUMBING DRAWINGS). PROVIDE PORTALS PLUS PLASTI-FLASH WITH C-126 CAP (OR EQUAL) FOR ROOF PENETRATION.

P3 PRIMARY ROOF DRAIN WITH DOME STRAINER (SEE PLUMBING DRAWINGS)

P4 OVERFLOW ROOF DRAIN WITH DOME STRAINER (SEE PLUMBING DRAWINGS)

P5 AREA OF ROOF SERVED BY ROOF DRAIN (TYP.)

PIPE PORTAL SCHEDULE


MANUFACTURER	CURB DIMENSIONS	CURB TYPE	CAP TYPE (QTY)	SERVES	MODE	FAN	COOLING	HEATING
RPS	12"x12"x11"H	RC-2A	N18 (1)	RTU-1 THROUGH RTU-3	OCCUPIED	ON	75°F	70°F
RPS	43"x12"x13"H	RC-2A	N18 (3)	CU-4	UNOCCUPIED	AUTO	90°F	55°F
RPS	27"x12"x13"H	RC-2A	N18 (2)	CU-1 THROUGH CU-3	HUMIDITY SETPOINT (FOR DEHUMIDIFICATION UNITS ONLY)	60%	DEMAND CONTROL VENTILATION	

SEQUENCE OF OPERATION

THERMOSTAT SETTINGS		
DRAWN BY	M.J.W	SETPOINTS
STD ISSUE DATE	2019-11	REVIEWED BY
DESCRIPTION	W.L.W	W.L.W
DATE ISSUED	01/23/20	01/23/20
SITE ID	015-0071.00.B	015-0071.00.B
SITE ADDRESS	605 SOUTH 7TH STREET, KANSAS CITY, KS	605 SOUTH 7TH STREET, KANSAS CITY, KS

RTU-1, RTU-2 & RTU-3:
 1. OCCUPIED MODE SHALL BEGIN AS FOLLOWS:
 • RTU-1: 1.5 HOURS BEFORE OPEN
 • RTU-2: 1 HOUR BEFORE OPEN
 • RTU-3: 30 MINUTES BEFORE OPEN
 2. ROOFTOP UNIT FAN SHALL RUN CONTINUOUSLY DURING OCCUPIED MODE
 3. ECONOMIZER SHALL BE OPEN DURING OCCUPIED MODE (OUTDOOR AIR THROUGH ROOFTOP UNITS SERVES AS MAKE-UP AIR FOR THE KITCHEN EXHAUST SYSTEM) – REFER TO E3.2 FOR HOOD/FAN INTERLOCK DETAILS.
 4. UNOCCUPIED MODE SHALL BEGIN ONE (1) HOUR AFTER STORE CLOSES
 5. DURING UNOCCUPIED MODE, ECONOMIZER IS CLOSED AND HEATING, COOLING AND FAN OPERATE IN AUTO MODE (ON DEMAND)

SHEET NO.	TITLE	DESIGNER
015-0071.00.B	2019 STANDARD BUILDING - BB20	McDonald's USA, LLC
M1.0	4597F10-WOOD/WOOD	emmanuelson-podas consulting engineers
015-0071.00.B	ROOF PLAN	Michael Weber, PE LIC# 17648 3801.0037 Emmanuelson-Podas, Inc. Edina, MN 55439 (612) 990-0050 www.epinc.com
REV. DATE	DESCRIPTION	BY
12/03/20	1. SERVICE AREA OPTIMIZATION	W.L.W
11/13/20	2. USDG SAO SET REVIEW	W.L.W
05/05/20	3. CIVIL & PLAN REVIEW COMMENTS	W.L.W
01/23/20	4. PERMIT SET	W.L.W
01/13/20	5. PROGRESS SET REVIEW	W.L.W

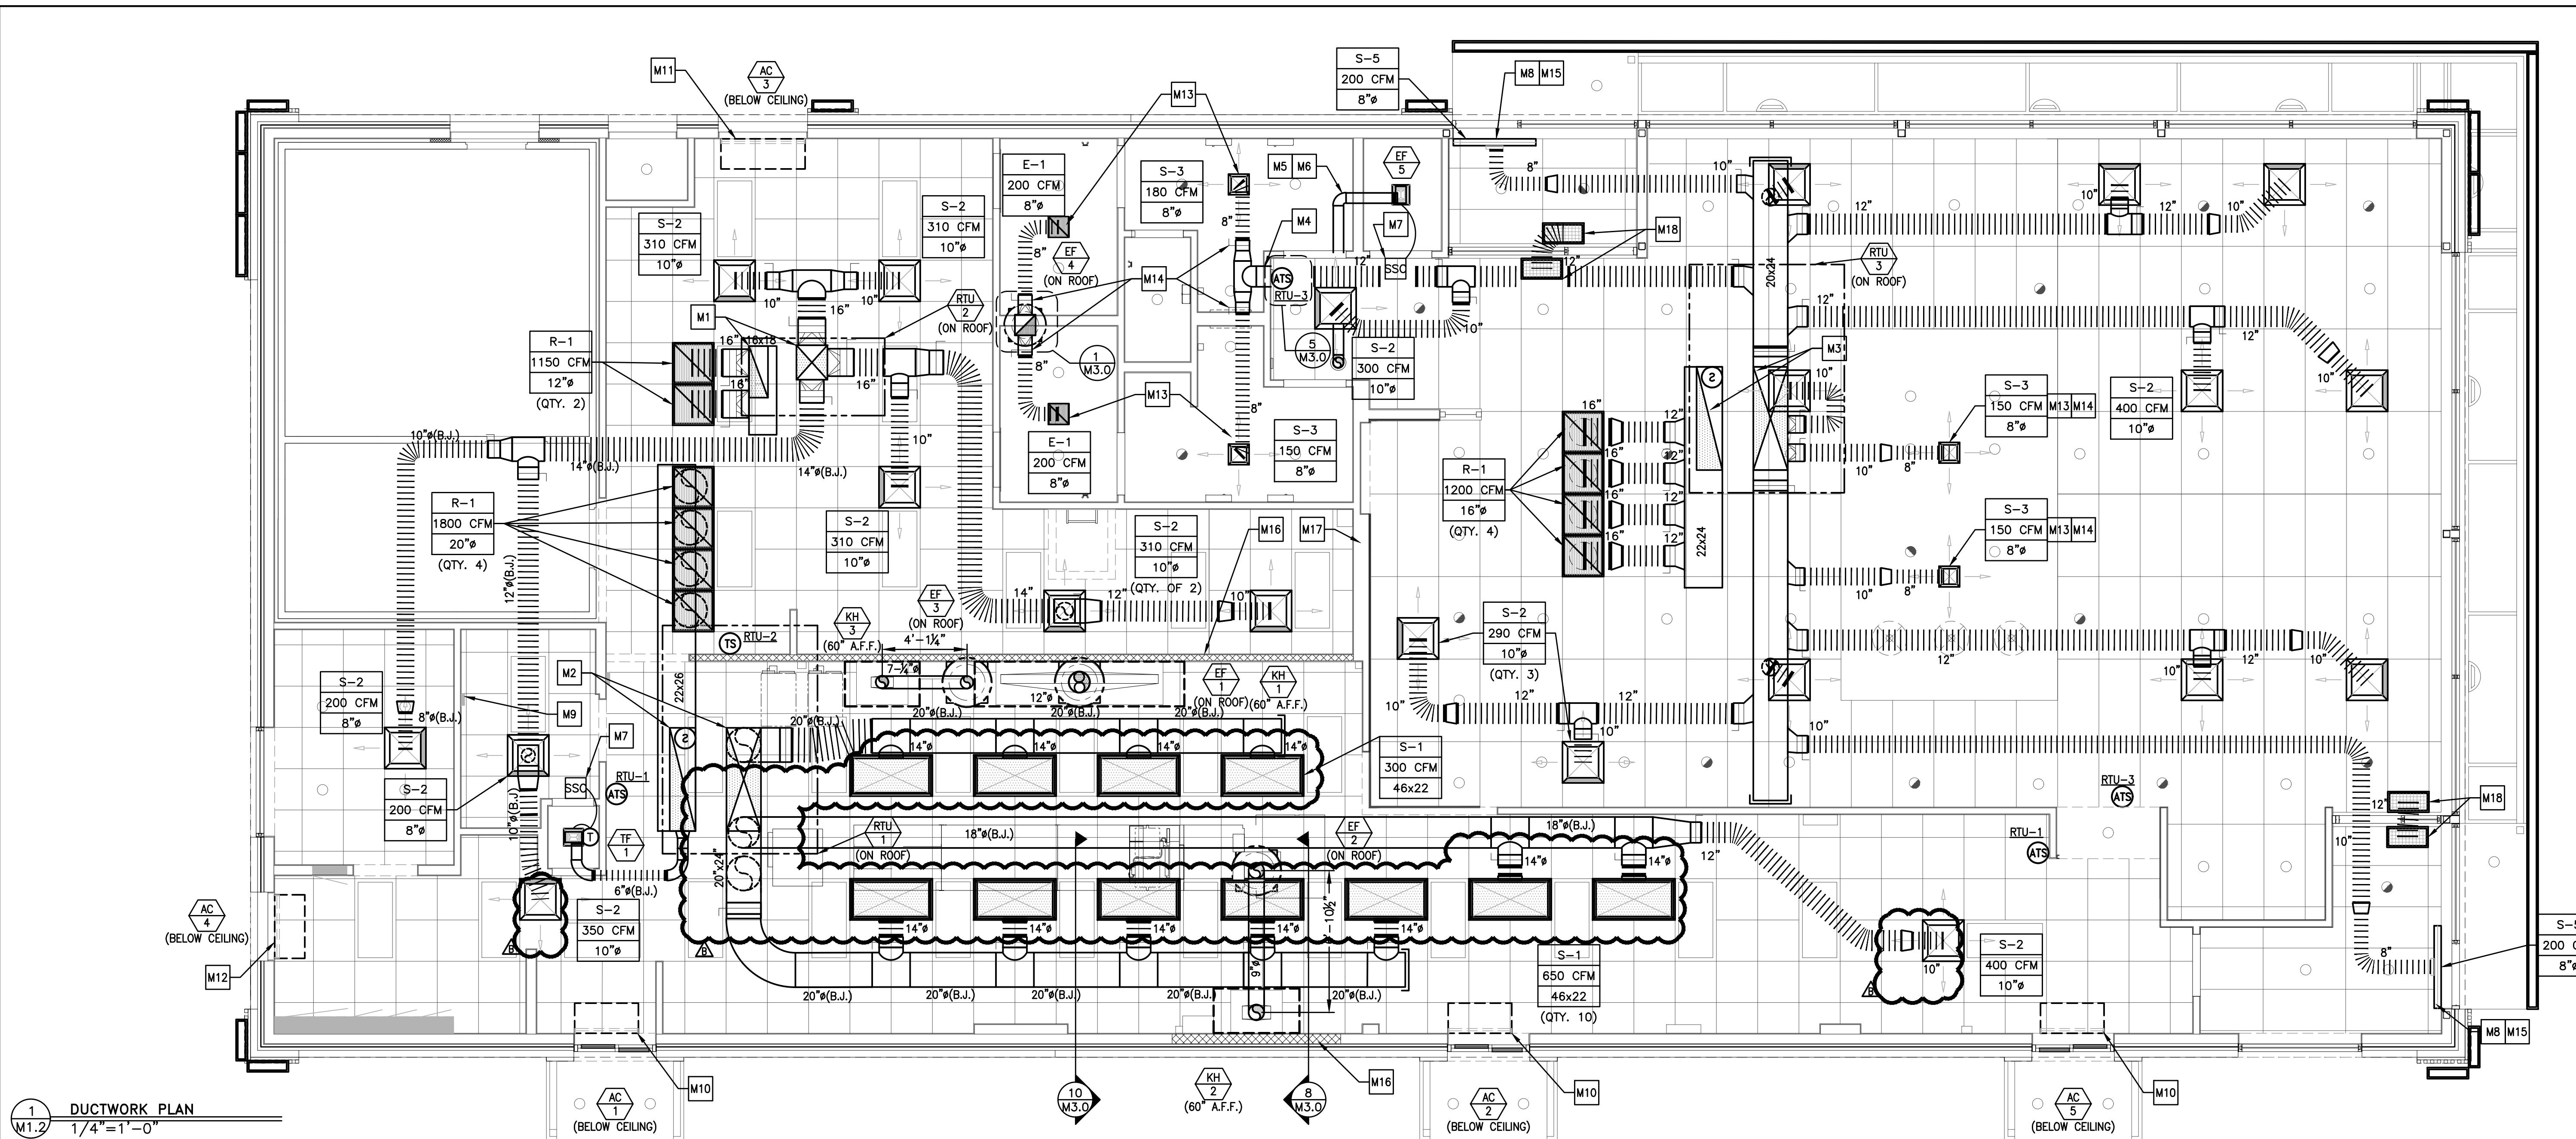

DRAWING NOTES

- ALL DUCTWORK SHALL BE RUN BETWEEN OR THROUGH THE JOISTS UNLESS NOTED OTHERWISE. DUCTWORK DESIGNATED WITH (B.J.) SHALL BE RUN BELOW THE JOISTS.
- DUCT SIZES SHOWN ARE INTERNAL FREE AREA DIMENSIONS UNLESS NOTED OTHERWISE.
- ALL SHEET METAL DUCTWORK SHALL BE EXTERNALLY INSULATED. INSULATION IS NOT SHOWN FOR CLARITY. SEE MECHANICAL NOTES FOR INSULATION REQUIREMENTS.
- CARBON STEEL KITCHEN EXHAUST DUCTWORK SHALL BE EXTERNALLY INSULATED. INSULATION NOT SHOWN FOR CLARITY. SEE MECHANICAL NOTES AND DETAILS FOR INSULATION REQUIREMENTS.
- RETURN AIRFLOW VOLUME SHOWN ON PLAN IS FOR DUCTWORK SIZING PURPOSES WHEN THE UNIT IS IN RECIRCULATION (UNOCCUPIED) MODE.
- DIFFUSERS IN DINING ROOM ARE SPECIFIC TO THE DECOR PLAN SHOWN. DIFFERENT CEILING LAYOUTS MAY REQUIRE A DIFFERENT DIFFUSER TYPES, QUANTITIES, LOCATIONS AND FINISHES/COLORS.

KEYED NOTES

- M1 18x20 SUPPLY AND 11x30 RETURN DUCT DROPS FROM ROOFTOP UNIT (RTU-2)
- M2 20x60 SUPPLY AND 15x60 RETURN DUCT DROPS FROM ROOFTOP UNIT (RTU-1)
- M3 20x60 SUPPLY AND 15x60 RETURN DUCT DROPS FROM ROOFTOP UNIT (RTU-3)
- M4 PROVIDE SHEET METAL DUCT AT ALL DRAFTSTOP WALL PENETRATIONS (TYP.) (WHERE REQUIRED BY CODE.)
- M5 6"Ø ALUMINUM DUCT FROM EXHAUST FAN UP THROUGH ROOF
- M6 EXTERNALLY INSULATE EXHAUST DUCT FROM FAN TO ROOF PENETRATION
- M7 STEADY STATE SPEED CONTROLLER FOR CEILING MOUNTED EXHAUST FAN. STEADY STATE SPEED CONTROLLER SHALL BE INSTALLED OVER SUSPENDED CEILING FOR ACCESS. DO NOT INSTALL OVER AREAS WITH DRYWALL CEILINGS.
- M8 SET DIFFUSER (S-5) FOR VERTICAL AIR THROW PATTERN (TYP.)
- M9 BUILDING AUTOMATION SYSTEM LOCATION. SEE LIGHTING CONTROL DETAILS ON SHEET E4.1.
- M10 MOUNT AIR CURTAIN TIGHT TO CEILING
- M11 MOUNT AIR CURTAIN WITH BOTTOM OF UNIT AT TOP OF DOOR FRAME
- M12 MOUNT AIR CURTAIN WITH BOTTOM OF UNIT ABOVE DOOR FRAME AND TOP OF SWITCHGEAR TO MEET 3'-0"
- M13 MINIMUM SWITCHGEAR'S CLEARANCE REQUIREMENT
- FOR DIFFUSERS INSTALLED IN DRYWALL CEILINGS, VOLUME DAMPER IS INTEGRAL TO DIFFUSER AND ADJUSTABLE AT FACE OF DIFFUSER (SEE NOTE 18 UNDER "VENTILATION SYSTEMS" ON DRAWING M4.0 AND AIR DEVICE SCHEDULE ON DRAWING M4.1)
- M14 FOR DIFFUSERS INSTALLED IN DRYWALL CEILINGS, INSTALL HIGH-EFFICIENCY TAKE-OFFS WITH VOLUME DAMPER IN FULL-OPEN POSITION TO FACILITATE BALANCING AT FACE OF DIFFUSER.
- M15 GENERAL CONTRACTOR SHALL PROVIDE ADDITIONAL T-BAR FRAME TO PROPERLY LOCATE DIFFUSER AS SHOWN. AIR STREAM FROM DIFFUSER SHALL COVER ENTIRE DOOR OPENING.
- M16 NONCOMBUSTIBLE WALL CONSTRUCTION BEHIND TYPE I KITCHEN HOODS. REFER TO SHEET A1.0 FOR MORE INFORMATION.
- M17 CONTRACTOR TO PROVIDE LOUVRED RETURN AIR BEHIND EACH MENU BOARD.

M18 PROVIDE TITUS 50F OR EQUAL, 24x12 OPEN CEILING GRATE PAINTED TO MATCH CEILING. PROVIDE PLASTER FRAMING FOR DRYWALL CEILING APPLICATIONS.

2015 IMC SECTION 403.3 - VENTILATION SCHEDULE


UNIT	AREA SERVED	AREA FT ²	CFM/PERSON	CFM/FT ³	PEOPLE OR PEOPLE/1000 FT ³	UNCORRECTED REQUIRED O/A CFM	Ez*	REQUIRED O/A CFM (Vot)**	ACTUAL O/A CFM	REQUIRED EXHAUST CFM	ACTUAL EXHAUST CFM
RTU-1	PRESENTER	352	5	0.06	4	42	0.8	0.90			
	KITCHEN	682	7.5	0.18	18		0.8				
RTU-2	SUPPORT	574	0	0.12	0	69	0.8	0.90	-	-	
	MANAGER'S OFFICE	59	5	0.06	1	9	0.8		-	-	
	CREW ROOM	99	5	0.06	5	31	0.8		-	-	
	ORDER	140	5	0.06	7	43	0.8		-	-	
RTU-3	DINING	1759	7.5	0.18	95	1030	0.8	0.91	151	168	400
	PRESENTER	0	5	0.06	0	0	0.8		-	-	
	VESTIBULE 1	90	0	0.06	0	5	0.8		-	-	
	VESTIBULE 2	53	0	0.06	0	3	0.8		-	-	
	WOMEN'S	136	0	0.06	0	8	0.8		-	-	
	MEN'S	122	0	0.06	0	7	0.8		-	-	
RTU-4	PLAYPLACE	0	7.5	0.18	0	1054		0.96	1080	1330	
	EATERY	1000	7.5	0.18	100	1080	0.8		0	0	
EF-1, 2 & 3	KITCHEN	682	-	0.7	-	-	-	-	-	477	2405
EF-4	WOMEN'S	136	-	-	-	-	-	-	100	200	
EF-6	MEN'S	122	-	-	-	-	-	-	100	200	
	PLAYPLACE (UNISEX)	0	-	-	-	-	-	-	0	0	

* Zone Air Distribution Effectiveness Based on ASHRAE 62.1 Table 6.2 for Ceiling Supply of Warm Air 15° F or More Above Space Temperature and Ceiling Return (IMC Table 403.3.1.2)

** Ventilation System Efficiency Based on ASHRAE 62.1 Table 6.3 and Section 6.2.5 (IMC Section 403.3.2 MZ)

*** Corrected Required O/A Intake Required for System Calculated Based on ASHRAE 62.1 Section 6.2 (IMC Section 403.3)

TITLE	2019 STANDARD BUILDING - BB20	STD ISSUE DATE	2019-11	REVIEWED BY	WLW
DESCRIPTION	4597F10-WOOD/WOOD	DATE ISSUED	01-23-20	PERMIT SET	
WOOD BEARING WALLS W/FIBER CEMENT SIDING & CI		REV. DATE	01/13/20	PROGRESS SET REVIEW	
WOOD ROOF TRUSS FRAMING					
FIBER CEMENT PANEL/BATTEN/ALPOLIC PANEL/BRICK EXT. FINISH					
SITE ID	015-0071.00.B	SITE ADDRESS	605 SOUTH 7TH STREET, KANSAS CITY, KS		
SHEET NO.	M1.2	TITLE	DUCTWORK PLAN	BY	

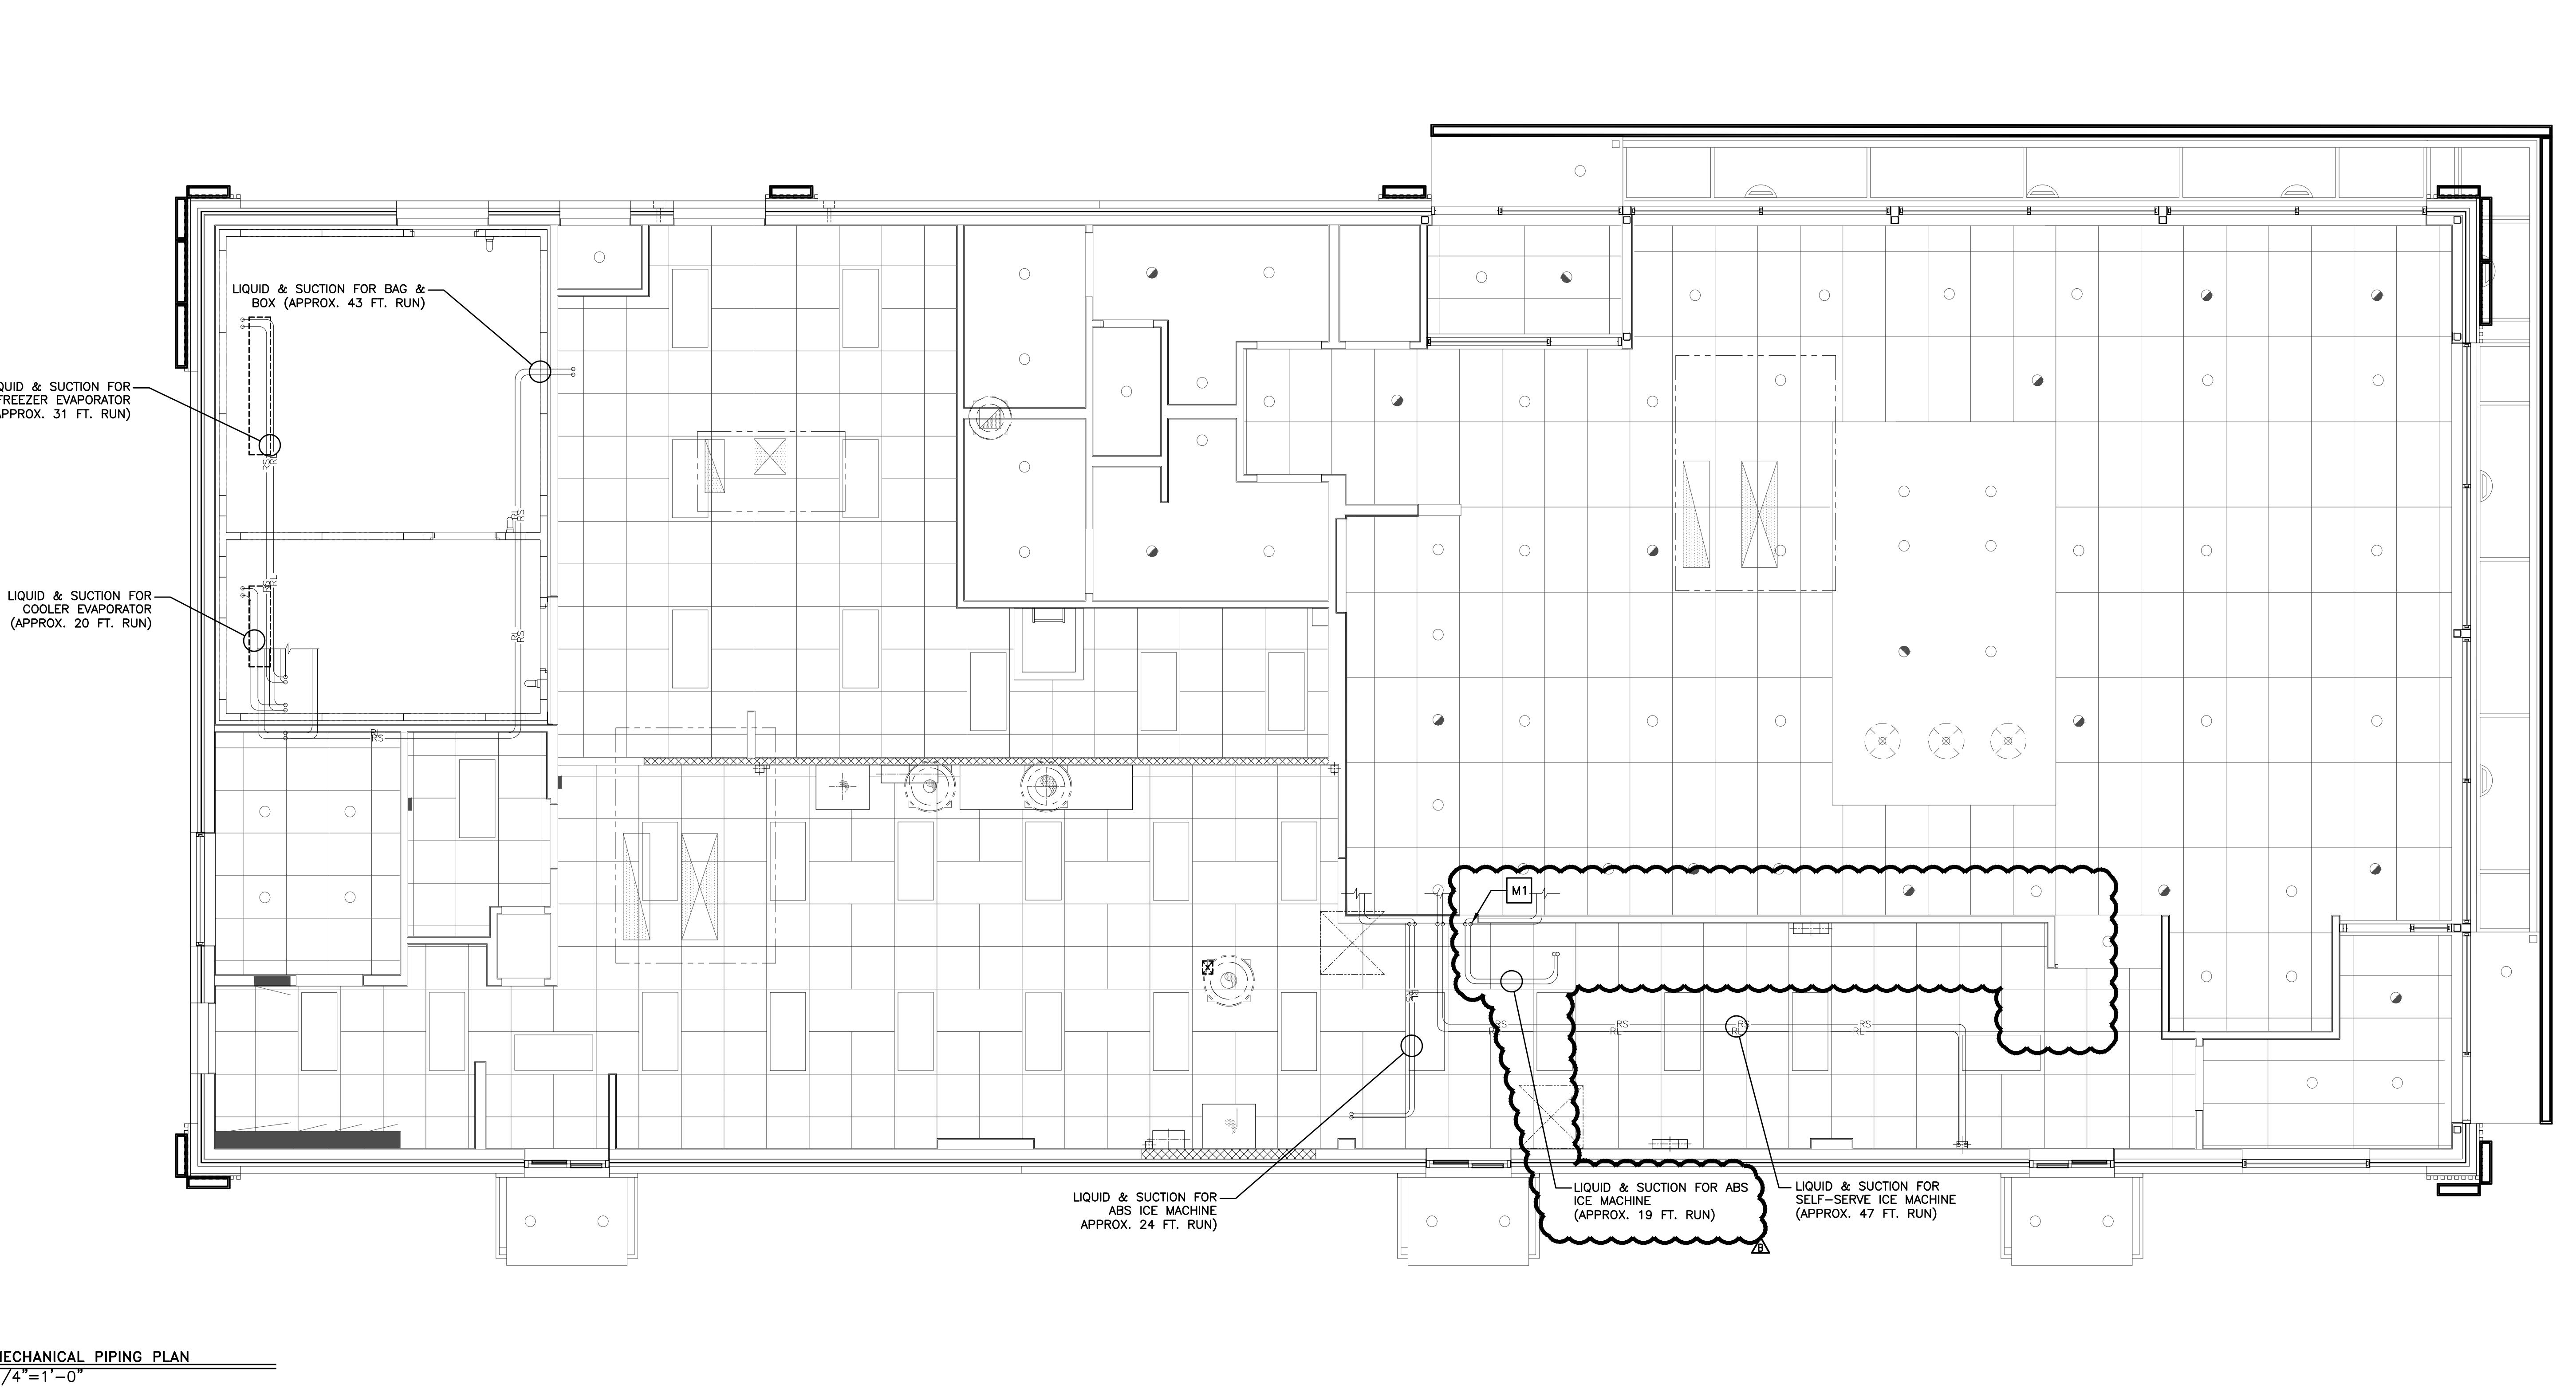

MECHANICAL PIPING PLAN
1/4"=1'-0"

DRAWING NOTES

1. GAS PIPING LENGTHS ARE APPROXIMATE AND ARE SHOWN FOR SIZING PURPOSES ONLY.
2. REFRIGERANT PIPE SIZES SHALL BE PER MANUFACTURER'S INSTALLATION INSTRUCTIONS.


KEYED NOTES

- M1 REFRIGERANT LIQUID AND SUCTION LINES UP THROUGH ROOF TO CONDENSING UNITS (TYP. 6 PLACES - SEE DETAIL 3 ON DRAWING M3.0)

SHEET NO.	TITLE	PREPARED BY:	REVIEWED BY:	DATE ISSUED:	PERMIT SET:	PROGRESS SET REVIEW:	REV:	DESCRIPTION	BY:
015-0071.00.B	M1.4 MECH. PIPING PLAN	McDonald's USA, LLC © 2020 McDonald's USA, LLC	emmanuelson-podas consulting engineers	12/03/20	SERVICE AREA OPTIMIZATION	01/13/20	01/13/20	W/L/W	

W/L/W
11/13/20 USD, SAO, SET REVIEW
W/L/W
05/05/20 CIVIL & PLAN REVIEW COMMENTS
W/L/W
01/23/20 PERMIT SET
W/L/W
01/13/20 PROGRESS SET REVIEW
W/L/W
REV DATE

3801.0037

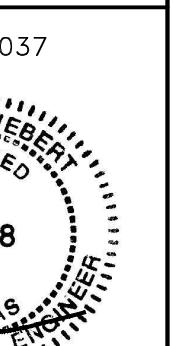

12/03/20

17648


KANSAS

LICENCHED


PROFESSIONAL ENGINEER

MICHAEL WEBER


12/03/20

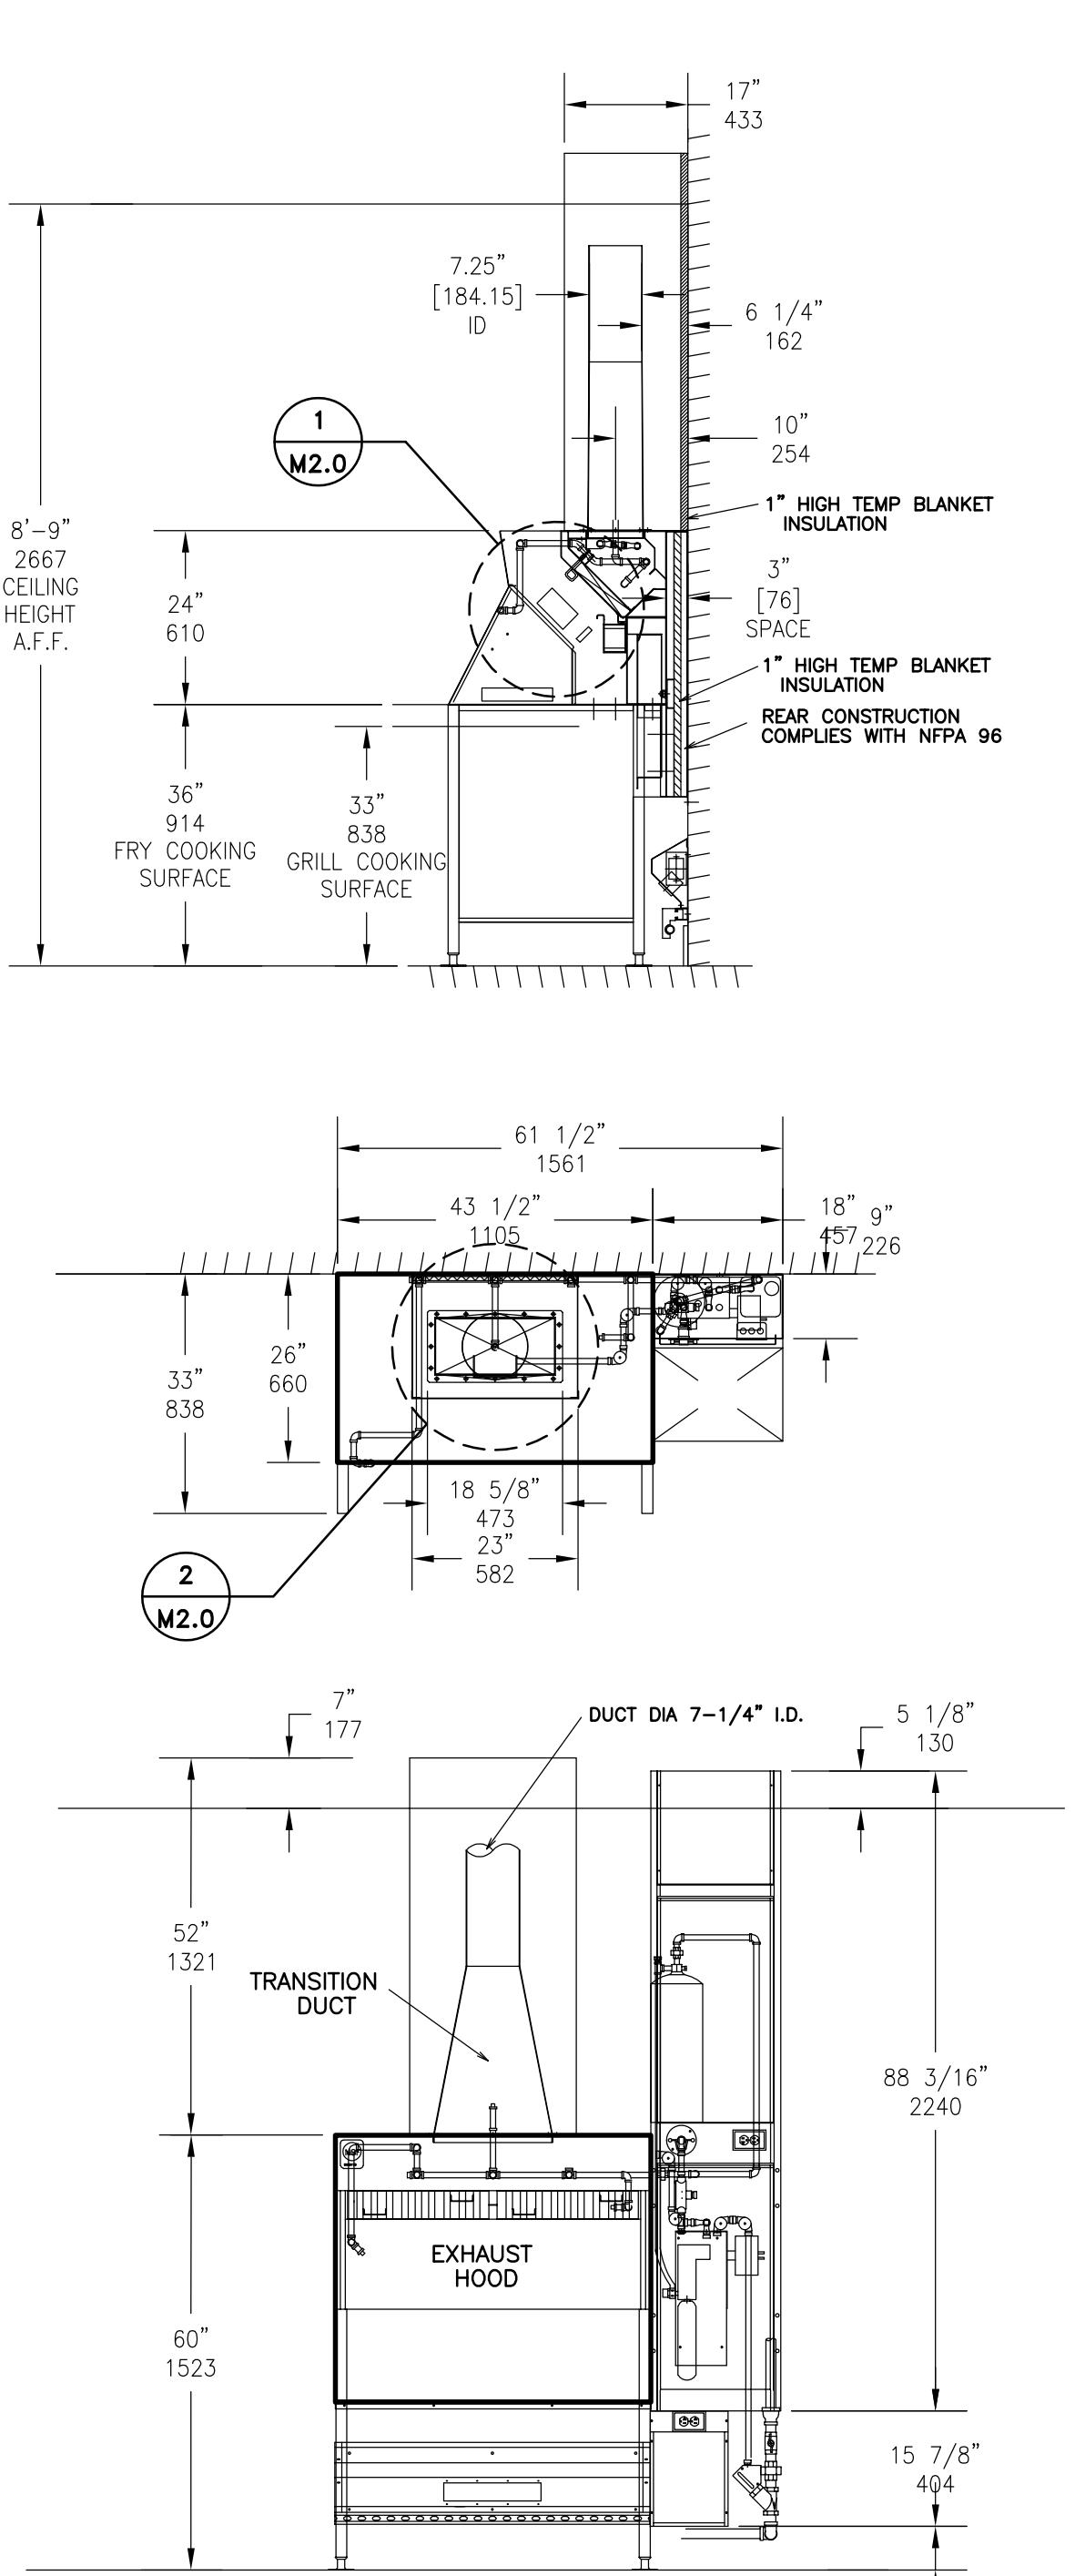


KITCHEN EXHAUST HOOD
TAG: KH-3 (SEE KITCHEN EXHAUST HOOD SCHEDULE)
SCALE: $\frac{1}{2}''=1'-0''$

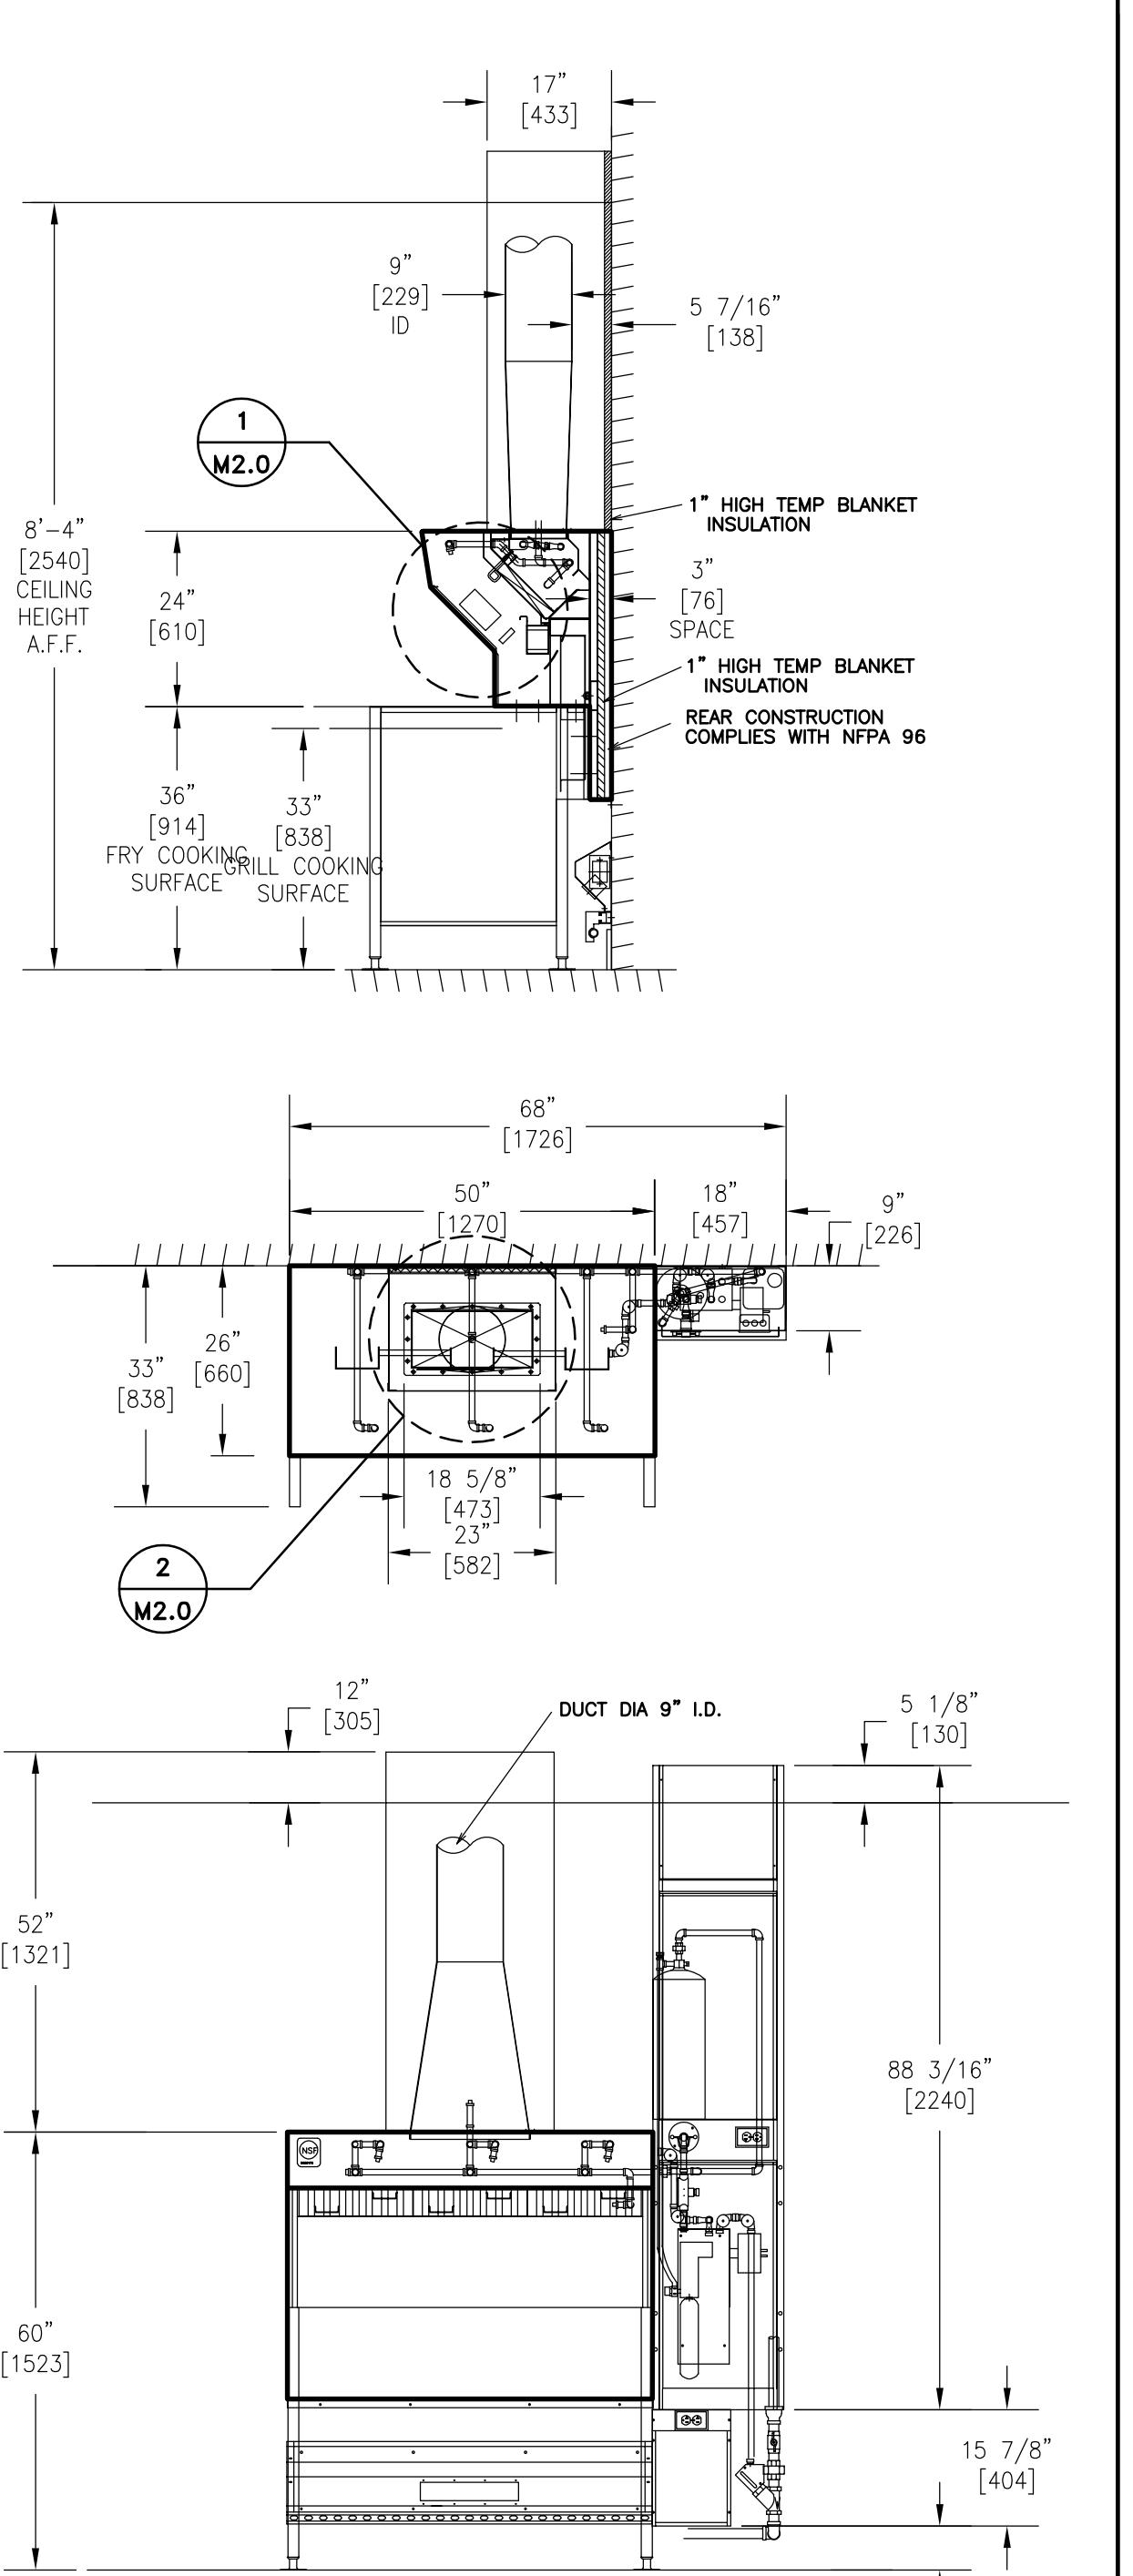


KITCHEN EXHAUST HOOD
TAG: KH-2, KH-3 (SEE KITCHEN EXHAUST HOOD SCHEDULE)
SCALE: $\frac{1}{2}''=1'-0''$

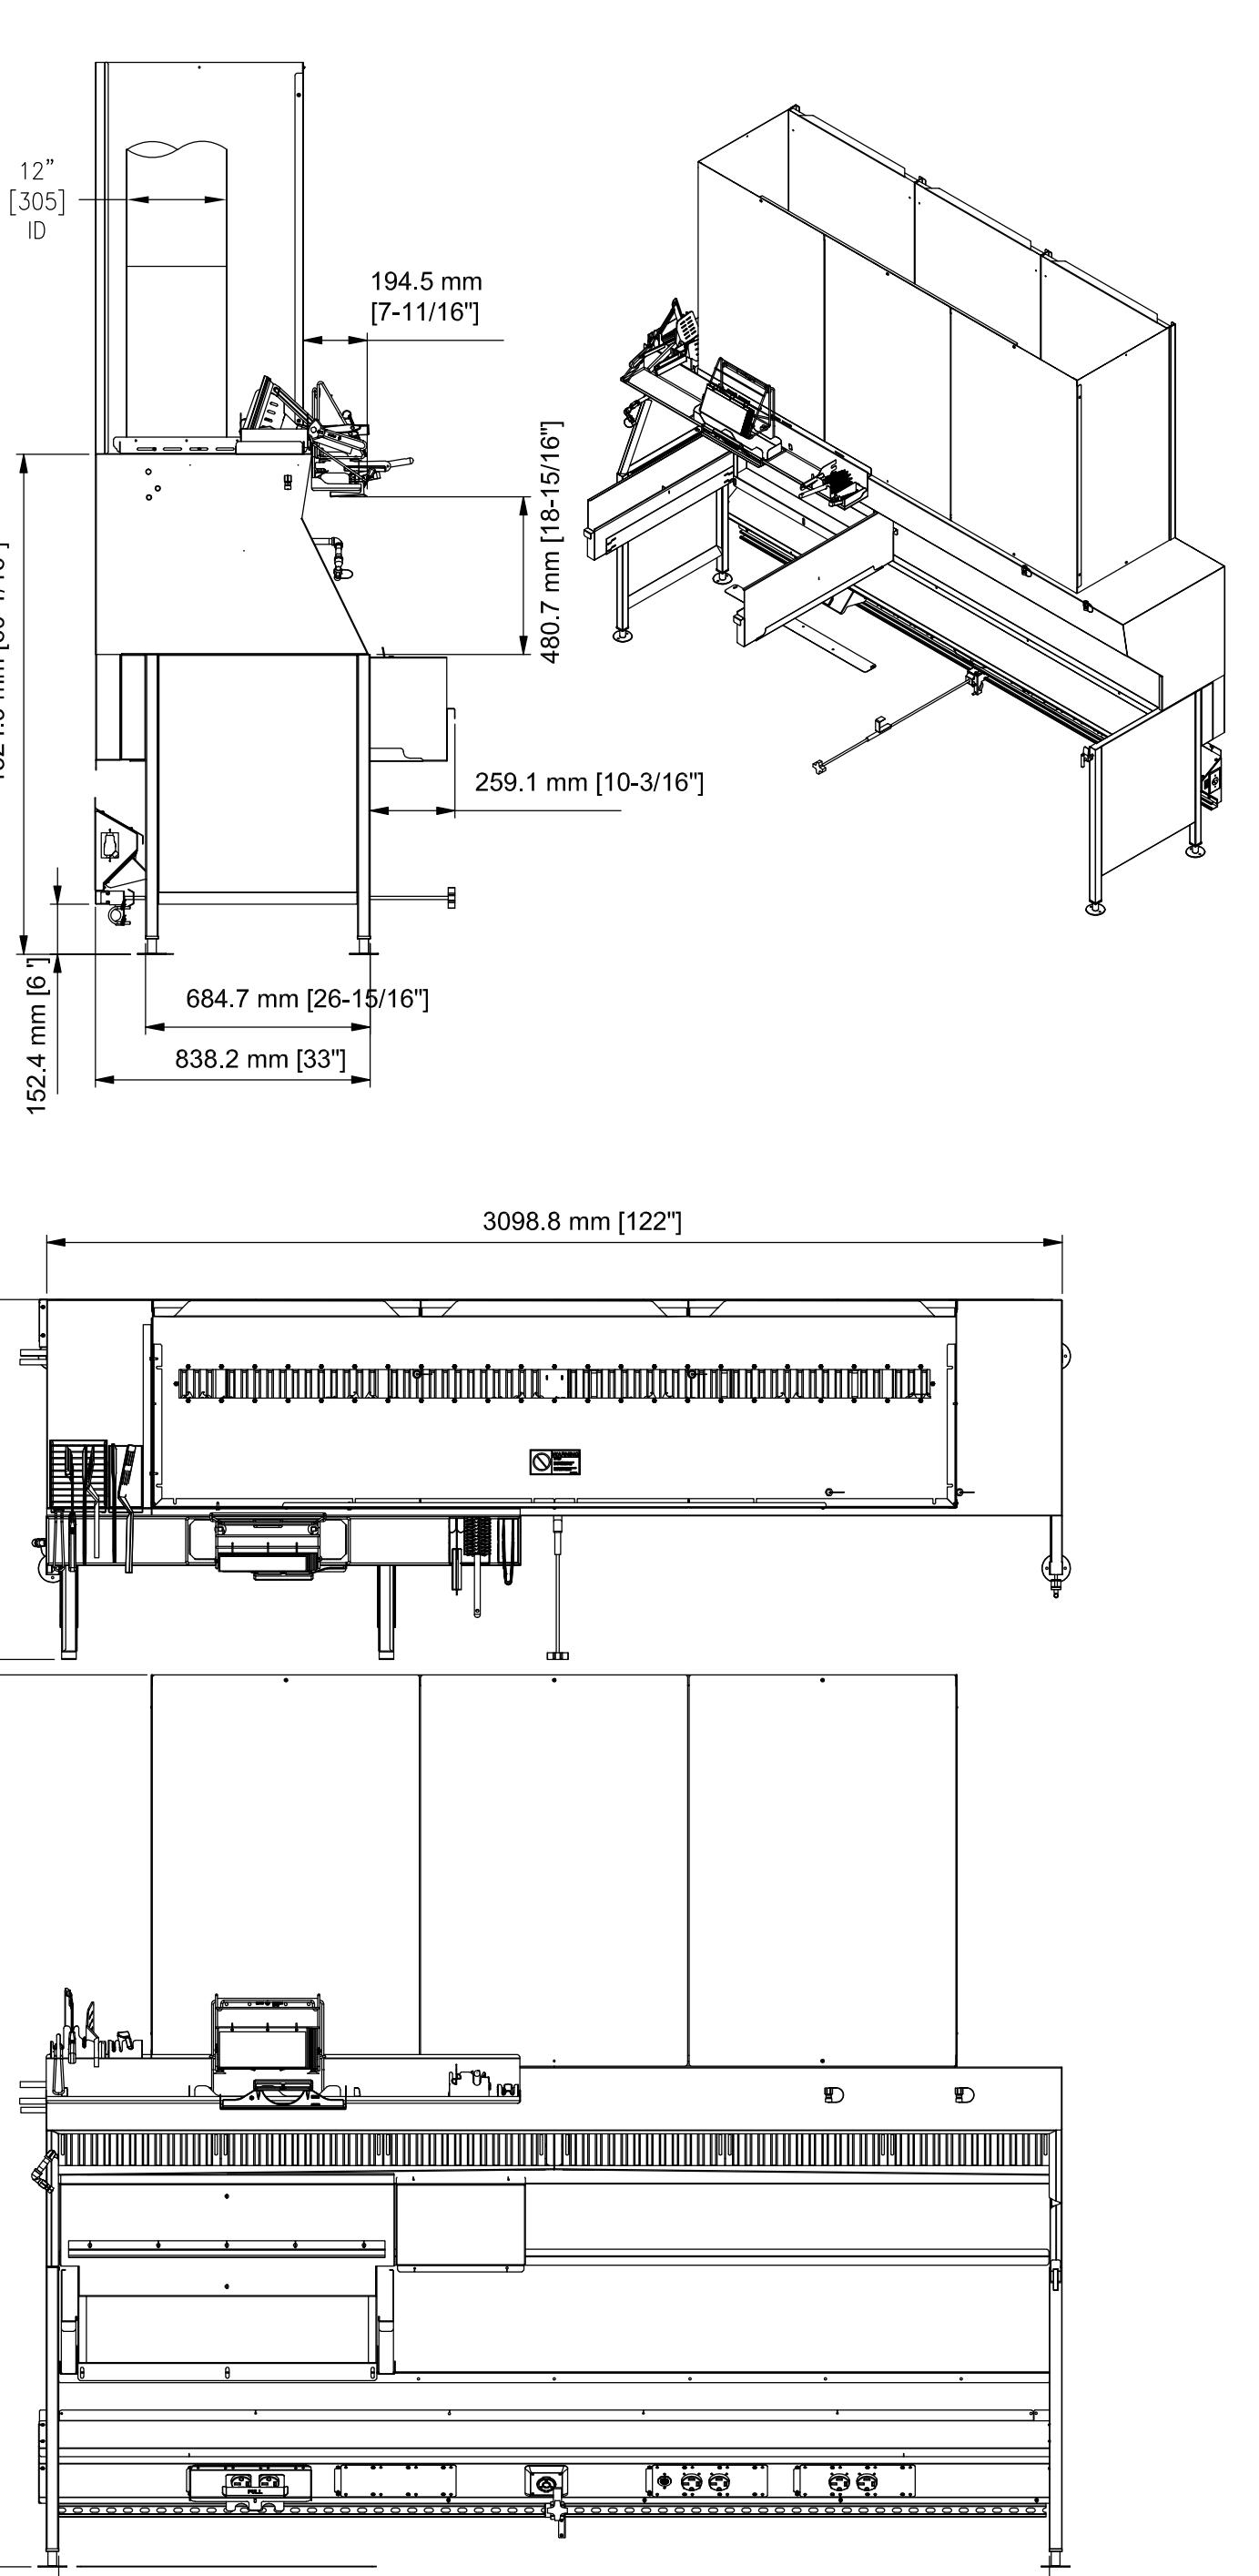

KITCHEN EXHAUST HOOD
TAG: KH-1 (SEE KITCHEN EXHAUST HOOD SCHEDULE)
SCALE: $\frac{1}{2}''=1'-0''$

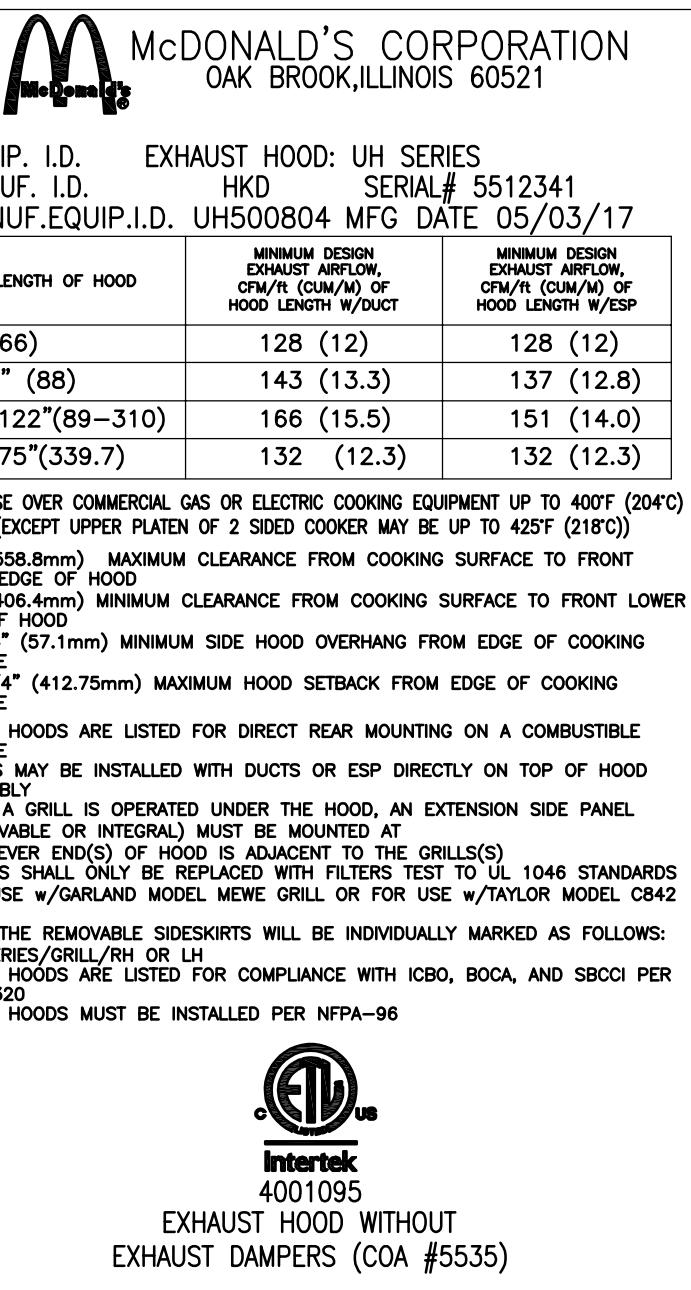

DETAIL
UL LABEL
SCALE: NONE

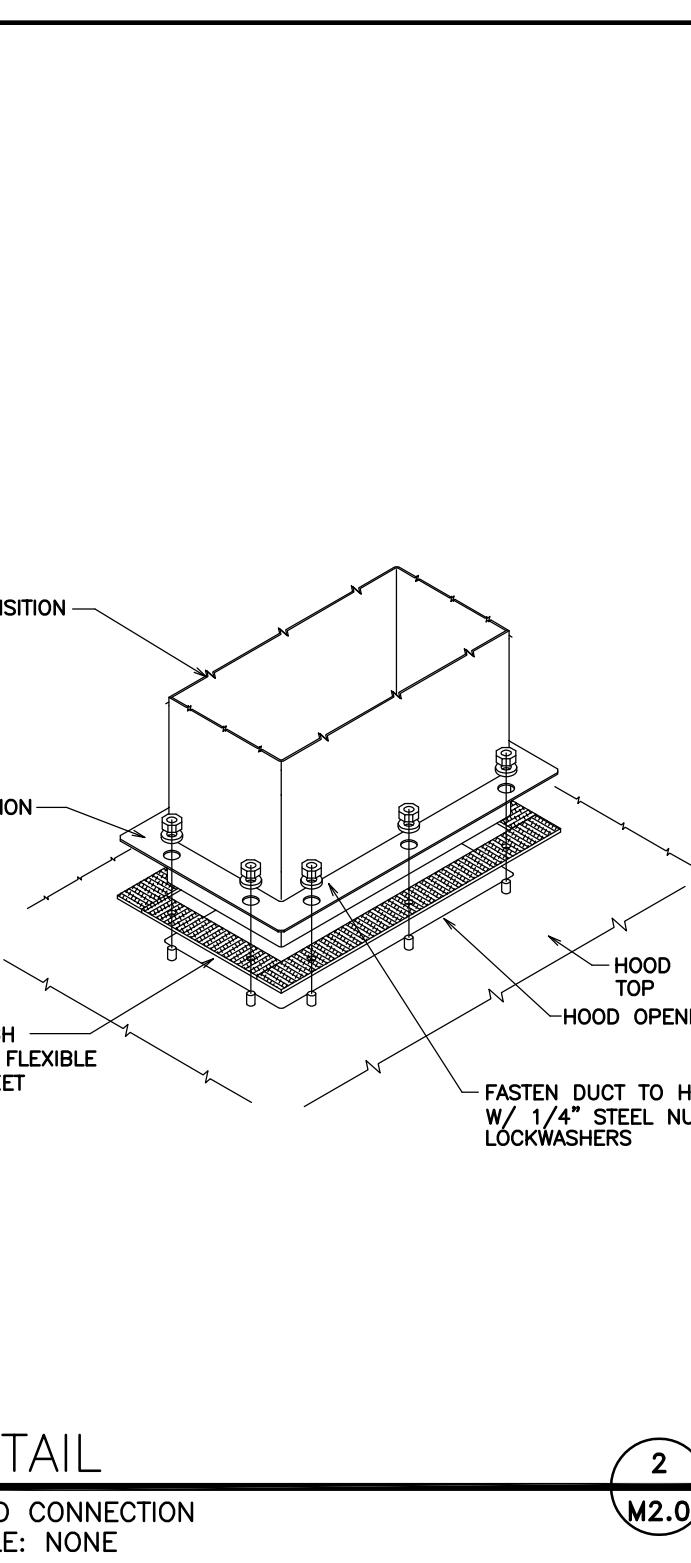

DETAIL
HOOD CONNECTION
SCALE: NONE

OWNER SELECTED EQUIPMENT WITH
MANUFACTURER CUT SHEET
FOR INFORMATION PURPOSES ONLY

TITLE	2019 STANDARD BUILDING - BB20	STD ISSUE DATE	2019-11	REVIEWED BY	WLW
DESCRIPTION	WOOD BEARING WALLS W/FIBER CEMENT SIDING & CI				
	WOOD ROOF TRUSS FRAMING				
	FIBER CEMENT PANEL/BATTEN/ALUMINUM/BRICK EXTER. FINISH				
SITE ID	015-0071	SITE ADDRESS	605 SOUTH 7TH STREET, KANSAS CITY, KS	REV. DATE	01/13/20

PREPARED BY:
McDonald's USA, LLC

© 2020 McDonald's USA, LLC
These drawings and specifications are the confidential and proprietary property of McDonald's USA, LLC and shall not be copied or reproduced in whole or in part without the express written consent of McDonald's USA, LLC and its affiliate companies. These drawings and specifications are not suitable for use on this specific site or at a later time. Use of these drawings for reference or example on another project requires the services of properly licensed architects and engineers. Reproduction of the contract documents for reuse on another project is not authorized.

PREPARED FOR:
McDonald's USA, LLC

3801.0037

17648
MICHAEL WEBER
LICENSED
PROFESSIONAL ENGINEER
01/23/20




DRAWING NOTES

1. 16 GA. STAINLESS STEEL MATERIAL USED FOR HOOD CONSTRUCTION
2. FILTER BAFFLE:
UL FILE R14372, VOL. 1, SEC. 1
UL CONTROL NUMBER 5L65
MEA-446-92-M
3. EXHAUST HOOD:
UL FILE MH12755, VOL. 4
UL CONTROL NUMBER 78L1
4. UTILITY CHASE AND RACEWAY:
UL FILE E163328, VOL.1, SEC.3
5. HIGH TEMP GASKET:
UL FILE MH12755, VOL. 2, SEC. 1, ILL. 9
6. HOOD CONSTRUCTION COMPLIES WITH NSF STANDARD 2
7. HOOD PERFORMANCE TESTED IN ACCORDANCE WITH UL 710
8. UL 300 AND NFPA 17A COMPLIANT R-102 WET CHEMICAL SYSTEM INCLUDED WITH HOOD INSTALLATION
9. ANSUL CONNECTIONS AND STARTUP BY APPROVED ANSUL REPRESENTATIVE
10. REFER TO E3.2 FOR HOOD/FAN INTERLOCK DETAILS

PREPARED BY:
McDonald's USA, LLC

015-0071.00.0
M2.0
EXHAUST HOODS

Sheet No. 015-0071.00.0

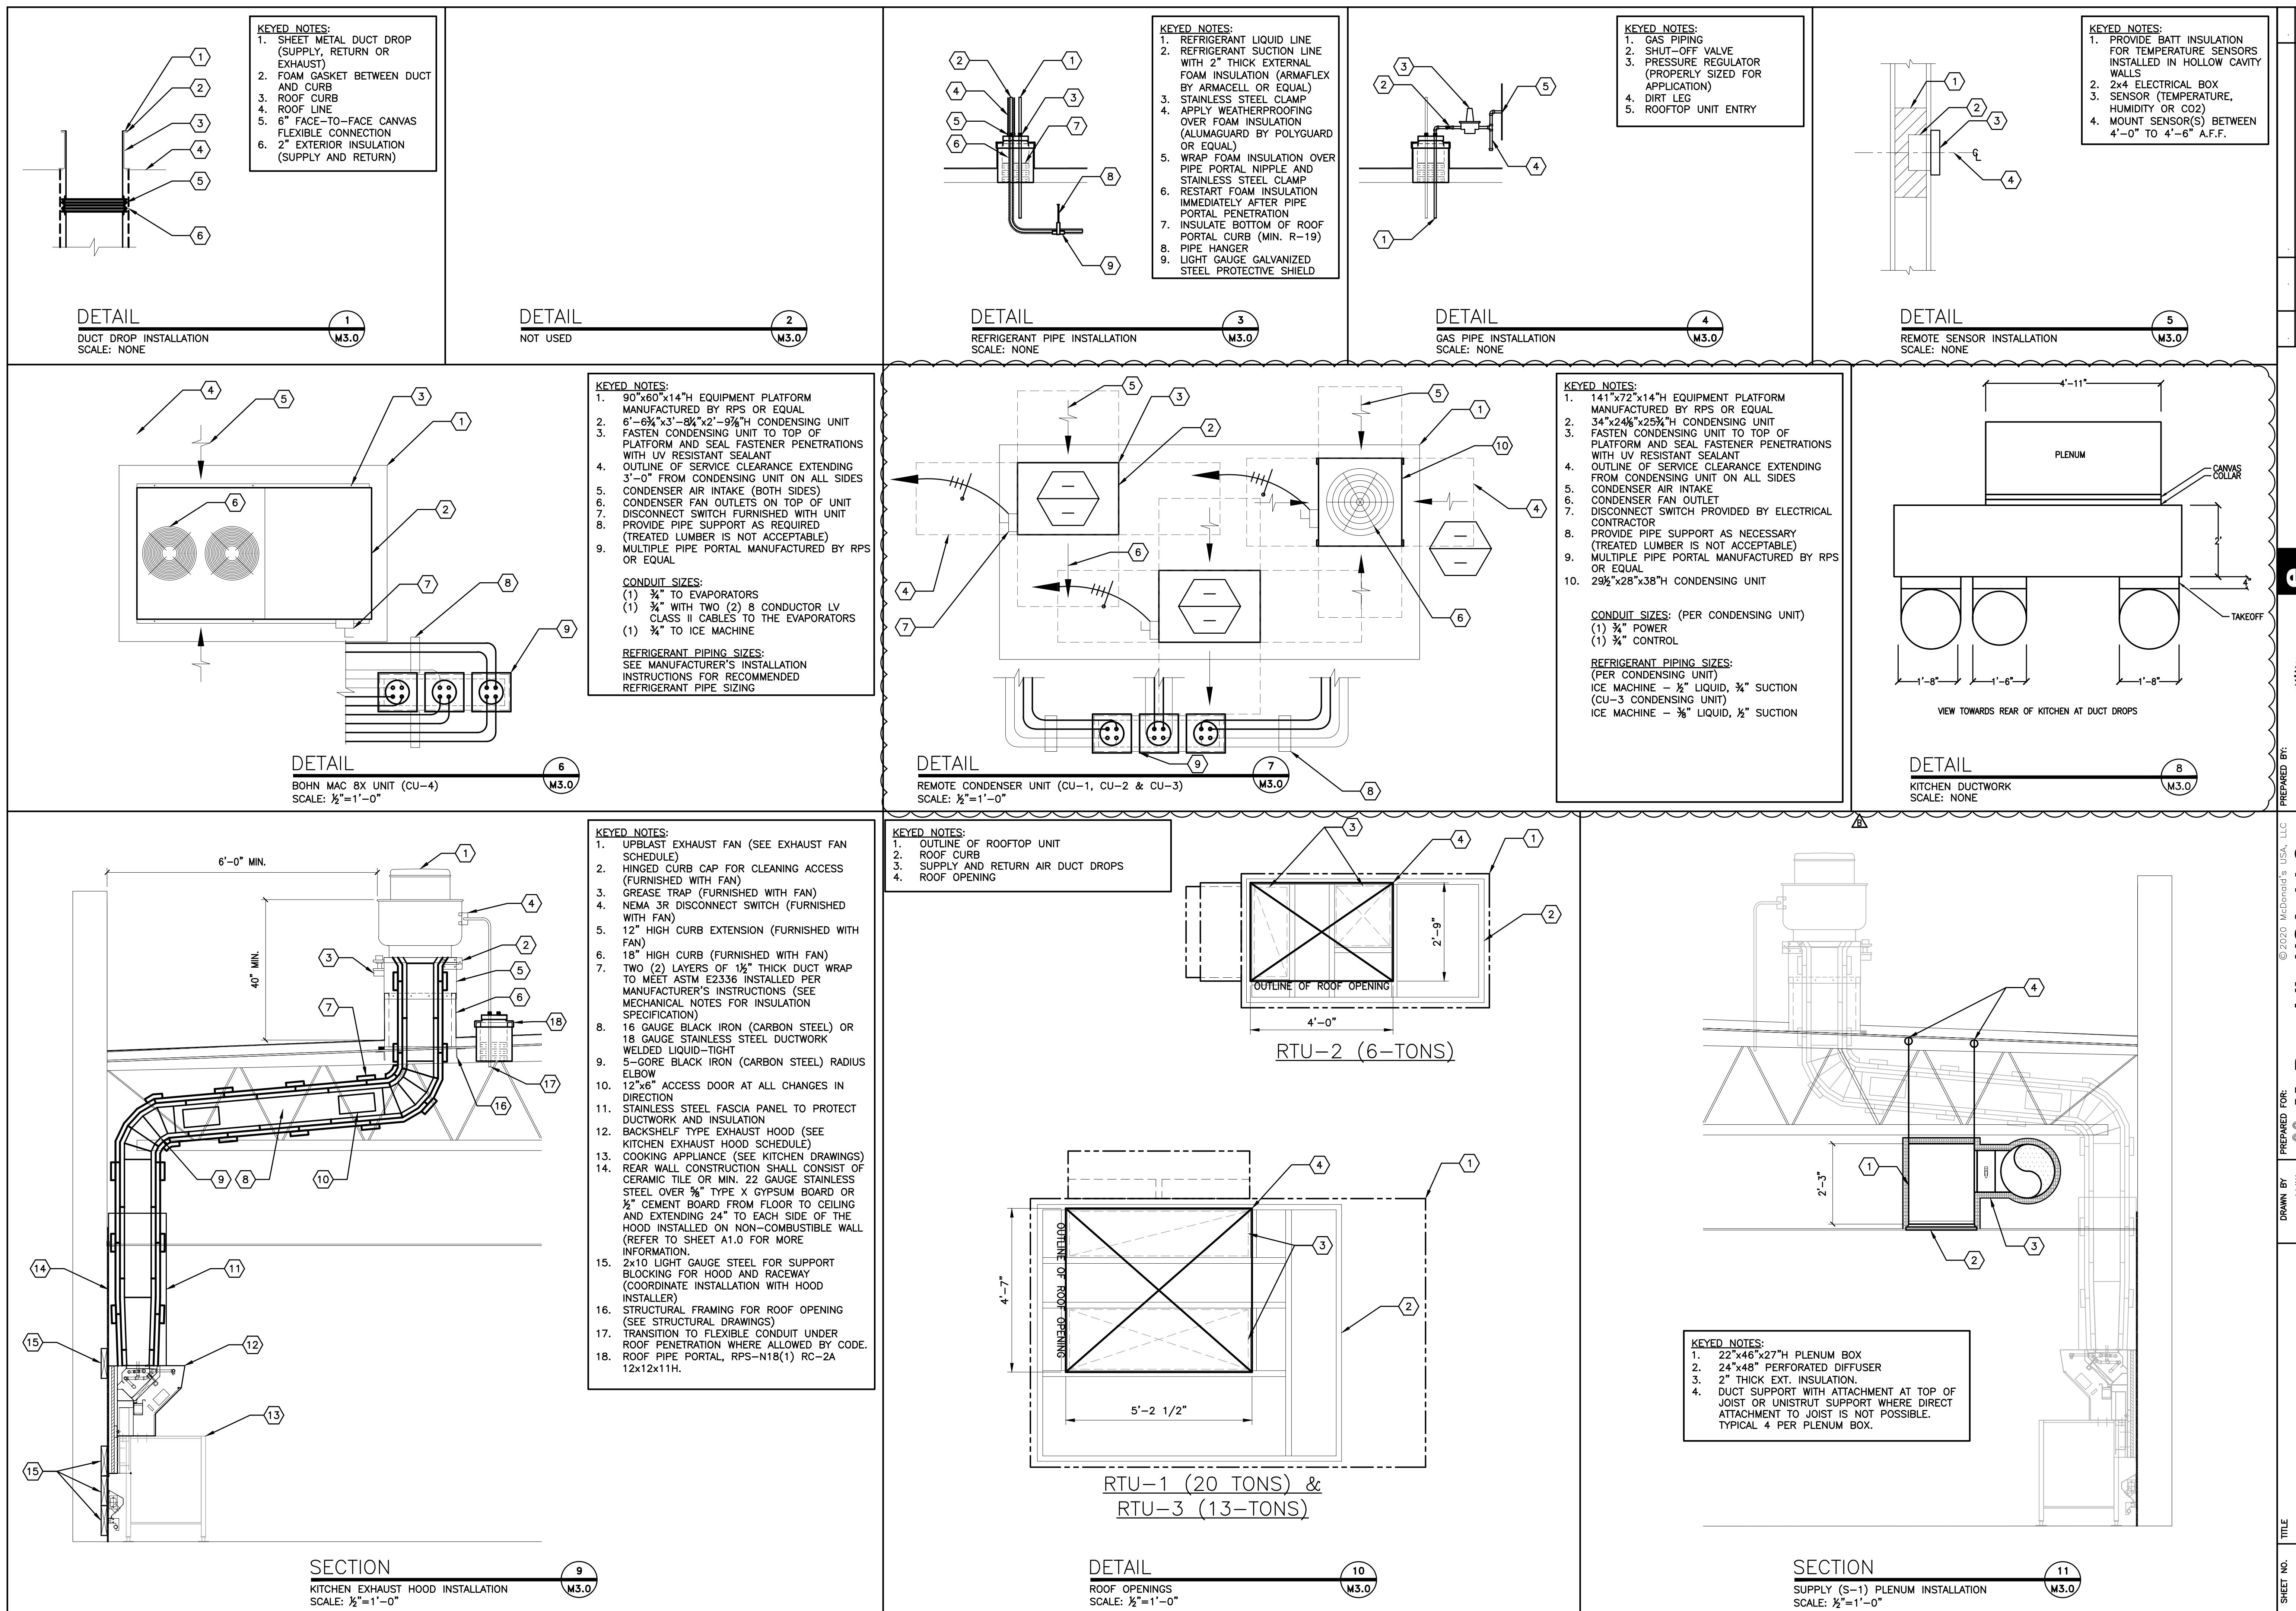


COORDINATION SCHEDULE						
GENERAL REQUIREMENTS	FURNISH	INSTALL	FINAL CONNECTION	NOTES		
MECHANICAL PERMIT	MC			1-3		
HOT WORK (WELDING) PERMIT (IF APPLICABLE)	KES			1-3		
REFRIGERATION PERMIT (IF APPLICABLE)	MC			1-3		
PLUMBING PERMIT	PC			1-3		
ELECTRICAL PERMIT	EC			1-3		
FIRE SPRINKLER PERMIT (IF APPLICABLE)	FPC			1-3		
FIRE ALARM PERMIT (IF APPLICABLE)	FAC			1-3		
CONTRACTOR COORDINATION REQUIREMENTS						
HEATING & AIR-CONDITIONING						
ROOFTOP UNITS, INTAKE AND RELIEF	MC	MC		1-5, 17, 22		
ROOF CURBS	MC	MC		1-3, 20, 22		
GAS PIPING AND GAS PIPE KIT	PC	PC	PC	1-3, 14, 22-23		
CONTROLS WIRING	MC	EC	EC	1-3, 19, 22, 24		
POWER WIRING	EC	EC	EC	1-3, 19, 22, 24		
CONDENSATE TRAP	MC	PC		1-3, 22-23		
CONDENSATE PIPING (IF APPLICABLE)	PC	PC		1-3, 22-23		
DUCT-MOUNTED SMOKE DETECTOR	MC	MC	EC	1-3, 22, 24		
GENERAL EXHAUST SYSTEMS						
EXHAUST FANS	MC	MC		1-3, 17, 22		
ROOF CURBS	MC	MC		1-3, 22		
CONTROLS (WHERE APPLICABLE)	MC	EC	EC	1-3, 22, 24		
POWER WIRING	EC	EC	EC	1-3, 22, 24		
TEMPERATURE CONTROLS						
THERMISTORS & SUBBASES	MC	MC	EC	1-3, 22, 24		
REMOTE SENSORS (RH AND/OR TEMPERATURE)	MC	MC	EC	1-3, 22, 24		
CONTROLS WIRING (WHERE APPLICABLE)	MC	EC	EC	1-3, 22, 24		
POWER WIRING	EC	EC	EC	1-3, 22, 24		
DUCTWORK AND ACCESSORIES						
GALVANIZED SHEET METAL DUCTWORK	MC	MC		1-3, 22		
EXTERNAL INSULATION	MC	MC		1-3, 22		
INTERNAL INSULATION (IF APPLICABLE)	MC	MC		1-3, 22		
WEATHERPROOFING (IF APPLICABLE)	MC	MC		1-3, 22		
SPIN-IN COLLARS	MC	MC		1-3, 22		
Flexible Ductwork	MC	MC		1-3, 22		
VOLUME/BALANCING DAMPERS	MC	MC		1-3, 22		
FIRE DAMPERS (IF APPLICABLE)	MC	MC		1-3, 22		
FIRESTOPPING (IF APPLICABLE)	MC	MC		1-3, 22		
AIR DEVICES AND ACCESSORIES	MC	MC	MC	1-3, 7, 22, 28		
PLUMBING SYSTEMS						
WATER HEATERS	PC	PC	PC	1-3, 11-12, 23		
HOT AND COLD WATER PIPE	PC	PC	PC	1-3, 23		
VENTS AND INTAKES	PC	PC	PC	1-3, 23		
THERMOSTATIC MIXING VALVE	PC	PC	PC	1-3, 23		
POWER AND CONTROL WIRING	EC	EC	EC	1-3, 23-24		
KITCHEN EXHAUST SYSTEMS						
MCDONALD'S BACKSHELF EXHAUST HOODS	KES	KEI		1-3, 6, 22, 27		
CANOPY EXHAUST HOODS (IF APPLICABLE)	KES	KEI		1-3, 6, 22		
BLACK IRON DUCTWORK	KES	KEI		1-3, 6, 22		
STAINLESS STEEL DUCTWORK (IF APPLICABLE)	KES	KEI		1-3, 6, 22		
ALUMINUM DUCTWORK (IF APPLICABLE)	KES	KEI		1-3, 6, 22		
UL LISTED DUCT WRAP	MC	MC		1-3, 6, 22		
FIRE-RATED DUCT ENCLOSURE (IF APPLICABLE)	GC	GC		1-3, 6, 20, 22		
EXHAUST FANS	MC	MC		1-3, 6, 17, 22		
ROOF CURBS	MC	MC		1-3, 6, 20, 22		
CURB EXTENSIONS	MC	MC		1-3, 6, 22		
CONTROLS (WHERE APPLICABLE)	EC	EC	EC	1-3, 6, 22, 24		
POWER WIRING	EC	EC	EC	1-3, 6, 22, 24		
FIRE SUPPRESSION SYSTEM	KES	KES	KES	1-3, 16, 22, 27		
KITCHEN EQUIPMENT						
COOLER/FREEZER	KES	GC		1-3, 27		
EVAPORATOR COILS	KES	MC		1-3, 27		
CONDENSATE PIPING	PC	PC	PC	1-3, 23, 27		
REMOTE CONDENSING UNIT (MAC)	KES	MC		1-3, 22, 27		
ROOF CURBS	MC	MC		1-3, 22		
REFRIGERANT PIPING	KES	MC	MC	1-3, 22, 27		
POWER WIRING	EC	EC	EC	1-3, 22, 24, 27		
CONTROL WIRING	EC	EC	EC	1-3, 24, 27		
PIPE PORTALS	MC	MC		1-3, 22		
ICE MACHINES	KES	KEI		1-3, 27		
WATER SUPPLY PIPING	KES	KEI	BSI	1-3, 27		
REMOTE CONDENSING UNITS	KES	MC		1-3, 22, 27		
ROOF CURBS	MC	MC		1-3, 22, 27		
REFRIGERANT PIPING	KES	MC	MC	1-3, 22, 27		
POWER WIRING	EC	EC	EC	1-3, 22, 24, 27		
CONTROL WIRING	KES	EC	EC	1-3, 24, 27		
PIPE PORTALS	MC	MC		1-3, 22		
GRILLS	KES	KES		1-3, 27		
GAS PIPING (IF APPLICABLE)	PC	PC	PC	1-3, 23, 27		
POWER WIRING	EC	EC	EC	1-3, 24, 27		
CONTROL CABLE (6' CLAMSHELL ONLY)	MC	EC	EC	1-3, 23, 24, 27		
FRYERS	KES	KES		1-3, 27		
GAS PIPING (IF APPLICABLE)	PC	PC	PC	1-3, 23, 27		
POWER WIRING	EC	EC	EC	1-3, 24, 27		
3-COMPARTMENT SINK	KES	KES		1-3, 12, 27		
FAUCETS AND PRE-RINSE SPRAYER	KES	KES		1-3, 27		
WATER SUPPLY PIPING	PC	PC	PC	1-3, 23, 27		
SANITARY DRAIN PIPING	PC	PC	PC	1-3, 23, 27		
HAND SINKS	PC	PC		1-3, 23, 27		
FAUCET	PC	PC		1-3, 23, 27		
WATER SUPPLY PIPING	PC	PC	PC	1-3, 23, 27		
SANITARY DRAIN PIPING	PC	PC	PC	1-3, 23, 27		
VEGETABLE SINK	KES	KES		1-3, 23, 27		
FAUCET	KES	KES		1-3, 23, 27		
WATER SUPPLY PIPING	PC	PC	PC	1-3, 23, 27		
SANITARY DRAIN PIPING	PC	PC	PC	1-3, 23, 27		
WASHING MACHINE	KES	KES		1-3, 23, 27		
WATER SUPPLY PIPING	PC	PC	PC	1-3, 23, 27		
SANITARY DRAIN PIPING	PC	PC	PC	1-3, 23, 27		
WARE WASHER	KES	KES		1-3, 23, 27		
WATER SUPPLY PIPING	PC	PC	PC	1-3, 23, 27		
SANITARY DRAIN PIPING	PC	PC	PC	1-3, 23, 27		
MISCELLANEOUS ITEMS						
FIRE SPRINKLER SYSTEMS	FPC	FPC	FPC	1-3, 15, 25		
HVAC EQUIPMENT START-UP TEST, ADJUST AND BALANCE HVAC SYSTEMS	MC			1-3, 22		
DOOR GRILLES (IF APPLICABLE)	TAB			1-3, 22		
ROOF/WALL OPENINGS	GC			1-3, 20-24		
APPLIANCE BACKFLOW PREVENTION	KES/BSI	PC	PC	1-3, 23, 27		
CO2 DETECTION SYSTEM	MC	EC	EC	1-3, 22, 27		

AIR DEVICE SCHEDULE								
Tag	Manufacturer	Model	Border	Size	Color	Accessories	Notes	
S-1	TITUS	PDR	LAY-IN	48x24	WHITE	7	1,2	
S-2	TITUS	SPD	LAY-IN	24x24	VARIERS	4,6,7	1,6,7	
S-3	TITUS	SPD	LAY-IN	12x12	VARIERS	1,2,7	1,3,6	
S-5	TITUS	TBDI-80	LAY-IN	48"	(1) 24" SLOT	VARIERS	7	1,5,6
R-1	TITUS	60L	LAY-IN	24x24	VARIERS	3,7	1,6	
E-1	TITUS	60L	LAY-IN	12x12	WHITE	1,7	1	
ACCESSORIES:								
NOTES: 1. COMBINATION DAMPER AND EQUALIZING GRID 2. PLASTER FRAME FOR DRYWALL CEILING INSTALLATION 3. SQUARE-TO-ROUND COLLAR CONNECTION 4. BACKPACK INSULATION 5. OPOSED BLADE DAMPER 6. BLANK-OFF PANEL AS SHOWN ON DUCTWORK PLAN 7. PLASTER FRAME MAY BE NECESSARY - COORDINATE WITH DECOR DRAWINGS 8. 1" FILTER MEDIA								
NOTES: 1. SEE PLAN FOR NECK SIZES 2. FABRICATE 46" x 22" x 27" plenum with 14" side inlet (see detail 10 on drawing M3.0) 3. PROVIDE 1" FIBERGLASS INSULATION FOR DIFFUSER BACKPAN 4. NOT USED 5. GENERAL CONTRACTOR SHALL PROVIDE ADDITIONAL 4 FT. T-BAR FOR DIFFUSER FRAMING 6. AIR DEVICE FINISH WILL VARY: * KITCHEN, STORAGE, RESTROOM - WHITE * DINING ROOM, VESTIBULES - WHITE, BLACK OR PAINTABLE/PRIME COAT (COORDINATE FINAL COLOR WITH DECOR PLANS). 7. ADDITIONAL ACCESSORIES AND/OR ALTERNATE DIFFUSERS MAY BE REQUIRED. REFER TO DECOR DRAWINGS TO VERIFY.								

AIR CURTAIN SCHEDULE							
Tag	Manufacturer	Model	Serves	Airflow	Elec	Access.	Notes
AC 1	POWERED AIRE	MP 1-30E	CASH BOOTH	VARIABLE	8 KW 1/2 HP	2,3,5-7	1-2
AC 2	POWERED AIRE	MP 1-30E	PRESENTER'S BOOTH	VARIABLE	8 KW 1/2 HP	2,3,5-7	1-2
AC 3	POWERED AIRE	RBT 1-48	STORAGE ENTRANCE	2,559 CFM	MCA: 10 MOPC: 20 3/4 HP	1-4	1,2
AC 4	POWERED AIRE	RBT 1-36	REAR ENTRANCE	2,541 CFM	MCA: 10 MOPC: 20 3/4 HP	1-4	1,2
AC 5	POWERED AIRE	MP 1-30	FORWARD PRESENTER'S BOOTH	VARIABLE	MCA: 5.5 MOPC: 10 3/4 HP	2-4	1,2
ACCESORIES:							
NOTES: 1. SEE DELAY TIMER TO 30 SECONDS							

KITCHEN HOOD SCHEDULE							
GENERAL				AIRFLOW			
Tag	Served By	Manufacturer	Model	CFM	CFM/LF	QTY/SIZE	FPM
KH 1	EXHAUST FAN (EF-1)	FRANKE	UH-122	1-4	1350	166	(5)10x20
KH 2	EXHAUST FAN (EF-2)	FRANKE	UH-50	1-4	575	173	(3)10x16
KH 3	EXHAUST FAN (EF-3)	FRANKE	UH-43	1-4	480	166	(2)10x20
NOTES:							
1. HOODS SHALL BE PROVIDED BY THE KES (SEE COORDINATION SCHEDULE)<br							

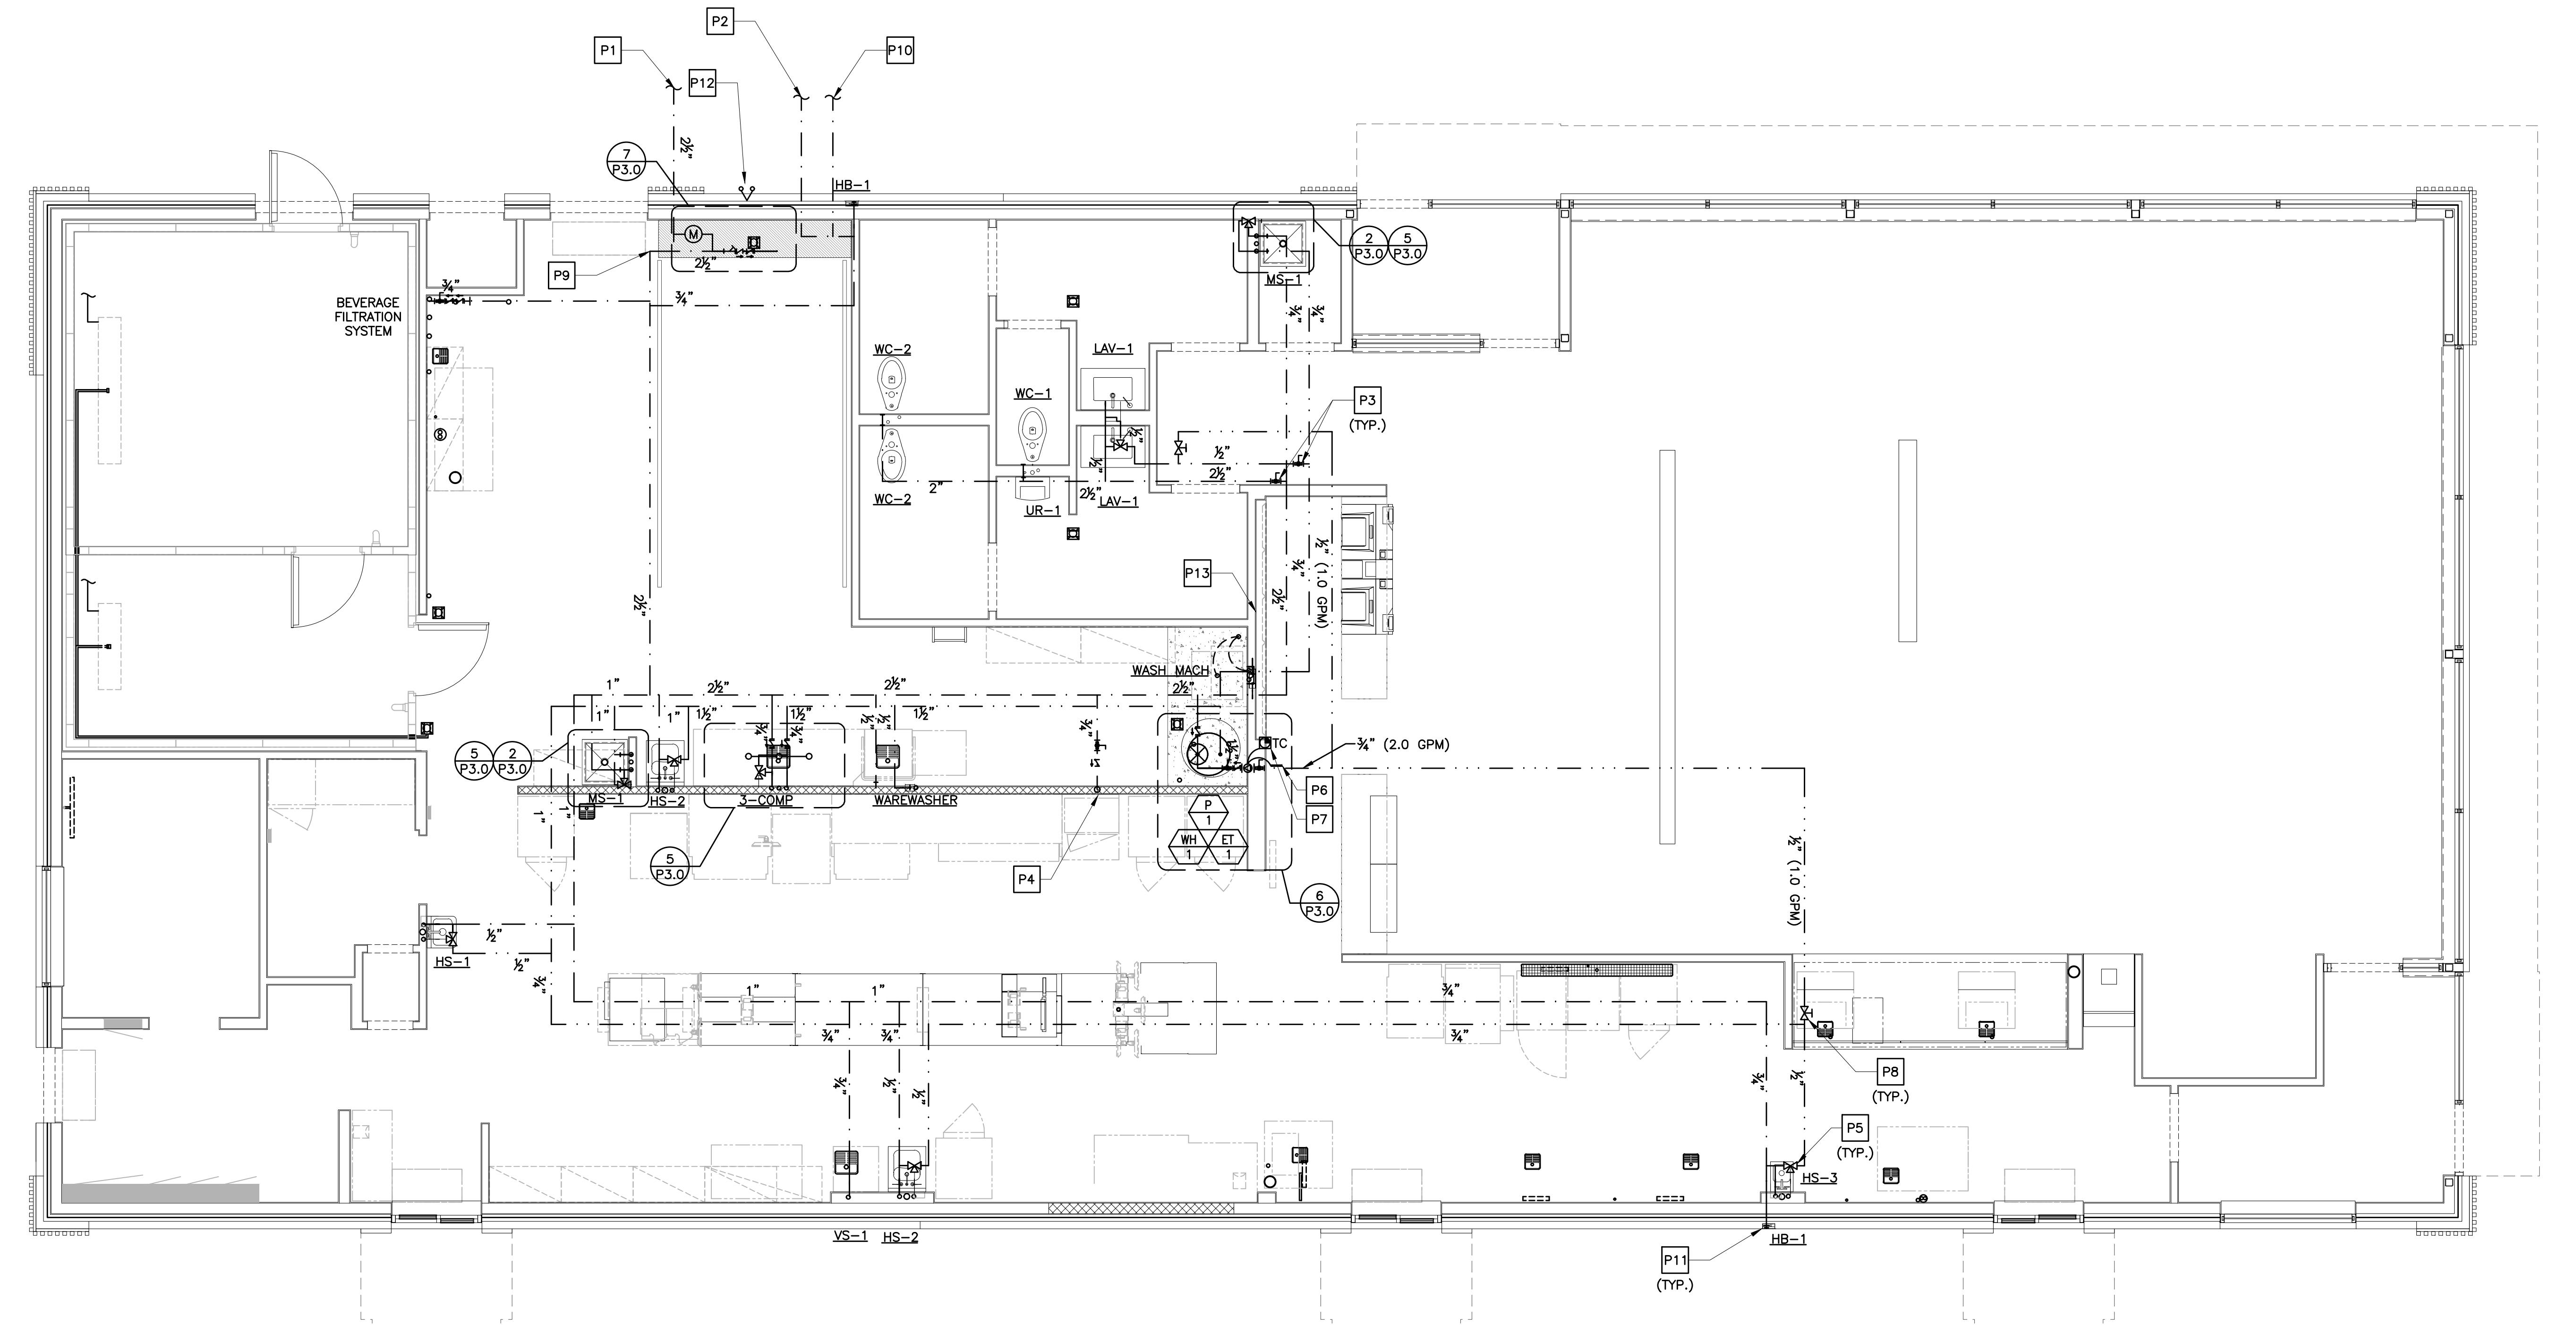

1 DOMESTIC WATER PIPING PLAN
P1.0 1/4"=1'-0"

DRAWING NOTES

1. PIPING ROUTES AS SHOWN ARE GENERAL AND MAY VARY DUE TO FIELD CONDITIONS. COORDINATE ALL PIPE ROUTES WITH OTHER TRADES.
2. ALL WATER DISTRIBUTION PIPING SHALL BE INSULATED. INSULATION NOT SHOWN FOR CLARITY. SEE PLUMBING NOTES FOR INSULATION REQUIREMENTS.
3. ALL OUTDOOR UTILITIES MOUNTED ON THE WALL MUST BE PAINTED TO MATCH THE BUILDING

DRAWINGS AND SPECIFICATIONS ARE TO BE CONSIDERED AS SUPPLEMENTING EACH OTHER. WORK SPECIFIED BUT NOT SHOWN ON DRAWINGS, OR SHOWN ON DRAWINGS BUT NOT SPECIFIED, SHALL BE PERFORMED OR FURNISHED AS THOUGH MENTIONED IN BOTH SPECIFICATIONS AND DRAWINGS. IF NOT OTHERWISE DIRECTED, INSTALLATION OF ALL SYSTEMS AND EQUIPMENT SHALL BE IN ACCORDANCE WITH APPLICABLE CODES AND IN ACCORDANCE WITH MANUFACTURER'S INSTALLATION INSTRUCTIONS. WHERE WORK DESCRIBED IN THE SPECIFICATIONS IS IN CONFLICT WITH THE WORK SHOWN ON THE DRAWINGS, THE CONTRACTOR SHALL SUPPLY THE GREATER QUANTITY, QUALITY AND COST VIA THE BID AND CONTACT THE ENGINEER FOR CLARIFICATION ON DIRECTION PRIOR TO INSTALLATION.

PRIOR TO BID, THE CONTRACTOR SHALL REVIEW THE MECHANICAL, ELECTRICAL AND KITCHEN EQUIPMENT DRAWINGS. THE CONTRACTOR SHALL INCLUDE IN HIS BID ALL RELEVANT WORK IN THE ENTIRE SET OF DOCUMENTS AND REPORT ALL DISCREPANCIES BETWEEN THESE DRAWINGS TO THE ENGINEER PRIOR TO BIDDING FOR CLARIFICATION. DISCREPANCIES REMAIN UNRESOLVED DUE TO A SHORT TIME FRAME, THE CONTRACTOR SHALL INCLUDE THE MOST WORK AND THE HIGHER COSTS IN THE BID. SOLUTIONS TO UNREPORTED DISCREPANCIES WILL BE DETERMINED BY THE ARCHITECT/ENGINEER, WITH NO ADDITIONAL COMPENSATION DUE TO THE CONTRACTOR.

KEYED NOTES

- P1 INCOMING UNDERGROUND WATER SERVICE (SEE SITE PLAN FOR CONTINUATION). WATER PIPING FROM THIS POINT TO CEILING PENETRATION INSIDE BUILDING SHALL BE COPPER.
- P2 COLD WATER UNDERGROUND TO YARD HYDRANT (HB-2) IN TRASH CORRAL. SEE SITE PLAN FOR CONTINUATION.
- P3 SHUT-OFF VALVE FOR RESTROOM AND HOSE BIBB ISOLATION. SEE VALVE SCHEDULE. ALL LOCATE IN AREAS WITH DRYWALL CEILINGS.
- P4 1/4" COLD WATER UP TO ROOF HYDRANT.
- P5 MIXING VALVE LOCATIONS SHOWN FOR INFORMATIONAL PURPOSES. SEE DETAIL 3 ON DRAWING P3.0 FOR MIXING VALVE INSTALLATION DETAILS.
- P6 PIPE-MOUNTED AQUASTAT TO SHUT PUMP DOWN WHEN RECIRCULATION TEMPERATURE REACHES 140°F. SEE DETAIL 6 ON DRAWING P3.0.
- P7 TIME CLOCK TO SHUT PUMP AND WATER HEATER DOWN DURING UNOCCUPIED HOURS. SEE ELECTRICAL DRAWINGS FOR WIRING DETAIL.
- P8 BALANCING VALVE FOR RECIRCULATION SYSTEM. SEE VALVE SCHEDULE. ALL BALANCING VALVES SHALL BE LOCATED OVER SUSPENDED CEILINGS FOR ACCESSIBILITY. DO NOT LOCATE IN AREAS WITH DRYWALL CEILINGS.
- P9 WATER PIPING AFTER CEILING PENETRATION CAN TRANSITION TO CPVC WHERE PERMITTED BY CODE.
- P10 VERIFY IRRIGATION SYSTEM, PROVIDE WATER LINE WITH BACKFLOW PREVENTER, VERIFY EXACT LOCATION WITH LANDSCAPE. 1" SEWER DEDUCT METER AND BACKFLOW ASSEMBLY.
- P11 PROVIDE FREEZE PROOF HYDRANT.

FIRE DEPARTMENT SIAMESE CONNECTION. SPRINKLER CONTRACTOR SHALL ROUTE LINE IN ACCESSIBLE CEILING SPACE FROM CONNECTION TO FIRE SPRINKLER SERVICE. MAKE ALL CONNECTIONS REQUIRED. VERIFY PIPE SIZE AND LOCATION OF SIAMESE WITH CIVIL AND FIRE MARSHALL. PROVIDED BY OTHERS. COORDINATE LOCATION OF SIAMESE CONNECTION WITH FIRE SPRINKLER SHEETS.

P13 PROPERLY SEAL ALL PIPE PENETRATIONS THROUGH ANY FIRE WALL(TYP)


SUPPLY PIPE SIZING - UPC

Fixture Type	SIZE	SUPPLY HW	SUPPLY CW	QUANTITY	TOTAL
URINAL	1 IN.	0	20	1	20
WATER CLOSET	1 IN.	0	90	3	90
LAVATORY SINK	1/2 IN.	1	1	2	2
WASH SINK (HAND SINK)	1/2 IN.	2	2	4	8
MOP SINK	3/4 IN.	3	3	2	6
VEGETABLE SINK	3/4 IN.	0	3	1	3
3-COMP SINK	3/4 IN.	3	3	1	3
WASHING MACHINE	3/4 IN.	4	4	1	4
DISH WASHER	3/4 IN.	1.5	1.5	1	3
HOSE BIB	3/4 IN.	0	2.5	4	5.5
LAWN SPRINKLER	1/2 IN.	0	1	4	4
WATER FILTRATION SYSTEM	3/4 IN.	0	1	3	3
CLEANING FAUCET	1/2 IN.	2	2	0	0
TOTAL					151.5

IF YOU HAVE ANY QUESTIONS REGARDING THE PLANS, PLEASE CALL THE DESIGNER.

DESIGNER: Wendy Wenborg
PHONE/FAX: 952-540-4047
EMAIL: wwwenborg@epinc.com

PREPARED BY:	emmanuelson-podas
CONSULTING ENGINEERS	Emmanuelson-Podas, Inc. Edina, MN 55439 (612) 990-0050 www.epinc.com
DATE:	05/05/20
W/L/W	01/23/20 PERMIT SET
W/L/W	01/13/20 USD PROGRESS SET REVIEW
W/L/W	REV DATE

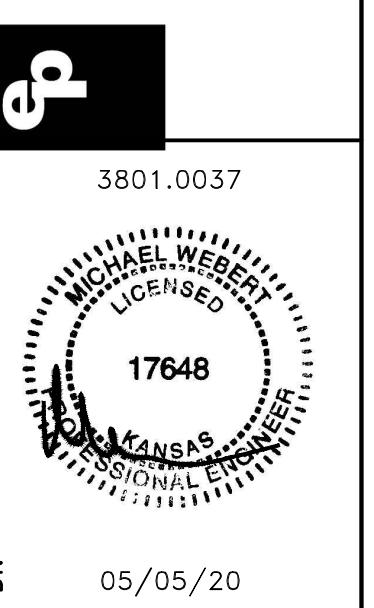

05/05/20

3801.0037

© 2020 McDonald's USA, LLC

McDonald's USA, LLC


These drawings and specifications are the confidential and proprietary property of McDonald's USA, LLC and shall not be copied or reproduced for use on this specific site in conjunction with the issuance of another permit or license or for use on a different site or at a later time. Use of these drawings for reference or example on another project requires the services of properly licensed architects and engineers. Reproduction of the contract documents for reuse on another project is not authorized.

DRAWN BY: M.J.W.
STD ISSUE DATE: 2019-11
REVIEWED BY: W/L/W
DATE ISSUED: 01-23-20
SITE ADDRESS: 605 SOUTH 7TH STREET, KANSAS CITY, KS
REF#19175

SHEET NO. 015-0071.00.A

P1.0

DOMESTIC WATER PIPING

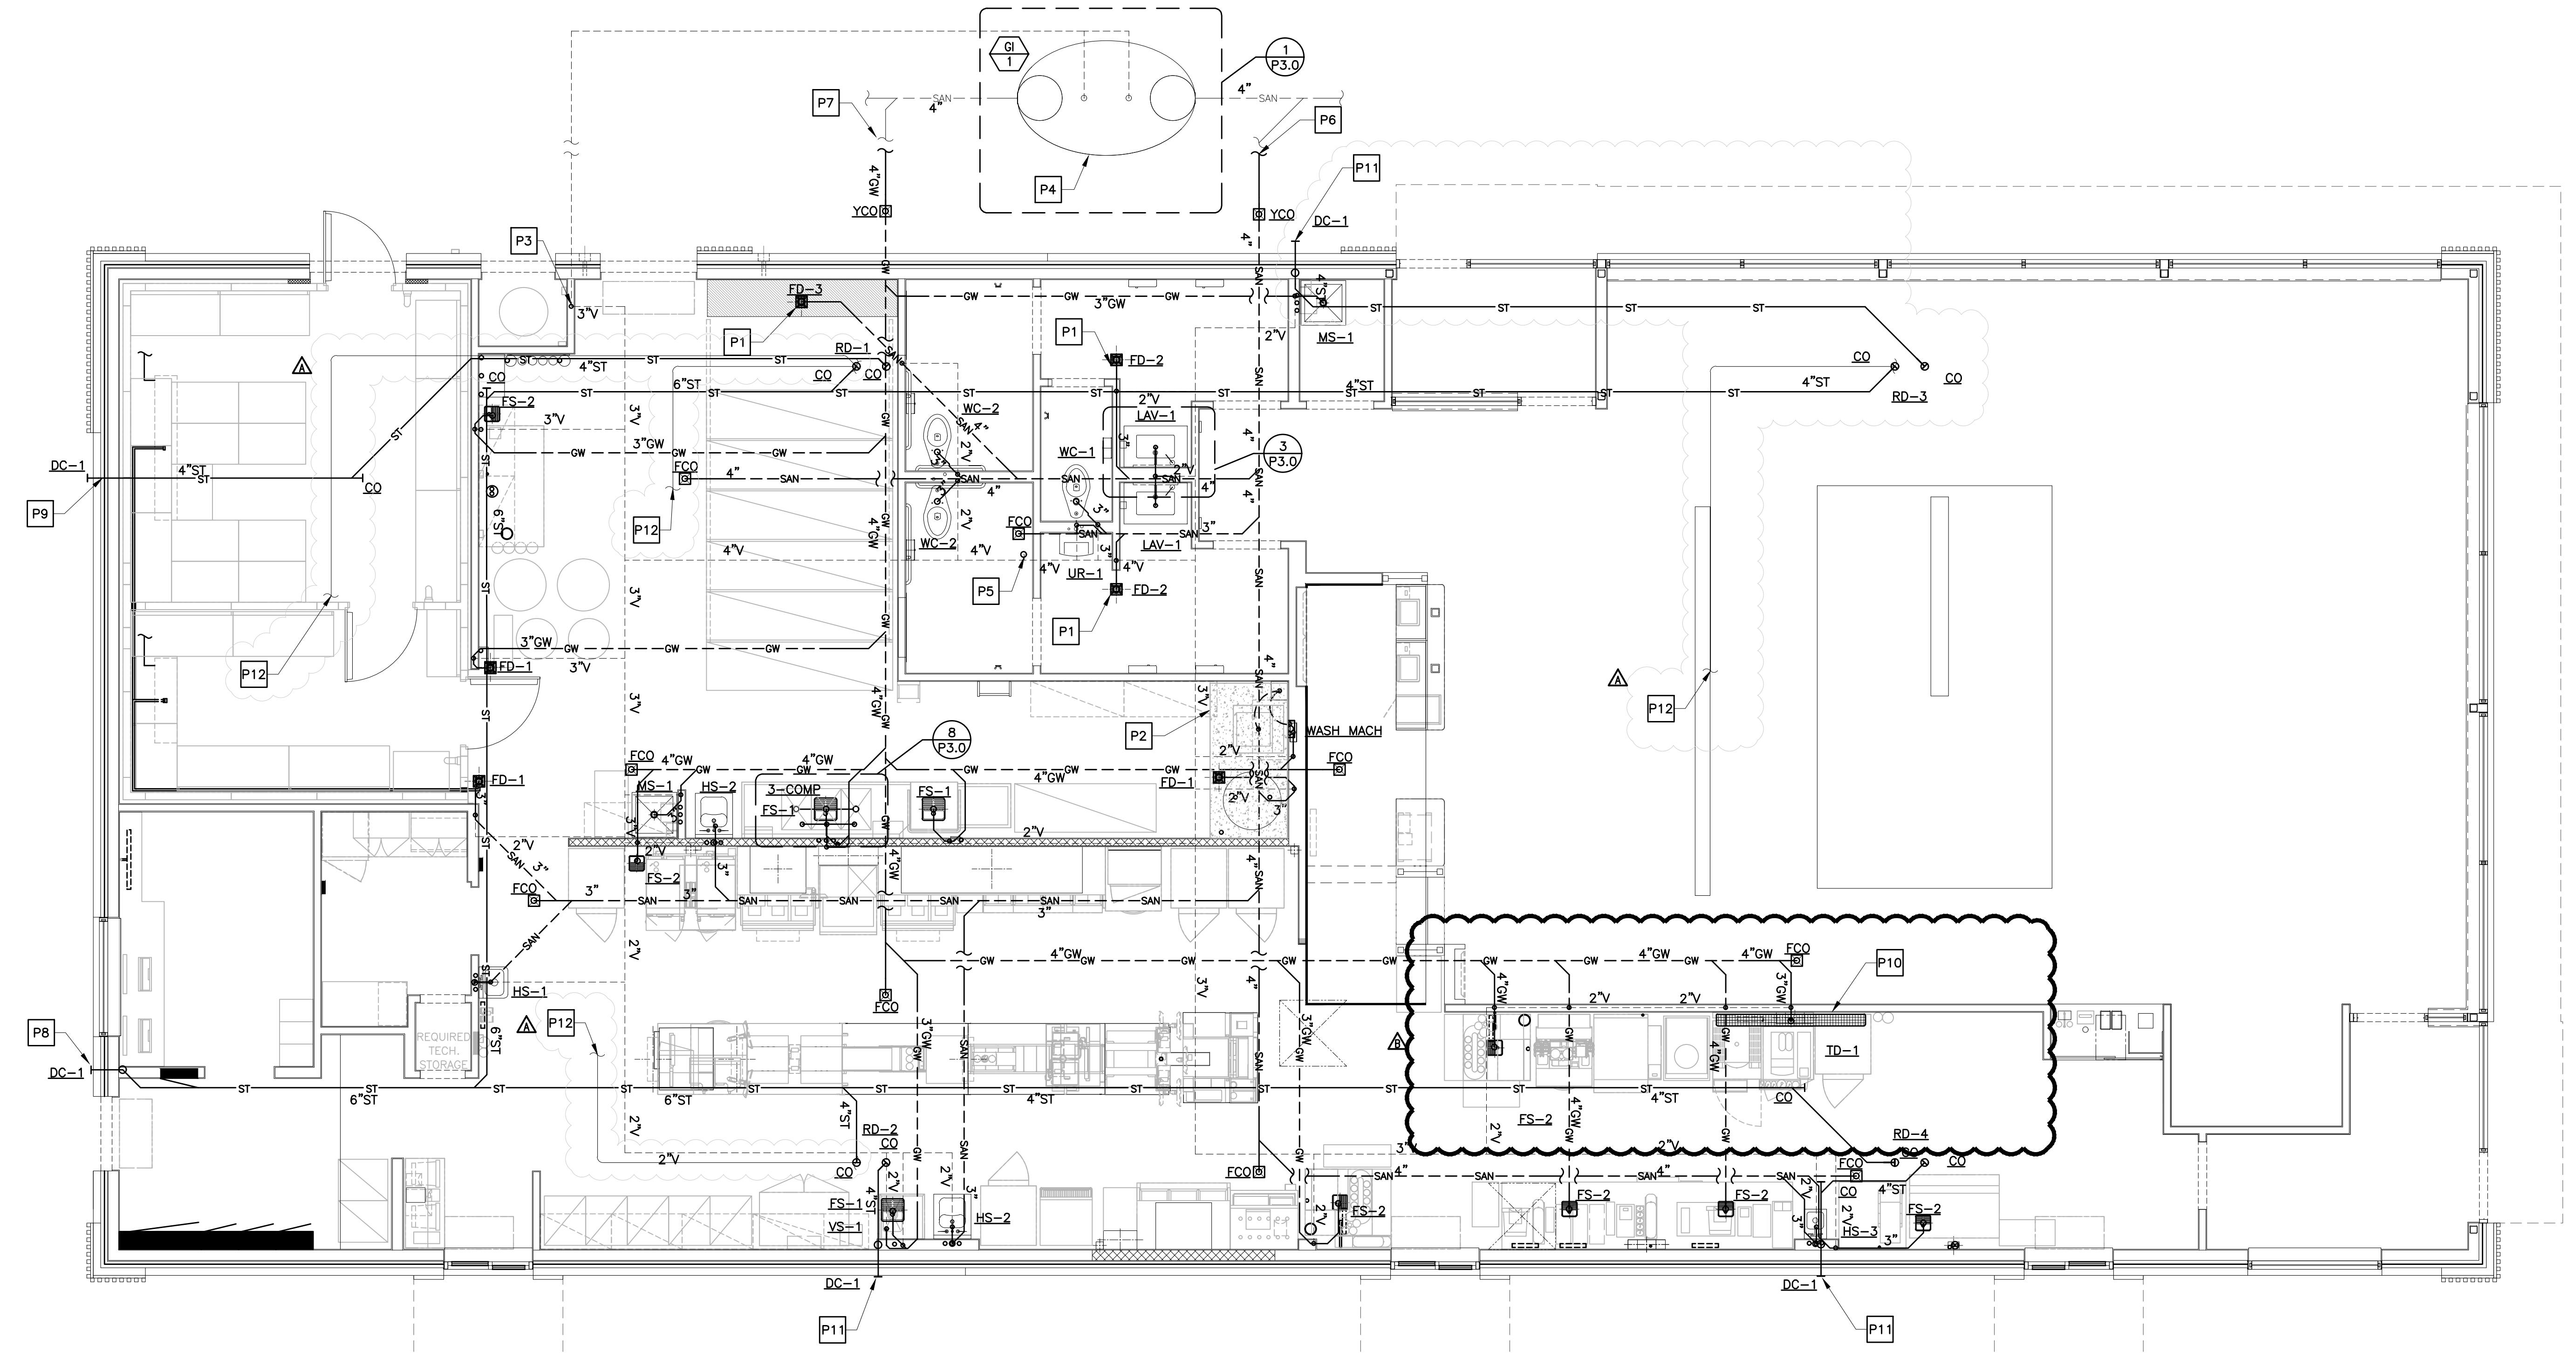

1 WASTE & VENT PIPING PLAN
P1.2 1/4"=1'-0"

DRAWING NOTES

1. PIPING ROUTES ARE GENERAL AND MAY VARY DUE TO FIELD CONDITIONS. COORDINATE ALL PIPE ROUTES WITH OTHER TRADES.
2. WALL CLEAN-OUTS FOR WASTE PIPING NOT SHOWN FOR CLARITY. SEE GENERAL NOTES FOR REQUIREMENTS.
3. ONLY MAIN FLOOR CLEAN-OUTS ARE SHOWN FOR CLARITY. SEE GENERAL NOTES FOR REQUIREMENTS.
4. ALL HORIZONTAL STORM DRAINAGE PIPING SHALL BE INSULATED TO PREVENT CONDENSATION. INSULATION NOT SHOWN FOR CLARITY. SEE PLUMBING NOTES FOR INSULATION REQUIREMENTS.=

KEYED NOTES

- P1 PROVIDE PROSET TRAP GUARD® OR TRAP PRIMER FOR FLOOR DRAIN OR FLOOR SINK.
- P2 TOP OF CONCRETE SLAB IS 0'-6" A.F.F.
- P3 VENT FROM GREASE INTERCEPTOR. SEE SITE PLAN FOR CONTINUATION. COORDINATE PIPE ROUTING WITH LOCATION OF GREASE INTERCEPTOR.
- P4 GREASE INTERCEPTOR LOCATION SHOWN FOR REFERENCE ONLY. COORDINATE GREASE INTERCEPTOR LOCATION WITH CIVIL ENGINEER AND SITE CONTRACTOR.
- P5 4"x5" VENT THROUGH ROOF
- P6 SANITARY LINE TO SANITARY SEWER. SEE SITE PLAN FOR CONTINUATION.
- P7 GREASE LINE TO EXTERIOR GREASE INTERCEPTOR. SEE SITE PLAN FOR CONTINUATION
- P8 TERMINATE BOTTOM OF PRIMARY STORM DRAIN A MINIMUM OF 12" ABOVE GRADE WITH DOWNSPOUT COVER.
- P9 TERMINATE OVERFLOW DRAIN AS HIGH AS POSSIBLE WITH DOWNSPOUT COVER.
- P10 REFERENCE MANUFACTURER INSTALLATION GUIDE FOR LAYOUT GUIDELINES PRIOR TO INSTALL AND POURING THE SLAB
- P11 TERMINATE BOTTOM OF OVERFLOW DRAIN A MINIMUM OF 12" ABOVE GRADE WITH DOWNSPOUT COVER.
- P12 ROUTE CONDENSATE TO ROOF DRAIN AS SHOWN

WASTE PIPE SIZING - UPC

Fixture Type	TRAP SIZE	DFU	QUANTITY	TOTAL
URINAL	2 IN.	2	1	2
WATER CLOSET	3 IN.	4	3	12
LAVATORY SINK	1 1/4 IN.	1	2	2
WASH SINK (HAND SINK)	1 1/2 IN.	2	4	8
FLOOR DRAIN OR SINK	3 IN.	6	5	30
FLOOR DRAIN OR SINK	4 IN.	8	1	8
FLOOR DRAIN EMERGENCY	3 IN.	0	0	0
TOTAL				62

GREASE PIPE SIZING - UPC

MOP SINK	3 IN.	3	2	6
FLOOR DRAIN OR SINK	3 IN.	6	10	60
TRENCH DRAIN	4 IN.	8	1	8
WASHING MACHINE	2 IN.	1	3	3
TOTAL				77

STORM PIPE SIZING

RAINFALL = 4 IN./HR
VERTICAL LEADERS


ROOF AREA	SIZE
RD-1	1,345
RD-2	1,340
RD-3	1,145
RD-4	1,145
TOTAL	4,975

HORIZONTAL PIPING (SLOPE X" PER FOOT)

ROOF AREA	SIZE
RD-1	1,345
RD-2	1,340
RD-3	1,145
RD-4	1,145
TOTAL	4,975

DESCRIPTION	REV DATE
W.L.W. SERVICE AREA OPTIMIZATION	12/03/20
W.L.W. USD: SAO SET REVIEW	11/13/20
W.L.W. CIVL & PLAN REVIEW COMMENTS	05/05/20
W.L.W. PERMIT SET	01/23/20
W.L.W. PROGRESS SET REVIEW	01/13/20
W.L.W. REV DATE	

emmanuelson-podas consulting engineers
380.00.037
Michael Weber
LICENSED
17648
KANSAS STATE BOARD OF ENGINEERS
12/03/20

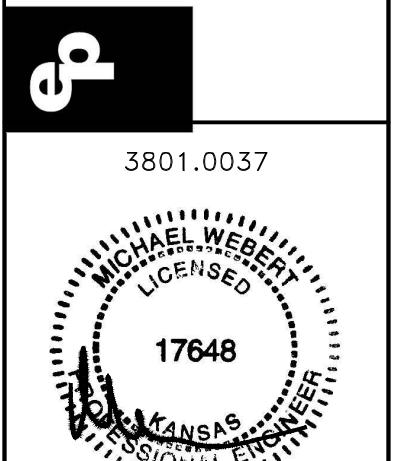

© 2020 McDonald's USA, LLC
PREPARED BY:
McDonald's USA, LLC
These drawings and specifications are the confidential and proprietary property of McDonald's USA, LLC and shall not be copied or reproduced for use on this specific site in construction with the issuance of one or more sets of drawings for reference or example on another project, unless the services of properly licensed architects and engineers. Reproduction of the contract documents for reuse on another project is not authorized.

PREPARED FOR:
McDonald's USA, LLC

REVIEWED BY:
W.L.W.

DATE ISSUED:
01-23-20

REF# 1975

TITLE: 2019 STANDARD BUILDING - BB20
4597F10-WOOD/WOOD


DESCRIPTION: DEBRARING WALLS W/FIBER CEMENT SIDING & CI
WOOD BEARING WALLS W/FIBER CEMENT SIDING & CI
WOOD ROOF TRUSS FRAMING

SITE ID: SITE ADDRESS: 605 SOUTH 7TH STREET, KANSAS CITY, KS

015-0071.00.B

P1.2

WASTE, VENT & STORM PIPING

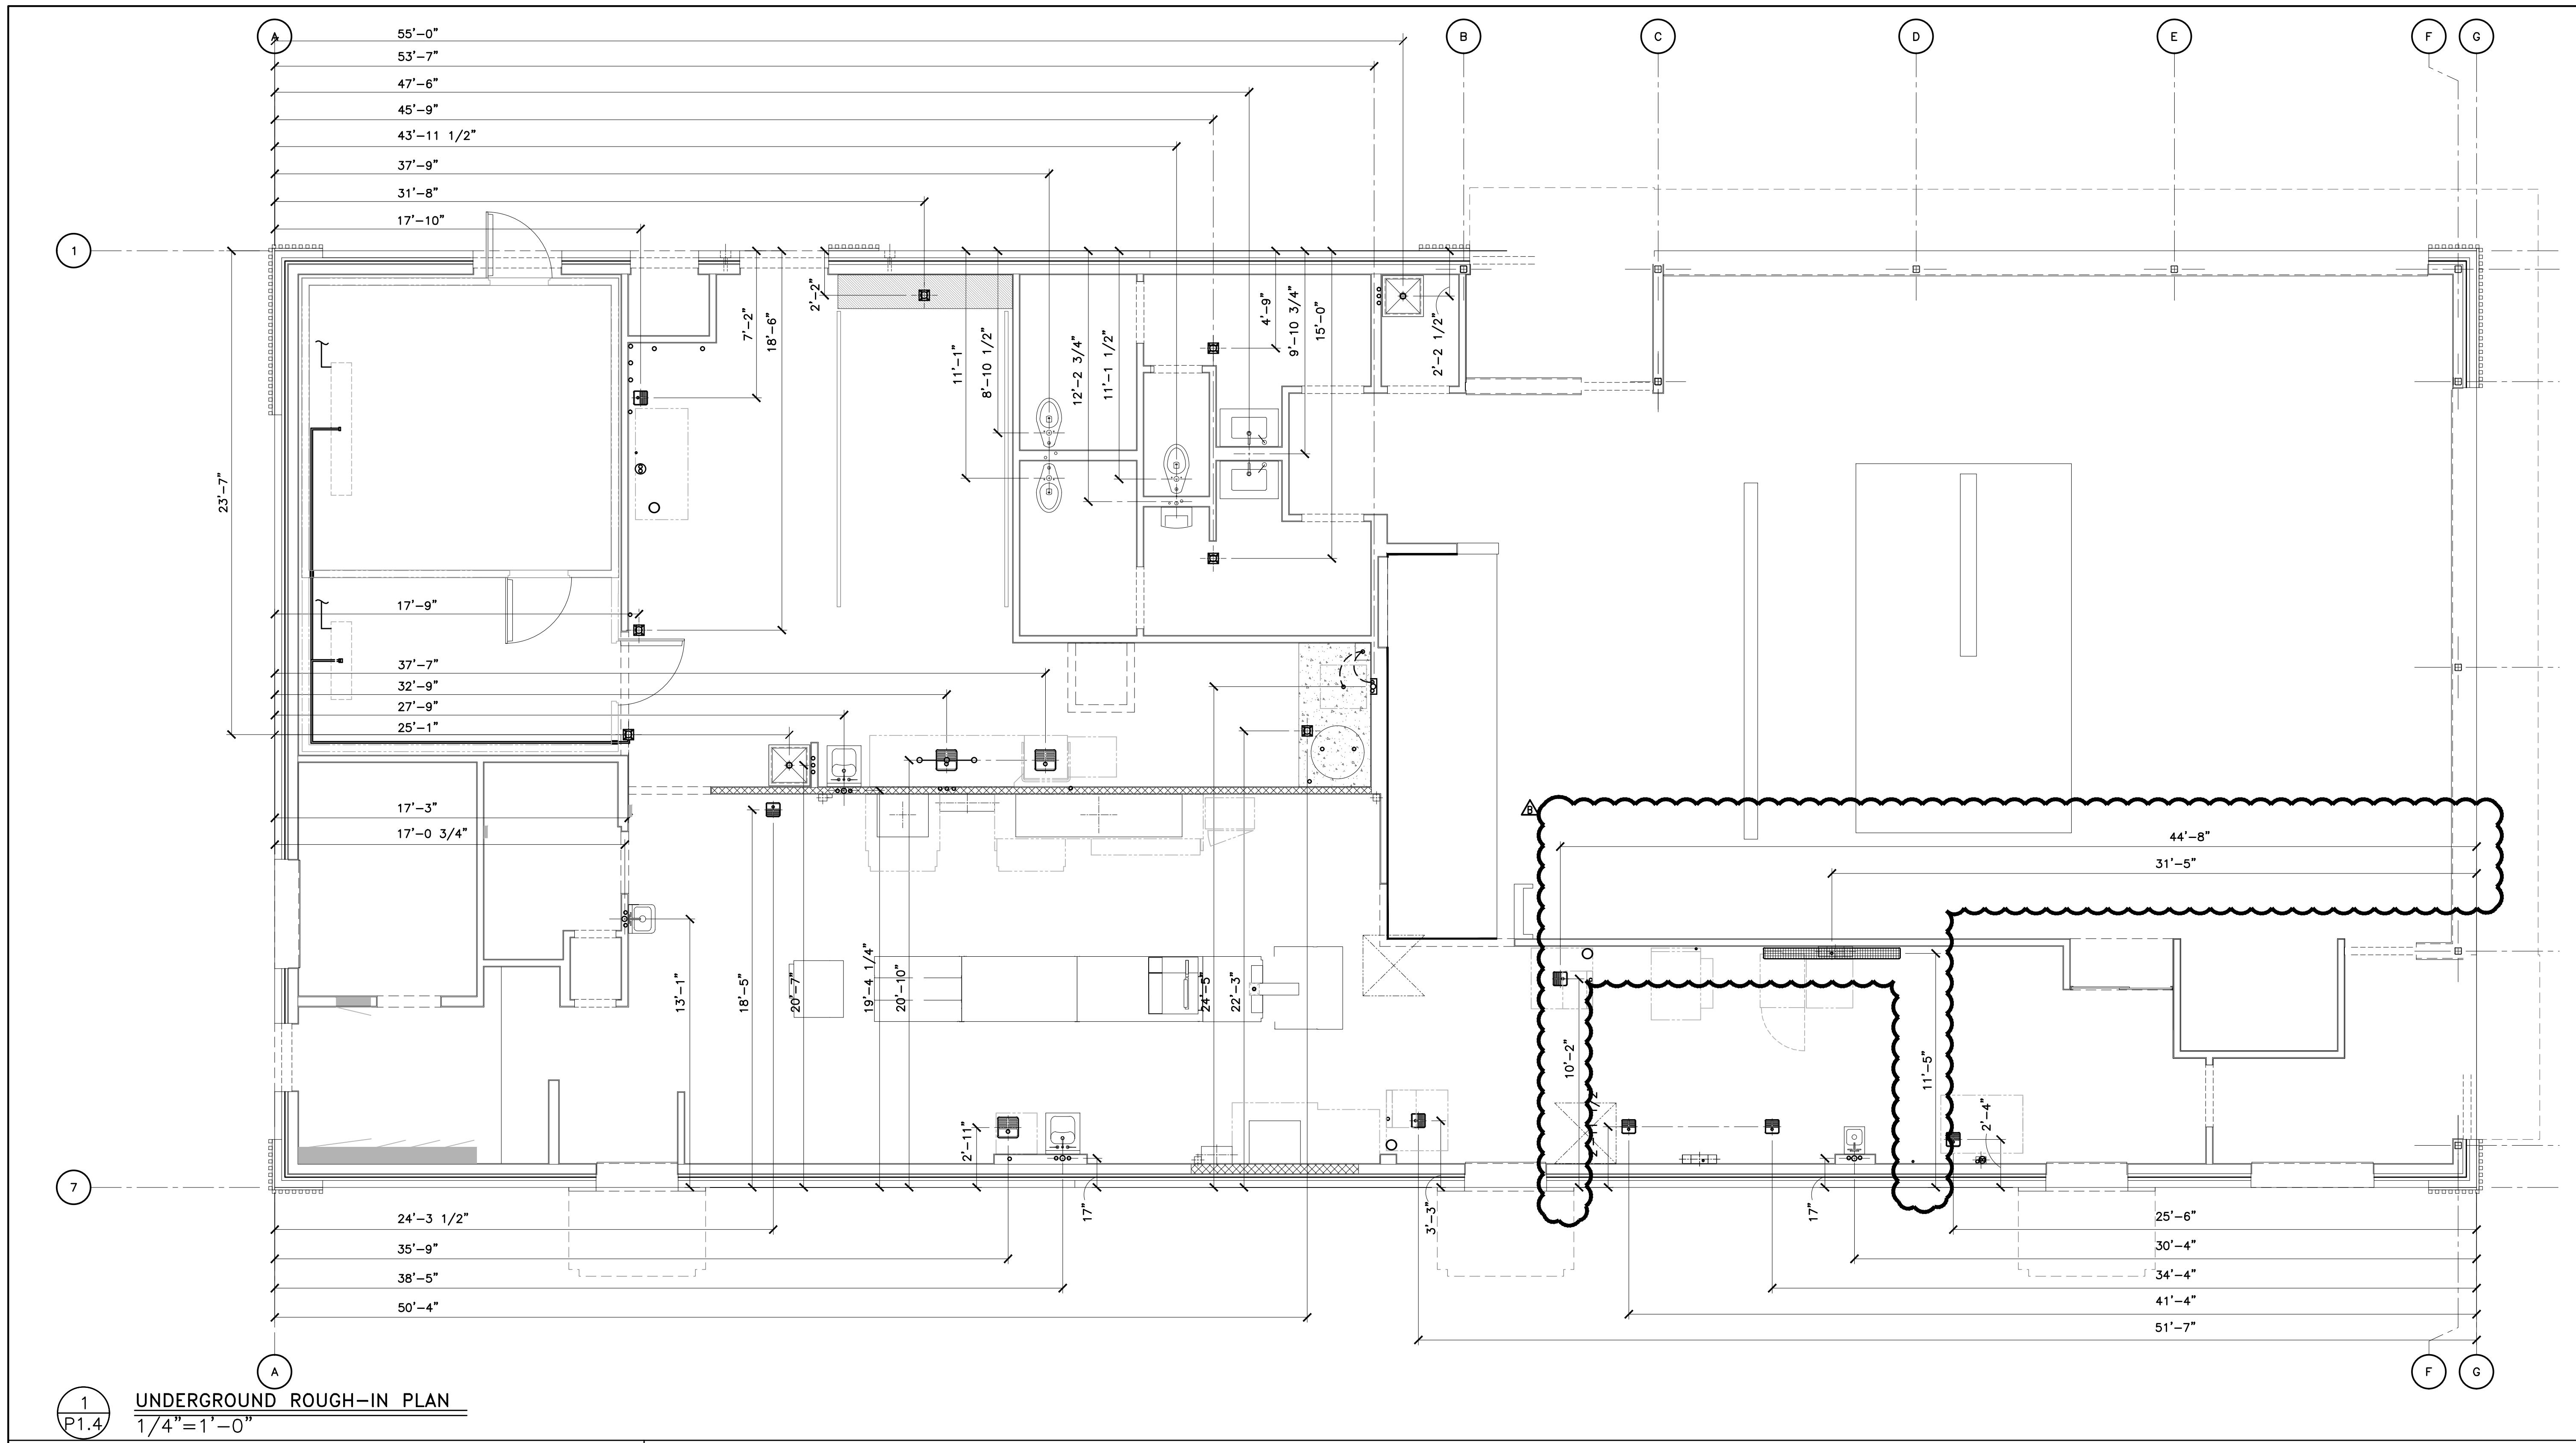


DRAWING NOTES

1. THIS PLAN IS PROVIDED AS A GUIDE FOR THE PLUMBING CONTRACTOR. ALL DIMENSIONS ARE ROUNDED TO THE NEAREST $\frac{1}{4}$ ", AND ARE TAKEN FROM ARCHITECTURAL GRID LINES.

SHEET NO.	TITLE	PREPARED BY:	REVIEWED BY:	DATE ISSUED:	DESCRIPTION	REV. DATE	BY
	McDonald's USA, LLC	M.J.W	W.L.W.	12/03/20	SERVICE AREA OPTIMIZATION		
				11/13/20	USED SAD SET REVIEW		
				05/05/20	CIVIL & PLAN REVIEW COMMENTS		
				01/23/20	PERMIT SET		
				01/13/20	PROGRESS SET REVIEW		
				REV.	DATE		

emmanuelson-podas
consulting engineers

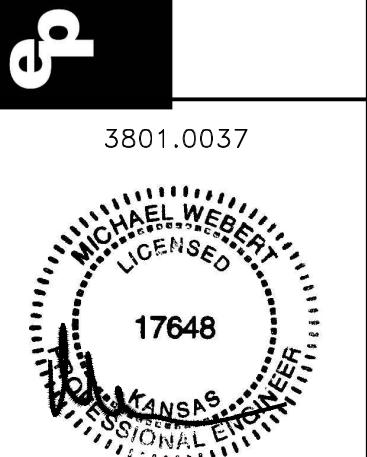

3801.0037
17648
12/03/20

(Circular stamp: MICHAEL WEBER LICENSED KANSAS PROFESSIONAL ENGINEER)

17648
12/03/20

© 2020 McDonald's USA, LLC

These drawings and specifications are the confidential and proprietary

property of McDonald's USA, LLC and shall not be copied or reproduced

or otherwise communicated without the written consent of the

owner. These drawings and specifications are issued for use on this

specific project only and are not suitable for use on any other project.

Use of these drawings for reference or example on another project requires the


services of a properly licensed architect or engineer. Reproduction of

the contract documents for reuse on another project is not authorized.

SHEET NO.	TITLE	DRAWN BY	PREPARED BY:	REVIEWED BY:	DATE ISSUED:	DESCRIPTION	REV. DATE	BY
	2019 STANDARD BUILDING - BB20	M.J.W						
	4597F10-WOOD/WOOD	STD ISSUE DATE 2019-11						
	WOOD BEARING WALLS W/FIBER CEMENT SIDING & CI							
	WOOD ROOF TRUSS FRAMING							
	FIBER CEMENT PANEL/BATTEN/ALPOLIC PANEL/BRICK EXT. FINISH							
	SITE ADDRESS							
015-0071	605 SOUTH 7TH STREET, KANSAS CITY, KS							
015-0071	R#1975							

P1.4
UNDERGROUND ROUGH-IN

SEE SHEET P1.6 FOR OVERHEAD
DIMENSIONS AND PLUMBING SCHEDULE.

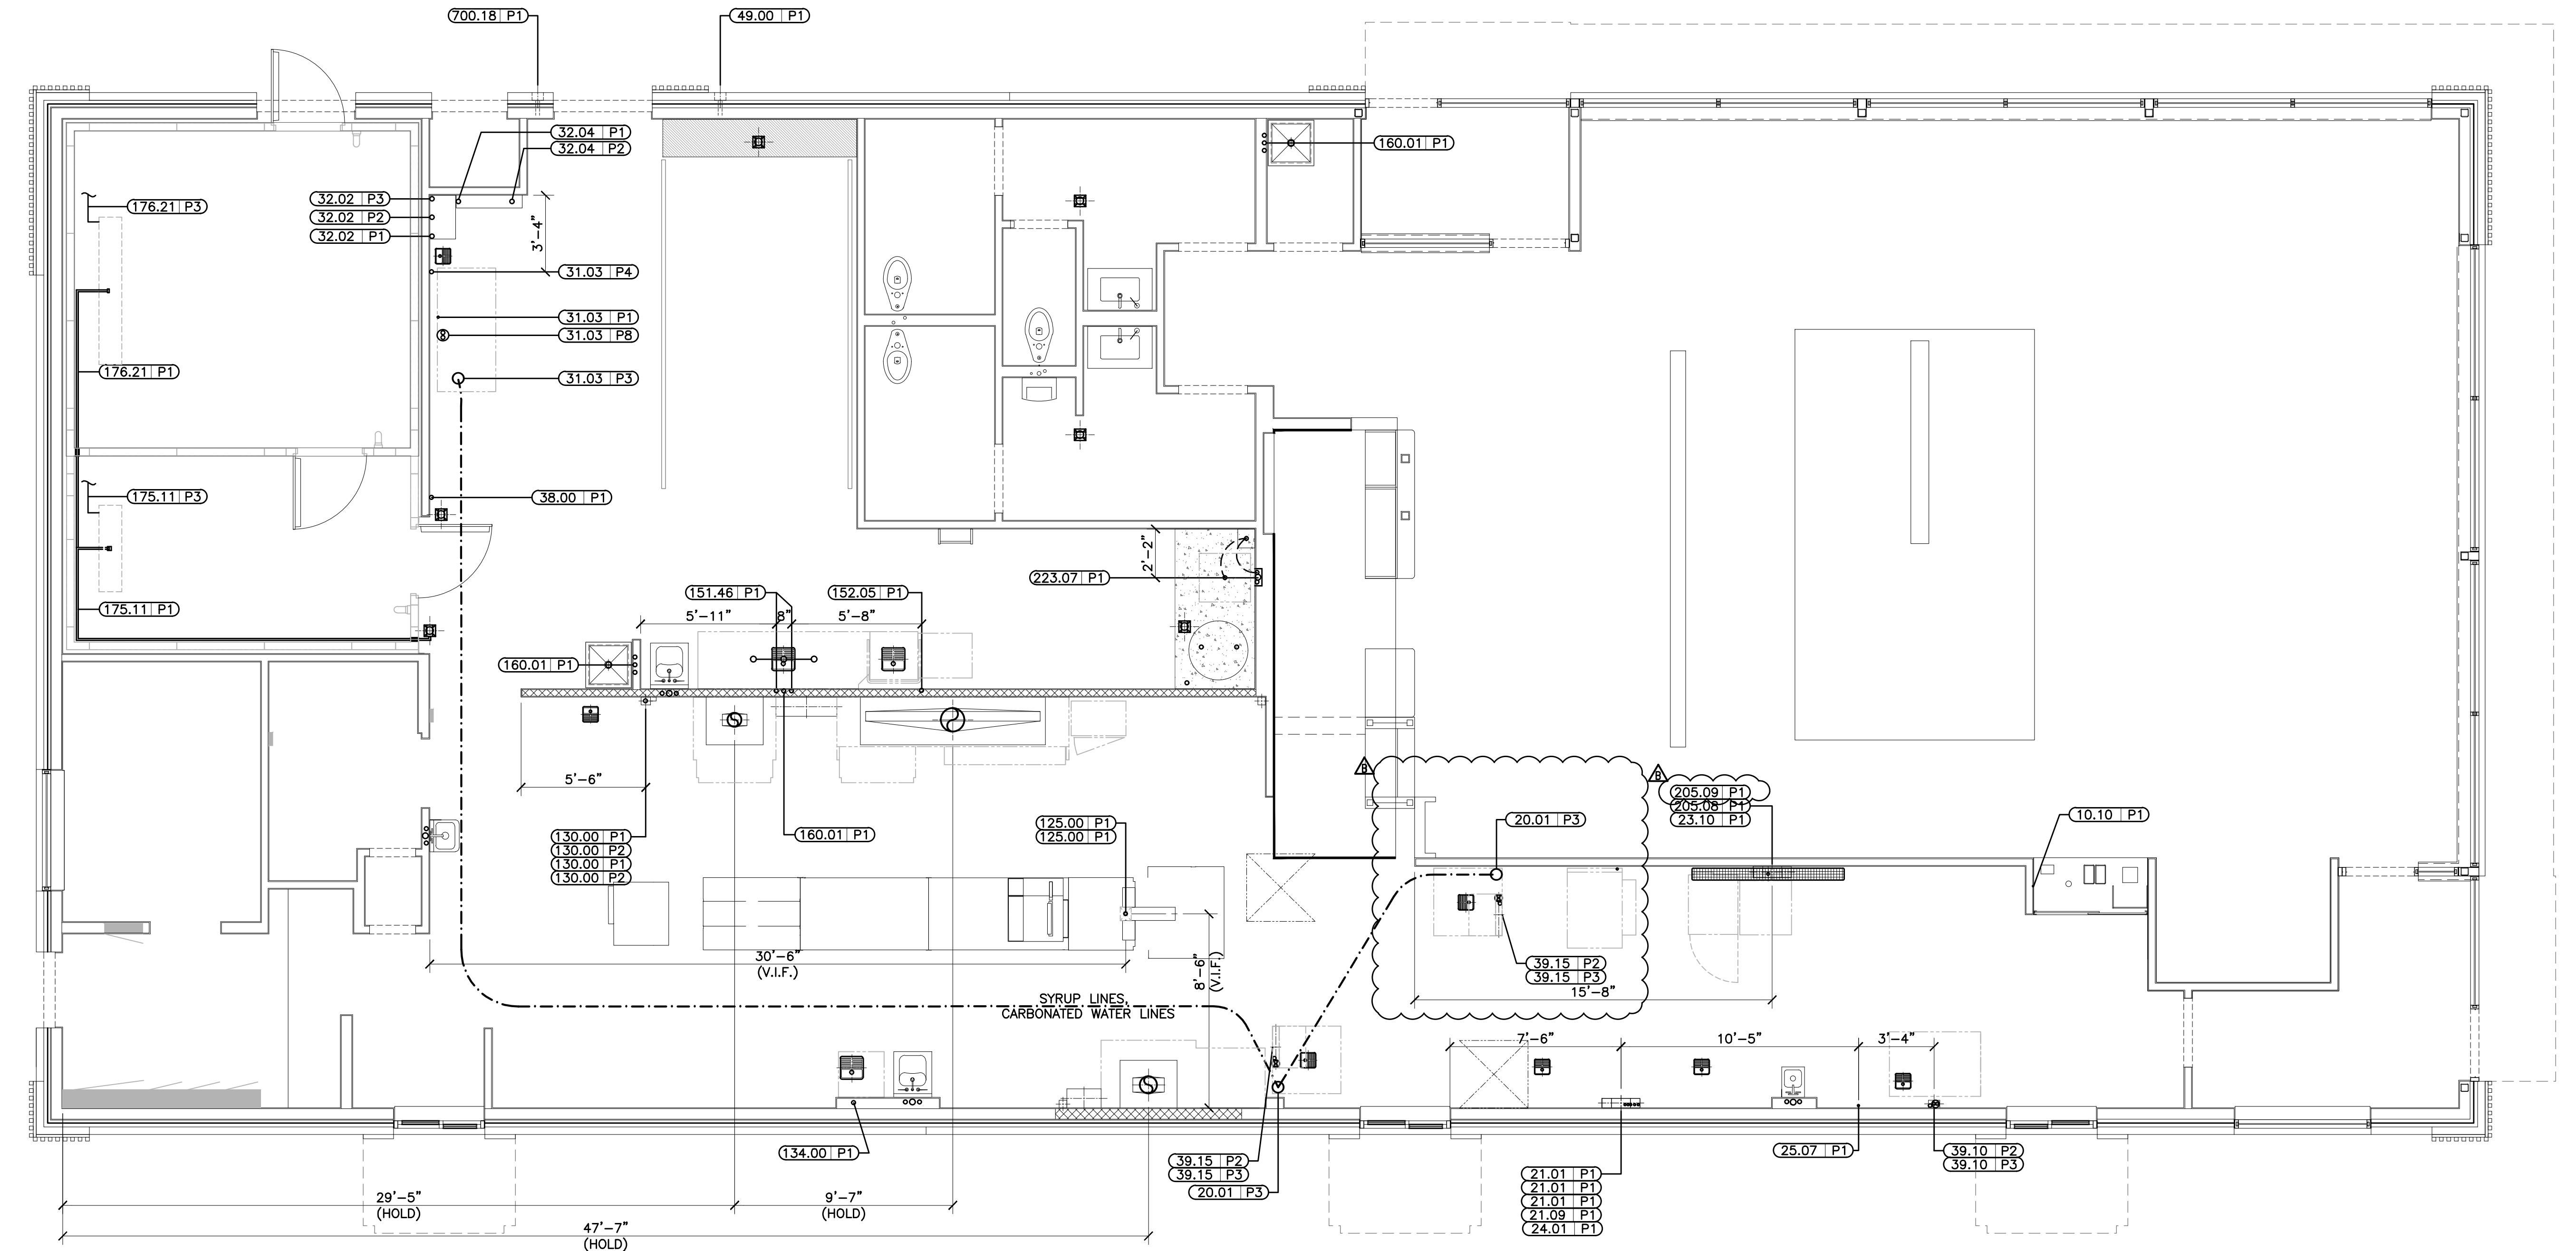

OVERHEAD ROUGH-IN PLAN
P1.6 1/4"=1'-0"

SEE SHEET P1.4 FOR
UNDERGROUND ROUGH-IN PLAN


VF = Verify in Field
PC = Plumbing Contractor
BSI = Beverage System Installer

PLUMBING SCHEDULE

TAG #	QTY	DESCRIPTION	GAS TYPE	GAS BTU	GAS SIZE	HW	CW	MISC PLBG	HGT AFF	DRAIN	REQUIREMENTS & REMARKS
010.10P1	1	CO2 DRIVEN KETCHUP DISPENSERS	-	-	-	-	-	3/8" CO2	SEE RMKS	-	DN CHASE FROM BULK CO2 IF NO CHASE RUN IN 2"COND TO JB -BSI TO CONN CO2 LINE PER LOCAL CODES
020.01P3	2	AUTOMATED BEVERAGE SYSTEM 2.0	-	-	-	-	-	6" PVC CONDUIT	SEE RMKS	-	ABOVE CEILING FROM SODA SYSTEM - TERMINATE AT CHASE
021.01P1	1	COFFEE BREWER (GLASS DECANTERS)	-	-	-	-	1/4"	TRTD	SEE RMKS	-	DN CHASE FROM SODA SYSTEM - IF NO CHASE RUN IN 2"COND TO JB -BSI TO CONN CW LINE PER LOCAL CODES. 1/4" R.O. WATER OPTIONAL
021.09P1	1	HOT WATER DISPENSER	-	-	-	-	1/4"	-	SEE RMKS	-	DN CHASE FROM SODA SYSTEM - IF NO CHASE RUN IN 2"COND TO JB -BSI TO CONN CW LINE PER LOCAL CODES. 1/4" R.O. WATER OPTIONAL
023.10P1	1	ESPRESSO BREWER	-	-	-	-	3/8"	R.O.	SEE RMKS	-	DN CHASE FROM P.C. SYSTEM IF NO CHASE RUN IN 2"COND TO JB -BSI TO CONN CW LINE PER LOCAL CODES
024.01P1	1	ORANGE JUICE DISPENSER	-	-	-	-	1/2"	FLTR	SEE RMKS	-	DN CHASE FROM SODA TOWER CW LINE W/ RECURV/CHILLED INSULATED BUNDLE-BSI CONN CWLINE LOCAL CODES PERMITTING
025.07P1	1	INFUSION TEA BREWER - MIS	-	-	-	1/2"	TRTD	3/8" CO2	SEE RMKS	-	DN CHASE FROM SODA SYSTEM - IF NO CHASE RUN IN 2"COND TO JB -BSI TO CONN CW LINE PER LOCAL CODES
028.15P3	1	NOT USED	-	-	-	-	-	SODA BUNDLE	SEE RMKS	3/4" IND	DN CHASE FROM SODA SYSTEM - BSI TO MAKE FINAL CONNECTIONS PER LOCAL CODES
031.03P1	1	SODA SYSTEM PACKAGE B.I.B.(RECIRCULATING- 3 TOWERS)	-	-	-	-	-	3/8" OUTLET	SEE RMKS	-	FLEX LINE OVERHEAD TO VARIOUS EQUIP. BSI TO MAKE FINAL CONN PER LOCAL CODES
031.03P3	1	SODA SYSTEM PACKAGE B.I.B.(RECIRCULATING- 3 TOWERS)	-	-	-	-	-	SODA BUNDLE	SEE RMKS	-	OVERHEAD TO SODA TOWER CHASE(S) - BSI TO MAKE FINAL CONNECTIONS PER LOCAL CODES
031.03P4	1	SODA SYSTEM PACKAGE B.I.B.(RECIRCULATING- 3 TOWERS)	-	-	-	3/4"	-	1'-6"	3/4" IND	BSI TO MAKE CONNECTION FROM BACKFLOW PREVENTER (VERIFY HEIGHT IN FIELD)	-
031.03P8	1	SODA SYSTEM PACKAGE B.I.B.(RECIRCULATING- 3 TOWERS)	-	-	-	-	-	REFRIG LINES	SEE RMKS	-	FROM REMOTE CONDENSING UNIT
032.02P1	1	REVERSE OSMOSIS WATER FILTRATION SYSTEM	-	-	-	-	3/8"	-	SEE RMKS	-	FLEX LINE OVERHEAD FROM SODA SYSTEM - BSI TO MAKE FINAL CONN PER LOCAL CODES
032.02P2	1	REVERSE OSMOSIS WATER FILTRATION SYSTEM	-	-	-	-	-	3/8" OUTLET	SEE RMKS	-	FLEX LINE OVERHEAD TO RAPID STEAMER, ESPRESSO, AND COFFEE (OPT.) -BSI TO MAKE FINAL CONN PER LOCAL CODES
032.02P3	1	REVERSE OSMOSIS WATER FILTRATION SYSTEM	-	-	-	-	-	1/4"	WASTE	-	-
032.04P1	1	WATER FILTRATION SYSTEM	-	-	-	-	3/4" INLET	6'-0"	-	-	DN CHASE IF NO CHASE RUN IN 2"COND TO JB -BSI TO CONNECT LINES PER LOCAL CODES
032.04P2	1	WATER FILTRATION SYSTEM	-	-	-	-	3/4" OUTLET	-	-	-	DN CHASE IF NO CHASE RUN IN 2"COND TO JB -BSI TO CONNECT LINES PER LOCAL CODES
038.00P1	1	CLEAN IN PLACE PANEL	-	-	-	1/2"	FLTR	6'-0"	-	-	FOR CLEANING BULK COKE TANKS. INSTALL HEIGHT TO BOTTOM OF UNIT


PLUMBING SCHEDULE

TITLE	2019 STANDARD BUILDING - BB20	STD ISSUE DATE	2019-11	DRAWN BY	M.J.W	REVIEWED BY	WLW	DESCRIPTION
DESCRIPTION	WOOD BEARING WALLS W/FIBER CEMENT SIDING & CI	DATE ISSUED	01-23-20	PREPARED BY:	McDonald's USA, LLC	PREPARED BY:	emmanuelson-podas consulting engineers	These drawings and specifications are the confidential and proprietary property of McDonald's USA, LLC and shall not be copied or reproduced for use on this specific site in construction with the issued drawings and are not suitable for use on a different site or at a later time. Use of these drawings for reference or example on another project requires the services of properly licensed architects and engineers. Reproduction of the contract documents for reuse on another project is not authorized.
SITE ID	015-0071	SITE ADDRESS	605 SOUTH 7TH STREET, KANSAS CITY, KS	PERMIT SET	11/13/20	PERMIT SET	11/13/20	PERMIT SET
FILE NUMBER	4597F10-WOOD/WOOD	FILE NUMBER	R0f1975	REV. DATE	12/03/20	REV. DATE	12/03/20	REV. DATE
SHEET NO.	P1.6	SHEET NO.	OVERHEAD ROUGH-IN	BY	BY	BY	BY	BY

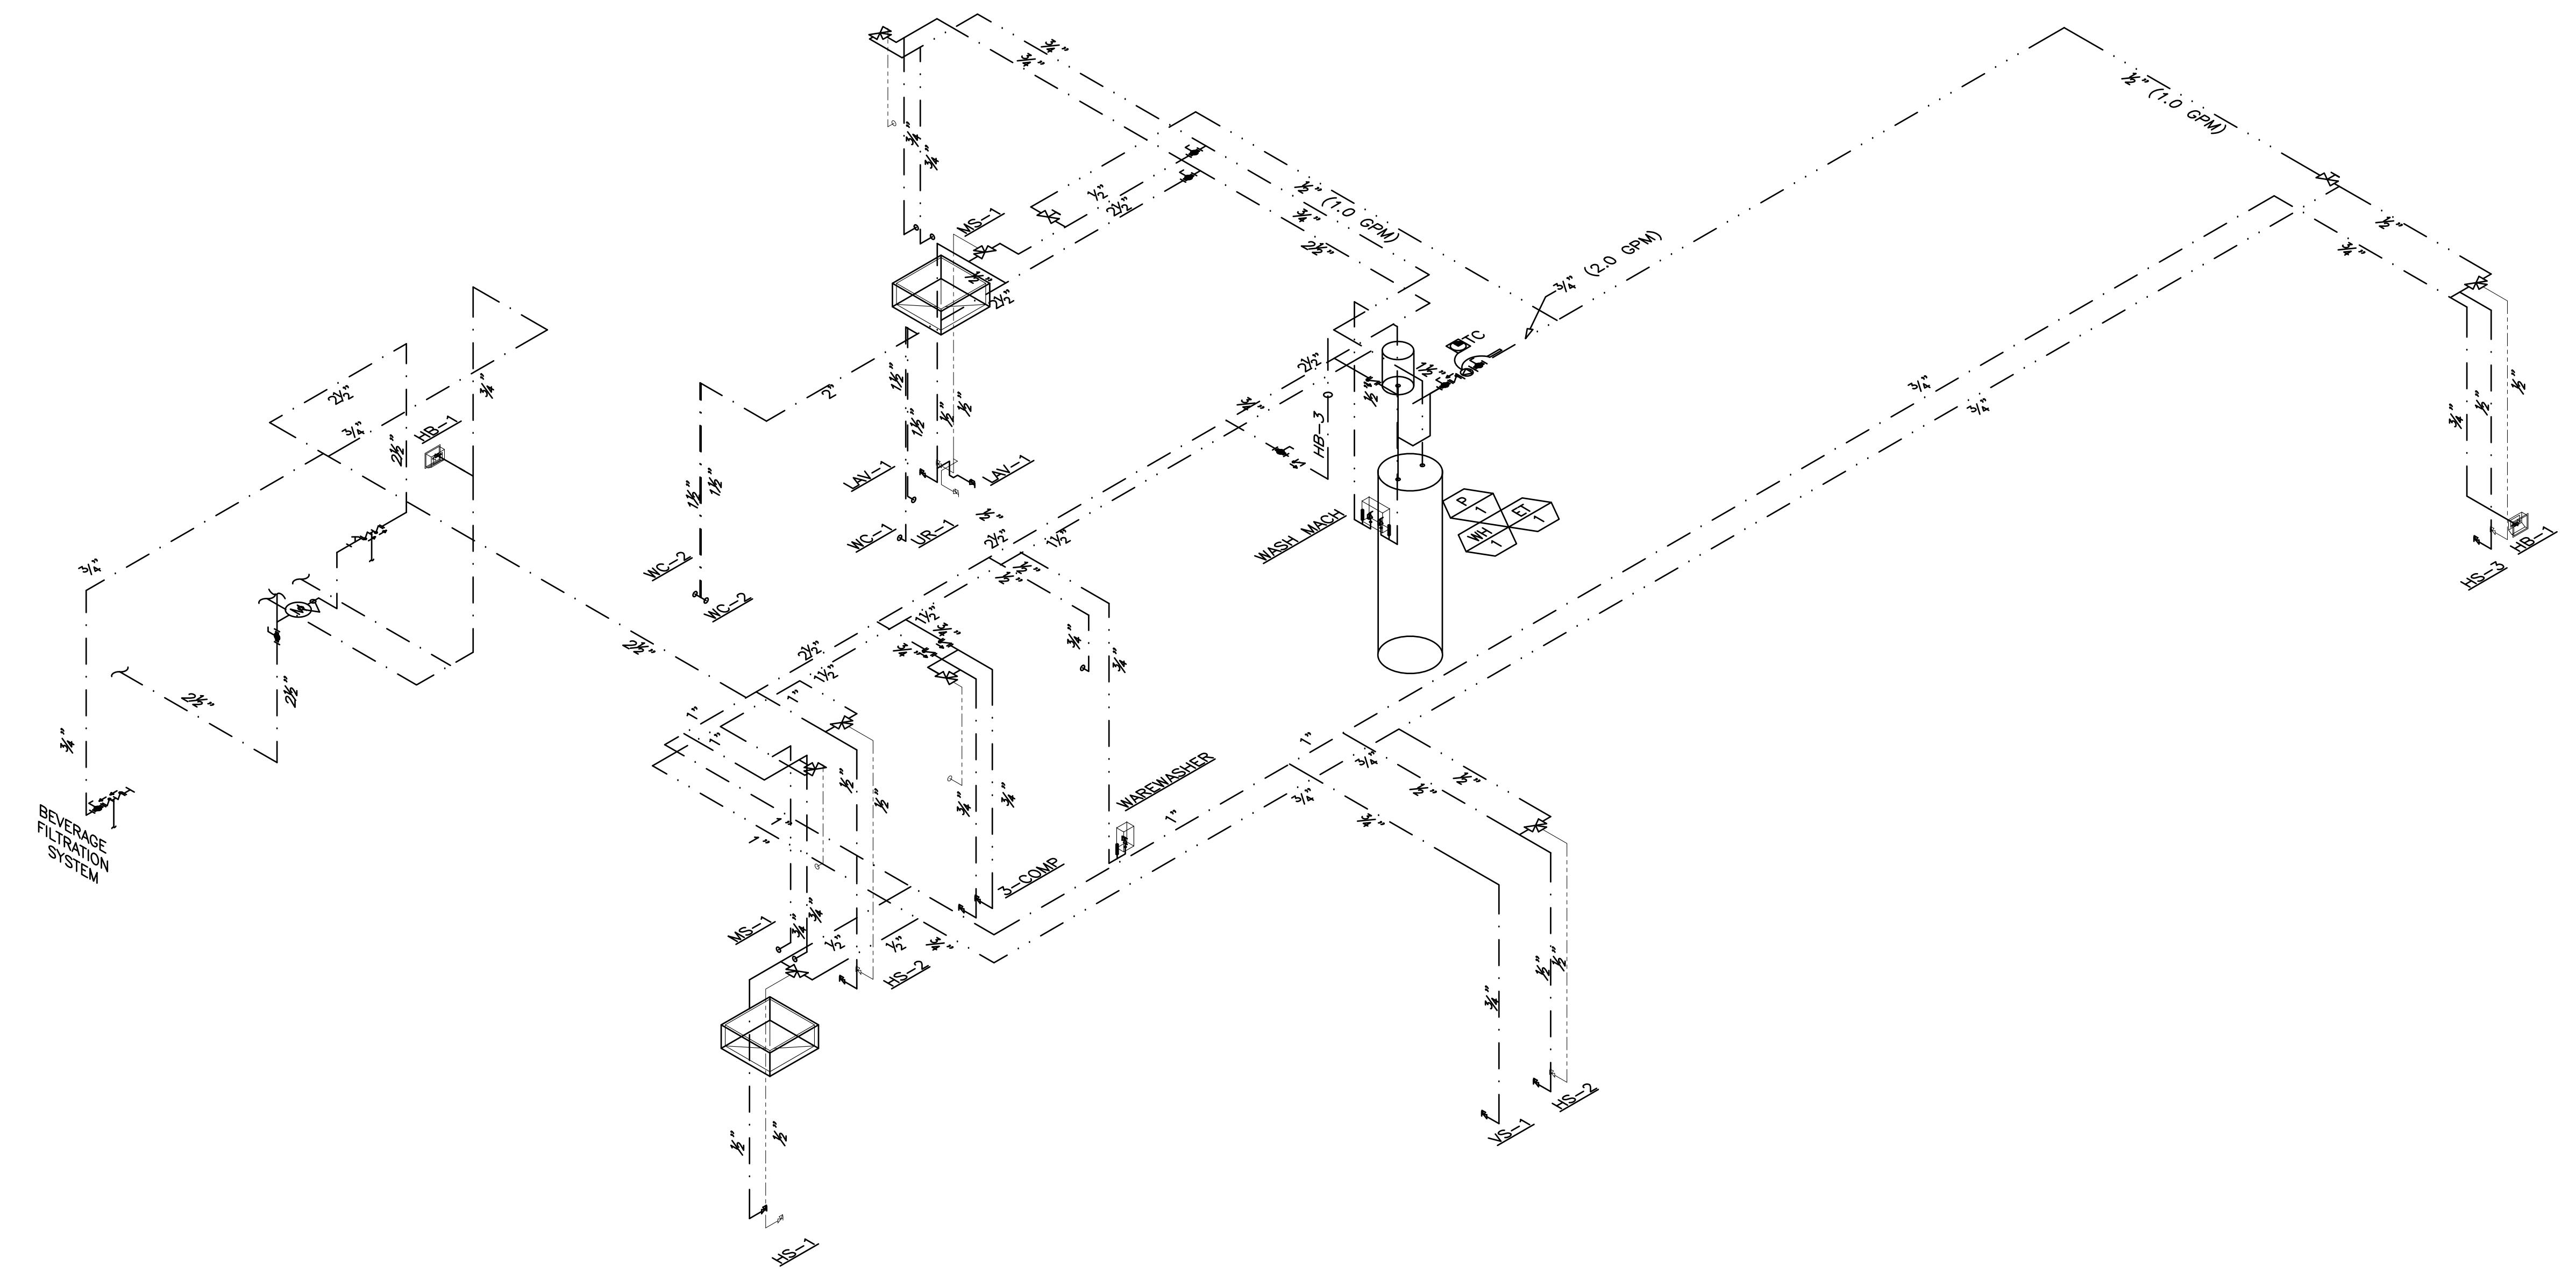

SHEET NO.	TITLE	DRAWN BY	PREPARED FOR:
015-0071.00.0	2019 STANDARD BUILDING - BB20 4597F10-WOOD/WOOD	M.J.W STD ISSUE DATE 2019-11	© 2020 McDonald's USA, LLC McDonald's USA, LLC
	DESCRIPTION WOOD BEARING WALLS W/FIBER CEMENT SIDING & CI WOOD ROOF TRUSS FRAMING FIBER CEMENT PANEL/BATTEN/ALPOLIC PANEL/BRICK EXT. FINISH	W.L.W REVIEWED BY DATE ISSUED 01-23-20	These drawings and specifications are the confidential and proprietary property of McDonald's USA, LLC and shall not be copied or reproduced for use on this specific site in conjunction with the issued date and are not suitable for use on a different site or at a later time. Use of these drawings for reference or example on another project requires the services of properly licensed architects and engineers. Reproduction of the contract documents for reuse on another project is not authorized.
015-0071	SITE ADDRESS 605 SOUTH 7TH STREET, KANSAS CITY, KS	R.D#19175	

ep emanuelson-podas
Consulting Engineers
Emmanuel-Podas, Inc.
Edina, MN 55439
(612) 990-0050 | www.epinc.com

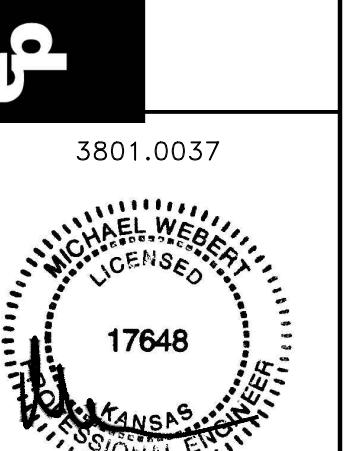

3801.0037

17648
01/23/20


KANSAS
STATE
LICENSED
PROFESSIONAL ENGINEER

01/23/20

BY

DATE

DESCRIPTION

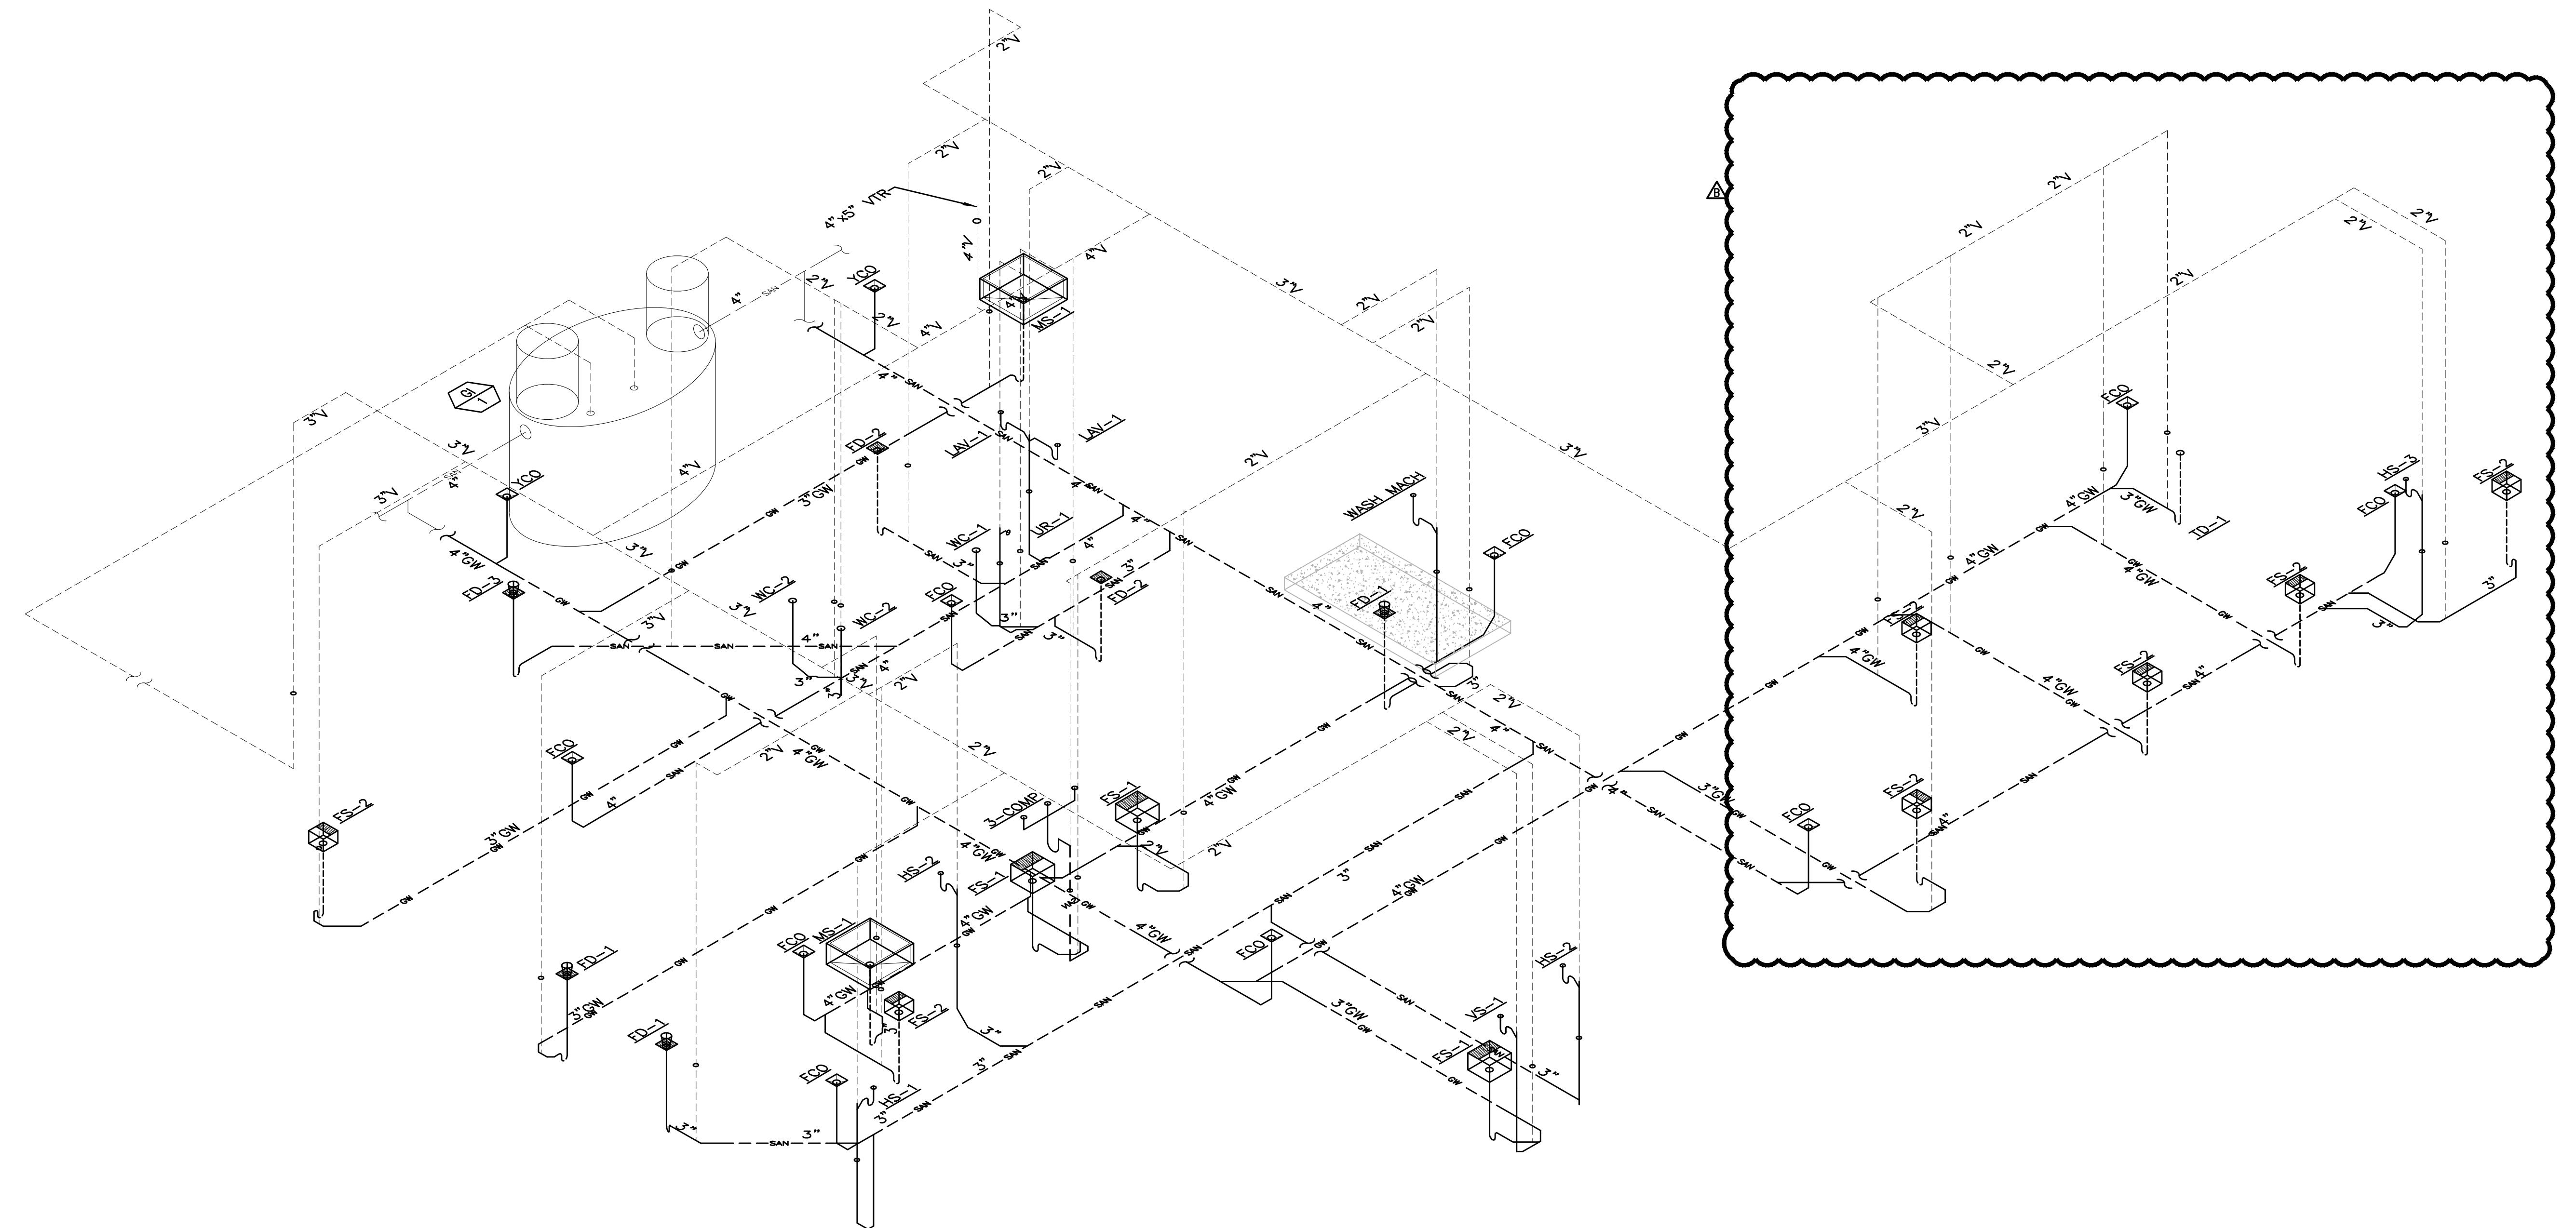

SHEET NO.	TITLE	DRAWN BY	PREPARED BY:	REVIEWED BY:	DATE ISSUED	DESCRIPTION	REV. DATE
015-0071.00.B	2019 STANDARD BUILDING - BB20 4597F10-WOOD/WOOD	M.J.W 2019-11	© 2020 McDonald's USA, LLC McDonald's USA, LLC	W.L.W	12/03/20	Waste & Vent Isometric	
	DESCRIPTION WOOD BEARING WALLS W/FIBER CEMENT SIDING & CI WOOD ROOF TRUSS FRAMING FIBER CEMENT PANEL/BATTEN/ALPOLIC PANEL/BRICK EXT. FINISH					These drawings and specifications are the confidential and proprietary property of McDonald's USA, LLC and shall not be copied or reproduced for use on any other site or at a later time. Use of these drawings for reference or example on another project requires the services of properly licensed architects and engineers. Reproduction of the contract documents for reuse on another project is not authorized.	
	SITE ID 015-0071	SITE ADDRESS 605 SOUTH 7TH STREET, KANSAS CITY, KS					
			R#19175				

△	12/03/20	SERVICE AREA OPTIMIZATION
△	11/13/20	USRD SAO SET REVIEW
△	05/05/20	CIVIL & PLAN REVIEW COMMENTS
△	01/23/20	PERMIT SET
△	01/13/20	PROGRESS SET REVIEW
REV	DATE	DESCRIPTION




3801.0037

17648

12/03/20

Michael Weber
LICENSED
KANSAS
CIVIL ENGINEER
17648

Emmanuelson-Podas, Inc.
605 South 7th Street
Edison, NJ 08810
(920) 930-0050 | www.epinc.com

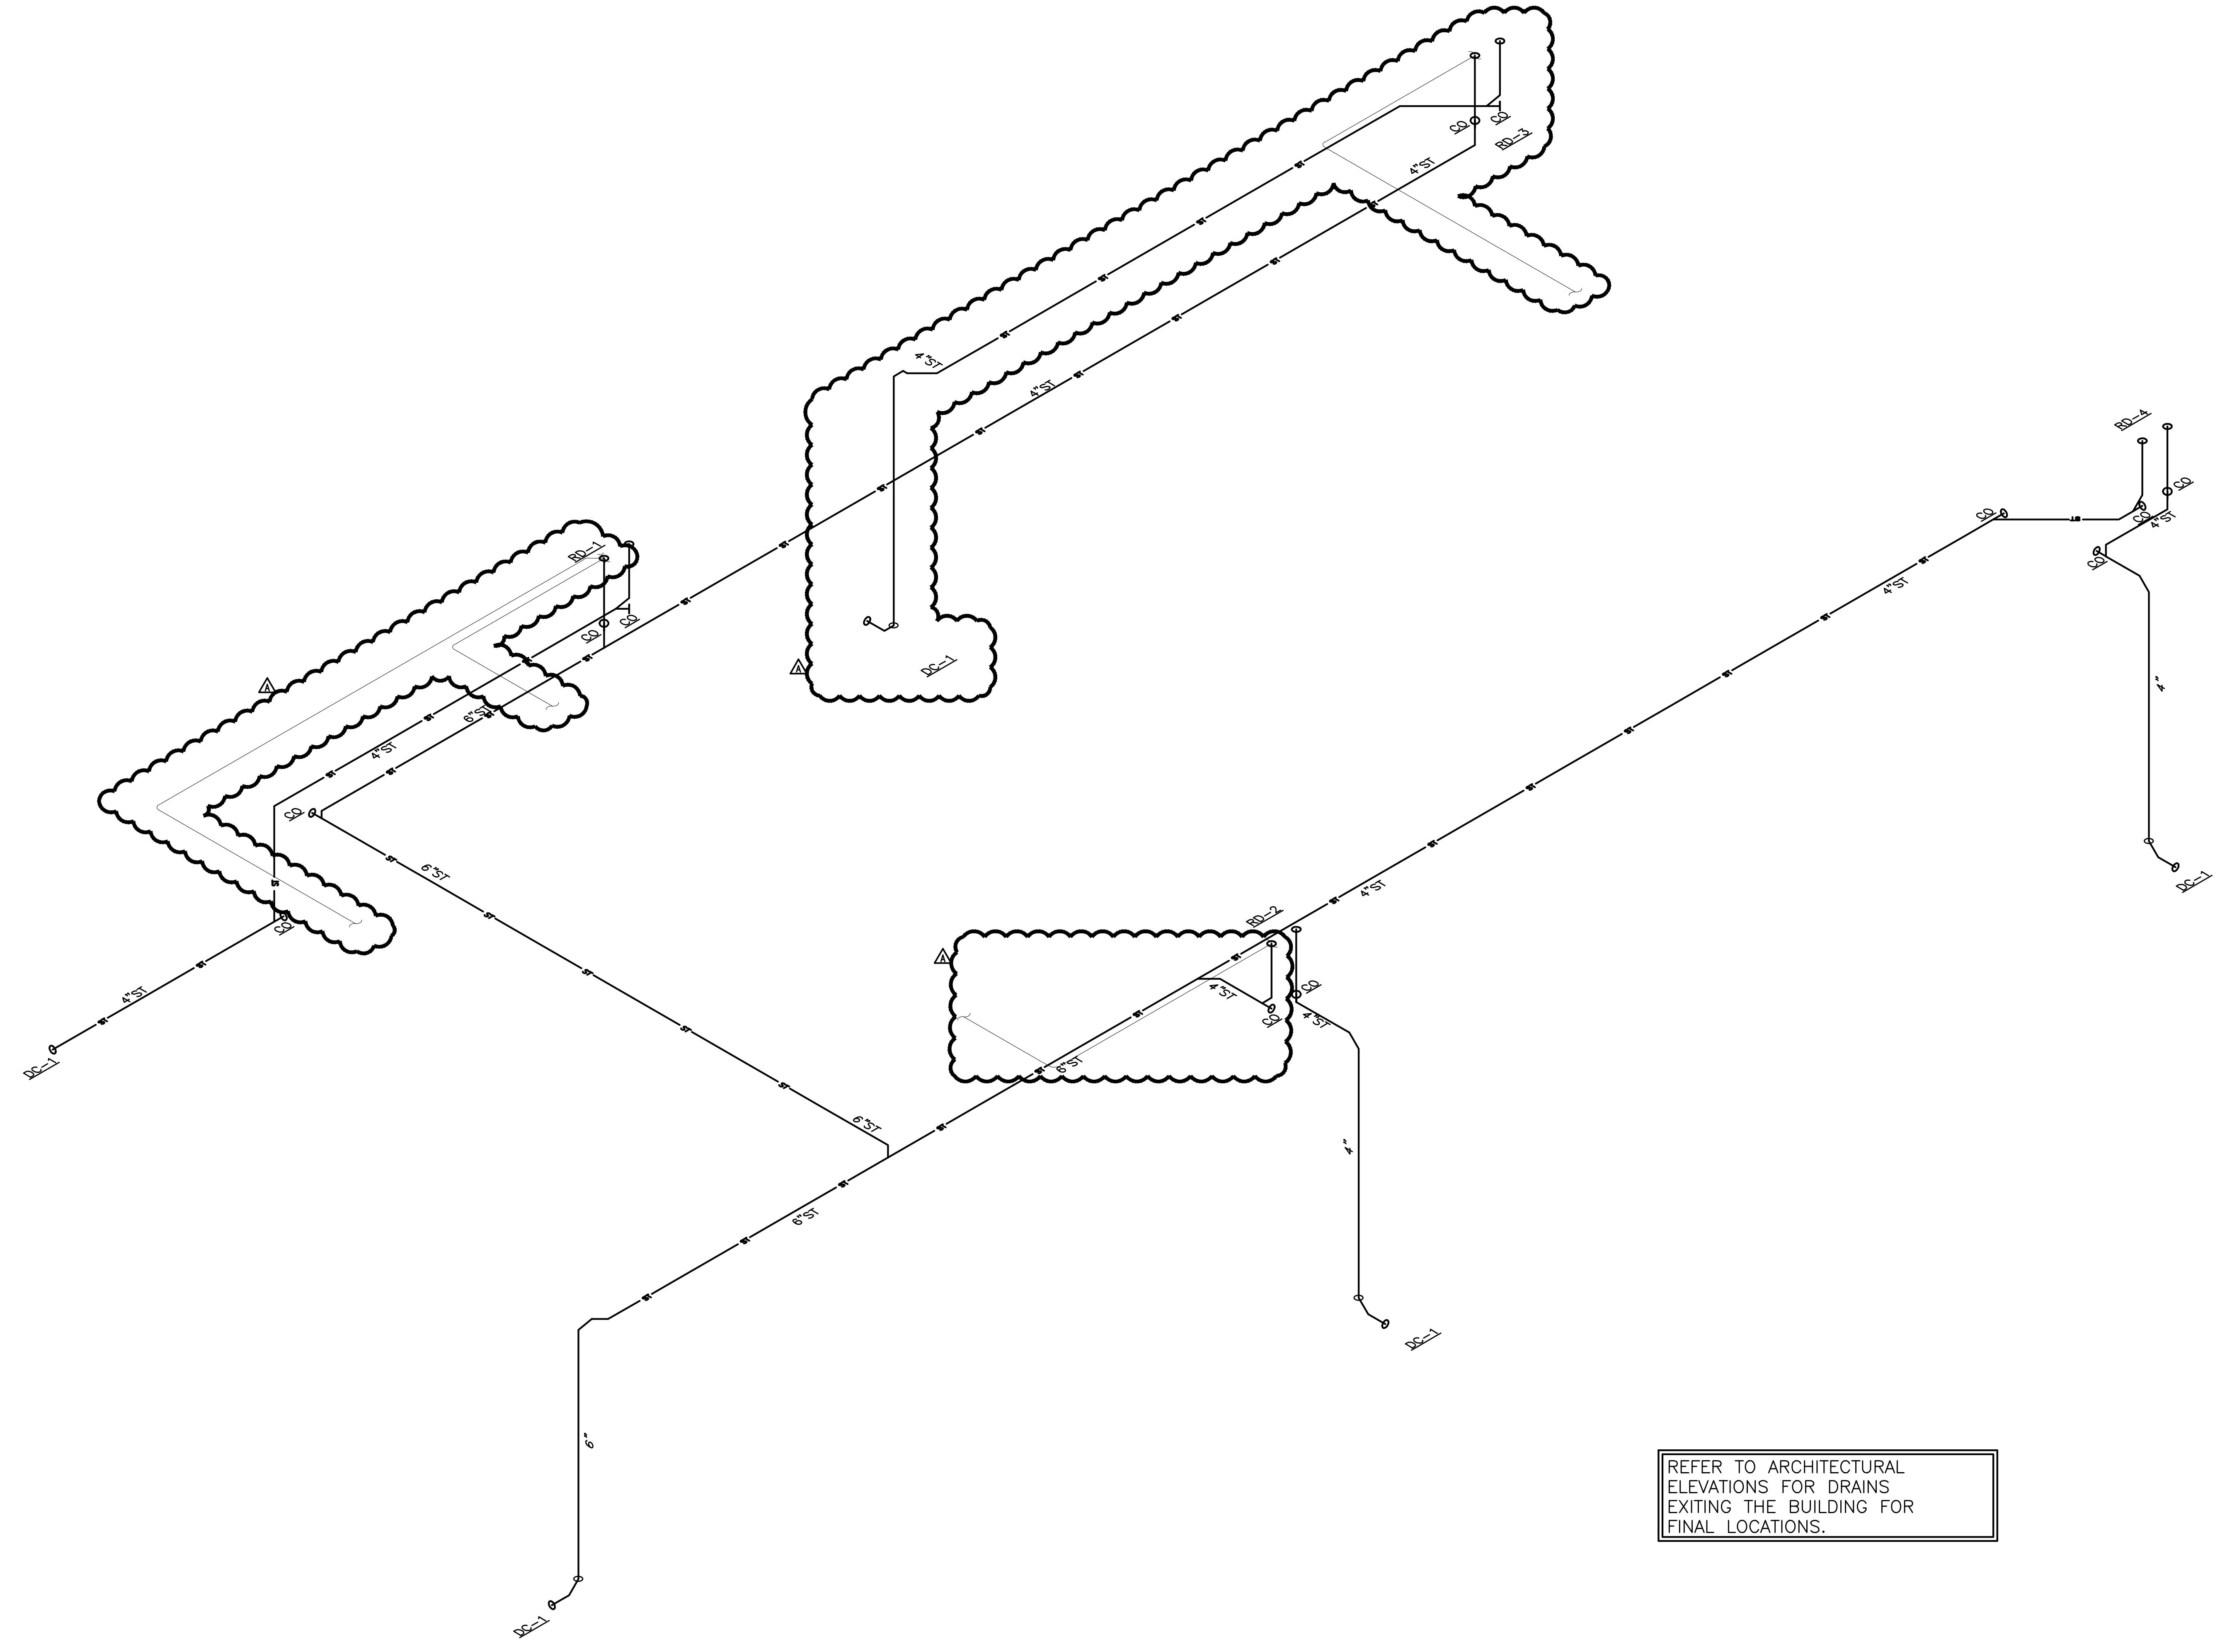


REFER TO ARCHITECTURAL
ELEVATIONS FOR DRAINS
EXITING THE BUILDING FOR
FINAL LOCATIONS.

1 STORM PIPING ISOMETRIC
P2.2 NO SCALE

2019 STANDARD BUILDING — BB20		STD ISSUE DATE 2019_11	REVIEWED BY WLW
4597F10—WOOD/WOOD		DATE ISSUED 01-23-20	
DESCRIPTION			
WOOD BEARING WALLS W/FIBER CEMENT SIDING & Ci			
WOOD ROOF TRUSS FRAMING			
FIBER CEMENT PANEL/BATTEN/ALPOLIC PANEL/BRICK EXT. FINISH			
SITE ID	SITE ADDRESS		
015-0071	605 SOUTH 7TH STREET KANSAS CITY KS		
015-0071.00.A			

The logo for McDonald's USA, LLC. It features a stylized 'M' icon composed of three horizontal bars of increasing height from left to right. To the right of the icon, the text "McDonald's USA, LLC" is written in a bold, sans-serif font. A registered trademark symbol (®) is located at the bottom right of the 'LLC' text.


emanuelson-podas		consulting engineers		
REV	DATE	DESCRIPTION		BY
▲	05/05/20	CIVIL & PLAN REVIEW	COMMENTS	WLW
	01/23/20	PERMIT SET		WLW
	01/13/20	USRD PROGRESS SET REVIEW		WLW

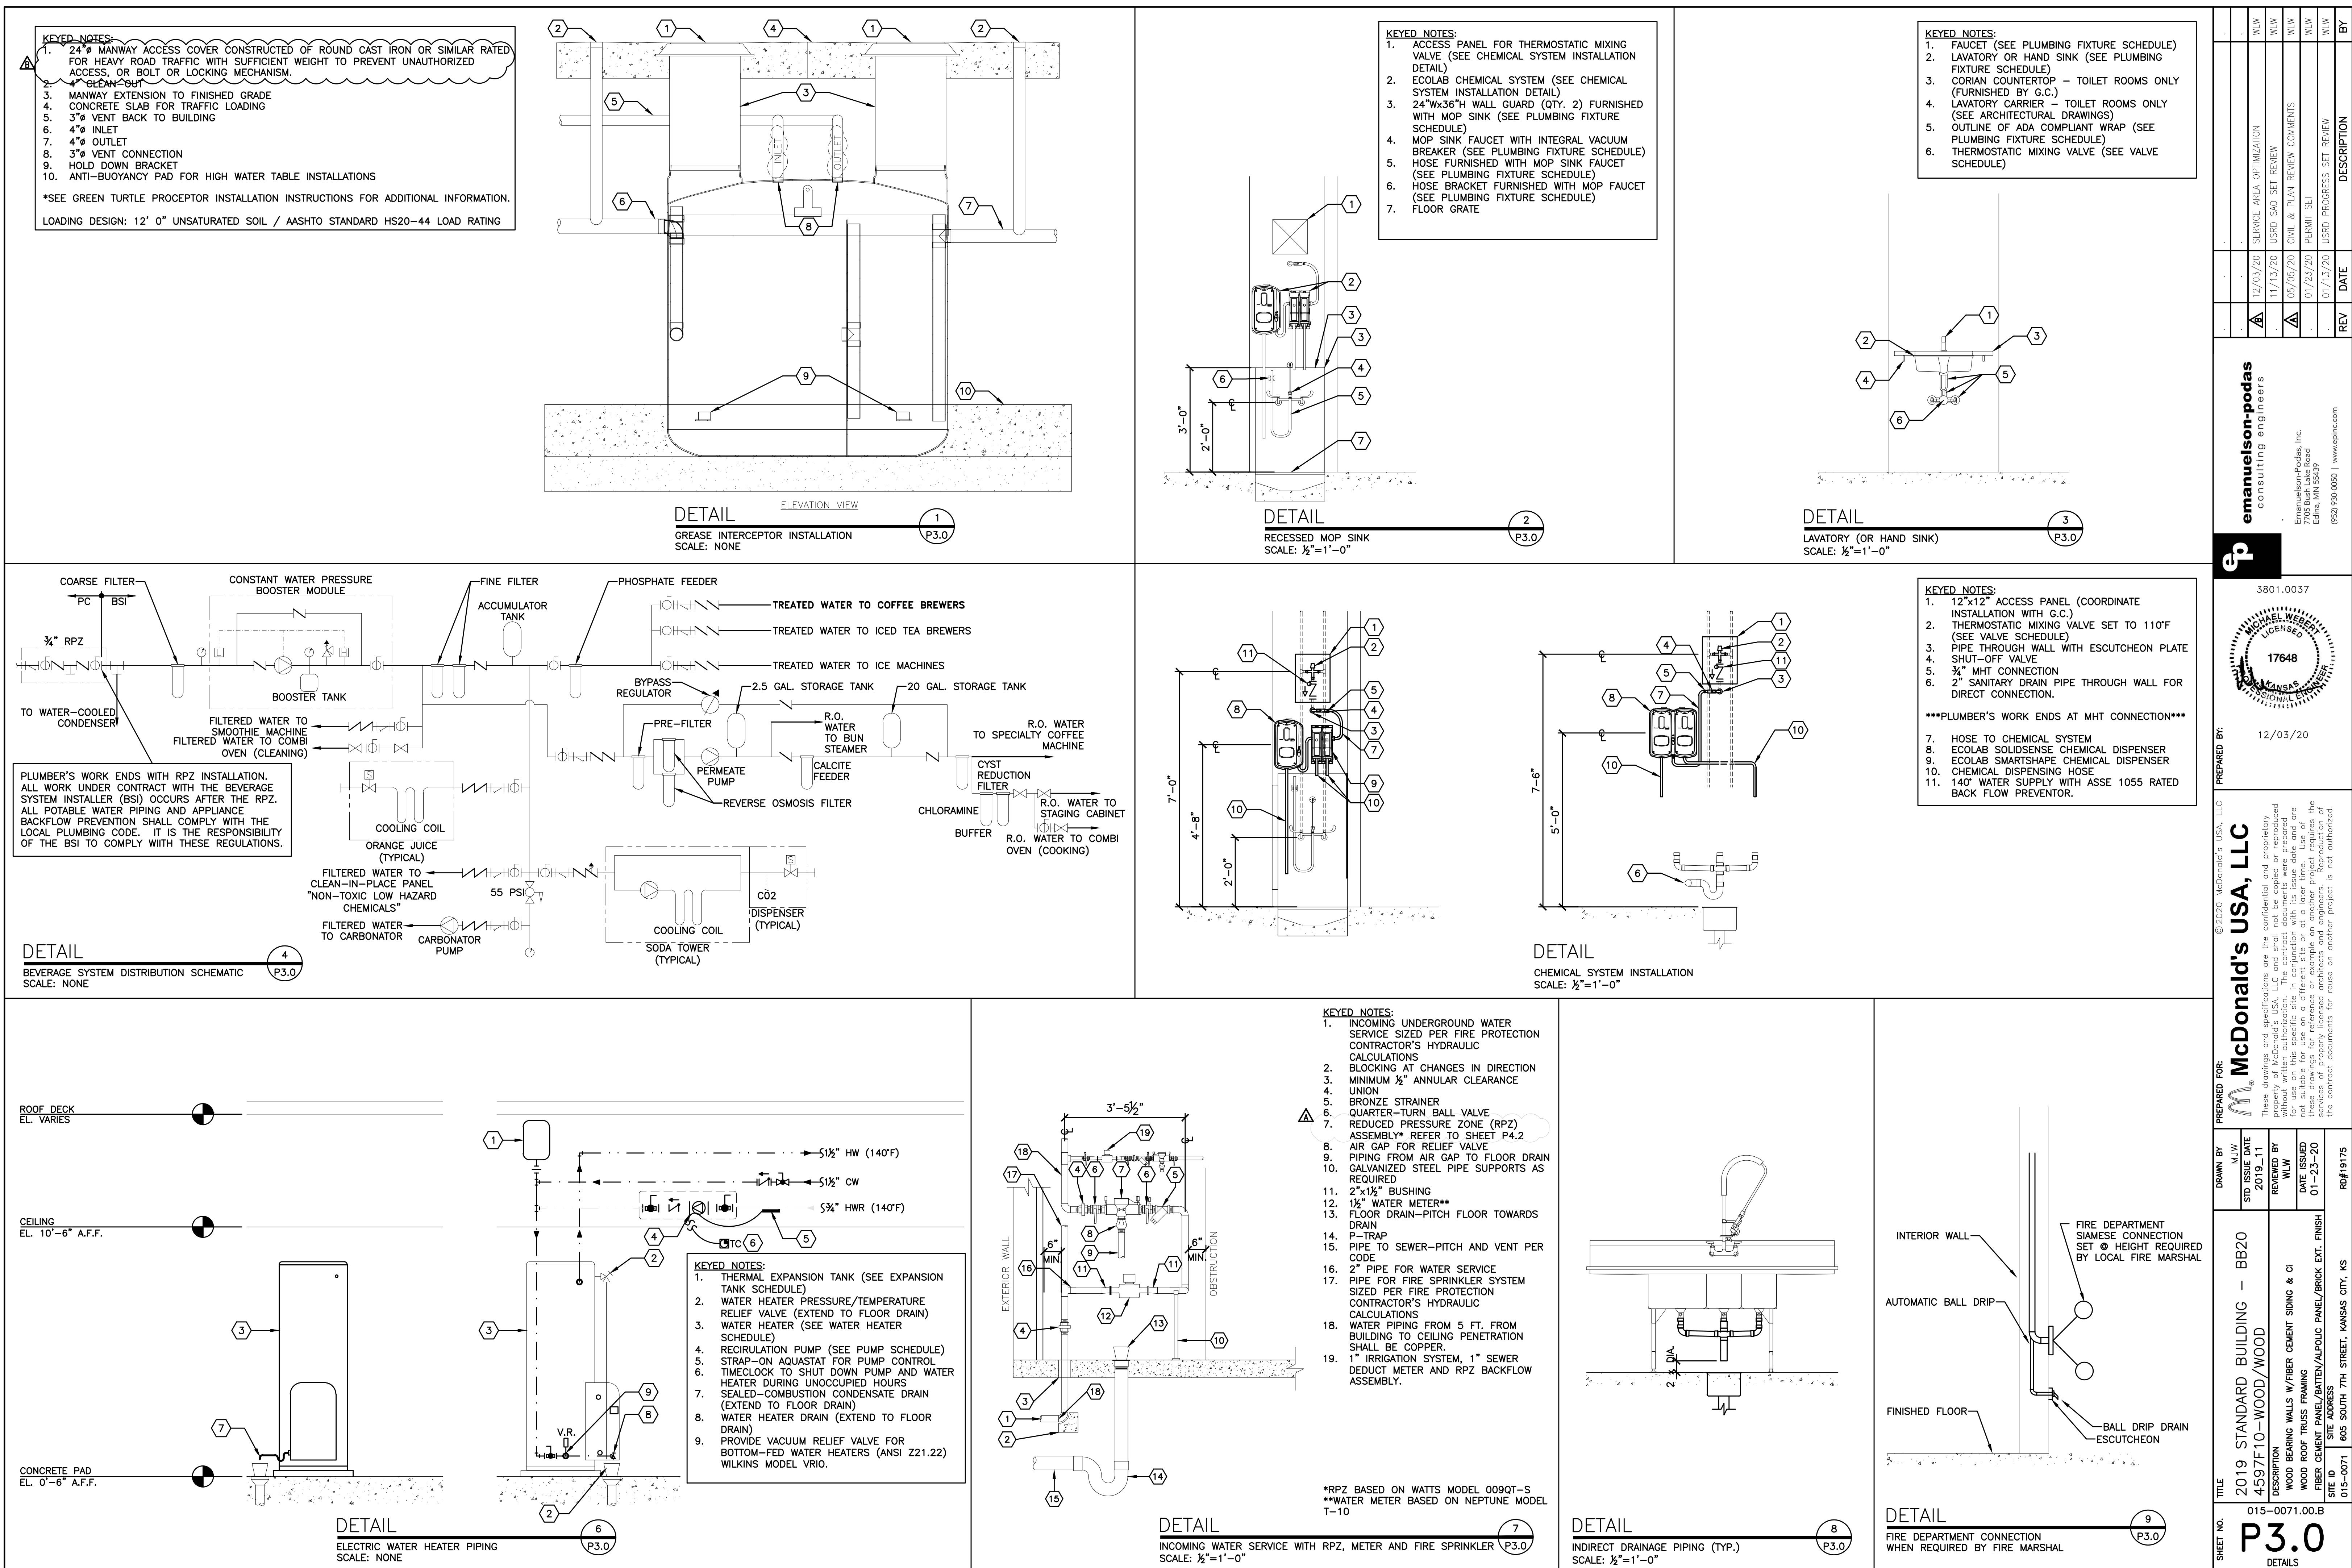

GENERAL PLUMBING NOTES		Grease Interceptor Sizing (MPC) DFU INTERCEPTOR VOLUME (GAL) 8 500 21 750 35 1000 90 1250 172 1500 216 2000 REQUIRED SIZE SIZE INSTALLED 1250 1500	LEGEND		ABBREVIATIONS																		
GENERAL:			— — — — —	COLD WATER PIPING	ACM	AREA CONSTRUCTION MANAGER																	
1. ALL WORK PERFORMED SHALL BE IN ACCORDANCE WITH ALL LOCAL CODES AND ACCEPTABLE TO THE AUTHORITY HAVING JURISDICTION.			— — — — —	TEMPERED WATER PIPING (110°F)	AVB	ATMOSPHERIC VACUUM BREAKER																	
2. ALL PLUMBING WORK SHALL BE PERFORMED BY A LICENSED PLUMBER.			— — — — —	HOT WATER PIPING (140°F)	BSI	BEVERAGE SYSTEM INSTALLER																	
3. ALL DIMENSIONS, CLEARANCES AND TOLERANCES SHALL BE VERIFIED PRIOR TO INSTALLATION. ALL ROUGH-IN LOCATIONS SHALL BE COORDINATED WITH THE MANUFACTURER'S SUBMITTAL INFORMATION.				RECIRCULATED HOT WATER PIPING	CO	CLEAN-OUT																	
4. ALL DIMENSIONAL INFORMATION IS AS FOLLOWS (UNLESS NOTED OTHERWISE): A. UNDERGROUND PIPE IS TO FOUNDATION B. OVERHEAD PIPE IS TO FINISHED WALL C. ELEVATIONS ARE TO FINISHED FLOOR				OVERHEAD LINES (BY P.C.)	DC	DOWNSPOUT COVER																	
5. ALL MATERIALS, FIXTURES AND EQUIPMENT USED SHALL BE IN ACCORDANCE WITH McDONALD'S SPECIFICATIONS. SPECIFICATIONS ARE CONTAINED WITHIN THESE DRAWINGS AND THE McDONALD'S PROJECT MANUAL. ANY CONTRACTOR IN NEED OF A COPY OF THE McDONALD'S PROJECT MANUAL SHALL CONTACT THE McDONALD'S AREA CONSTRUCTION MANAGER. ANY VARIANCE FROM THE McDONALD'S SPECIFICATIONS SHALL BE REVIEWED AND APPROVED BY THE ENGINEER-OF-RECORD.				— SAN — — — UNDERGROUND SANITARY PIPING	DFU	DRAINAGE FIXTURE UNIT(S)																	
6. SEE COORDINATION SCHEDULE FOR ADDITIONAL SCOPE OF WORK.				— GW — — — UNDERGROUND GREASE WASTE PIPING	EC	ELECTRICAL CONTRACTOR																	
7. ALL EQUIPMENT SHALL BE INSTALLED IN ACCORDANCE WITH ITS LISTING AND/OR THE MANUFACTURER'S INSTALLATION INSTRUCTIONS.				— — — — — VENT PIPING	FAC	FIRE ALARM CONTRACTOR																	
8. WHERE POOR SOIL CONDITIONS EXIST OR WHERE SUBSTANTIAL SETTLEMENT OF EITHER THE PIPING, THE BUILDING OR ADJACENT WALKS, PLANTERS, ETC., MAY OCCUR, THE CONTRACTOR SHALL PROVIDE ADEQUATE UNDERSLAB STAINLESS STEEL PIPE HANGERS OR APPROVED OTHER SUPPORT.			— ST — — — ABOVE GROUND STORM PIPING	FCO	FLOOR CLEAN-OUT																		
9. ALL PIPE SLEEVES SHALL BE PROPERLY SEALED AND INSULATED TO PREVENT HEAT LOSS AND SEEPAGE.		— — ST — — — UNDERGROUND STORM PIPING	FD	FLOOR DRAIN																			
10. ALL PIPE INSULATION SHALL BE PROTECTED FROM DAMAGE FROM PIPE HANGERS. PROTECTION SHALL BE LIGHT GAUGE GALVANIZED STEEL OR EQUAL.		⊕	HOSE BIBB	FPC	FIRE PROTECTION CONTRACTOR																		
11. ALL PENETRATIONS OF FIRE-RATED WALLS SHALL BE FIRESTOPPED WITH AN APPROVED AND LISTED FIRESTOPPING SYSTEM.		Z → OR Z ←	CHECK VALVE	FS	FLOOR SINK																		
SANITARY AND VENT SYSTEMS:		⊕	BALL VALVE	GC	GENERAL CONTRACTOR																		
1. THE BUILDING SANITARY PIPE SHALL BE LOCATED A MINIMUM OF 5 FT. FROM THE INCOMING WATER SERVICE, WHERE A 5 FT. SEPARATION IS NOT POSSIBLE, THE BOTTOM OF THE WATER SERVICE PIPE SHALL BE A MINIMUM OF 12 IN. ABOVE THE TOP OF THE HIGHEST POINT OF THE SANITARY PIPE.		⊗	THERMOSTATIC MIXING VALVE	GI	GREASE INTERCEPTOR																		
2. ALL SANITARY AND VENT PIPE SHALL BE PVC TYPE DWV, ABS OR PROTECTO 401 LINED CAST-IRON WHERE REQUIRED BY CODE.		□	FLOOR DRAIN	GPF	GALLONS PER FLUSH																		
3. ALL HORIZONTAL SANITARY PIPE SHALL BE INSTALLED WITH A MINIMUM PITCH OF $\frac{1}{4}$ " PER FOOT, OR IF THE (AHU) ALLOWS AS FOLLOWS:		□	CLEAN-OUT (FLOOR OR YARD)	GPM	GALLONS PER MINUTE																		
<table border="1"> <thead> <tr> <th>PIPE SIZE</th> <th>MIN. SLOPE</th> </tr> </thead> <tbody> <tr> <td>2$\frac{1}{2}$" OR LESS</td> <td>$\frac{1}{8}$" PER FT.</td> </tr> <tr> <td>3" TO 6"</td> <td>$\frac{1}{6}$" PER FT.</td> </tr> <tr> <td>8" OR LARGER</td> <td>$\frac{1}{16}$" PER FT.</td> </tr> </tbody> </table>		PIPE SIZE	MIN. SLOPE	2 $\frac{1}{2}$ " OR LESS	$\frac{1}{8}$ " PER FT.	3" TO 6"	$\frac{1}{6}$ " PER FT.	8" OR LARGER	$\frac{1}{16}$ " PER FT.	□	FLOOR SINK	GW	GREASE WASTE										
PIPE SIZE	MIN. SLOPE																						
2 $\frac{1}{2}$ " OR LESS	$\frac{1}{8}$ " PER FT.																						
3" TO 6"	$\frac{1}{6}$ " PER FT.																						
8" OR LARGER	$\frac{1}{16}$ " PER FT.																						
4. CLEANOUTS SHALL BE INSTALLED IN ALL HORIZONTAL DRAINAGE PIPE AND SHALL BE LOCATED NOT MORE THAN 100 FT. APART.		○	PRESSURE GUAGE	HS	HAND SINK																		
5. CLEANOUTS SHALL BE INSTALLED AT ALL CHANGES OF DIRECTION GREATER THAN 45 DEGREES. WHERE MORE THAN ONE CHANGE OF DIRECTION OCCURS IN A SINGLE PIPE RUN, ONLY ONE (1) CLEANOUT SHALL BE REQUIRED FOR EVERY 40 FEET OF DEVELOPED LENGTH.		□	LOW PRESSURE SWITCH	I.P.S.	IRON PIPE SIZE (ALSO NPS)																		
6. CLEANOUTS SHALL BE INSTALLED ON PIPES PRIOR TO ANY SLAB PENETRATION.		□	HIGH PRESSURE SWITCH	KEI	KITCHEN EQUIPMENT INSTALLER																		
7. WHERE PIPING IS LOCATED WITHIN WALL CAVITIES, ACCESS TO THE CLEANOUTS SHALL BE PROVIDED.		⊗	SOLENOID VALVE	KES	KITCHEN EQUIPMENT SUPPLIER																		
8. CLEANOUTS ON 6-IN. AND SMALLER PIPES SHALL BE PROVIDED WITH A CLEARANCE OF NOT LESS THAN 18 IN. CLEANOUTS ON 8-IN. AND LARGER PIPE SHALL BE PROVIDED WITH A CLEARANCE OF NOT LESS THAN 36 IN.		⊗	THREE-WAY VALVE	LAV	LAVATORY																		
9. ALL SUSPENDED SANITARY AND VENT PIPE SHALL BE SUPPORTED AS FOLLOWS:		○	PRESSURE REGULATOR	MC	MECHANICAL CONTRACTOR																		
<table border="1"> <thead> <tr> <th>MATERIAL</th> <th>MAX. HORIZ. SPACING</th> <th>MAX. VERT. SPACING</th> </tr> </thead> <tbody> <tr> <td>COPPER PIPE</td> <td>12 FT.</td> <td>10 FT.</td> </tr> <tr> <td>COPPER TUBING $\leq \frac{1}{2}$"</td> <td>6 FT.</td> <td>10 FT.</td> </tr> <tr> <td>COPPER TUBING $> \frac{1}{2}$"</td> <td>10 FT.</td> <td>10 FT.</td> </tr> <tr> <td>CPVC $\leq 1"$</td> <td>3 FT.</td> <td>10 FT.</td> </tr> <tr> <td>CPVC $\geq 1\frac{1}{2}"$</td> <td>4 FT.</td> <td>10 FT.</td> </tr> </tbody> </table>		MATERIAL	MAX. HORIZ. SPACING	MAX. VERT. SPACING	COPPER PIPE	12 FT.	10 FT.	COPPER TUBING $\leq \frac{1}{2}$ "	6 FT.	10 FT.	COPPER TUBING $> \frac{1}{2}$ "	10 FT.	10 FT.	CPVC $\leq 1"$	3 FT.	10 FT.	CPVC $\geq 1\frac{1}{2}"$	4 FT.	10 FT.	○	DUAL CHECK VALVE OR RPZ	MHT	MALE HOSE THREADS
MATERIAL	MAX. HORIZ. SPACING	MAX. VERT. SPACING																					
COPPER PIPE	12 FT.	10 FT.																					
COPPER TUBING $\leq \frac{1}{2}$ "	6 FT.	10 FT.																					
COPPER TUBING $> \frac{1}{2}$ "	10 FT.	10 FT.																					
CPVC $\leq 1"$	3 FT.	10 FT.																					
CPVC $\geq 1\frac{1}{2}"$	4 FT.	10 FT.																					
10. ALL PLUMBING FIXTURES SHALL BE VENTED AND THE MAXIMUM DISTANCE FROM THE FIXTURE TRAP TO THE VENT SHALL BE AS FOLLOWS:		○	DUAL CHECK VALVE WITH ATMOSPHERIC VENT	MS	MOP SINK																		
<table border="1"> <thead> <tr> <th>TRAP SIZE</th> <th>SLOPE</th> <th>DISTANCE</th> </tr> </thead> <tbody> <tr> <td>1$\frac{1}{2}$"</td> <td>$\frac{1}{8}$" PER FT.</td> <td>2'-6"</td> </tr> <tr> <td>2$\frac{1}{2}$"</td> <td>$\frac{1}{8}$" PER FT.</td> <td>3'-6"</td> </tr> <tr> <td>3"</td> <td>$\frac{1}{8}$" PER FT.</td> <td>5'-0"</td> </tr> <tr> <td>4" & LARGER</td> <td>$\frac{1}{8}$" PER FT.</td> <td>6'-0"</td> </tr> <tr> <td></td> <td></td> <td>10'-0"</td> </tr> </tbody> </table>		TRAP SIZE	SLOPE	DISTANCE	1 $\frac{1}{2}$ "	$\frac{1}{8}$ " PER FT.	2'-6"	2 $\frac{1}{2}$ "	$\frac{1}{8}$ " PER FT.	3'-6"	3"	$\frac{1}{8}$ " PER FT.	5'-0"	4" & LARGER	$\frac{1}{8}$ " PER FT.	6'-0"			10'-0"	○	STRAINER	NPS	NATIONAL PIPE THREAD STANDARD
TRAP SIZE	SLOPE	DISTANCE																					
1 $\frac{1}{2}$ "	$\frac{1}{8}$ " PER FT.	2'-6"																					
2 $\frac{1}{2}$ "	$\frac{1}{8}$ " PER FT.	3'-6"																					
3"	$\frac{1}{8}$ " PER FT.	5'-0"																					
4" & LARGER	$\frac{1}{8}$ " PER FT.	6'-0"																					
		10'-0"																					
11. ALL PLUMBING VENTS THROUGH THE ROOF SHALL TERMINATE A MINIMUM OF 12 INCHES ABOVE THE ROOF, AND SHALL BE LOCATED A MINIMUM OF 8 FT. FROM ANY PARAPET WALL. WHERE A VENT TERMINATES WITHIN 8 FT. OF A PARAPET WALL, THE VENT SHALL TERMINATE A MINIMUM OF 6 INCHES ABOVE THE PARAPET.		○	RELIEF VENT	NPT	NATIONAL PIPE THREAD TAPERED																		
12. ALL PLUMBING VENTS SHALL TERMINATE A MINIMUM OF 10 FT. HORIZONTALLY FROM ANY OUTDOOR AIR INTAKE. WHERE A PLUMBING VENT IS LOCATED WITHIN 10 FT. OF AN INTAKE, THE VENT SHALL TERMINATE A MINIMUM OF 3 FT. ABOVE THE INTAKE.		○	FULL-PORT BALL VALVE	O/O	OWNER/OPERATOR																		
13. ALL SIDE WALL VENT TERMINATIONS SHALL BE PROTECTED TO PREVENT BIRDS OR RODENTS FROM ENTERING OR BLOCKING THE VENT OPENING.		○	PUMP	OH	OVERHEAD																		
14. ALL FLOOR DRAINS THAT DO NOT SERVE EQUIPMENT SHALL BE PROTECTED AGAINST DRYING OUT EITHER THROUGH THE INSTALLATION OF A TRAP PRIMER, DEEP SEAL TRAP OR PROSTET TRAP GUARD. TRAP GUARD NOT ALLOWED IN KITCHEN AREA		○	BACK FLOW PREVENTER	P	PUMP																		
15. ALL APPLIANCES SHALL DRAIN TO AN APPROVED SANITARY WASTE RECEPTOR (FLOOR SINK OR FLOOR DRAIN WITH FUNNEL). INDIRECT DRAINAGE FROM AN APPLIANCE SHALL MAINTAIN AN AIR GAP BETWEEN THE PIPE OUTLET AND THE TOP OF THE RECEPTOR. THE MINIMUM DISTANCE BETWEEN THE PIPE OUTLET AND THE TOP OF THE RECEPTOR SHALL BE TWICE THE DIAMETER OF THE APPLIANCE DRAIN PIPE.		○	PLUMBING CONTRACTOR	PC	PLUMBING CONTRACTOR																		
16. THE PVC PLASTIC PIPING TO BE INSTALLED MUST COMPLY WITH ONE OF THE FOLLOWING ASTM STANDARDS: D2665, OR F891. THE INSTALLATION MUST COMPLY WITH ASTM STANDARD D2321		○	REFRIGERATION CONTRACTOR	RC	REFRIGERATION CONTRACTOR																		
17. ALL PLASTIC PIPE USED FOR DRAIN, WASTE, AND VENT SYSTEM (ABS, PVC) SHALL COMPLY WITH ASTM D2661 OR F268 (ABS) AND D2665, D2649 OR F891 (PVC). ABOVE GRADE HORIZONTAL RUNS OF PLASTIC WASTE AND VENT PIPE CAN NOT EXCEED 35 FEET IN TOTAL LENGTH, AND ABOVE GRADE VERTICAL STACKS CONSTRUCTED OF PLASTIC PIPE MAY EXCEED 35 FEET IN TOTAL HEIGHT ONLY IF AN APPROVED EXPANSION JOINT IS USED. SOLVENT WELD JOINTS IN PVC AND CPVC PIPE MUST INCLUDE USE OF PRIMER WHICH IS OF CONTRASTING COLOR TO THE PIPE AND CEMENT.		○	REDUCED PRESSURE PRINCIPLE BACKFLOW PREVENTER	RPZ	REDUCED PRESSURE PRINCIPLE BACKFLOW PREVENTER																		
18. CAST IRON PIPE USED FOR ABOVE GROUND WASTE SYSTEMS MUST MEET ANSI STANDARD A21.2, A21.6, A21.8, A40.5, OR ASTM STANDARD A-74.		○	SANITARY SEWER	SAN	SANITARY SEWER																		
		○	STORM SEWER	ST	STORM SEWER																		
		○	ANTI-SIPHON, SPILL RESISTANT VACUUM BREAKER	SVB	ANTI-SIPHON, SPILL RESISTANT VACUUM BREAKER																		
		○	TEST AND BALANCE CONTRACTOR	TAB	TEST AND BALANCE CONTRACTOR																		
		○	UNDERGROUND	UG	UNDERGROUND																		
		○	URINAL	UR	URINAL																		
		○	VENT	V	VENT																		
		○	WATER CLOSET	WC	WATER CLOSET																		
		○	WALL CLEAN-OUT	WCO	WALL CLEAN-OUT																		
		○	WATER SUPPLY FIXTURE UNIT(S)	WSFU	WATER SUPPLY FIXTURE UNIT(S)																		
		○	YARD CLEAN-OUT	YCO	YARD CLEAN-OUT																		

emmanuelson-podas
consulting engineers

Emmanuelson-Podas, Inc.
Edison, NJ 07003 | (973) 939-0050 | www.eppinc.com

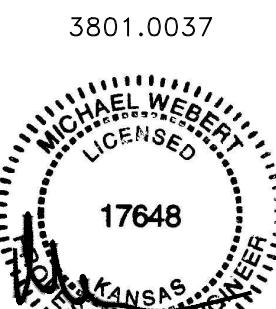

01/23/20

© 2020 McDonald's USA, LLC
McDonald's USA, LLC

These drawings and specifications are the confidential and proprietary property of McDonald's USA, LLC, and shall not be copied or reproduced for use on other projects or in other locations, or in conjunction with its issuance, or for use on this specific project in a different site or at a later time. Use of these drawings for reference or example on another project requires the services of properly licensed architects and engineers. Reproduction of these drawings and specifications for reuse on another project is not authorized.

PREPARED FOR:
m McDonald's USA, LLC
DRAWN BY: MJW
STD ISSUE DATE: 2019-11
REVIEWED BY: WLW
DATE ISSUED: 01-23-20
TITLE: 2019 STANDARD BUILDING - BB20
DESCRIPTION: 4597F10-WOOD/WOOD
WOOD BEARING WALLS W/FIBER CEMENT SIDING & CI
WOOD ROOF TRUSS FRAMING
FIBER CEMENT PANEL/BATTEN/ALPOLIC PANEL/BRICK EXT. FINISH
SITE ADDRESS: 605 SOUTH 1H STREET, KANSAS CITY, KS
SITE ID: 015-0071
RD#19175
SHEET NO. P4.0
GENERAL NOTES

ROOFTOP EQUIPMENT SCHEDULE				
ITEM	DESCRIPTION	QUANTITY	NOTES	REVISIONS
1	ROOFTOP UNIT	1	1. ROOFTOP UNIT EQUIPMENT SUPPLIED BY THE MECHANICAL CONTRACTOR 2. KITCHEN EQUIPMENT SUPPLIER SHALL BE ON SITE AT THE SAME TIME AS THE ROOFTOP UNIT. 3. EQUIPMENT SITE ARRIVAL DATE SHALL BE COORDINATED BETWEEN THE CONSTRUCTION MANAGER, MECHANICAL CONTRACTOR AND KITCHEN EQUIPMENT SUPPLIER.	A
2	WATER HEATER	1	1. WATER HEATERS INSTALLED IN McDONALD'S RESTAURANTS SHALL BE HIGH EFFICIENCY SEALED-COMBUSTION WATER HEATERS. THE INSTALLATION OF STANDARD EFFICIENCY GRAVITY-VENTED WATER HEATERS IS PROHIBITED.	B
3	PLUMBING	1	1. PLUMBING WORK SHOWN ON P1.6 DRAWING(S) SHALL BE COMPLETED BY THE PLUMBING SYSTEM INSTALLER (OR K.E.S.) UNLESS OTHERWISE NOTED IN THE DRAWINGS.	C
4	WATER LINE	1	1. PLUMBING WORK ON P1.0 & P1.2 DRAWING(S) SHALL BE BY THE PLUMBING CONTRACTOR.	D
5	COOKING EQUIPMENT	1	1. PLUMBING SYSTEM INSTALLER FURNISHES, RUNS AND CONNECTS ALL WATER AND SYRUP LINES FOR ALL AFFECTED EQUIPMENT INCLUDING THE FOLLOWING: - CHOCOLATE - COFFEE BREWER - MACHINE - DA TOWERS	E
6	WATER HEATERS	1	1. WATER HEATERS INSTALLED IN McDONALD'S RESTAURANTS SHALL BE HIGH EFFICIENCY SEALED-COMBUSTION WATER HEATERS. THE INSTALLATION OF STANDARD EFFICIENCY GRAVITY-VENTED WATER HEATERS IS PROHIBITED.	F
7	DISHWASHER	1	1. CONSTRUCTION MANAGER, PLUMBING CONTRACTOR AND KITCHEN EQUIPMENT SUPPLIER SHALL COORDINATE WHICH SOILED DISHWASHER (PARTMENT SINK) IS BEING INSTALLED IN THE RESTAURANT.	G
8	COOKING EQUIPMENT	1	1. GAS PIPING FOR COOKING EQUIPMENT SHALL TERMINATE IN THE CEILING CHASE TO THE INSTALLATION OF THE PIPING CHASE. UPON INSTALLATION OF CHASE, THE GAS PIPING SHALL THEN BE CONTINUED IN THE CHASE FOR CONNECTION TO THE APPLIANCE.	H
9	ROOFTOP EQUIPMENT	1	1. GAS PIPING FOR ROOFTOP EQUIPMENT SHALL BE BROUGHT UP THROUGH THE USE OF THE UNIT TO MINIMIZE ROOF PENETRATIONS. WHERE THIS IS POSSIBLE, THE PLUMBING CONTRACTOR SHALL PROVIDE THE NECESSARY PORTALS ON ROOF.	I
10	STRUCTURE	1	1. FIRE PROTECTION DRAWINGS CONTAINED WITHIN THIS SET ARE STRICTLY FOR INFORMATION ONLY. FIRE SPRINKLER DRAWINGS SHALL BE DESIGNED AND PROVIDED BY A FIRE PROTECTION CONTRACTOR.	J
11	WET CHEMICAL FIRE SUPPRESSION SYSTEM	1	1. NO WET CHEMICAL FIRE SUPPRESSION SYSTEMS FOR TYPE I HOODS SHALL BE DESIGNED AND INSTALLED BY A LOCAL ANSUL AGENT. THE USE OF WET CHEMICAL SYSTEMS IS PROHIBITED. THE LOCAL ANSUL AGENT CONTRACT IS HANDLED THROUGH THE KITCHEN EQUIPMENT SUPPLIER.	K
12	EXHAUST FANS	1	1. ROOFTOP UNITS AND EXHAUST FANS ARE SUPPLIED WITH A PRE-INSTALLED DISCONNECT SWITCH.	L
13	PLUMBING CONTRACTOR	1	1. PLUMBING CONTRACTOR SHALL PROVIDE DISCONNECT SWITCHES FOR REMOTE MOUNTING UNITS.	M
14	ELECTRICAL CONTRACTOR	1	1. ELECTRICAL CONDUITS FOR ROOFTOP EQUIPMENT SHALL BE BROUGHT UP FROM THE BASE OF THE UNIT TO MINIMIZE ROOF PENETRATIONS. WHERE NOT POSSIBLE, THE ELECTRICAL CONTRACTOR SHALL PROVIDE THE NECESSARY PIPE PORTALS ON ROOF.	N
15	ARCHITECTURAL CONTRACTOR	1	1. ARCHITECTURAL DRAWINGS FOR ADDITIONAL INFORMATION.	O
16	STRUCTURAL CONTRACTOR	1	1. STRUCTURAL DRAWINGS FOR ADDITIONAL INFORMATION.	P
17	MECHANICAL CONTRACTOR	1	1. MECHANICAL DRAWINGS FOR ADDITIONAL INFORMATION.	Q
18	PLUMBING CONTRACTOR	1	1. PLUMBING DRAWINGS FOR ADDITIONAL INFORMATION.	R
19	ELECTRICAL CONTRACTOR	1	1. ELECTRICAL DRAWINGS FOR ADDITIONAL INFORMATION.	S
20	STRUCTURE	1	1. FIRE PROTECTION DRAWINGS FOR ADDITIONAL INFORMATION.	T
21	WET CHEMICAL FIRE SUPPRESSION SYSTEM	1	1. FIRE ALARM DRAWINGS FOR ADDITIONAL INFORMATION.	U
22	ROOFTOP EQUIPMENT	1	1. KITCHEN DRAWINGS FOR ADDITIONAL INFORMATION.	V
23	STRUCTURE	1	1. PLUMBING CONTRACTOR DRAWINGS FOR ADDITIONAL INFORMATION.	W
EXPANSION TANK SCHEDULE				
MANUFACTURER	MODEL	TOTAL VOL.	CONNECTION	ACCESSORIES
MTROL	ST-12	4.4 GAL.	¾"	-

TAG	MA
P-1	
ACCESSORIES	
1.	TIMEC
2.	AQUA
3.	CHEC
BAC	
TYPE	MP
AG	FURN
AG	FURN
AVB	FURN
AVB	FU
VB	F
DCV	F
DCV	F
DCV	WAT
RPZ	WIL
RPZ	WIL
PVB	WATT
NOTES:	
. SEE GR	
. GREASE	
. INTERIO	
. FOR ZU	
TAG	
F-1	
F-2	
FCO	
D-1	
D-2	
D-3	
D-4	
S-1	
S-2	
S-3	
B-1	
B-2	
B-3	
B-4	
S-1	
S-2	
S-3	STA
AV-1	
AV-2	
S-1	
D-1	
R-1	
WB-1	
WB-2	
WC-1	
WC-2	
-	
S-1	
-	
-	
NCO	

PUMP SCHEDULE

MANUFACTURER	MODEL	HP	V	Ø	Hz	ACCESSORIES
GRUNDFOS	UP 15-18 B7	1/25	120	1	60	1-3
ES: CLOCK STAT K VALVE		NOTES: 1. SEE ELECTRICAL DRAWINGS FOR TIMECLOCK WIRING 2. DESIGN: 2 GPM, 7 FT. HEAD 3. SEE DETAIL 6 ON DRAWING P3.0				

KFLOW PREVENTER SCHEDULE

FR.	MODEL	ASSE LISTING	SERVES	LOCATION
. WITH CHEM. SYS.	1055B	CHEMICAL SYSTEM	DIN. RM.-MOP SINK	
. WITH CHEM. SYS.	1055B	CHEMICAL SYSTEM	KITCHEN-MOP SINK	
. WITH CHEM. SYS.	1001	CHEMICAL SYSTEM	SUPP. RM.-3-COMP	
RN. WITH FAUCET	-	MOP SINK FAUCET	SEE DRAWINGS	
FURN. WITH HB	1012	WALL HYDRANT	SEE DRAWINGS	
FURN. WITH HB	1052	YARD HYDRANT	TRASH CORRAL	
FURN. WITH HB	1052	ROOF HYDRANT	ROOF	
TTTS	SD-3	SDA TOWERS AND SPEC. COFFEE		
KINS	375XL-SXL-AG	INCOMING WATER	SUPPORT ROOM	
KINS	375XL-AG	FILTRATION SYSTEM	SUPPORT ROOM	
S	WA800M4QT-100	IRRIGATION SYSTEM	IRRIGATION SYSTEM	

INTERCEPTOR SCHEDULE

DESCRIPTION	MANUFACTURER	MODEL
EXTERIOR GREASE INTERCEPTOR	ZURN	PRECAST CONCRETE


EASE INTERCEPTOR NOTES ON DRAWING P4.0
 INTERCEPTOR IS SIZED FOR CITY SEWER APPLICATIONS ONLY. DO NOT USE.
 PRECAST CONCRETE SHALL BE COATED WITH TWO (2) LAYERS OF NOVA
 PROCTOR ORDERING, CONTACT HUGHES SUPPLY, DIRECT LINE: (407) 261-1234

PLUMBING SCHEDULE

DESCRIPTION	MANUFACTURER	MODEL
FAUCET FOR LAV-1 & LAV-2	TOTO	TEL101-D1
	ZURN	Z6950-XL-
FAUCET FOR MS-1	ZURN	Z843M4
6x6 FLOOR CLEAN OUT	ZURN	Z1400-SZ
	JAY R. SMITH	4040
6x6 FLOOR DRAIN WITH FUNNEL	ZURN	Z415-SZ-
	JAY R. SMITH	3510-F25
6x6 FLOOR DRAIN	ZURN	Z415-SZ
	JAY R. SMITH	2005
6x6 FLOOR DRAIN WITH FUNNEL	ZURN	Z415-SZ-
	JAY R. SMITH	3510-F25
6x6 FLOOR DRAIN	ZURN	Z415-SZ
	JAY R. SMITH	2005
12x12 FLOOR SINK WITH HALF-GRATE	ZURN	ZN1901
	JAY R. SMITH	3435
8x8 FLOOR SINK WITH HALF-GRATE	ZURN	ZN1910
	JAY R. SMITH	3415
8x8 FLOOR SINK	ZURN	ZN1910
	JAY R. SMITH	3415
WALL HYDRANT	WOODFORD	B65
	ZURN	Z1320-EZ
	JAY R. SMITH	5519
YARD HYDRANT	WOODFORD	S4H
ROOF HYDRANT	WOODFORD	RHY2-MS
GARAGE HYDRANT	WOODFORD	C22CP3
STAINLESS STEEL HAND SINK	ADVANCE TABCO	7-PS-61
STAINLESS STEEL HAND SINK - ADA	ADVANCE TABCO	7-PS-26
INLESS STEEL HAND SINK - SUPER SAVER	ADVANCE TABCO	7-PS-22
LAVATORY	KOHLER	K-2882-0
	TOTO	LT191G#01
WALL-MOUNTED LAVATORY	KOHLER	K-2084
MOP SINK	FIELD FABRICATED	RECESSED (24x24x12)
	ADVANCE TABCO	9-OP-24F
TRENCH DRAIN	ZURN	Z886-SMG
ADA WALL-HUNG URINAL	TOTO	UT445U#01
	ZURN	Z5755
	-	-
WALL BOX FOR WASHING MACHINE	SIOUX CHIEF	696-2313
WALL BOX FOR WAREWASHER	SIOUX CHIEF	696-1011
WATER CLOSET	TOTO	CT705EN#01
	ZURN	Z5655
	-	-
ADA WATER CLOSET	TOTO	CT705ELN#01
	ZURN	Z5665
	-	-
3-COMPARTMENT SINK	-	-
VEGETABLE PREPARATION SINK	-	-
WAREWASHER	ECOLAB	SUPRA Q20 VAPOR VEN
WASHING MACHINE	-	-
6x6 WALL CLEAN OUT	ZURN	71441-VP

SHEET NO.	TITLE	
	2019 STANDARD BUILDING 4597F10-WOOD/WOOD	
	DESCRIPTION	
	WOOD BEARING WALLS W/FIBER CEMENT SIDING	WOOD ROOF TRUSS FRAMING
	FIBER CEMENT PANEL/BATTEN/ALPOLIC PANEL	SITE ADDRESS
SITE ID	015-0071	
015-0071	605 SOUTH 7TH STREET, KANSAS CITY	
015-0071.00.B		
P.4.1 SCHEDULES		

DO NOT SCALE DRAWING
WORK TO DIMENSIONS

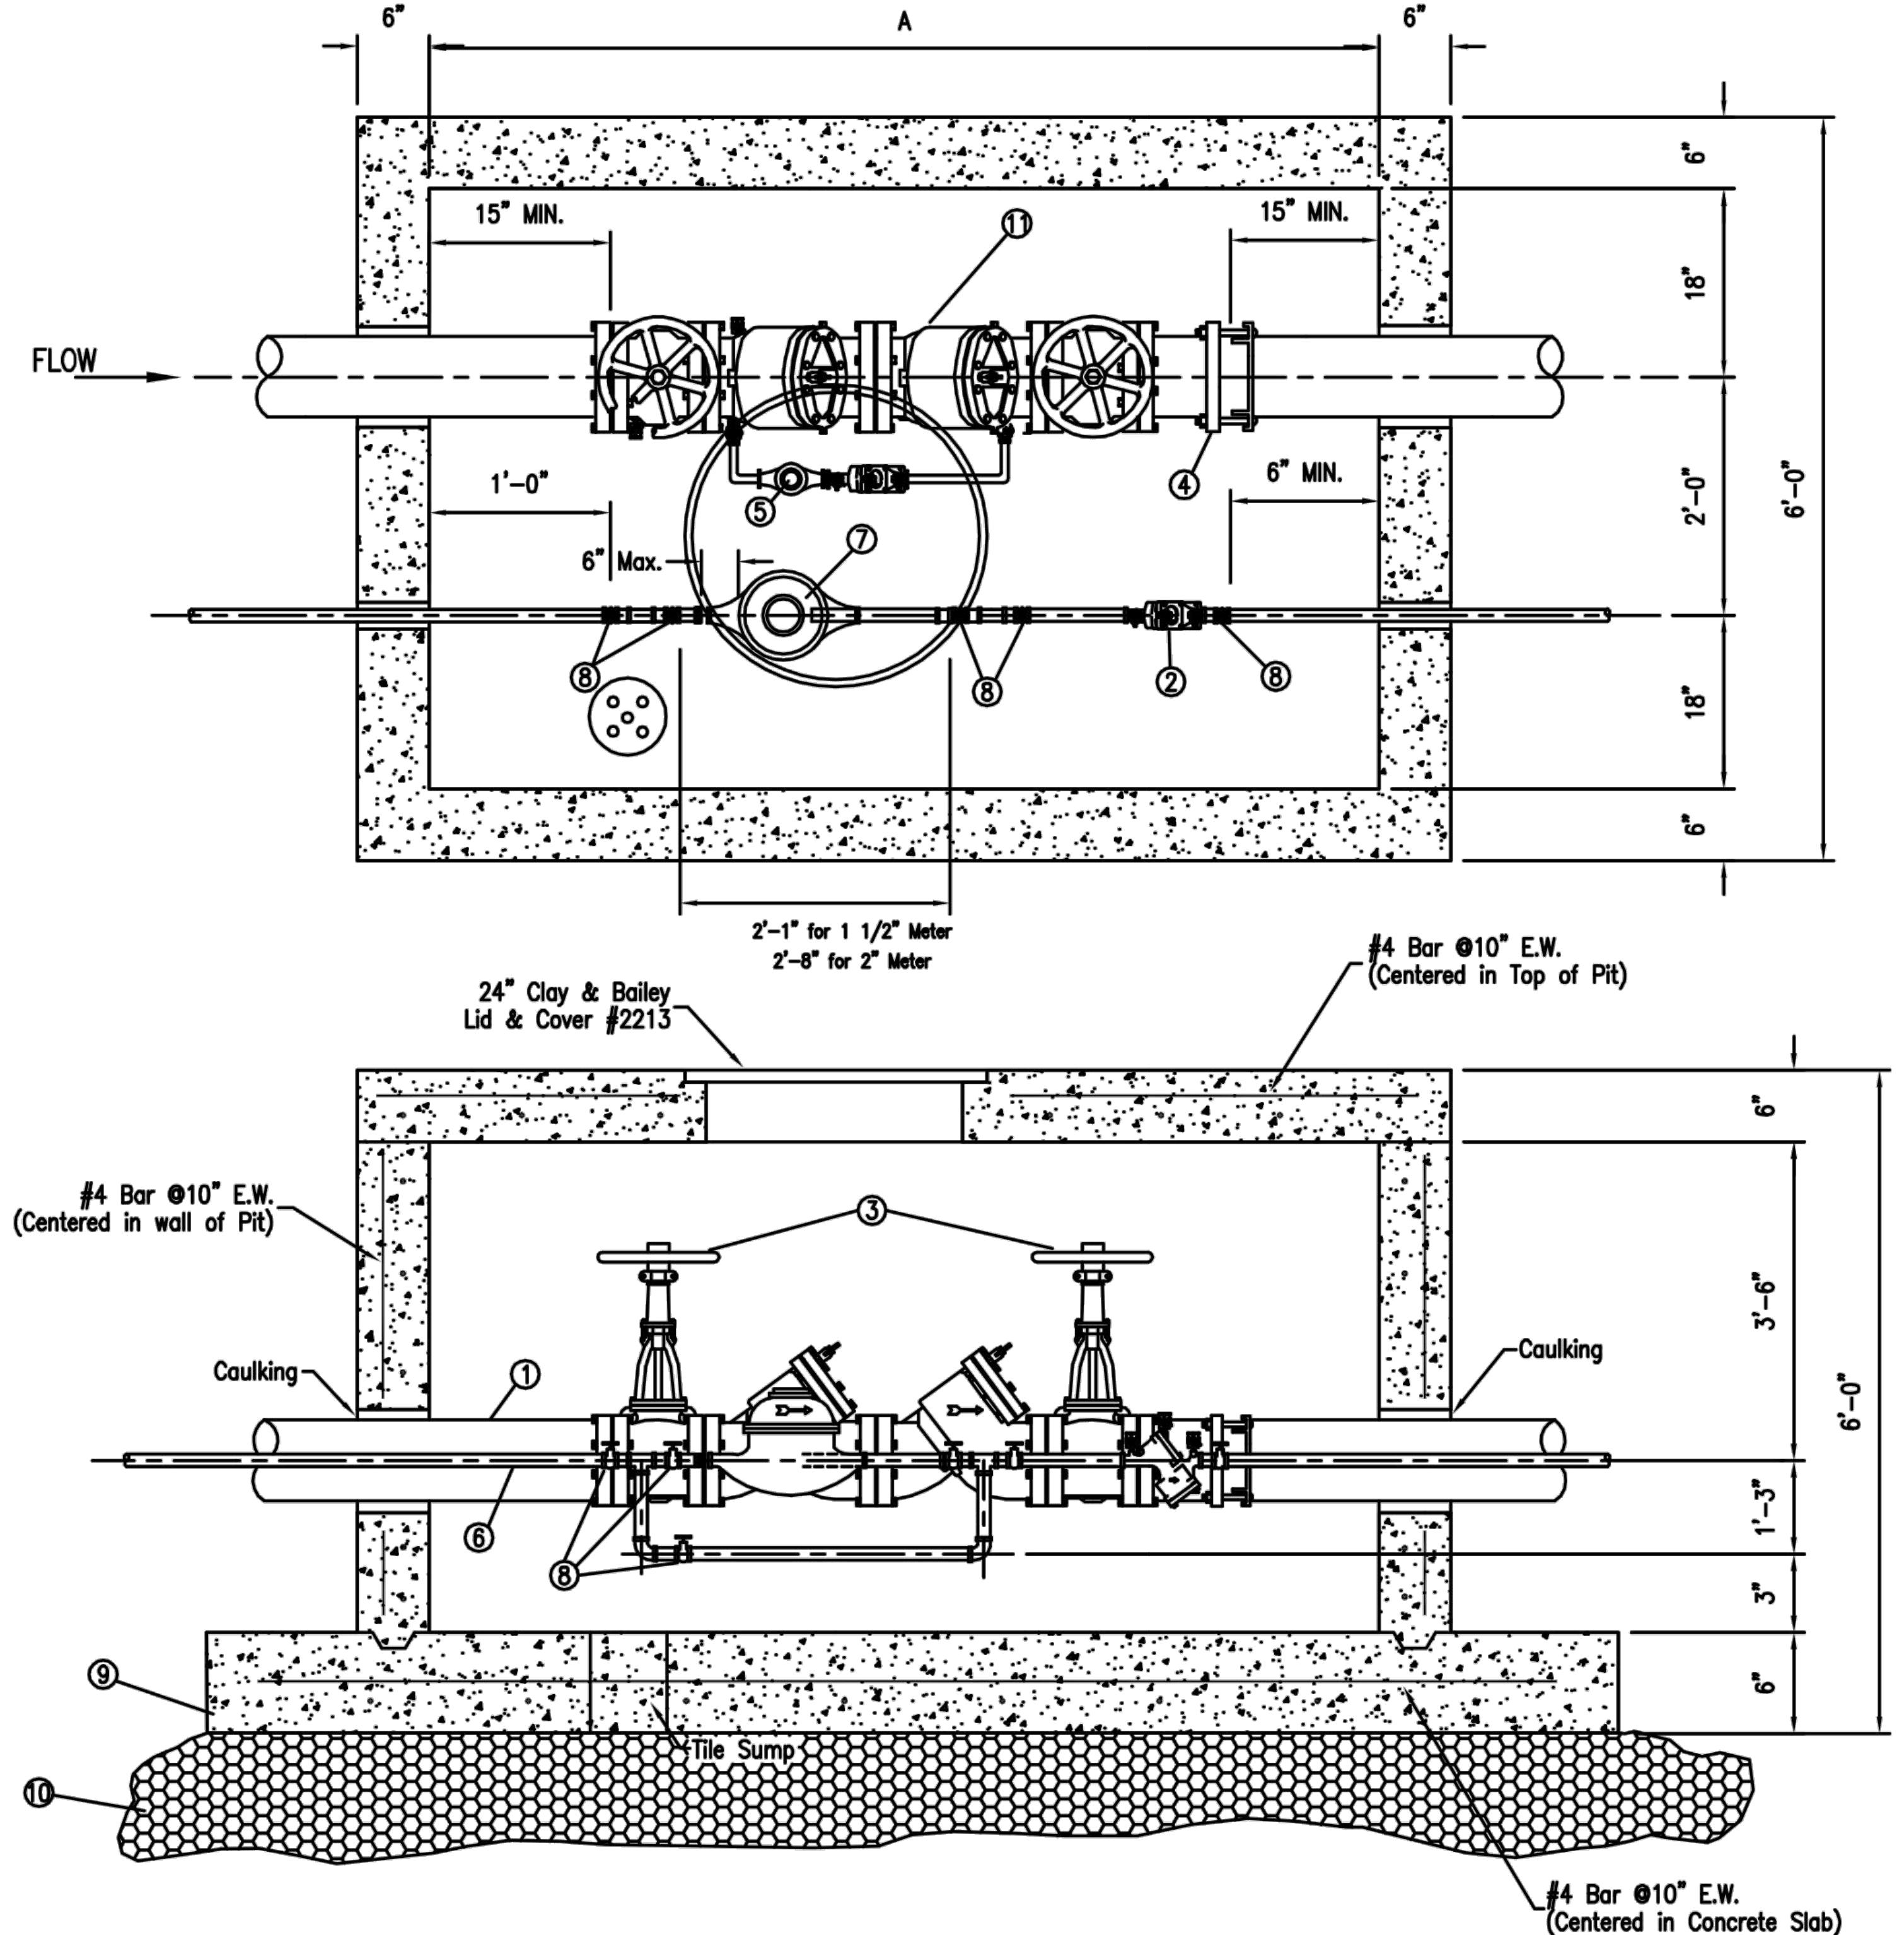

LEGEND

- ① Pipe Spool (Flanged Ductile Iron Pipe).
- ② Approved double check valve assembly with 4 test cocks (Fitted with brass plugs).
- ③ O.S.&Y Resilient seated gate valve.
- ④ Rockwell 913 Steel flanged coupling adapter or approved equal.
- ⑤ 5/8" box water meter, Badger Model #25 with read in cubic feet to meet B.P.U. specifications.
- ⑥ Brass pipe or rigid copper tubing (sweat).
- ⑦ Meter installed by B.P.U.
- ⑧ Wheel gate valve or resilient seated ball valve.
- ⑨ 10'-6"x 7'-0"x 6" Reinforced concrete slab.
- ⑩ 12" of 1/2" or 3/4" crushed rock.
- ⑪ Approved double check detector check valve assembly with 4 test cocks(Fitted with brass plugs)


NOTES

- 1 All backflow prevention assemblies shall be installed horizontally or as approved by BPU.
- 2 Dimension to be determined by unit installed.
- 3 AB-3, CA-5 or gravel will not be allowed as back fill material around water service.

BOARD OF PUBLIC UTILITIES
ENGINEERING & TECHNICAL SERVICES
KANSAS CITY, KANSAS
1 1/2"-2" Meter w/ 3", 4", & 6"
Double Check Detector Check
Valve Assembly

DRAWN	A.A.G.	DATE	4/1/92	ENGR. APPV.	R.W.
APPV.		DATE		SHEET	9 OF 37
REV.		DATE		DWG. NO.	
TRACED		DATE			
SCALE	NONE	W.O.			BF-009a

TITLE	DETAILS	BY
2019 STANDARD BUILDING - BB20		
4597F10-WOOD/WOOD		
STD ISSUE DATE		
2019-11		
REVIEWED BY		
WLW		
DESCRIPTION		
WOOD BEARING WALLS W/FIBER CEMENT SIDING & CI		
WOOD ROOF TRUSS FRAMING		
FIBER CEMENT PANEL/BATTEN/ALPOLIC PANEL/BRICK EXT. FINISH		
SITE ID		
015-0071-00-A		
SITE ADDRESS		
605 SOUTH 7TH STREET, KANSAS CITY, KS		
015-0071		
REV. DATE		
01/13/20		
PROGRESS SET REVIEW		
01/23/20		
PERMIT SET		
01/23/20		
CIVIL & PLANT REVIEW COMMENTS		
05/05/20		
EMANUELSON-PODAS		
CONSULTING ENGINEERS		
Emmanuelson-Podas, Inc.		
Edwards, IN 46332		
(920) 930-0050 www.epinc.com		
REV. DATE		
05/05/20		

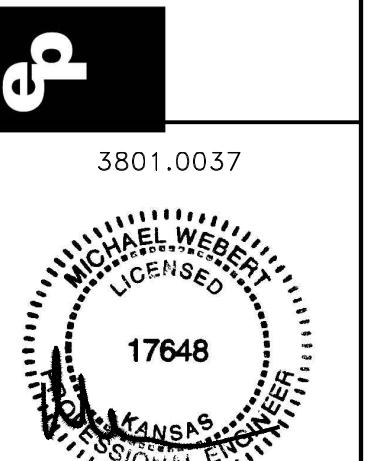


05/05/20

© 2020 McDonald's USA, LLC
McDonald's USA, LLC
PREPARED FOR:
These drawings and specifications are the confidential and proprietary property of McDonald's USA, LLC, and shall not be copied or reproduced for use on this specific site in conjunction with its issuance date and are not suitable for use on a different site or at a later time. Use of these drawings for reference or example on another project requires the services of properly licensed architects and engineers. Reproduction of the contract documents for reuse on another project is not authorized.

DRAWN BY:
M.J.W.
STD ISSUE DATE:
2019-11
REVIEWED BY:
WLW
DATE ISSUED:
01-23-20
DESCRIPTION:
WOOD BEARING WALLS W/FIBER CEMENT SIDING & CI
WOOD ROOF TRUSS FRAMING
FIBER CEMENT PANEL/BATTEN/ALPOLIC PANEL/BRICK EXT. FINISH
SHEET NO.:
015-0071-00-A
DETAILS:
P4.2

TITLE	2019 STANDARD BUILDING - BB20	DATE	4/1/92	ENGR. APPV.	R.W.
DETAILS	4597F10-WOOD/WOOD				
DESCRIPTION	WOOD BEARING WALLS W/FIBER CEMENT SIDING & CI				
	WOOD ROOF TRUSS FRAMING				
	FIBER CEMENT PANEL/BATTEN/ALPOLIC PANEL/BRICK EXT. FINISH				
SITE ID	015-0071				
SITE ADDRESS	605 SOUTH 7TH STREET, KANSAS CITY, KS				
REV. DATE					
01/13/20					
PROGRESS SET REVIEW					
01/23/20					
CIVIL & PLANT REVIEW COMMENTS					
05/05/20					
PERMIT SET					
01/23/20					
EMANUELSON-PODAS					
CONSULTING ENGINEERS					
Emmanuelson-Podas, Inc.					
Edwards, IN 46332					
(920) 930-0050 www.epinc.com					
REV. DATE					
05/05/20					

THE PURPOSE OF THIS SHEET IS TO PROVIDE A CHECKLIST AND VISUAL GUIDE SO THE INSTALLING EC CAN VERIFY THE WORK IS IN COMPLIANCE WITH MCDONALD'S SPECIFICATIONS THAT ARE CRITICAL TO THE PROPER FUNCTIONING OF OUR POINT OF SALE (POS) COMPUTER SYSTEMS.

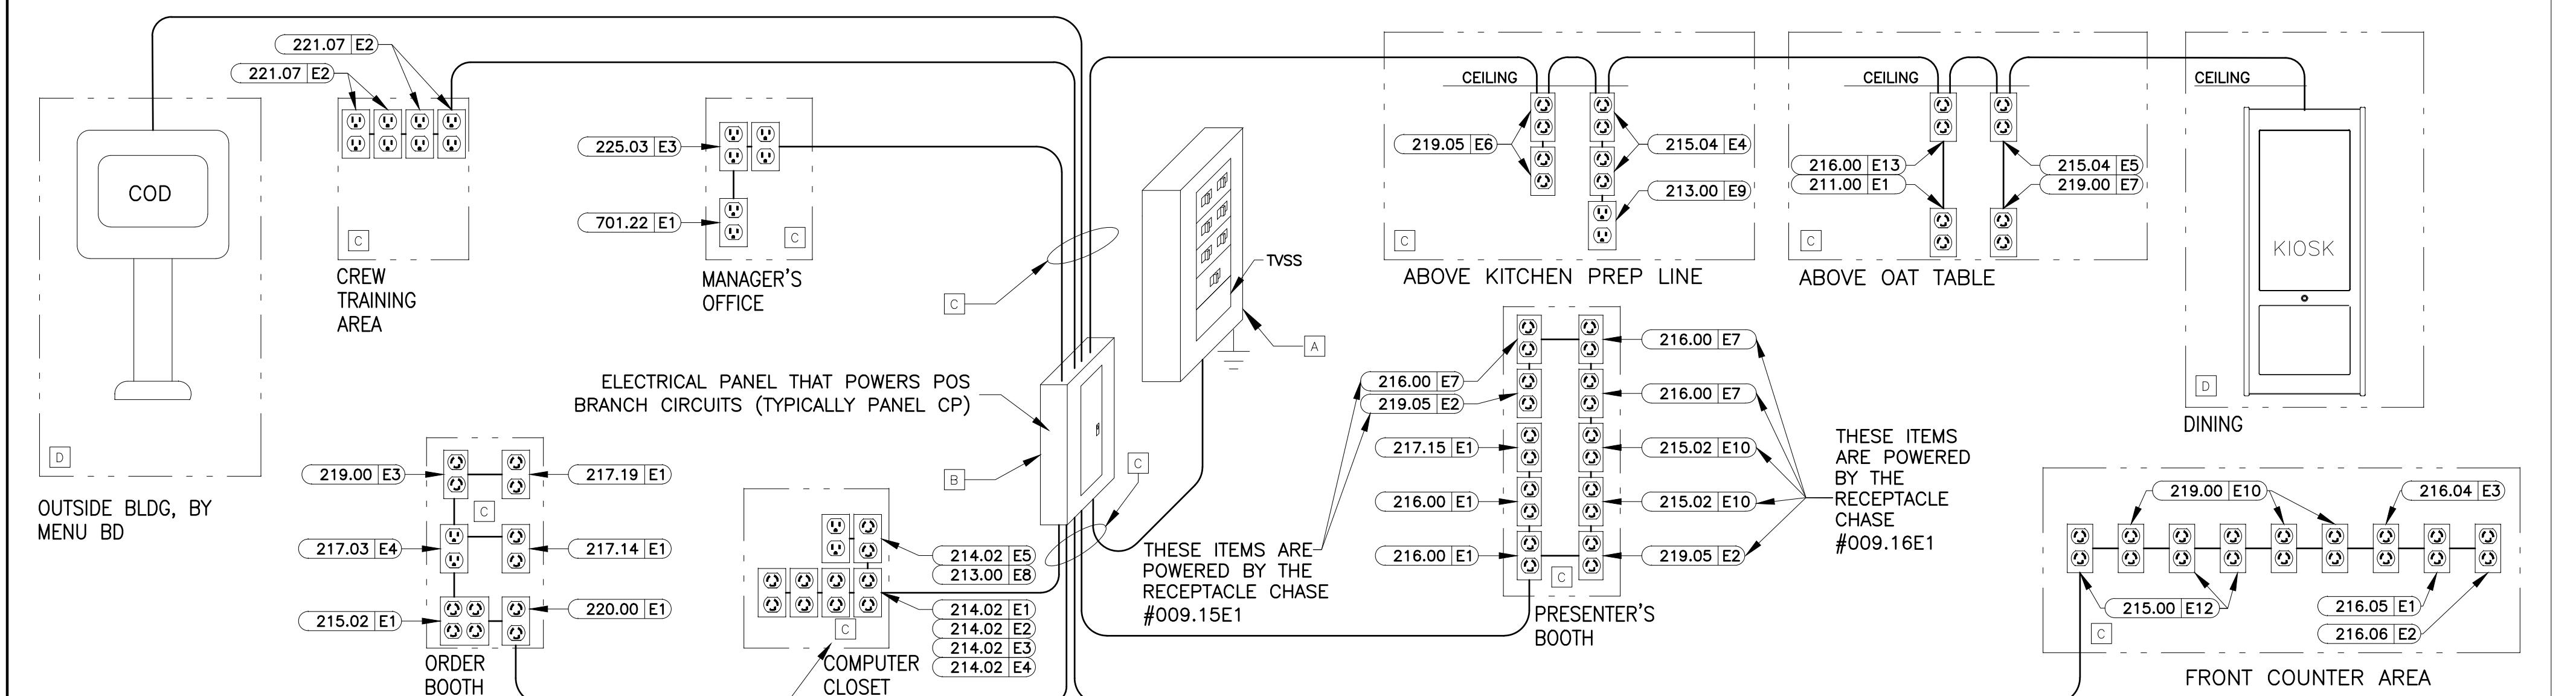

POS ELECTRICAL RISER DIAGRAM

THIS RISER DIAGRAM SHOWS THE ELECTRICAL ROUGH-INS REQUIRED FOR A TYPICAL POINT OF SALE (POS) SYSTEM IN A FREE STANDING 2 BOOTH RESTAURANT. VERIFY ALL POS ROUGH-INS AND MOUNTING HEIGHTS WITH THE ELECTRICAL ROUGH-IN PLAN, NOTES AND INFORMATION DRAWINGS.

LOW VOLTAGE CABLE MANAGEMENT SPECIFICATION

GENERAL/MATERIALS

- THE CC OR EC SHALL FURNISH AND INSTALL A COMPLETE LOW VOLTAGE CABLE MANAGEMENT SYSTEM UTILIZING CADDY-ERICO TYPE CAT-32 J-HOOK SUPPORTS (2-INCH DIAMETER LOOP MINIMUM). ALL J-HOOKS SHALL:
 - HAVE A MINIMUM BEARING SURFACE OF $\frac{1}{32}$ "
 - HAVE FLARED EDGES TO PREVENT DAMAGE TO HIGH PERFORMANCE CABLES,
 - HAVE AN ELECTRO-GALVANIZED FINISH,
 - HAVE 3/8" WIDE CABLE RETAINING STRAPS,
 - BE UL LISTED AND LABELED,
 - BEAR THE UL SYMBOL MARKING ON THE PART FOR IDENTIFICATION
 - BE INSTALLED PER THE MANUFACTURERS INSTALLATION INSTRUCTIONS.
- THE ENTIRE INSTALLATION SHALL BE IN COMPLIANCE WITH THE NATIONAL ELECTRICAL CODE (NEC), NEC SECTION 800, BICSI STANDARDS 568 & 569, ALL APPLICABLE NATIONAL, STATE, LOCAL, AND SAFETY CODES, AND MCDONALD'S SPECIFICATIONS.

INSTALLATION

- LOW VOLTAGE J-HOOK CABLE PATHWAY (FOR POS CABLING SYSTEM) SHALL BE PROVIDED FROM THE MANAGERS OFFICE (OR COMPUTER CLOSET) DATA CONDUIT STUB-UP LOCATION TO THE FOLLOWING DATA CONDUIT STUB-UP LOCATIONS (AS APPLICABLE):
 - FRONT COUNTER,
 - PRESENTER'S BOOTH,
 - CASHIERS BOOTH,
 - THIRD DRIVE-THRU WINDOW(IF PRESENT).
 - CREW ROOM,
 - VALENCE WALL,
 - REMOTE ORDERING STATIONS,
 - NETPOF TELEPHONE PANEL LOCATION.
- CABLE SUPPORTS SHALL BE PROVIDED WITHIN 24 INCHES OF THESE STUB-UP LOCATIONS. ALL STUB-UP CONDUITS SHALL BE PROVIDED WITH AN INSULATED BUSHING TO PROTECT CABLES DURING INSTALLATION.
- ALL NON-POS LOW VOLTAGE CABLING SHALL BE INSTALLED IN A SEPARATE CABLE MANAGEMENT SYSTEM INDEPENDENT OF THE LOW-VOLTAGE CABLE MANAGEMENT SYSTEM UTILIZED FOR THE POS CABLING.
- THE POS INSTALLER SHALL BE RESPONSIBLE TO FURNISH AND INSTALL ALL LOW VOLTAGE CABLING REQUIRED FOR THE COMPLETE AND FULLY FUNCTIONAL OPERATION OF THE POS SYSTEM. ALL POS CABLING SHALL BE INSTALLED WITHIN THE LOW-VOLTAGE CABLE MANAGEMENT SYSTEM.

ELECTRICAL POS CERTIFICATION

AS OF THE DATE BELOW, I HEREBY CERTIFY THAT ALL ELECTRICAL WORK, ELECTRICAL SERVICE AND ELECTRICAL SYSTEMS, MATERIALS AND LABOR RELATED TO THE POS ELECTRICAL INSTALLATION IN WHICH THE UNDERSIGNED ARE DIRECTLY OR INDIRECTLY RESPONSIBLE HAVE BEEN PROPERLY INSTALLED IN FULL COMPLIANCE WITH ALL CONSTRUCTION DOCUMENTS AND ALL NFPA BUILDING, ELECTRICAL AND OTHER APPLICABLE CODES, ALONG WITH ALL OF THE REQUIREMENTS OUTLINED ON THIS DRAWING. I FURTHER CERTIFY THAT THE ELECTRIC SERVICE POWERING THE POS SYSTEM HAS BEEN PROPERLY INSTALLED BY A QUALIFIED ELECTRICIAN. SKILLED, KNOWLEDGEABLE AND TRAINED TO INSTALL ALL THE REQUIRED ELECTRICAL DISTRIBUTION COMPONENTS NECESSARY TO POWER THE POINT OF SALE (POS) SYSTEM.

GENERAL CONTRACTOR: _____
BY: _____
DATE: _____

ELECTRICAL CONTRACTOR: _____
BY: _____
DATE: _____

THE EC SHALL COMPLETE THE BELOW CHECKLIST TO VERIFY COMPLIANCE WITH MCDONALD'S SPECIFICATIONS.

IF YOU HAVE ANY QUESTIONS REGARDING THE PLANS, PLEASE CALL THE DESIGNER.
DESIGNER: Wendy Wenborg
PHONE: 952-540-4047
EMAIL: wwenborg@epinc.com

START HERE

A VISUALLY INSPECT THE MAIN ELECTRICAL PANEL (MDP)

YES NO N/A

1. IS AN EQUIPMENT GROUND BAR INSTALLED SUCH THAT IT IS ELECTRICALLY CONNECTED TO THE PANEL?
2. DO ALL NEUTRAL CONDUCTORS TERMINATE ONLY TO THE NEUTRAL BAR?
3. DO ALL EQUIPMENT GROUND CONDUCTORS TERMINATE ONLY TO THE EQUIPMENT GROUND BAR?
4. DOES THE ISOLATED GROUND CONDUCTOR (GREEN W/YELLOW STRIPE) TERMINATE ON THE EQUIPMENT GROUND BAR?
5. IS THERE AN APPROPRIATE ELECTRICAL CONNECTION (BOND) BETWEEN THE NEUTRAL BAR AND THE EQUIPMENT GROUND BAR?
6. DOES THE GROUNDING SYSTEM COMPLY WITH MCDONALD'S "BUILDING ELECTRICAL GROUNDING DETAIL"?
7. IS A SURGE PROTECTOR INSTALLED THAT COMPLIES WITH MCDONALD'S "TVSS INSTALLATION GUIDE" OR DETAIL?
8. ARE ALL ELECTRICAL CONNECTIONS (WIRING & BUSING) PROPERLY TIGHTENED?
9. ARE ALL CIRCUIT BREAKERS CLEARLY LABELED?

B VISUALLY INSPECT THE PANEL "CP" THAT POWERS POS

YES NO N/A

1. IS AN EQUIPMENT GROUND BAR INSTALLED SUCH THAT IT IS ELECTRICALLY CONNECTED TO THE PANEL?
2. IS AN ISOLATED GROUND BAR INSTALLED SUCH THAT IT IS ELECTRICALLY INSULATED FROM THE PANEL?
3. DO ALL NEUTRAL CONDUCTORS TERMINATE ONLY TO THE NEUTRAL BAR?
4. DO ALL EQUIPMENT GROUND CONDUCTORS TERMINATE ONLY TO THE EQUIPMENT GROUND BAR?
5. DO ALL ISOLATED GROUND CONDUCTORS (GREEN W/YELLOW STRIPE) TERMINATE ONLY TO THE ISOLATED GROUND BAR?
6. ARE ALL ELECTRICAL CONNECTIONS (WIRING & BUSING) PROPERLY TIGHTENED?
7. ARE ALL POS & COD CIRCUIT BREAKERS ON THE SAME PANEL?
8. ARE ALL CIRCUIT BREAKERS CLEARLY LABELED?
9. DO ALL POS & COD CIRCUIT BREAKERS HAVE A LOCKING MECHANISM ON THEIR HANDLES TO PREVENT THEM FROM BEING SHUT OFF BY MISTAKE?
10. DOES THE FEEDER CIRCUIT FOR THIS SUBPANEL CONTAIN PHASE, NEUTRAL ONE EQUIPMENT GROUND AND ONE ISOLATED GROUND CONDUCTORS THAT ARE PROPERLY TERMINATED (SEE POS & COD ISO GND/DED CKT DETAIL)?

VISUALLY INSPECT ALL REMAINING ELECTRICAL SUBPANELS

YES NO N/A

1. IS AN EQUIPMENT GROUND BAR INSTALLED SUCH THAT IT IS ELECTRICALLY CONNECTED TO THE PANEL?
2. DO ALL NEUTRAL CONDUCTORS TERMINATE ONLY TO THE NEUTRAL BAR?
3. DO ALL EQUIPMENT GROUND CONDUCTORS TERMINATE ONLY TO THE EQUIPMENT GROUND BAR?
4. ARE ALL ELECTRICAL CONNECTIONS (WIRING & BUSING) PROPERLY TIGHTENED?
5. ARE ALL CIRCUIT BREAKERS CLEARLY LABELED?
6. DOES THE FEEDER CIRCUIT FOR THIS SUBPANEL CONTAIN PHASE, NEUTRAL AND ONE EQUIPMENT GROUND CONDUCTORS THAT ARE PROPERLY TERMINATED? (SEE BUILDING ELECTRICAL GROUNDING DETAIL)

REWORK ELECTRICAL SYSTEM TO BRING INTO COMPLIANCE WITH MCDONALD'S SPECIFICATIONS

C VISUALLY INSPECT THE POS BRANCH CIRCUITS

YES NO N/A

1. ARE THE POS BRANCH CIRCUITS ROUTED IN THEIR OWN CONDUIT BY THEMSELVES?
2. IF THE POS BRANCH CIRCUIT IS ROUTED ABOVE GRADE, IS IT IN A METALLIC CONDUIT?
3. DOES EACH POS BRANCH CIRCUIT CONTAIN: ONE PHASE (BLACK COLORED INSULATION) ONE NEUTRAL (WHITE COLORED INSULATION) ONE EQUIPMENT GROUND (GREEN COLORED INSULATION) ONE ISOLATED GROUND (GREEN W/YELLOW STRIPE COLORED INSULATION).
4. DO ALL POS BRANCH CIRCUITS TERMINATE AT EITHER AN IG4700, IG4710, IG5261, IG5262 RECEPTACLES OR ANY COMBINATION OF THESE?
5. ARE ALL ELECTRICAL TERMINATIONS TO IG RECEPTACLES MADE WITH SOLID #12 AWG WIRE CAPTURED AROUND THE SCREW BARREL AND SUITABLY TIGHTENED?
6. ARE ALL BRANCH CIRCUIT CONNECTIONS PROPERLY TIGHTENED?
7. ARE THE CORRECT AMOUNT AND TYPE OF IG RECEPTACLES PROVIDED AS SHOWN IN THE ELECTRICAL ROUGH-IN PLAN, NOTES AND INFORMATION?
8. DO ALL POS RECEPTACLES HAVE ORANGE "COMPUTER ONLY" COVERPLATES?
9. DO ALL POS BRANCH CIRCUITS COMPLY WITH THE "POS & COD ISOLATED GND/DEDICATED CIRCUIT" DETAIL?

D VISUALLY INSPECT THE POS BRANCH CIRCUIT FOR THE COD

YES NO N/A

1. ARE THE COD BRANCH CIRCUITS ROUTED IN THEIR OWN CONDUIT BY THEMSELVES?
2. DOES EACH COD BRANCH CIRCUIT CONTAIN:
 - ONE PHASE (BLACK COLORED INSULATION),
 - ONE NEUTRAL (WHITE COLORED INSULATION),
 - ONE EQUIPMENT GROUND (GREEN COLORED INSULATION),
 - ONE ISOLATED GROUND (GREEN W/YELLOW STRIPE COLORED INSULATION).
3. IS THE COD POWERED FROM THE SAME PANEL AS THE POS?
4. DOES THE BREAKER FOR THE COD HAVE A LOCKING MECHANISM ON ITS HANDLE THAT WILL PREVENT IT FROM BEING SHUT OFF?
5. DO THE COD BRANCH CIRCUIT(S) COMPLY WITH THE "POS & COD ISOLATED GND/DEDICATED CIRCUIT" DETAIL?
6. IF THE COD HAS AN OPTICAL ISOLATOR, IS A STRAIGHT BLADE ISOLATED GROUND RECEPTACLE ON AN ISOLATE GROUND/DEDICATED CIRCUIT PROVIDED FOR IT?


TITLE	DESCRIPTION	REV. DATE	BY
2019 STANDARD BUILDING - BB20 4597F10-WOOD/WOOD	WOOD BEARING WALLS W/FIBER CEMENT SIDING & CI WOOD ROOF TRUSS FRAMING FIBER CEMENT PANEL/BATTEN/ALPOLIC PANEL/BRICK EXTER. FINISH	01/23/20	W.W. W.W. W.W. W.W.

emmanuelson-podas consulting engineers
Emmanuelson-Podas, Inc.
Edina, MN 55439
(952) 930-0050 | www.epinc.com

3801.0037
MICHAEL WEBER
LICENSED
17648
MISSISSIPPI ELECTRICAL
01/23/20
PREPARED BY:

© 2020 McDonald's USA, LLC
These drawings and specifications are the confidential and proprietary property of McDonald's USA, LLC, and shall not be copied or reproduced for use on another project or site, or in whole or in part, without the express written consent of McDonald's USA, LLC, and shall not be used in conjunction with its issued drawings for use on another site or at a later time. Use of these drawings for reference or example on another project requires the services of a licensed architect or engineer. Reproduction of the contract documents for reuse on another project is not authorized.

DRAWN BY: MRV
STD ISSUE DATE: 2019-11
REVIEWED BY: WLW
DATE ISSUED: 01-23-20
SHEET NO. 015-0071.00.0
TITLE E1.0
DESCRIPTION POS RISER DIAGRAM

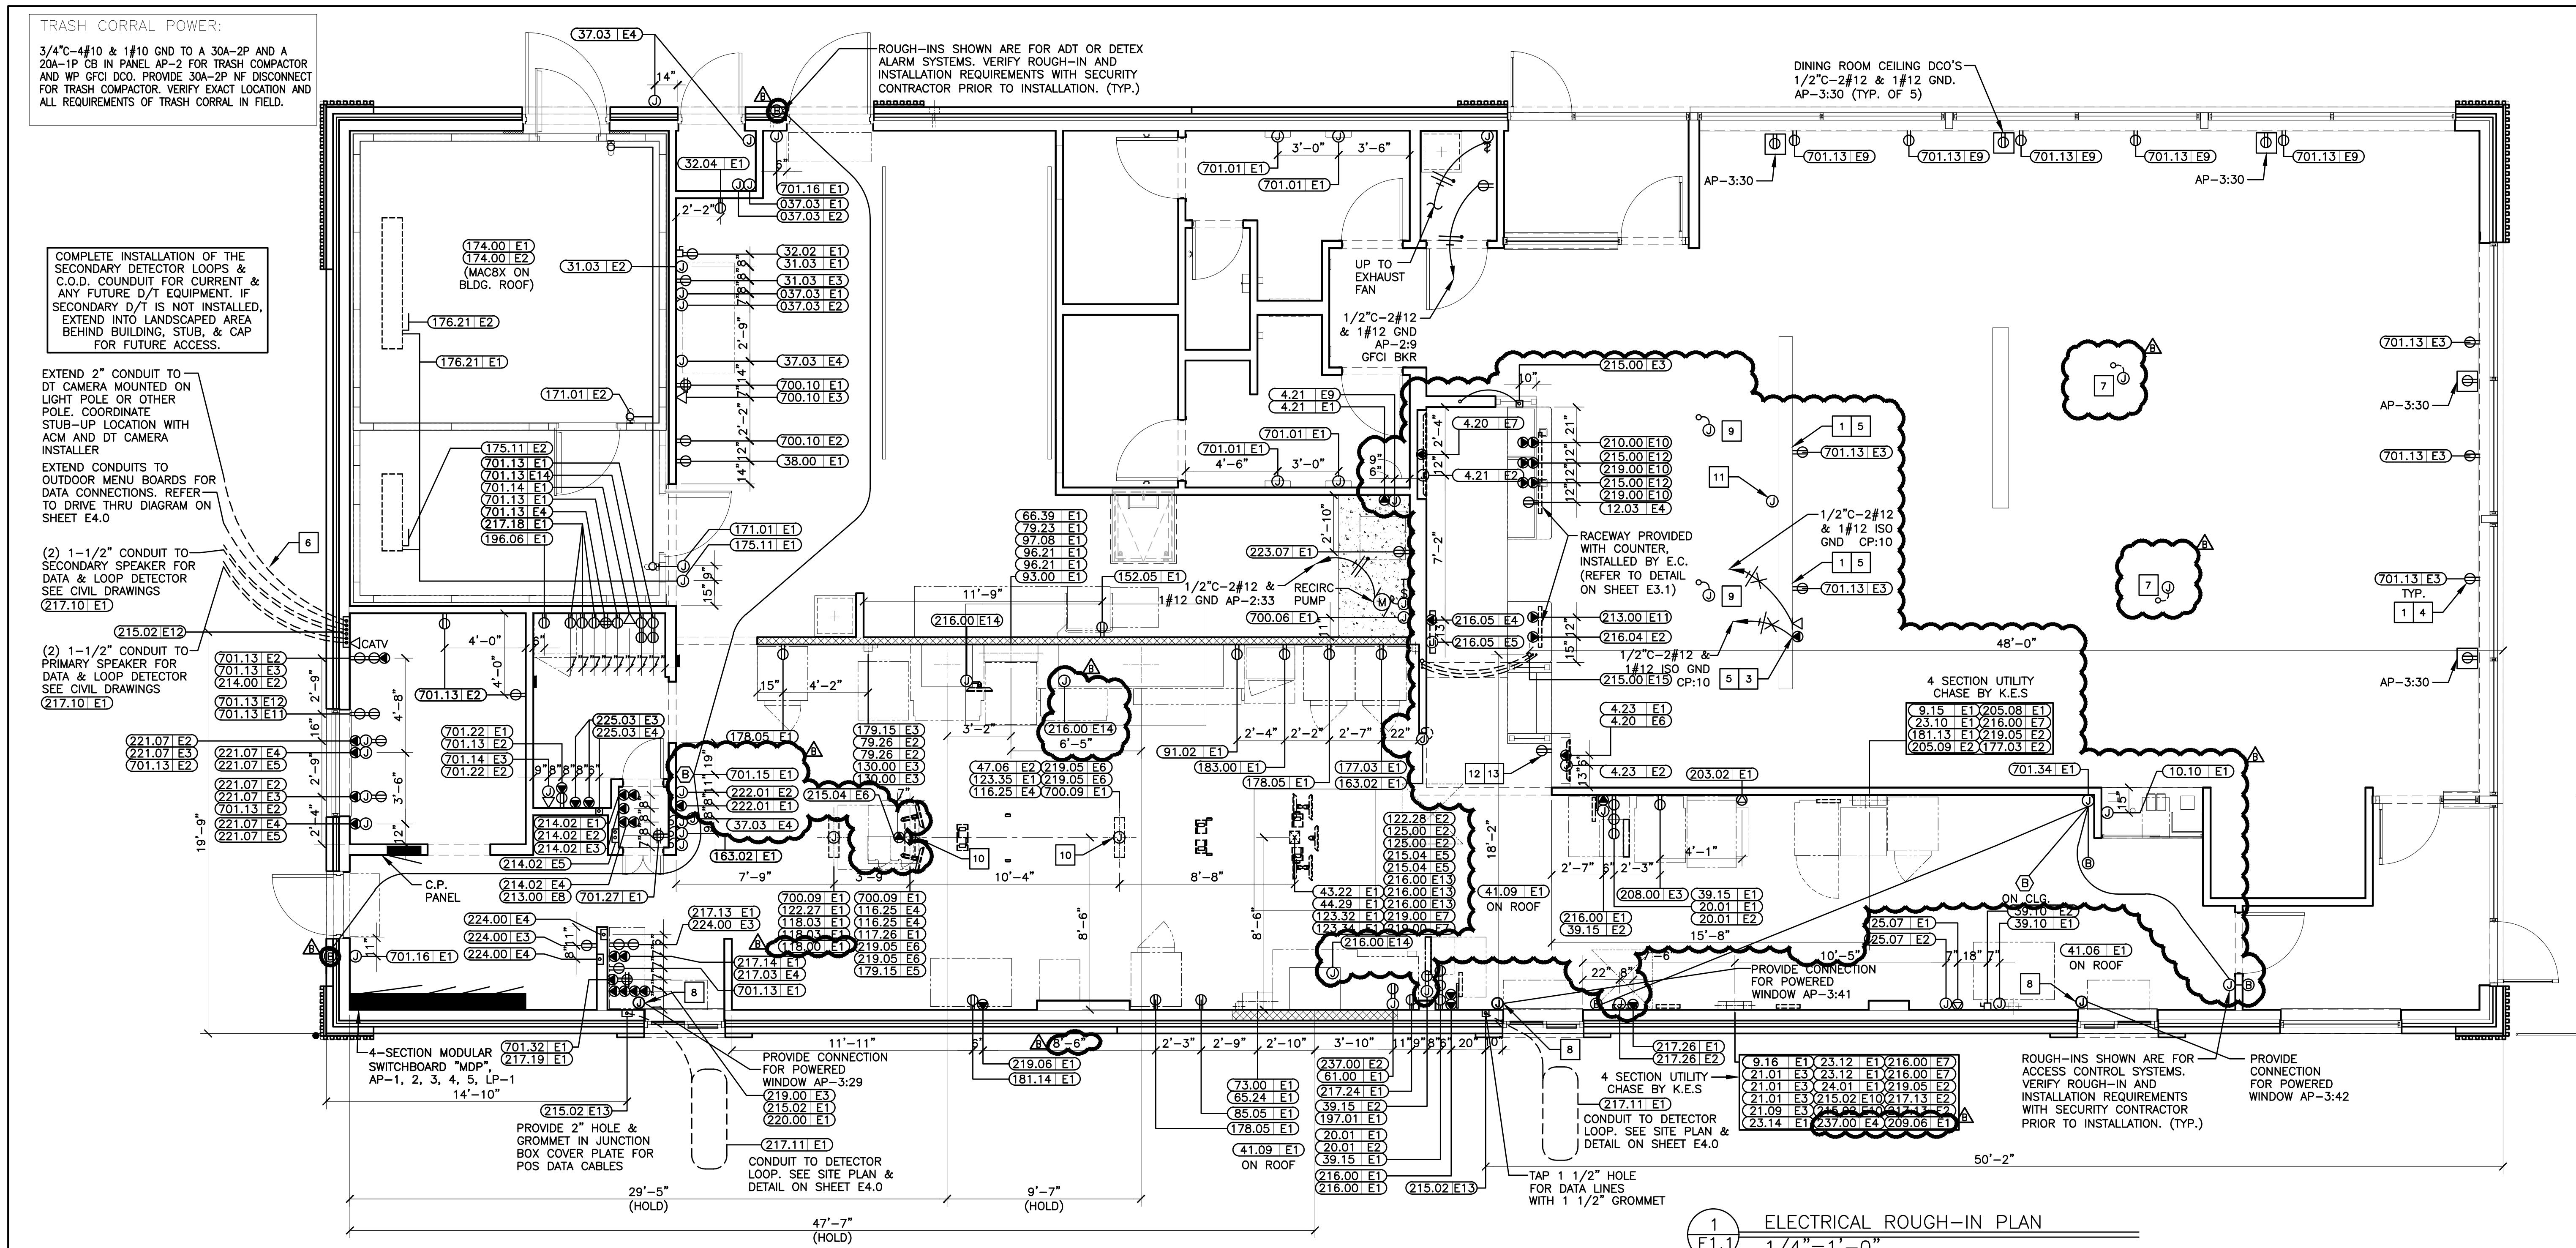

SYMBOLS AND ABBREVIATIONS

SYMBOL	DESCRIPTION	SYMBOL	DESCRIPTION
\$	SINGLE POLE SWITCH, 3W=THREE WAY SWITCH, K=KEYED SWITCHED, VS=VACANCY SENSOR	(B)	BUZZER
\$T	MANUAL SWITCH (T= THERMAL OVERLOADS)	(B)	BUTTON FOR BUZZER
□	TRANSFORMER	(○)	PULLBOX
○	JB WITH DUPLEX CONVENIENCE OUTLET (FLUSH WITH CEILING)	■	PANELBOARD
○	JB WITH SINGLE CONVENIENCE OUTLET	○	CIRCUIT BREAKER
○	JB WITH DUPLEX CONVENIENCE OUTLET	A	AMPERES
○	JB WITH TWO DUPLEX CONVENIENCE OUTLETS	ACM	AREA CONSTRUCTION MANAGER
○	JB WITH SPECIAL PURPOSE OUTLET	AFF	ABOVE FINISHED FLOOR
○	JB WITH ISOLATED GROUND OUTLET (IG) = IG4710, (IG) = IG5261, (IG) = IG4700A, (IG) = IG5262	C	CONDUIT
▲	INTERCOM STATION W/ 3/4" C- TO MAIN STATION	CCT	CIRCUIT
●	TELEPHONE JACK	EC	ELECTRICAL CONTRACTOR
○	JUNCTION BOX - WALL OR CEILING MOUNTED	GC	GENERAL CONTRACTOR
□	DISCONNECT SWITCH	GFI/GFCI	GROUND FAULT CIRCUIT INTERRUPTER
○	STUB UP THRU ROOF	GND	GROUND
○	THERMOSTAT SENSOR W/ 1/2" C- UP TO CEILING SPACE	IG	ISOLATED GROUND
○	MOTOR CONNECTION	JB	JUNCTION BOX
—	CONDUIT RUN CONCEALED IN CEILING OR WALLS	KES	KITCHEN EQUIPMENT SUPPLIER
—	CONDUIT RUN IN FLOOR SLAB	MLO	MAIN LUGS ONLY
—X	HOT (SHORT), NEUTRAL (LONG), EQUIP GRD (LONG WITH DOT), & X' DENOTES ISOLATED GRD	WP	WEATHERPROOF
○○	J-BOX WITH FINAL EQUIPMENT CONNECTION	CO	CARBON MONOXIDE SENSOR
○○	CEILING MOUNTED OCCUPANCY SENSOR		

ADT ROUGH-IN NOTES

1. COORDINATE EXACT INSTALLATION REQUIREMENTS WITH ADT PRIOR TO INSTALLATION TEL. 800-417-8238
2. EC SHALL PROVIDE A 2 GANG 3 25/32" X 3 25/32" X 3 1/2" D JUNCTION BOX AT DOOR FOR INSTALLATION OF DOOR ALARM UNIT. STUB 1/2" C ABOVE CEILING FROM JUNCTION BOX. PROVIDE 1/2" C FROM J-BOX TO DOOR MAGNETIC SWITCH LOCATION.
3. EC SHALL PROVIDE 4" X 4" JUNCTION BOX ABOVE CEILING FOR INSTALLATION OF LOW VOLTAGE TRANSFORMER. VERIFY EXACT LOCATION WITH ADT PRIOR TO INSTALLATION. PROVIDE 1/2" C-2#12 TO LOCKOUT TYPE CB IN PANEL LP-1.

GENERAL NOTES

1. SEE SHEET E3.0 FOR PANEL & CIRCUIT BREAKER ASSIGNMENT, VOLT/PH, FLA, BREAKER SIZE, COND/WIRE, RECEPTACLE TYPE, HEIGHT ABOVE FINISHED FLOOR, REQUIREMENTS & REMARKS FOR ALL ELECTRICAL EQUIPMENT.
2. SEE LOW VOLTAGE CABLE MANAGEMENT SPECIFICATION ON SHEET E1.0 FOR POS, DATA, AND SOUND SYSTEM REQUIREMENTS.
3. GC/EC SHALL COORDINATE LOCATION AND ALL REQUIREMENTS OF CT& METER CABINET WITH LOCAL UTILITY COMPANY. CT & METER CABINET SHALL NOT BE INSTALLED ON D/T SIDE OF BUILDING. GC SHALL PAINT TO MATCH BUILDING COLOR.

KEY NOTES

- 1 TAMPER RESISTANT GFCI DUPLEX RECEPTACLE IN PUBLIC AREAS. EC SHALL PROVIDE HUBBELL GFTRST* (*": AL=ALMOND, BK=BLACK, BR=BROWN, GR=GRAY, IV=IVORY, LA=LIGHT ALMOND, RD=RED, WH=WHITE). SPECIFIED RECEPTACLE BECOMES DE-ENERGIZED UPON FAILURE OF GFCI DEVICE. NO SUBSTITUTIONS.(TYPICAL)
- 2 SEE POS ELECTRICAL RISER DIAGRAM ON SHEET E1.0. (TYPICAL)
- 3 SEE NOTE FLAT PANEL TELEVISION NOTE ON SHEET E3.1.

KEY NOTES

- 4 PER THE AMERICAN WITH DISABILITIES ACT ACCESSIBILITY GUIDELINES (ADAAG), A MINIMUM OF ONE (1) ADA COMPLIANT ELECTRICAL RECEPTACLE SHALL BE INSTALLED AT AN ACCESSIBLE TABLE. GC/EC SHALL REFERENCE FINAL DECOR PLANS AND PROVIDE RECEPTACLES AS NECESSARY FOR COMPLIANCE. (TYPICAL)
- 5 COORDINATE LOCATION OF RECEPTACLES SO THAT RECEPTACLES ARE LOCATED ON FULL HEIGHT WALLS PER THE DECOR PLAN. STUB UP AND CIRCUIT IN HALF WALL FOR RECEPTACLES NOT ON FULL HEIGHT WALLS. CONFIRM FINAL LOCATIONS WITH DECOR DRAWINGS PRIOR TO ROUGH-IN.
- 6 IF MOUNTED TO A LIGHTING POLE, DT CAMERA SHALL ONLY BE INSTALLED ON A POLE WITH MAXIMUM OF (2) LIGHTING HEADS. PROVIDE ISOLATION OF DT CAMERA MOUNTING HARDWARE AND POLE TO PREVENT BI-METALLIC OR GALVANIC CORROSION.
- 7 EC TO PROVIDE AN ALLOWANCE IN BID TO PROVIDE TWO(2) FLEXIBLE POWER CONNECTIONS FOR POWER TO FURNITURE. FAMILY EXPERIENCE ELEMENTS AS PART OF THE DECOR PACKAGE. EC SHALL IDENTIFY EXACT LOCATIONS IN FIELD AND WITH DECOR DRAWINGS. PROVIDE ALL NECESSARY MATERIALS AND SUPPORT FOR A COMPLETE AND FULL NEC CODE COMPLIANT INSTALLATION. ALL COMPONENTS SHALL BE FED FROM A GFCI TYPE CIRCUIT BREAKER AND BRANCH CIRCUIT SHALL CONTAIN TWO PATHS OF GROUNDING (CONDUIT BODY AND AN INSULATED GROUNDING CONDUCTOR) TO COMPLY WITH McDONALD'S GROUNDING STANDARDS.
- 8 DRIVE THRU WINDOW POWER, CONFIRM REQUIREMENTS WITH MANUFACTURER DRAWINGS.
- 9 PROVIDE POWER WITHIN CEILING FOR CONNECTION TO SELF ORDER KIOSKS. COORDINATE EXACT LOCATION OF KIOSKS WITH DECOR DRAWINGS. PROVIDE 2#12, 1#12 GRD., & 1#12 ISOLATED GROUND ON A 20A DEDICATED CIRCUIT FED FROM THE CP PANEL FOR EVERY ONE (1) DOUBLE SIDED OR TWO (2) SINGLE SIDED KIOSKS.
- 10 VERIFY DROP CORDS AND RECEPTACLES DO NOT FALL BELOW HEIGHTS LISTED ON E3.0 ELECTRICAL SCHEDULE. RECEPTACLES SHOULD BE LOCATED AT HEIGHTS TO AVOID CONTACT WITH HOT APPLIANCES.

11 PROVIDE J-BOX ABOVE CEILING NEAR KIOSK FOR FUTURE DIGITAL MERCHANDISER. EXTEND CIRCUIT TO THIS LOCATION FROM DIGITAL MERCHANDISER NEAR SERVICE AREA. EXTEND J-HOOKS FROM SERVICE AREA FOR FUTURE DATA CABLES.

12 CONTRACTOR TO PUNCH HOLES IN SERVICE POD FOR CABLE AND CONDUIT ROUTING. UTILIZE BUSHINGS PROVIDED WITH SERVICE POD TO PROTECT CABLES

13 PROVIDE A 5-20R RECEPTACLE FOR DELIVERY POD DOWNLIGHT, F12DP. INSTALL RECEPTACLE AT 7'-6" AFF. PROVIDE 2#12, 1#12GRD IN 1/2" C TO A 20A CIRCUIT FROM THE LP PANEL. REFER TO LIGHTING PLAN FOR CIRCUIT NUMBER.


SHEET NO.	TITLE	DRAWN BY	REVIEWED BY
015-0071.00.B	2019 STANDARD BUILDING - BB20	MRL	WLW
	4597F10-WOOD/WOOD		
	WOOD BEARING WALLS W/FIBER CEMENT SIDING & CI		
	WOOD ROOF TRUSS FRAMING		
	FIBER CEMENT PANEL/BATTEN/ALUMINUM/BRICK EXTER. FINISH		
	SITE ADDRESS		
015-0071	605 SOUTH 7TH STREET, KANSAS CITY, KS		
	REV 1975		
		BY DATE	
		12/03/20	
		11/13/20	USRD SAO SET REVIEW
		05/05/20	CIVIL & PLAN REVIEW COMMENTS
		01/23/20	PERMIT SET
		01/13/20	PROGRESS SET REVIEW
			REV DATE

emanuelson-podas
consulting engineers
Emmanuelson-Podas, Inc.
Edmond, OK 73034
(405) 930-0050 | www.eppc.com

McDonald's USA, LLC
3801.0037
Matthew W. Mulls
LIC# 17667
12/03/20

PREPARED BY:
© 2020 McDonald's USA, LLC

These drawings and specifications are the confidential and proprietary property of McDonald's USA, LLC and shall not be copied or reproduced without the express written consent of McDonald's USA, LLC. These drawings and specifications are issued in confidence and are not suitable for use on this specific site or on a later time. Use of these drawings for reference or example on another project requires the services of a properly licensed architect or engineer. Reproduction of the contract documents for reuse on another project is not authorized.

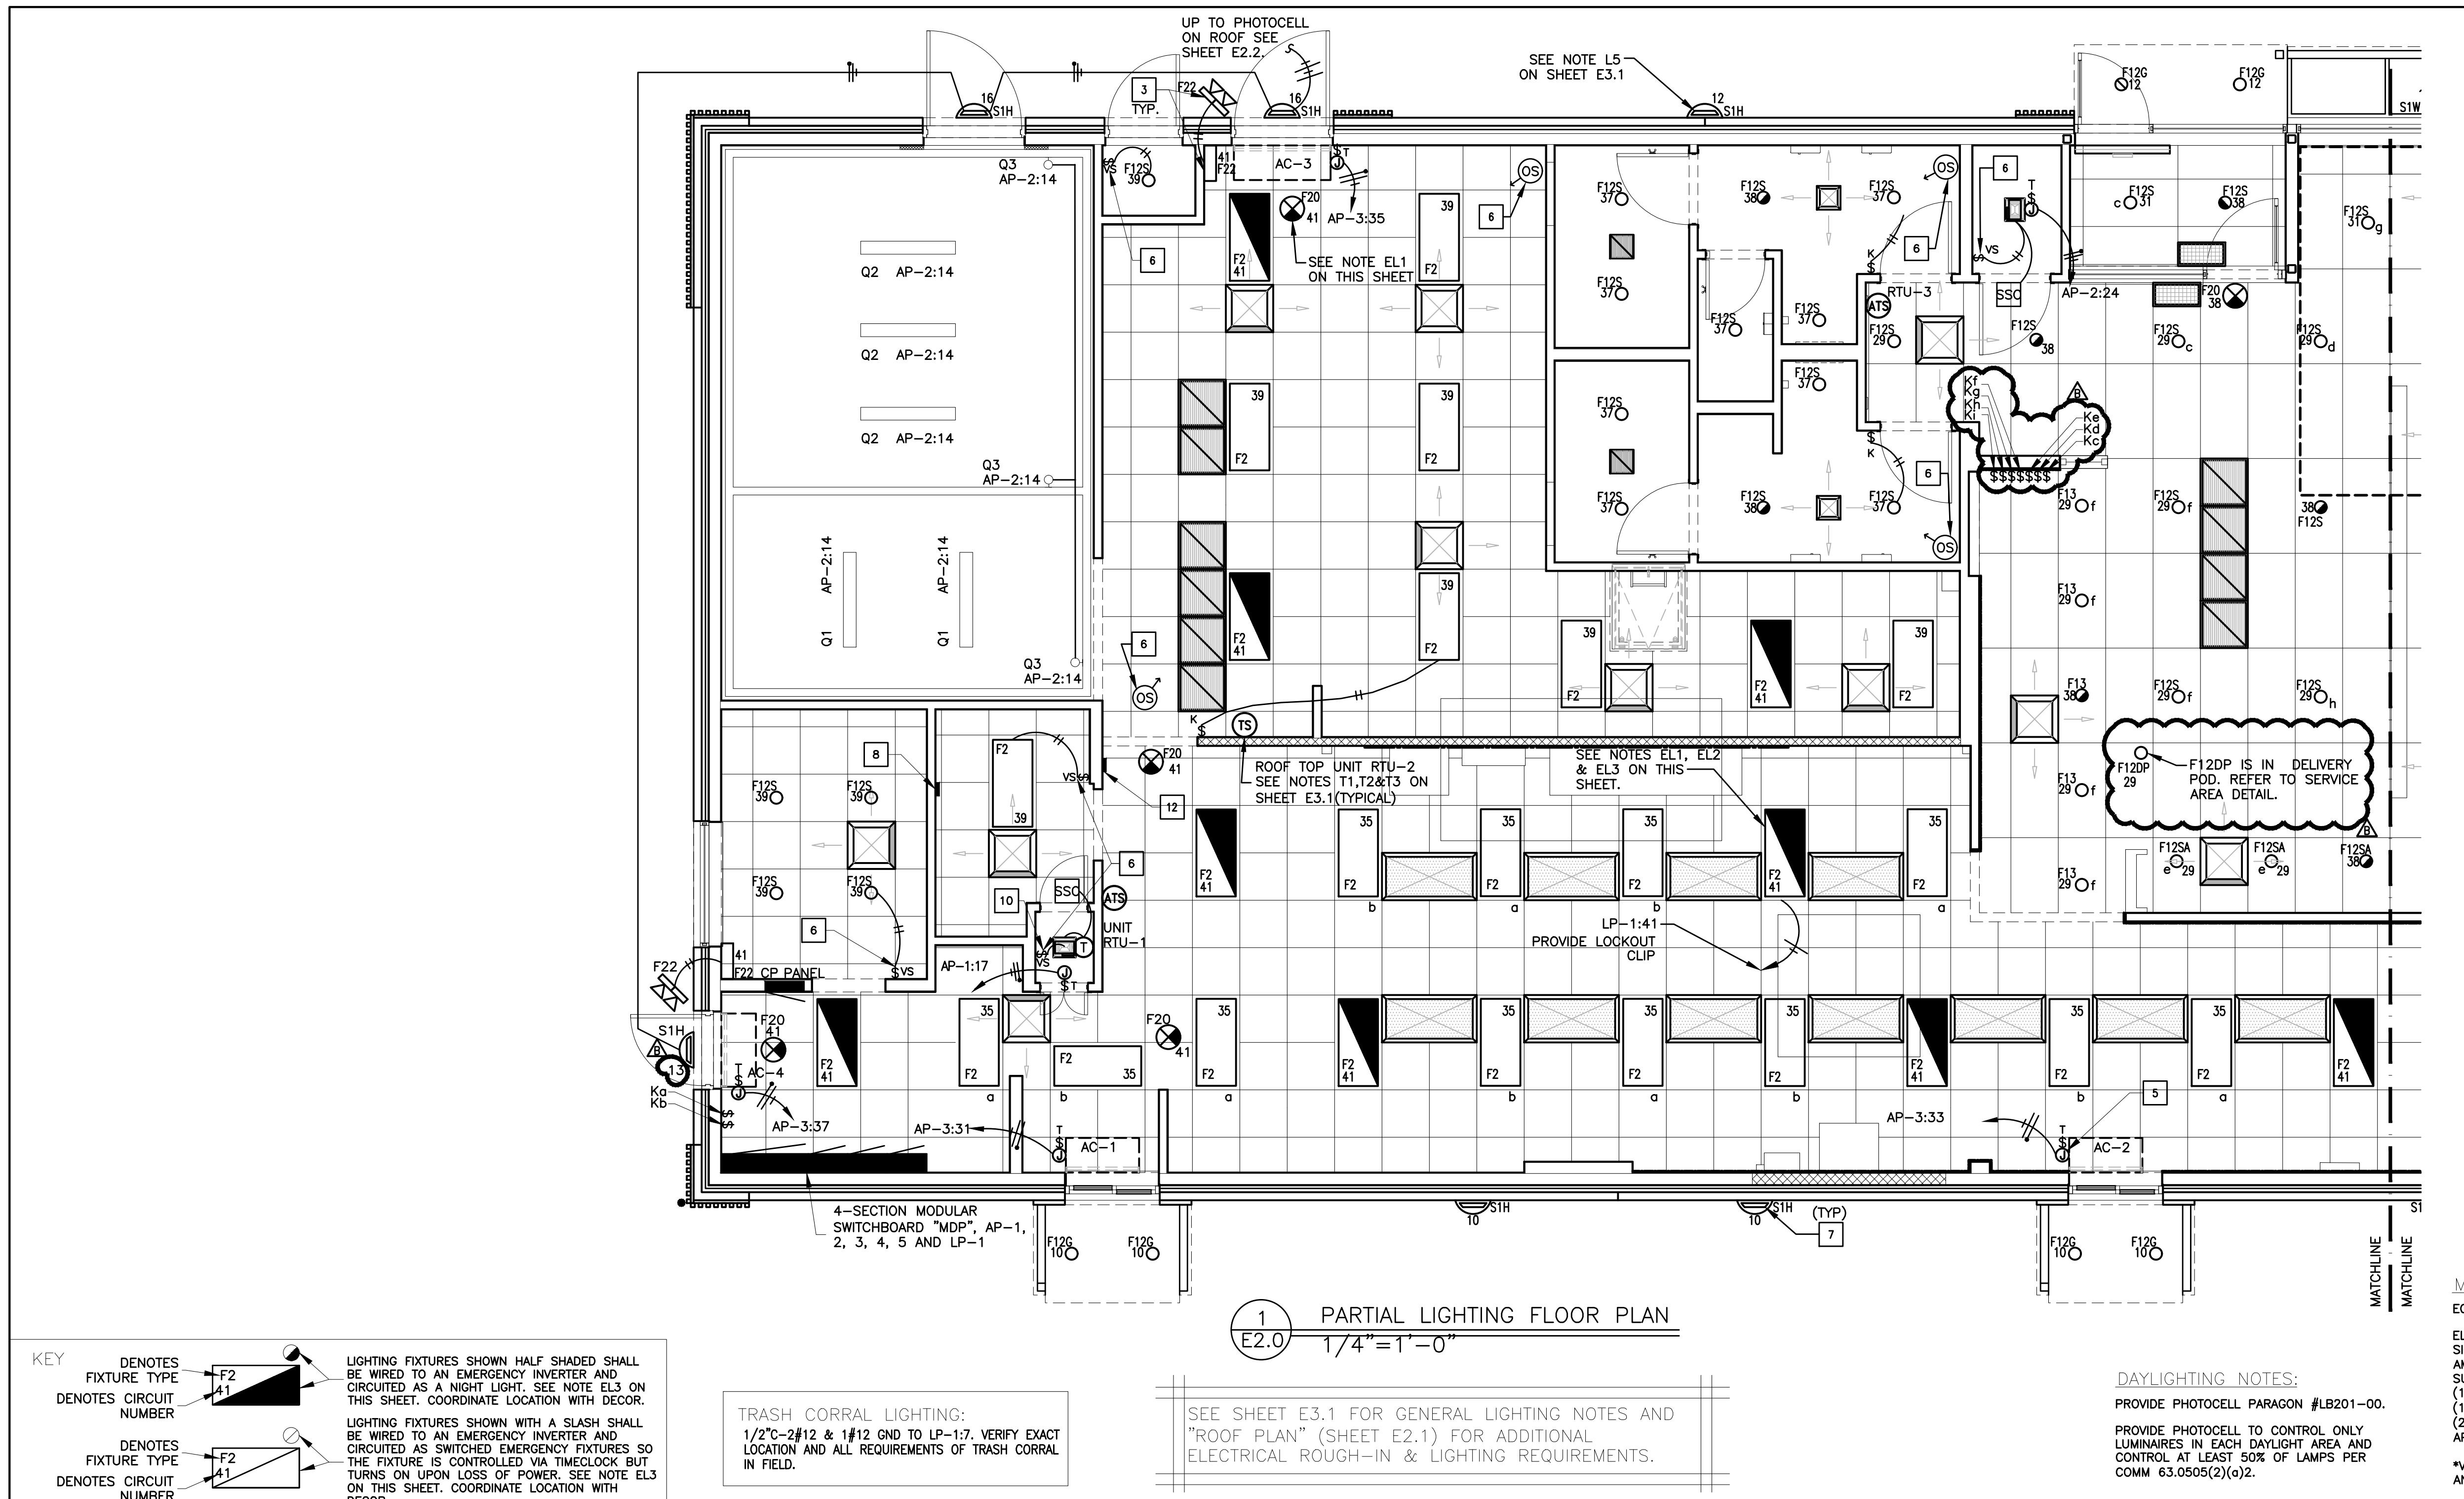

LIGHTING FIXTURE SCHEDULE:

MARK	SYMBOL	DESCRIPTION	DIFFUSER	LAMPS		BALLAST	MOUNTING	MANUFACTURER AND CATALOG NUMBER	Q1	REFRIGERATION LIGHTING	INTERNAL PRISMATIC LENS VAPOR TIGHT	81.1W	LED	-	SURFACE FREEZER/COOLER	METALUX 4VT2-LD4-8-DR-UNV-L835-CD1-WL-U
				WATTS	TYPE											
F2	□	2' X 4' GRID TROFFER	PRISMATIC ACRYLIC	44W	LED	-	RECESSED	SECURITY LIGHTING: # LCAT24-35HLC-EDU-WP-CK	Q2	REFRIGERATION LIGHTING	INTERNAL PRISMATIC LENS VAPOR TIGHT	38W	LED	-	SURFACE FREEZER/COOLER	METALUX 4VT2-LD4-4-DR-UNV-L835-CD1-WL-U
F12DP	○	4" LED DOWN LIGHT - GOLD TRIM - DELIVERY POD	9W	LED	-	RECESSED	SECURITY LIGHTING # LB4A-6LDDM-30K-9-GD/IBX4L-120	Q3	REFRIGERATION LIGHTING	INTERNAL PRISMATIC LENS VAPOR TIGHT	1-100	A16	-	SURFACE TO WALL FREEZER AND COOLER	KASON REFRIGERATION LIGHTING: 1802000002, WITH WIRE GUARD.	
F12G	○	6" LED DOWN LIGHT - SHALLOW HOUSING	12W	LED	-	RECESSED	SECURITY LIGHTING # LB6LEDA10L-50K-9-GD/RMNIC-QL	S1H	"DOWN ONLY" RADIAL WALL SCONCE - SILVER	TEMPERED GLASS	(1)-14W	LED	-	SURFACE TO WALL	SECURITY LIGHTING: #RWSC-36L-5K-D0-U-PS	
F12S	○	6" LED DOWN LIGHT	-	12W	LED	-	RECESSED	SECURITY LIGHTING # LB6LEDA10L-30K-9-SA/DBXOL-DM	S1W	"DOWN ONLY" RADIAL WALL SCONCE - WHITE	TEMPERED GLASS	(1)-14W	LED	-	SURFACE TO WALL	SECURITY LIGHTING: #RWSC-36L-5K-D0-U-WH
F12SA	○	6" LED ADJUSTABLE DOWN LIGHT	-	12W	LED	-	RECESSED	SECURITY LIGHTING # LB6LEDA10L-30K-9-SA/DBXOL-DM COORDINATE DOWN LIGHT TO BE USED IN DINING WITH PHOTOMETRIC								
F13	○	4" LED DOWN LIGHT	-	25W	LED	-	RECESSED	SECURITY LIGHTING # LF4SL-4LFSL20L-30K-SP-SL-DL-B24								
F14	○	ALPHABET PENDANT	-	(1)-8W	LED	-	PENDANT	SECURITY LIGHTING # MS-P-A-BM-108LED-CBC (TO BE VERIFIED WITH DECOR DRAWINGS)								
F20	○	EXIT SIGN WITH BATTERY BACKUP	-	1.8W	LED	-	SURFACE	SECURITY LIGHTING: EVEURWE. SEE NOTE LS2 ON THIS SHEET.								
F21	○	2 HEADED EMERGENCY BATTERY LIGHT	-	-	LED	-	SURFACE TO WALL OR CEILING	SECURITY LTG. #EV4D								
F22	○	EMER BATTERY & 2 REMOTE HEADS	-	-	LED	-	SURFACE TO WALL OR SOFFIT	SECURITY LTG. #EV4D-02L-0/EV0DB								
F23	○	2 HEADED EMERG LIGHT & 2 REMOTE HEAD IF REQ'D	-	-	LED	-	SURFACE TO WALL OR SOFFIT	SECURITY LTG. #EV4D/EV0DB								

LIGHTING SCHEDULE NOTES:

LS1. ORDER LED EXIT SIGNS WITH LETTER COLORS THAT COMPLY WITH LOCAL CODES.

- FOR RED LETTERS USE #EVE-U-R (UNIVERSAL),
- FOR GREEN LETTERS USE #EVE-U-G (UNIVERSAL), OR
IF THE ABOVE EXIT SIGNS DO NOT COMPLY WITH LOCAL CODES USE: LED SIGN WITH BATTERY BACKUP, LETTER SIZE, COLOR, TYPE & DIRECTIONAL ARROWS AS REQUIRED BY THE LOCAL AUTHORITIES.

LS2. ALL INTERIOR LIGHT FIXTURES SHALL BE 120 VOLT UNLESS NOTED OTHERWISE.

LS3. LIGHTING FIXTURES HAVE BEEN CHOSEN TO ACHIEVE MAXIMUM ENERGY CONSERVATION WHILE MAINTAINING ADEQUATE LEVEL OF ILLUMINATION. SPECIFICATIONS SHALL BE STRICTLY FOLLOWED. ANY DEVIATION FROM THE SPECIFICATIONS SHALL BE APPROVED IN WRITING BY McDONALD'S CORPORATION.

LS4. VERIFY DOWNLIGHT TO BE USED IN DINING WITH PHOTOMETRIC

ORDER ALL LIGHT FIXTURES FROM:

SECURITY LIGHTING SYSTEMS, INC.
PHONE: 1-800-LIGHT-IT
EMAIL: QUOTATIONS@SECURITYLIGHTING.COM

CS ILLUMINATIONS
PHONE: 760-477-1244
EMAIL: MCD@CSILLUMINATIONS.COM
WWW.CSILLUMINATIONS.COM/MCD

TITLE	2019 STANDARD BUILDING - BB20	STD ISSUE DATE	2019-11	REVIEWED BY	WLW
DESCRIPTION	4597F10-WOOD/WOOD	DATE ISSUED	01-23-20		
SITE ID	015-0071.00.B	SITE ADDRESS	605 SOUTH 7TH STREET, KANSAS CITY, KS		
SHEET NO.	E2.0	FILE NUMBER	R0f1975		
PREPARED BY:	McDonald's USA, LLC	PREPARED FOR:	McDonald's USA, LLC	© 2020 McDonald's USA, LLC	These drawings and specifications are the confidential and proprietary property of McDonald's USA, LLC and shall not be copied or reproduced without the express written consent of McDonald's USA, LLC. These drawings and specifications are intended for use on this specific site in conjunction with the issuance date and are not suitable for use on a different site or at a later time. Use of these drawings for reference or example on another project requires the services of properly licensed architects and engineers. Reproduction of the contract documents for reuse on another project is not authorized.
KEY NOTES	<p>1 CENTER PENDANT LIGHTS OVER TABLES (TYPICAL)</p> <p>2 ALL SOFFIT LOCATIONS, LIGHTING, & SUPPLY GRILLS SHALL BE COORDINATED WITH DECOR COMPANY DRAWING PRIOR TO INSTALLATION.</p> <p>3 EC SHALL INSTALL AND CONFIGURE REMOTE EMERGENCY LIGHTING AT ALL EGGS EXTERIOR DOORS FOR MAXIMUM ILLUMINATION AT POINTS OF EGGS. INSTALL WP J-BOX WITHIN SOFFIT TO ALLOW A FLUSH INSTALLATION OF ANY EXTERIOR EMERGENCY EGGS (TYPICAL).</p> <p>4 OPTIONAL ADJUSTABLE WALL WASH FIXTURE TO ILLUMINATE LOGO OR GRAPHICS. EC SHALL VERIFY EXACT LOCATION SO AS TO ADEQUATELY ILLUMINATE McDONALD'S ARCH LOGO SIGN AND GRAPHICS.</p> <p>5 AIR CURTAIN UNIT, NON HEATED VERSION TO USE 1/2" C, 2#12, 1#12GRD. HEATED VERSION TO USE 1" C, 2#6, 1#10 GRD. (TYPICAL).</p> <p>6 PROVIDE DUAL TECHNOLOGY OCCUPANCY SENSOR OR VACANCY SENSOR SWITCH AS SHOWN, ORDER ALL SENSORS FROM: SECURITY LIGHTING SYSTEMS, INC.</p> <p>7 RADIAL WALL SCONCE. SEE NOTE L2 ON SHEET E3.1 AND ARCHITECTURAL ELEVATIONS ON SHEETS A2.0 & A2.1. (TYPICAL)</p> <p>8 BUILDING AUTOMATION SYSTEM LOCATION. SEE LIGHTING CONTROL DETAILS ON SHEET E4.1.</p> <p>9 PROVIDE DUAL-LITE LIGHTING INVERTER MODEL #LG125T FOR USE WITH TYPE F12S, F12SA & F12O FIXTURES SHOWN SHADED OR SLASHED. EC SHALL FIELD VERIFY EXACT QUANTITY AND LOCATION OF DEVICE PROVIDED. INSTALLATION OF EACH SLASHED QUANTITY OF FIXTURES THAT CAN BE CONNECTED TO INVERTER WITHOUT EXCEEDING OPERATING CAPACITY OF UNIT AND PROVIDE ADDITIONAL CIRCUITS AND INVERTERS AS REQUIRED. (TYPICAL)</p> <p>10 CENTER VACANCY SENSOR SWITCH OPPOSITE COMPUTER RACK IN A LOCATION ACCESSIBLE FROM BOTH DOORS FOR CONTROL OF CEILING MOUNTED LIGHT, IN DATA ROOM. FAN CONTROLLED BY LOCAL THERMOSTAT.</p> <p>11 PROVIDE POWER FOR LIGHT WITHIN TOY DISPLAY. COORDINATE EXACT LOCATION WITH DECOR DRAWINGS.</p> <p>12 LIGHTING CONTACTORS IN NEMA 1 ENCLOSURE JUST BELOW CEILING. EC SHALL FIELD VERIFY 120 VOLT CONTROL CIRCUIT TO CONTACTOR PANEL. VERIFY EXACT LOCATION IN FIELD AND REFER TO DRAWING E4.1 FOR ADDITIONAL DETAILS.</p>				

emmanuelson-podas
consulting engineers
3801.0037

Matthew W. Ellis
LIC# 17667
KANSAS
PROFESSIONAL ENGINEER
12/03/20


PREPARED BY:
McDonald's USA, LLC

These drawings and specifications are the confidential and proprietary property of McDonald's USA, LLC and shall not be copied or reproduced without the express written consent of McDonald's USA, LLC. These drawings and specifications are intended for use on this specific site in conjunction with the issuance date and are not suitable for use on a different site or at a later time. Use of these drawings for reference or example on another project requires the services of properly licensed architects and engineers. Reproduction of the contract documents for reuse on another project is not authorized.

PB = Pullbox
JB = Junction Box
EC = Electrical Contractor
VIF = Verify in Field

TAG #	QTY	DESCRIPTION	VOLT/PH	FLA	BRK SIZE	COND/WIRE	PNL/CCT	RECEP TYPE	HGT AFF	REQUIREMENTS & REMARKS
701.13E9	5	DCO - GENERAL PURPOSE	120/1	1.5	20A	1/2C-2#12	AP-2:42	5-20R	1'-6"	-
701.14E1	1	TELEPHONE	PHONE BOX	-	-	-	-	RJ-11C JACK	4'-6"	-
701.14E3	1	TELEPHONE	PHONE BOX	-	-	-	-	RJ-11C JACK	3'-6"	-
701.15E1	1	DOOR BUZZER	120/1	.5	20A	1/2C-2#12	LP-1:16	-	8'-0"	CONNECT TRANSFORMER TO POWER & ROUTE LOW VOLTAGE WIRES OVERHEAD TO DOOR BUTTON
701.16E1	2	DOOR ALARM	120/1	.5	20A	1/2C-2#12	LP-1:16	JB	SEE RMKS	JUNCTION BOX ABOVE CEILING, PROVIDE LOCKOUT ON CIRCUIT BREAKER HANDLE.
701.22E1	1	WAYPORT - WIRELESS INTERNET SERVER	120/1 ISOLATED	1.5	20A	1/2C-2#12IG	CP:2	IG5262	8'-0"	-
701.22E2	1	WAYPORT - WIRELESS INTERNET SERVER	DATA CABLE	-	-	-	-	JB	8'-0"	EXTEND 1" CONDUIT ABOVE CLG. W/BUSHING FOR DATA CABLE
701.27E1	1	DCO-SATELLITE MUSIC SYSTEM	120/1	1.0	20A	1/2C-2#12	AP-3:6	(2) 5-20R	3'-0"	PROVIDE DOUBLE DUPLEX WALL PLATE
701.32E1	1	REMOTE ORDER TAKER BATTERY PACK	120/1	2.0	20A	1/2C-2#12	AP-1:9	(2) 5-20R	4'-6"	PROVIDE DOUBLE DUPLEX WALL PLATE. FIELD VERIFY HEIGHT AND LOCATION WITH ACM
701.34E1	1	ACCESS CONTROL PANEL	120/1	2.0	20A	1/2C-2#12	LP-1:16	JB	8'-0"	ROUTE LOW VOLTAGE WIRES TO DOOR BUTTON, HORN AND DOOR STRIKE AS REQUIRED


ELECTRICAL SCHEDULE

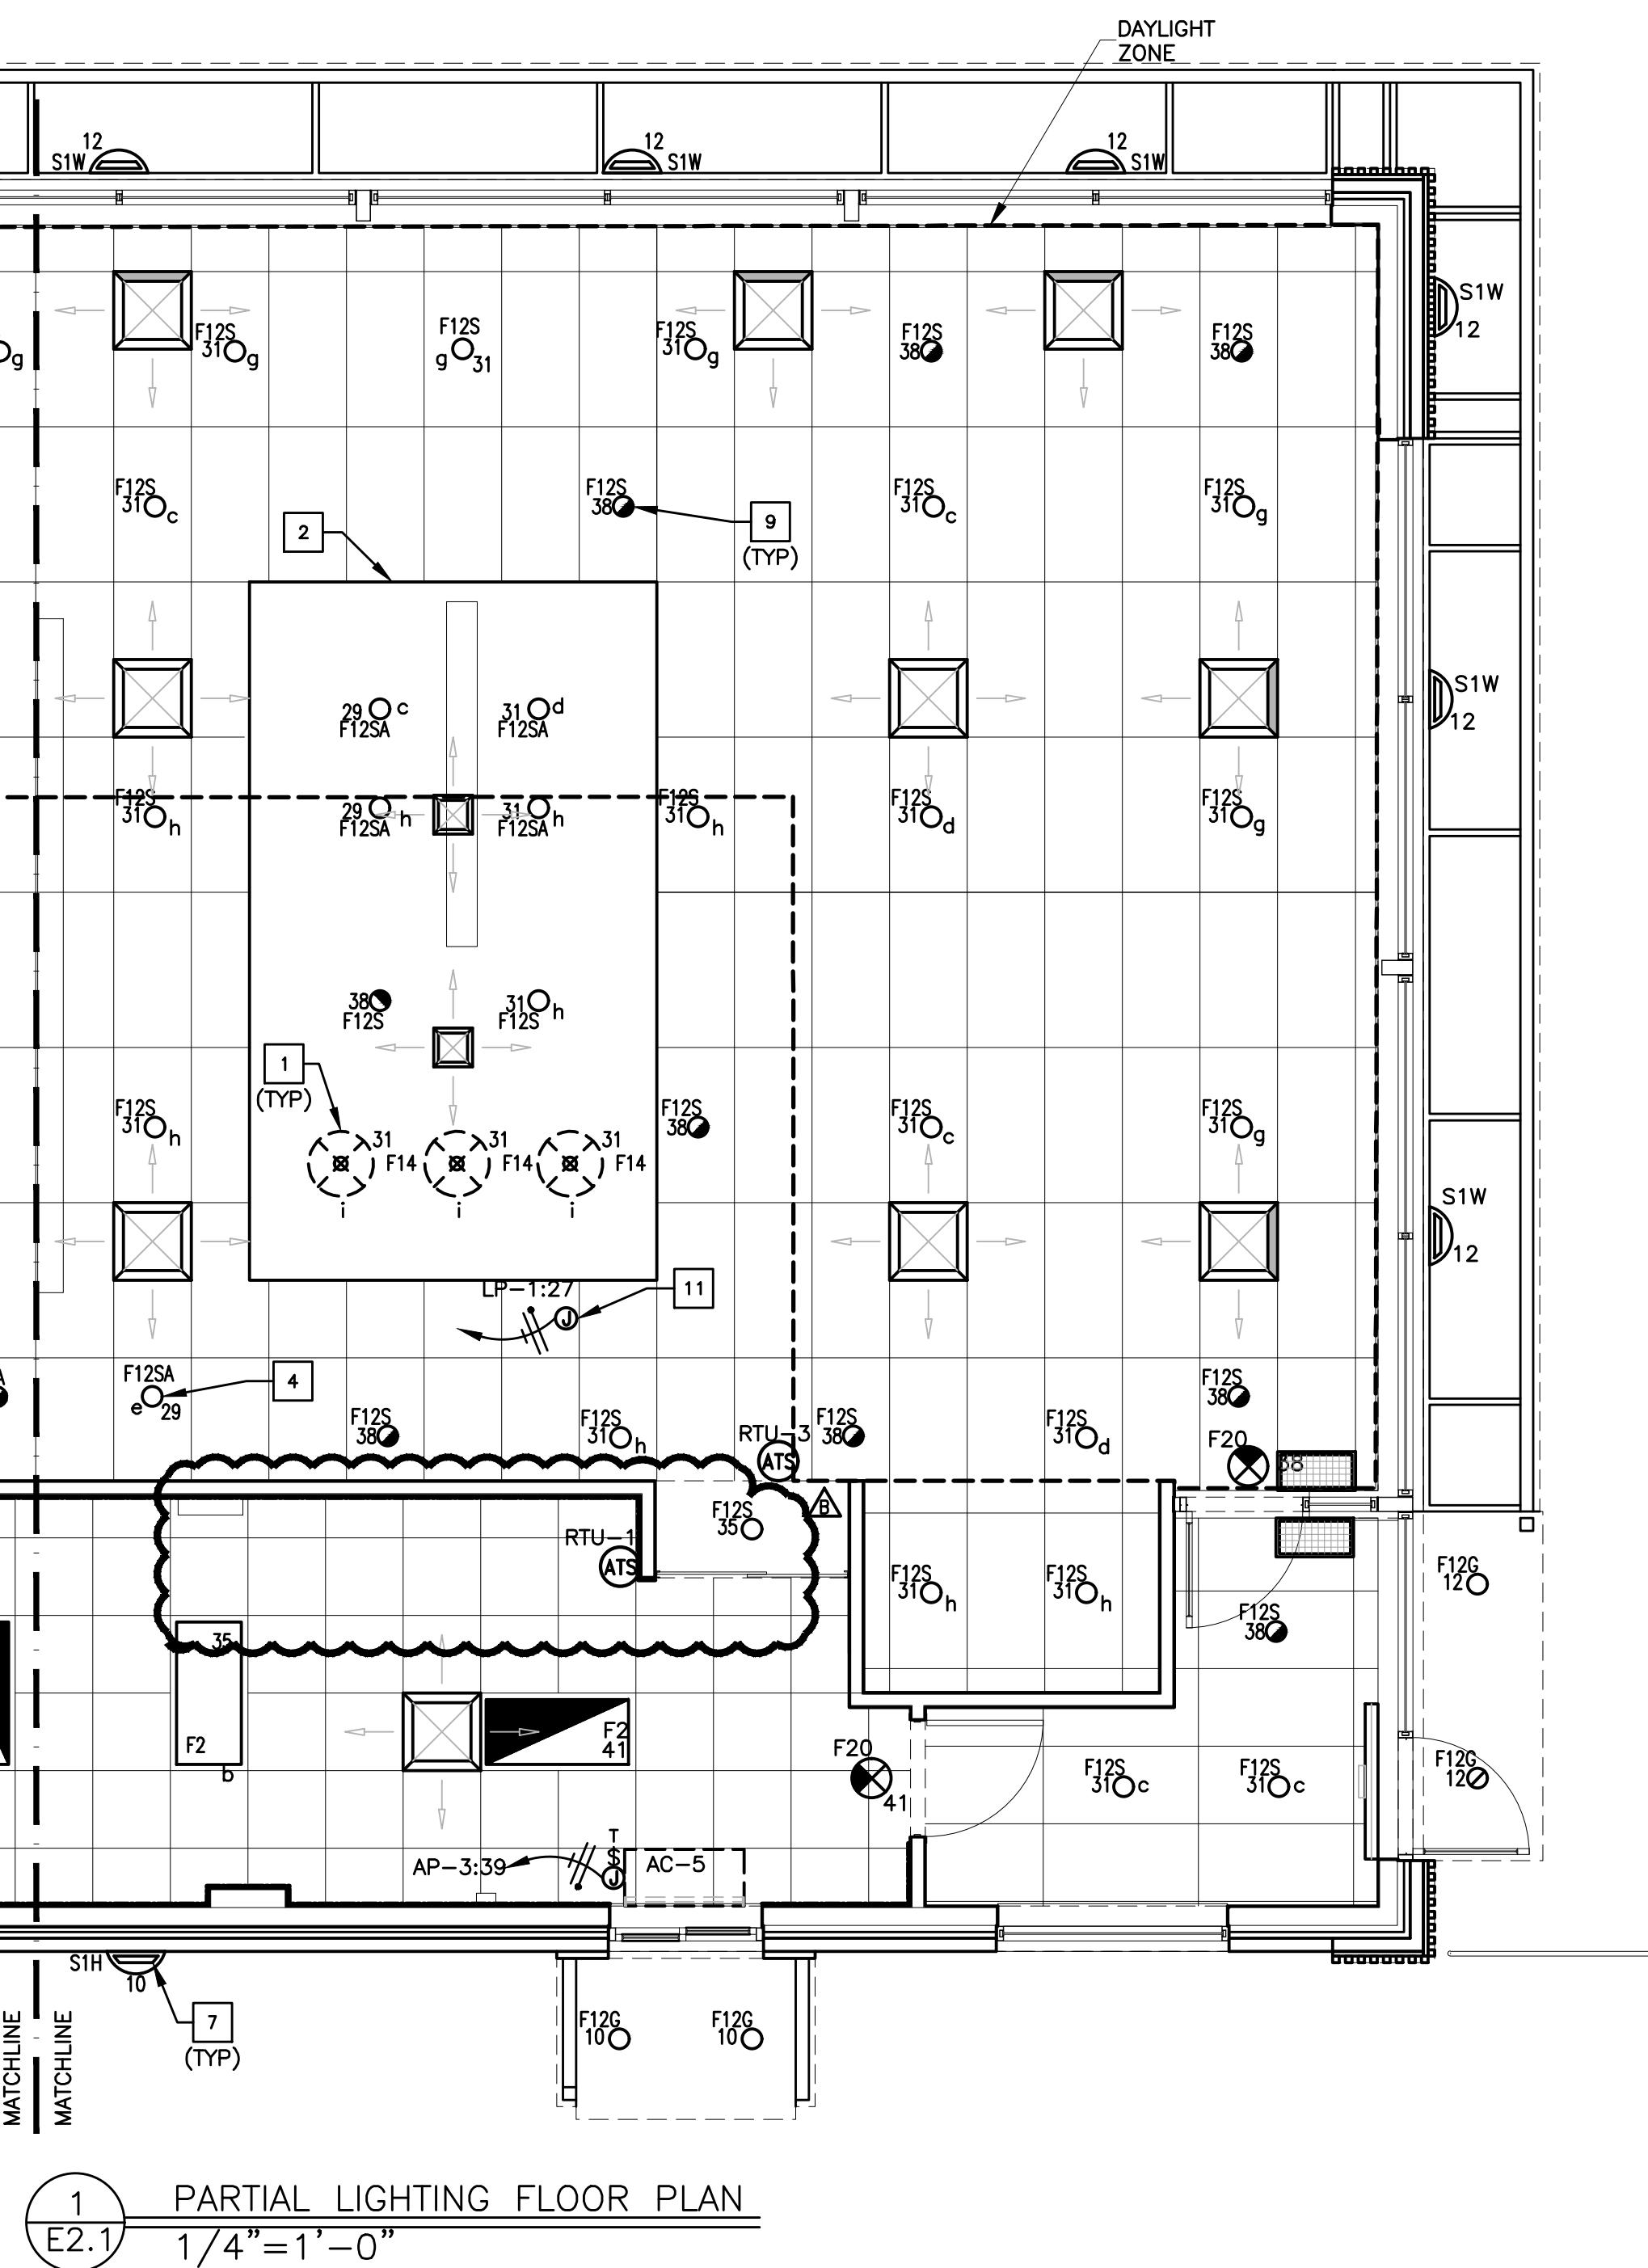

1
E2.1
1/4"=1'-0"

PARTIAL LIGHTING FLOOR PLAN

SHEET NO.	TITLE	DRAWN BY		PREPARED BY:	
015-0071.00.B	2019 STANDARD BUILDING - BB20 4597F10-WOOD/WOOD	MRL MRL		McDonald's USA, LLC	
		STD ISSUE DATE	2019-11	REVIEWED BY	W.L.W.
				DATE ISSUED	01-23-20
		DESCRIPTION		W.L.W. WOOD BEARING WALLS W/FIBER CEMENT SIDING & CI WOOD ROOF TRUSS FRAMING FIBER CEMENT PANEL/BATTEN/ALPOLIC PANEL/BRICK EXT. FINISH	
		SITE ID	SITE ADDRESS	REFER TO E2.0 FOR NOTES. SEE SHEET E3.1 FOR GENERAL LIGHTING NOTES AND "ROOF PLAN" (SHEET E2.2) FOR ADDITIONAL ELECTRICAL ROUGH-IN & LIGHTING REQUIREMENTS.	
015-0071	605 SOUTH 7TH STREET, KANSAS CITY, KS	REV#19175	E2.1	BY	

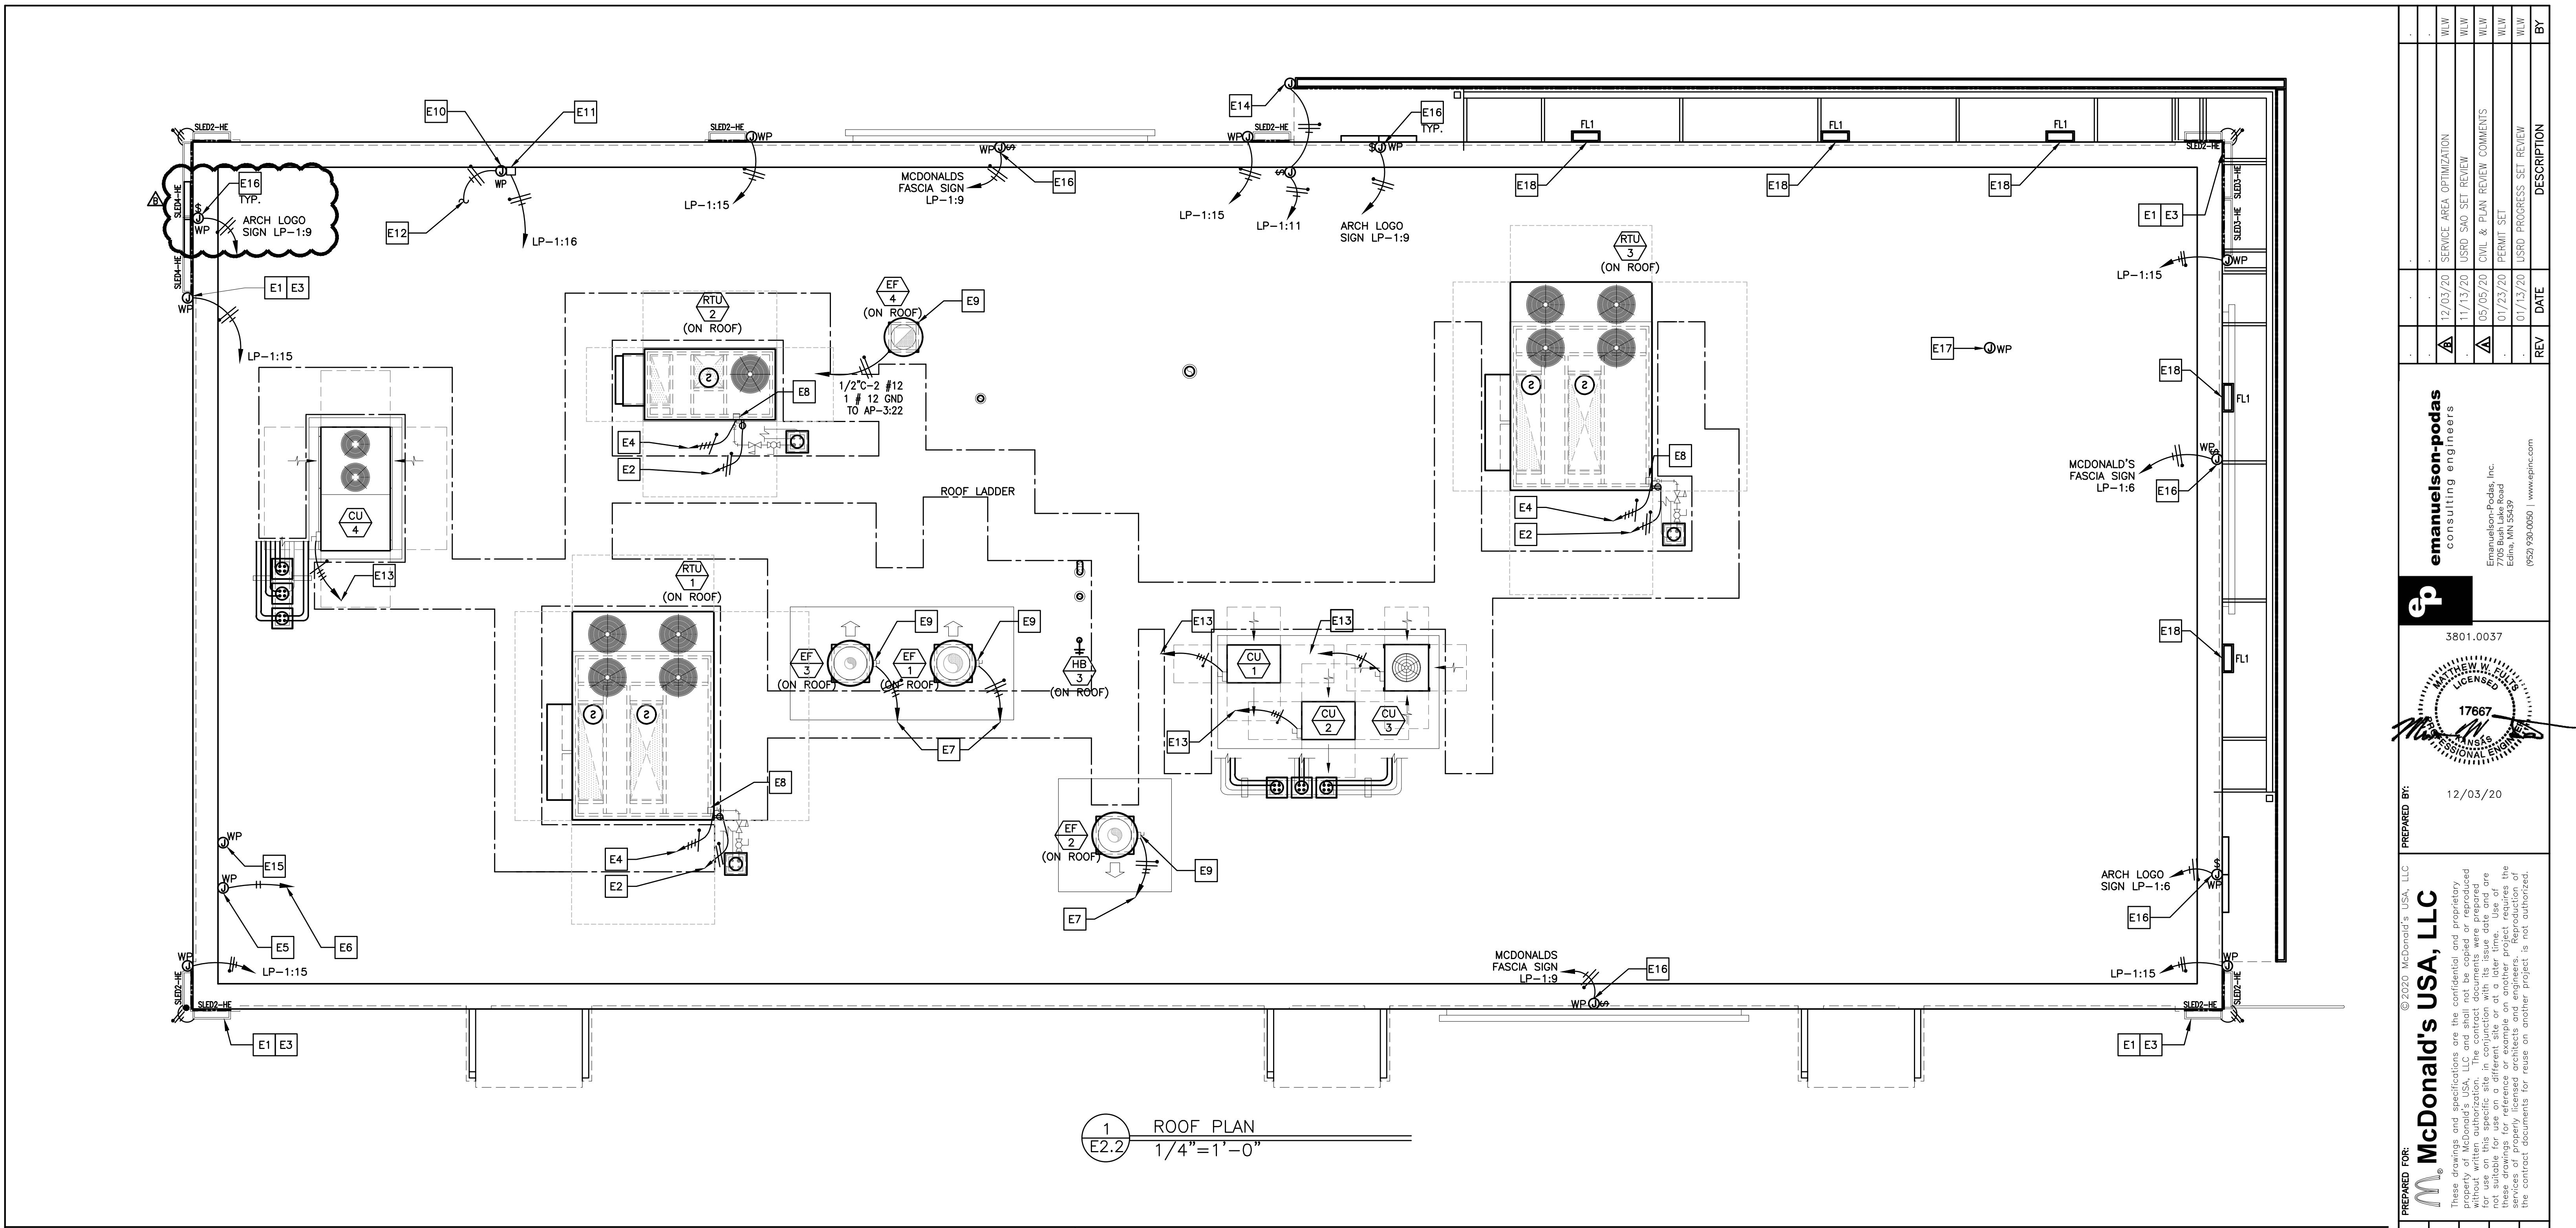

KEYED NOTES

- E1 EVERY LINEAR RUN OF SLED FIXTURES REQUIRES A DEDICATED WHIP KIT PROVIDED WITH FIXTURE. CONTRACTOR TO FIELD VERIFY FIXTURE MOUNTING HEIGHT, LOCATION, QUANTITY, FIXTURE LENGTHS, AND ALL ELECTRICAL CONNECTION REQUIREMENTS WITH SECURITY LIGHTING PRIOR TO ORDERING AND INSTALLATION (TYPICAL).
- E2 WEATHER PROOF RECEPTACLES WITH GFCI PROTECTION ARE PROVIDED AND MOUNTED WITHIN MOTOR HOUSING LOCATIONS PER NEC ARTICLE 210.63. CIRCUIT SHALL EMANATE FROM PANEL AP-3,CCT.#34.(TYPICAL).
- E3 SMOOTH BRACING IS REQUIRED FOR LED FIXTURE INSTALLATION UNDER COPING/FLASHING.(TYPICAL)
- E4 REFER TO SHEET E4.0 FOR CONDUIT AND WIRE SIZE.(TYPICAL)
- E5 E.C. SHALL PROVIDE A WEATHER-PROOF J-BOX ON INSIDE FACE OF PARAPET, MOUNTED 6" BELOW TOP OF PARAPET FOR LIGHTING CONTROL PANEL PHOTOCELL. (PHOTOCELL FURNISHED BY OTHERS AND INSTALLED BY EC). REFER TO LIGHTING CONTROL DETAILS ON E4.1
- E6 TO LIGHTING ENCLOSURE W/ TIMER. COORDINATE WITH LIGHTING CONTROL DETAILS ON SHEET E4.1
- E7 COOKING EQUIPMENT EXHAUST FANS. SEE SHEET E3.0 FOR ELECTRICAL REQUIREMENTS. SEE SHEET E3.2 FOR EXHAUST FAN INTERLOCK WIRING DIAGRAMS. (TYPICAL)
- E8 PROVIDE NEMA 3R DISCONNECT WITH CURRENT LIMITING FUSES TO COMPLY WITH NEC 110 AND 440. ELECTRICAL CONTRACTOR SHALL STUB UP THRU RACEWAY IN CURB TO ELIMINATE CONDUIT PENETRATION OF ROOFING. (TYPICAL)
- E9 EXTERNAL NEMA 3R MOUNTED ON SIDE OF FAN BY MANUFACTURER. ELECTRICAL CONTRACTOR SHALL STUB UP THRU ROOF AND PROVIDE FLEXIBLE WEATHERPROOF CONDUIT FROM ROOF PENETRATION TO DISCONNECT (TYPICAL).
- E10 E.C. SHALL PROVIDE A WEATHER-PROOF JUNCTION BOX ON INSIDE FACE OF PARAPET FOR PHOTOCELL INSTALLATION. MOUNT JB 6" BELOW TOP OF PARAPET. PHOTOCELL FURNISHED AND INSTALLED BY EC. MOUNT FACING NORTH.
- E11 PHOTOCELL ON ROOF (SEE SHEET E2.0 FOR CONTINUATION AT DOOR LOCATIONS).
- E12 TO SOFFIT LIGHT FIXTURES NEAR DOORS. SEE SHEET E2.0 FOR CONTINUATION. TYPICAL FOR CCT LP-1:16.
- E13 REMOTE CONDENSING UNITS. SEE SHEET E3.0 FOR WIRING AND CIRCUITRY REQUIREMENTS.
- E14 CANOPY LIGHT. LP-1:11 EC SHALL VERIFY EXACT SPECIFICATIONS AND LOCATION WITH MANUFACTURER. REMOTE POWER SUPPLIES ABOVE ACCESSIBLE CEILING WITHIN VESTIBULE. VERIFY EXACT INFEEF REQUIREMENTS IN THE FIELD. SEE NOTE L5 ON SHEET E3.1. (TYPICAL)
- E15 E.C. SHALL PROVIDE A WEATHER-PROOF JUNCTION BOX WITH 3/4" STUB DOWN TO CEILING SPACE WITH BUSHING FOR ROOF-TOP CAMERA OR SATELLITE. VERIFY EXACT LOCATION(S) WITH MCD AREA CONSTRUCTION MANAGER PRIOR TO INSTALLATION.
- E16 E.C. SHALL PROVIDE A JUNCTION BOX FOR ARCH LOGO / McDONALD'S FASCIA / PLAY-PLACE SIGN. SEE NOTE L1 ON SHEET E3.1. COORDINATE EXACT LOCATION IN FIELD WITH ACM. ALL SIGNS PROVIDED WITH INTEGRAL DISCONNECT SWITCH FROM MANUFACTURER.(TYPICAL)
- E17 E.C. SHALL PROVIDE A JUNCTION BOX FOR ROOF-TOP FLAG POLE LIGHTING. VERIFY LOCATION(S) WITH MCD PROJECT MANAGER PRIOR TO INSTALLATION.
- E18 FLOOD LIGHT MOUNTED ABOVE CANOPY. LP-1:11 EC SHALL VERIFY EXACT SPECIFICATIONS AND LOCATION WITH ARCHITECTURAL ELEVATIONS. VERIFY EXACT INFEEF REQUIREMENTS IN THE FIELD. SEE FLOOD LIGHT DETAIL ON SHEET E3.1. (TYPICAL)

DRAWING NOTES


1. SEE DRAWING M-4.0 FOR GENERAL MECHANICAL NOTES.
2. SEE DRAWINGS M-3.0 AND M-4.1 FOR MECHANICAL EQUIPMENT SCHEDULES AND DETAILS.
3. SEE DRAWING M-4.0 FOR MECHANICAL LEGEND.
4. SEE DRAWING K-2.1 FOR REMOTE CONDENSER AND MAC UNIT INFORMATION.
5. SEE ELECTRICAL DRAWINGS FOR ADDITIONAL INFORMATION.

LED FIXTURE SCHEDULE:

MARK	SYMBOL	DESCRIPTION	DIFFUSER	LAMPS WATTS PER Fixture	BALLAST	MOUNTING	MANUFACTURER AND CATALOG NUMBER
SLED3	■	DOWN ONLY ACCENT LIGHTING (SEE PLAN)	TEMPERED GLASS	1-30W PER Fixture	LED	-	SECURITY LIGHTING: SLED-HE-36-DO-U-I0-C16 CUSTOM BUILT FOR EXTERIOR ACCENT CHANNELS.
SLED2-HE	■	DOWN ONLY ACCENT LIGHTING (SEE PLAN)	TEMPERED GLASS	1-10W PER Fixture	LED	-	SECURITY LIGHTING: SLED-HE-24-DO-U-I0 CUSTOM BUILT FOR EXTERIOR ACCENT CHANNELS.
SLED3-HE	■	DOWN ONLY ACCENT LIGHTING (SEE PLAN)	TEMPERED GLASS	1-14W PER Fixture	LED	-	SECURITY LIGHTING: SLED-HE-36-DO-U-I0 CUSTOM BUILT FOR EXTERIOR ACCENT CHANNELS.
SLED4-HE	■	DOWN ONLY ACCENT LIGHTING (SEE PLAN)	TEMPERED GLASS	1-19W PER Fixture	LED	-	SECURITY LIGHTING: SLED-HE-48-DO-U-I0 CUSTOM BUILT FOR EXTERIOR ACCENT CHANNELS.
FL1	■	UP ONLY ACCENT LIGHTING (SEE PLAN)	TEMPERED GLASS	1-16W PER Fixture	LED	-	SECURITY LIGHTING: EL218-W-5-8L-5K-UV-I0-JW10

TITLE	2019 STANDARD BUILDING - BB20	DRAWN BY	MRL
DESCRIPTION	WOOD BEARING WALLS W/ FIBER CEMENT SIDING & CI	STD ISSUE DATE	2019-11
DESCRIPTION	WOOD ROOF TRUSS FRAMING	REVIEWED BY	WLW
DESCRIPTION	FIBER CEMENT PANEL/BATTEN/ALPOLIC PANEL/BRICK EXC. FINISH	DATE ISSUED	01-23-20
SITE ID	015-0071.00.B	SITE ADDRESS	605 SOUTH 7TH STREET, KANSAS CITY, KS
SHEET NO.	E2.2	REV #	1975

PB	Pullbox	VIF	Verify in Field	ELECTRICAL SCHEDULE											PB	Pullbox	VIF	Verify in Field	ELECTRICAL SCHEDULE												
JB	Junction Box															JB	Junction Box														
EC	Electrical Contractor																EC	Electrical Contractor													
TAG #	QTY	DESCRIPTION	VOLT/PH	FLA	BRK SIZE	COND/WIRE	PNL/CCT	RECEP TYPE	HGT AFF	REQUIREMENTS & REMARKS		TAG #	QTY	DESCRIPTION	VOLT/PH	FLA	BRK SIZE	COND/WIRE	PNL/CCT	RECEP TYPE	HGT AFF	REQUIREMENTS & REMARKS									
004.20E6	1	DIGITAL MERCHANTISER	120/1 ISOLATED	2.6	20A	1/2C-2#12G	CP:6	IG5262	6'-5"	-		197.01E	1	HAND WASH TIMER	120/1	0.1	20A	1/2C-2#12	AP-1:33	5-20R	4'-6"	-									
004.20E7	1	MENU BOARD - DIGITAL	120/1 ISOLATED	2.6 EACH	20A	1/2C-2#12G	CP:6	(2) IG5262	6'-2"	-		203.02E1	1	HEAT TREAT COMBINATION SHAKE/SUNDAE MACHINE	208/3	35.0	45A	3/4C-3#6	AP-1:(18,20,22)	4x4x4 PB	1"-0"	RECEP #4609R BY KES, IF CARPIGNANI K3 IS ORDERED USE A 30A BRKR & #10 CONDUCTORS - EC MAKES FINAL CONN									
004.21E1	1	MENU BOARD - DIGITAL - MEDIA PLAYER	120/1 ISOLATED	1.0 EACH	20A	1/2C-2#12G	CP:6	(2) IG5262	7"-9"	EC TO MOUNT OUTLETS HORIZONTALLY		205.08E1	1	BIC MACHINE	120/1	8.6	20A	1/2C-2#12	AP-2:29	BY KES	SEE RMKS	EC TO EXTEND DEDICATED CIRCUIT TO 5-20R RECEPACLE IN CHASE									
004.21E2	1	MENU BOARD - DIGITAL - MEDIA PLAYER	DATA CABLE	-	-	-	-	JB	9"-0"	JB W/ 2-1/2" C. TO TERMINATE ABOVE CEILING W/BUSHINGS. FOR DATA CABLES. SUPPLY W/GROMMETED OPENING IN COVER PLATE		206.09E2	1	FROZEN BEVERAGE DISPENSER	208/1	20.0	30A	1/2C-2#10	AP-4:(17,19)	SEE RMKS	SEE RMKS	RECEP L-6-30R IN CHASE BY KES, EC MAKES FINAL CONN									
004.21E3	1	MENU BOARD - DIGITAL - MEDIA PLAYER	DATA CABLE	-	-	-	-	JB	7"-9"	JB W/ 2-1/2" C. TO TERMINATE ABOVE CEILING W/BUSHINGS. FOR DATA CABLES. SUPPLY W/ GROMMETED OPENING IN COVER PLATE		209.06E1	1	McDELIVERY CENTER	120/1	8.0	20A	1/2C-2#12	AP-4:18	5-20R	2"-0"	SEE RMKS	EC TO EXTEND BASE AND COUNTERTOP UNIT								
004.23E1	1	DIGITAL MERCHANTISER - MEDIA PLAYER	120/1 ISOLATED	1.0	20A	1/2C-2#12G	CP:6	IG5262	6'-5"	USE SAME RECEPACLE AS 4.20E6		210.00E10	1	CASH RECYCLER	120/1	4.5	20A	1/2C-2#12G	CP:23	(2) IG5262	SEE RMKS	PROVIDE RECEP. IN COUNTER-MOUNTED RACEWAY									
004.23E2	1	DIGITAL MERCHANTISER - MEDIA PLAYER	DATA CABLE	-	-	-	-	JB	6'-5"	JB W/ 1" C. TO FULL HEIGHT WALL AND TO ABOVE CEILING W/BUSHINGS. FOR DATA CABLES. SUPPLY W/GROMMETED OPENING IN COVER PLATE		213.00E11	1	TABLE LOCATOR SYSTEM	120/1	2.6	20A	1/2C-2#12G	CP:4	SEE RMKS	SEE RMKS	EC TO EXTEND CIRCUIT BELOW SLAB TO NEAREST FULL HEIGHT WALL. PROVIDE IG5262 RECEP. IN COUNTER-MOUNTED RACEWAY									
009.15E1	1	UTILITY CHASE - FFDT INTERIOR WALL	-	-	-	-	-	-	-	SEE RMKS	UTILITY CHASE AND RECEPACLES PROVIDED BY K.E.S.		213.00E12	1	TABLE LOCATOR SYSTEM	120/1	2.6	20A	1/2C-2#12G	CP:21	SEE RMKS	SEE RMKS	TSS SERVER, COORDINATE WITH MANUFACTURERS REQUIREMENTS								
010.10E1	1	CO2 DRIVEN KETCHUP DISPENSER	-	-	-	-	-	JB	10"	FOR CO2 LINE TO KETCHUP DISP. IF CHASE IS NOT SPECIFIED. SEE P1.6		214.00E2	1	CREW VIDEO	120/1	3.0	20A	1/2C-2#12G	CP:24	IG5262	5"-0"	-									
012.03E4	1	BAKED GOODS DISPLAY CASE - 14"	120/1	2.5	15A	1/2C-2#12	AP-3:1	5-15R	SEE RMKS	EC TO EXTEND CIRCUIT BELOW SLAB TO NEAREST FULL HEIGHT WALL, PROVIDE RECEP. IN COUNTER-MOUNTED RACEWAY		214.02E1	1	TECHNOLOGY RACK	120/1	5.0	20A	1/2C-2#12G	CP:11	IG4700	7"-6"	FOR SWITCHES, HUBS AND DRIVE-THRU CAMERAS									
020.01E1	2	AUTOMATED BEVERAGE SYSTEM 2.0	120/1	5.0	20A	1/2C-2#12	AP-1:12	5-20R	2"-0"	-		214.02E2	1	TECHNOLOGY RACK	120/1	3.0	20A	1/2C-2#12G	CP:12	IG4700	3"-0"	FOR SECURITY SYSTEM									
020.01E2	2	AUTOMATED BEVERAGE SYSTEM 2.0	120/1	14.9	20A	1/2C-2#12	AP-1:5	5-20R	3"-10"	FOR PRE-COOLER		214.02E3	1	TECHNOLOGY RACK	120/1	10.0	20A	1/2C-2#12G	CP:15	IG4700	3"-0"	FOR CASHLESS DEVICE UPS									
021.01E3	3	COFFEE BREWER (THERMAL POTS)	120-208/1	15.5	20A	1/2C-3#12	AP-1:(2,4)(14,16), AP-3(26,28)	BY KES	SEE RMKS	EC TO EXTEND CIRCUIT TO L14-20R RECEPACLE IN CHASE		214.02E4	1	TECHNOLOGY RACK	120/1	12.0	20A	1/2C-2#12G	CP:17	IG4700	3"-0"	FOR POS SYSTEM UPS AND ORB CONTROLLER									
021.09E3	1	HOT WATER DISPENSER	120/1	15.4	20A	1/2C-2#12	AP-2:13	BY KES	SEE RMKS	EC TO EXTEND CIRCUIT TO 5-20R RECEPACLE IN CHASE		215.00E12	2	POS REGISTER - FRONT COUNTER	120/1	3.0 EA	-	3/4C-2#12G	CP:19	IG4700	SEE RMKS	PROVIDE IG RECEP. IN COUNTER-MOUNTED RACEWAY									
023.10E1	1	ESPRESSO BREWER	208/1	21.6	30A	1/2C-2#10	AP-1:(19,21)	BY KES	SEE RMKS	EC TO EXTEND CIRCUIT TO L6-30R RECEPACLE IN CHASE		215.00E15	1	POS REGISTER - FRONT COUNTER	120/1	3.0 EA	-	3/4C-2#12G	CP:19	IG4700	SEE RMKS	PROVIDE POS DATA CABLES									
023.12E1	2	COFFEE CREAM DISPENSER	120/1	1.0	20A	1/2C-2#12	AP-1:8	BY KES	SEE RMKS	EC TO EXTEND CIRCUIT TO 5-20R RECEPACLE IN CHASE		215.00E3	1	POS REGISTER - FRONT COUNTER	120/1	3.0 EA	-	3/4C-2#12G	CP:19	IG4700	10"	EXTEND 2" CONDUIT UNDER SLAB TO NEAREST FULL HEIGHT WALL AND TO ABOVE CEILING FOR POS DATA CABLES									
023.14E1	1	SUGAR/SWEETENER DISPENSER	120/1	1.5	20A	1/2C-2#12	AP-1:8	BY KES	SEE RMKS	EC TO EXTEND CIRCUIT TO 5-20R RECEPACLE IN CHASE		215.02E1	1	POS REGISTER - 2 WINDOW D/T	120/1	3.0 EA	SEE RMKS	1/2C-2#12G	SEE REMARKS	(2) IG4700	10"	EXTEND 2" CONDUIT TO ABOVE CEILING FOR POS DATA CABLES									
024.01E1	1	ORANGE JUICE DISPENSER	120/1	10.0	20A	1/2C-2#12	AP-1:8	BY KES	SEE RMKS	EC TO EXTEND CIRCUIT TO 5-20R RECEPACLE IN CHASE		215.02E10	2	POS REGISTER - 2 WINDOW D/T	120/1	3.0 EA	SEE RMKS	1/2C-2#12G	CP:1	BY KES	SEE RMKS	EC TO EXTEND CIRCUIT TO IG4700 RECEPACLE IN CHASE									
025.07E1	1	INFUSION TEA BREWER - MIS	120-208/1	13.0	20A	1/2C-3#12	AP-2:(32,34)	L14-20R	2"-3"	-		215.02E12	2	POS REGISTER - 2 WINDOW D/T	120/1	3.0 EA	SEE RMKS	1/2C-2#12G	CP:19	IG4700	10"	REFER TO D/T LOW VOLTAGE CONDUIT DIAGRAM FOR CONDUITS UNDER SLAB AND EXTEND (2) 1/2" TO ABOVE CLG.									
025.07E2	1	INFUSION TEA BREWER - MIS	-	-	-	-	-	JB	2"-3"	FOR WATER LINE TO ICED TEA BREWER IF CHASE IS NOT SPECIFIED. SEE P1.6		215.02E15	1	POS REGISTER - FRONT COUNTER	120/1	3.0 EA	-	3/4C-2#12G	CP:19	IG4700	10"	EXTEND 2" CONDUIT UNDER SLAB TO NEAREST FULL HEIGHT WALL AND TO ABOVE CEILING FOR POS DATA CABLES									
031.03E1	1	SODA SYSTEM PACKAGE - B.I.B. (RECIRCULATING 3 TOWERS)	208/3	26.0	30A	3/4C-3#10	AP-2:(37,39,41)	SEE RMKS	3"-0"	SEE RMKS	EC SUPPLIES 30A-3P NF DISC SW MTD 9" BELOW CEILING PER NEC SECT. 404.8(A)		215.02E16	2	POS REGISTER - FRONT COUNTER	120/1	3.0 EA	SEE RMKS	1/2C-2#12G	CP:19	IG4700	10"	REFER TO D/T LOW VOLTAGE CONDUIT DIAGRAM FOR CONDUITS UNDER SLAB AND EXTEND (2) 1/2" TO ABOVE CLG.								
031.03E2	1	SODA SYSTEM PACKAGE - B.I.B. (RECIRCULATING 3 TOWERS)	-	-	-	-	-	JB	4"-0"	FOR CONTROL WIRES FROM REMOTE CONDENSING UNIT		215.02E17	2	POS REGISTER - 2 WINDOW D/T	120/1	3.0 EA	SEE RMKS	1/2C-2#12G	CP:1	BY KES	SEE RMKS	EC TO EXTEND CIRCUIT TO IG4700 RECEPACLE IN CHASE									
031.03E3	1	SODA SYSTEM PACKAGE - B.I.B. (RECIRCULATING 3 TOWERS)	120/1	(2) 6.8	20A	1/2C-2#12	AP-2:35	5-20R	6"-6"	FOR WATER BOOSTER SYSTEM AND OPTIONAL AIR COMPRESSOR		215.04E5	2	POS - KVS MONITOR	120/1	1.5 EA	20A	1/2C-2#12G	CP:3	SEE RMKS	SEE RMKS	EC TO EXTEND CIRCUIT TO IG4700 RECEPACLE IN CHASE									
032.02E1	1	REVERSE OSMOSIS WATER FILTRATION SYSTEM	120/1	4.0	20A	1/2C-2#12	EA	AP-2:23	5-20R	6"-0"	-	215.04E6	1	POS - KVS MONITOR	120/1	1.5 EA	20A	1/2C-2#12G	CP:3	SEE RMKS	SEE RMKS	FLUSH ON CLG		</							

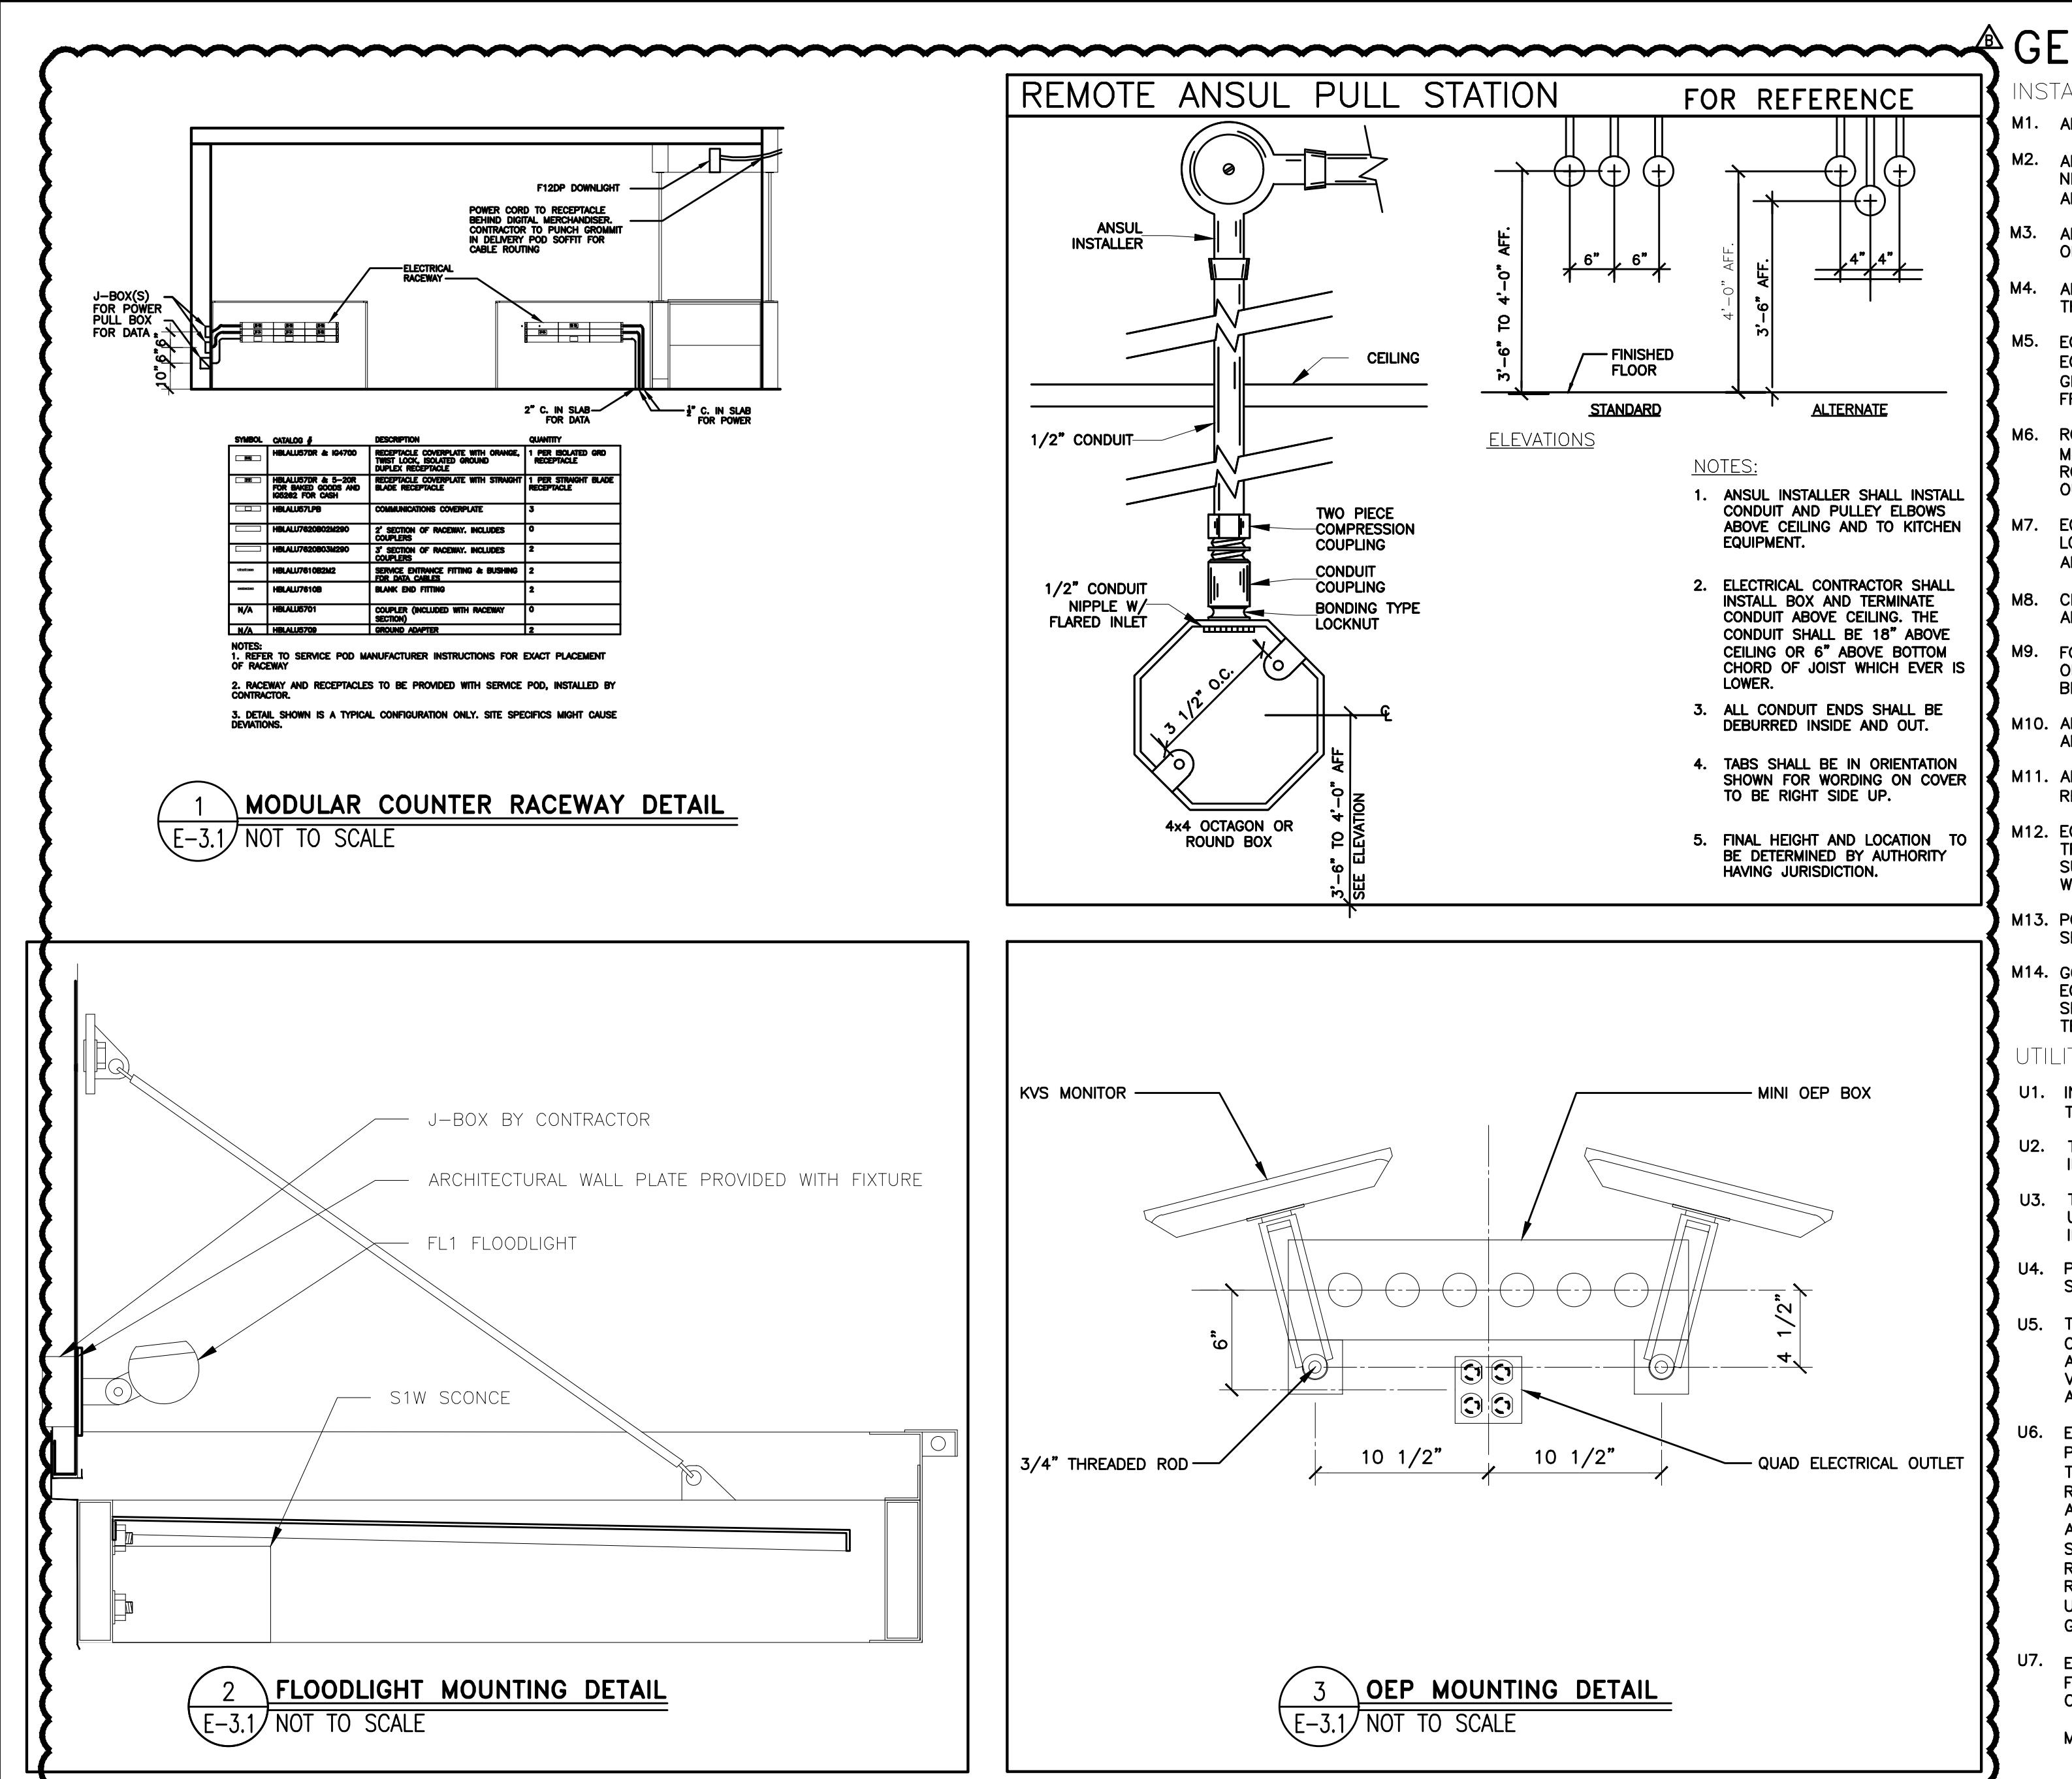

GENERAL ELECTRICAL NOTES:

INSTALLATION METHODS:

- ALL ELECTRICAL MATERIAL USED ON THIS PROJECT SHALL BE "UL" LISTED AND LABELED.
- ALL DIMENSIONS SHOWN ARE TAKEN FROM FACE OF GYP BOARD/PLYWOOD. THE EC SHALL MAKE NECESSARY DIMENSIONAL ALLOWANCES. ALL DIMENSIONS SHOWN ARE TO CENTER LINE OF OUTLET BOX AND/OR RECEPTACLE UNLESS NOTED OTHERWISE.
- ALL J-BOXES, DCOS, AND OTHER ELECTRICAL DEVICES SHOWN SHALL BE RECESSED INTO A WALL, FLOOR OR CEILING UNLESS SPECIFICALLY NOTED OTHERWISE.
- ALL RECEPTACLES (EXCEPT SPECIFIED HUBBELL PIN & SLEEVE TYPES) SHALL BE FURNISHED BY THE EC. THE RECEPTACLES INCLUDING PIN AND SLEEVE TYPE SHALL BE INSTALLED BY THE EC.
- EC SHALL PROVIDE STAINLESS STEEL COVER PLATES ON ALL RECEPTACLES AND J-BOXES. ADDITIONALLY, EC SHALL PROVIDE ORANGE NYLON COVER PLATES MARKED "COMPUTER ONLY" ON ALL ISOLATED GROUND/DEDICATED CIRCUIT RECEPTACLES. PURCHASE PJ8CO (ONE DUPLEX) OR PJ82CO (TWO DUPLEX) FROM HUBBELL.
- ROUGH-INS FOR OPTIONAL EQUIPMENT ARE SHOWN ON THESE SHEETS. EC SHALL VERIFY WITH MCDONALD'S PROJECT MANAGER WHICH OPTIONAL EQUIPMENT IS TO BE INCLUDED AND INSTALL OPTIONAL ROUGH-INS AS REQUIRED. PRICING FOR OPTIONAL ROUGH-INS SHALL BE INCLUDED IN BID AND CALLED OUT AS OPTIONAL.
- EC SHALL COORDINATE WITH KITCHEN EQUIPMENT SUPPLIER, MECHANICAL CONTRACTOR AND GC FOR FINAL LOCATIONS AND CONNECTION REQUIREMENTS OF ALL EQUIPMENT PRIOR TO INSTALLATION OF ANY CONDUIT AND/OR STUB-UP LOCATIONS.
- CEILING MOUNTED ECONOMY OEP BOX IS FURNISHED BY MCDONALD'S, AND INSTALLED BY THE GC. CORD AND PLUG SET FURNISHED BY KES AND INSTALLED BY THE EC.
- FOR GRILLS, FRYERS, AND ANSUL SYSTEMS, EC SHALL EXTEND CONDUIT AND CONDUCTORS DOWN CHASE OR WALL TO TERMINAL BLOCK MOUNTED ON EQUIPMENT AND MAKE FINAL CONNECTIONS TO TERMINAL BLOCKS.
- ALL HOLES IN THE FRONT COUNTER FOR THE POS CORDS AND CABLES SHALL BE LOCATED BY OWNER AND DRILLED BY GC.
- ALL ELECTRICAL CONDUCTORS SHALL BE CONNECTED TO RECEPTACLES USING ONLY THE TERMINAL SCREWS. RECEPTACLE BACK WIRE/QUICK CONNECTIONS SHALL NOT BE USED.
- EC SHALL PROVIDE 208V HEAT TRACE ON THE FREEZER EVAPORATOR CONDENSATE DRAIN LINE. HEAT TRACE SHALL OPERATE CONTINUOUSLY. EC SHALL WIRE HEAT TRACE TO FREEZER EVAPORATOR POWER SUPPLY. A SEPARATE CIRCUIT FOR HEAT TRACE IS NOT REQUIRED. VERIFY HEAT TRACE REQUIREMENTS WITH EVAPORATOR MANUFACTURER.
- POWER AND CONTROL CORDS ARE FURNISHED WITH KITCHEN APPLIANCES. THE EC SHALL CONNECT CORD SETS TO APPLIANCES AS REQUIRED.
- GC SHALL NOT INSTALL CEILING TILE IN AREAS OF THE BEVERAGE BAR REFRIGERATION LINES AND EQUIPMENT PENETRATION LOCATIONS UNTIL THE LINES HAVE BEEN INSTALLED. THE CEILING TILE INSTALLER SHALL RETURN AND INSTALL THE TILES AFTER THE REFRIGERATION LINES HAVE BEEN INSTALLED AND TESTED.

UTILITIES:

- INCOMING SERVICE SHALL BE 208Y/120V, 3 PHASE, 4 WIRE. ANY DEVIATIONS TO THIS SERVICE TYPE SHALL NOT BE PERMITTED UNLESS APPROVED IN WRITING BY MCDONALD'S.
- THE EC SHALL ARRANGE WITH THE ELECTRIC, TELEPHONE, AND OTHER UTILITY COMPANIES FOR INCOMING SERVICE REQUIREMENTS AND SHALL INCLUDE ALL COSTS IN BASE BID.
- THE EC SHALL VERIFY EXACT METHODS AND REQUIREMENTS FOR ELECTRICAL SERVICE WITH LOCAL UTILITY COMPANY. CURRENT TRANSFORMERS SHALL BE INSTALLED OUTSIDE RESTAURANT, LOCATE INSIDE ONLY IF REQUIRED BY UTILITY COMPANY OR LOCAL AUTHORITIES.
- PROVIDE CONCRETE PAD IF TRANSFORMER IS LOCATED ON GRADE AND PROVIDE SECONDARY SERVICE FEEDER AND CONDUITS TO PANEL MDP AS PER LOCAL UTILITY REQUIREMENTS.
- THE EC/GC/ACM SHALL OBTAIN AVAILABLE SHORT CIRCUIT CURRENT FROM THE LOCAL UTILITY COMPANY. THE EC/GC/ACM SHALL ADVISE IN WRITING (FAX SUPPLIER THE UTILITY LETTER) THE AVAILABLE AMOUNT OF FAULT CURRENT. THE PANELBOARD SUPPLIER SHALL BE RESPONSIBLE TO VERIFY THAT THE ELECTRICAL EQUIPMENT SHIPPED HAS APPROPRIATE ELECTRICAL RATINGS WHICH ARE EQUAL TO OR GREATER THAN THE AVAILABLE AMOUNT OF FAULT CURRENT AT THE SITE.
- EC AND ACM OR OWNER/OPERATOR AND ACM SHALL COORDINATE WITH LOCAL PHONE COMPANY TO PROVIDE A 10 PAIR (OR MORE) COUPLE TELEPHONE CABLE FROM THE TELEPHONE UTILITY EASEMENT TO THE RESTAURANT TELEPHONE DEMARCTION POINT. IF THE TELEPHONE PANEL/BOX IS LOCATED INSIDE THE RESTAURANT, EC SHALL PROVIDE (2) EMPTY 3/4" CONDUITS FROM THE TELEPHONE PANEL/BOX UP TO ABOVE THE CEILING FOR FUTURE TELEPHONE CABLE INSTALLATION. ADDITIONALLY, THE EC SHALL PROVIDE AN EMPTY 3/4" CONDUIT FROM THE TELEPHONE PANEL/BOX TO THE LOCATION OF THE FUTURE INTERNET SERVER (VERIFY LOCATION WITH PM). EC SHALL CONNECT, INSTALL AND INCORPORATE ALL OTHER REQUIREMENTS NECESSARY FOR COMPLETE AND OPERATIONAL TELEPHONE SYSTEM(S) FOR THIS SITE. THE REMAINING UNUSED TELEPHONE CONDUCTOR PAIRS SHALL BEAPPED AND LEFT IN PLACE FOR FUTURE USE. THE TELEPHONE PANEL/BOX SHALL BE GROUNDED AS SHOWN IN THE "BUILDING ELECTRICAL DRAWING DETAIL".
- EC SHALL PROVIDE A 4" SCHEDULE 40/80 PVC CONDUIT THAT IS SUITABLE FOR DIRECT BURIAL FROM BUILDING TO UTILITY EASEMENT/ROW IN UTILITY CABLING/CONDUIT TRENCH PROVIDED BY GC. CONDUIT SHALL RUN FROM INCOMING TELCOM LOCATION AT BUILDING TO TELECOM PEDESTAL LOCATION IN UTILITY EASEMENT/ROW. VERIFY EXACT LOCATIONS IN FIELD WITH AREA CONSTRUCTION MANAGER AND TELECOM UTILITY PROVIDER PRIOR TO INSTALLATION.

INSTALLATION NOTES:

- IF TELCOM CONDUIT IS TERMINATED WITHIN BUILDING, PVC SHALL TRANSITION TO HWG/RMC TYPE CONDUIT PRIOR TO RISING ABOVE FINISHED SLAB.
- PROVIDE THERMOPLASTIC BUSHINGS AT BOTH ENDS OF CONDUIT FOR CABLING PROTECTION.
- IF 90 DEGREE BENDS ARE REQUIRED, CONTRACTOR SHALL PROVIDE WIDE SWEEPING BENDS TO PREVENT BENDING/DAMAGE TO CABLE.
- ALL COMMUNICATIONS CABLING SHALL BE PULLED VIA THIS CONDUIT.
- INSTALL A MINIMUM OF 6 PULL WIRES IN CONDUIT TO ALLOW FOR THE INSTALLATION OF FUTURE CABLING. USE NON-DEGRADING POLYPROPYLENE OR MONOFILAMENT PLASTIC LINE OR #12 AWG SOLID COPPER CONDUCTOR. WIRES MUST NOT BE LESS THAN 20% OF TENSILE STRENGTH. PROVIDE AT LEAST 12 INCHES OF SLACK AT EACH END OF PULL WIRE.
- AFTER INSTALLATION OF COMMUNICATIONS CABLING AND PULLSTRINGS/WIRES, CONTRACTOR SHALL SEAL BOTH ENDS OF CONDUIT TO PREVENT INTRUSION FROM WEATHER, RODENTS, DEBRIS, ETC. SEAL SHALL BE OF TYPE TO ALLOW FOR REMOVAL FOR INSTALLATION OF FUTURE CABLING

CONDUIT AND WIRE:

- THE FOLLOWING WIRING METHODS SHALL NOT BE USED: NON-METALLIC SHEATHED CABLE (ROMEX, NM, NMC, & NMS), ARMORED CABLE TYPE AC (BX), ELECTRICAL NON-METALLIC TUBING, TYPE ENT (SMURF-TUBE).
- CONDUTR RUNS MAY BE COMBINED EXCEPT WHERE ISOLATED GROUNDS ARE USED. IG CIRCUITS SHALL BE RUN IN SEPARATE CONDUITS. ALL HOME RUNS SHALL BE SIZED BASED ON DERATED CONDUCTOR AMPACITIES AND INCREASE CONDUIT AND WIRE SIZE AS REQUIRED BY NEC SECTION 310 REQUIREMENTS.
- CONDUTR SHALL HAVE A MAXIMUM OF 4 BENDS WITHOUT A JUNCTION BOX TO PREVENT DAMAGE TO CABLE DURING PULLING. THE EC SHALL PIGTAIL #12 PULL WIRE AT EACH END FOR INSTALLER TO PULL CABLE. ALL LOW VOLTAGE CONDUIT STUB-UPS SHALL BE PROVIDED WITH A BUSHING.
- MINIMUM WIRE SIZE SHALL BE #12 AWG COPPER UNLESS NOTED OTHERWISE. MINIMUM CONDUIT SIZE SHALL BE 1/2" UNLESS NOTED OTHERWISE. WIRES INSTALLED UNDERGROUND OR OUTDOORS SHALL BE THW.
- CONDUCTORS #10 AWG AND SMALLER SHALL BE SOLID COPPER. CONDUCTORS #8 AND LARGER SHALL BE STRANDED COPPER. ALUMINUM CONDUCTORS SHALL NOT BE UTILIZED FOR FEEDER OR BRANCH CIRCUIT DISTRIBUTION.
- RACEWAYS SHALL BE ANY OF THE FOLLOWING MATERIALS, INSTALLED IN ACCORDANCE WITH ALL APPLICABLE CODES:

OUTDOORS: (FOR SPECIFIC APPLICATIONS AND APPROPRIATE FITTINGS, SEE TABLE W6)

- EXPOSED: RMC, IMC.
- CONCEALED: RMC, IMC.
- BELLOW GRADE: SINGLE RUN: RNC, RMC.
- BELLOW GRADE: GROUPED: RNC, RMC.
- CONNECTION TO VIBRATING EQUIPMENT (INCLUDING TRANSFORMERS AND HYDRAULIC, PNEUMATIC, ELECTRIC SOLENOID, OR MOTOR-DRIVEN EQUIPMENT): LFMC.
- BOXES AND ENCLOSURES: NEMA 250, TYPE 3R OR 4.

INDOORS: (FOR SPECIFIC APPLICATIONS AND APPROPRIATE FITTINGS, SEE TABLE W6)

- EXPOSED: EMT, IMC.
 - CONCEALED: EMT, IMC.
- (CONTINUED ON TOP)

- CONNECTION TO VIBRATING EQUIPMENT (INCLUDING TRANSFORMERS AND HYDRAULIC, PNEUMATIC, ELECTRIC SOLENOID, OR MOTOR-DRIVEN EQUIPMENT): FMC; EXCEPT USE LFMC IN DAMP OR WET LOCATIONS.
- DAMP OR WET LOCATIONS: RIGID STEEL CONDUIT.
- BOXES AND ENCLOSURES: NEMA 250, TYPE 1, EXCEPT AS FOLLOWS: A. DAMP, WET OR KITCHEN LOCATIONS: NEMA 250, TYPE 4, STAINLESS STEEL.

TABLE W6:

LOCATION	208V.	480V.	LOW ENERGY*
indoors	< 1" EMT COMPRESS. FTGS >1.25" IMC THREADED FTGS	IMC THREADED FTGS	EMT COMPR. FTGS
outdoors	RMC OR IMC THREADED FTGS	RMC OR IMC THREADED FTGS	RMC OR IMC THREADED FTGS
concealed			
walls	<2" EMT SET SCREW FTGS >2.5" IMC THREADED FTGS	<2" EMT SET SCREW FTGS >2.5" IMC THREADED FTGS	EMT 1/2" - 2" SET SCREW FTGS 2.5" - 4" COMPR. FTGS
air handling ceiling/pace	<2" EMT COMP. FTGS >2.5" IMC THREADED. FTGS	<2" EMT COMP. FTGS < 2.5" IMC THREADED. FTGS	EMT COMP. FTGS
non air handling ceiling/pace	<2" EMT SET SCREW FTGS >2.5" IMC THREADED. FTGS	<2" EMT COMP. FTGS >2.5" IMC THREADED. FTGS	EMT 1/2" - 2" SET SCREW FTGS 2.5" - 4" COMP. FTGS
below grade			
interior	IMC THREADED FTGS OR SCHEDULE 40 OR 80 PVC	IMC THREADED FTGS	IMC THREADED FTGS SCHEDULE 40 OR 80 PVC
exterior	SCHEDULE 40 OR 80 PVC OR RMC THREADED FTGS	SCHEDULE 40 OR 80 PVC OR RMC THREADED FTGS	SCHEDULE 40 OR 80 PVC OR RMC THREADED FTGS

W7. ALL CONDUITS PENETRATING THE FREEZER/COOLER BOX SHALL BE SEALED IN COMPLIANCE NEC SECTION 300 AND THE FREEZER/COOLER BOX MANUFACTURERS REQUIREMENTS.

W8. PROVIDE THREE (3) 3/4" EMPTY CONDUITS FROM PANEL LP-1 UP TO THE CEILING SPACE AND CAP FOR FUTURE USE.

GROUNDING:

- ALL BRANCH AND FEEDER CIRCUITS SHALL BE GROUNDED BY TWO METHODS. THE FIRST METHOD SHALL INCLUDE AN INSULATED COPPER EQUIPMENT GROUNDING CONDUCTOR CONTAINED WITHIN THE SAME CONDUIT AS THE PHASE CIRCUIT CONDUCTORS AND SIZED PER NEC SECTION 250 REQUIREMENTS. THIS INSULATED EQUIPMENT GROUNDING CONDUCTOR SHALL HAVE ONE END PROPERLY TERMINATED AT THE EQUIPMENT GROUND BUS IN THE CORRESPONDING CIRCUIT BREAKER PANEL, AND THE OTHER END TERMINATED AT THE GROUNDING CONTACT OF A GROUNDING RECEPTACLE AND TO THE JUNCTION BOX OR TO AN EQUIPMENT CABINET, APPLICABLE. THE SECOND METHOD PROVIDES EQUIPMENT GROUNDING VIA METALLIC CONDUIT THAT IS CONNECTED AND TERMINATED IN FITTINGS LISTED FOR GROUNDING PER NEC SECTION 250 REQUIREMENTS. BOTH GROUNDING METHODS ARE REQUIRED IN A MCDONALD'S RESTAURANT. ISOLATED GROUND SHALL BE INSTALLED WHERE INDICATED ON PLAN AND AS SHOWN IN POS ISOLATED GROUND/DEDICATED CIRCUIT DETAIL ON SHEET E4.2.
- THE BUILDING GROUNDING SYSTEM SHALL COMPLY WITH NEC ARTICLE 250. MCDONALD'S SPECIFICATIONS, AND SHEET E4.2. CAUTION: IT IS A SAFETY HAZARD AND AN NEC VIOLATION TO HAVE ANY NEUTRAL TO GROUND CONNECTIONS BEYOND THE MAIN ELECTRICAL DISCONNECT MEANS. MCDONALD'S GROUNDING STANDARDS PURPOSELY EXCEED THOSE GIVEN BY THE NEC. THE EC SHALL PROVIDE A BUILDING GROUNDING SYSTEM MEETING NEC SECTION 250 REQUIREMENTS AS WELL AS MCDONALD'S STANDARDS.
- EC SHALL REFER TO "POS ISOLATED GROUND/DEDICATED CIRCUIT DETAIL, SHEET E4.2, FOR REQUIRED WIRING REQUIREMENTS OF COMPUTER PANEL CP."
- METAL RACEWAYS CONTAINING A GROUNDING ELECTRODE CONDUCTOR SHALL BE BONDED AT BOTH ENDS AS REQUIRED BY NEC SECTION 250 REQUIREMENTS.

TEMPERATURE CONTROLS:

- REMOTE TEMPERATURE SENSORS: EC SHALL PROVIDE 1/2" CONDUIT FROM JUNCTION BOX ABOVE CEILING DOWN TO SENSOR MOUNTED AT 4'-0" TO 4'-6" AFF.
- SEE DETAIL ON SHEET M3.0 FOR SENSOR MOUNTING DETAIL. LOCATION OF WALL MOUNTED TEMPERATURE SENSORS ARE SHOWN ON SHEET M1.2 AND E2.0.
- WHEN WIRING FOR PROGRAMMABLE THERMOSTATS AND REMOTE SENSORS IS NOT IN A CONDUIT, THE WIRING SHALL BE RUN TO THE UNDERSIDE OF THE ROOF DECK. NONE OF THE WIRING SHALL BE ROUTED OVER FLUORESCENT BALASTS, POWER BOXES OR IN A CONDUIT WITH LINE VOLTAGE WIRING AS ELECTRICAL INTERFERENCE (NOISE) WILL CAUSE ERRATIC CONTROL OPERATION. ALL THERMOSTATS SHALL BE MOUNTED 4'-0" AFF.

FLAT PANEL TELEVISIONS:

- EC SHALL PROVIDE A DUPLEX RECEPTACLE AND A LOW VOLTAGE BROADBAND CONNECTION FOR THE INSTALLATION OF FLAT PANEL TELEVISIONS. COORDINATE EXACT LOCATIONS WITH DECOR COMPANY. FOR BROADBAND CONNECTION, EC SHALL PROVIDE A 4 X 4 BOX WITH A 3/4" CONDUIT STUB-UP WITH A BUSHING INTO ACCESSIBLE CEILING SPACE.

ELECTRICAL PANELS:

- THE EC SHALL BE RESPONSIBLE FOR BALANCING THE LOADS ON ALL PANELS.
- THE EC SHALL PROVIDE ELECTRICAL SERVICE TO THE EQUIPMENT MOUNTED BREAKER PANEL. SEE ELECTRICAL ROUGH-IN PLAN AND SCHEDULE FOR ALL REQUIREMENTS.
- THE EC SHALL BE RESPONSIBLE FOR THE PROPER IDENTIFICATION AND LABELING OF ALL CIRCUIT BREAKERS. EACH PANEL SHALL BE PROVIDED WITH AN ACCURATE TYPEWRITTEN CIRCUIT DIRECTORY AT THE CONCLUSION OF THE PROJECT AND PRIOR TO RESTAURANT OPENING.

SECURITY AND DRIVE-THRU CAMERAS:

- EC TO PROVIDE ELECTRICAL POWER AND COMMUNICATION CONDUITS FOR BUILDING MOUNTED SECURITY AND DRIVE THRU CAMERAS. COORDINATE FINAL LOCATIONS WITH SECURITY AND DRIVE THRU CAMERA INSTALLERS.

LIGHTING:


- PROVIDE A WEATHERPROOF JUNCTION BOX IN PARAPET FOR FASCIA SIGN. FINAL CONNECTION BY OTHERS.
- COORDINATE THE LOCATION OF JUNCTION BOX (IN THE WALL) WITH THE OPENING IN TRELLIS (FOR THE LIGHT FIXTURE WIRES). THE LOCATION OF THE JUNCTION BOX AND THE OPENING IN THE TRELLIS SHALL BE ALIGNED FOR THE LIGHT FIXTURE TO BE INSTALLED PROPERLY. COORDINATE INSTALLATION OF JUNCTION BOX AND ANY NECESSARY OPENINGS IN TRELLIS WITH GC AND TRELLIS/CANOPY MANUFACTURER. SEE LIGHT FIXTURE INSTALLATION INSTRUCTIONS FOR REQUIREMENTS REGARDING MOUNTING BRACKETS FOR USE IN C-CHANNEL TRELLISES.
- EC SHALL FIELD VERIFY THAT LIGHT FIXTURES DO NOT OBSTRUCT OR CONFLICT WITH THE WORK OF OTHER TRADES. IF A DISCREPANCY IS FOUND, THE EC SHALL IMMEDIATELY NOTIFY THE GC BEFORE THE INSTALLATION OF SUCH FIXTURE(S). EC SHALL COORDINATE LOCATIONS OF ALL LIGHT FIXTURES IN DINING AREA WITH FINAL SEATING AND DECOR PLANS.
- IF PC-POS CASH REGISTER SYSTEM IS INSTALLED, EC SHALL RELOCATE FIXTURES ABOVE FRONT COUNTER TO AVOID GLARE ON THE CASH REGISTER SCREENS. EC SHALL INSTALL CABLE WHIP TO FIXTURES SO THAT FIXTURE MAY BE RELOCATED FOUR FEET WITHOUT DISCONNECTING CABLE WHIP.
- EC SHALL COORDINATE LOCATION OF ALL EXTERIOR LIGHTS TO AVOID INTERFERENCE WITH ANY CORBELS, TRUSSES, BEAMS OR OTHER SPECIAL EXTERIOR TREATMENTS. INSTALL LIGHT FIXTURES WITH CORRECT ORIENTATION PER MANUFACTURER'S INSTRUCTIONS.
- THE USE OF INTERLOCK TYPE "MC" CABLE IN LENGTHS OF 6 FEET OR LESS (WHERE PERMITTED BY LOCAL CODES) SHALL BE ALLOWED FOR WIRING TO INTERIOR LIGHTING FIXTURES. "ROMEX" OR "BX" SHALL NOT BE USED.
- EC SHALL VERIFY THAT NOT MORE THAN 3% VOLTAGE DROP EXISTS FROM THE LIGHTING PANEL TO ANY EXTERIOR LIGHTING FIXTURE OR SIGN/BALLET.
- WHERE MCDONALD'S RESTAURANT HAS A PLAYPLACE, THE EC SHALL COORDINATE EXACT LOCATION OF PLAYPLACE LIGHTING WITH PLAYPLACE TOY VENDOR FOR MAXIMUM ILLUMINATION AND SAFETY PER THE FINAL LOCATION OF THE PLAYPLACE TOY. LIGHTING FIXTURES SHALL NOT BE MOUNTED TO THE TOY OR ANY PART OF THE TOY STRUCTURE.
- EC SHALL VERIFY ALL TAP SETTINGS FOR H.I.D. LIGHTING FIXTURES AND MAKE ANY NECESSARY CORRECTIONS PRIOR TO INSTALLATION.


emmanuelson-podas consulting engineers	
Emmanuelson-Podas, Inc. Edna, IN 47028 (920) 930-0050 www.eppinc.com	
3801.0037	
MATTHEW W. PULLS LICENSED 17667 KANSAS PROFESSIONAL ENGINEER 12/03/20	


© 2020 McDonald's USA, LLC

These drawings and specifications are the confidential and proprietary property of McDonald's USA, LLC and shall not be copied or reproduced without the express written consent of McDonald's USA, LLC and its affiliated companies. These drawings and specifications are issued in confidence and are to be used only on the specific project for which they were issued. Use of these drawings for reference or example on another project requires the prior written permission of the project's architect and engineer. Reproduction of these drawings and specifications for use on another project is not authorized.

TITLE	2019 STANDARD BUILDING - BB20
STD ISSUE DATE	2019-11
REVIEWED BY	WLW
DATE ISSUED	01-23-20
DESCRIPTION	WOOD BEARING WALLS W/FIBER CEMENT SIDING & CI WOOD ROOF TRUSS FRAMING FIBER CEMENT PANEL/BATTEN/ALPOLIC PANEL/BRICK EXT. FINISH
SITE ID	015-0071.00-B
SITE ADDRESS	605 SOUTH 7TH STREET, KANSAS CITY, KS
REV#	1975
SHEET NO.	E3.1
NOTES & DETAILS	015-0071.00-B

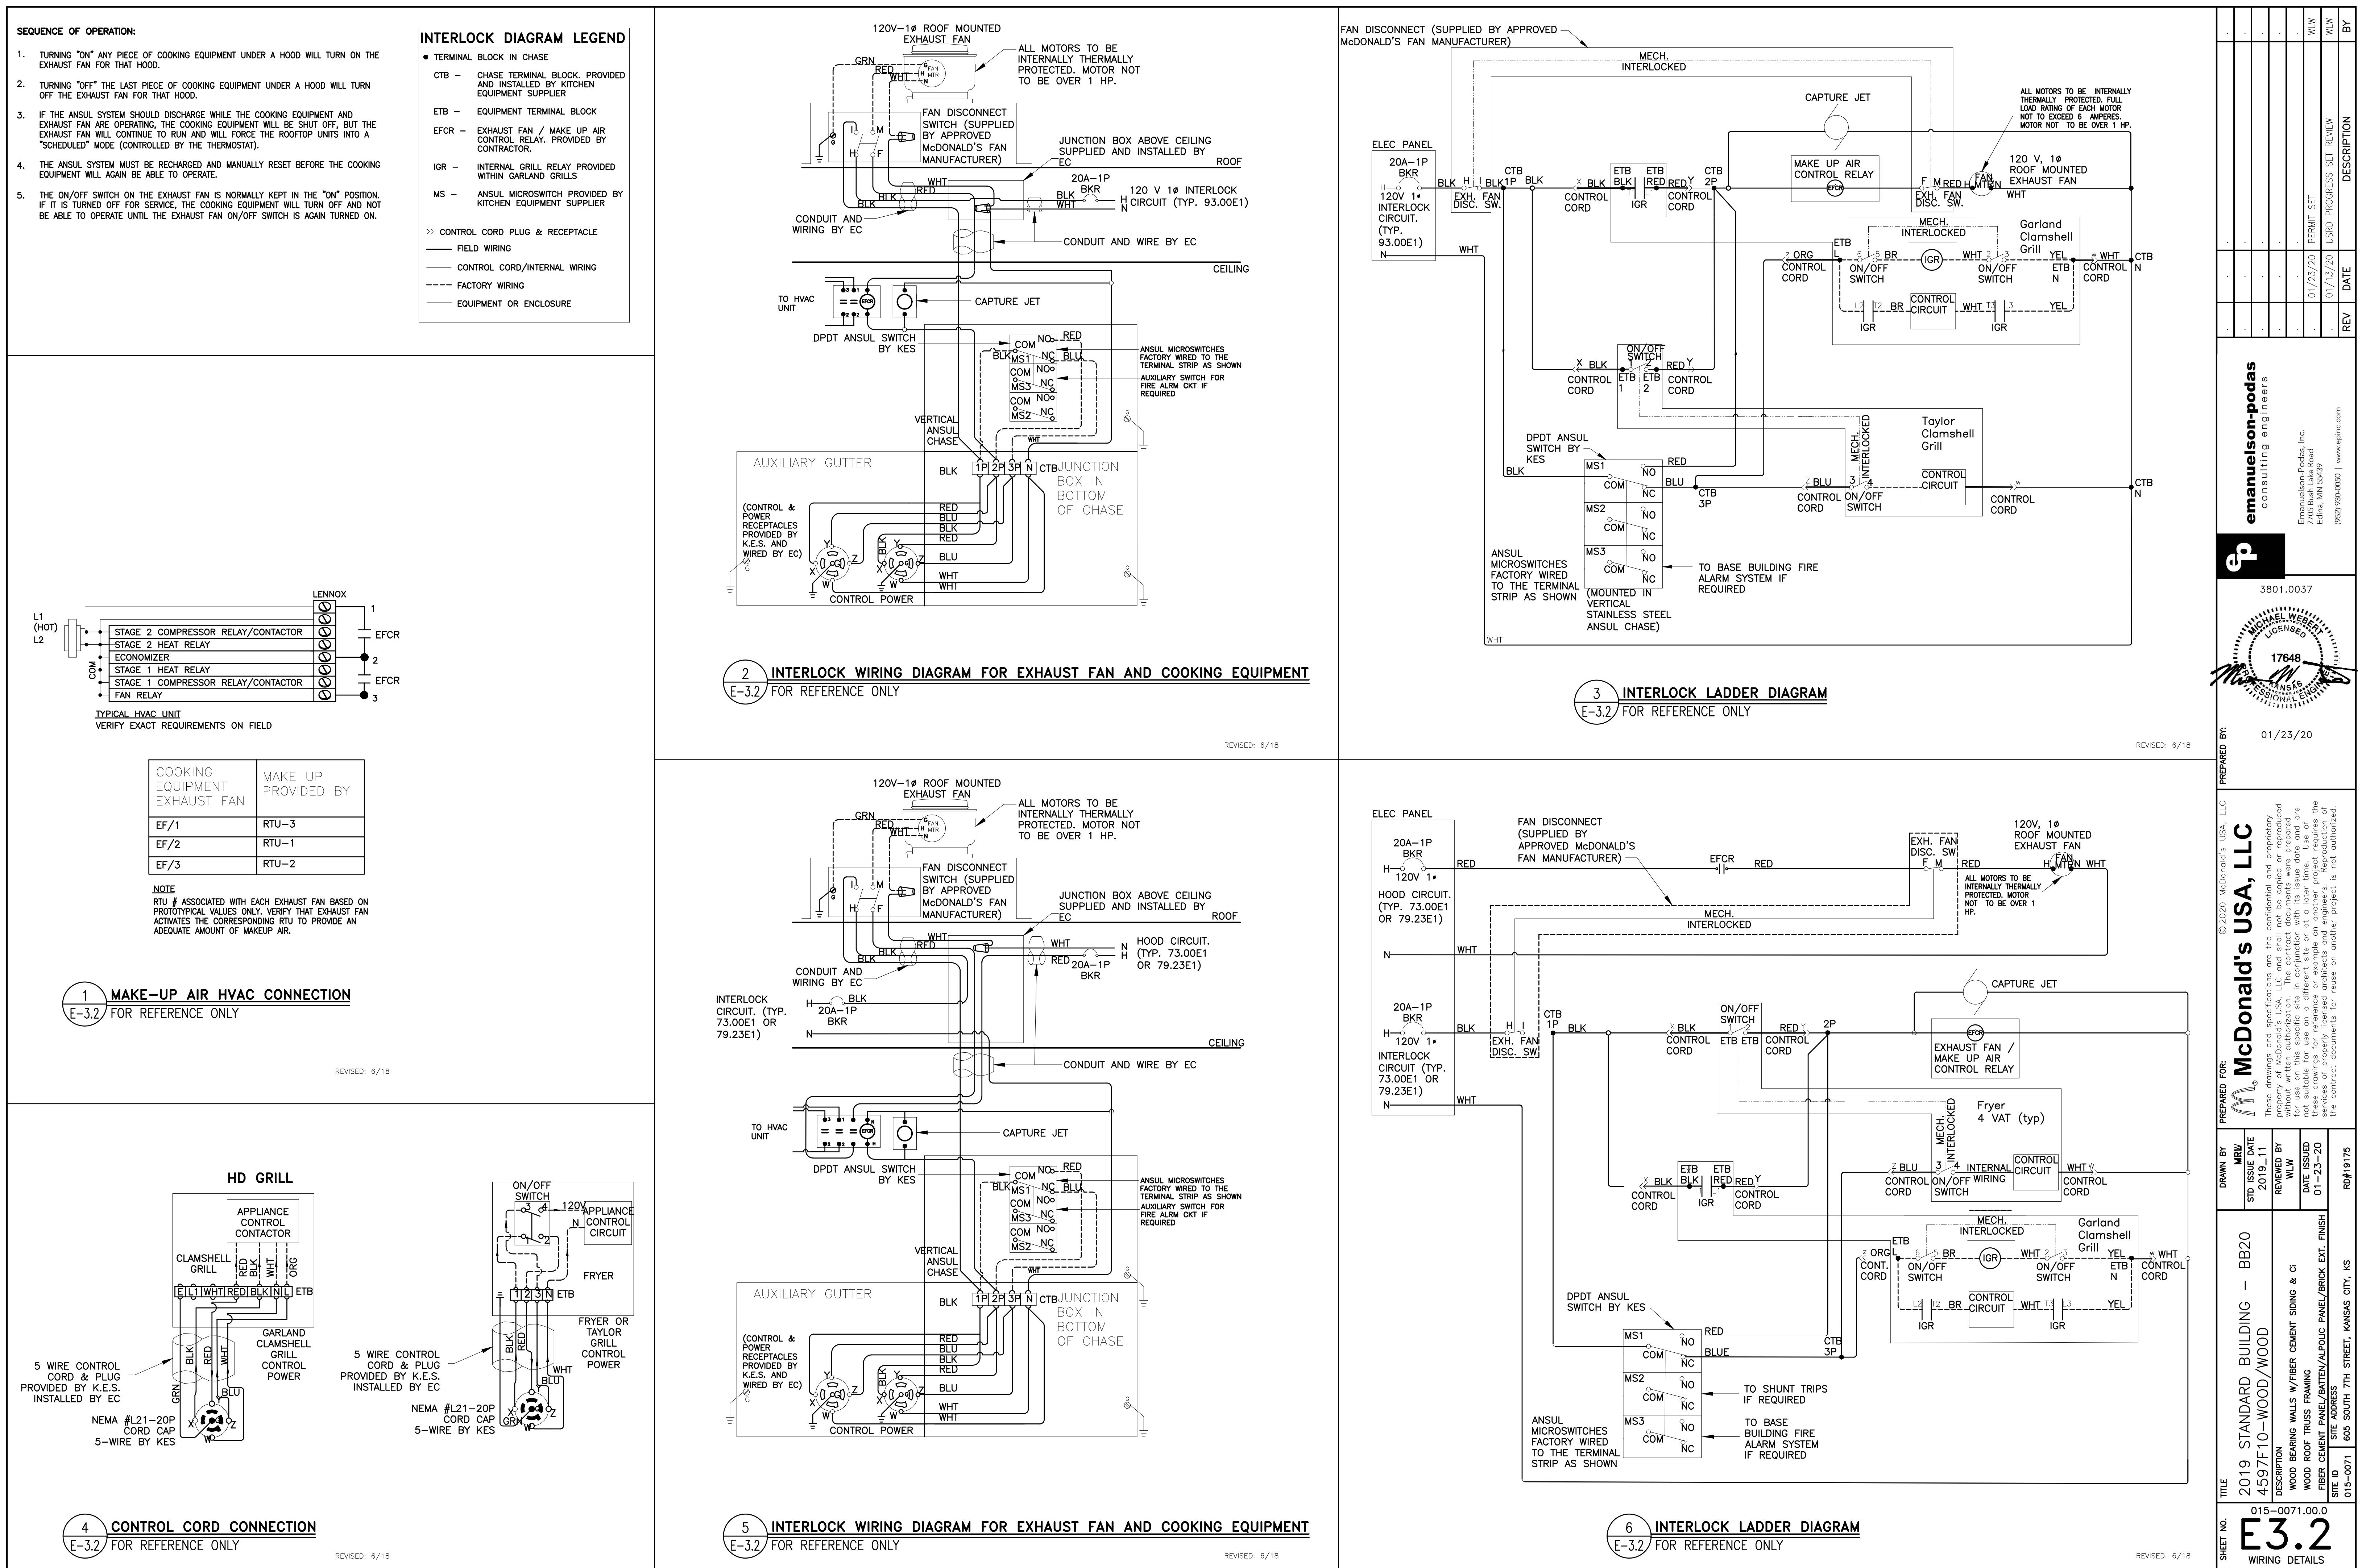

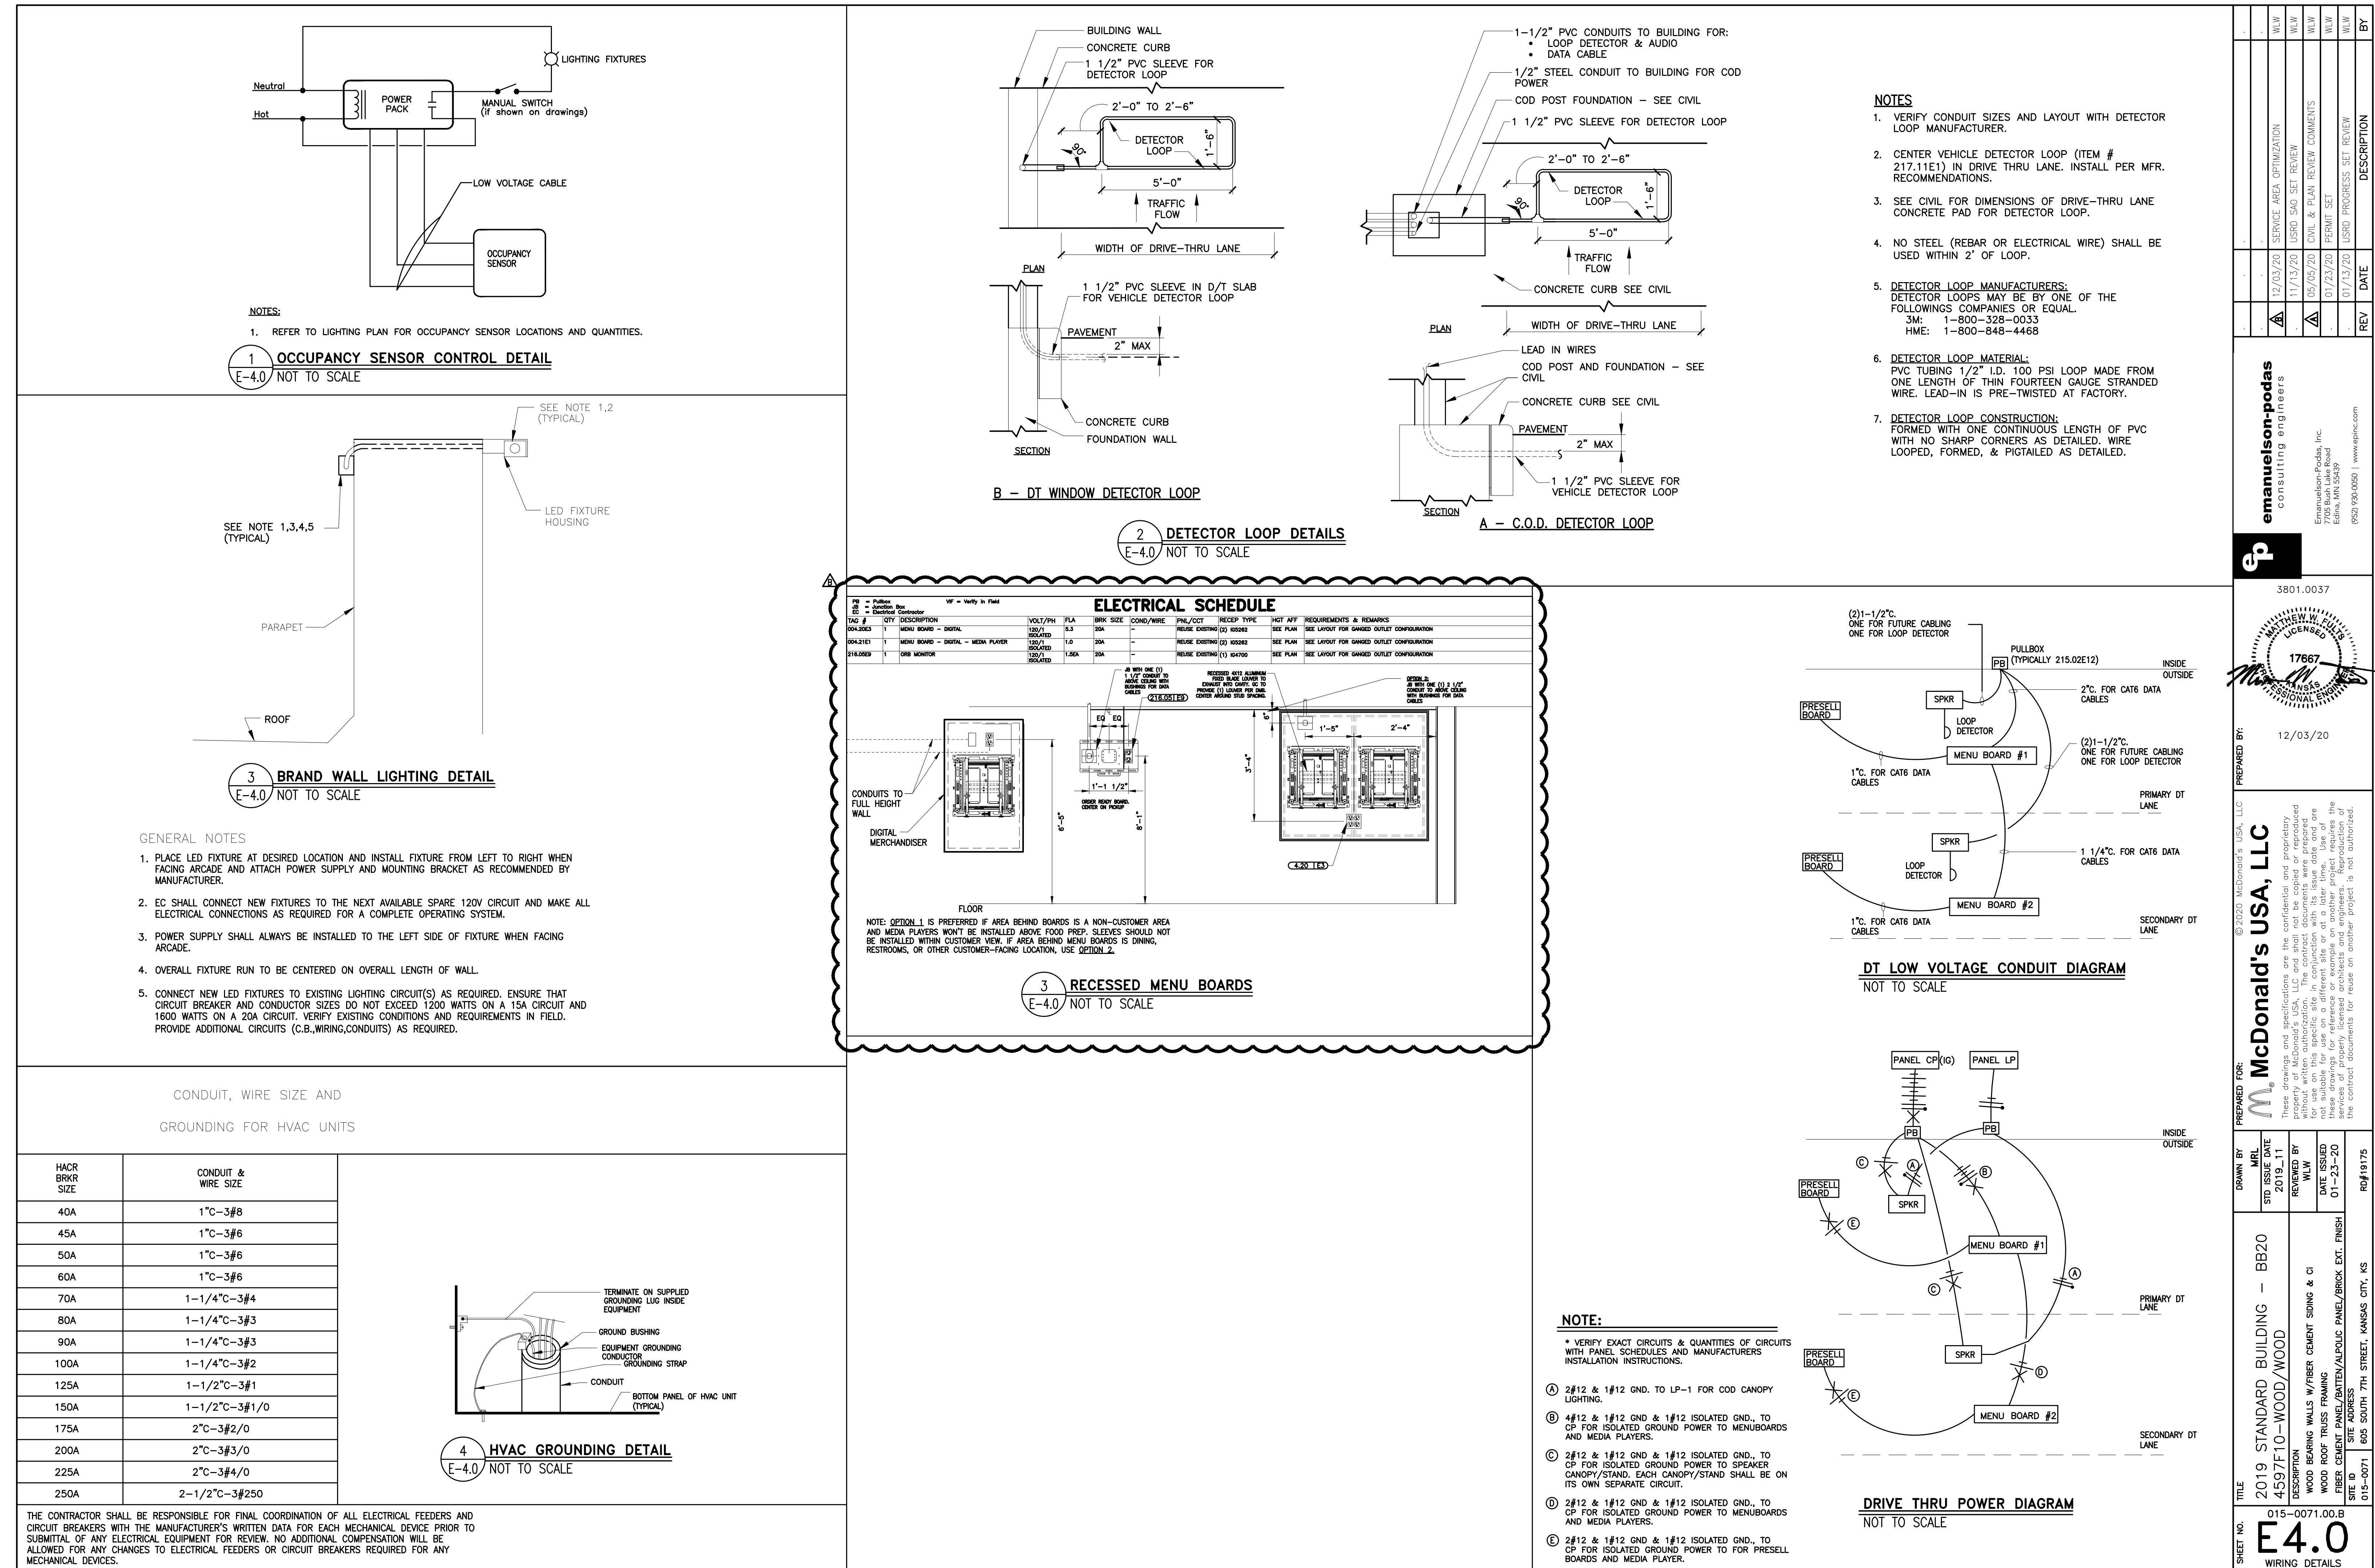

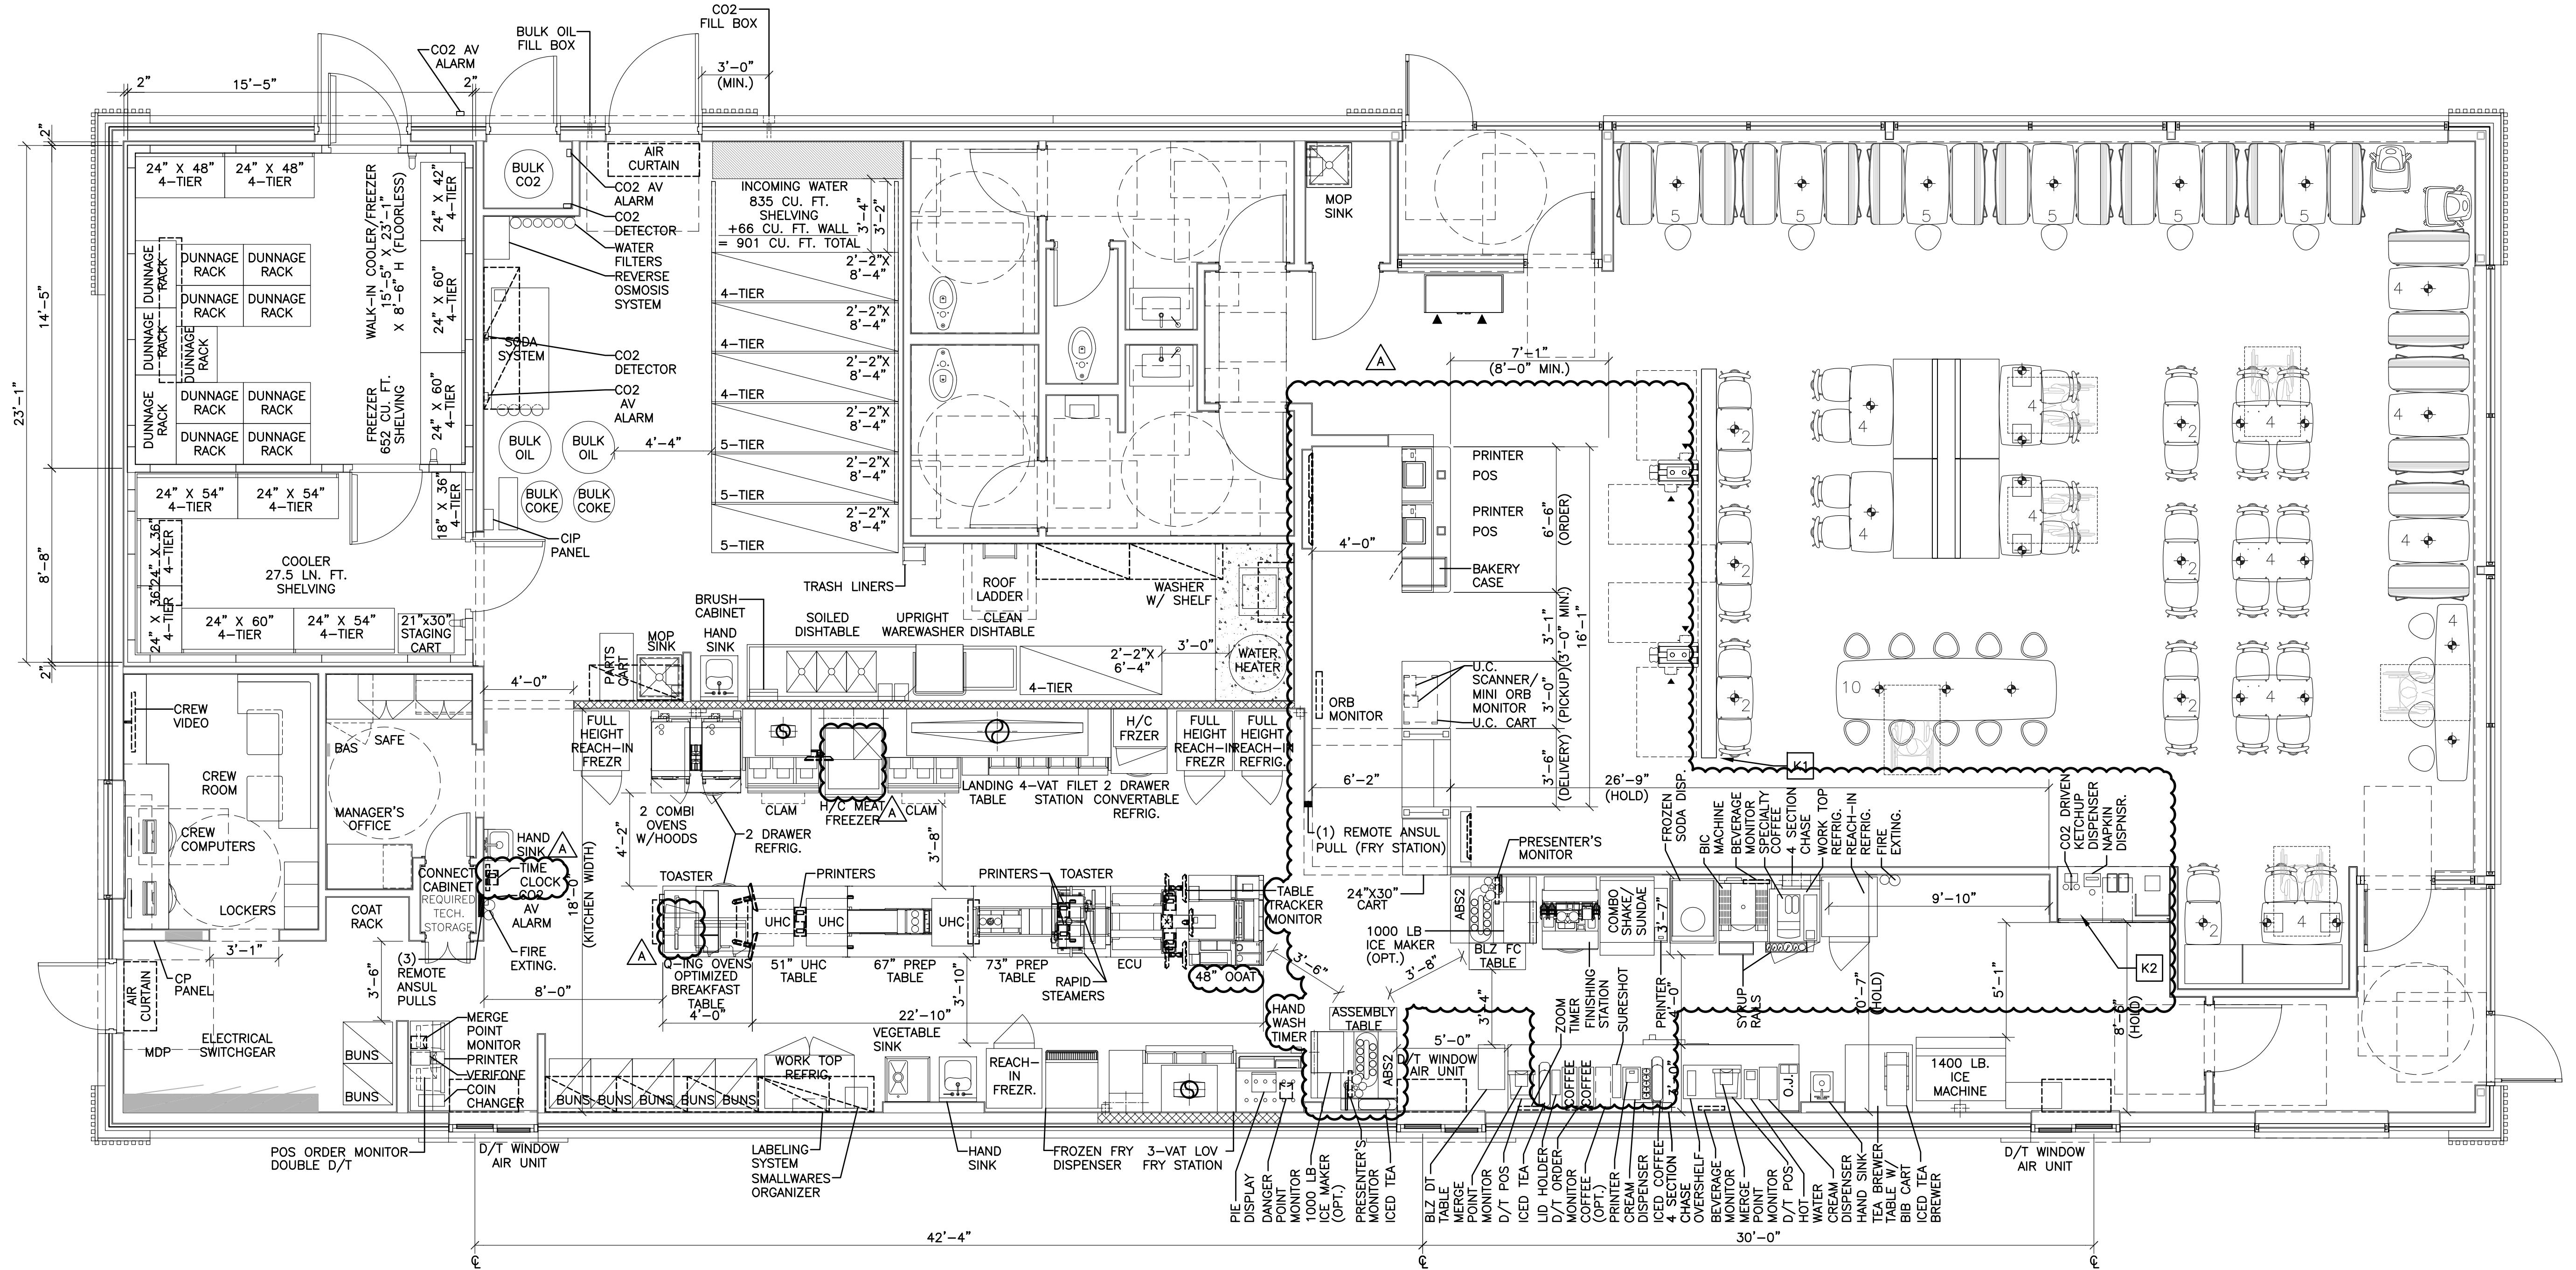

KITCHEN COVER SHEET

1
K1.0 1/4" = 1'-0"

KEYED NOTES

K1 SEATING AND KIOSKS MUST BE 5'-0" CLEAR FROM BEVERAGE CELL WALL

K2 KES TO ENSURE AMENITY TOWER EQUIPMENT PLACEMENT MEETS ADA REQUIREMENTS

PREPARED FOR: **McDonald's USA, LLC** PREPARED BY:

DRAWN BY: RH

STD ISSUE DATE: 2019-11

REVIEWED BY: RH

DATE ISSUED: 11/15/2019

REV. DATE: BY

© 2019 McDonald's USA, LLC

These drawings and specifications are the confidential and proprietary property of McDonald's USA, LLC and shall not be copied or reproduced without the express written consent of McDonald's USA, LLC. These drawings are for use on this specific site in conjunction with its issued date and are not suitable for use on a different site or at a later time. Use of these drawings for reference or example on another project requires the services of properly licensed architects and engineers. Reproduction of the contract documents for use on another project is not authorized.

SHEET NO. 015-0071.00.0

TITLE: 2019 STANDARD BUILDING - BB20



DESCRIPTION: WOOD BEARING WALLS W/4" BRICK EXTERIOR FINISH & CI

ELLS/BATTEN/METAL PANEL/BRICK EXTERIOR FINISH

SITE ID: 015-0071

SITE ADDRESS: 605 South 7th Street Kansas City KS

K1.0 KITCHEN COVER SHT

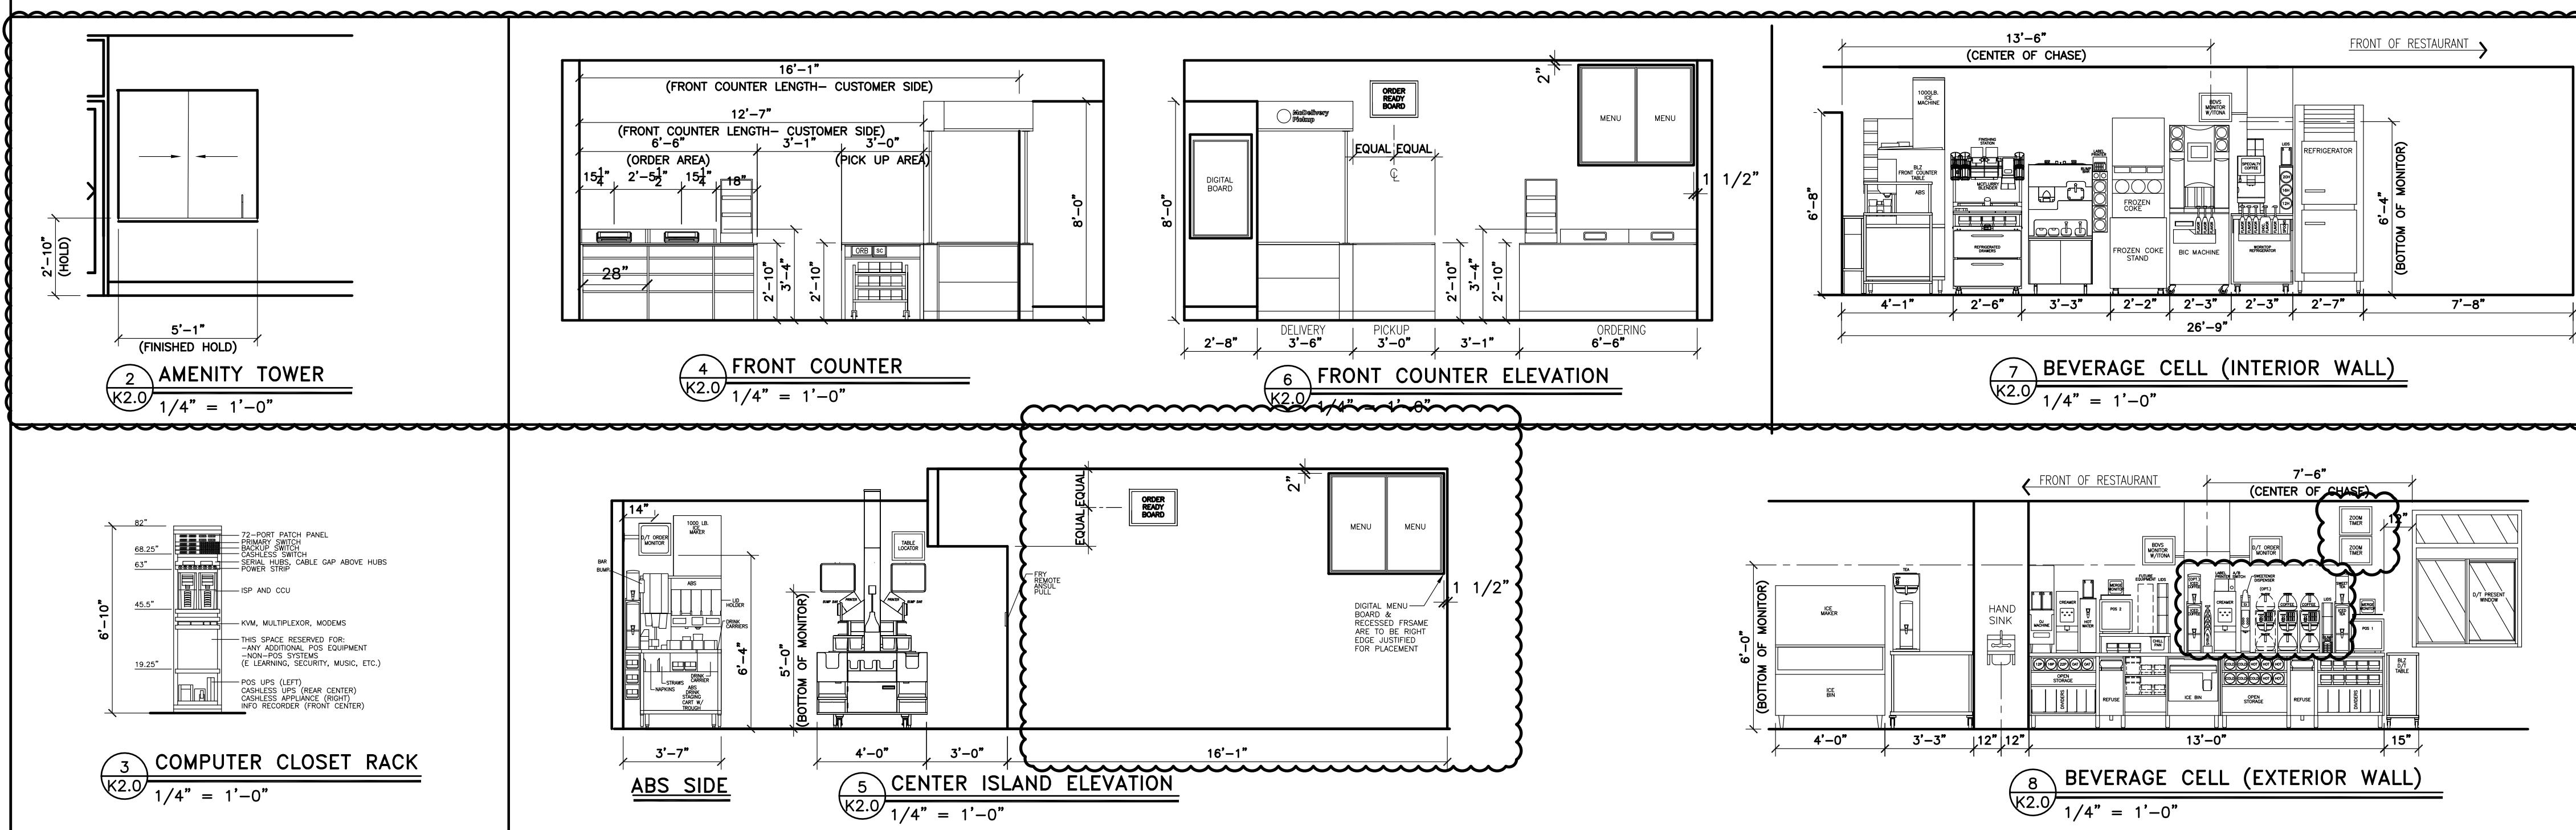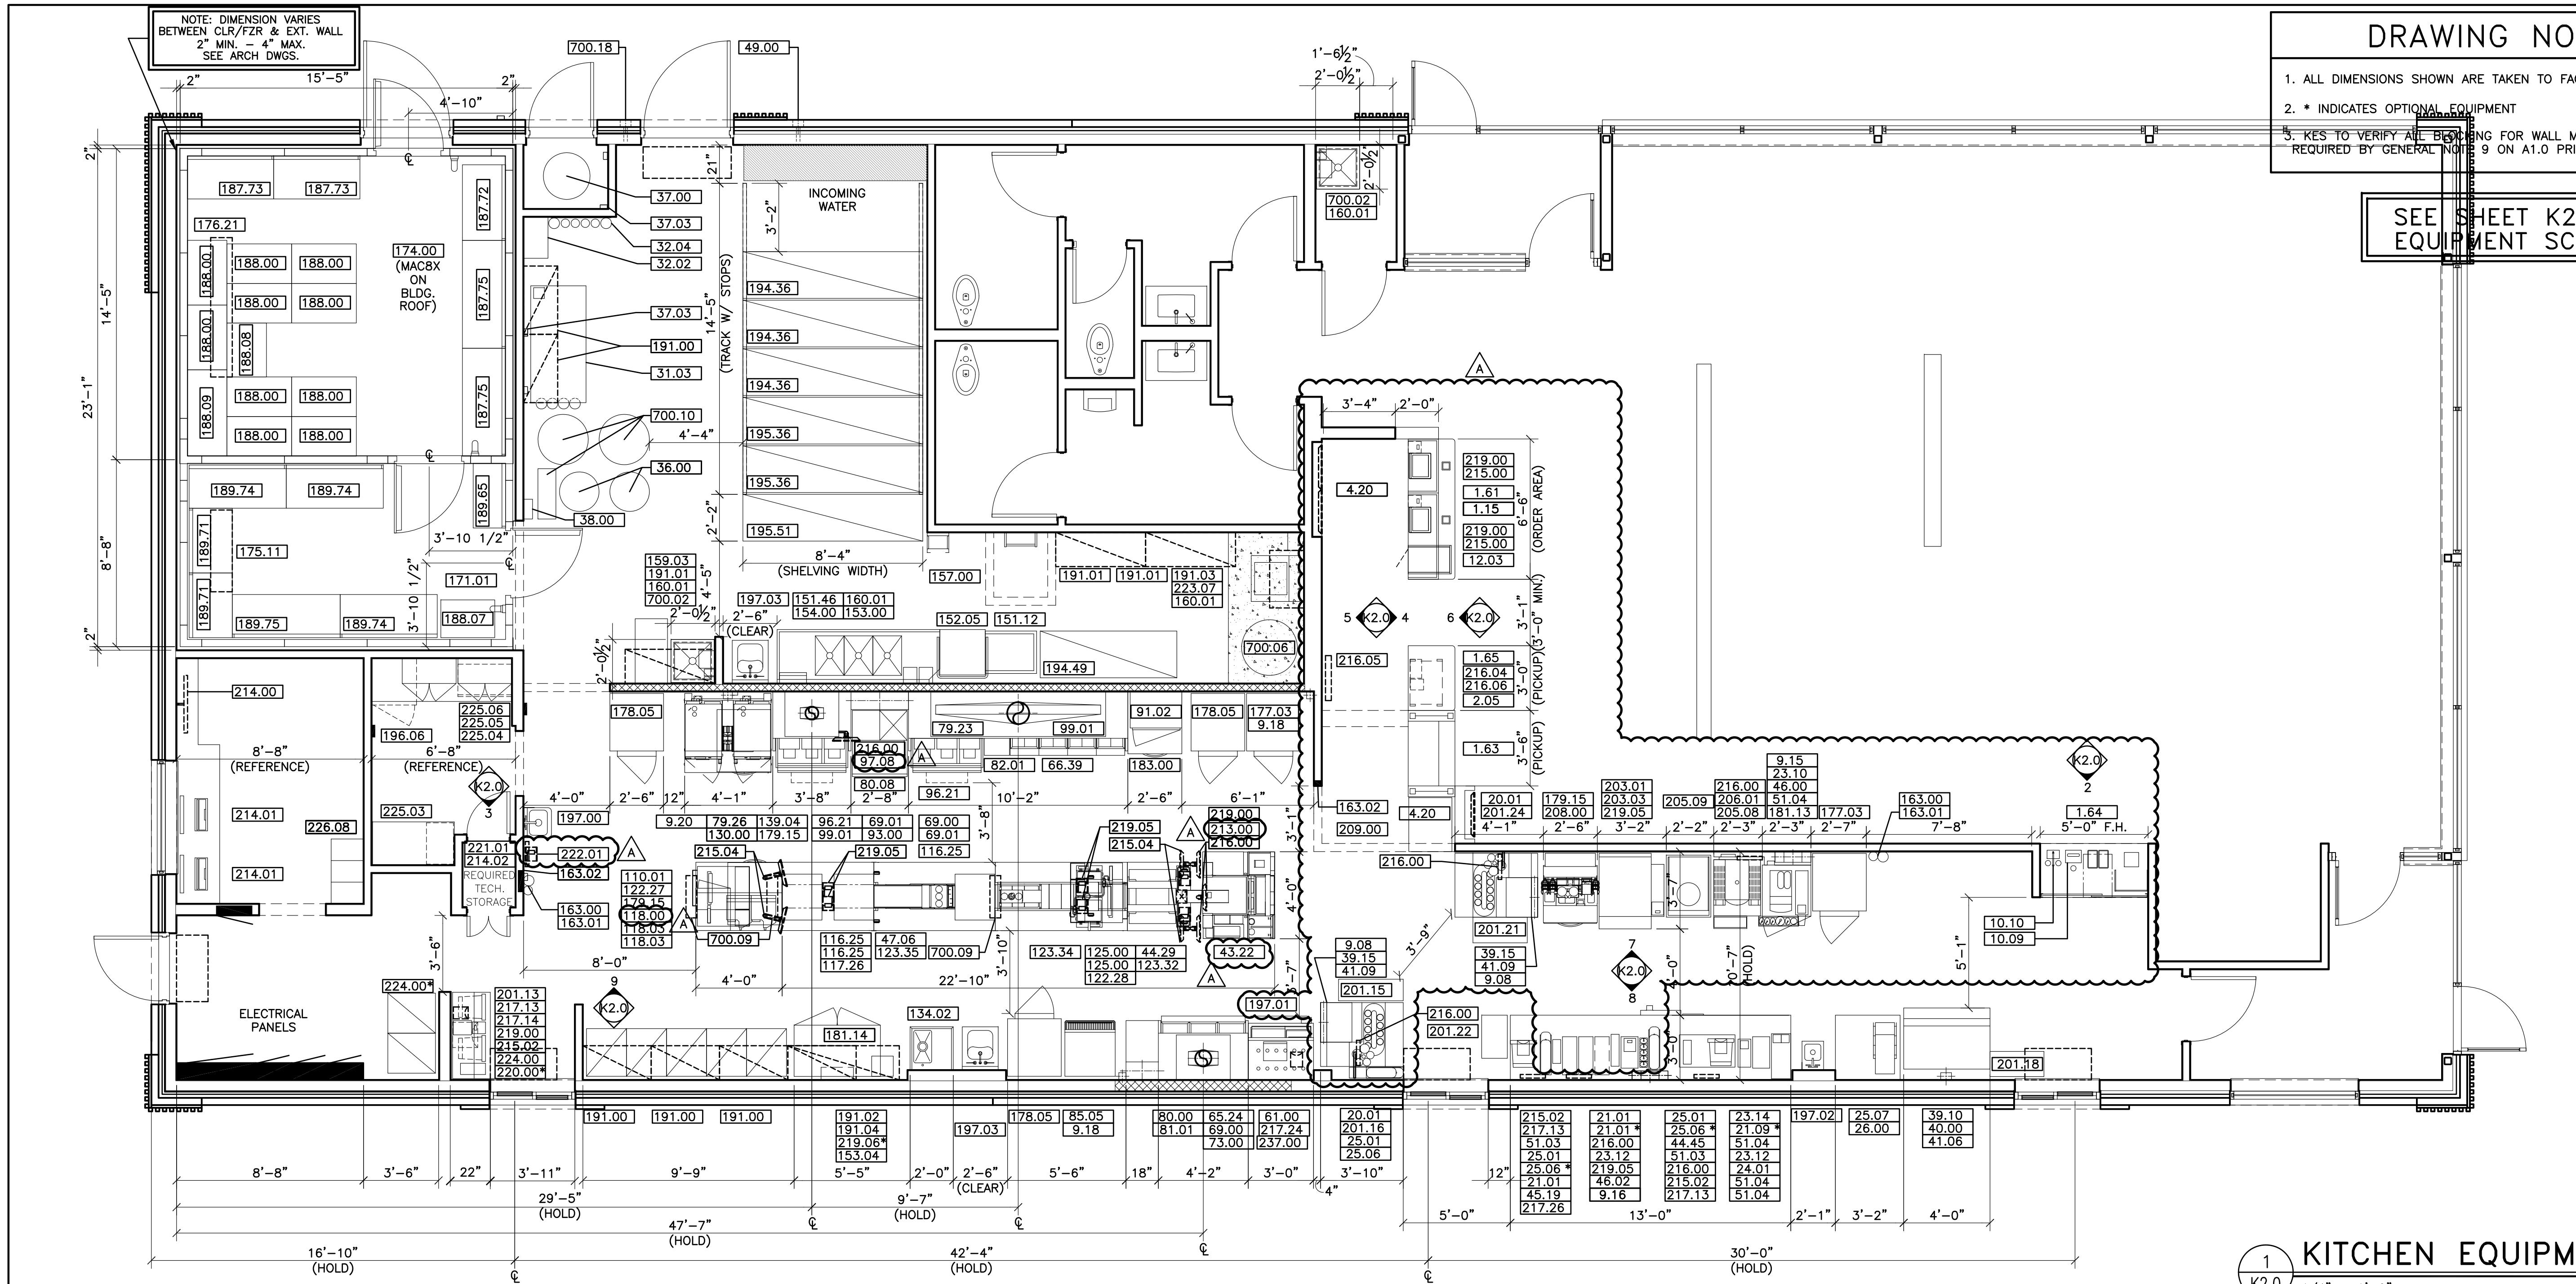

SHEET NO.	TITLE	DRAWN BY	DRAWN FOR:	STD ISSUE DATE	REVIEWED BY	DATE ISSUED	BY
015-0071.000	2019 STANDARD BUILDING - BB20 4597-WOOD/WOOD	RH	M® McDonald's USA, LLC	2019-11	RH	11 15 2019	

DESCRIPTION: WOOD BEARING WALLS W/4" BRICK EXTERIOR FINISH & GI
WOOD ROOF TRUSSES FRAMING
EL.F.S./BATTE/METAL PANEL/BRICK EXTERIOR FINISH
ADDRESS: 605 South 7th St. Kansas City KS
SITE ID: 015-0071

x = Optional Equipment
CC = General Contractor
R = Relocated Equipment

EQUIPMENT SCHEDULE

ITEM	O	QTY	DESCRIPTION	MANUFACTURER	MODEL #	UL	NSF	FURNISHED	GENERAL REMARKS	SPECIAL REQUIREMENTS
1.15	3	SERVICE POD COUNTER PLUS BASE EXTENSION	DECOR	MFC-6	-	2	KES	-		
1.61	1	SERVICE POD - 6"	DECOR	SEE PLAN	-	2	KES	-		
1.63	1	McDELIVERY PICKUP COUNTER	DECOR	SEE PLAN	-	2	KES	-		
1.64	1	AMENITY TOWER	DECOR	SEE PLAN	-	2	KES	-		
1.65	1	PICKUP POD - 36"	DECOR	SEE PLAN	-	2	KES	-		
2.05	1	UNDER COUNTER CART - 24" W x 18" D FRONT	INTERMETRO	DC 8-DMS	-	2	KES	-		
4.20	3	WENBOARD - DIGITAL	LG	49SH7DB	-	-	AT&T	-		
9.08	2	UTILITY CHASE - ICE MAKER ON ABS VERSION	KES	5"x8"x23"	-	2	KES	CONCEALS WATER AND CONDENSING UNIT LINES		
9.15	1	UTILITY CHASE - FFDT INTERIOR WALL	KES	20"x5"x76"	-	2	KES	4 SECTION CHASE FOR BUYOUT RECEPTACLES, POS, CO2 AND WATER		
9.16	2	UTILITY CHASE - FFDT EXTERIOR WALL	KES	20"x5"x76"	-	2	KES	4 SECTION CHASE FOR BUYOUT RECEPTACLES, POS AND WATER		
9.18	2	UTILITY CHASE - WALL VERSION	KES	4"x4"x82"	-	2	KES	CHASE FOR BULK OIL LINES, MOUNT AT 2"-0"		
9.20	1	UTILITY CHASE - COMBI CELL	KES	4"x8"x84"	-	2	KES	CHASE FOR BUYOUT RECEPTACLES AND WATER		
10.09	1	NAPKIN DISPENSER - DROP-IN	GEORGIA PACIFIC	54218	-	2	KES			
10.10	1	CO2 DRIVEN KETCHUP DISPENSER	PERFECTION	MCD-1	-	2	KES			
12.03	1	BAKED GOODS DISPLAY CASE - 14"	ANTUNES	DC-14	-	2	KES			
20.01	2	AUTOMATED BEVERAGE SYSTEM 2.0	MI CORNELIUS	821058990101	-	-	KES	INSTALLATION KIT INCLUDES STAINLESS STEEL CHASE & DATA LINE		
21.01	3	COFFEE BREWER (THERMAL POTS)	BUNN-O-MATIC	AIXOM-DV-3	E32066	4	KES	W/ELECTRONIC CONTROLLER FOR CONVERSION TO LOW OR HIGH VOLTAGE		
21.09	1	HOT WATER DISPENSER	BUNN-O-MATIC	HW2	E32066	4	KES	-		
23.10	1	ESPRESSO BREWER	FRANKE	FM850	-	4	KES	-		
23.12	2	COFFEE CREAM DISPENSER	SURESHOT	AC110-PC-51	E217698	20	KES	-		
23.14	1	SUGAR/SWEETENER DISPENSER	SURESHOT	AC2-6P-30	E217698	18	KES	-		
24.01	1	ORANGE JUICE DISPENSER	TAYLOR	C009	-	18	KES	-		
25.01	3	SIMLINE ICED BEVERAGE DISPENSER	BUNN-O-MATIC	TDO-N	E32066	4	KES	KES TO VERIFY EXACT QUANTITY PER MARKET		
25.06	3	SIMLINE ICED BEVERAGE DISPENSER - SHORT	BUNN-O-MATIC	TDO-N LP	E32066	4	KES	KES TO VERIFY EXACT QUANTITY PER MARKET		
25.07	1	INFUSION TEA BREWER - MIS	BUNN-O-MATIC	ITCB-DV	E32066	4	KES	PROVIDED WITH BREWER, INSTALLATION KIT AND TDO-N BOOSTER		
26.00	1	TEA BREWER TABLE - 30"x36"	ISS SHELVING	WST1756C	-	2	KES	-		
31.03	1	SODA SYSTEM PACKAGE B.I.B.RECIRCULATING - 3 TOWERS) - REMOTE	MULTIPLEX	500GR04	E121876	18	KES	-		
32.02	1	REVERSE OSMOSIS WATER FILTRATION SYSTEM - EVERPURE	EVERPURE	ENVI-RO-600	-	-	KES	FOR COFFEE MAKER, ESPRESSO MACHINE, AND RAPID BUN STEAMER		
32.04	1	WATER FILTRATION SYSTEM	EVERPURE	EV9337-26	-	-	KES	-		
36.00	2	BULK COKE	CHART INDUSTRIES	10667511	-	18	MANUFACTURER	SYRUP LINES BY CHART INDUSTRIES		
37.00	1	BULK CO2 - 750 LB.	CHART INDUSTRIES	CARBO-MAX 750	-	-	MANUFACTURER	-		
37.03	2	CO2 SAFETY SYSTEM	SEE RMKS	-	-	-	KES	SEE MECHANICAL DRAWINGS	INCLUDES DETECTOR AND (4) AV ALARMS	
38.00	1	CLEAN IN PLACE PANEL	CHART INDUSTRIES	10667431	-	18	MANUFACTURER	MOUNT 6" x 7"H. BOX @ 6"-0" AFF TO BOX CENTER LINE		
39.10	1	ICE MACHINE - 1400 LB.	MANITOWOC	IY149N3/B970	SA4027	12	KES	USE HEADMASTER KIT KG0221		
39.15	2	ICE MACHINE - 1000 LB.	MANITOWOC	IB1094YC	SA4027	12	KES	CONDENSER: ICD-1195-263		
40.00	1	ICE MACHINE CHASE	KES	4"x6"x48"	-	2	KES	CONCEALS WATER AND CONDENSING UNIT LINES		
41.06	1	ICE MACHINE REMOTE CONDENSER - 1400 LB	MANITOWOC	JC-1395	SA4027	12	KES	-		
41.09	2	ICE MACHINE REMOTE CONDENSER - 1000 LB	MANITOWOC	JCV-1195-263	SA4027	12	KES	-		
43.22	1	OPTIMIZED ORDER ASSEMBLY TABLE	KES	OOAT 48X48	E152097	2	KES	-		
44.25	1	BREAKER PANEL - 125 AMP - 3 PHASE EQUIPMENT MOUNTED	KES	-	-	-	KES	-		
44.45	1	MEDIUM RISER SHELF - 31" TO 43"	KES	-	-	2	KES	-		
45.19	1	MODULAR BEVERAGE CABINET - 13"-0"	KES	-	-	2	KES	-		
46.00	1	CUP DISPENSER VERTICAL 3 CUP	KES	-	-	2	KES	-		
46.02	1	SYRUP BOTTLE RACK - (5) SYRUP PUMPS	PRONTO	-	-	2	KES	-		
47.06	1	CHILLED RAIL	KES	-	-	7	KES	LOCATED UNDER PREP TABLE OVERSHELF SEE EXTERIOR ELEVATIONS FOR MOUNTING HEIGHT. INSTALLED BY GC		
49.00	1	C02 FILL BOX - 6 1/2"W x 18"H	CHART INDUSTRIES	8512629	-	-	MANUFACTURER	-		
51.03	2	CUP LID HOLDER 3 HIGH S/S	KES	-	-	2	KES	-		
51.04	4	CUP LID HOLDER SINGLE STACK 8" HIGH	KES	-	-	2	KES	-		
51.05	1	FRY BAGGING STATION 36"	KES	FBO1-4	E99018	2	KES	-		
61.00	1	3-VAT LOV FRYER - ELECTRIC - F/F/F	FRYMASTER	BIELA14+BCSD	E44571	4	KES	-		
66.39	1	4-VAT LOV FRYER - ELECTRIC - S/S/S	FRYMASTER	BIELA4+4-BCSD	E44571	4	KES	-		
69.00	2	CAPTURE JET PLenum - FRYER	HALTON	CJF-F	MH27607	2	KES	ATTACH TO UNIVERSAL EXHAUST HOOD		
69.01	2	CAPTURE JET PLenum - GRILL	HALTON	CJF-G	MH27607	2	KES	ATTACH TO UNIVERSAL EXHAUST HOOD		
73.00	1	UNIVERSAL EXHAUST HOOD FULL-CLAM/4-VAT FRYER	KES	UH-50	MH12755	2	KES	-		
79.26	2	VENTLESS HOOD FOR COMBI OVEN	HALTON	COV	E325060	2	KES	-		
80.00	1	MECHANICAL CHASE	KES	9"x18" SCGL	E163328	2	KES	-		
80.08	1	MECHANICAL CHASE	KES	9"x32" SCGL	E163328	2	KES	-		
81.01	1	PRODUCT LANDING SHELF - SOLID TOP	KES	-	-	2	KES	-		
82.01	1	LANDING TABLE WITH POWER	KES	-	-	2	KES	-		
85.05	1	FROZEN FRY DISPENSER	RAM	280-FP	E140753	4	KES	-		
91.02	1	WALL MOUNT FREEZER UNIT-SINGLE WIDE-HIGH CAPACITY	KES	HCWF1	SAT7329	7	KES	AIR-COOLED, SELF-CONTAINED - MOUNT BOTTOM AT 51" AFF	HCWF1.99A INSTALL HARDWARE KIT REQUIRED	
93.00	1	UNIVERSAL EXHAUST HOOD FULL-CLAM GRILL	KES	UH-43	MH12755	2	KES	-		
96.21	2	36" NEXT GEN 3-PLATE CLAMSHELL GRILL - ELECTRIC	GARLAND	ME-3PX	E28898	4	KES	-		
97.08	1	MEAT FREEZER - DOUBLE WID - HIGH	KES	HCMF30B-RH	SA6032 S	2	KES	AIR-COOLED, SELF-CONTAINED		
99.01	2	GRILL TOOL ORGANIZER - 43" HOOD	KES	-	-	2	KES	-		
10.01	1	OPTIMIZED BREAKFAST TABLE	KES	OBT	-	2	KES	-		
116.25	3	UNIVERSAL HOLDING CABINET - HIGH DENSITY - 2-SIDED - PIN & SLEEVE	PRINCE CASTLE	UHC6PT-22MCD	-	4	KES	ETL RATINGS: SAFETY = 3197509CHI-003, SANITATION = 3197509CHI-004		
117.26	1	UHC TABLE HUB & SPOKE - 2 SIDED - 51"D	KES	-	-	2	KES	-		
18.00	1	DING OVEN - PIN & SLEEVE	AMANA	MC23MPW2	E40456	4	KES	-		
118.05	2	QING OVEN - PIN & SLEEVE	ACP	MCMO24	-	4	KES	-		
122.27	1	NEXGEN UNIVERSAL RADIANT TOASTER - PIN	ANTUNES	HRT-5H	-	4	KES	-		
122.28	1	NEXT GEN. UNIVERSAL CONTACT TOASTER - PIN	ANTUNES	HCT-5H	-	4	KES	-		
123.32	1	HUB & SPOKE ELECTRIC COMMUNICATION UTILITY	KES	ECU	-	2	KES	-		
123.34	1	PREP TABLE - HD - 2-SIDED OPL - 38"D x 67 1/2" - PIN & SLEEVE W/REF.	KES	-	-	2	KES	-		
125.00	2	RAPID BUN STEAMER	PRINCE CASTLE	625-MFY	-	4	KES	-		
130.00	2	COMBI OVEN	MANITOWOC	MS110-2083LCMD-1	-	4	KES	-		
134.02	1	VEGETABLE SINK	KES	SKO4-4	-	2	KES	-		
139.04	1	COMBI OVEN STAND - DOUBLE WIDE	KES	-	-	2	KES	-		
151.12	1	CLEAN DISHABLE - LEFT HAND - 28.23"	KES	SK-SPL	-	2	KES	-		
151.46	1	SOILED DISHABLE - RIGHT HAND - 90.5" WIDE	KES	SK-SPL	-	2	KES	-		
152.05	1	WAREWASHER	ECOLAB	OSR TSC	E5956	3	MANUFACTURER	PROVIDE VAPOR VENT - REQUIRED		
153.00	1	SCULLERY SHELVING KIT - 3 TIER - 14" x 36"	INTERMETRO	SHSS-4	-					