

GENERAL NOTES

1. ALL WORK SHALL BE IN COMPLIANCE WITH APPLICABLE FEDERAL, STATE AND LOCAL BUILDING CODES, REGULATIONS, ORDINANCES AND STANDARDS INCLUDING ADA AND OR OTHER HANDICAP ACCESSIBILITY CODES.
2. GENERAL CONTRACTOR IS RESPONSIBLE FOR COORDINATING WITH THE OWNER'S VENDORS REGARDING SCHEDULING ON SITE DURING CONSTRUCTION AND SEQUENCING OF THE WORK.
3. THE CONSTRUCTION NOTES AND DRAWINGS ARE SUPPLIED TO ILLUSTRATE THE DESIGN INTENT AND GENERAL TYPE OF CONSTRUCTION DESIRED AND ARE INTENDED TO IMPLY THE FINEST QUALITY OF CONSTRUCTION, MATERIAL AND WORKMANSHIP THROUGHOUT.
4. THE DRAWINGS ARE NOT TO BE SCALED. FOR INFORMATION CONCERNING EXISTING CONDITIONS, ETC., VERIFICATION MUST BE DONE IN THE FIELD. LARGE SCALE DRAWINGS HAVE PRECEDENCE OVER SMALL SCALE DRAWINGS.
5. PRIOR TO COMMENCEMENT OF ANY CONSTRUCTION, CONTRACTOR SHALL VERIFY EXISTENCE AND LOCATION OF ALL EXISTING ABOVE AND BELOW GRADE, UTILITIES, INCLUDING SANITARY SEWER, STORM SEWER, WATER, GAS, ELECTRICAL, TELEPHONE, ETC. ANY DISCREPANCIES IN UTILITY LOCATIONS SHALL BE BROUGHT TO THE IMMEDIATE ATTENTION OF THE ARCHITECT.
6. GENERAL CONTRACTOR SHALL BE RESPONSIBLE FOR VERIFICATION OF ALL BUILDING DIMENSIONS PRIOR TO BEGINNING CONSTRUCTION AND SHALL IMMEDIATELY NOTIFY THE ARCHITECT OF ANY VARIANCE OR DISCREPANCY AFFECTING NEW CONSTRUCTION PRIOR TO PROCEEDING WITH WORK.
7. CONTRACTOR SHALL PROVIDE ALL NECESSARY BLOCKING IN WALLS FOR SUPPORT OF ALL EQUIPMENT, SHELVING, ACCESSORIES, SIGNAGE, AND OTHER DEVICES REQUIRED.
8. ALL PENETRATIONS SHALL RECEIVE CAULKING TO SEAL ANY TYPE OF ENERGY LOSS.
9. THE CONTRACTOR SHALL VERIFY AND COORDINATE ALL APPLICABLE DIMENSIONS OF FIXTURES AND EQUIPMENT SUPPLIED AND/OR INSTALLED BY OTHERS.
10. UPON COMPLETION OF PROJECT, G.C. TO OBTAIN ALL FINAL INSPECTIONS AS REQUIRED BY LOCAL JURISDICTIONS AND FURNISH OWNER WITH EVIDENCE OF ALL SUCH INSPECTIONS AND CERTIFICATES OF OCCUPANCY.
11. SIGNS, UNLESS NOTED OTHERWISE, ARE PROVIDED BY OWNER'S SIGN CONTRACTOR. OWNER'S SIGN VENDOR WILL PROVIDE MONUMENT SIGN BASE (CONCRETE, STONE, BRICK, ETC.) IF PROJECT REQUIRES DECORATIVE BASE. SEE SHEET L-1 TO VERIFY IF REQUIRED. GENERAL CONTRACTOR TO PROVIDE ROUGH-IN & FINAL CONNECTION AND BRAILLE EXIT SIGN.
12. GENERAL CONTRACTOR TO PROVIDE FOUR (4) 30 YARD DUMPSTERS DURING McDONALD RETAIL MOVE-IN.
13. GENERAL CONTRACTOR SHALL PROVIDE ONE SKILLED LABORER FOR ONE WEEK DURING McDONALD RETAIL MOVE-IN. (40 HOURS)
14. GENERAL CONTRACTOR SHALL BE RESPONSIBLE FOR SET-UP AND COORDINATION OF ALL THE UTILITY SERVICES FOR THE PROJECT.
15. ALL EXTERIOR FLOOR PLAN DIMENSIONS ARE TO EXTERIOR FACE OF MASONRY UNLESS OTHERWISE NOTED. ALL INTERIOR FLOOR PLAN DIMENSIONS ARE TO FACE OF FINISH UNLESS OTHERWISE NOTED.
16. FINAL KEYING TO BE COORDINATED WITH McDONALD FACILITY MANAGER AND PAID FOR BY McDONALD.
17. REFER TO "PROJECT MANUAL" FOR ALL OTHER INSTRUCTIONS & DIRECTIVES NOT SHOWN IN DRAWINGS.

ABBREVIATIONS

GENERAL ABBREVIATIONS

A	ANNEALED	INSUL	INSULATION
AC	AIR CONDITIONING	MAX	MATERIAL
ACT	ACOUSTIC CEILING TILE	MECH	MECHANICAL
AFF	ABOVE FINISH FLOOR	MFR	MANUFACTURER
AHU	AIR HANDLING UNIT	MIN	MINIMUM
AL	ALUMINUM	MO	MASONRY OPENING
ASPH	ASPHALT	MR	MOISTURE RESISTANT
CJ	CONTROL JOINT	MTL	METAL
CLNG	CEILING	NA	NOT APPLICABLE
CMU	CONCRETE MASONRY UNIT	NIC	NOT IN CONTRACT
COL	COLUMN	NOM	NOMINAL
CONC	CONTINUOUS	NTS	NOT TO SCALE
CONT	CONTINUOUS	OC	ON CENTER
CP	CONCRETE PAD	OPP	OPPOSITE
CT	CEMERIC TILE	OPT	OPTIONAL
CL	CENTERLINE	PF	PREFABRICATED
DBL	DOUBLE	PSF	POUNDS PER SQUARE FOOT
DF	DRINKING FOUNTAIN	PT	PRESSURE TREATED
DIA	DIAMETER	PTD	PAINTED
DIM	DIMENSION	QT	QUARRY TILE
DN	DOWN	R	RADIUS
DS	DOWNSPOUT	REBAR	REINFORCING BAR
EA	EACH	REF	REFERENCE
EJ	EXPANSION JOINT	REQD.	REQUIRED
ELEC	ELECTRICAL	RO	ROUGH OPENING
ELEV	ELEVATION	SB	SPLASHBLOCK
EQ	EQUAL	SIM	SIMILAR
EXIST	EXISTING	SPEC	SPECIFICATION
FD	FLOOR DRAIN	SS	STAINLESS STEEL
FE	FIRE EXTINGUISHER	STL	STEEL
FEC	FIRE EXTINGUISHER CABINET	STOR	STORAGE
FF	FINISH FLOOR	SUSP	SUSPENDED
FR	FIRE RATED	TEMP	TEMPERATURE
FRP	FIBERGLASS REINFORCED PLASTIC	TYP	Typical
GALV	GALVANIZED	UNO	UNLESS NOTED OTHERWISE
GYP BD	GYPSUM BOARD	VCT	VINYL COMPOSITION TILE
HC	HANDICAP	VERT	VERTICAL
HDW	HARDWARE	WD	WOOD
HM	HOLLOW METAL	WP	WATERPROOF
HT	HEIGHT	WWF	WELDED WIRE FABRIC
HVAC	HEATING, VENTILATION, AIR CONDITIONING		

MCDONALD'S ABBREVIATIONS


AP	APOLIC MENTAL PANEL	LAM	LAMINATE
BM	BRAKE METAL	LE	ACCENT LIGHTING
C	ALUMINUM CANOPY	LP	LOW POINT
CG	CORNER GUARD	LL	LEVEL LANDING
CT	WALL TILE	MACHINE	
DE	DECOR ELEMENT	MANAGER	
DEVICE		MF	METAL FASCIA
DMB	DIGITAL MENU BOARD	MS	MOP SINK
DS	DROP SOFFIT	PB	PIPE BILLARD
D/T	DRIVE-THRU	PT	RMHC COIN COLLECTOR
FB	FILL BOX	RL	ROOF LADDER
F/C	FREEZER/COOLER	ROOM	
GC	GENERAL CONTRACTOR	S	MCDONALD'S SIGNAGE
HP	HIGH POINT	SCH	SHLUTER
KIOSK		SSBB	SELF SERVE BEVERAGE BAR
L	LIGHT FIXTURE	UN	ALUMINUM CANOPY underscore

SHEET NO.		TITLE		DRAWN BY		PREPARED BY:		DRAWN FOR:	
015-0071.00.0		2019 STANDARD BUILDING - BB20 459-F10-WOOD/WOOD		DIA STD ISSUE DATE 2019_11		McDonald's USA, LLC		12400 ARCHITECTURE & PLANNING BURNSVILLE, MN 55378 EMAIL: DATA@REPRISEDI.SIGN PHONE: (952) 252-4042 FAX: (952) 252-4043	
DESCRIPTION		DESCRIPTION		REVIEWED BY		REVIEWED BY		REVIEWED BY	
WOOD BEARING WALLS W/FIBER CEMENT SIDING & CI WOOD ROOF TRUSS FRAMING FIBER CEMENT PANEL/BATTEN/APOLIC PANEL/BRICK EXT. FINISH		KOD DATE ISSUED 01/23/20		KO DATE ISSUED 01/23/20		KO DATE ISSUED 01/23/20		KO DATE ISSUED 01/23/20	
SITE ID 015-0071		SITE ADDRESS 605 SOUTH 7TH STREET, KANSAS CITY, KS		SIGNATURE Signature Architect, Inc. DIA Date 01/23/20		SIGNATURE Signature Architect, Inc. DIA Date 01/23/20		SIGNATURE Signature Architect, Inc. DIA Date 01/23/20	
REV #		DATE		REV #		DATE		REV #	
GN1.0		GENERAL NOTES		GN1.0		GENERAL NOTES		GN1.0	

I hereby certify that this drawing, specification or report was prepared under my direction and supervision, and was drawn by me or under the direction of my registered architect, and was plotted or reduced from the drawings of the State of Minnesota.

Signature
Architect, Inc.
DIA
Date
01/23/20
Registration Number
Data

THE LAYOUT OF THE DRIVE-THRU LANES SHOWN IN THIS DETAIL ILLUSTRATES DRIVE-THRU DESIGN PRINCIPLES.

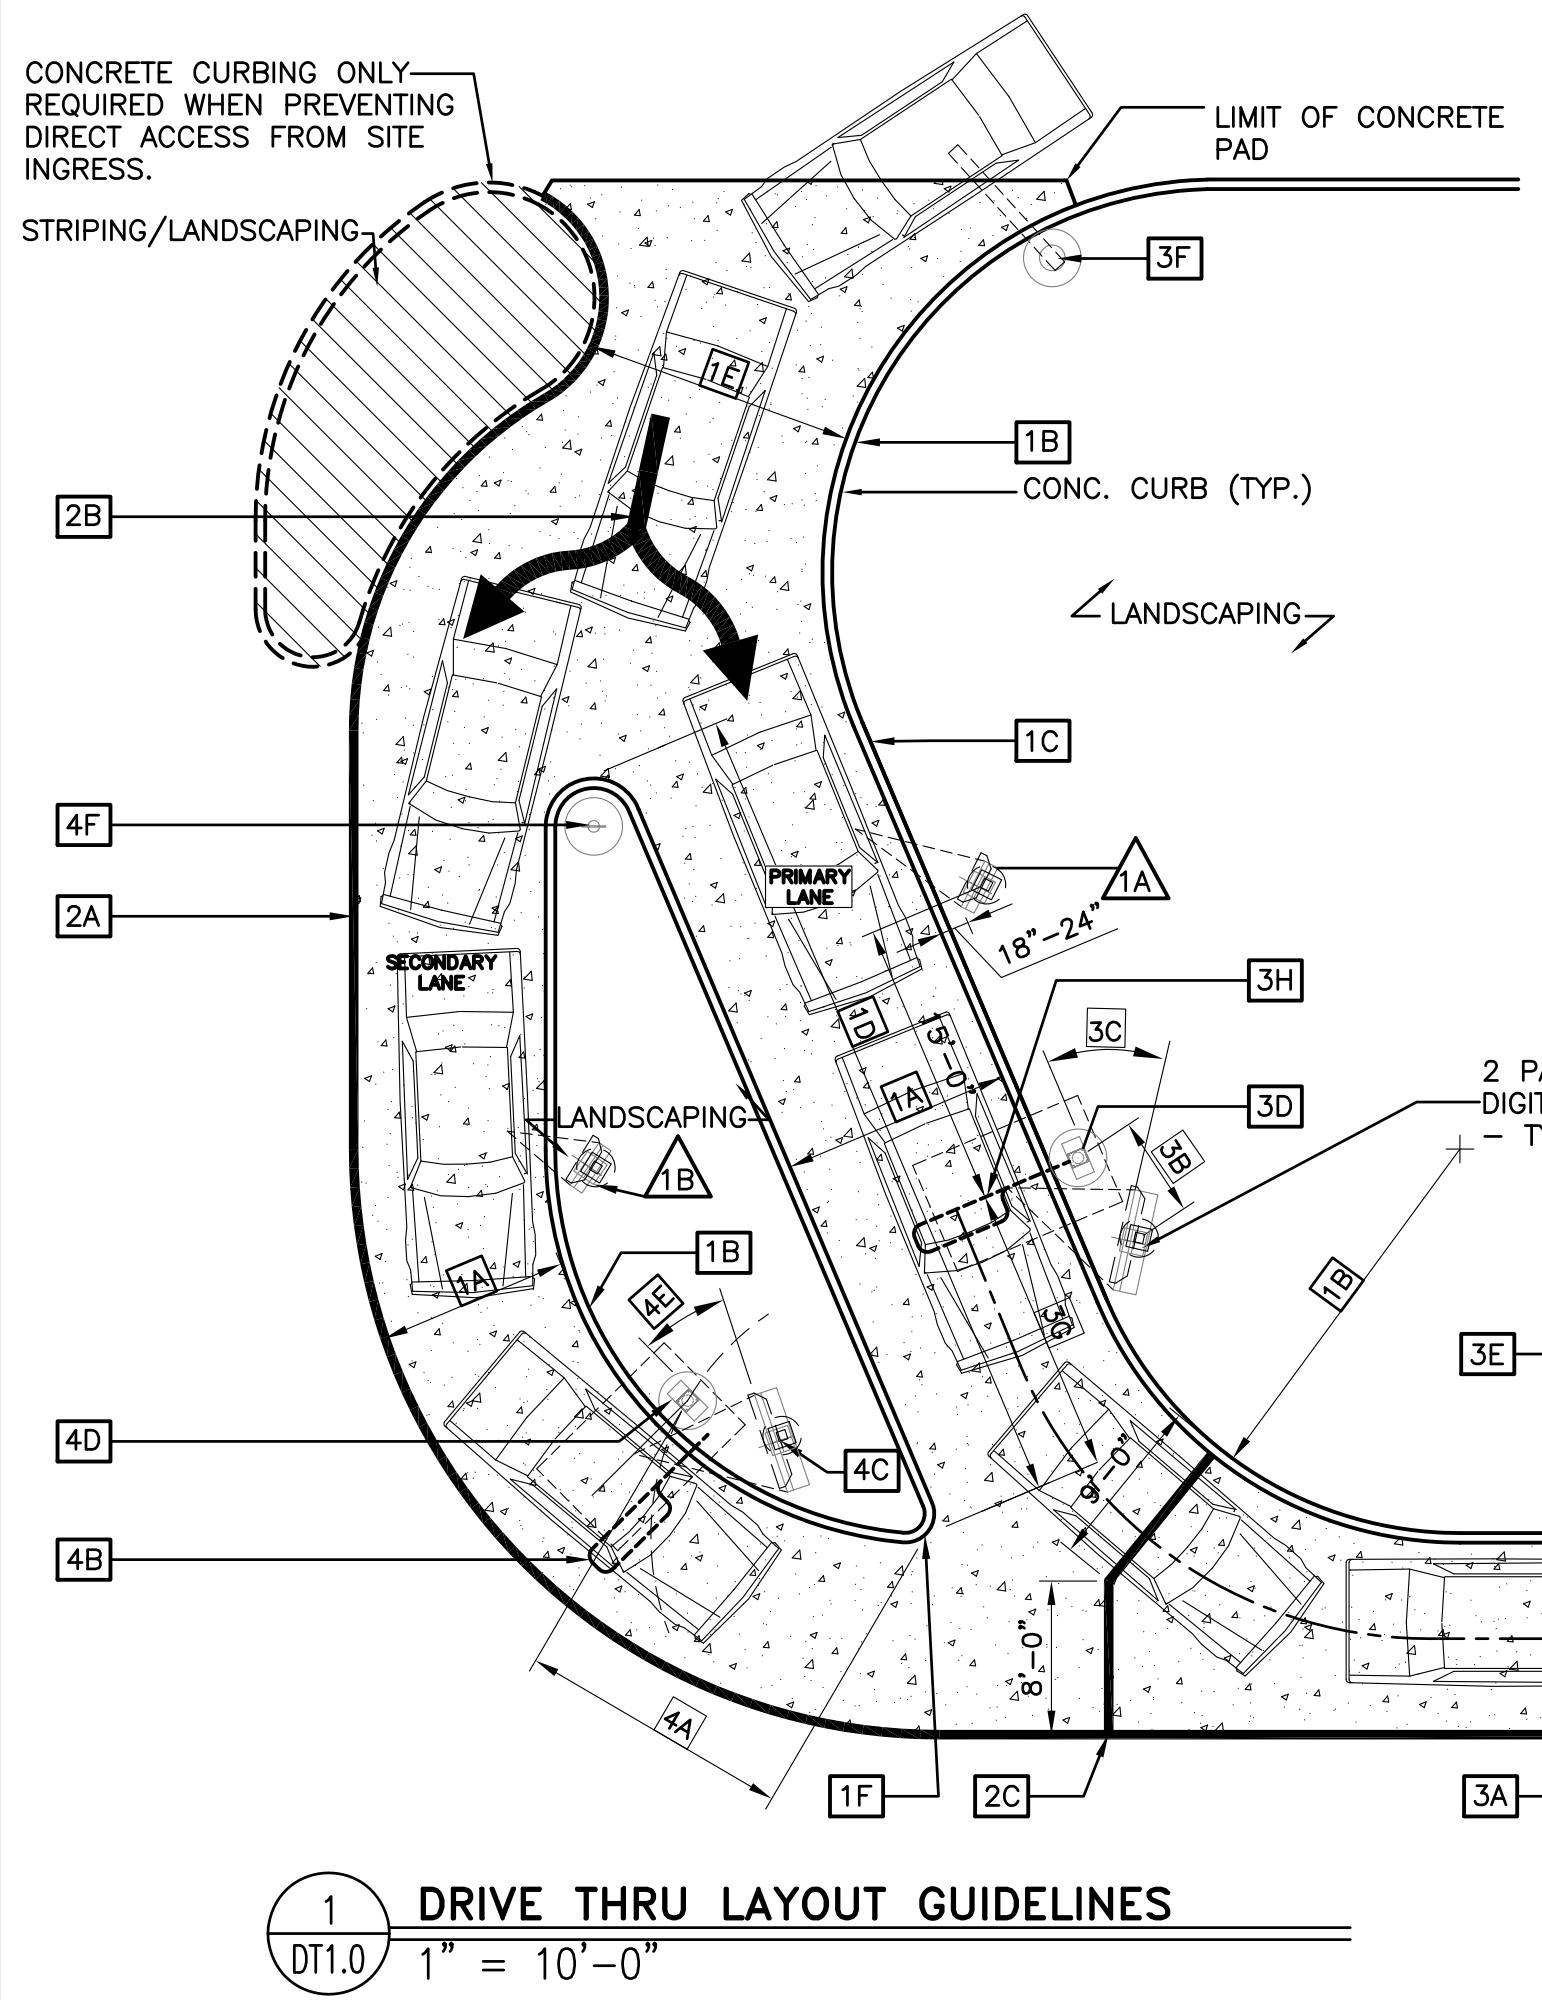


1 DRIVE THRU LAYOUT GUIDELINES

DT1.0 1" = 10'-0"

NOTES

- VERIFY CONDUIT SIZES AND LAYOUT WITH DETECTOR LOOP MANUFACTURER.
- CENTER VEHICLE DETECTOR LOOP IN DRIVE THRU LANE. INSTALL PER MFR. RECOMMENDATIONS.
- NO STEEL (REBAR OR ELECTRICAL WIRE) SHALL BE USED WITHIN 2' OF LOOP.
- DETECTOR LOOP MANUFACTURERS:
DETECTOR LOOPS MAY BE BY ONE OF THE FOLLOWING COMPANIES OR EQUAL.
3M: 1-800-328-0033
HME: 1-800-848-4468
- DETECTOR LOOP MATERIAL:
PVC TUBING 1/2" I.D. 100 PSI LOOP MADE FROM ONE LENGTH OF THIN FOURTEEN GAUGE STRANDED WIRE. LEAD-IN IS PRE-TWISTED AT FACTORY.
- DETECTOR LOOP CONSTRUCTION:
FORMED WITH ONE CONTINUOUS LENGTH OF PVC WITH NO SHARP CORNERS AS DETAILED. WIRE LOOPED, FORMED, & PIGTAILED AS DETAILED.

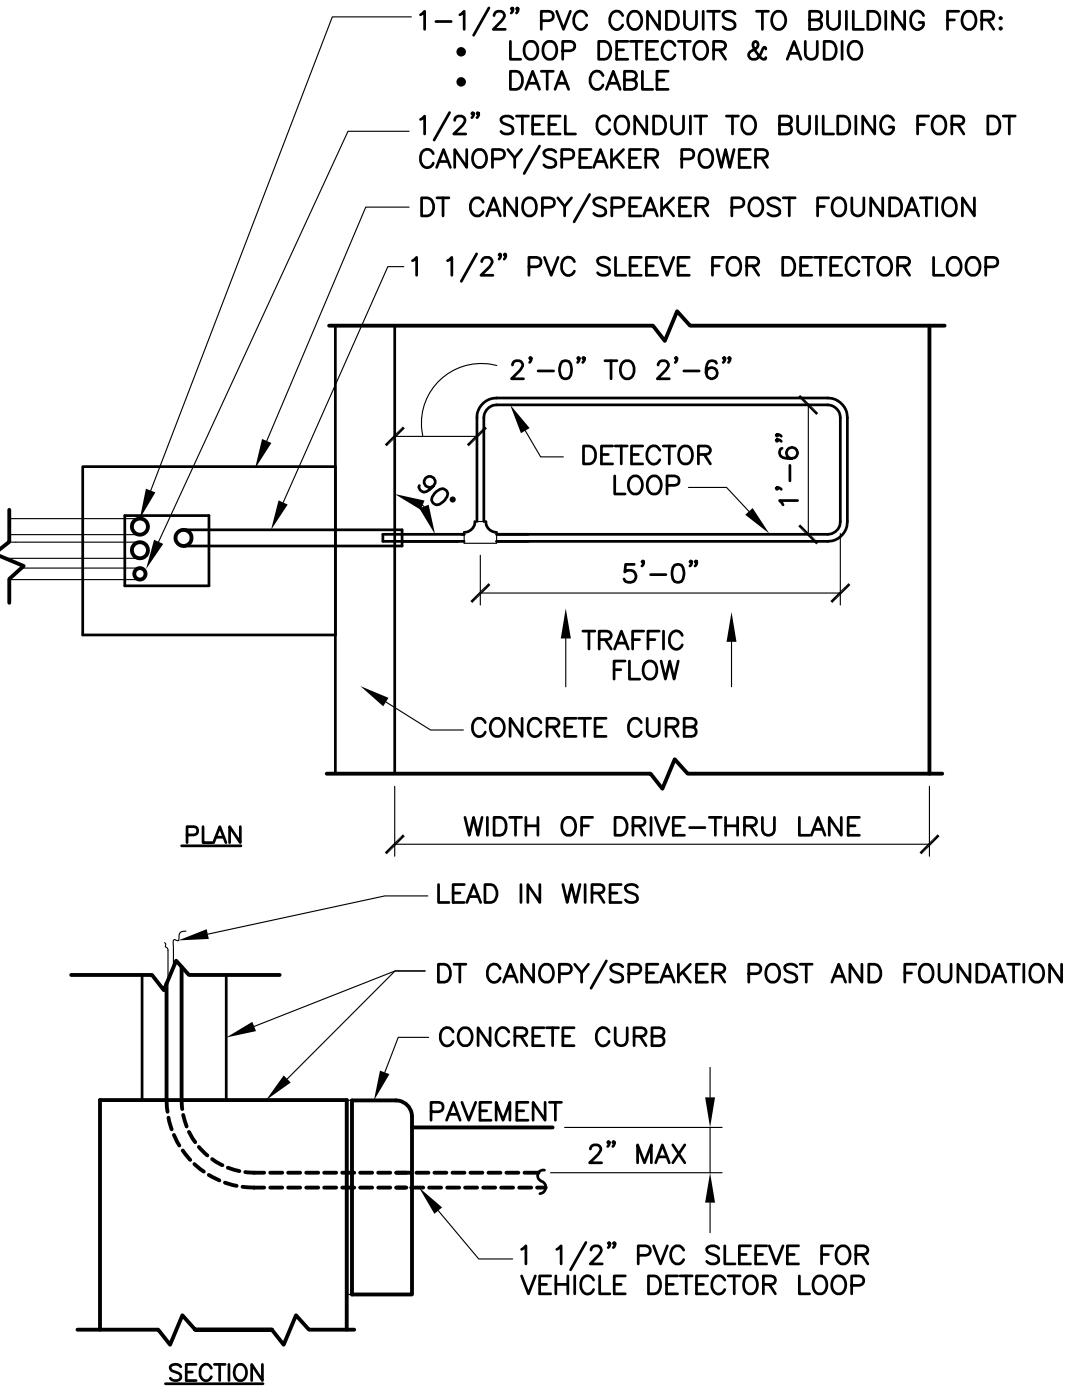

2 DETECTOR LOOP DETAILS

DT1.0 NOT TO SCALE

SIDE BY SIDE DRIVE-THRU STANDARD 1.0

- SIDE BY SIDE DRIVE-THRU STANDARD 1.0 CURBING DETAILS:**
 - DRIVE-THRU LANES BOUND BY CURB ON BOTH SIDES ARE TO BE 12'-0". LANES BOUND BY CURB ON ONE SIDE AND PAINTED STRIPING ON THE OTHER SIDE ARE TO BE A MIN. OF 10'-0".
 - THE MIN. RADIUS FOR ALL INSIDE/DRIVER'S SIDE DRIVE-THRU CURBING IS 20'-0".
 - PRIMARY LANE CURBING SHOULD BE AS STRAIGHT AS POSSIBLE. (LESS CURVING, THE BETTER).
 - THE OVERALL LENGTH OF THE CURBED ISLAND SHOULD BE 35'-45'. THE LENGTH OF THE ISLAND FROM THE DT CANOPY/SPEAKER ALLOWS FOR THREE CARS IN THE SECONDARY LANE, TWO IN THE PRIMARY LANE AND ONE AT THE COMMITMENT POINT.
 - ENTRANCE LANE ENTERING THE SIDE BY SIDE DRIVE-THRU IS TO BE 14'-0" MIN.
 - THE RADIUS FOR THE ISLAND TIP SHALL BE 1'-6".
- SIDE BY SIDE DRIVE-THRU STANDARD 1.0 PAVEMENT MARKINGS:**
 - 6" WIDE YELLOW PAINT STRIPE TO SPAN OUTER EDGE OF THE ENTIRE DRIVE-THRU LANE. LANE STARTS AT DRIVE-THRU ENTRANCE WHERE "McDONALD'S GATEWAY" SIGN IS LOCATED.
 - DOUBLE-HEADED ARROW PAVEMENT MARKING. STANDARD STRIPING MARKINGS ARE 7"-0" SHAFT, 7'-0" ARROW STEM AND 3"-0" FOR THE ARROW HEAD. TIP OF ARROW HEAD TO BE LOCATED AT CENTER OF EACH LANE.
 - MERGE POINT IS LOCATED WHERE TWO VEHICLES LEAVING EACH DT CANOPY/SPEAKER SIMULTANEOUSLY MEET. THE MERGE POINT STRIPING IS TO BE LOCATED BY OFFSETTING THE INNER PRIMARY LANE BACK OF CURB 9'-0" AND OFFSETTING THE OUTER LANE STRIPING 8'-0". AT THE INTERSECTION OF THESE OFFSETS, A 6" YELLOW STRIPE IS TO BE MARKED PERPENDICULAR TO THE OUTER LANE AS WELL AS THE INNER PRIMARY LANE.
 - THE WORDS "THANK YOU" ARE TO BE PLACED 8" FROM THE EDGE OF THE YELLOW STRIPE TO THE BOTTOM OF THE WORD "YOU".
 - THE 8" YELLOW STRIPE IS TO BE PLACED 40'-0" FROM THE CENTER LINE OF THE OPEN PRESENT WINDOW AND IS FOR PARKING CARS THAT ARE WAITING FOR ORDERS.
 - A CIRCLE DIRECTIONAL ARROW CENTERED ABOVE THE WORD "DRIVE THRU" USED TO INDICATE THE DRIVE THRU ENTRY POINT.

- SIDE BY SIDE DRIVE-THRU STANDARD 1.0 EQUIPMENT POSITIONING FOR PRIMARY LANE:**
 - MIN. 60'-0" (+5', 60'-65') LINEAR DISTANCE BETWEEN THE CENTER LINE OF THE PRIMARY DT CANOPY/SPEAKER AND THE CENTER LINE OF THE OPEN ORDER BOOTH WINDOW AS MEASURED ALONG THE CENTER LINE OF THE LANE. THIS MAY ONLY BE INCREASED IN 20'-0" INCREMENTS (+5' FOR 80', 100', AND 120') TO A MAX OF 120'. 100'-0" IS OPTIMAL.
 - THE CENTER OF THE PRIMARY MENU BOARD FOUNDATION IS TO BE 5'-9" (5'-6" MIN. AND 6'-0" MAX.) FROM THE CENTER OF THE DT CANOPY/SPEAKER FOUNDATION WITH THE END CAP OF THE PRIMARY MENU BOARD 15" PREFERRED BUT NOT LESS THAN 12" FROM THE FACE OF CURB.
 - THE PRIMARY MENU BOARD SHOULD BE AT AN ANGLE OF APPROXIMATELY 25° TO 35° ANGLE (35° PREFERRED) FROM A CAR POSITIONED AT THE DT CANOPY/SPEAKER AND WITH 100% VISIBILITY.
 - AUGER "McDONALD'S ORDER HERE CANOPY" CANOPY FOUNDATION TIGHT AGAINST BACK OF CURB. SEE MANUFACTURER/LOCAL SPECIFICATIONS FOR DETAILS.
 - A SINGLE BOLLARD SHOULD BE POSITIONED AT THE CORNER OF THE BUILDING ON THE DRIVE-THRU SIDE. IT SHOULD BE FLUSH AGAINST THE BUILDING AND FACE OF THE BOLLARD SHOULD BE TIGHT AGAINST THE BACK OF THE CURB.
 - AUGER "McDONALD'S GATEWAY" SIGN FOUNDATION TIGHT AGAINST BACK OF CURB. SEE MANUFACTURER/LOCAL SPECIFICATIONS FOR DETAILS.
 - THE DISTANCE BETWEEN THE TIP OF THE CURBED ISLAND AND THE CENTER LINE OF THE PRIMARY DT CANOPY/SPEAKER MUST BE 15'-0". THIS MEASUREMENT IS TAKEN PARALLEL TO THE INSIDE CURB FACE OF THE PRIMARY LANE.
 - THE PRIMARY LANE DETECTOR LOOP SHOULD BE PERPENDICULAR TO THE CENTER OF THE PRIMARY DT CANOPY/SPEAKER.
- SIDE BY SIDE DRIVE-THRU STANDARD 1.0 EQUIPMENT POSITIONING FOR SECONDARY LANE:**
 - TO POSITION THE SECONDARY DT CANOPY/SPEAKER, DRAW AN ARC WITH A 14' RADIUS THAT IS CENTERED FROM THE MIDPOINT OF THE ISLAND TIP. THEN OFFSET THE FACE OF THE CURB BY 24" TO DETERMINE THE LOCATION OF CENTER OF FOUNDATION OF THE SECONDARY DT CANOPY/SPEAKER.
 - WHEN THE SECONDARY DT CANOPY/SPEAKER IS LOCATED AT 14'-0" FROM THE TIP OF THE CURBED ISLAND, THE LOOP DETECTOR IS TO BE 2'-0" FORWARD OF THE DT CANOPY/SPEAKER CENTER LINE WITH THE LOOP FACING FORWARD AND THE DETECTOR LOOP PERPENDICULAR TO THE SECONDARY DT CANOPY/SPEAKER WHEN POSSIBLE.
 - THE CENTER OF THE SECONDARY MENU BOARD FOUNDATION SHALL BE 5'-9" (5'-6" MIN. AND 6'-0" MAX.) FROM CENTER OF THE DT CANOPY/SPEAKER FOUNDATION WITH THE END CAP OF THE SECONDARY MENU BOARD 15" PREFERRED BUT NOT LESS THAN 12" FROM FACE OF CURB.
 - AUGER "McDONALD'S ORDER HERE" DT CANOPY/SPEAKER FOUNDATION TIGHT AGAINST BACK OF CURB. SEE MANUFACTURER/LOCAL SPECIFICATIONS FOR DETAILS.
 - THE SECONDARY MENU BOARD SHOULD BE AT AN ANGLE OF APPROXIMATELY 25° FROM A VEHICLE POSITIONED AT THE DT CANOPY/SPEAKER AND WITH 100% VISIBILITY.
 - "ANY LANE, ANY TIME" BOLLARD SIGN MUST BE A MIN. OF 1'-6" FROM FACE OF CURB AT THE BEGINNING OF THE LANDSCAPE ISLAND. BOLLARD SIGN IS TO BE ORIENTED AT AN ANGLE OF 90° FROM THE CURB.
- SIDE BY SIDE DRIVE-THRU STANDARD 1.0 DETECTOR LOOP:**
 - DETECTOR LOOPS SHALL BE LOCATED AT THE CENTER OF THE OPENING WINDOW AT THE CASH AND PRESENTER BOOTHS.


SIDE BY SIDE DRIVE-THRU STANDARD 1.0 FEATURES:

- SIDE BY SIDE DRIVE-THRU STANDARD 1.0 EQUIPMENT:**
 - PRE-BROWSE BOARD MUST BE 18"-24" FROM FACE OF CURB. THE DISTANCE AS MEASURED ALONG THE FACE OF CURB. THIS IS MEASURED FROM THE CENTER OF THE PRE-BROWSE BOARD FOUNDATION TO THE CENTER OF THE DT CANOPY/SPEAKER FOUNDATION. THE ANGLE (APPROXIMATELY 50°) OF THE PRE-BROWSE BOARD SHOULD MAXIMIZE VISIBILITY TO THE SECOND CAR FROM DT CANOPY/SPEAKER.
 - PRE-BROWSE BOARD MUST BE MIN. 12" FROM FACE OF CURB. THE DISTANCE AS MEASURED ALONG FACE OF CURB. THIS IS MEASURED FROM THE POINT PERPENDICULAR TO THE CENTER OF THE PRE-BROWSE BOARD FOUNDATION TO THE POINT PERPENDICULAR TO THE CENTER OF THE DT CANOPY/SPEAKER FOUNDATION. THE ANGLE OF THE PRE-BROWSE BOARD SHOULD MAXIMIZE VISIBILITY TO THE SECOND CAR FROM DT CANOPY/SPEAKER (PREFERRED 35°).

GENERAL NOTES


- DRIVE-THRU ELEMENTS:**
DT CANOPY/SPEAKER DRIVE-THRU PYLON/CLEARANCE POLE AND BOLLARD SIGN SHALL BE CONSISTENT WITH THE STANDARD BUILDING DESIGN DRIVE-THRU ELEMENTS.
OTHER DESIGNS MAY NOT BE USED.
- CONTRACTOR SHALL COORDINATE WITH APPLICABLE PLANS, McDONALD'S AREA CONSTRUCTION MANAGER, CONTENT SUPPLIER AND SIGNAGE SUPPLIER TO DETERMINE EXACT LOCATION, ORIENTATION, MOUNTING HEIGHTS, AND NUMBER OF BOARDS AND OTHER DRIVE-THRU ELEMENTS TO BE INSTALLED AT THIS SITE. ALL WORK TO BE COORDINATED WITH OTHER TRADES.
- CONTACT McDONALD'S AREA CONSTRUCTION MANAGER FOR DRIVE-THRU ELEMENT FOOTING AND WIRING REQUIREMENTS NOT SHOWN. (INFORMATION ALSO AVAILABLE THROUGH VENDOR WEBSITES) SIGNAGE MANUFACTURER TO PROVIDE FOOTING ANCHORS & TEMPLATES TO G.C. PRIOR TO FOUNDATION POURING.
- SEE DETAIL 2/DT1.0 FOR DETECTOR LOOP INFORMATION, ELECTRICAL SHEETS FOR LOW VOLTAGE CONDUIT DIAGRAM AND FOR DRIVE THRU POWER DIAGRAM; VENDOR'S SPECIFICATIONS SHALL GOVERN UPON ANY DISCREPANCIES.
- CONTRACTOR TO COORDINATE THE RESPONSIBILITIES OF THE ELECTRICAL CONTRACTOR, CONTENT SUPPLIER AND THE SIGN SUPPLIER.
- CONTRACTOR TO INSTALL PRE-FORMED, PRE-WIRED VEHICLE DETECTOR LOOP.
- CONTRACTOR SHALL VERIFY CONDUIT SIZES REQUIRED BY VEHICLE LOOP DETECTOR SUPPLIER.

PREPARED BY:		McDonald's USA, LLC	
© 2019 McDonald's USA, LLC These drawings and specifications are the confidential and proprietary property of McDonald's USA, LLC and shall not be copied or reproduced without the express written consent of McDonald's USA, LLC. Use of these drawings and specifications in conjunction with other plans and/or for use on a different site or at a later time, or for any other purpose, requires the services of properly licensed architects and engineers. Reproduction of these drawings and specifications without the express written consent of McDonald's USA, LLC is unauthorized.			
DRAWN BY	-	STD ISSUE DATE	REVIEWED BY
		2019-11	RH
DESCRIPTION	2019 STANDARD BUILDING - BB20	DATE ISSUED	11 15 2019
ITEM NO.	015-0071.00	SITE ID	ELTS./BATTEN/METAL PANEL/BRICK EXTERIOR FINISH
	015-0071.00	ADDRESS	605 South 7th St, Kansas City, KS
SHEET NO.	DT1.0	DRIVE-THRU DETAILS	

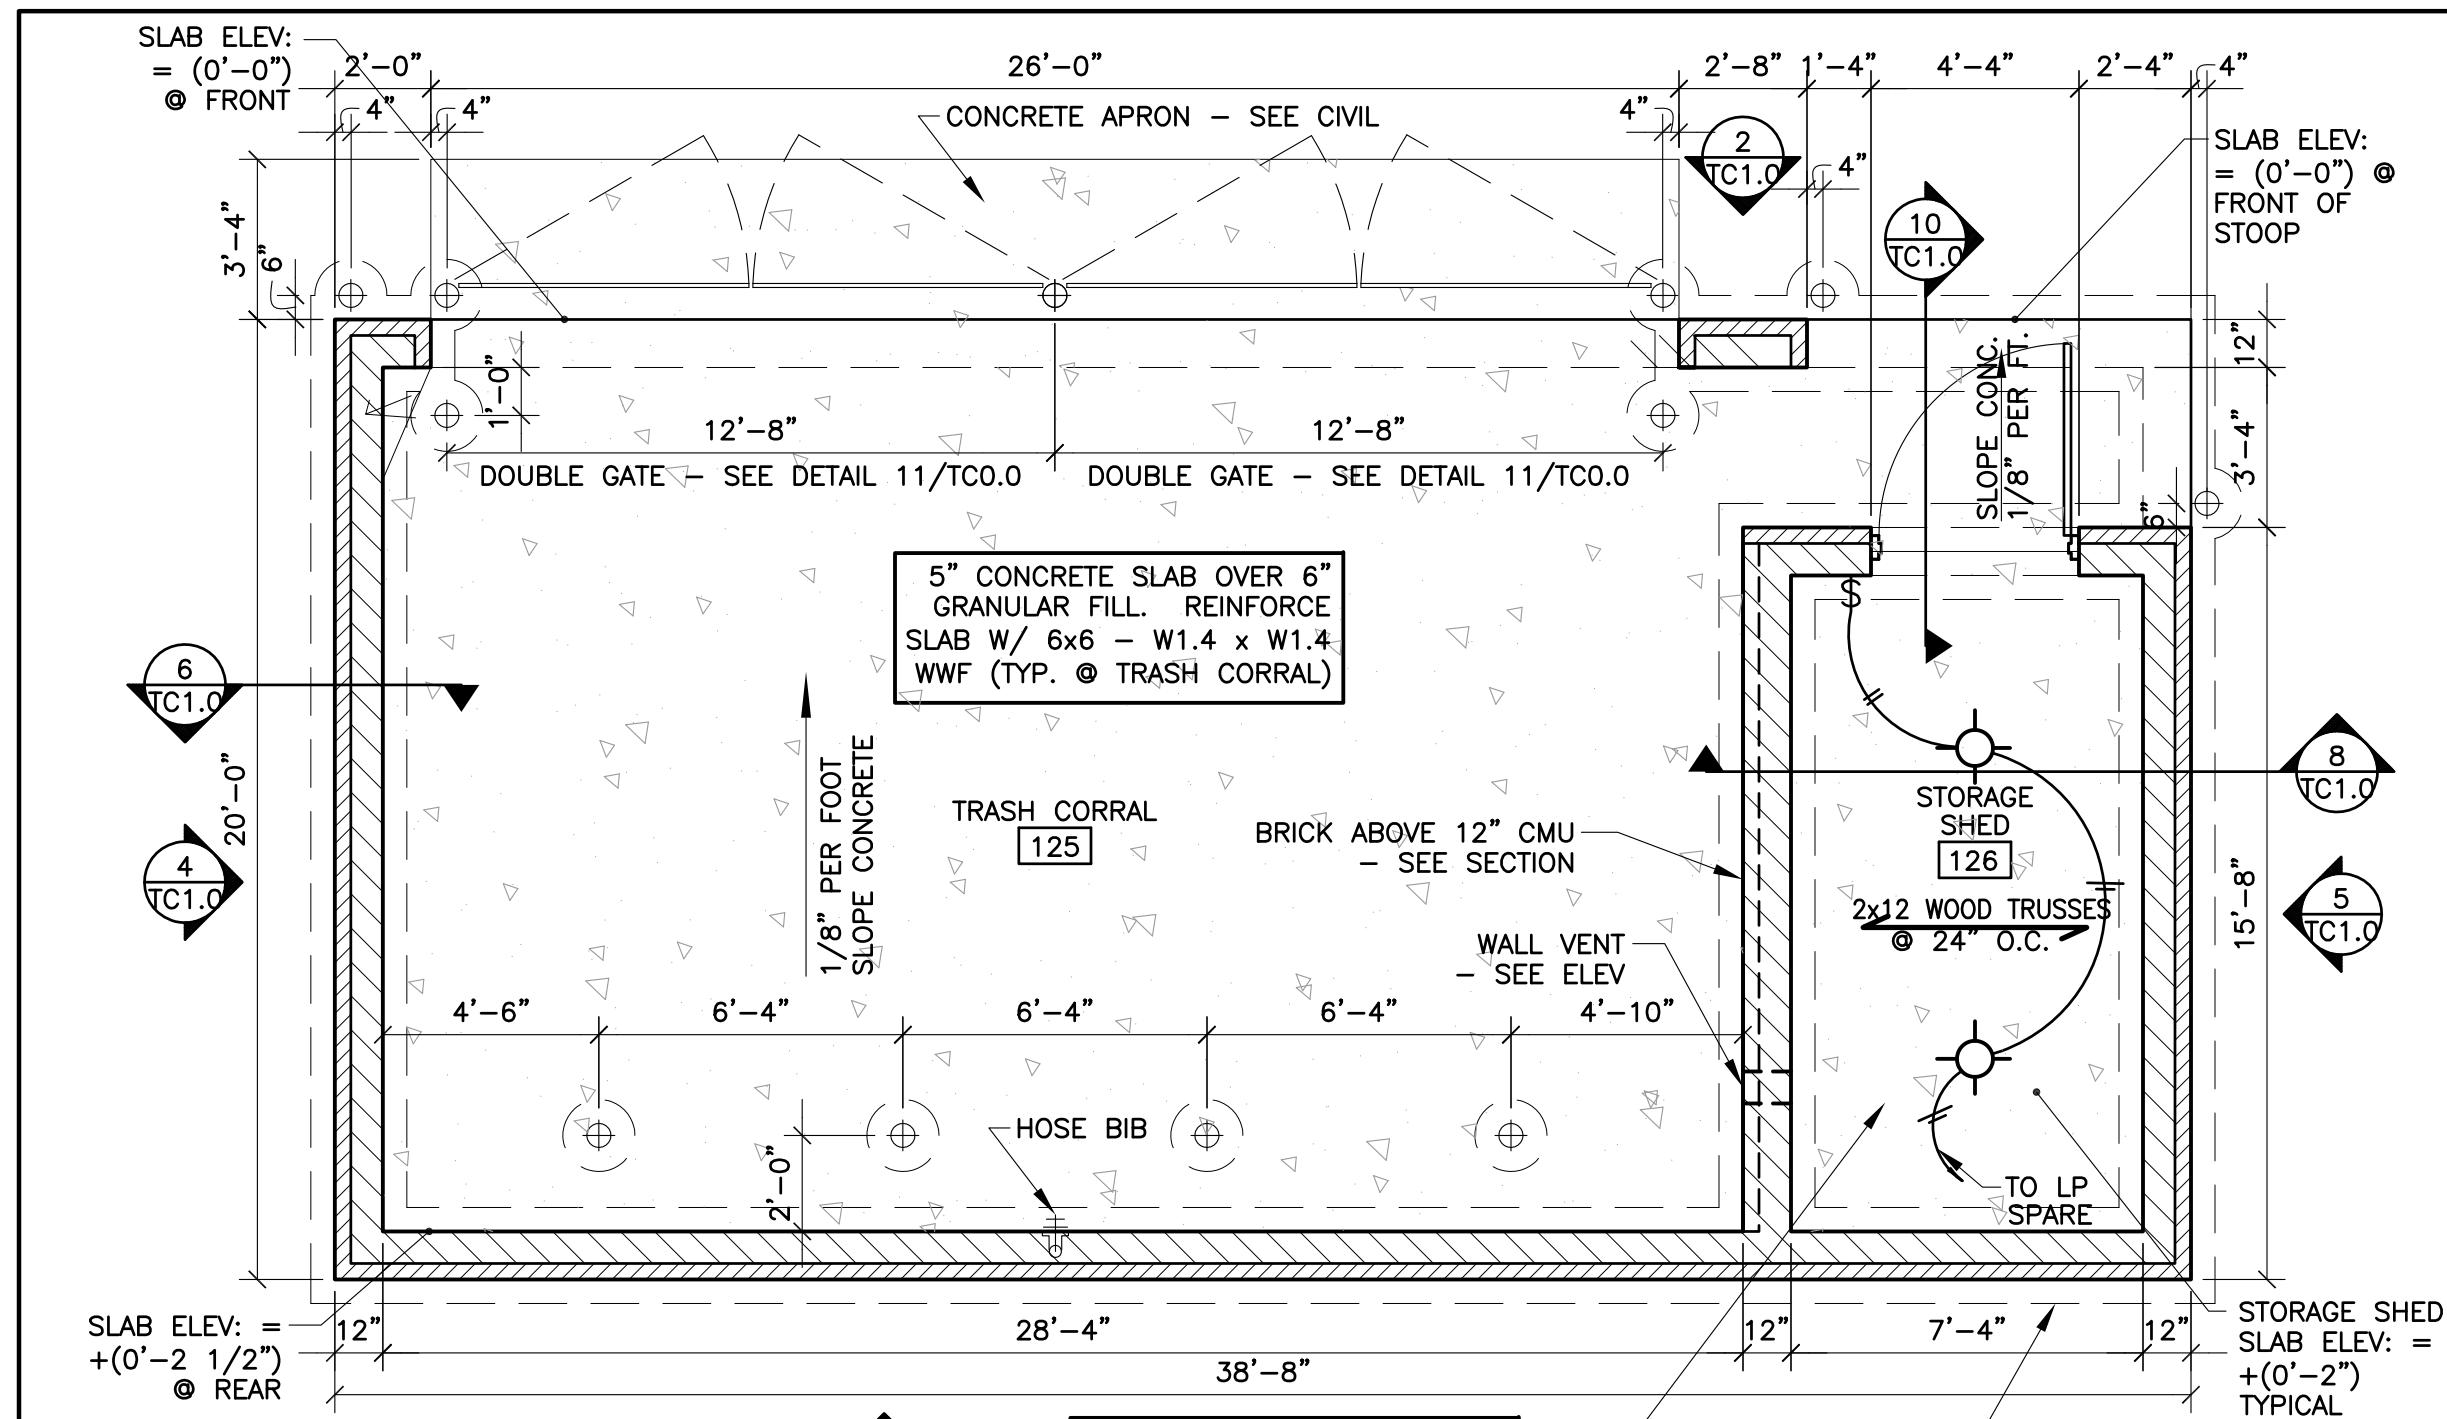


TRASH CORRAL PLAN W/ SHED

NOTE:
1. HOLLOW METAL DOOR SHALL BE 4' 0" x 7' 0" x 1 3/4" WITH FRAME, THRESHOLD, CONTINUOUS SINGE, LEVER HANDLE AND STOREROOM LOCKSET.
2. INCANDESCENT LIGHT FIXTURE SHALL BE FURNISHED, WIRE GUARD, 40 WATT LAMP, AND SURFACE MOUNT, PASS & SEMORE-#44 OR LIGHTING LTD #1742-2000 AWG

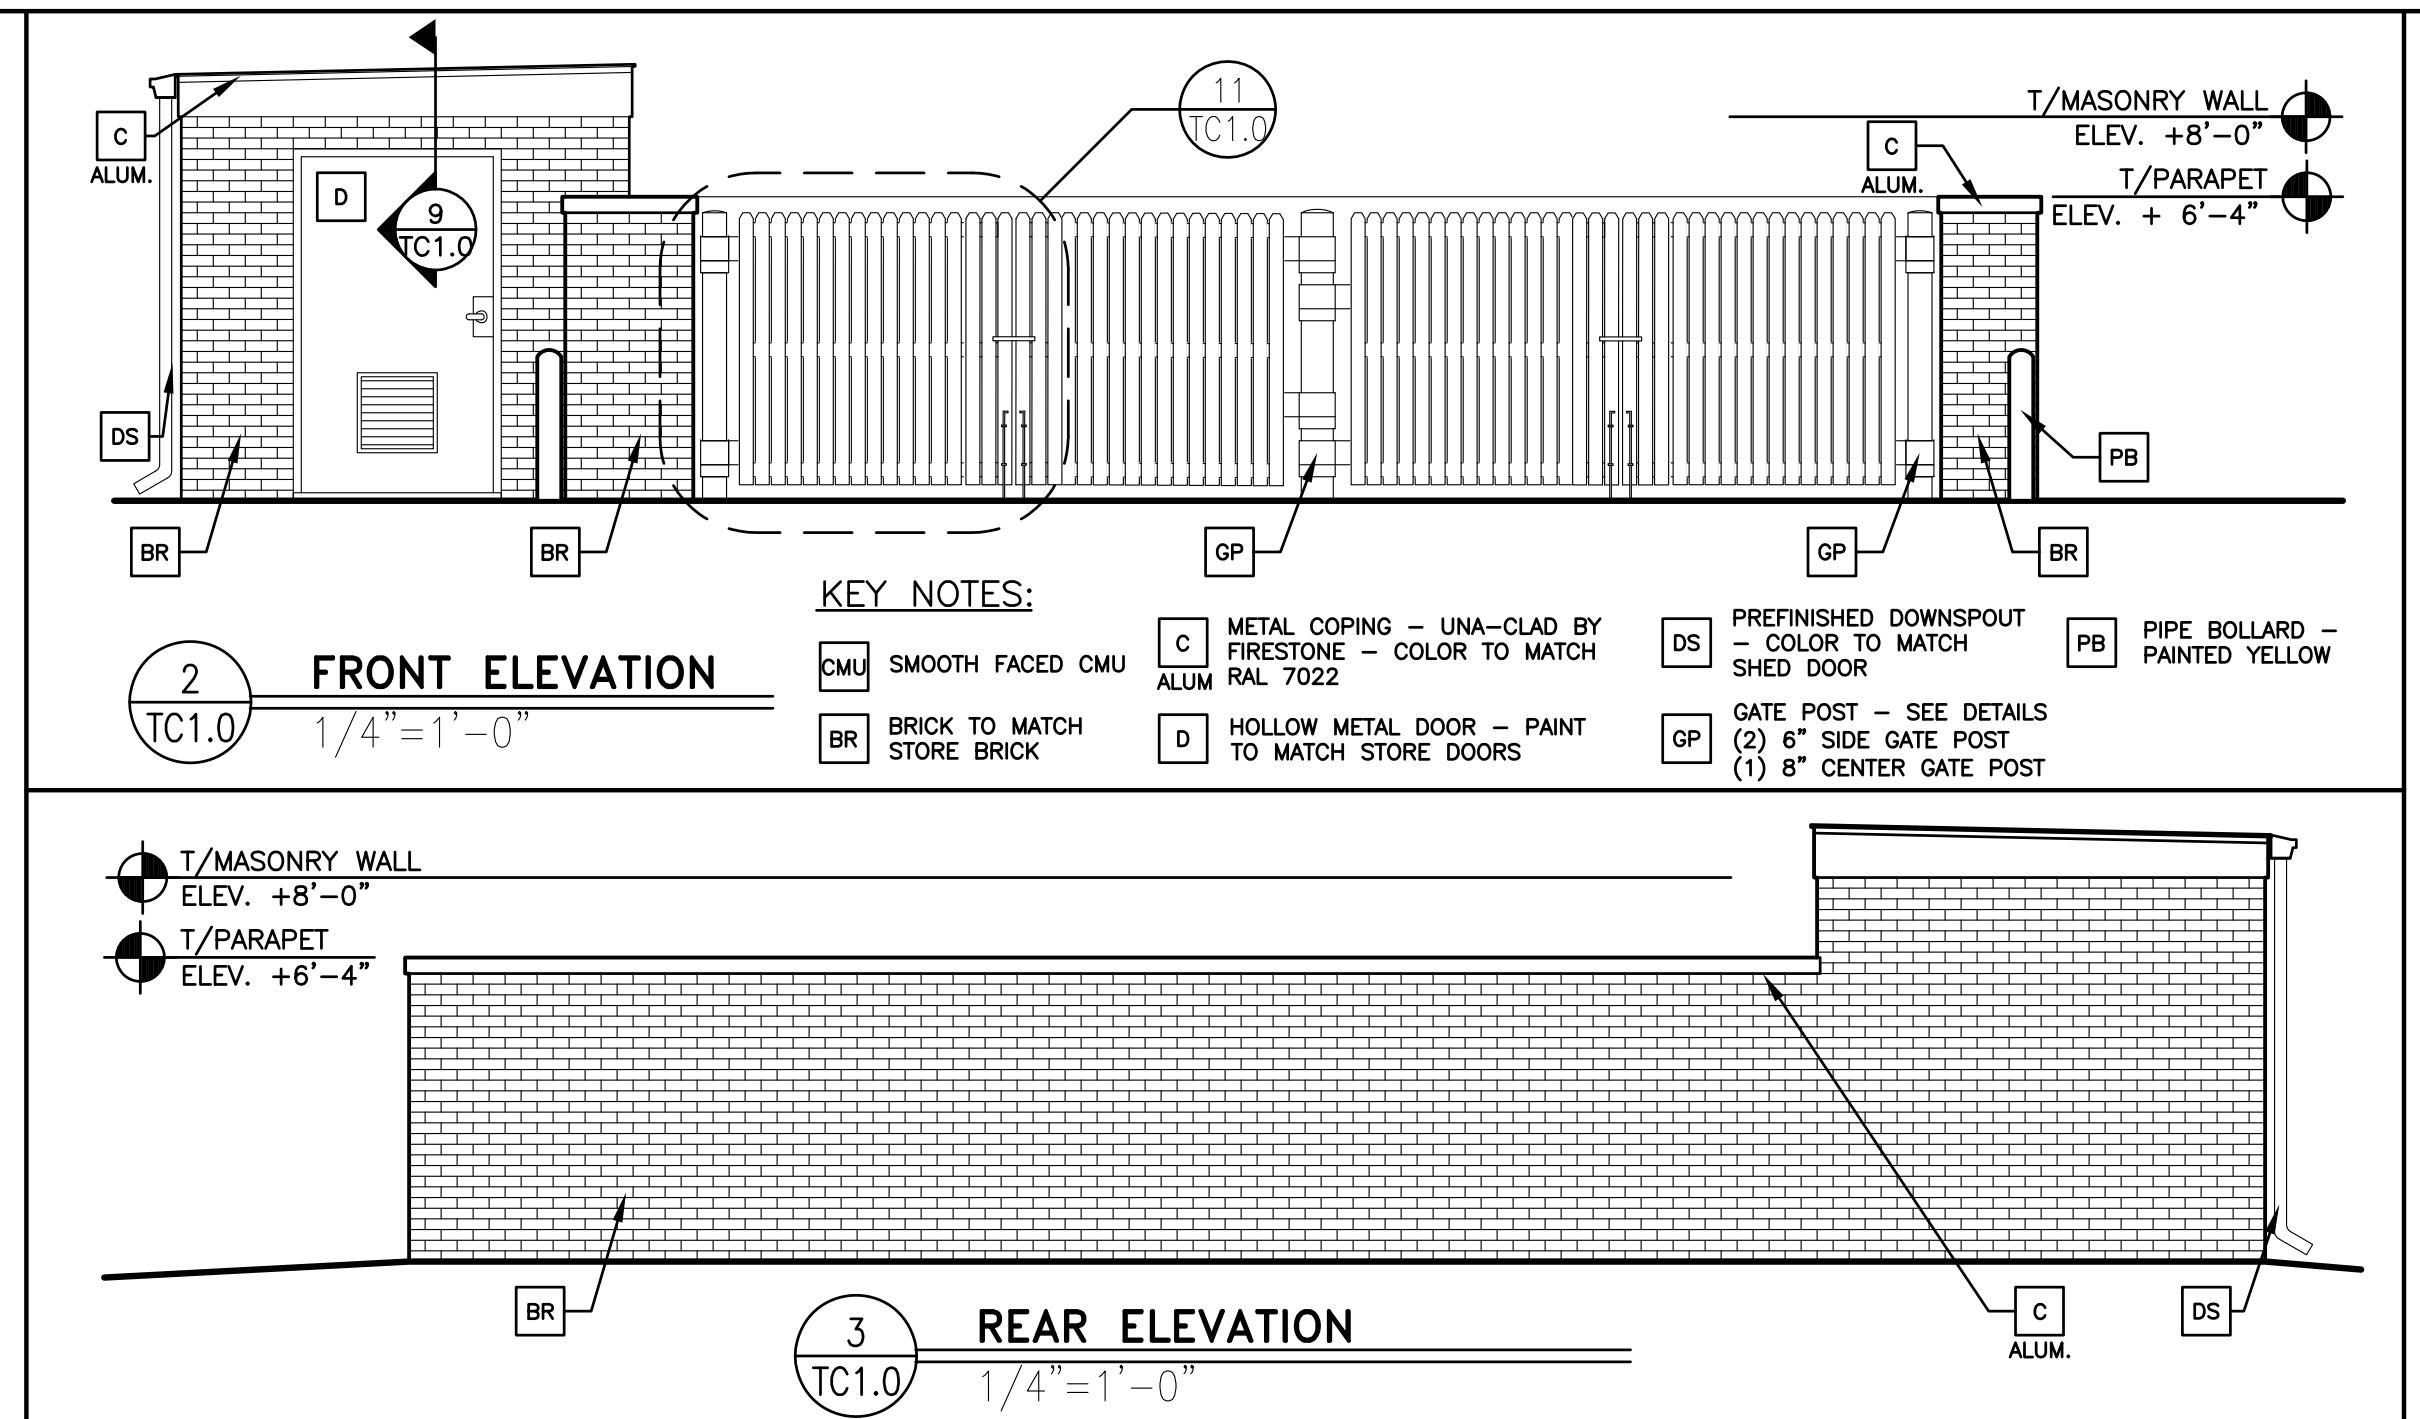

FRONT ELEVATION

REAR ELEVATION

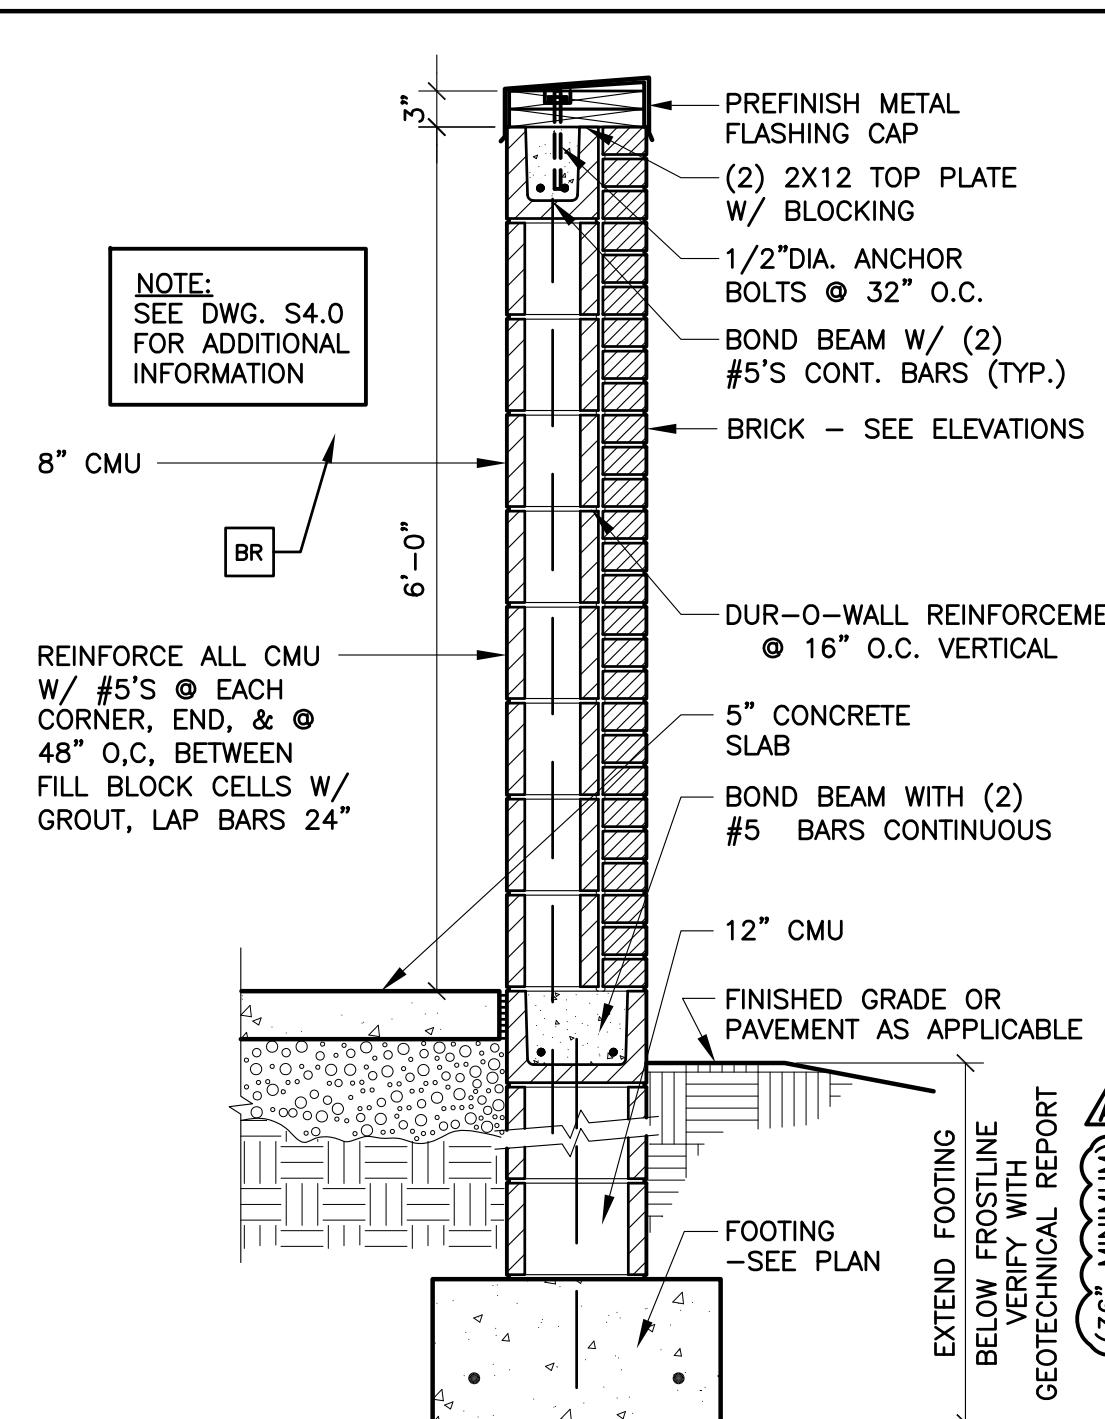

TYPICAL WALL SECTION

SHEET NO.	TITLE	DRAWN BY	REV.	DATE	DESCRIPTION	BY
015-0071.00.A	2019 STANDARD BUILDING - BB20	KO	11	05/05/20	CIVIL & PLAN REVIEW COMMENTS	
015-0071.00.A	4.59'F10-WOOD/WOOD	KO	11	01/23/20	PERMIT SET	
015-0071.00.A	WOOD BEARING WALLS W/FIBER CEMENT SIDING & CI	KO	11	01/13/20	USD PROGRESS SET REVIEW	
015-0071.00.A	WOOD ROOF TRUSS FRAMING	KO	11	01/13/20	GEOTECHNICAL REPORT	
015-0071.00.A	FIBER CEMENT PANEL/BATTEN/ALPOLIC PANEL/BRICK EXT. FINISH	KO	11	01/13/20	GEOTECHNICAL REPORT	
015-0071.00.A	SITE ADDRESS	KO	11	01/13/20	GEOTECHNICAL REPORT	
015-0071.00.A	015-0071.00.A	KO	11	01/13/20	GEOTECHNICAL REPORT	

I hereby certify that the above specification or report was prepared under my direction and supervision and is my direct responsibility. I further declare that the drawings and reports of the State of Kansas are my original work and have not been prepared by anyone else.

Signature: ERIN A. ARCHITECTURE, INC.

Date: 05/05/20

Registration Number: 55372



Design:

McDonald's USA, LLC


Architecture, Inc.

05/05/20


Date:

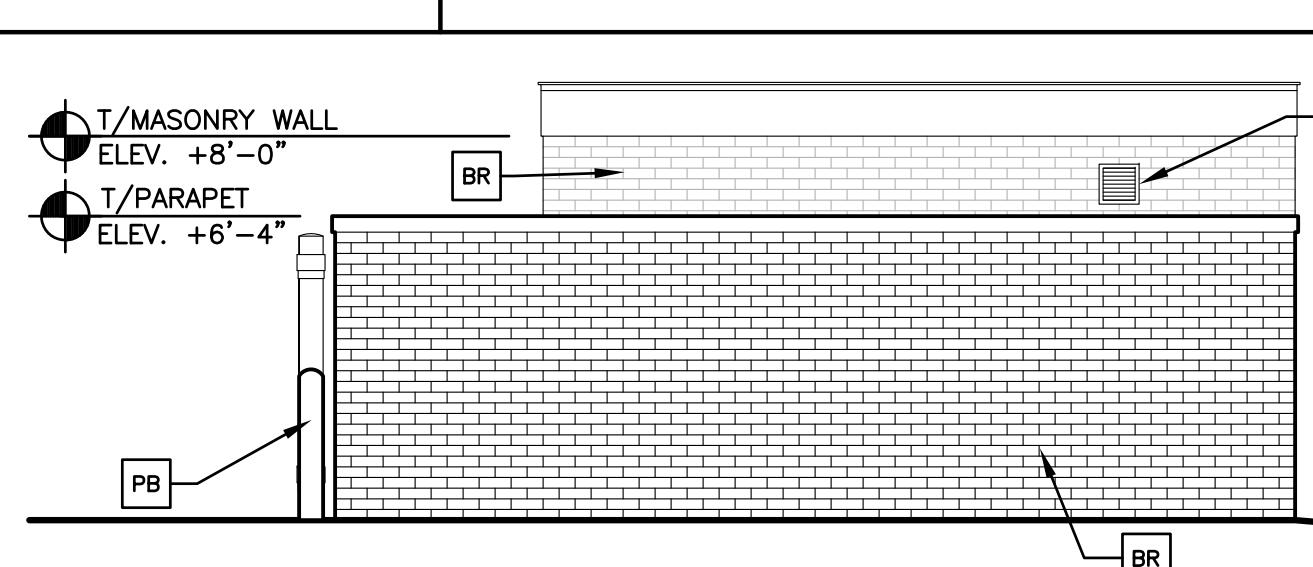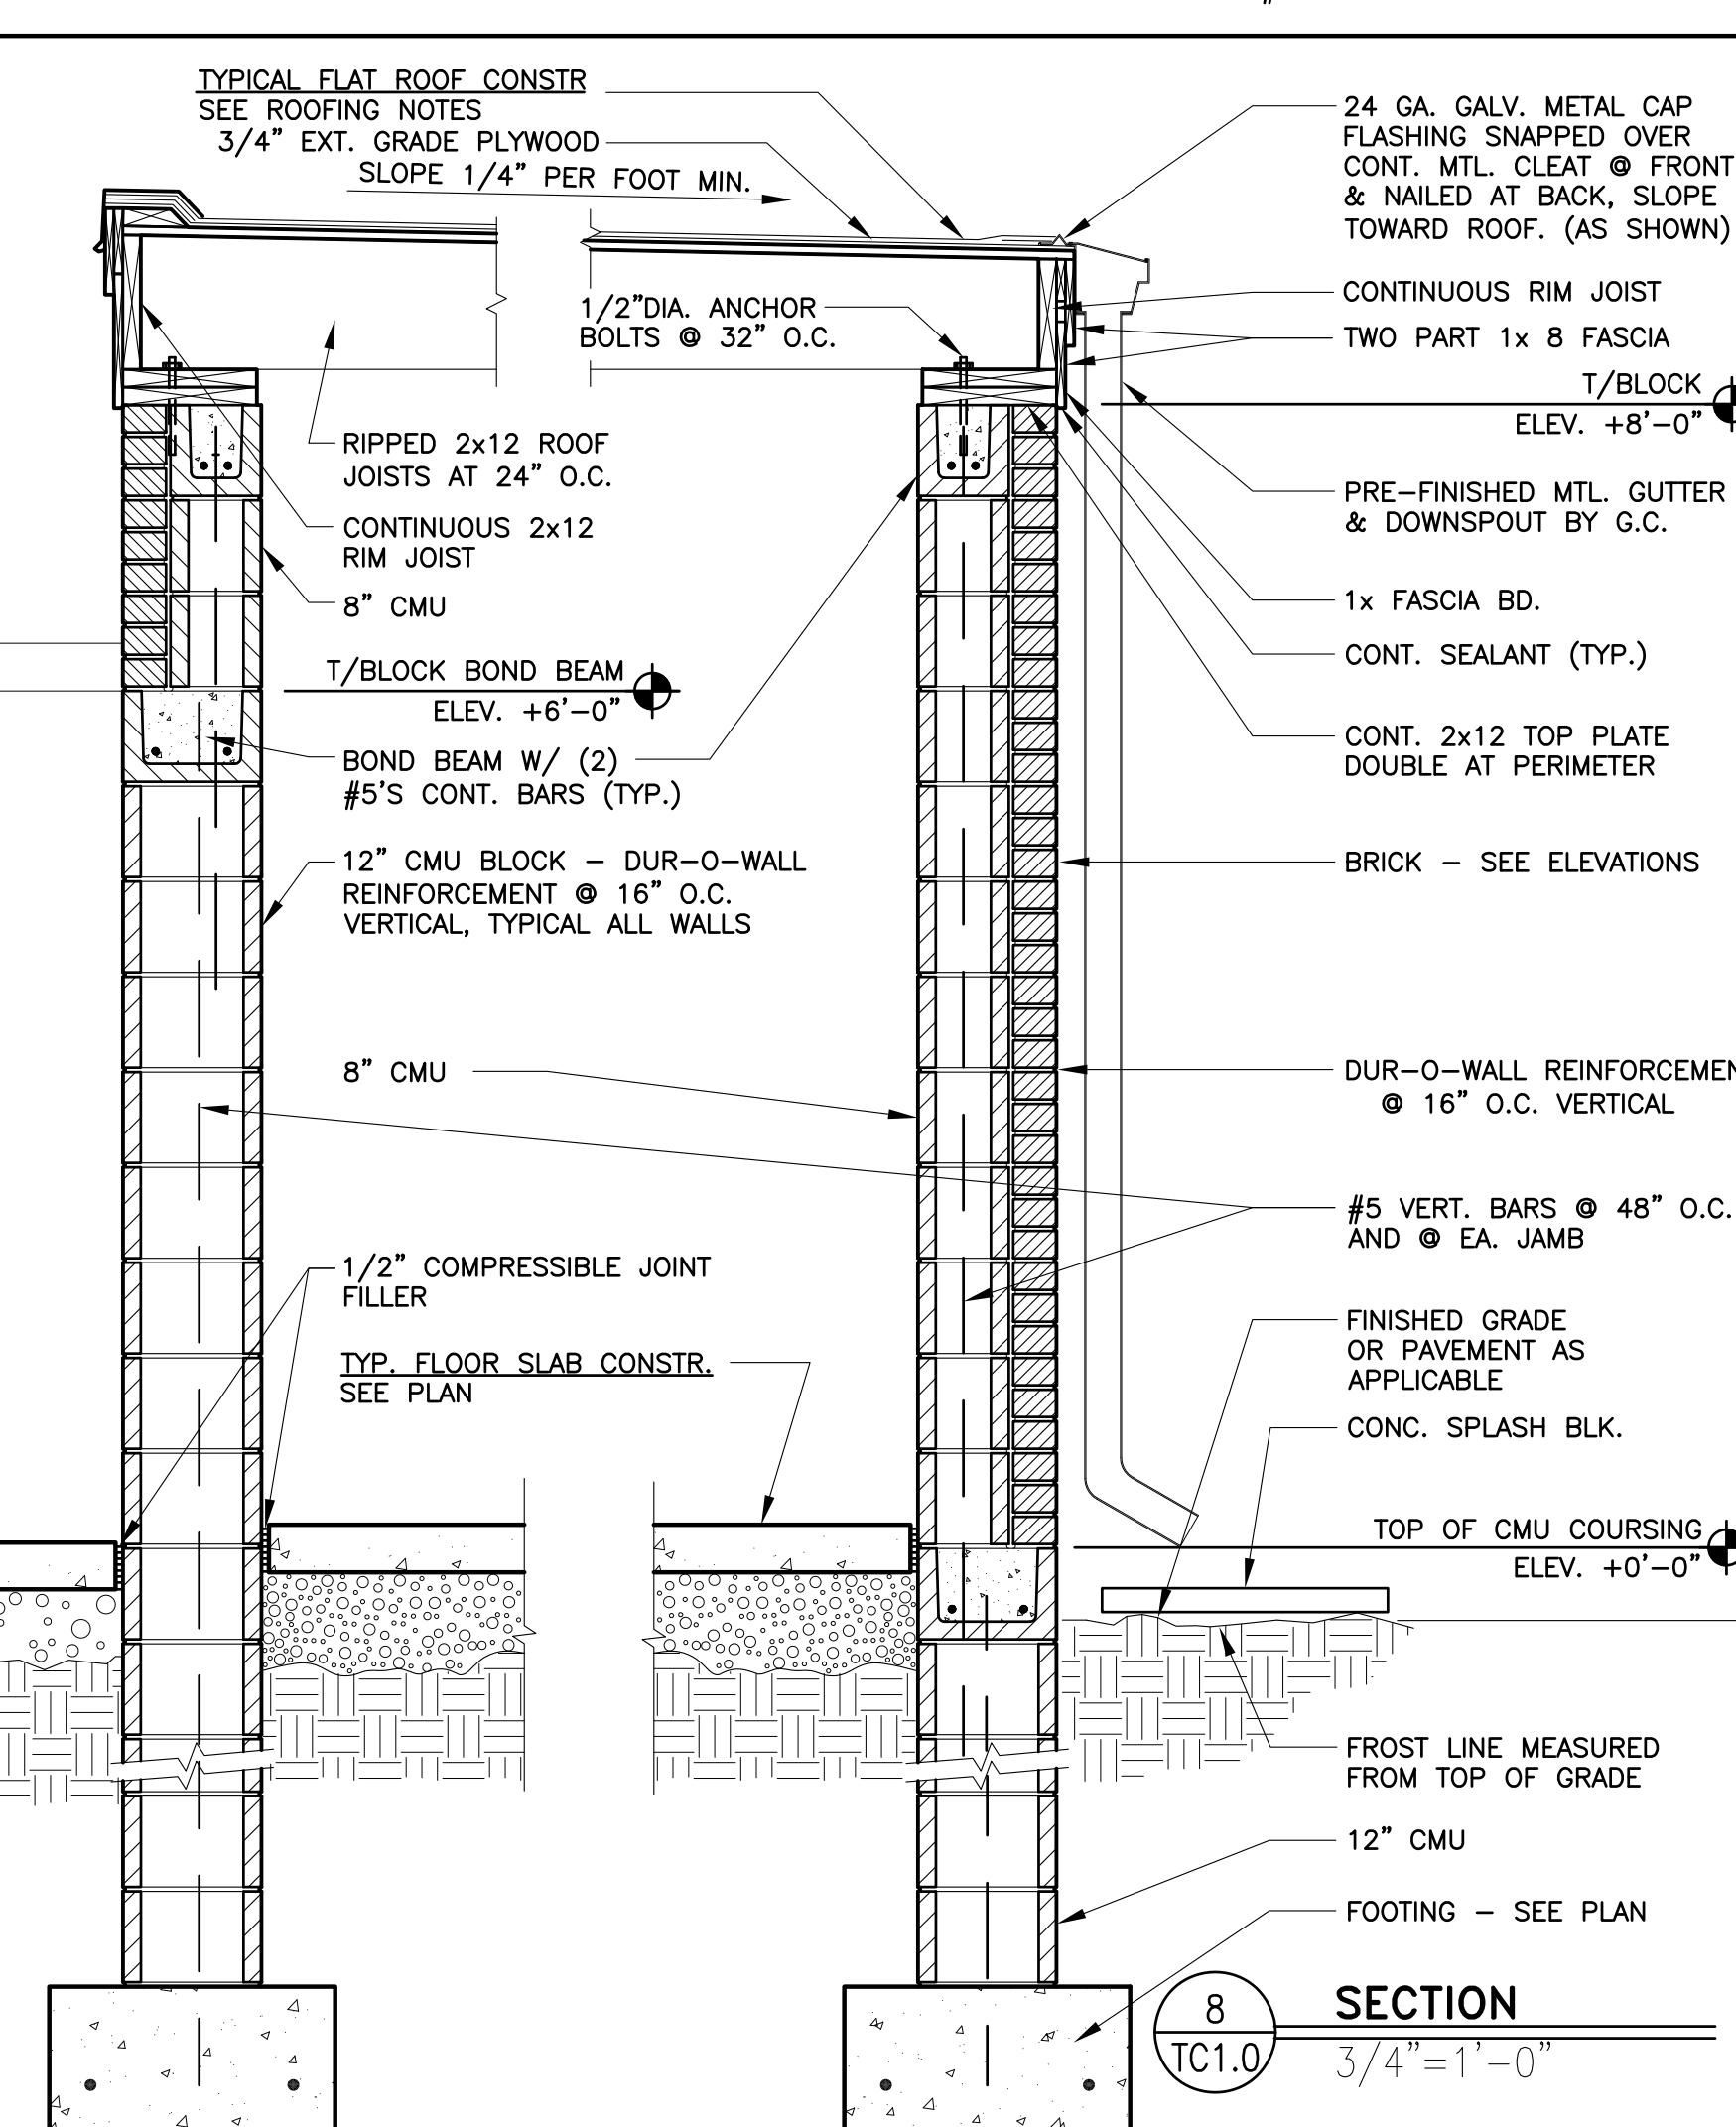

LEFT SIDE ELEVATION

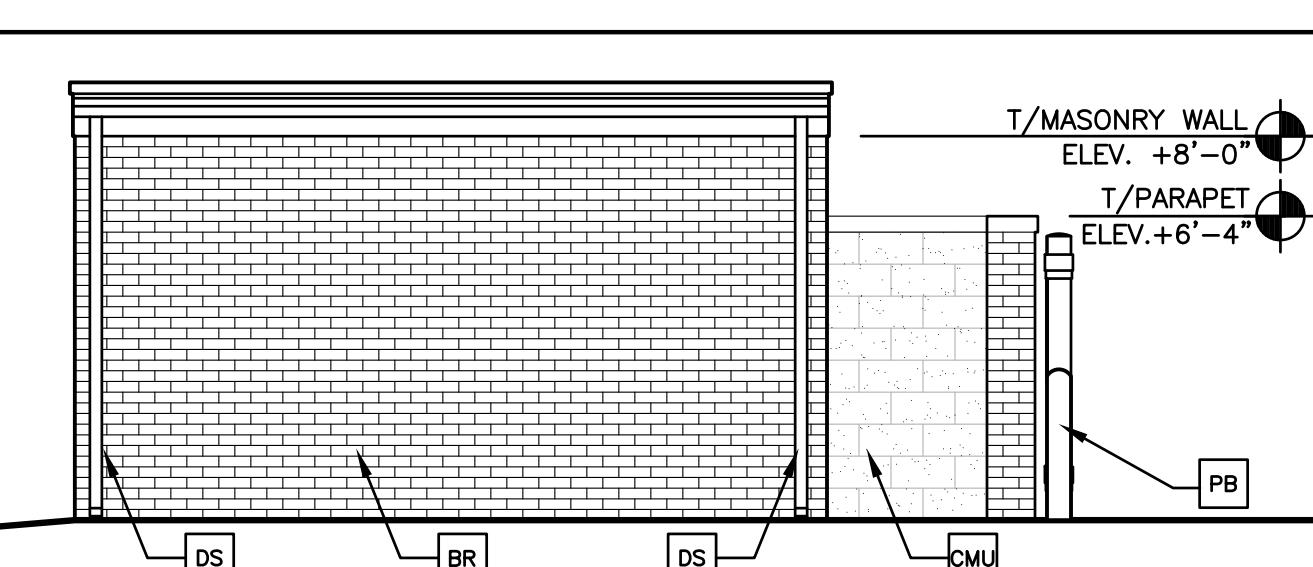


RIGHT SIDE ELEVATION

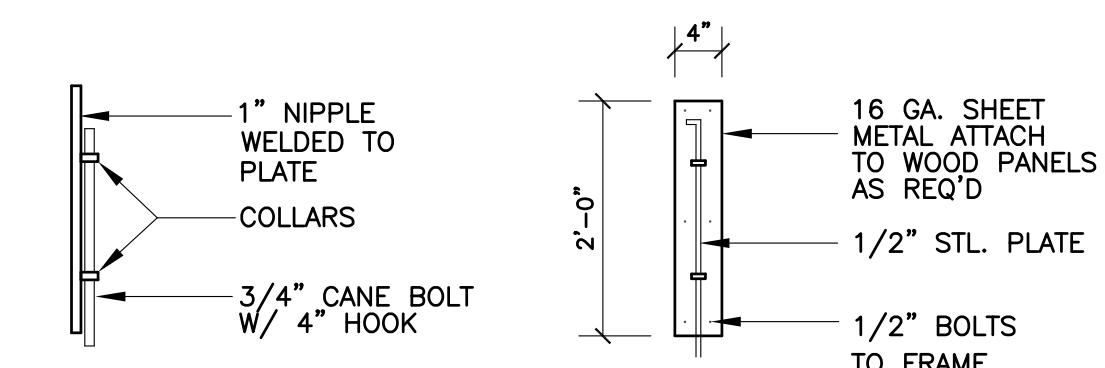


BOLT DETAILS

NOT TO SCALE

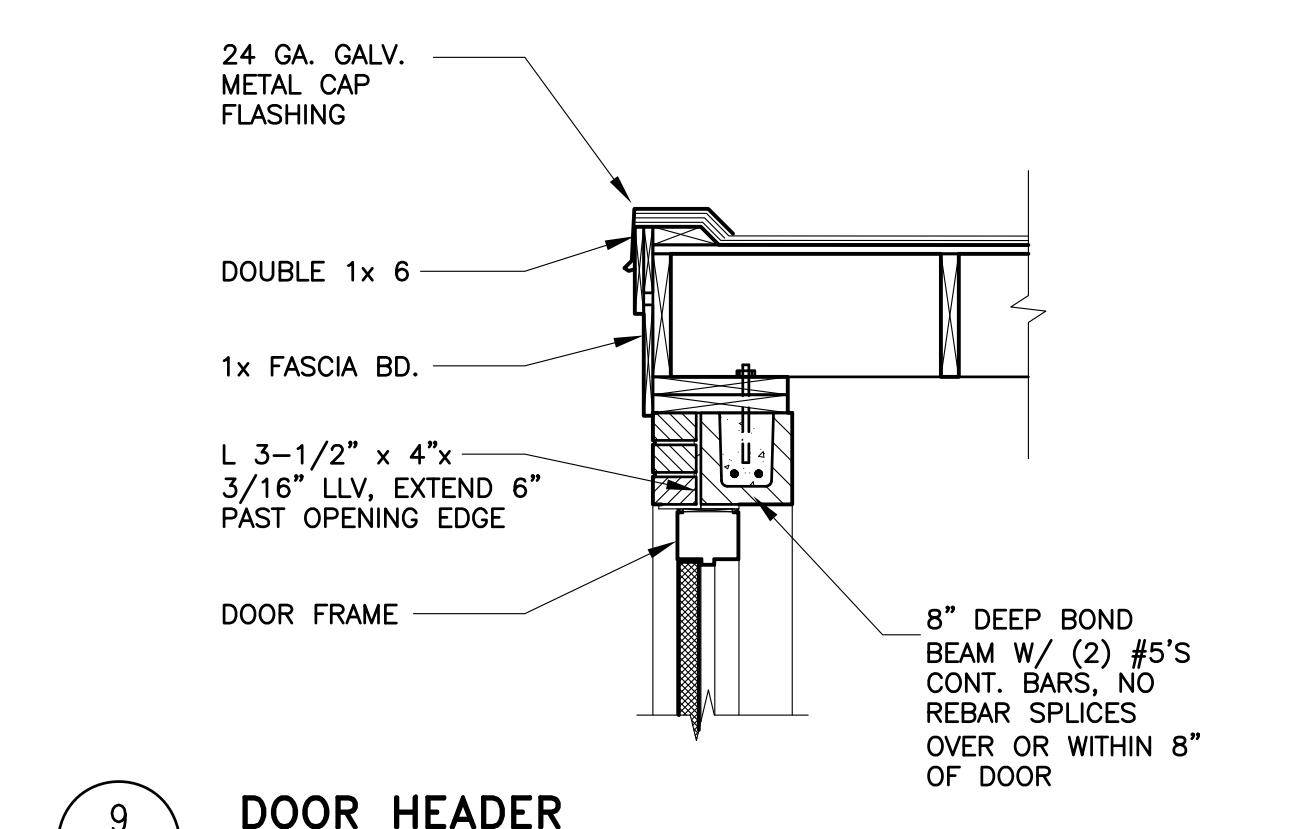


DOOR HEADER

3/4"=1'-0"

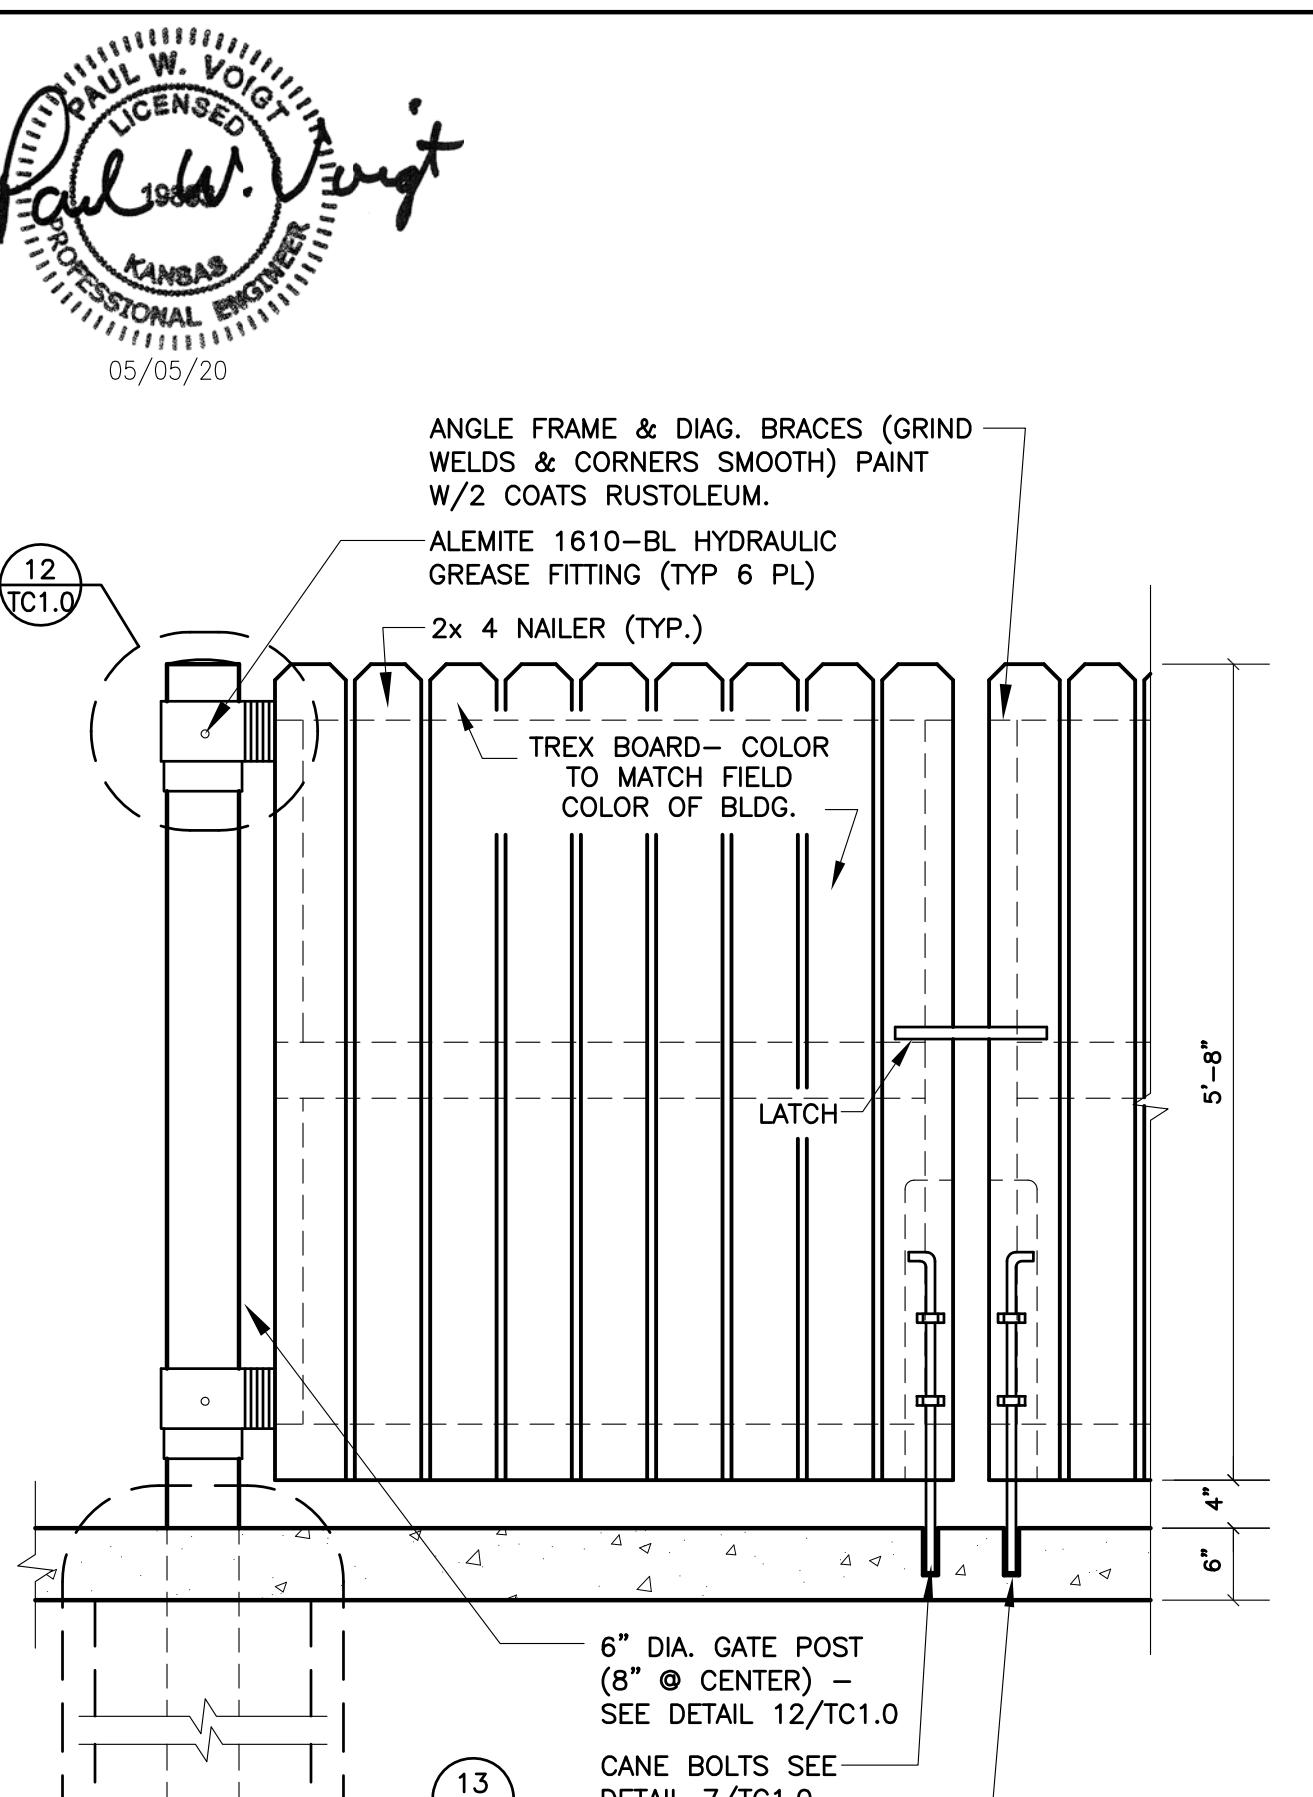


TYP. GATE DETAIL

1/2"=1'-0"

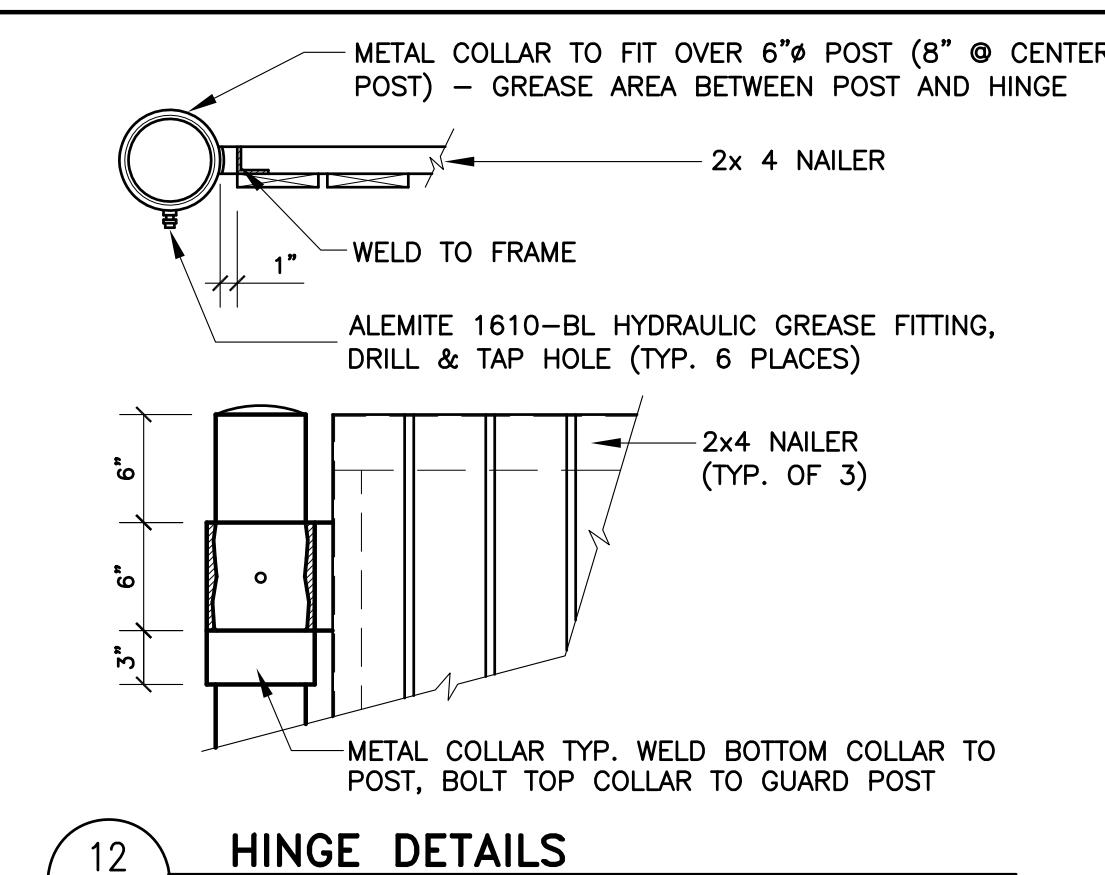




HINGE DETAILS

NOT TO SCALE

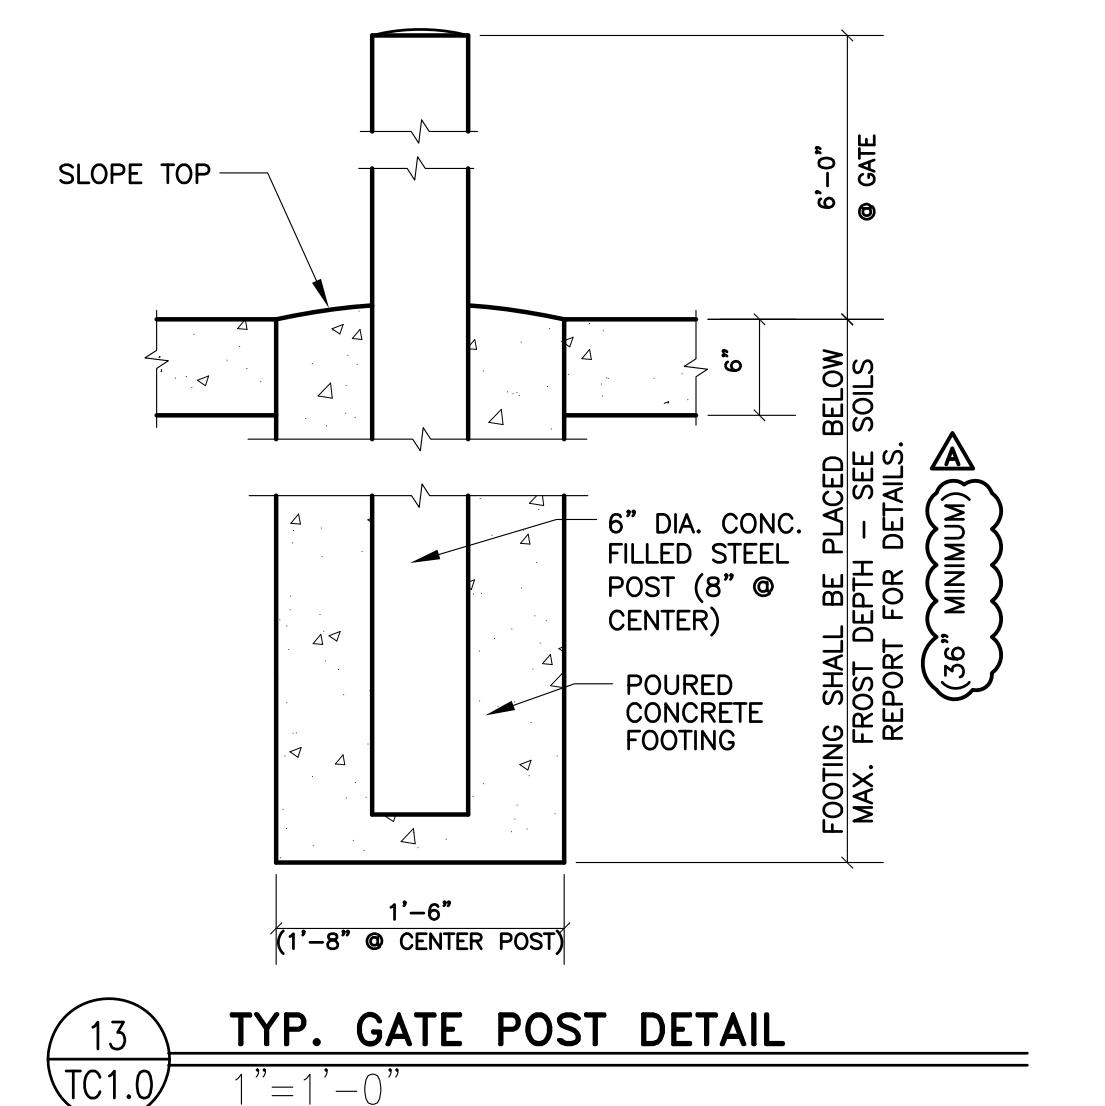

TYP. GATE POST DETAIL

1"=1'-0"

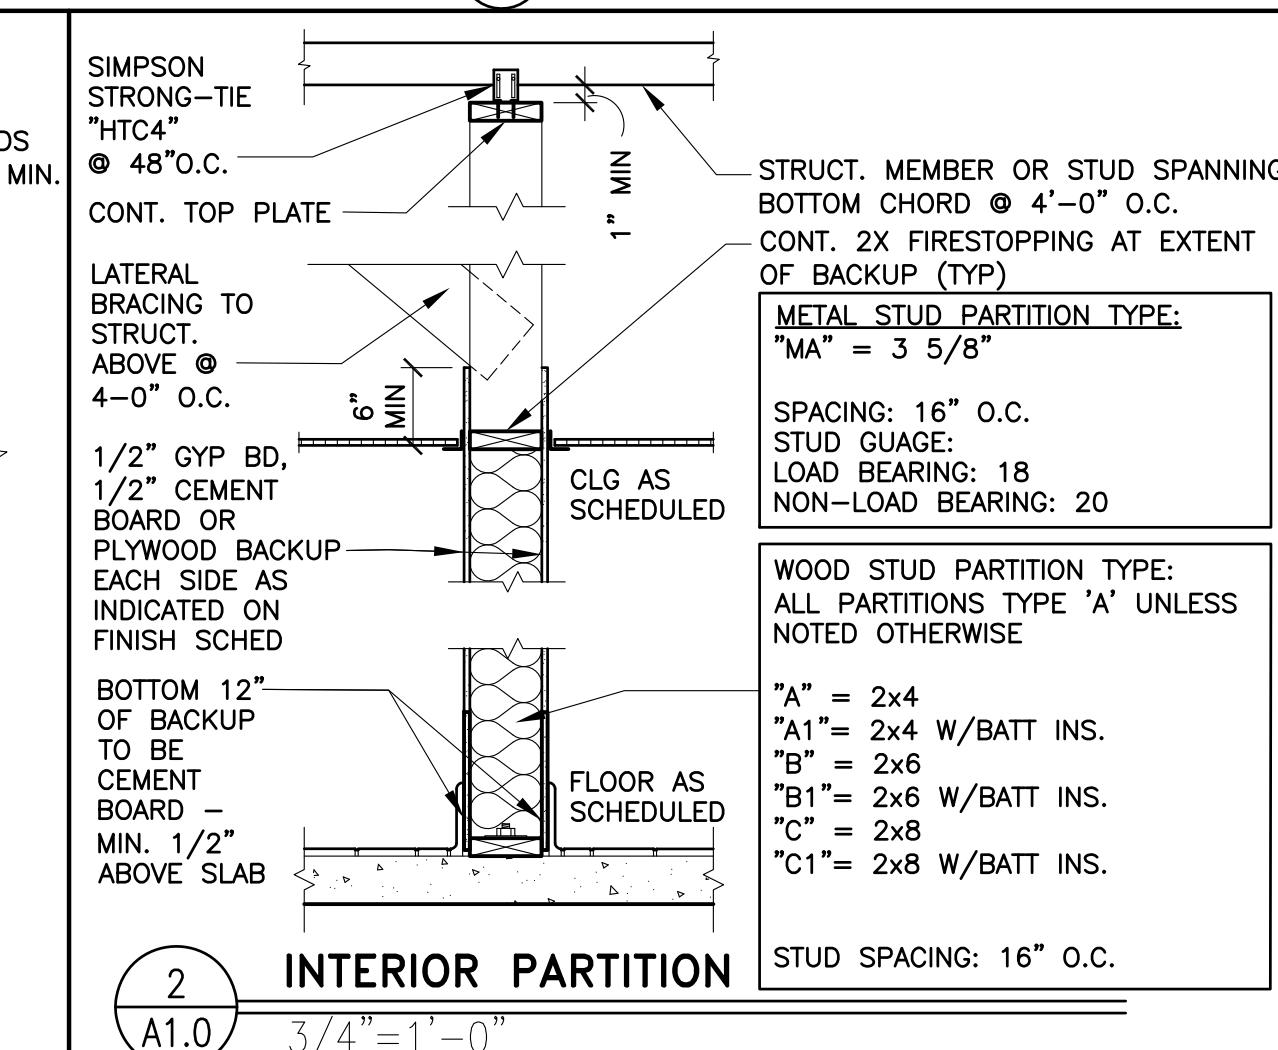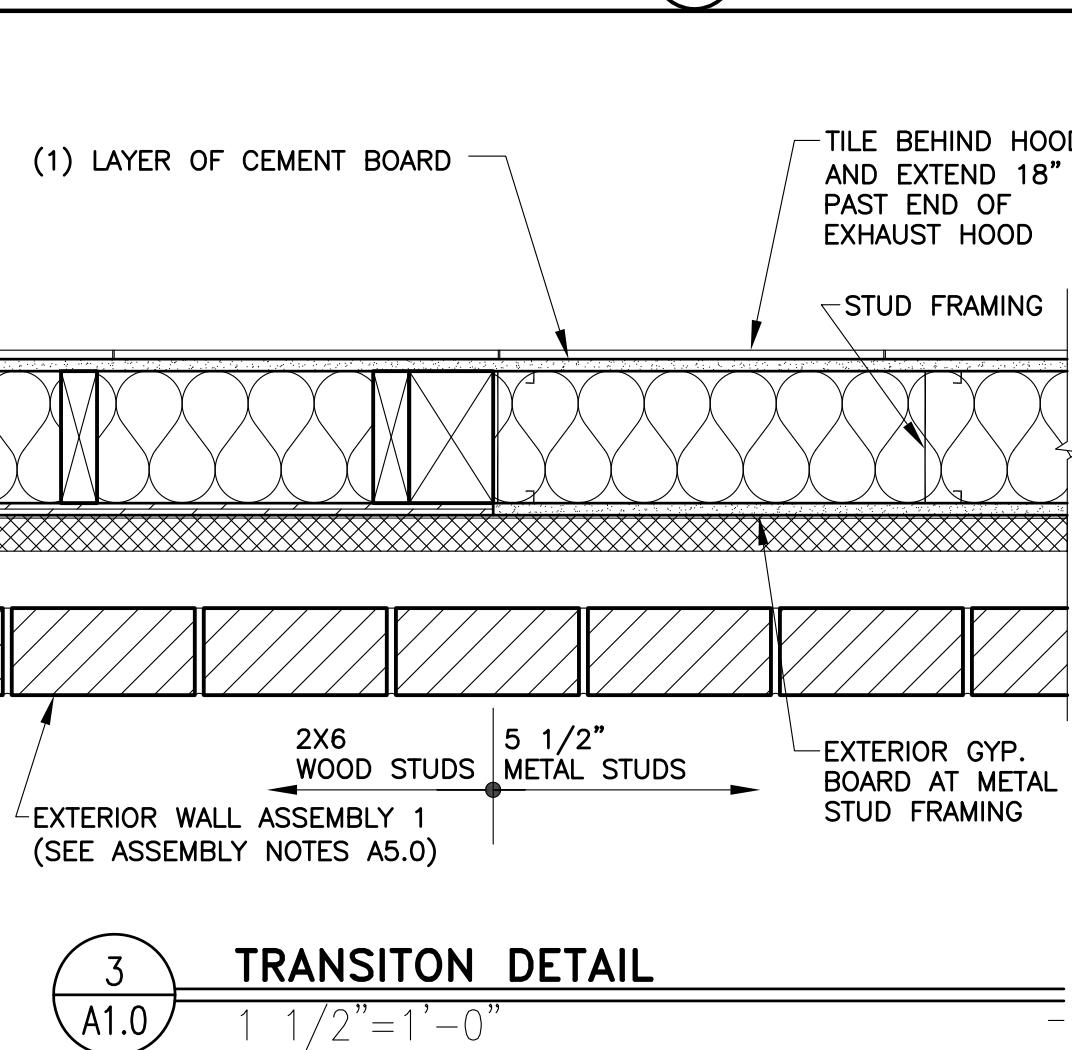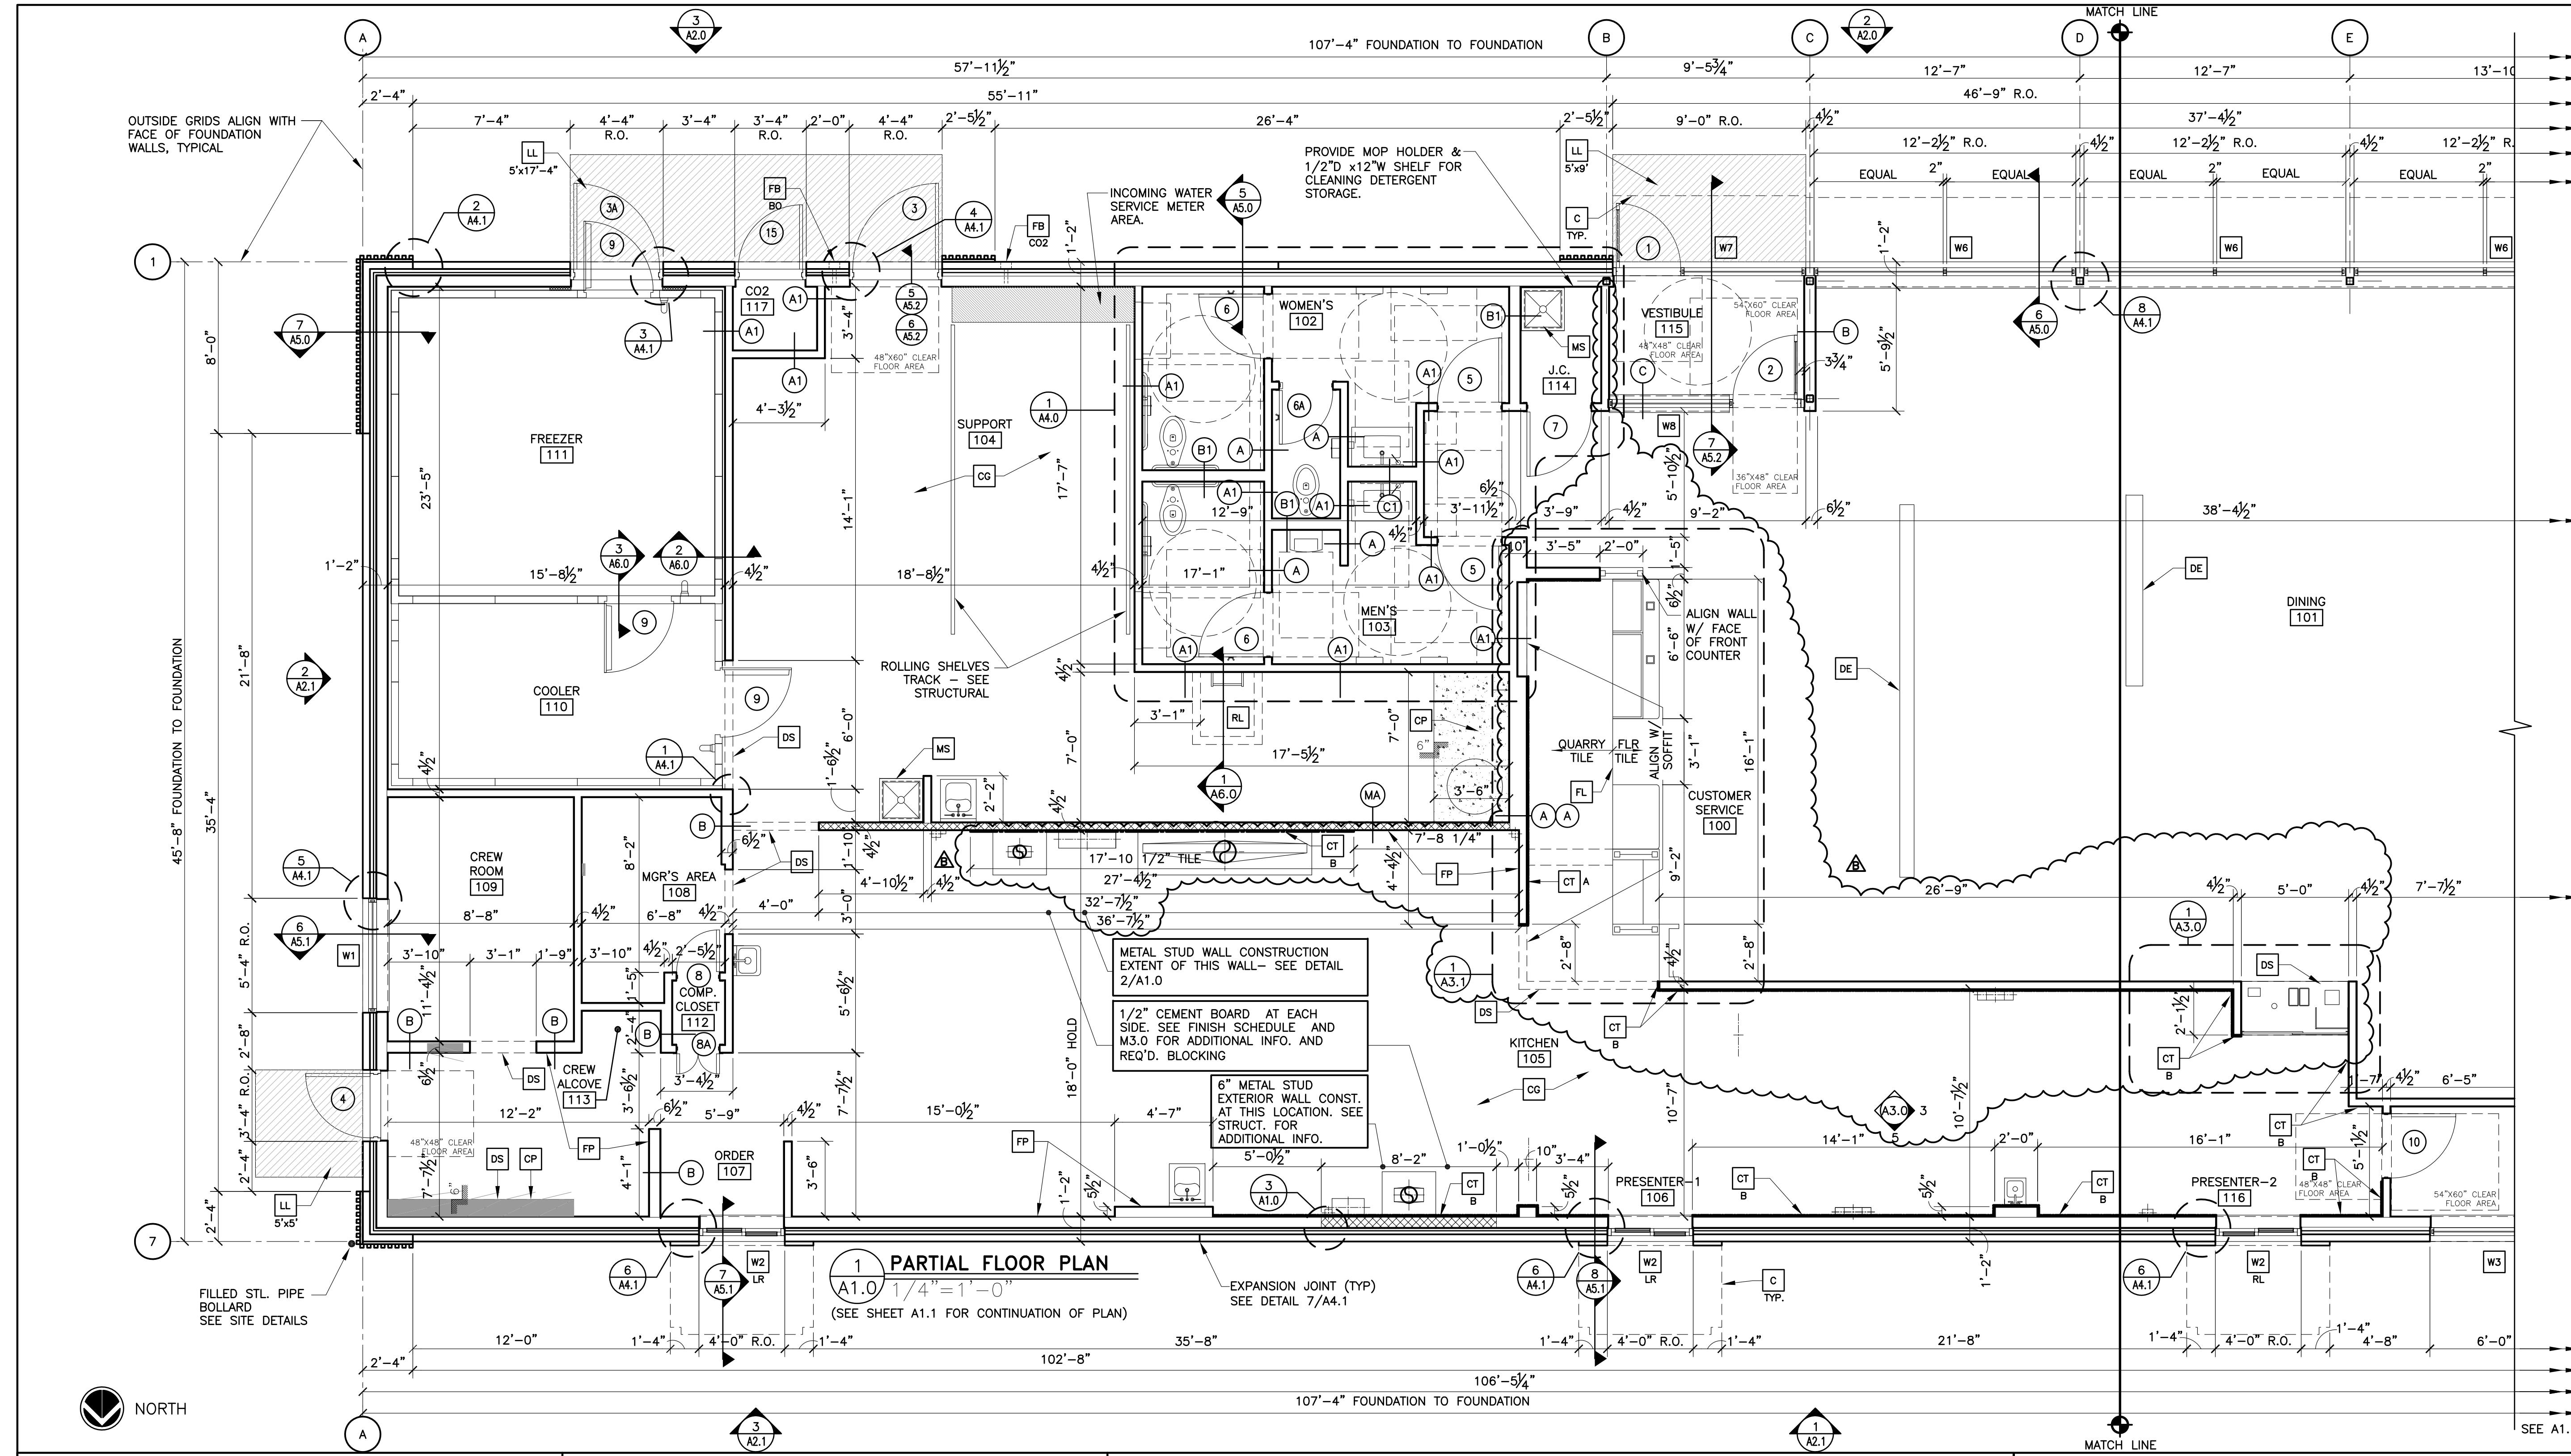

KEY NOTES

- C ALUMINUM CANOPY SYSTEM ABOVE - SEE 4/A5.0 FOR NOTES
- SEE ROOF PLAN FOR DIMENSIONS, SEE ELEVATION FOR
COLORS AND FASCIA LOCATIONS
 - CG G.C. TO PROVIDE 4"x4"x5'-0" HIGH STAINLESS STEEL CORNER
GUARDS AT ALL EXPOSED LOCATIONS IN KITCHEN/SUPPORT
AREA. CORNER GUARDS TO START AT FINISH FLOOR. ATTACH
WITH WOOD SCREWS INTO WOOD BLOCKING BULLNOSE COVE
BASE WHERE TILE MEETS STAINLESS STEEL CORNER - SEE
DETAIL 4/A6.0
 - CP CONCRETE EQMT PAD - SEE STRUCTURAL & DETAIL 5/A6.0
 - CT WALL TILE: CERAMIC WALL TILE,
SIZE: 4"x12", PATTERN: STACK BOND,
^A GROUT: MAPEI ULTRACOLOR PLUS - JOINT TO BE $\frac{1}{6}$ " MAX.
SEE DECOR DRAWINGS FOR TILE AND GROUT COLOR SPEC
 - CT WALL TILE: CROSSVILLE - COLOR BY NUMBERS,
COLOR: INTUITIVE GRAY, SIZE: 4"x12", PATTERN: RUNNING BOND
^B GROUT: MAPEI 02 PEWTER - JOINT TO BE $\frac{1}{6}$ " MAX.
USE THIS TILE WHEN HIGH LRV IS REQUIRED
COORDINATE WITH McDONALD'S AREA CONSTRUCTION MANAGER
 - DE DECOR ELEMENT- VERIFY SIZE AND PLACEMENT WITH
DECOR PLANS
 - DS DROPPED SOFFIT ABOVE - SEE REFLECTED CEILING PLAN
 - FB CO2 FILL BOX (EQUIPMENT SCHEDULE ITEM 49.00)
CO2
 - FB OPTIONAL BULK OIL FILL BOX (EQPM SCHEDULE ITEM 700.18)
BO CONFIRM USE WITH McDONALD'S AREA CONSTRUCTION MANAGER

- FL FLOOR LINE – CHANGE IN MATERIAL – SEE DECOR DRAWINGS**

**FP FIBERGLASS REINFORCED PLASTIC (FRP) – PANOLAM,
GRAY SMOOTH, CLASS C, .075. REFER TO ROOM FINISH
SCHEDULE SHEET A6.1 FOR INSTALLATION LOCATIONS.
FOR ORDERING, CONTACT KIMBERLY LAWSON
Kimberly_Lawson@panolam.com 1-866-925-4377**

**LL LEVEL LANDING @ EXT. DOOR W/ MAX. 2%
RUNNING/CROSS SLOPE AWAY FROM BUILDING
5'x5'**
SIZE OF LANDING

MS MOP SINK – SEE DETAIL 8/A6.1 AND PLUMBING DRAWINGS.

**RL ROOF ACCESS LADDER W/HATCH ABOVE SEE
STRUCTURAL FRAMING PLAN FOR LOCATING DIMENSIONS**


**Wx EXTERIOR WINDOW ASSEMBLY – SEE A2.0,
A2.1 & 4/A5.0 FOR ADDITIONAL NOTES**

SYMBOL LEGEND

- A** — PARTITION TYPE TAG SEE 2/A1.0 **7** DOOR TAG - SEE DOOR SCHEDULE ON
— — EXTENT OF WALL TILE **X** KEY NOTE

GENERAL NOTES

1. EXTERIOR DIMENSIONS ARE TO COLUMN REFERENCE LINES AND EXTERIOR FACE OF MASONRY UNLESS OTHERWISE NOTED. INTERIOR DIMENSIONS ARE TO FACE OF INTERIOR WALL BOARD
 2. SEE 4/A5.0 FOR EXTERIOR WALL ASSEMBLY TYPES. SEE 2/A1.0 FOR INTERIOR PARTITION TYPES. INTERIOR PARTITIONS ARE TYPE 'A' UNLESS NOTED OTHERWISE.
 3. SEE EXTERIOR ELEVATIONS FOR WINDOW TYPES
 4. SEE SHEET A6.0 FOR DOOR SCHEDULE AND SHEET A6.1 FOR ROOM FINISH SCHEDULES
 5. SEE SITE PLAN FOR SIDEWALKS, RAMPS, ETC.
 6. GC TO PROVIDE ADA SIGNAGE PACKAGE AND INSTALL SIGNS AT LOCATIONS AND POSITIONS INDICATED IN PACKAGE OR AS REQUIRED BY LOCAL CODES. SIGNAGE PACKAGE SUPPLIED BY: FORREST PERMA-SIGN 1-800-214-8765; 9292 1ST ST., BOX 588, NEW ROCHELLE, NY 10802; www.forrestpermesigns.com
 7. MAXIMUM OCCUPANCY SIGN TO BE POSTED PER LOCAL CODE. SIGN FURNISHED AND INSTALLED BY GENERAL CONTRACTOR.
 8. ALL HANDSINK LOCATIONS SHALL HAVE CEMENT BOARD BACKING 48" IN HEIGHT A.F.F.
 9. GC TO COORDINATE ALL REQUIRED BLOCKING FOR WALL HUNG EQUIPMENT, SHELVES, ETC. FOR PROPER INSTALLATION HEIGHTS.
 10. KNOX BOX TO BE INSTALLED BY GENERAL CONTRACTOR PER LOCAL CODE AS REQUIRED. MODEL AND LOCATION TO BE COORDINATED WITH FIRE MARSHALL.
 11. DASHED LINES @ DOORS, RESTROOMS, & FIXTURES REPRESENT CLEAR FLOOR MANEUVERING CLEARANCES AS REQUIRED BY THE ACCESSIBILITY CODE. CLEARANCES MUST BE MAINTAINED WITHOUT EXCEPTION. IF CONDITIONS PREVENT ANY CLEAR FLOOR SPACE FROM BEING MAINTAINED, CONTACT THE ARCHITECT FOR RESOLUTION.

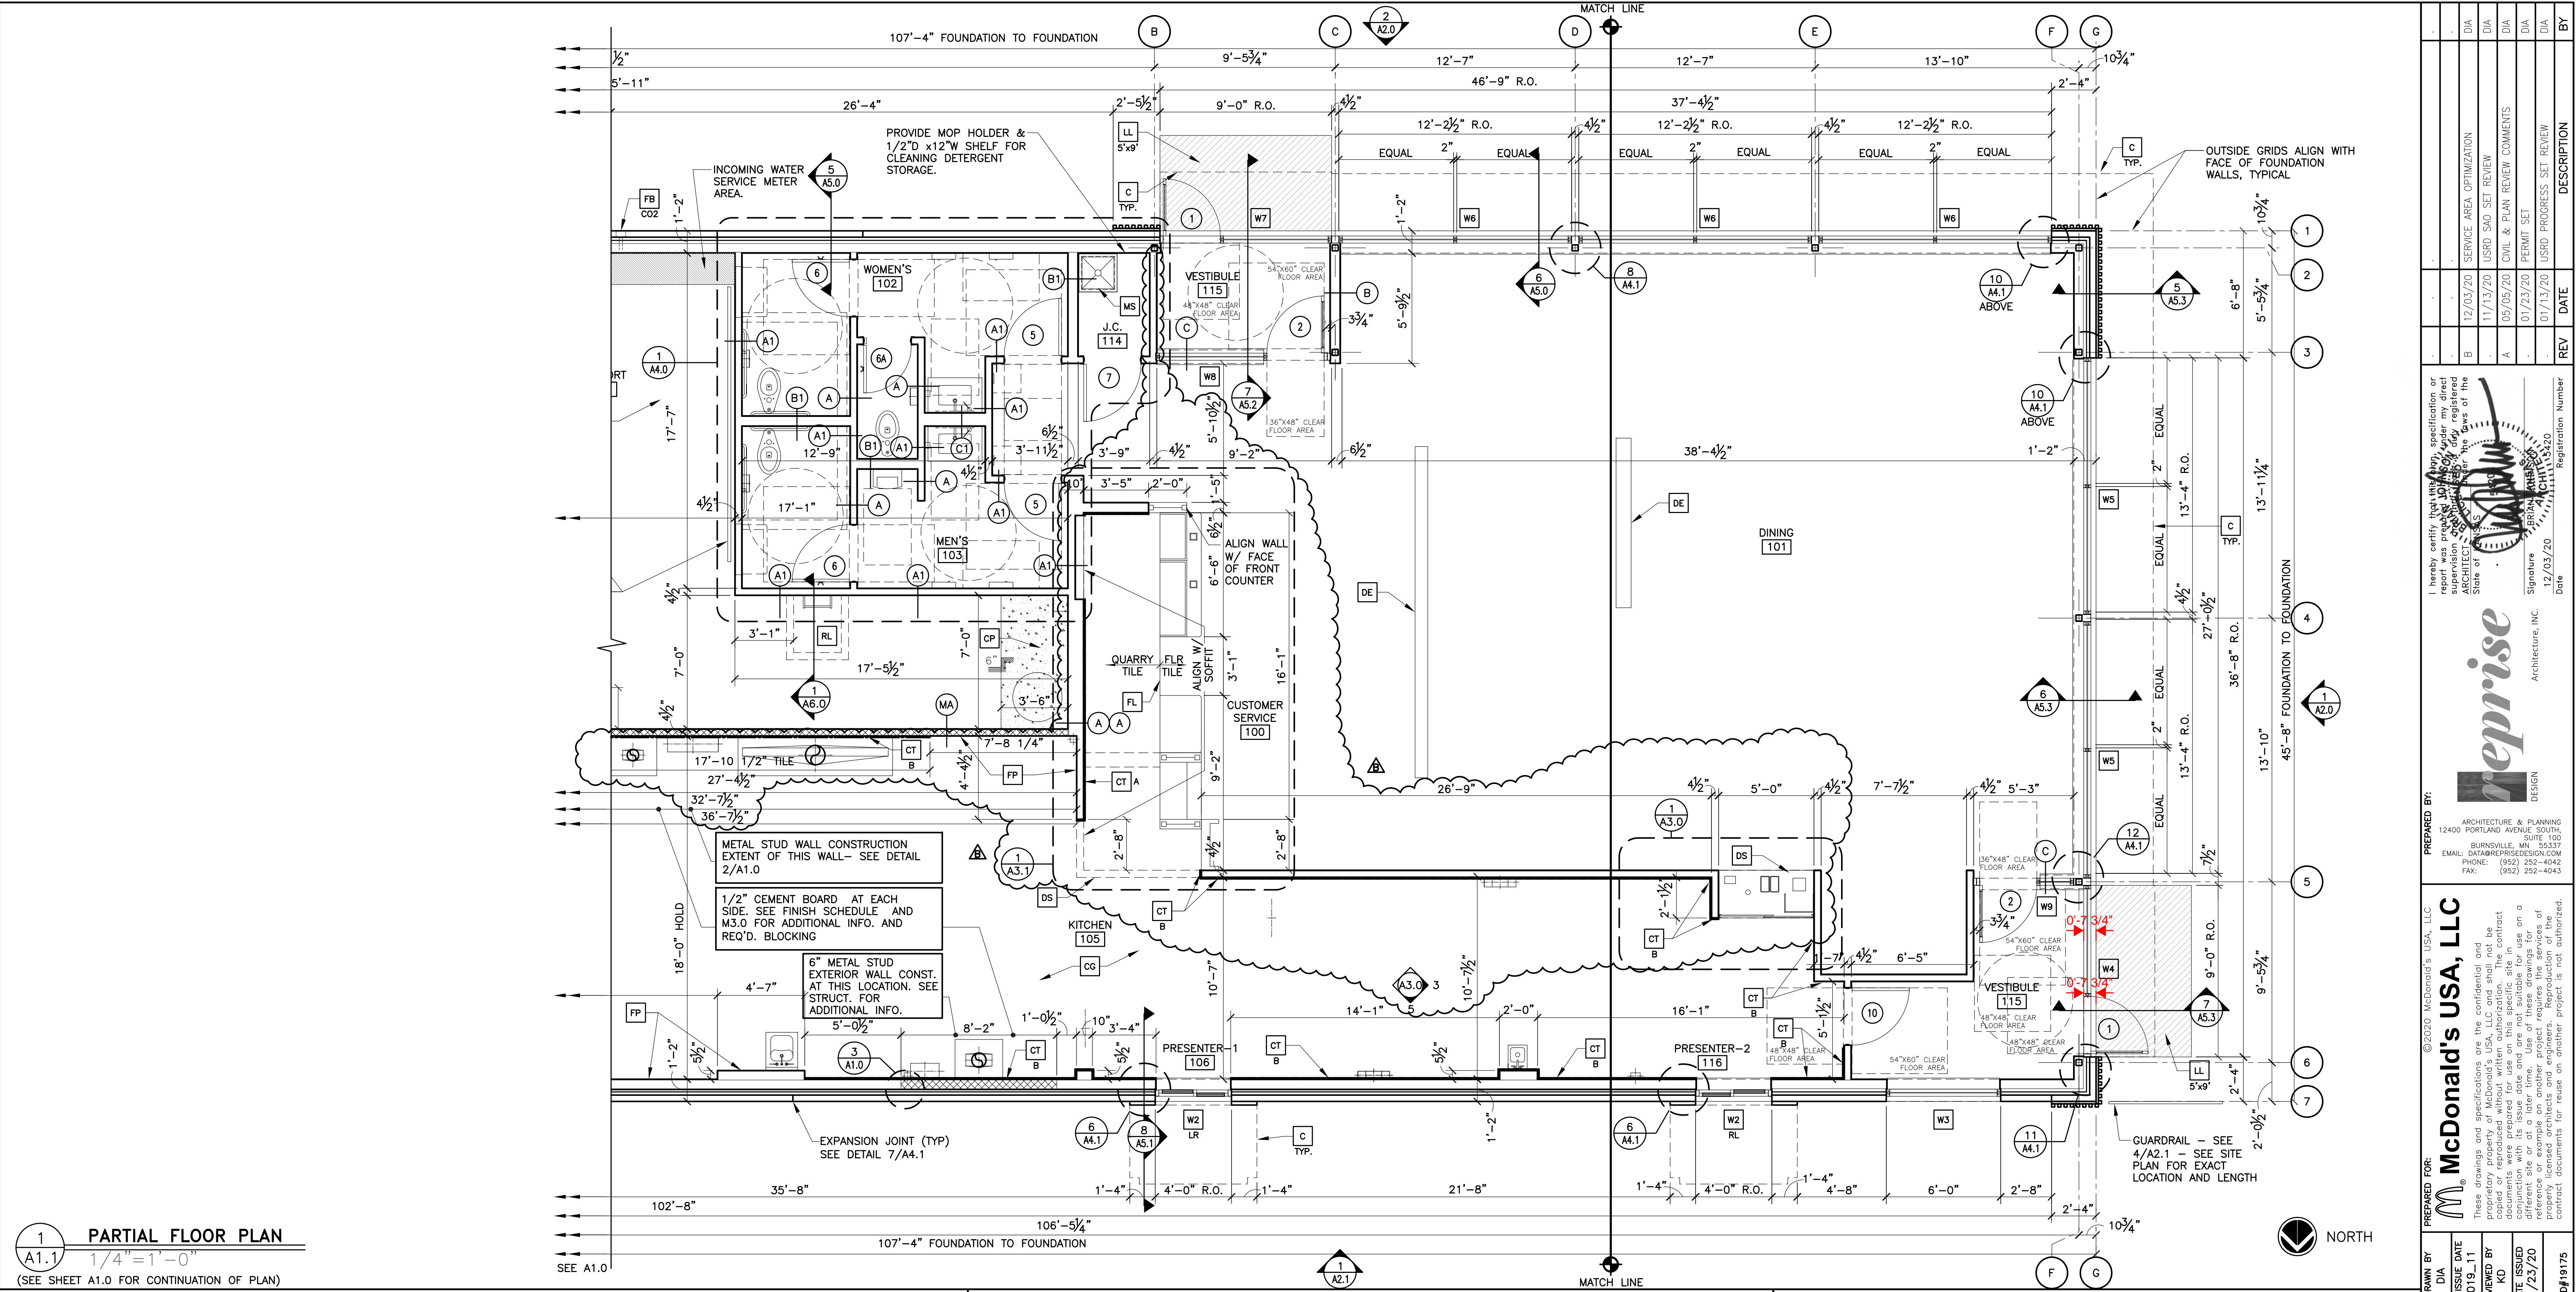

reprise
Architecture, INC.
DESIGN

Signature: *[Signature]*
Title: ARCHITECT
Date: 12/03/20
Registration Number: 55372
Date: 12/03/20

Design

©2020 McDonald's USA, LLC
McDonald's USA, LLC
PREPARED FOR:

12400 ARCHITECTURE & PLANNING, PORTLAND AVENUE SOUTH, SUITE 100, BURNSVILLE, MN 55337
EMAIL: DATA@REPRISEDI.S.COM
PHONE: (952) 252-4042
FAX: (952) 252-4943


These drawings and specifications are the confidential and proprietary property of McDonald's USA, LLC and shall not be reproduced or distributed outside the contract documents without the express written consent of McDonald's USA, LLC. These drawings and specifications are prepared for use on this specific project only and are not suitable for use on other projects or reference to another project. Reproduction, services or distribution of these drawings and specifications for use on other projects is not authorized.

RD#19175

REV DATE

BY

SHEET NO.	TITLE	DRAWN BY	REVISED BY	DATE ISSUED	DATE REVISED	DESCRIPTION
A1.1	2019 STANDARD BUILDING - BB20 4597F10-WOOD/WOOD	DIA STD ISSUE DATE 2019-11 K0	DIA REVISED BY KO	12/03/20 01/23/20	01/23/20	2019 STANDARD BUILDING - BB20 4597F10-WOOD/WOOD WOOD BEARING WALLS W/FIBER CEMENT SIDING & CI FIBER CEMENT PANEL/BATTEN/AUPOVIC PANEL/BRICK EXT. FINISH SITE ID 015-0071 005 SOUTH 7TH STREET, KANSAS CITY, KS SITE ADDRESS 015-0071 005 SOUTH 7TH STREET, KANSAS CITY, KS SITE ADDRESS

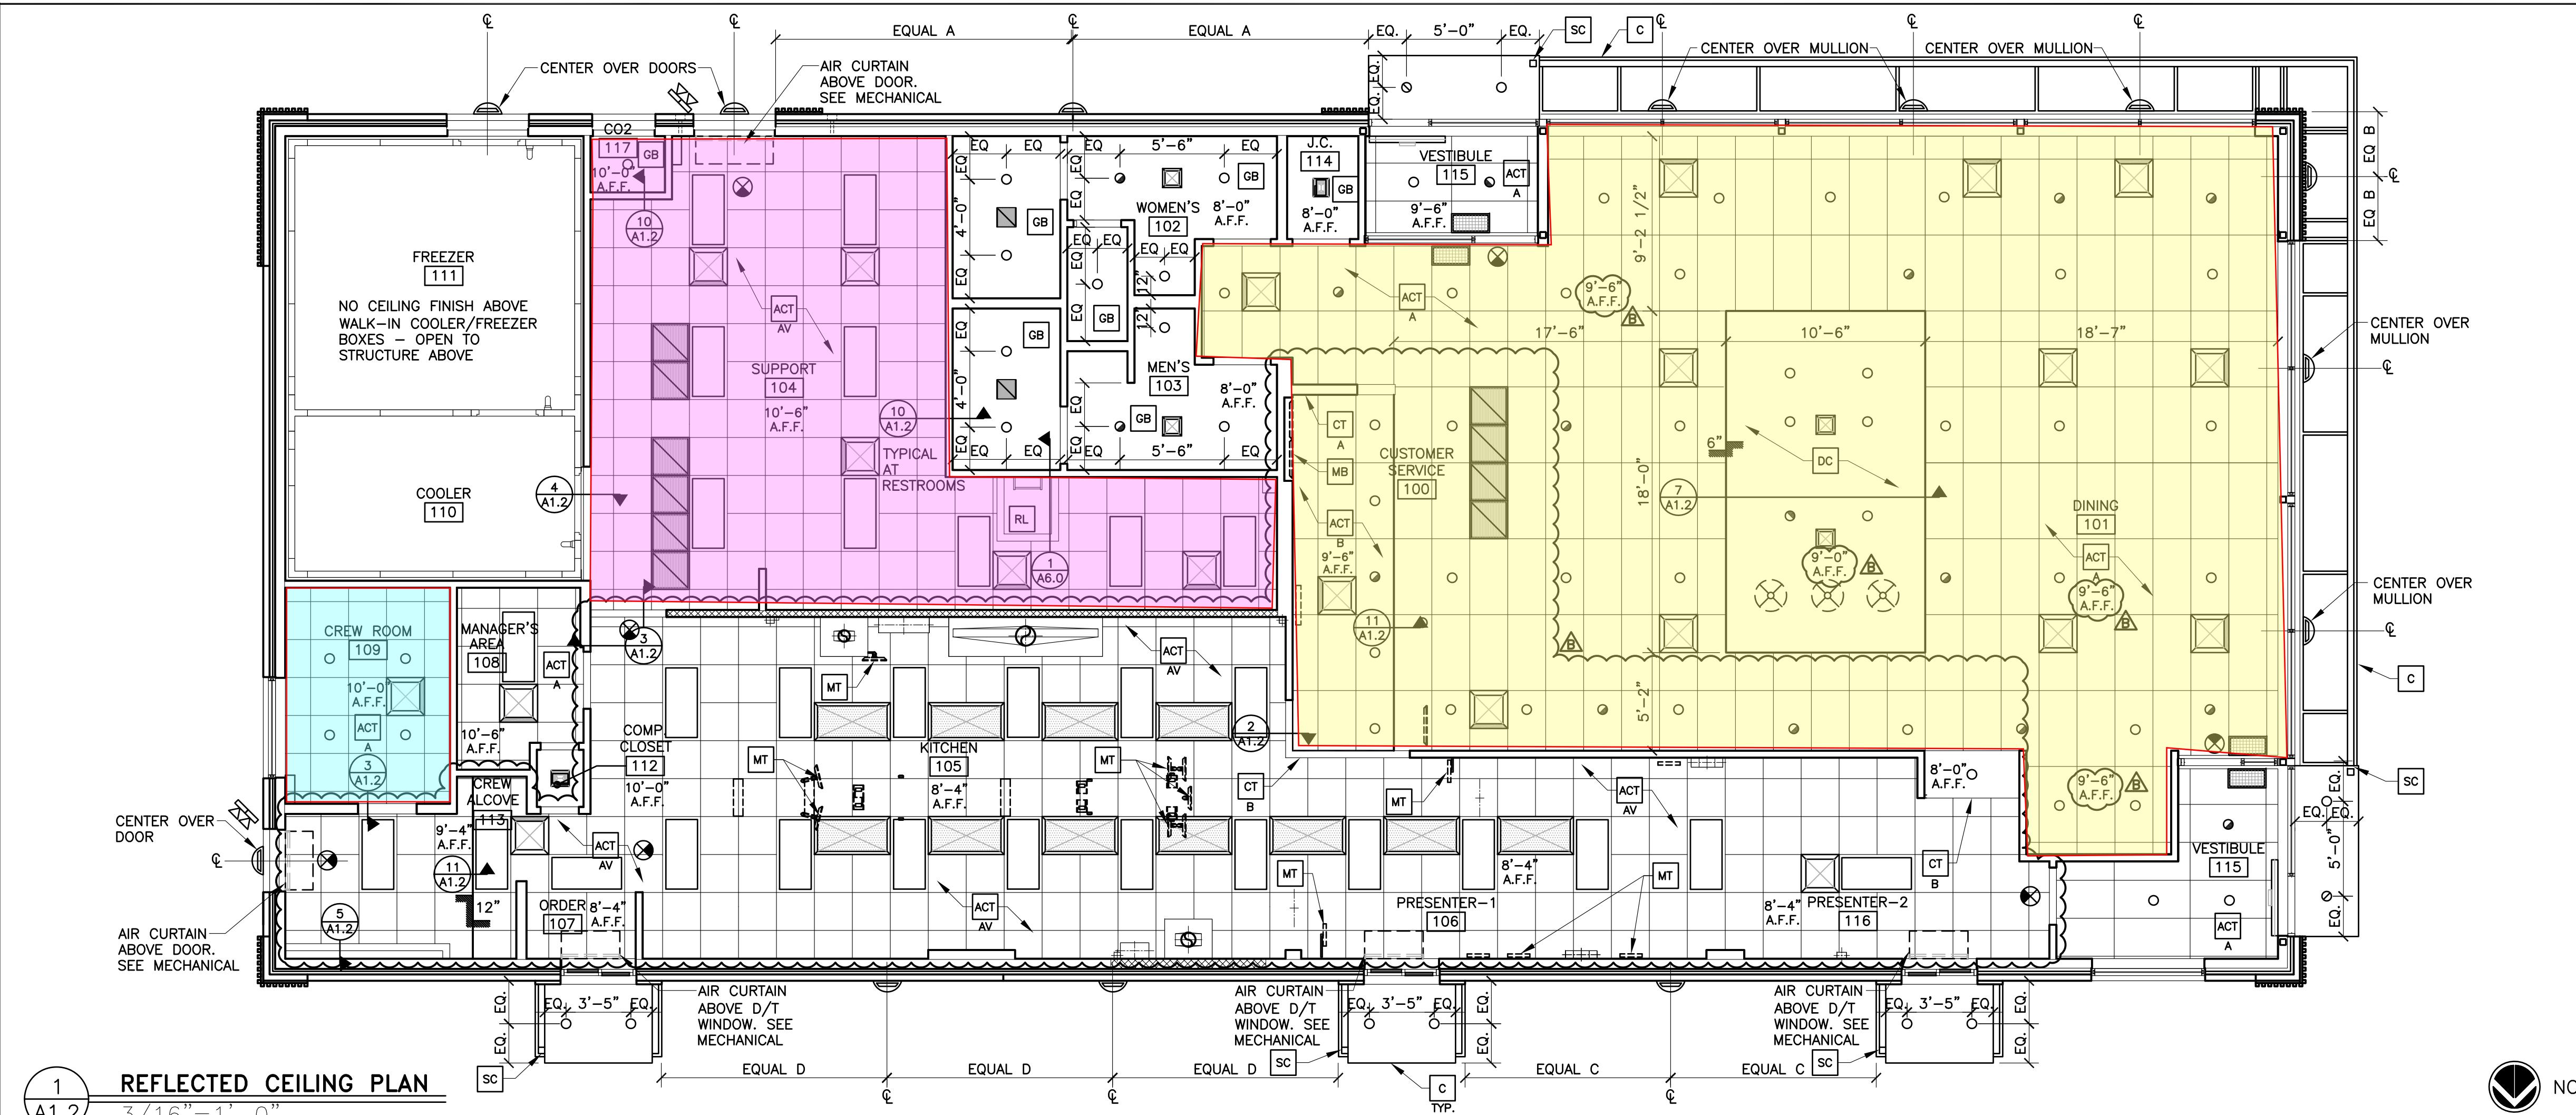

1 REFLECTED CEILING PLAN

A1.2 $3/16'' = 1'$

NORTH

KEY NOTES

ING TILE - 24"X48". VERIFY FINISHES
MPANY

ING TILE: VINYL FACED USG 24"X24"
MA-PLUS. UNPERFORATED. SMOOTH

6" DX/DXL COLOR: WHITE

ING TILE: USG 24"X48" PREMIER
US KAPOK PANELS.

ACK 205

6" DX/DXL COLOR: BLACK

PY WITH INTEGRAL GUTTER AND
4/A5.0 FOR NOTES - SEE ROOF
SIONS - SEE ELEVATION FOR COLOR
ATIONS

MIC TILE

TERN: STACK BOND

ULTRACOLOR PLUS - JOINT TO BE $\frac{1}{6}$ "

WINGS FOR TILE AND GROUT COLOR SPEC.

MIC TILE

TERN: STACK BOND

ULTRACOLOR PLUS - JOINT TO BE $\frac{1}{6}$ "

WINGS FOR TILE AND GROUT COLOR SPEC.

ORATIVE CEILING TREATMENT - SEE
S FOR ADDITIONAL INFORMATION

GN WITH GYP BD AT EXTERIOR WINDOW

ED BY ELEMENT BY DECOR SUPPLIER -
AREA CONSTRUCTION MANAGER

CEILING

TH BEZELS BY OTHERS UNDER SEPARATE
LEC PLANS

MONITOR: A) VERIFY MONITOR
McDONALD'S PROJECT MANAGER PRIOR
B) SEE DETAIL 6/A1.2 FOR
THOD

PENING

R SCUPPER

OTES

R CEILING FINISHES.

MENU BOARD DROPPED SOFFIT LOCATION


TOR SHALL COORDINATE HVAC DIFFUSER
COR & MECHANICAL PLANS AND REPORT
S TO ARCHITECT.

NICAL AND ELECTRICAL DRAWINGS FOR
HTING INFORMATION.

CEILING TILE RETENTION CLIPS IN ALL




IGN

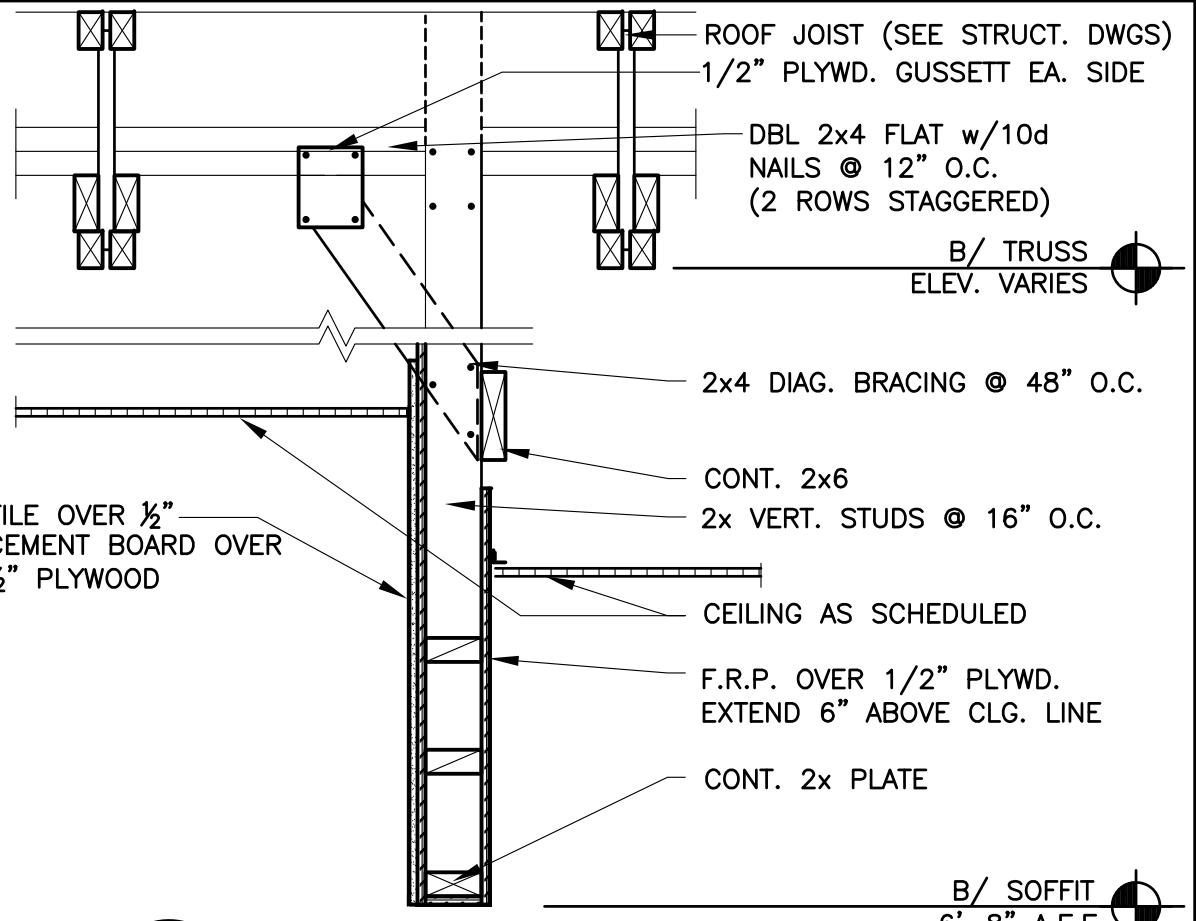


2 VALANCE SECTION

A1.2 1 " =

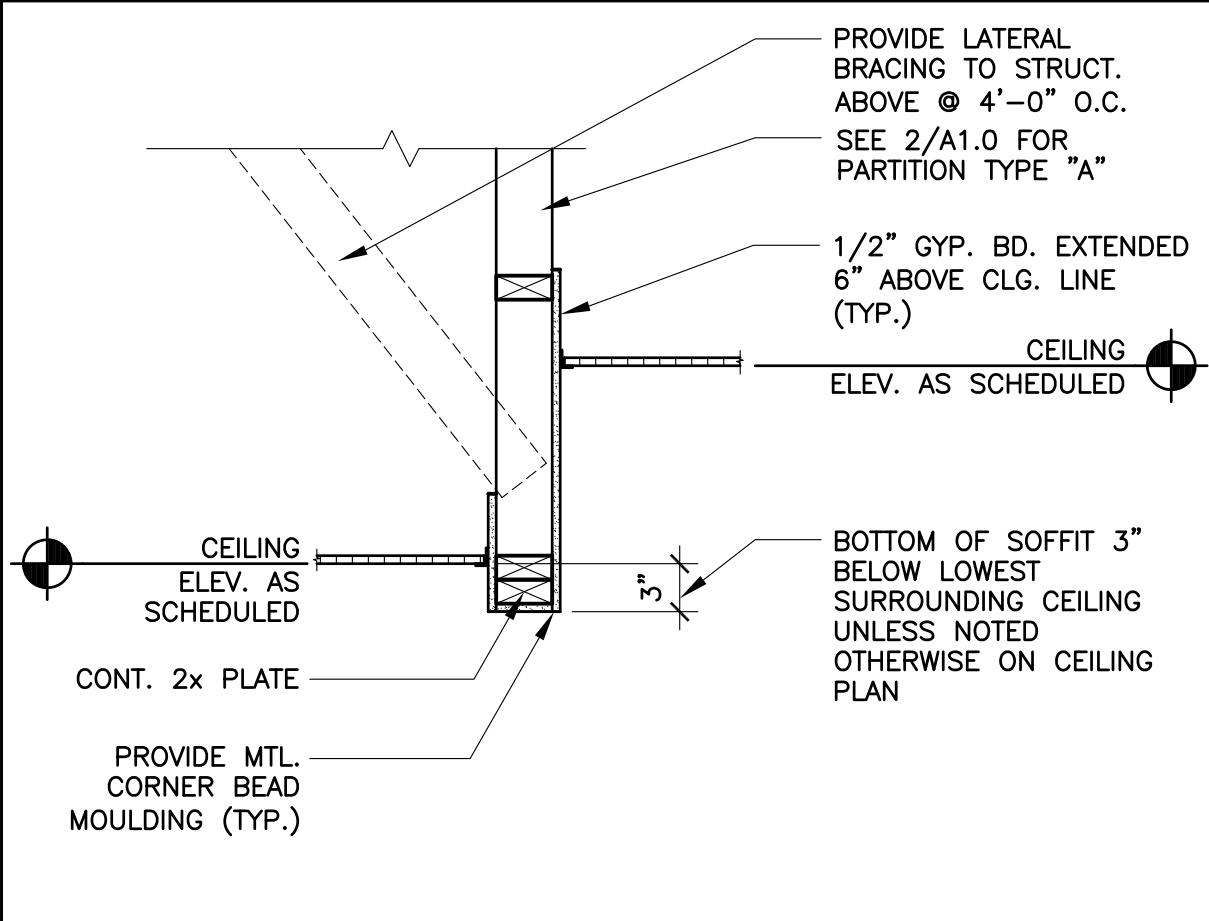


3 CEILING TRANSITION w/ SOFFIT


A1.2

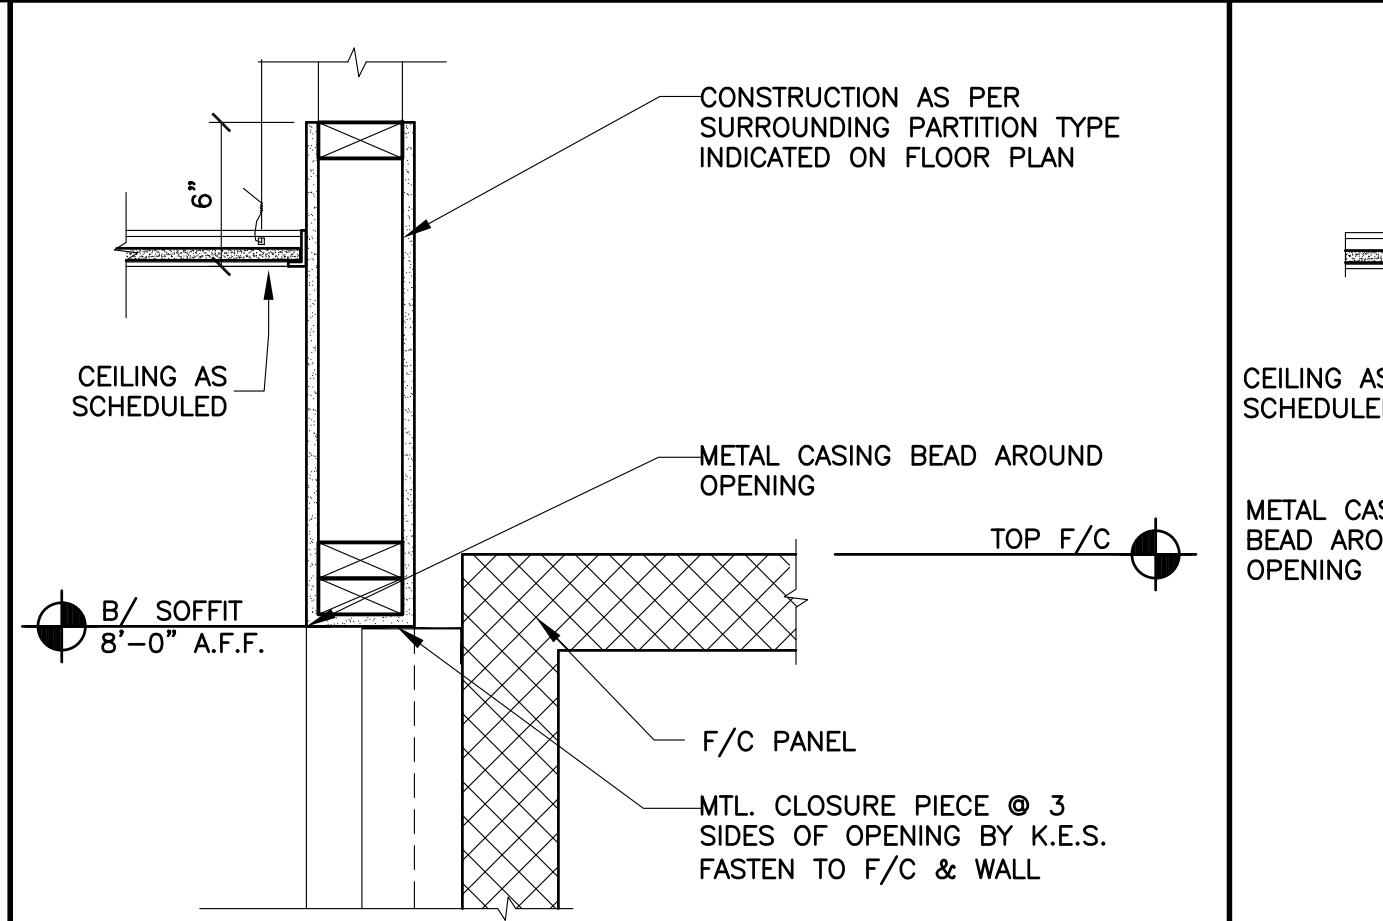


CEILING DETAIL AT COOLER

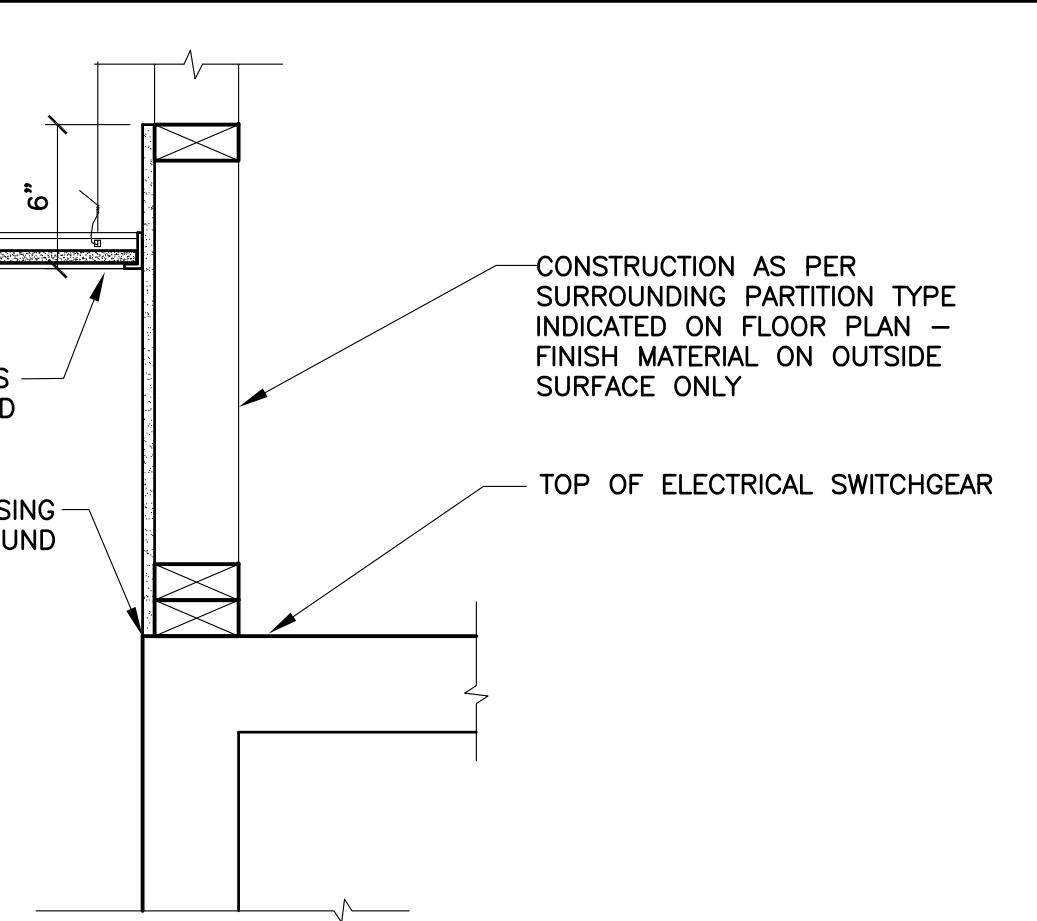

CEILING DETAIL AT SWITCHGEAR

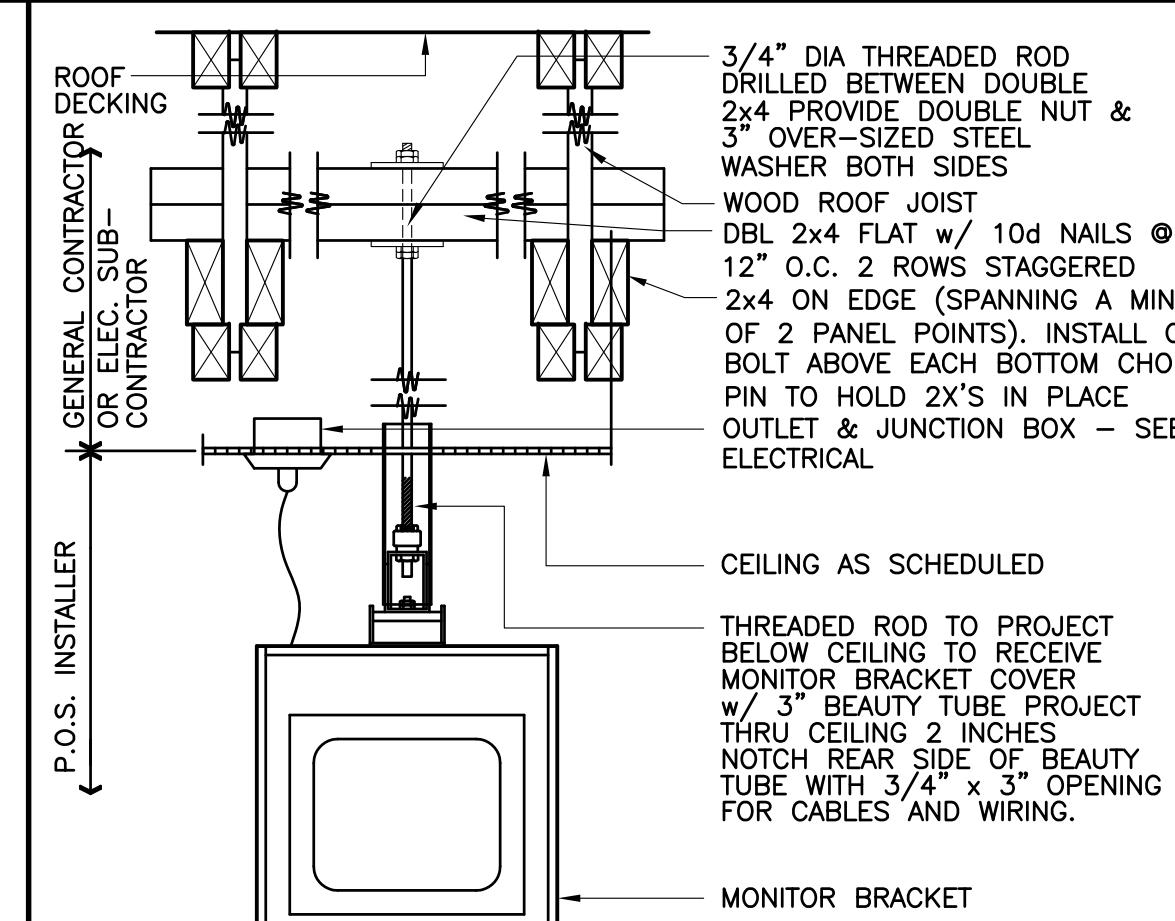


6 MONITOR INSTALLATION DETAIL

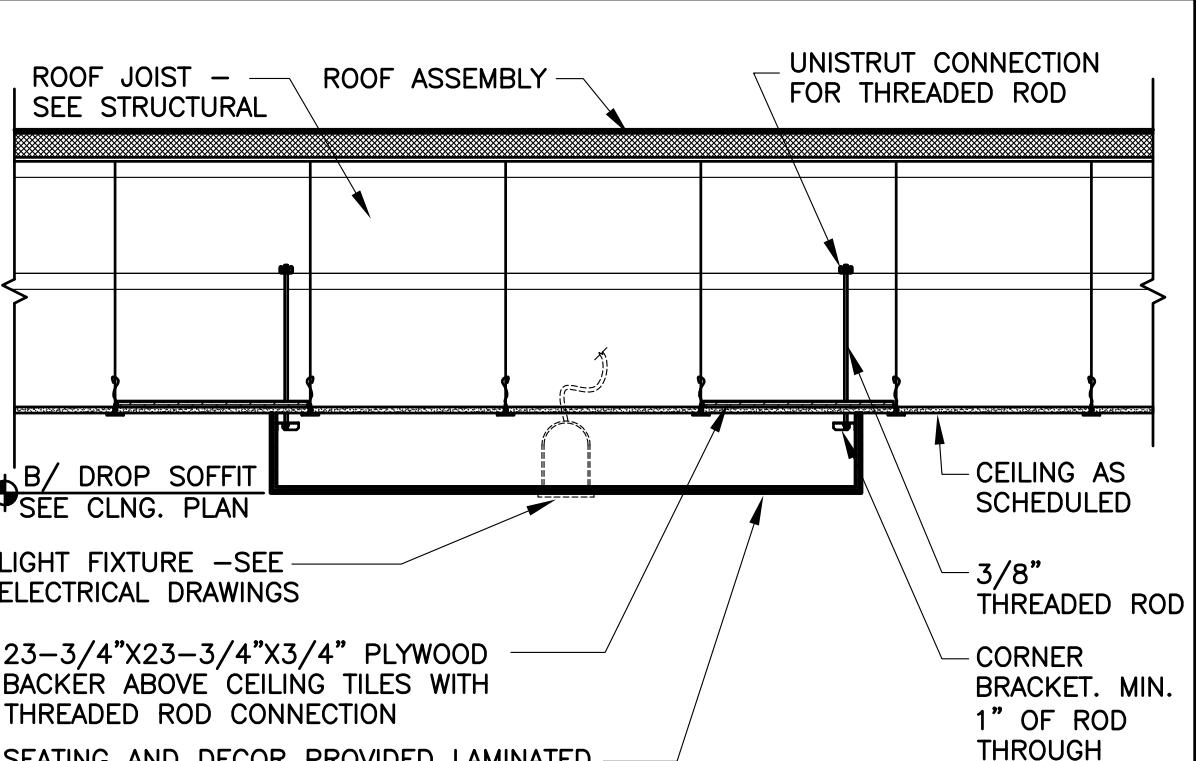


SLATING AND DECOR PROVIDED LAMINATED
SOFFIT. G.C. TO COORDINATE
ELECTRICAL / LIGHTING

ELECTRICAL/LIGHTING


CEILING TRANSITION w/ SOFFIT

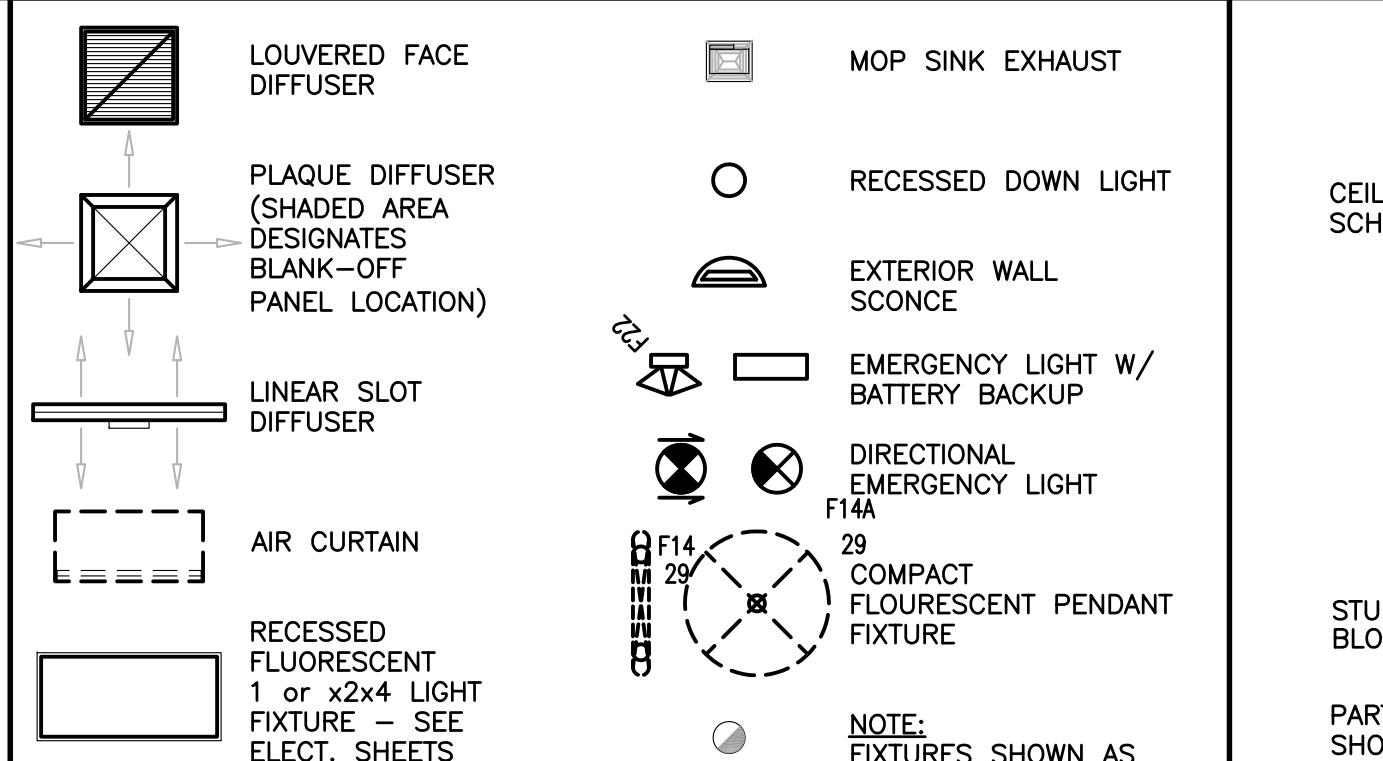


PERFORATED FACE

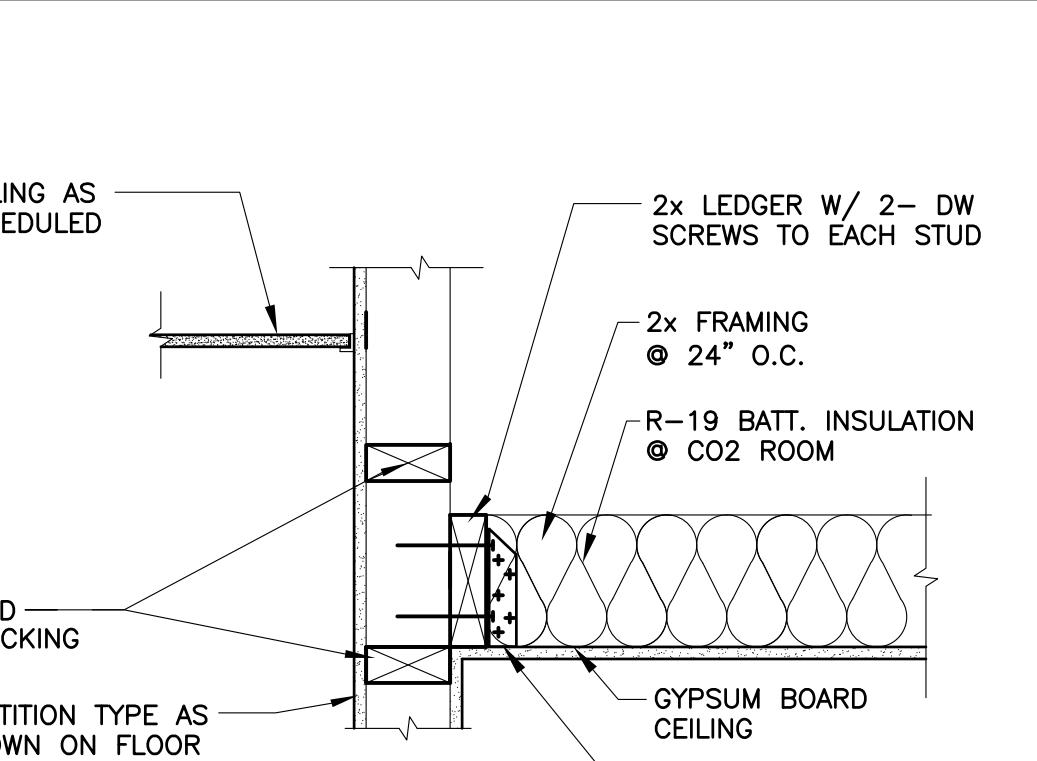


S.S.T. "U" HANGER

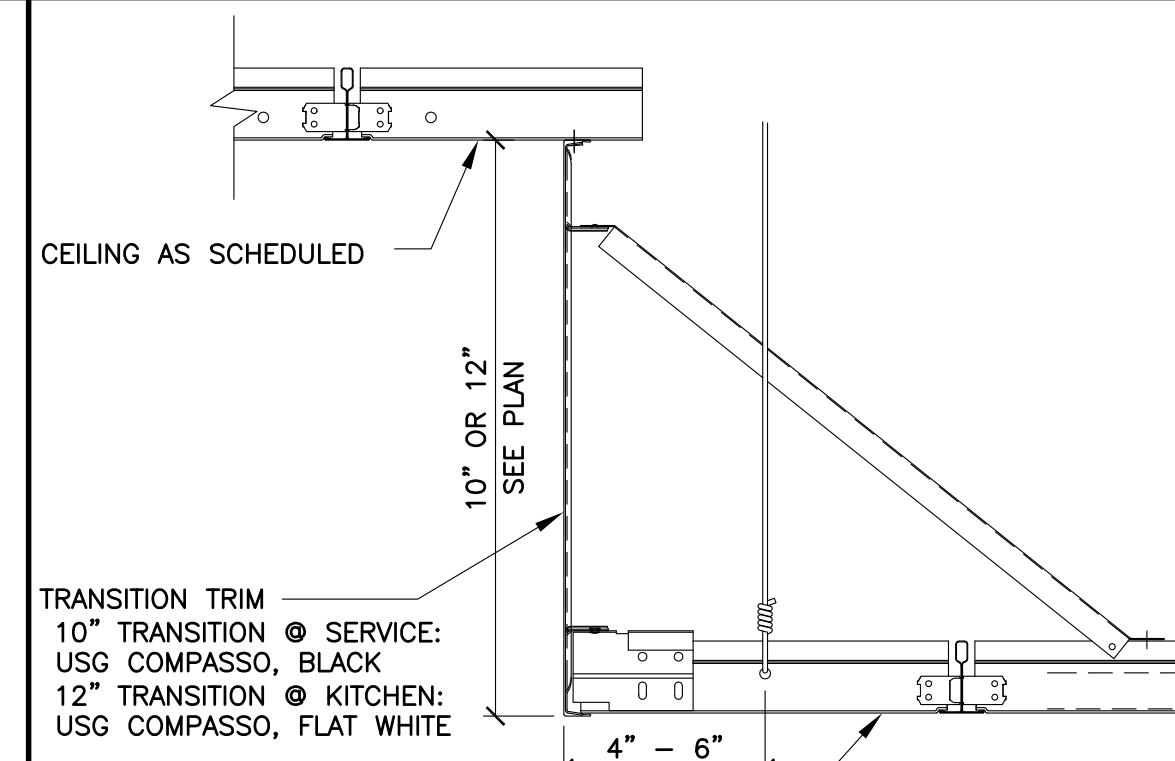

 A horizontal line with two vertical tick marks at its ends, representing a segment.

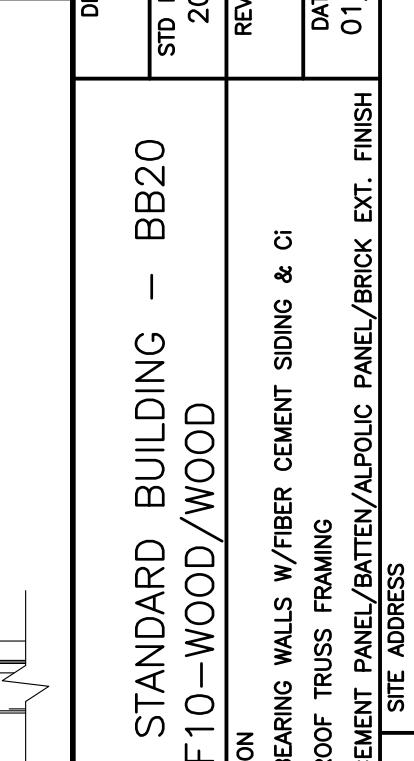

ID

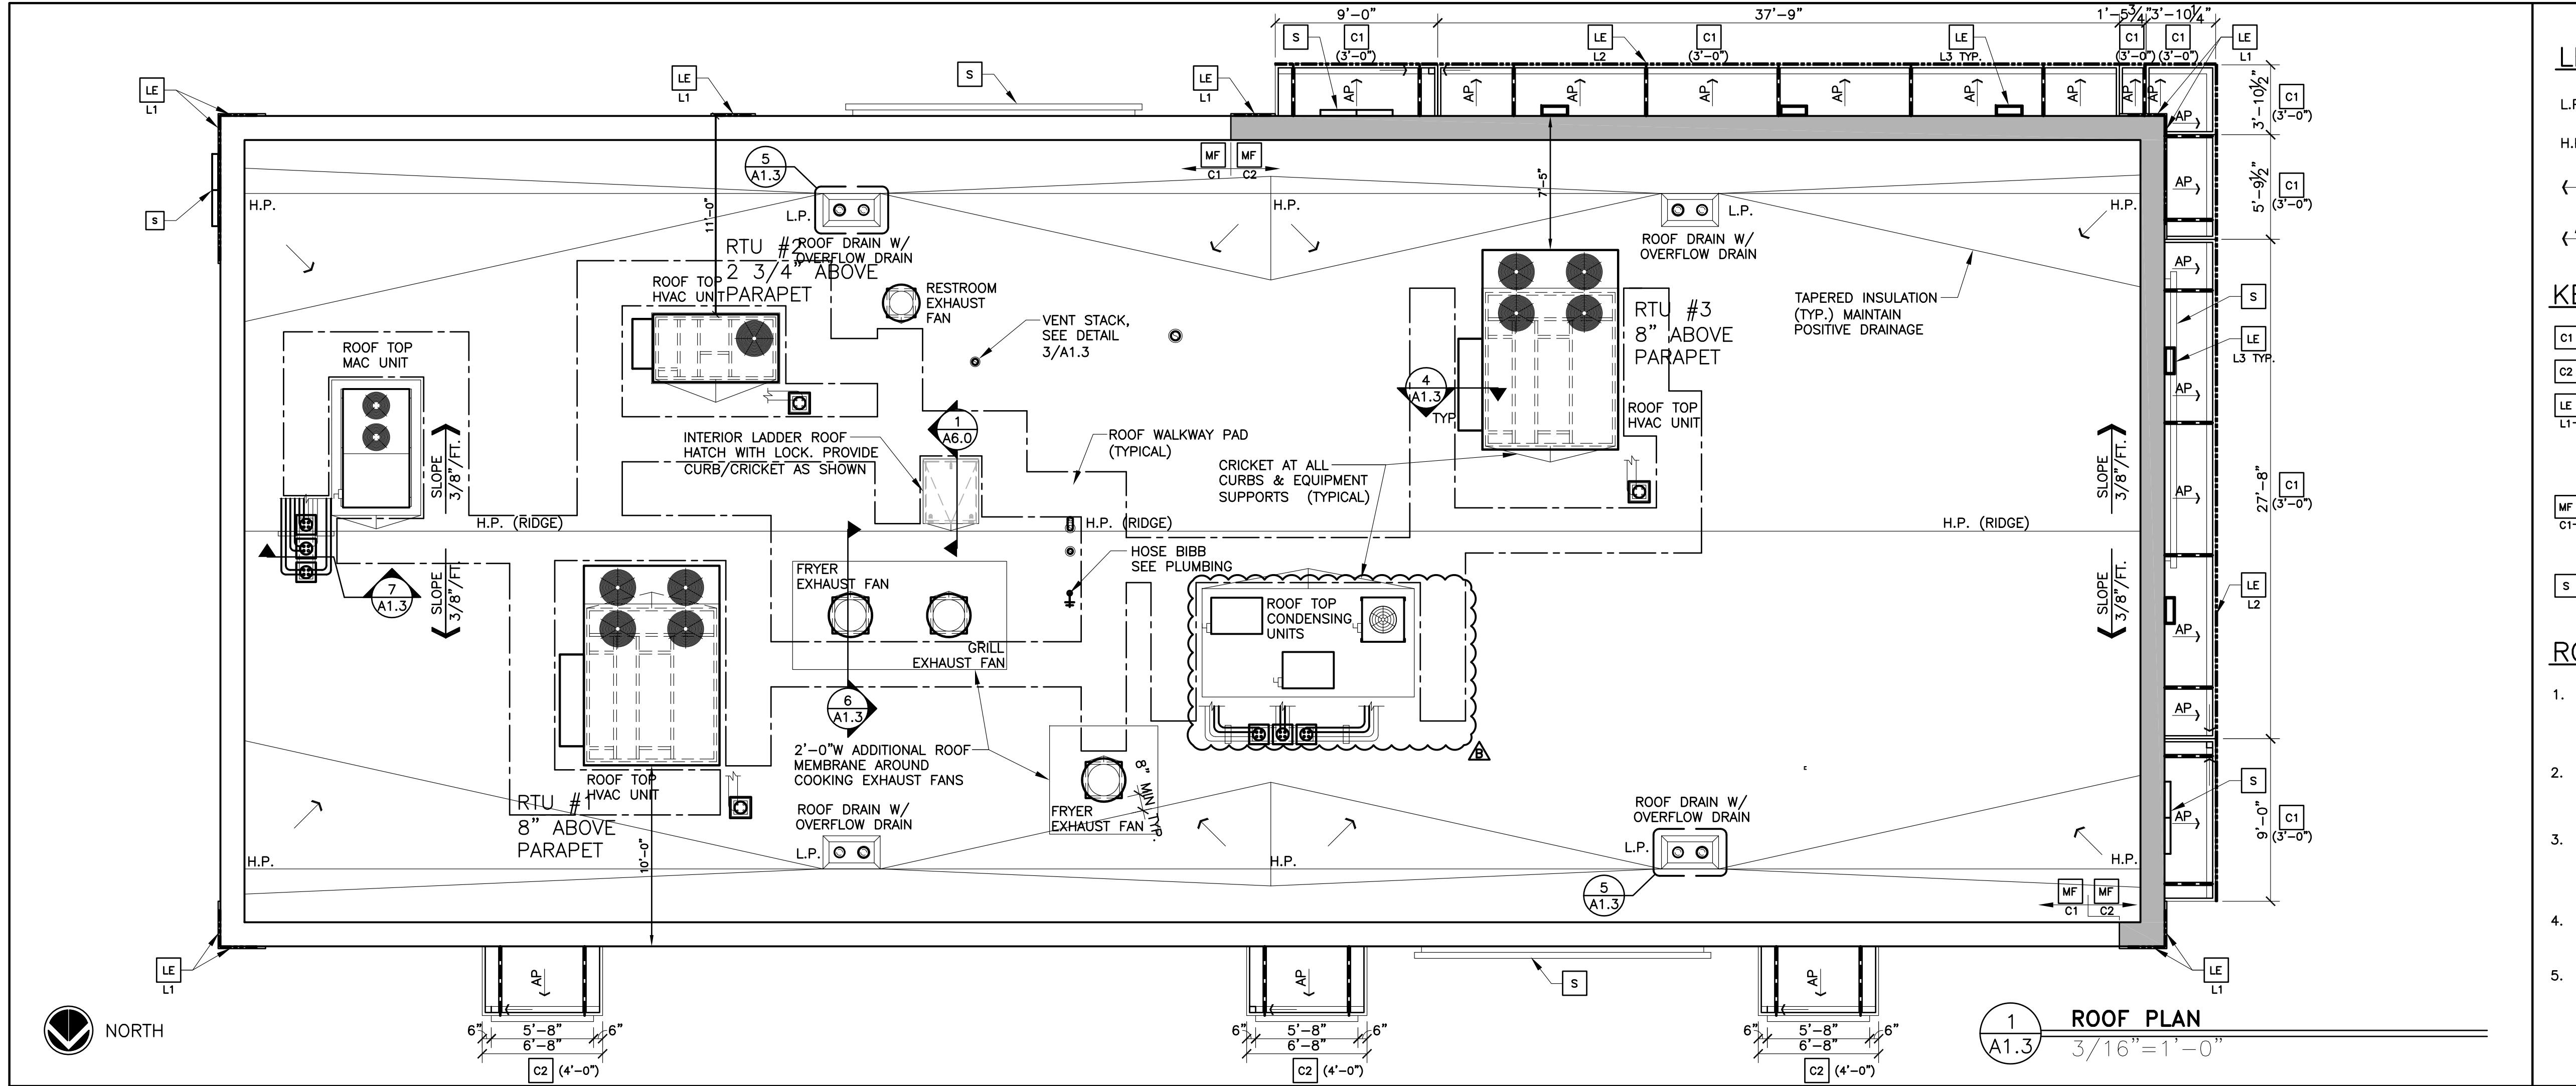

SHEET NO.	TITLE	REV	DATE	DESCRIPTION
	2019 STANDARD BUILDING - BB20	B	12/03/20	SERVICE AREA OPTIMIZATION
	4597F10-WOOD/WOOD	A	05/15/20	USFD SA SET REVIEW
			11/15/20	CIVIL & PLAN REVIEW COMMENTS
			01/23/20	PERMIT SET
			01/13/20	USD PROGRESS SET REVIEW
				BY

reprise
Architecture, Inc.
DESIGN

©2020 McDonald's USA, LLC
McDonald's USA, LLC

PREPARED BY:
ARCHITECTURE & PLANNING
12400 AVENUE SOUTH, SUITE 100
BURNSVILLE, MN 55337
EMAIL: DATAREPRISERED.COM
PHONE: (952) 252-4042
FAX: (952) 252-4943

PREPARED FOR:
McDonald's USA, LLC

NOTE: These drawings and specifications are the confidential and proprietary property of McDonald's USA, LLC and shall not be reproduced or distributed outside the contract documents without the express written consent of McDonald's USA, LLC. These drawings and specifications are prepared for use on this specific project and are not suitable for use on another project unless specifically authorized by McDonald's USA, LLC.

ROOFING SYSTEM

1. MANUFACTURERS AND PRODUCTS:
A REFER TO JOHNS MANVILLE WEBSITE (www.jm.com) FOR MOST UP-TO-DATE INFORMATION.
JM-TPO
NO SUBSTITUTIONS ALLOWED

2. SPECIFIED ROOFING SYSTEMS (AS SHOWN):
HEAT-WELDABLE SINGLE-PLY 60 MIL TPO ROOFING SYSTEM, INSTALLED OVER RIGID INSULATION ON WOOD ROOF DECK HAVING A SLOPE OF 3/8"/FT. MATERIALS SHALL BE AS FOLLOWS:
A. TPO ROOFING SYSTEM AS MANUFACTURED BY MANUFACTURER LISTED ABOVE TO COMPLY WITH ASTM E 108 OR UL 790, ASTM D-6878, AND FMG I-90 FOR WIND UPLIFT.
B. FASTENERS: METAL FASTENERS AND PLATES AS PER MANUFACTURER.
C. ACCESSORIES: PRE-FABRICATED CURBS, FLASHING, CORNERS, TERMINATION BARS, PIPE FLASHING, VENT FLASHING ETC. AS PER MANUFACTURER.
D. PLEASE SEE SINGLE PLY FLASHING SPECIFICATIONS FOR A FULL DESCRIPTION OF INSTALLATION INSTRUCTIONS AND REQUIREMENTS WHICH ARE CONSIDERED A PART OF THIS DETAIL.
E. ANY CARPENTRY OR METAL WORK SHOULD BE DESIGNED AND CONSTRUCTED IN ACCORDANCE WITH LOCAL CODE REQUIREMENTS AND/OR PROJECT SPECIFICATIONS. THESE COMPONENTS SHOULD BE REVIEWED AND APPROVED BY A LICENSED DESIGN PROFESSIONAL. CONTACT JM TECHNICAL FOR METAL OPTIONS TO BE INCLUDED WITHIN THE JM NDL GUARANTEE.
F. JM TPO EDGE SEALANT IS REQUIRED ON ALL CUT OR NON-ENCAPSULATED EDGES OF REINFORCED MEMBRANE. THIS INCLUDES FACTORY CUT REINFORCEMENT (SEE DETAIL T-MS-01).

3. WALKWAYS:
A. 30" WIDE WALKWAY ROLL, HOT AIR WELDED TO MEMBRANE.
B. PROVIDE WALKWAY FROM ROOF LADDER EXIT TO ALL ROOF TOP EQUIPMENT AS PER ROOF PLAN ABOVE.
C. INSTALL WALKWAY ACCORDING TO WALKWAY PAD MANUFACTURER'S WRITTEN INSTRUCTION.

4. RIGID INSULATION:
PROVIDE REQUIRED LAYERS OF POLYISOCYANURATE INSULATION W/ 1/2" "DENSEDECK" COVER BOARD TO MEET A MINIMUM CONTINUOUS R-30 VALUE - THICKNESS AS REQUIRED. PROVIDE POSITIVE SLOPE TO ALL ROOF DRAINS. SEE ROOF PLAN. PROVIDE TOP LAYER PROTECTION MATERIAL AS PER MANUFACTURER'S RECOMMENDATIONS. BOTTOM LAYER OF INSULATION TO HAVE INTEGRAL THERMAL BARRIER OR APPROVED ROOFING MANUFACTURER'S THERMAL UNDERLAYMENT SHEET. ASSEMBLY SHALL COMPLY WITH UL 1256 OR FMG 4450 AND ASTM C 1289, TYPE I OR II.

5. TAPERED INSULATION:
PROVIDE TAPERED INSULATION AS REQUIRED FOR POSITIVE DRAINAGE TO ROOF DRAINS AS INDICATED PER ROOF PLAN ABOVE. 1/4" PER FOOT MIN. REQUIRED.

6. EXHAUST FANS:
PROVIDE ADDITIONAL LAYER OF ROOF MEMBRANE AROUND EXHAUST FANS AS INDICATED PER ROOF PLAN ABOVE.

SEE PLUMBING DRAWINGS

3 TYPICAL VENT PENETRATION



4 HVAC UNIT ROOF CURB DETAIL

5 ROOF DRAIN DETAIL

6 DETAIL @ EXHAUST FAN

7 PIPE PORTAL DETAIL



8 SECTION @ ROOF DRAIN

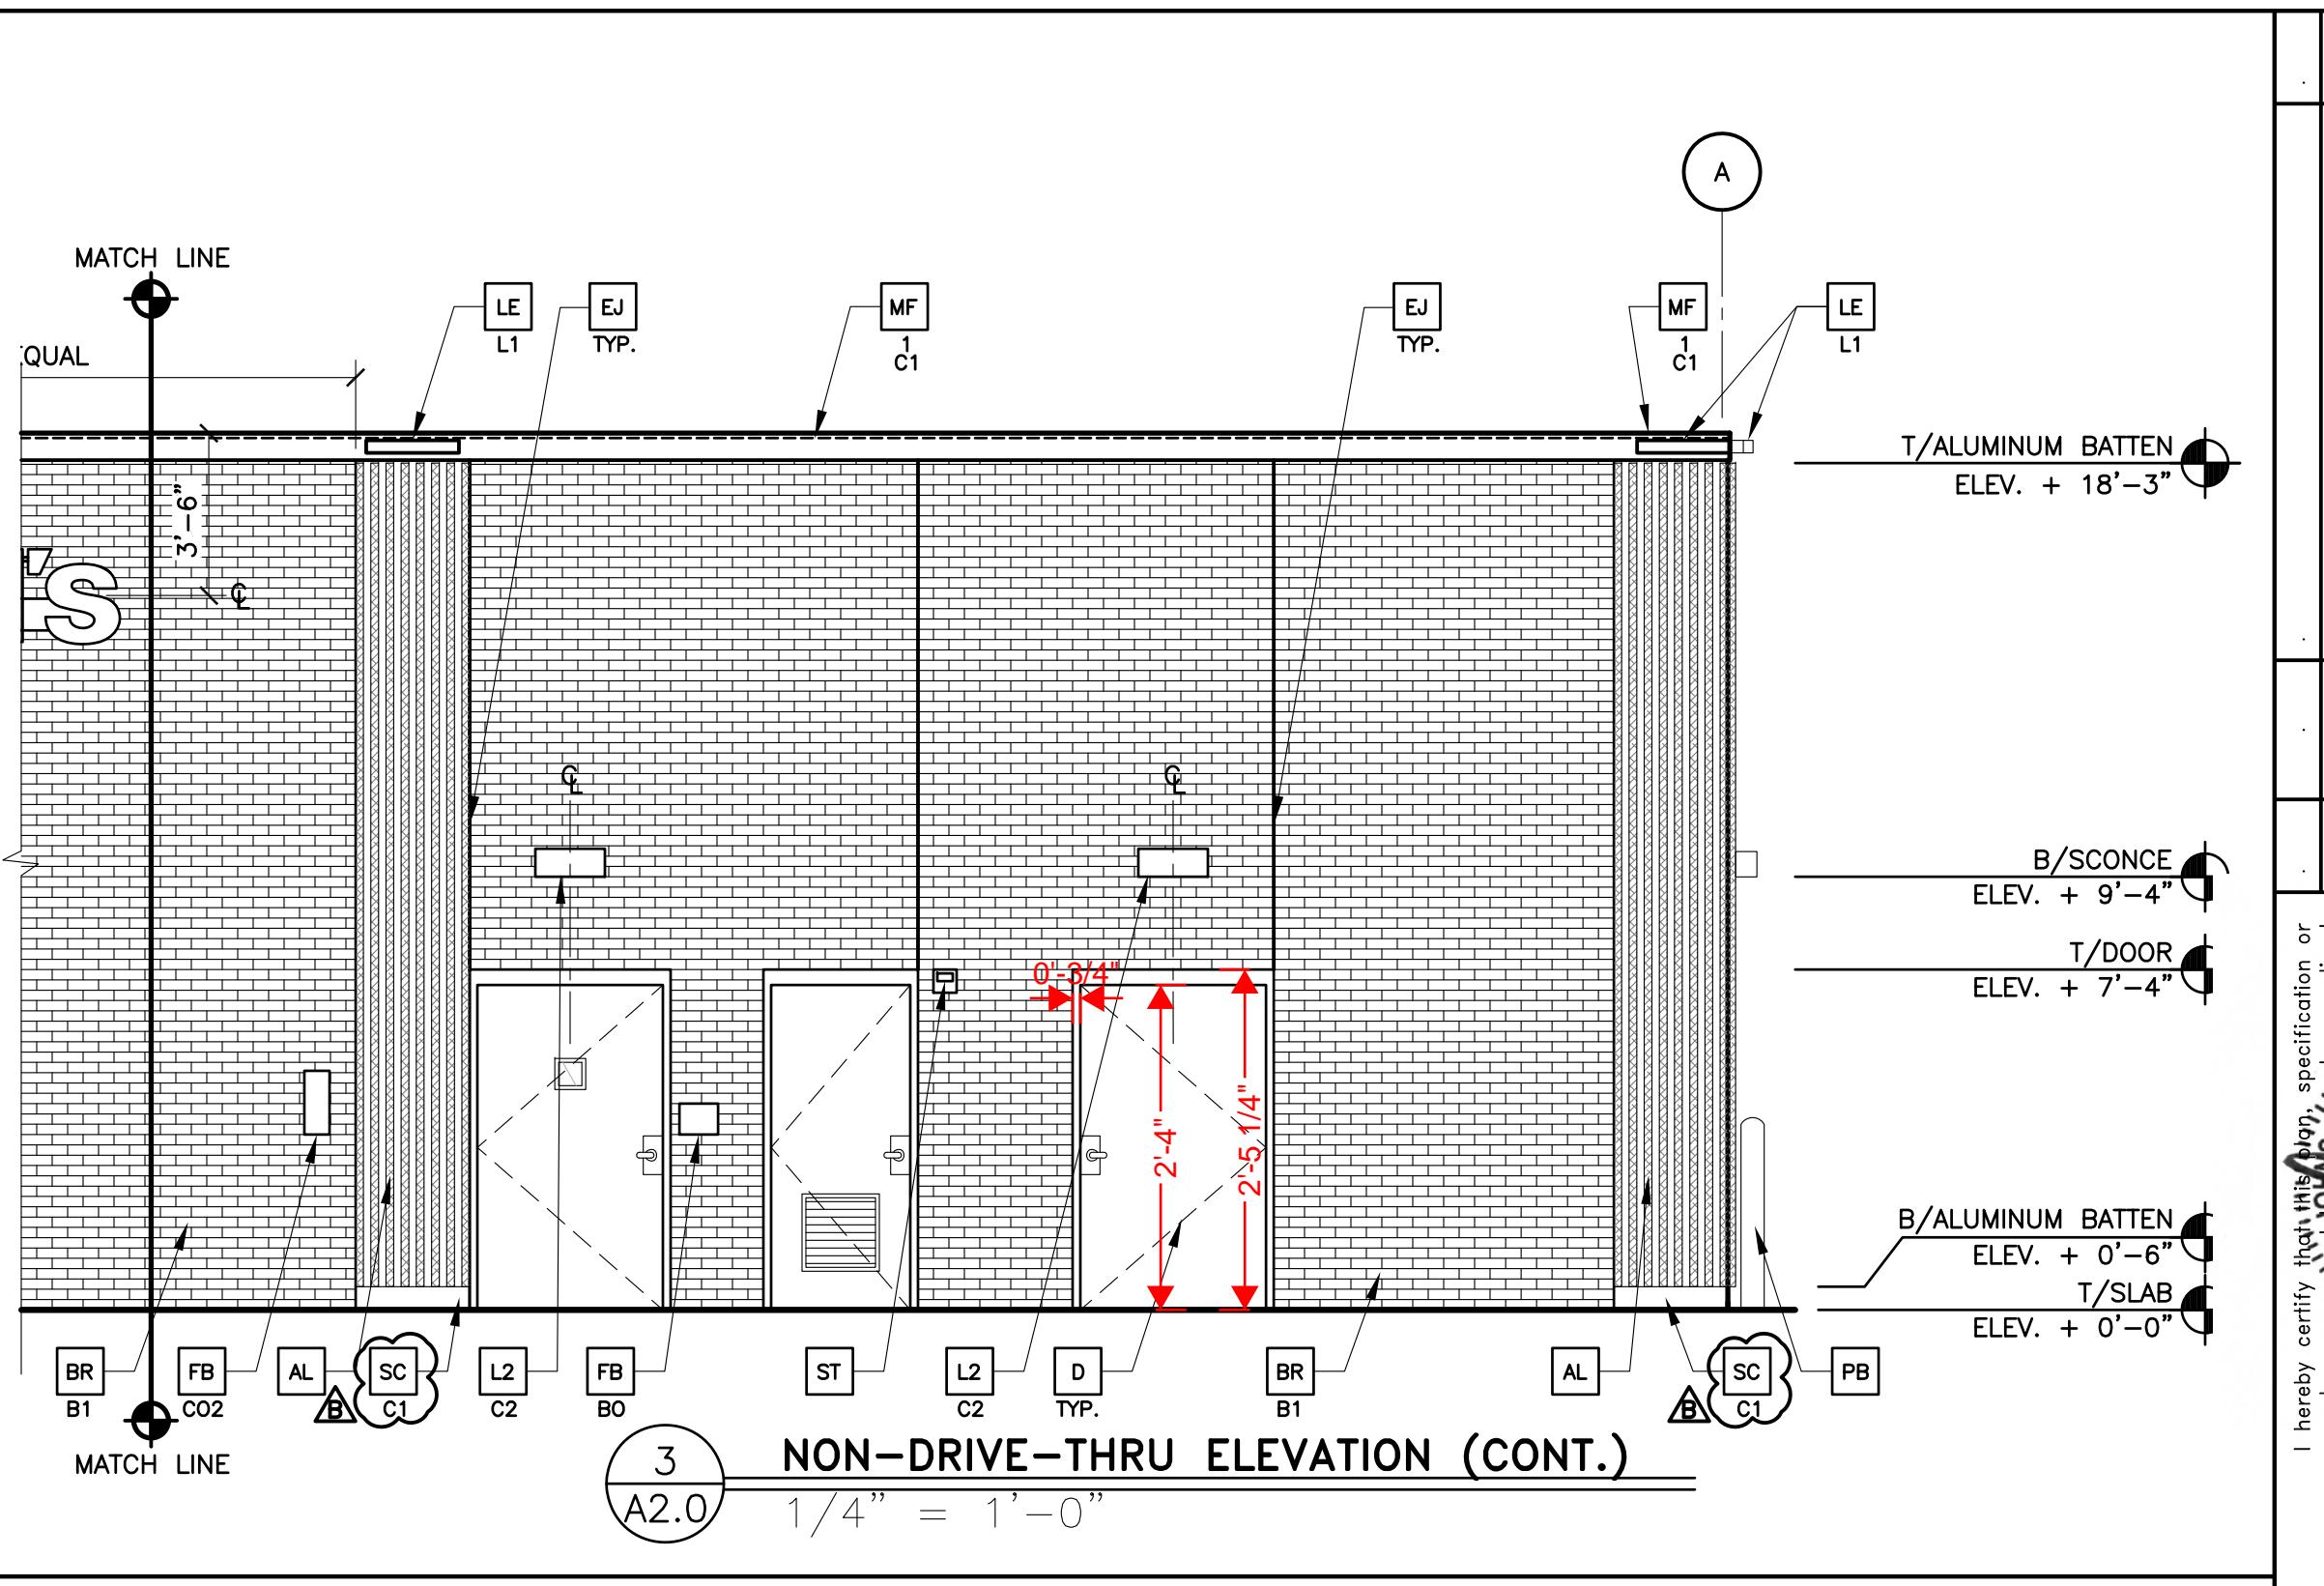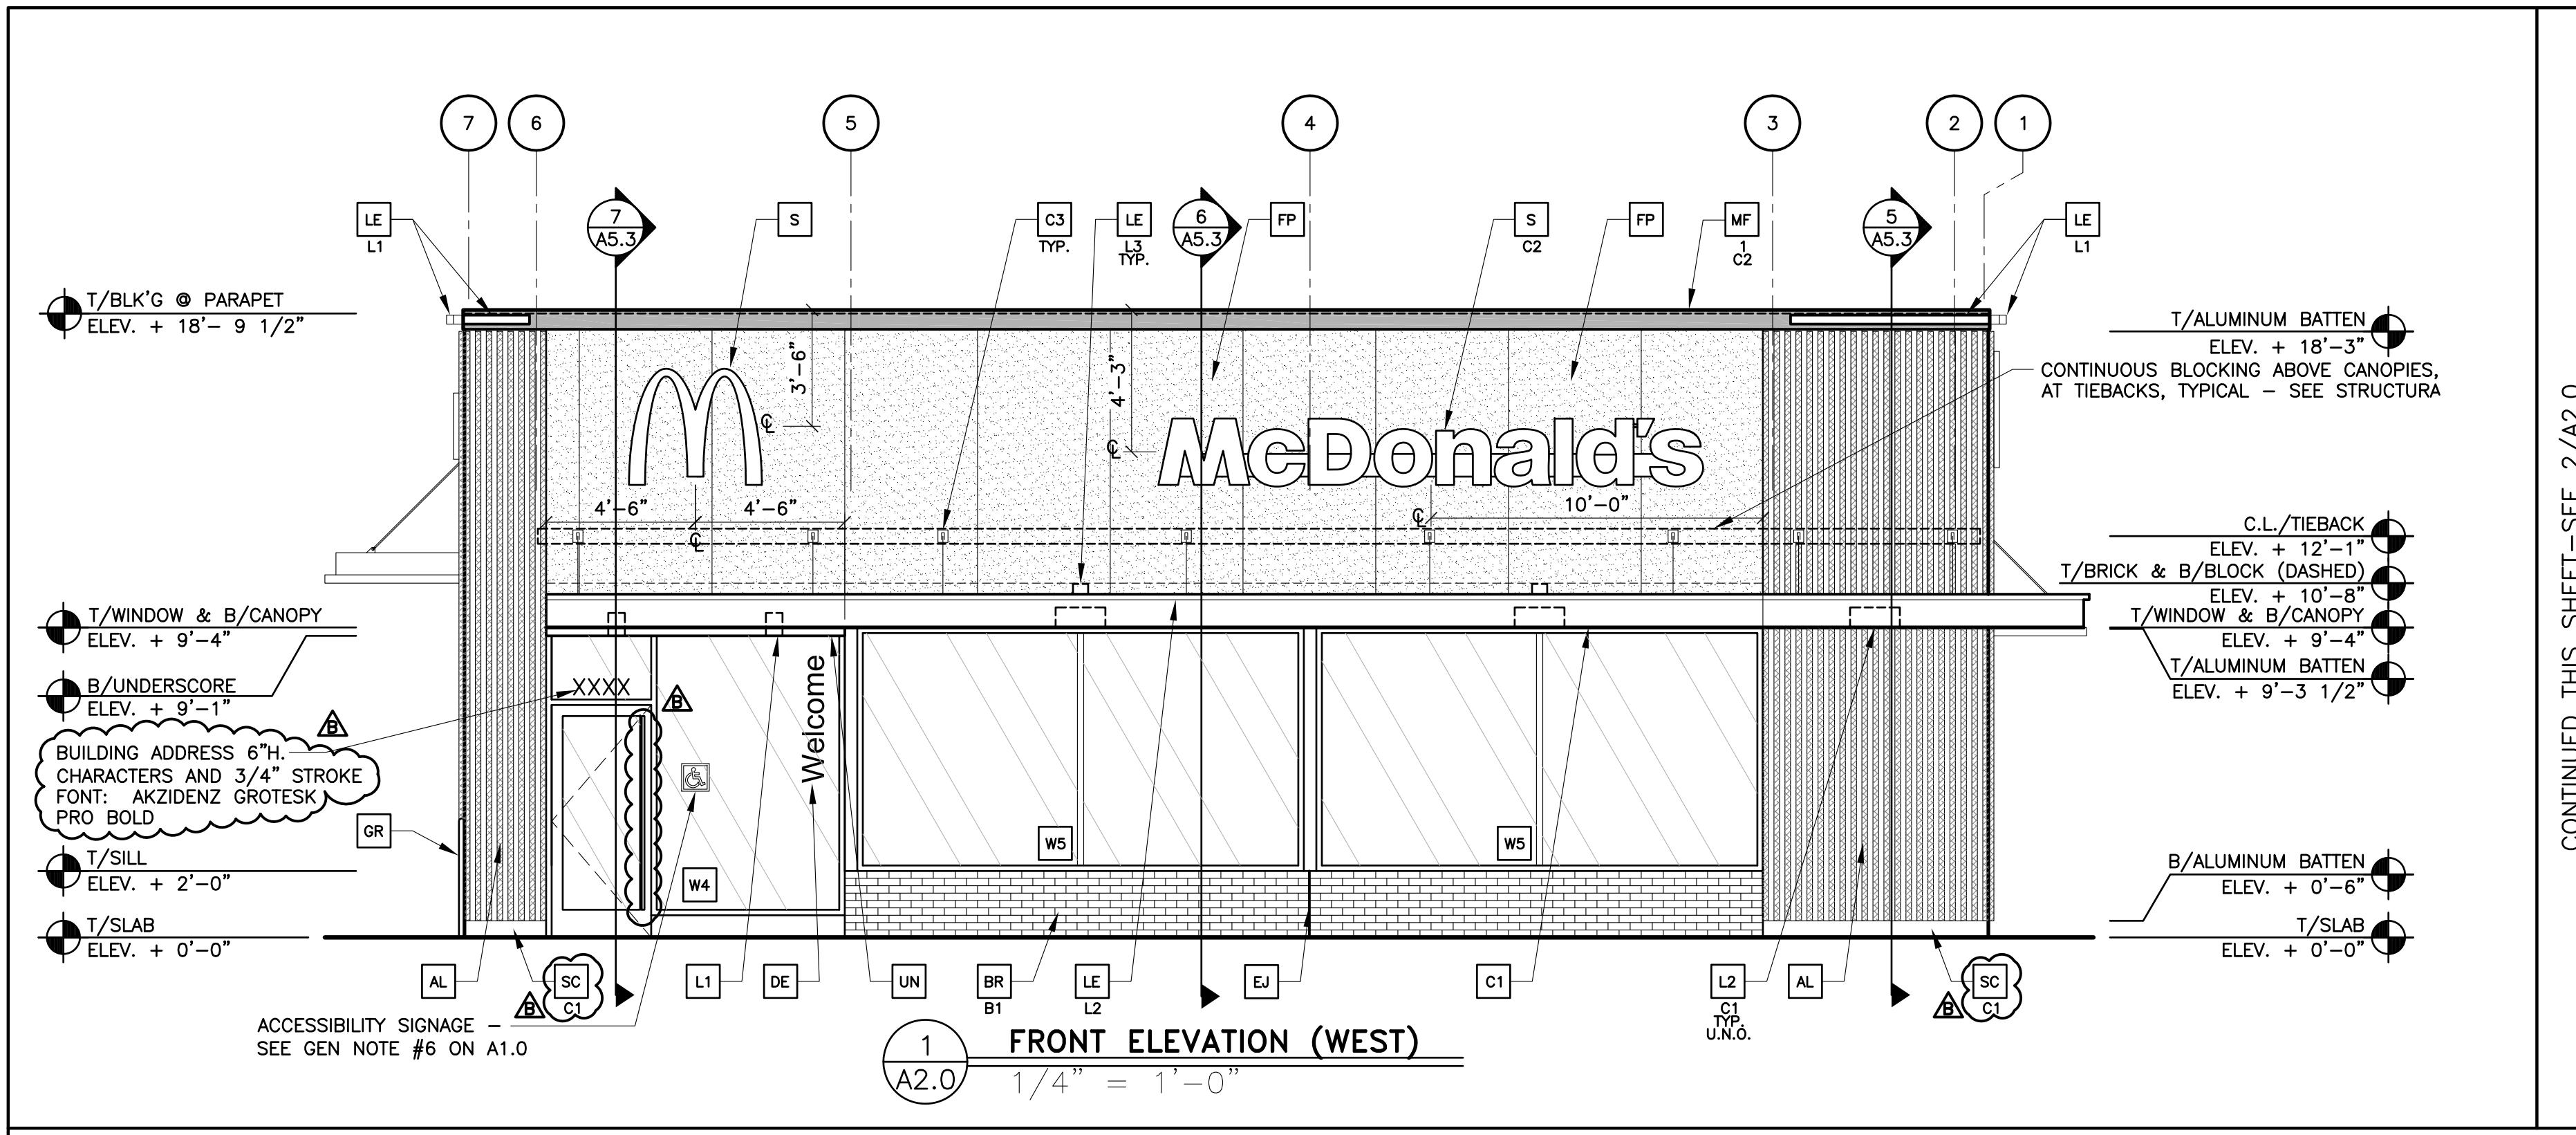

REVISION	DATE	DESCRIPTION
B	12/03/20	USED S&O SET REVIEW
A	05/05/20	CIVIL & PLAN REVIEW COMMENTS
DIA	01/23/20	PERMIT SET
DIA	01/13/20	USED PROGRESS SET REVIEW

Enterprise
Architecture, Inc.


Registration Number
Date

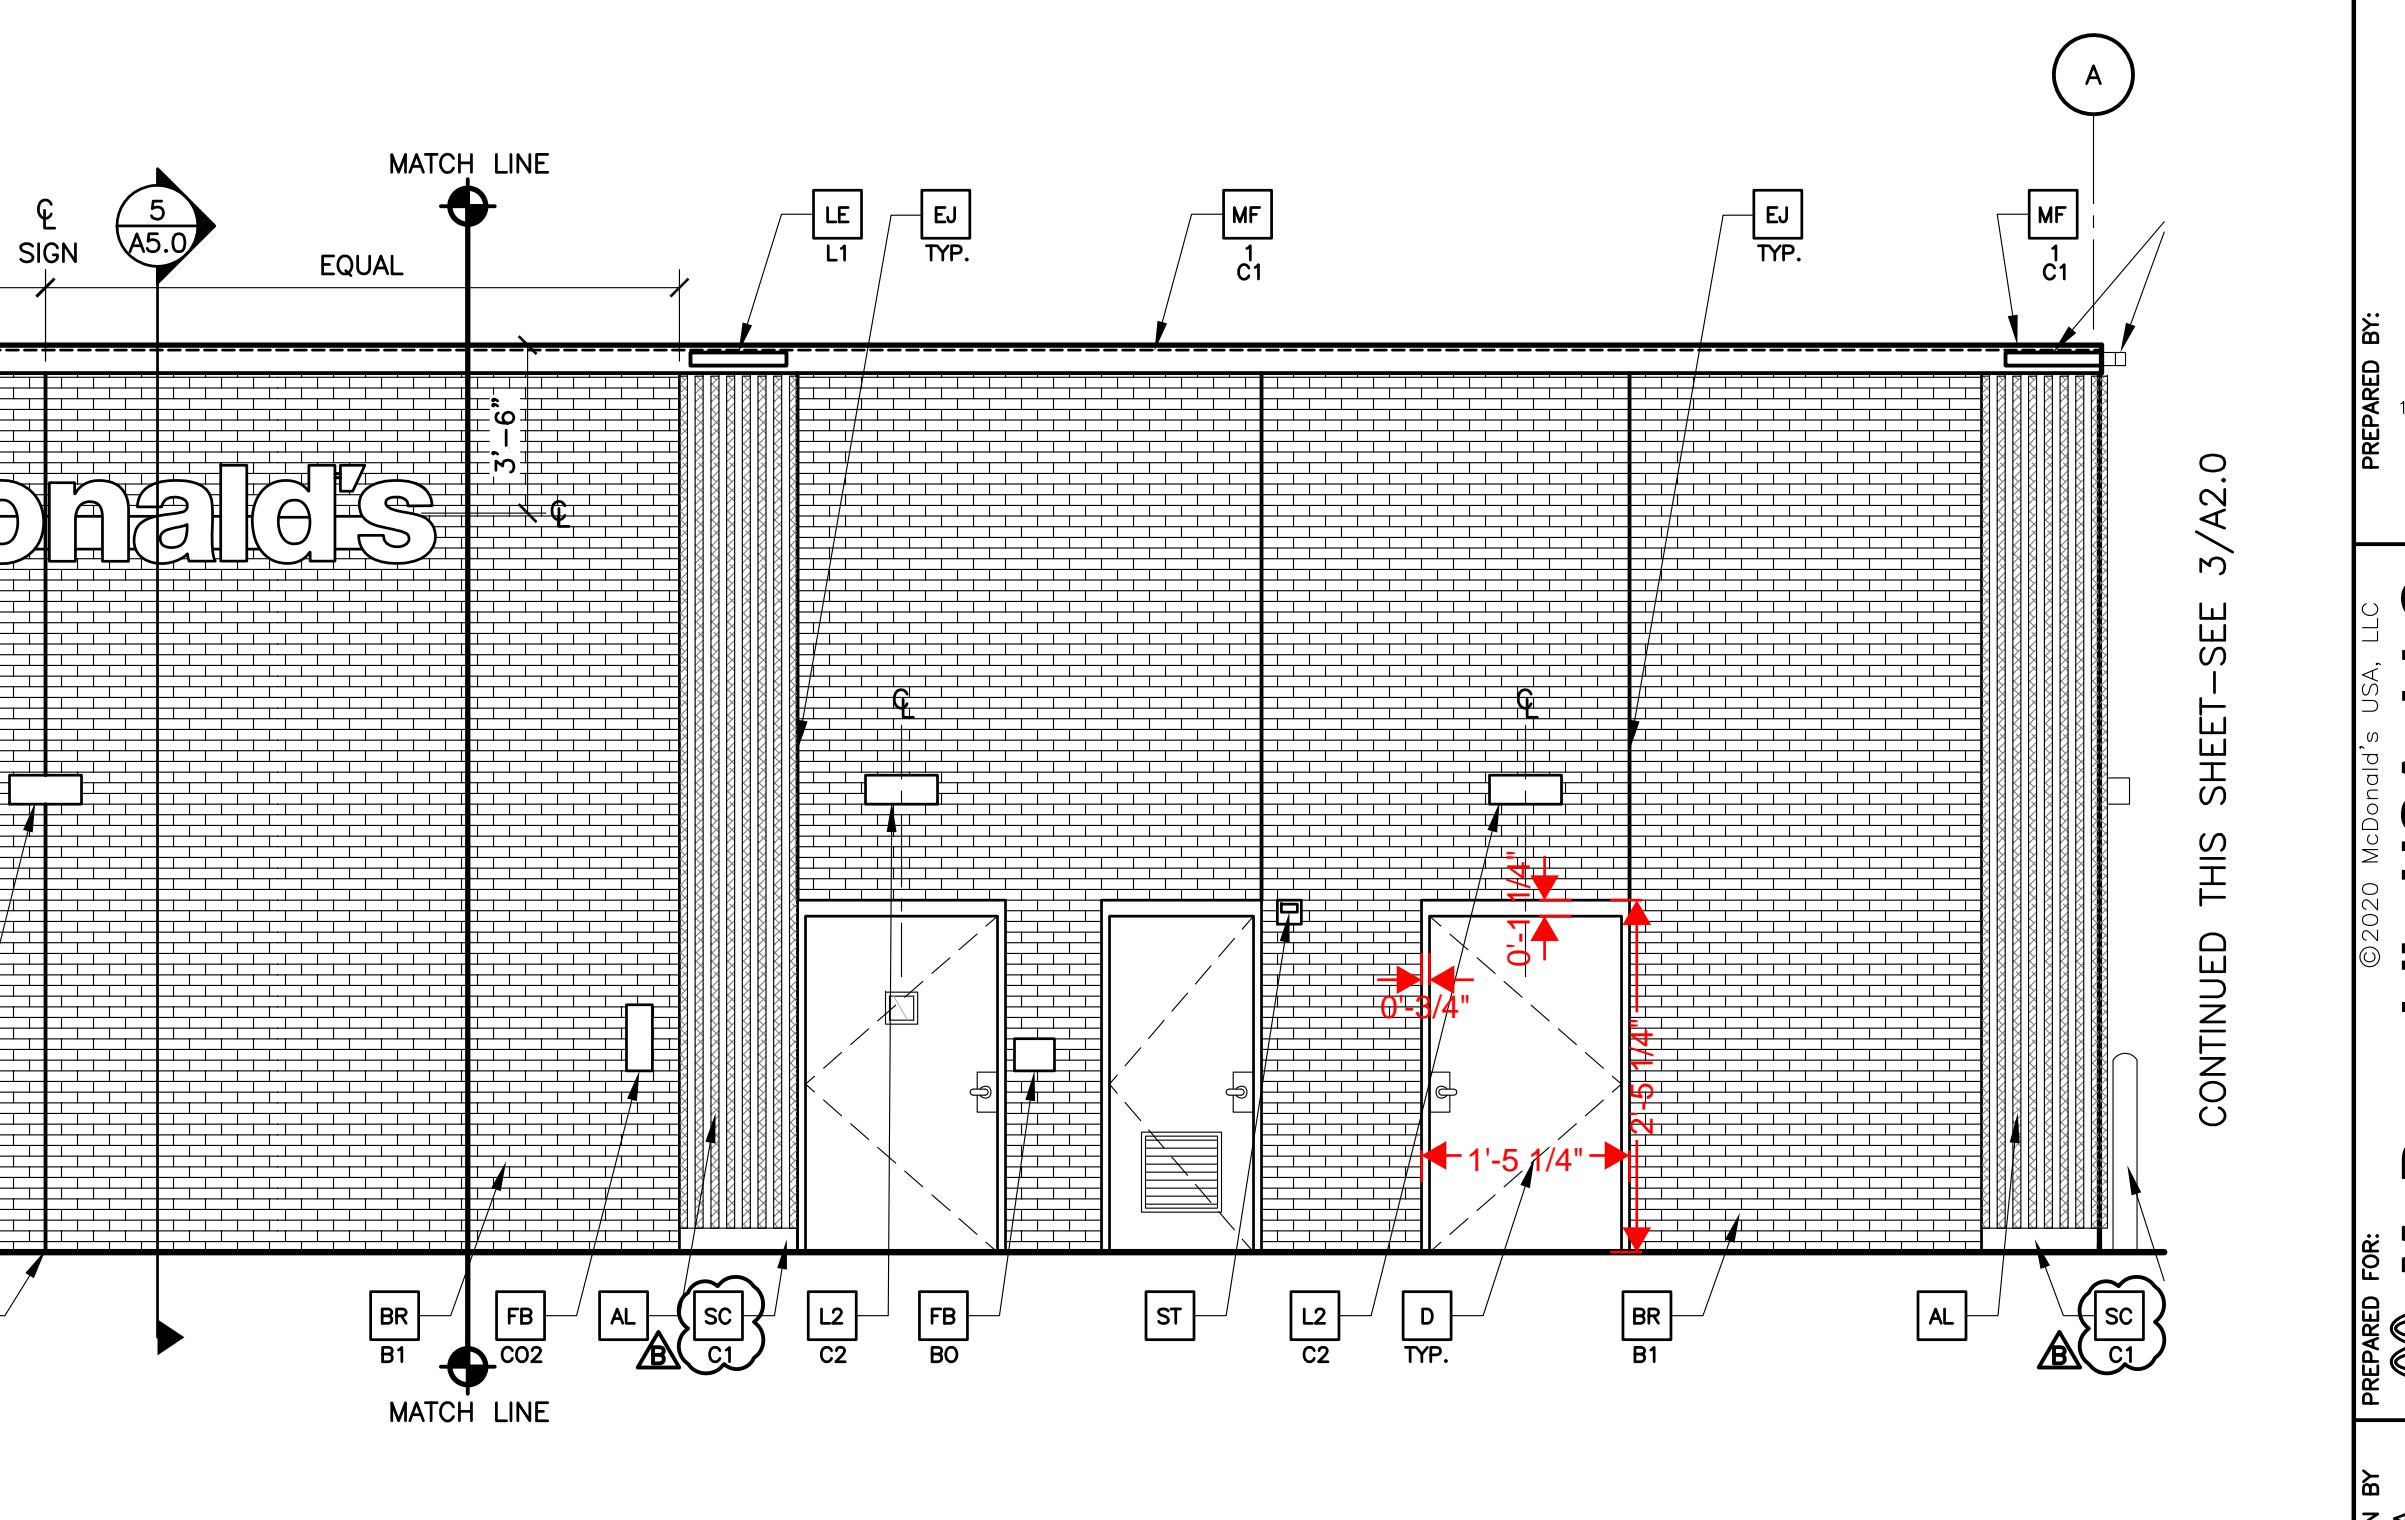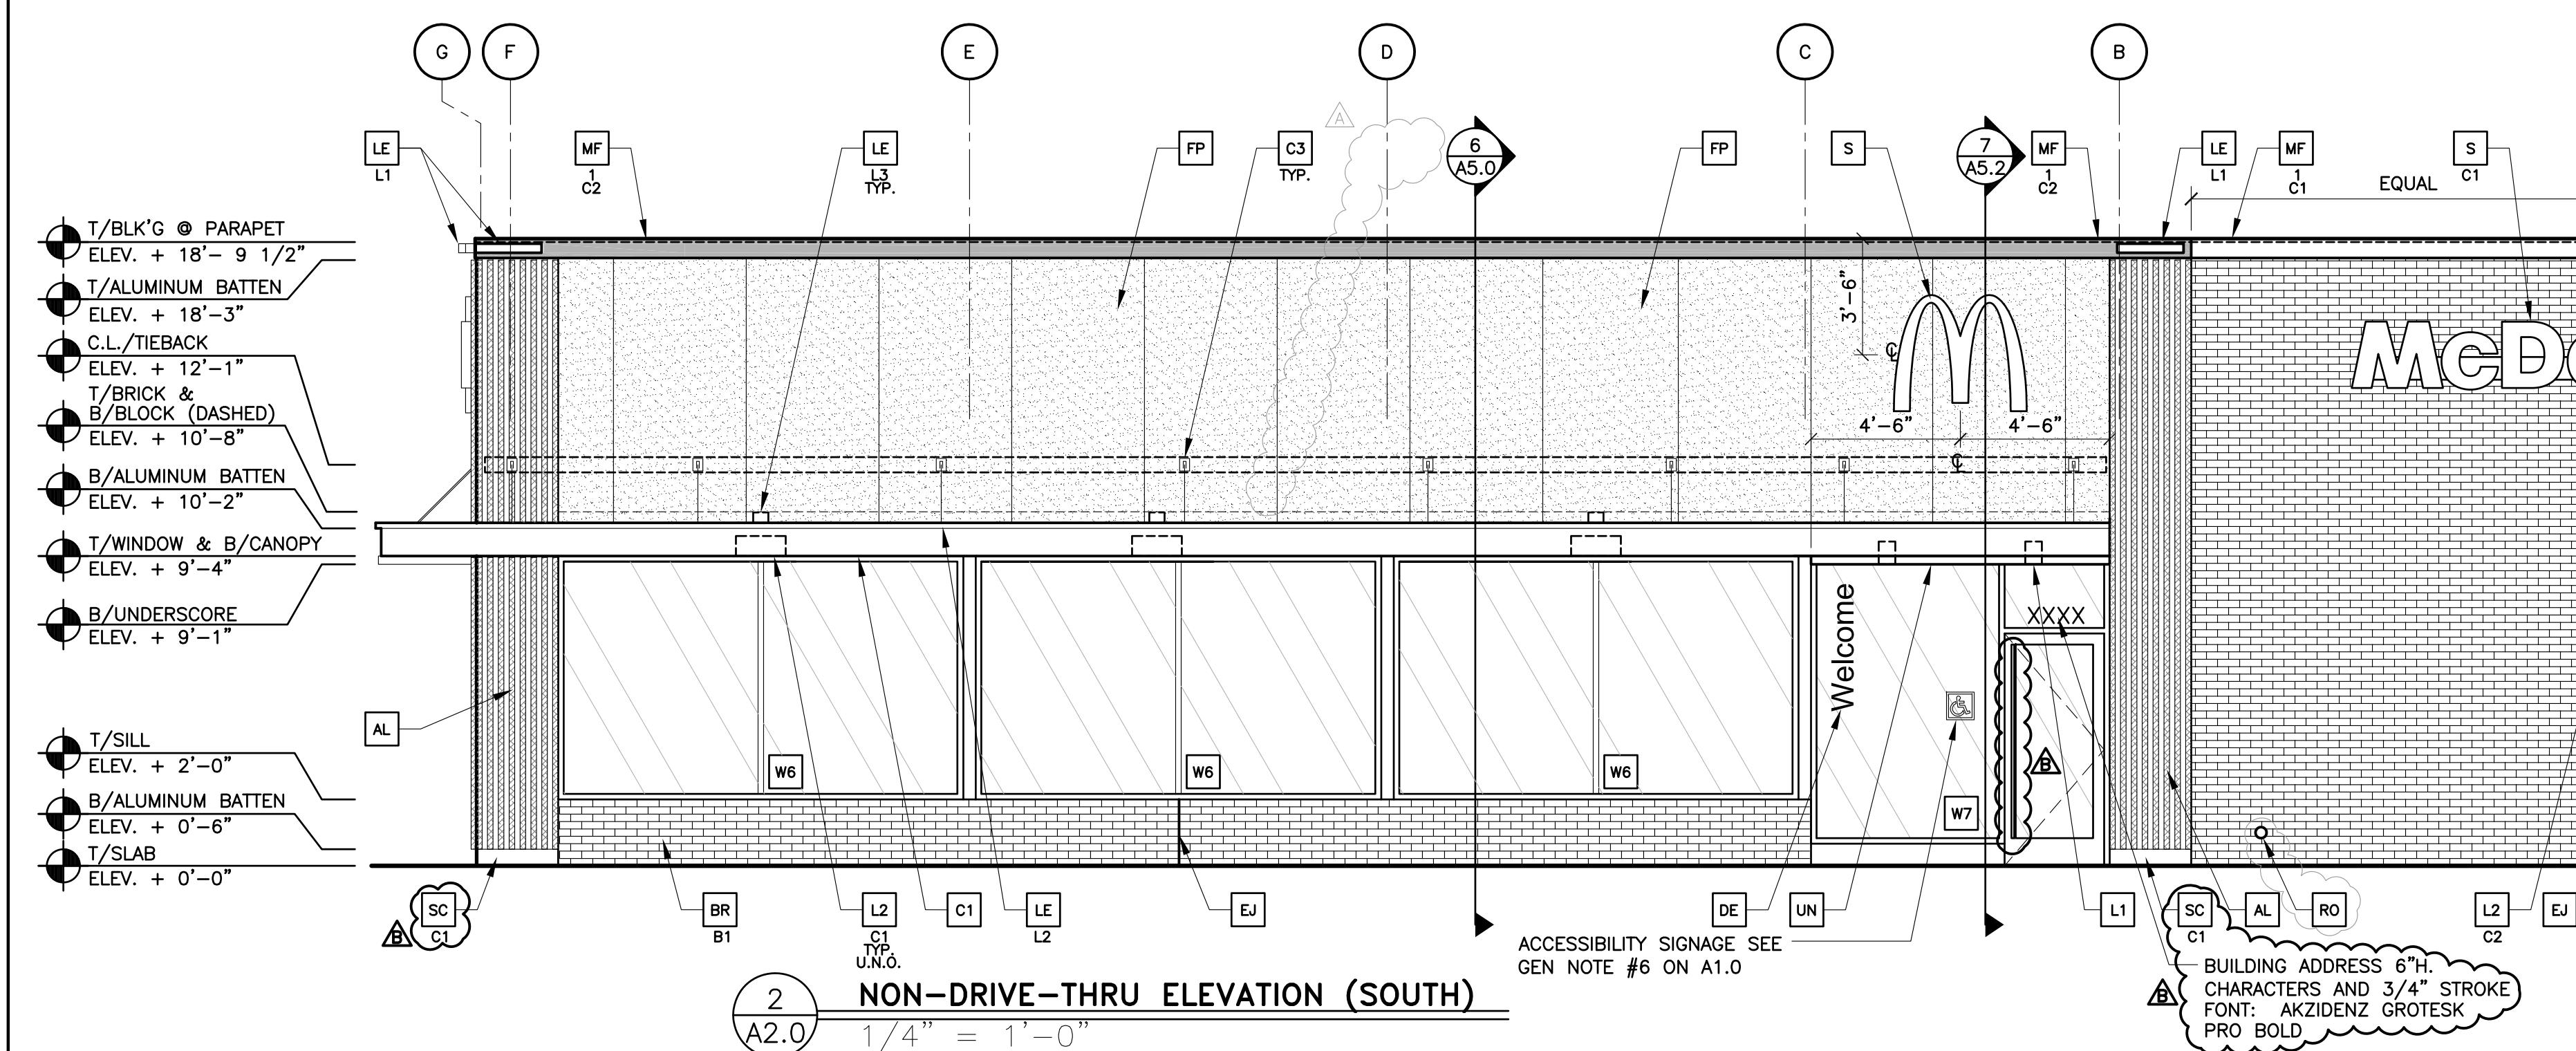

PREPARED BY:	DESIGN
McDonald's USA, LLC	12400 ARCHITECTURE & PLANNING 12400 PORTLAND AVENUE SOUTH, SUITE 100 BURNSVILLE, MN 55337 EMAIL: DATA@REPRISEDESIGN.COM PHONE: (952) 252-4042 FAX: (952) 252-4943

©2020 McDonald's USA, LLC

These drawings and specifications are the confidential and proprietary of McDonald's USA, LLC and shall not be reproduced or distributed outside the contract documents without the express written consent of McDonald's USA, LLC. These drawings and specifications are intended for use on this specific project only. They are not to be used for any other purpose or for any other time. Use of these drawings for reference or example on another project requires the services of an authorized contractor. Use of these drawings on another project is not authorized.

 


DRAWN BY	DIA	STD ISSUE DATE	REVIEWED BY	MATERIALS
		2019-11	KO	1 = PRE-FAB ANCHOR-TIE FASCIA 2 = NOT USED 3 = NOT USED
				COLOR: C1= WEATHERED ZINC C2= RAL 7022
				ROOF DRAIN OVERFLOW PIPE PAINT TO MATCH SURROUNDING MATERIAL
				S McDONALD'S SIGNAGE BY OTHERS - UNDER SEPARATE PERMIT. C1= WEATHERED ZINC RACEWAY C2= RAL 7022 RACEWAY
				SC STUCCO (@ BASE OF BATEN SYSTEM) C1= PAINT "IRON ORE" SW7069 BY SHERWIN WILLIAMS
				ST C2 STROBE/ALARM. SEE MECHANICAL DRAWINGS FOR SPECIFICATION.
				UN METAL underscore COLOR: GOLD
				W1 EXTERIOR WINDOW ASSEMBLY - TEMPERED GLASS COLOR: DARK BRONZE - SEE ASSEMBLY NOTES ON 4/A2.0 & FRAME TYPES ON SHEET A.6.0
				W2 DRIVE-THRU WINDOW BY READY ACCESS MODEL: 600 SERIES, 36" SERVICE HEIGHT WITH XX TRANSOM, MANUAL OPEN; ELECTRONIC RELEASE COLOR: DEEP BRONZE
				W3 COIN COLLECTOR UNIT: APERTURE WPT, #DTA2013 CALL 1-877-766-7642 TO ORDER
				PT (RMHC) COIN COLLECTOR UNIT: APERTURE WPT, #DTA2013 CALL 1-877-766-7642 TO ORDER

015-0071.00.B

A2.0

ELEVATIONS

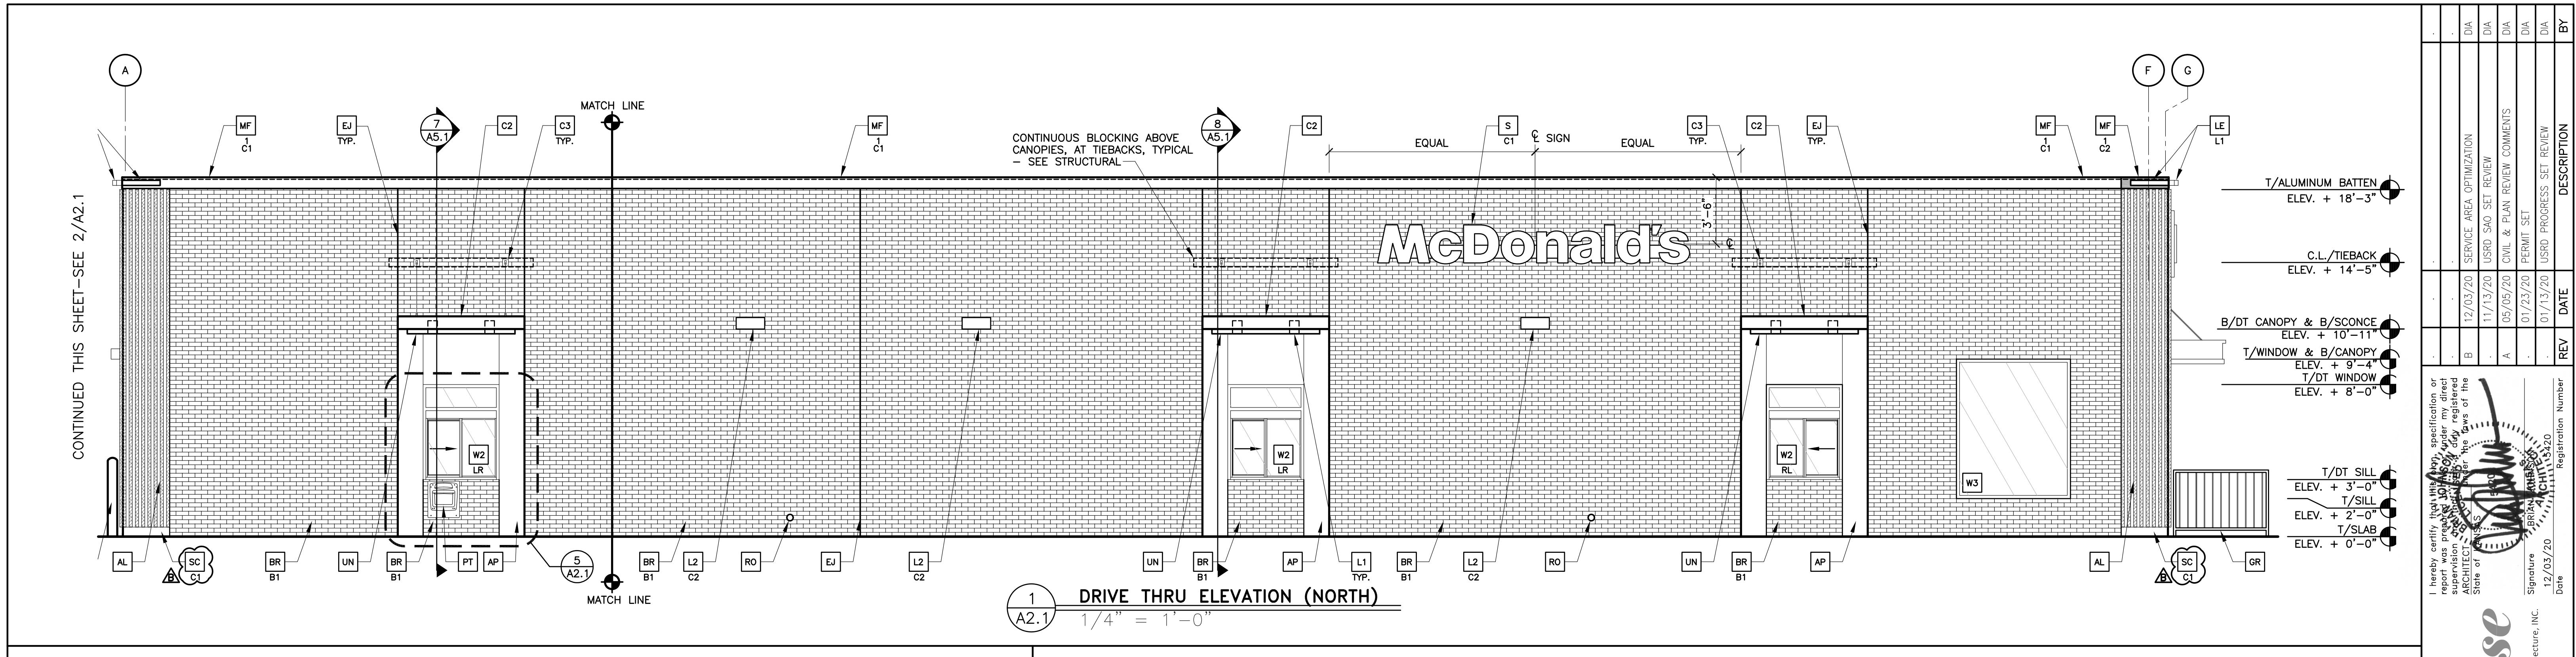

Architect, INC.

DESIGN

reprise

Signature

PRINTED BY:

12/03/20

Date

Registration Number

12/03/20

Date





Signature

PRINTED BY:

12/03/20


Date


Signature

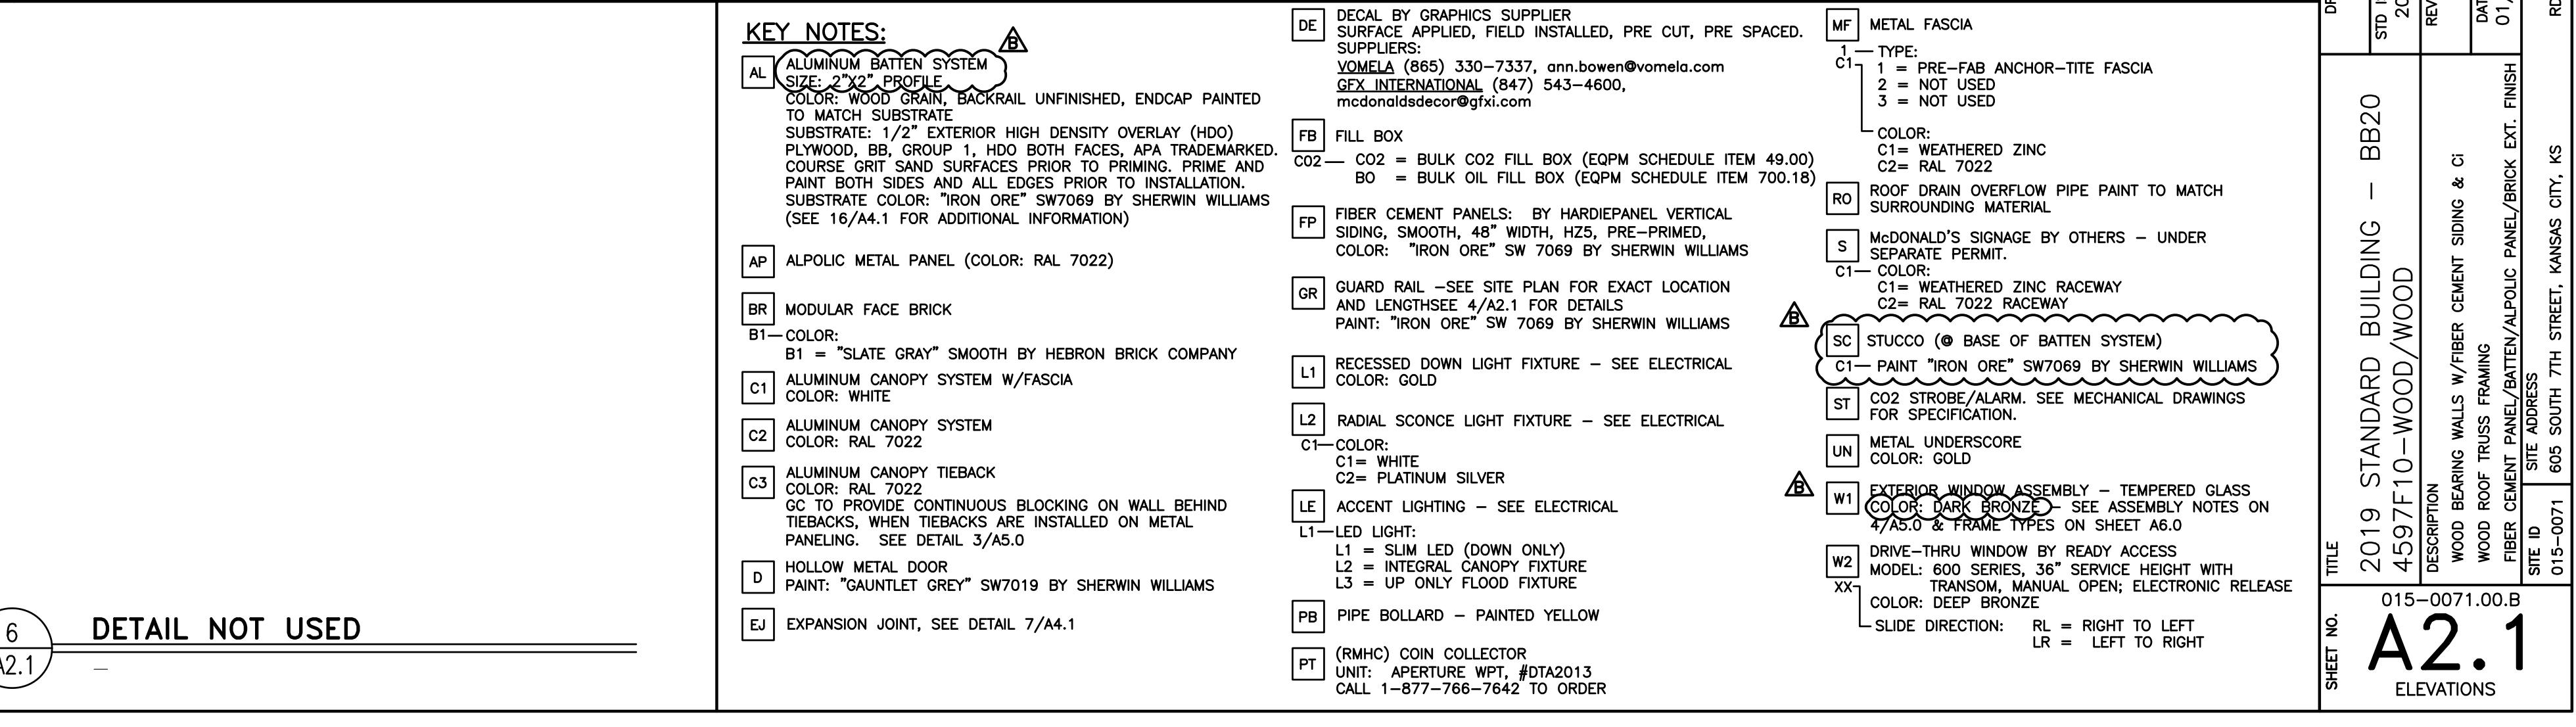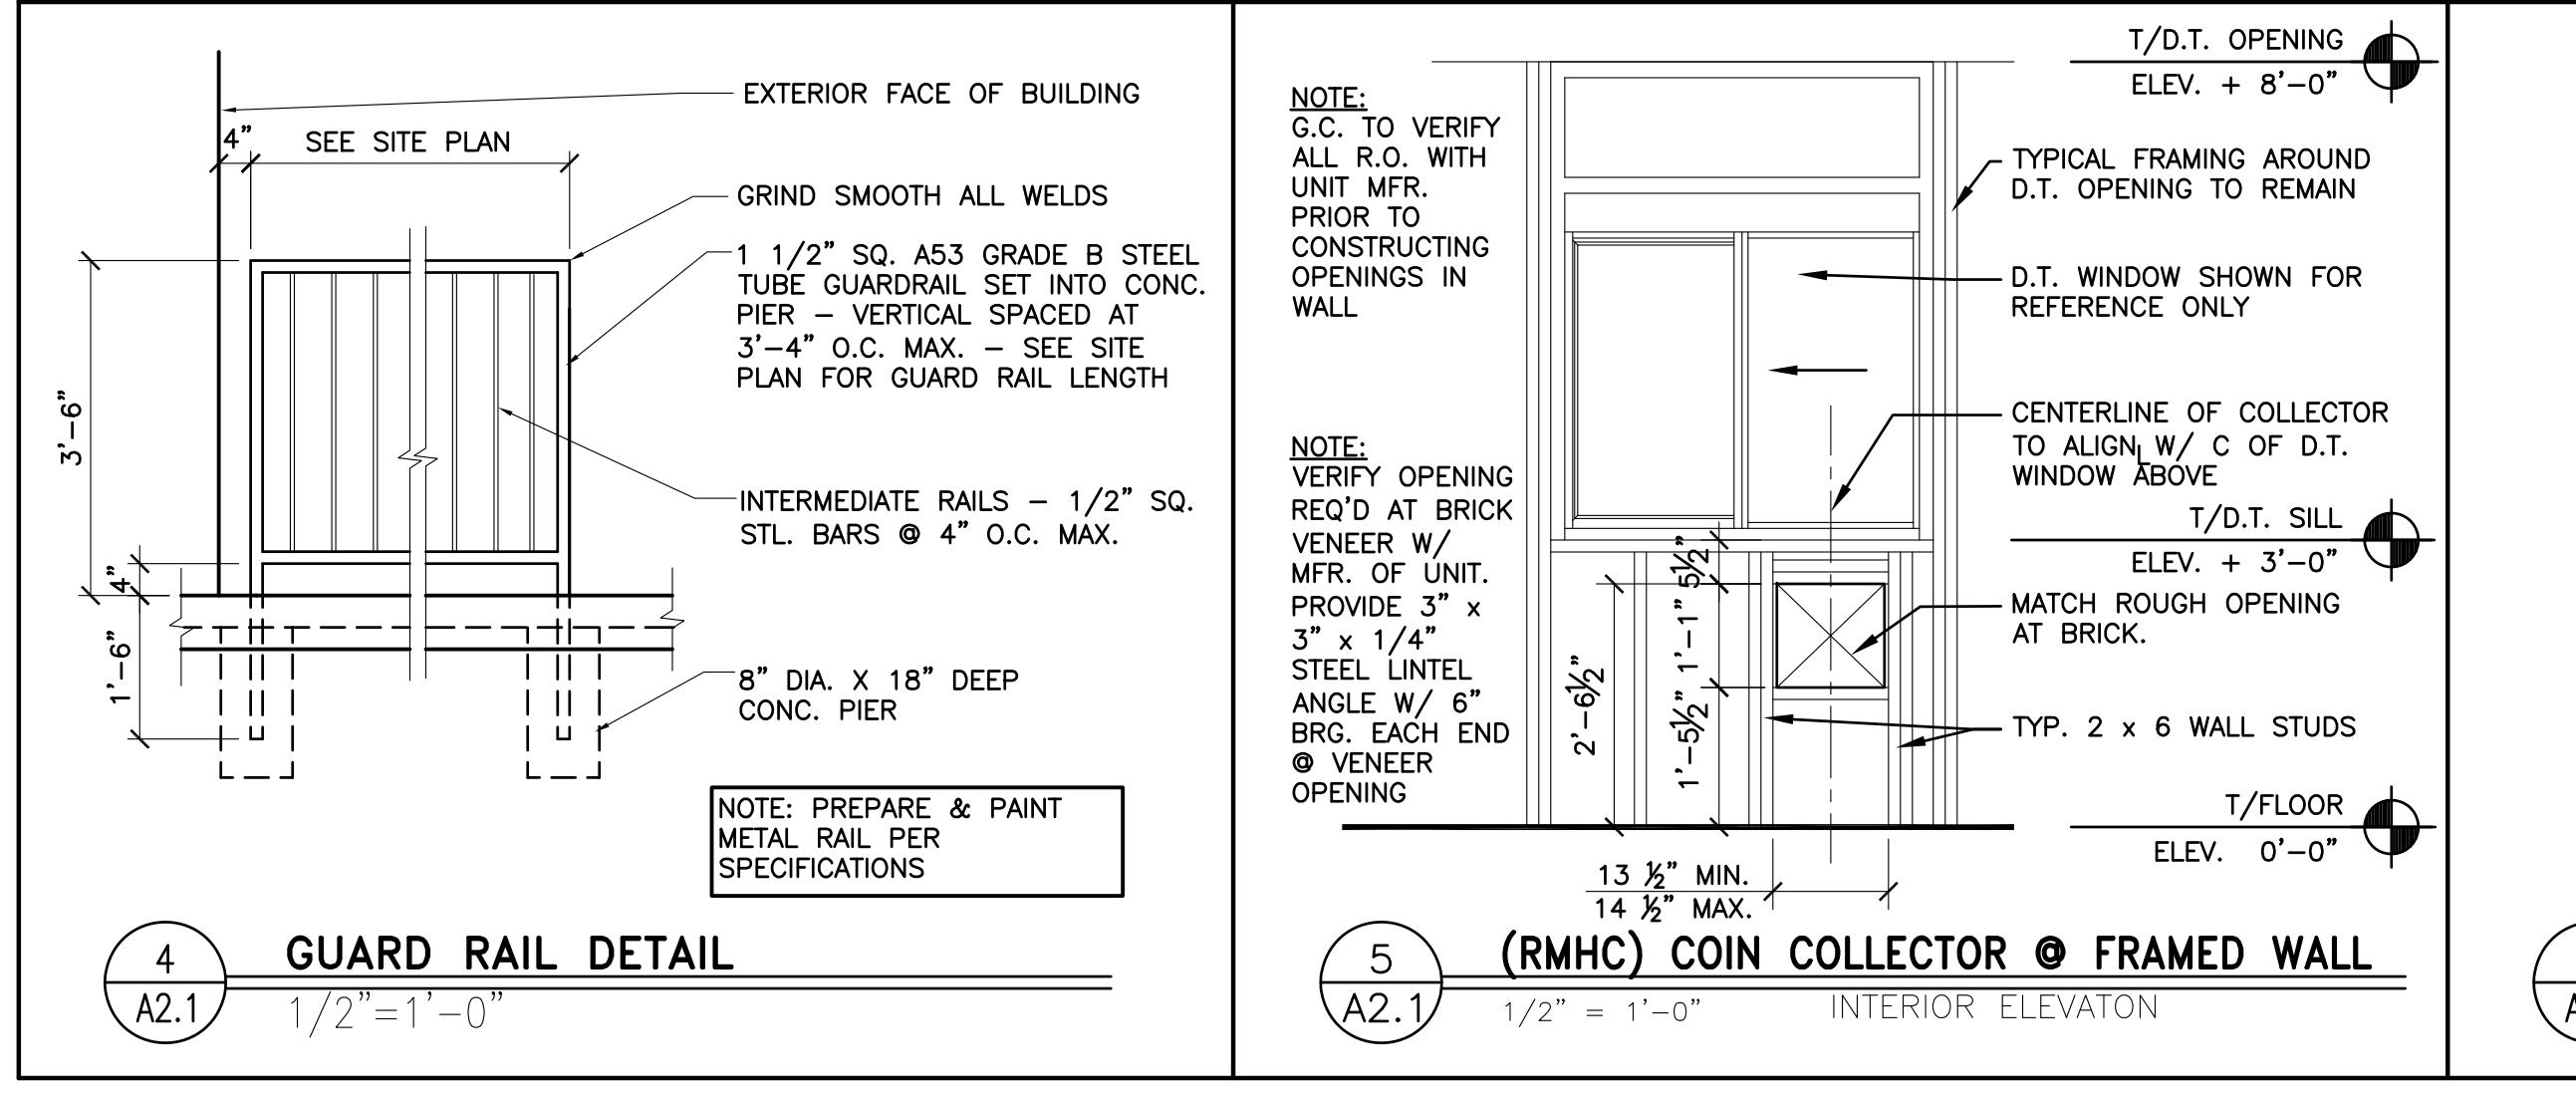
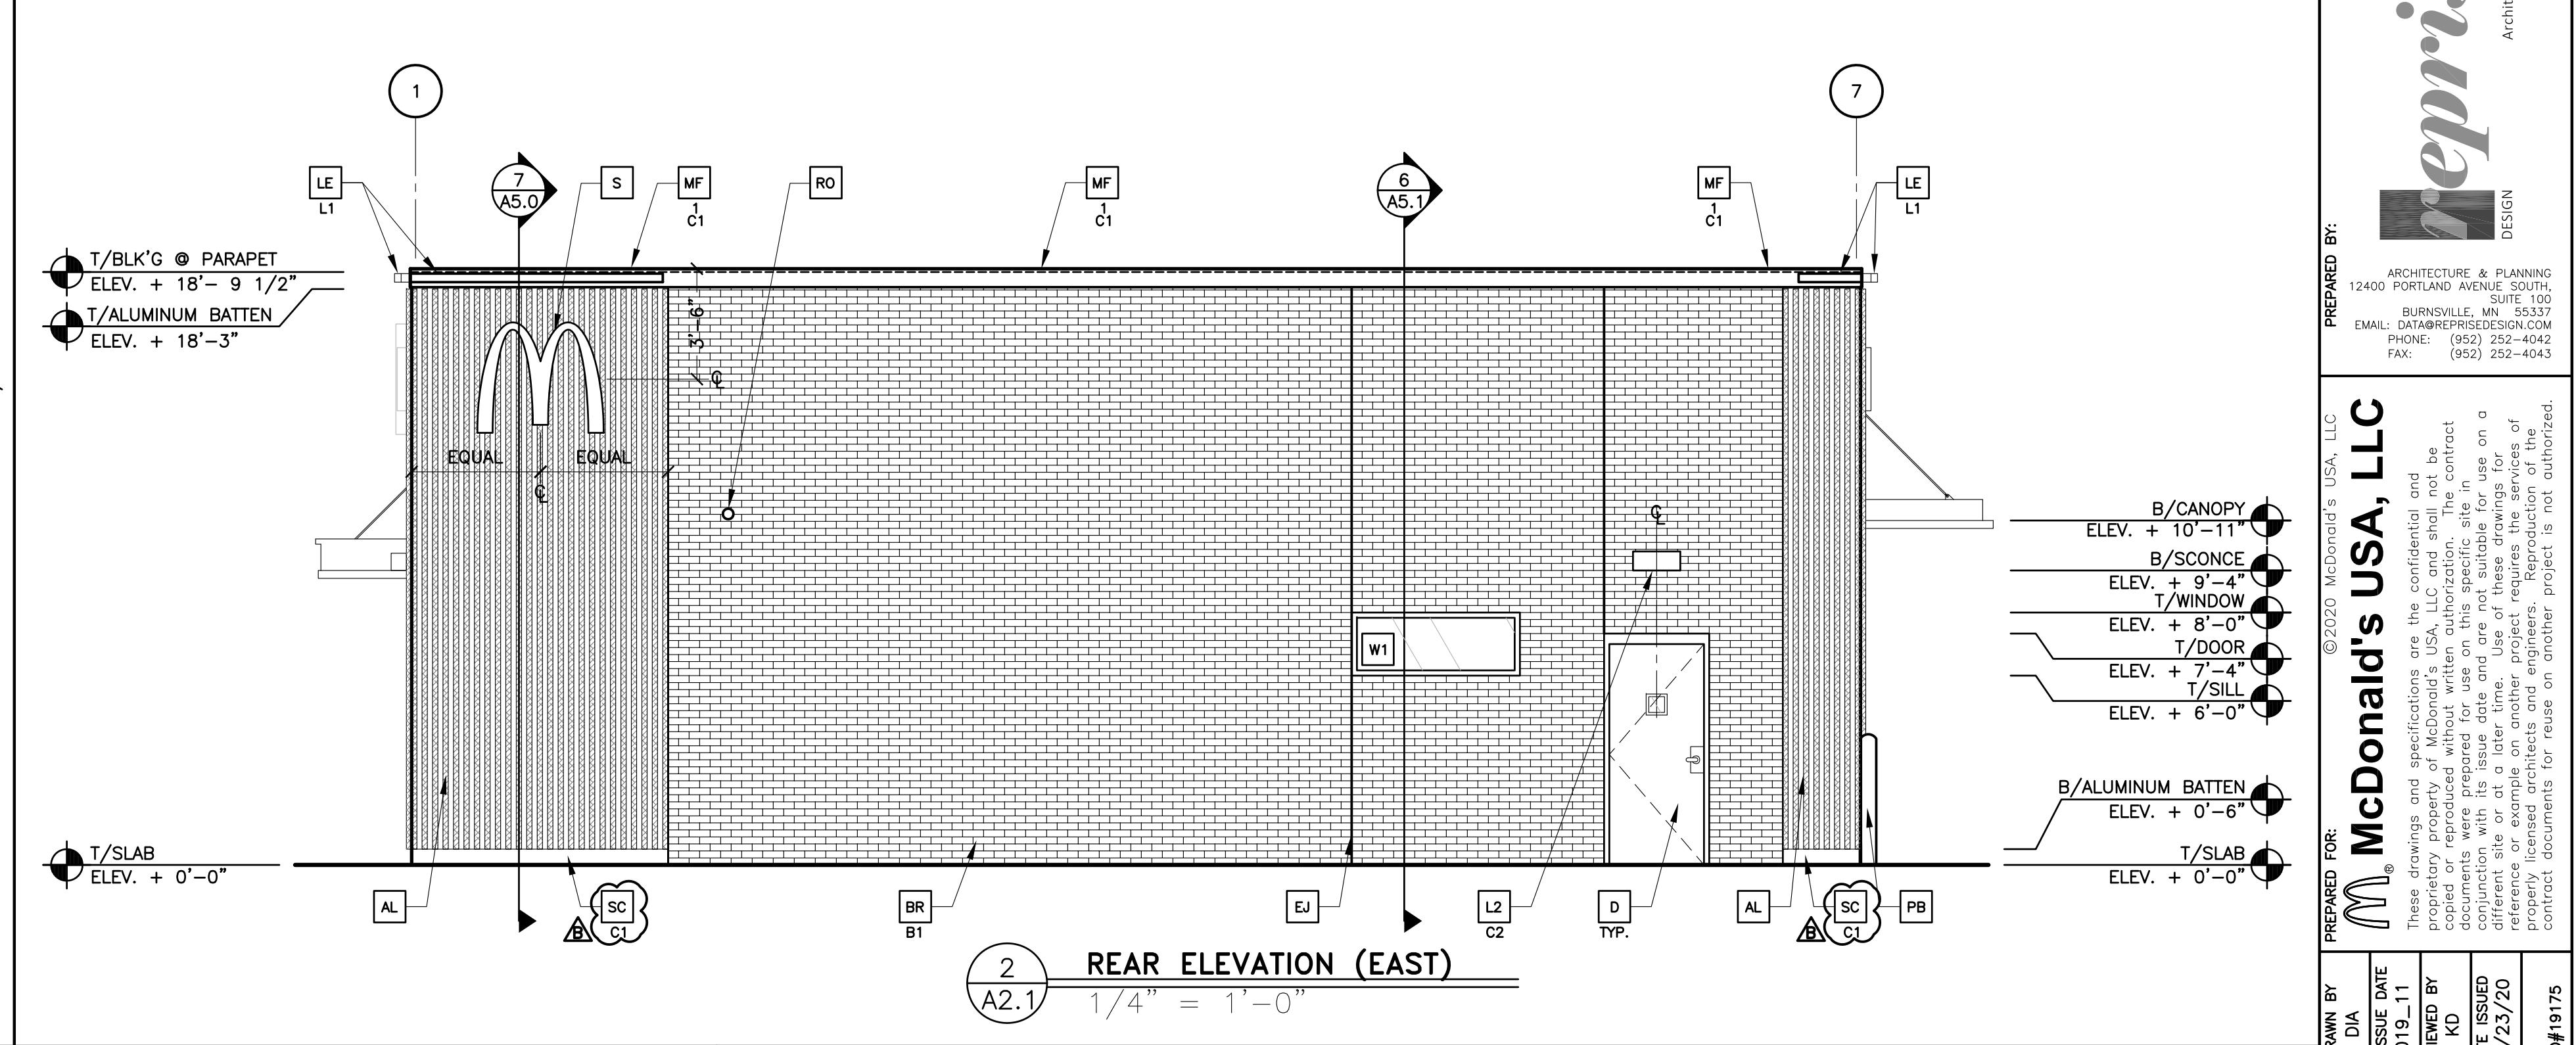
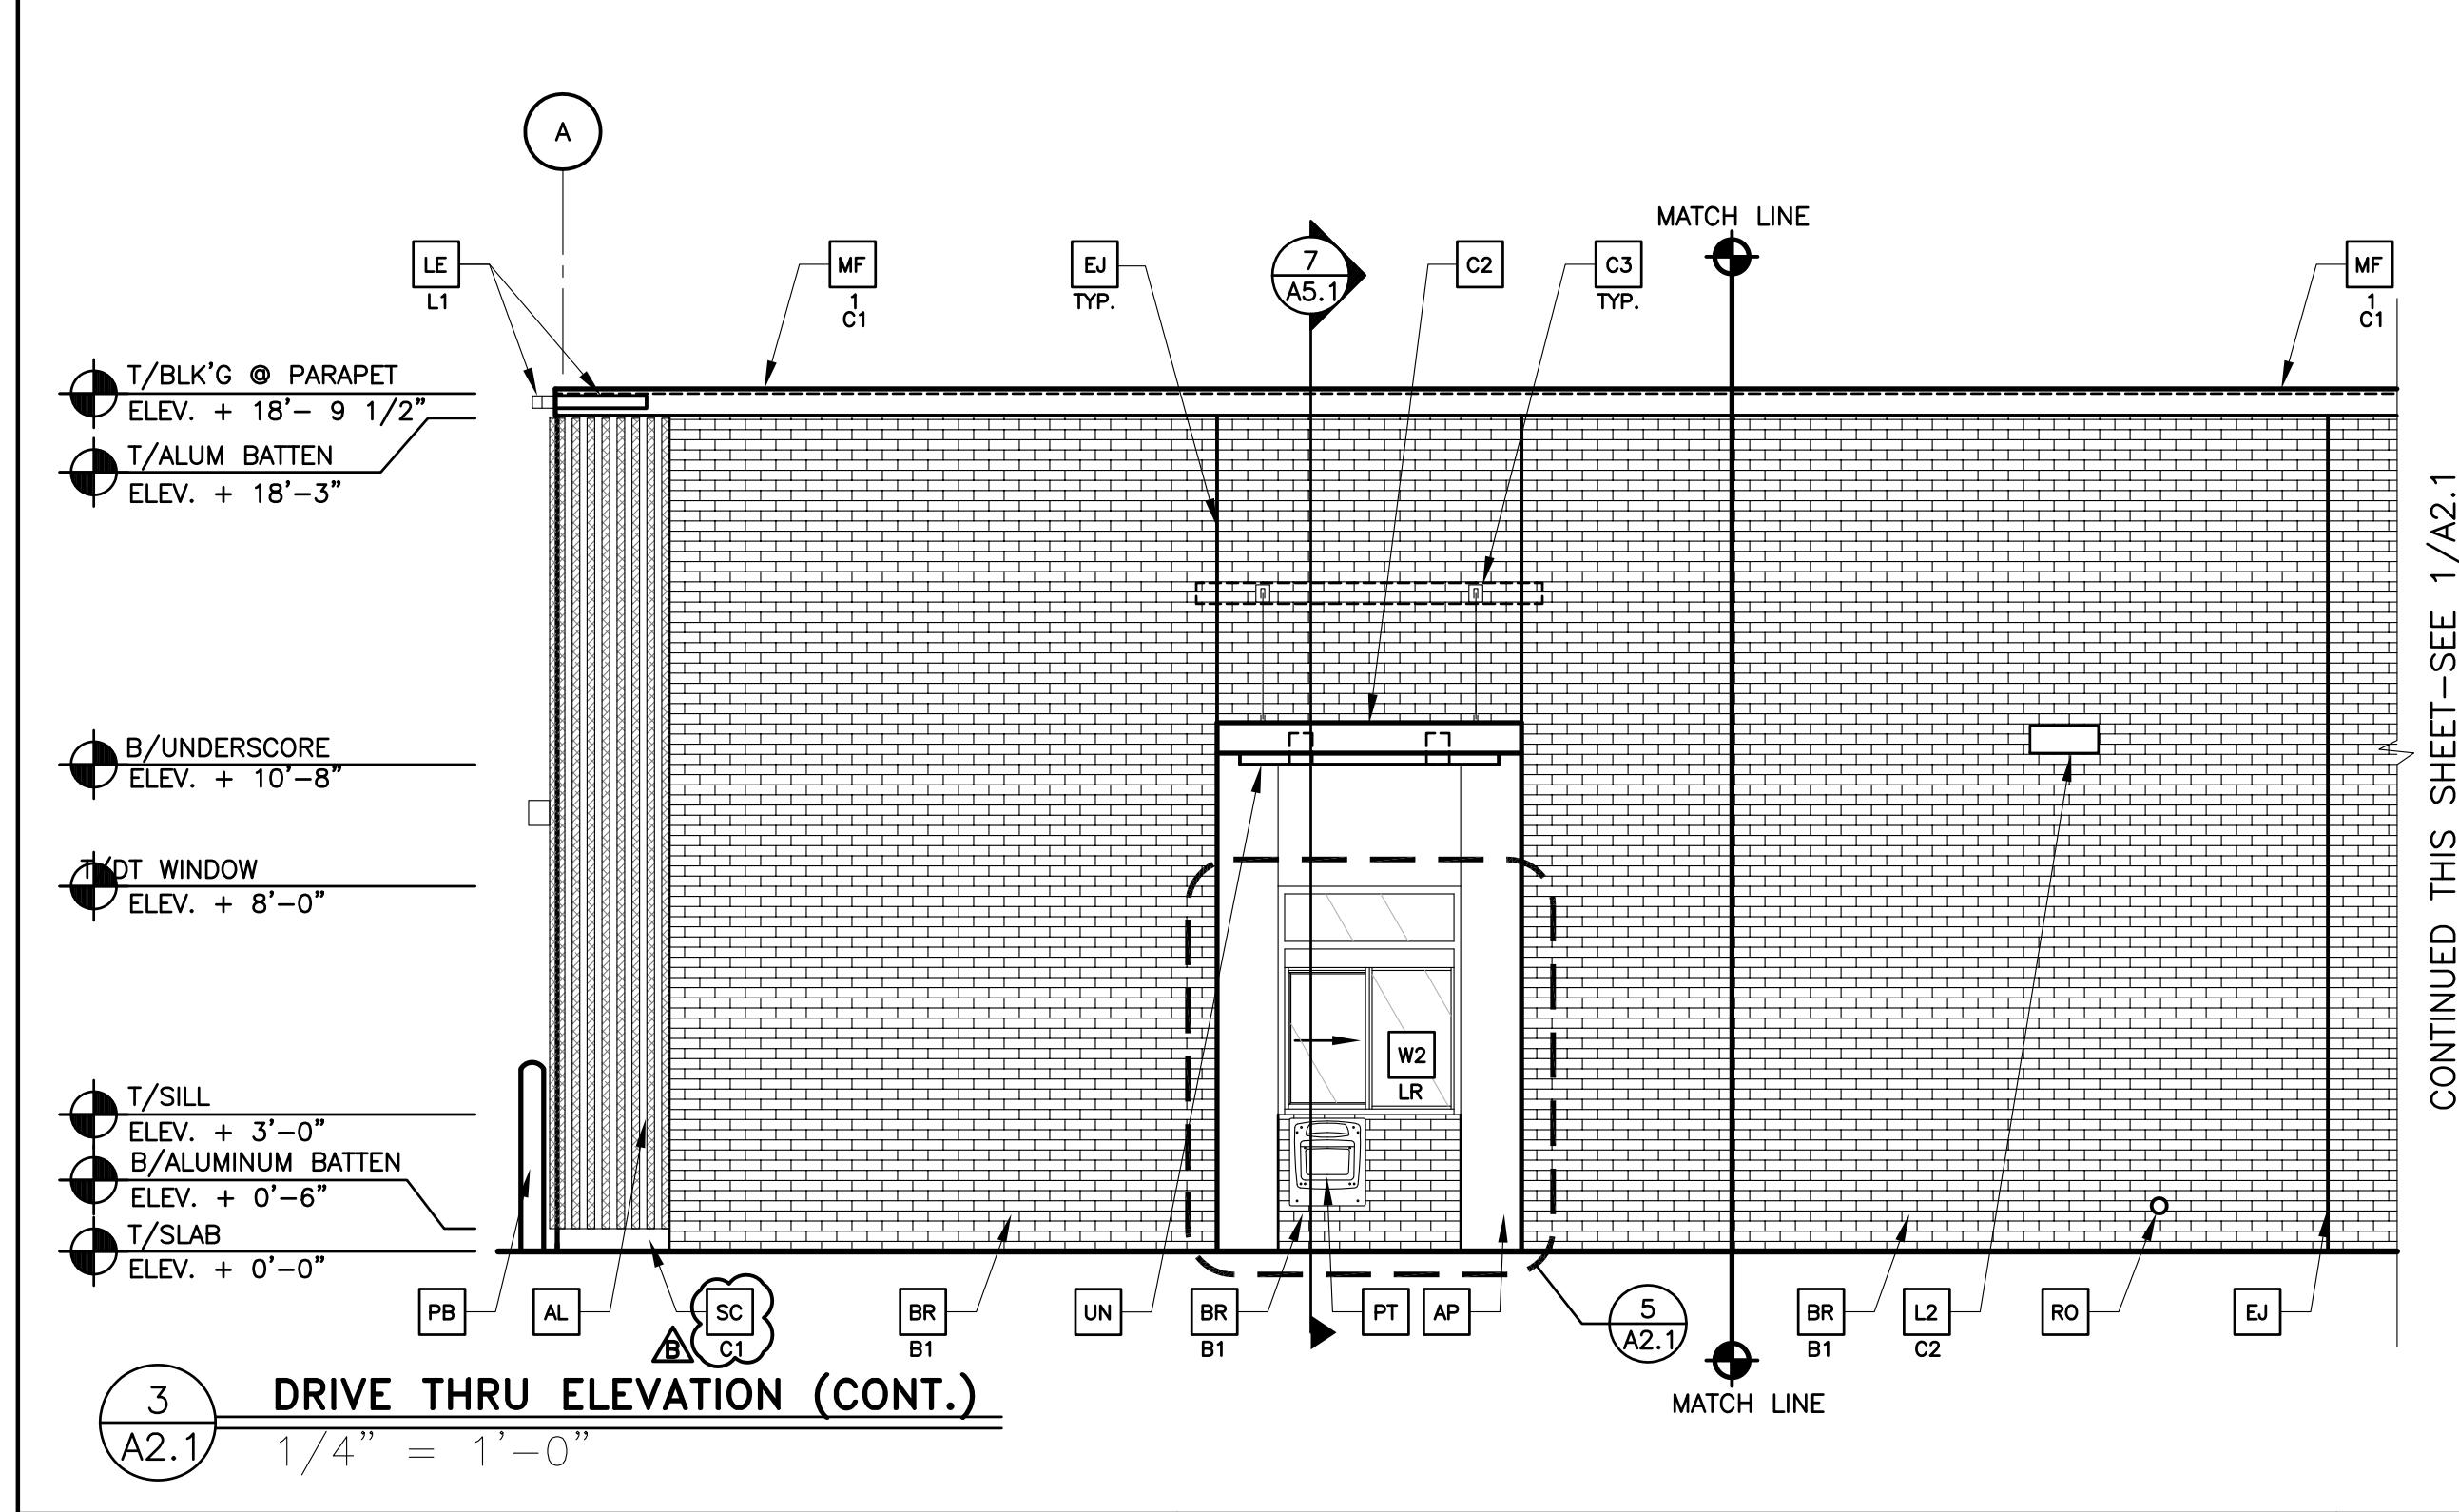


SHEET NO.	TITLE	DRAWN BY	DIA	STD ISSUE DATE	REVIEWED BY	DATE ISSUED	SITE ID	SITE ADDRESS
015-0071.00.B	2019 STANDARD BUILDING - BB20 4597F10-WOOD/WOOD	2019-11	KO	12/03/2019		01/23/2020	015-0071	605 SOUTH 7TH STREET, KANSAS CITY, KS

A2.1
ELEVATIONS

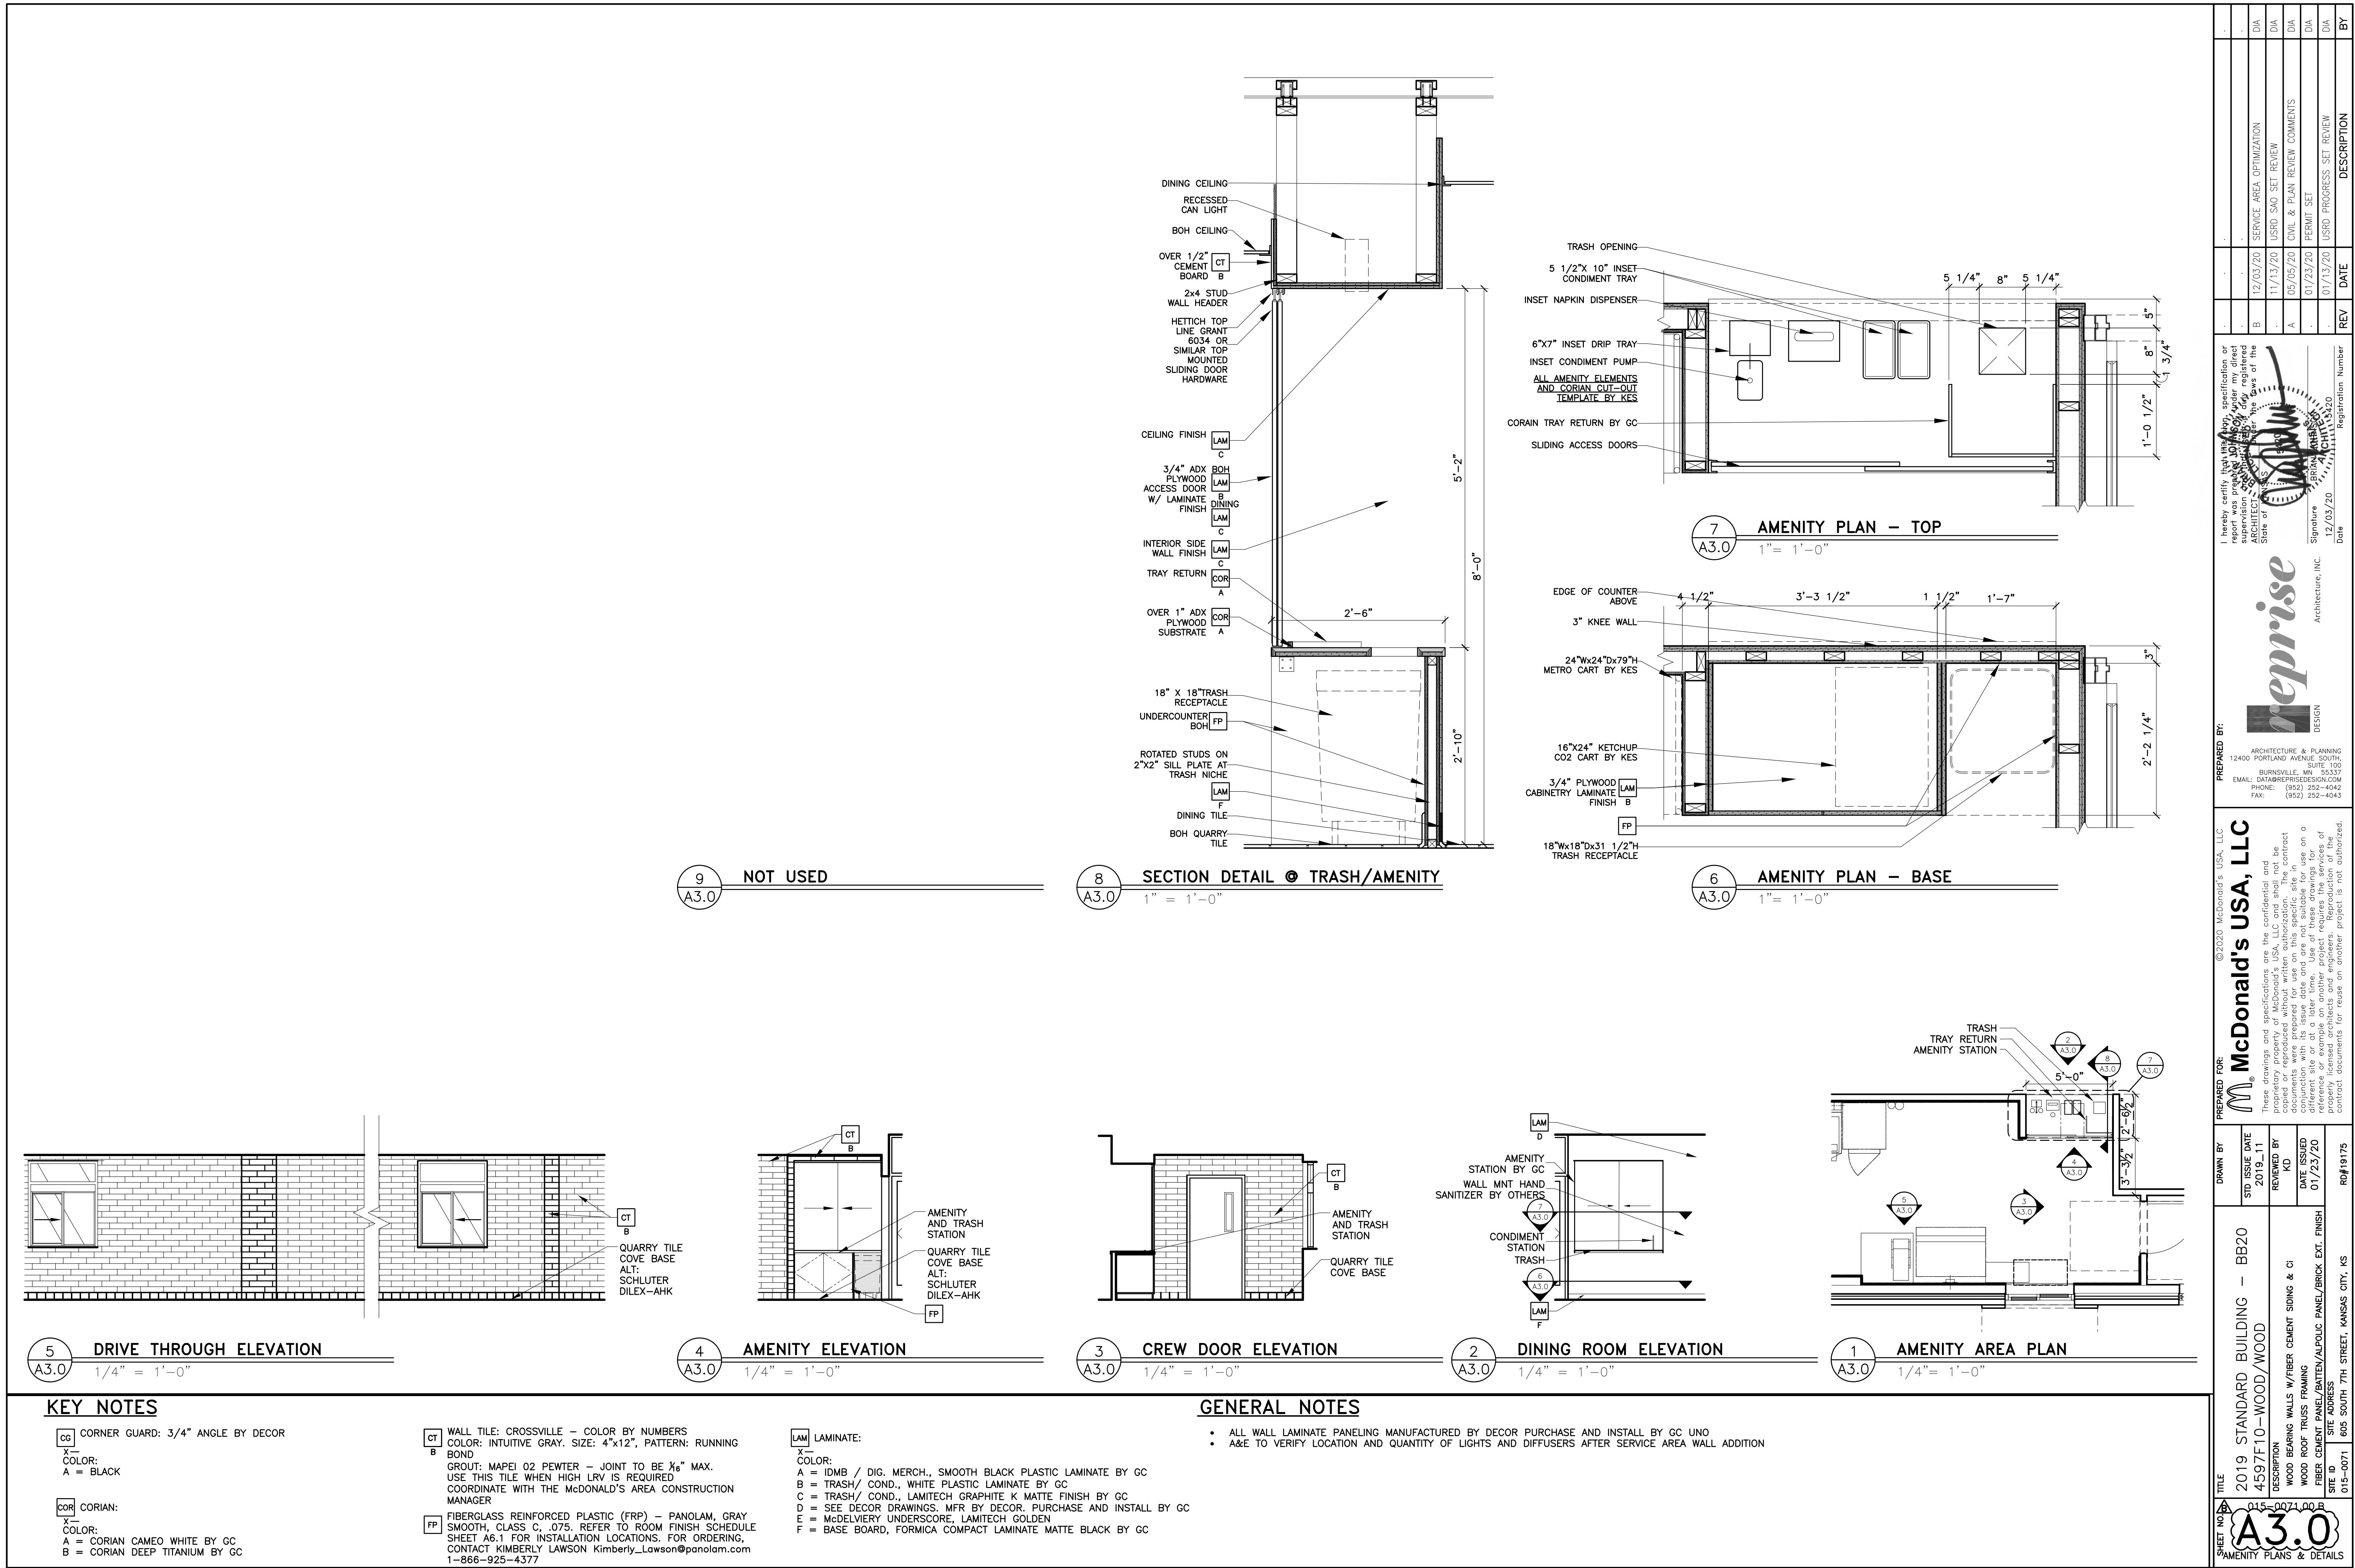

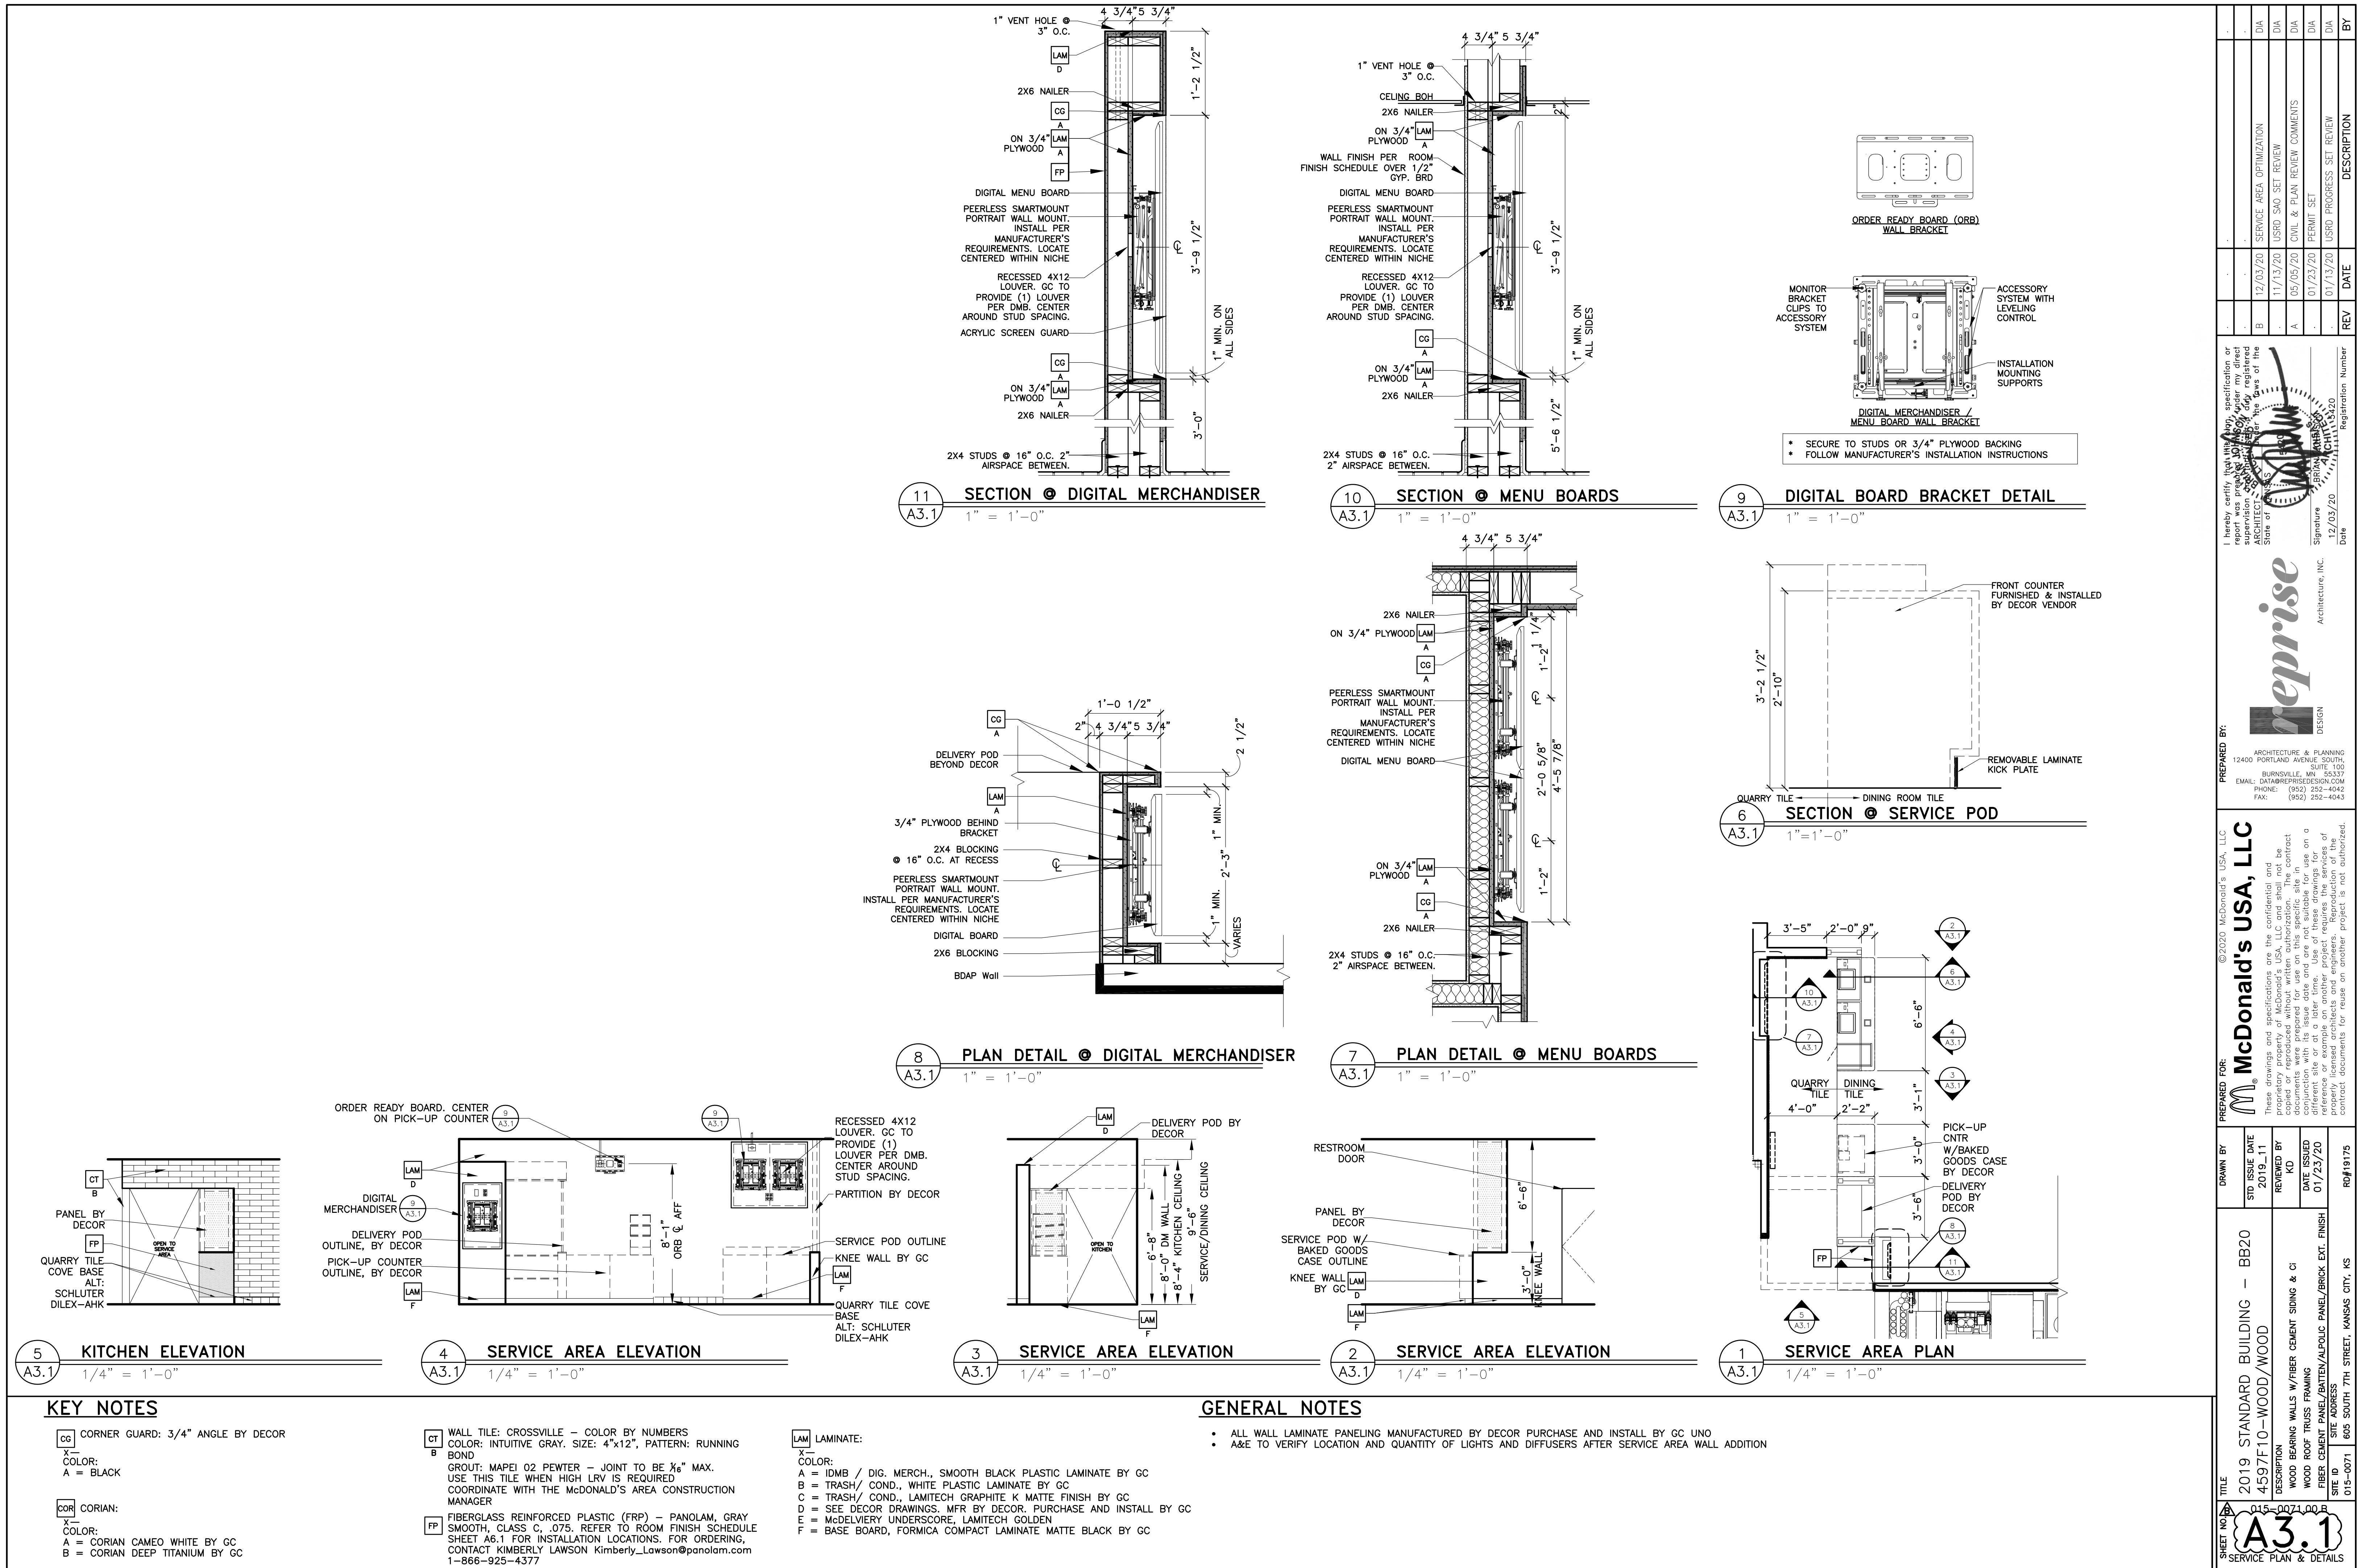

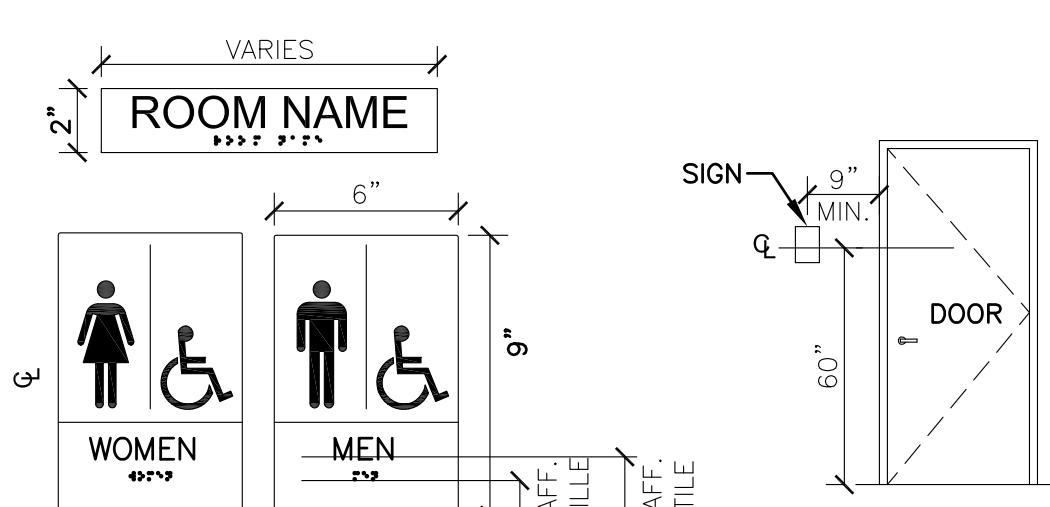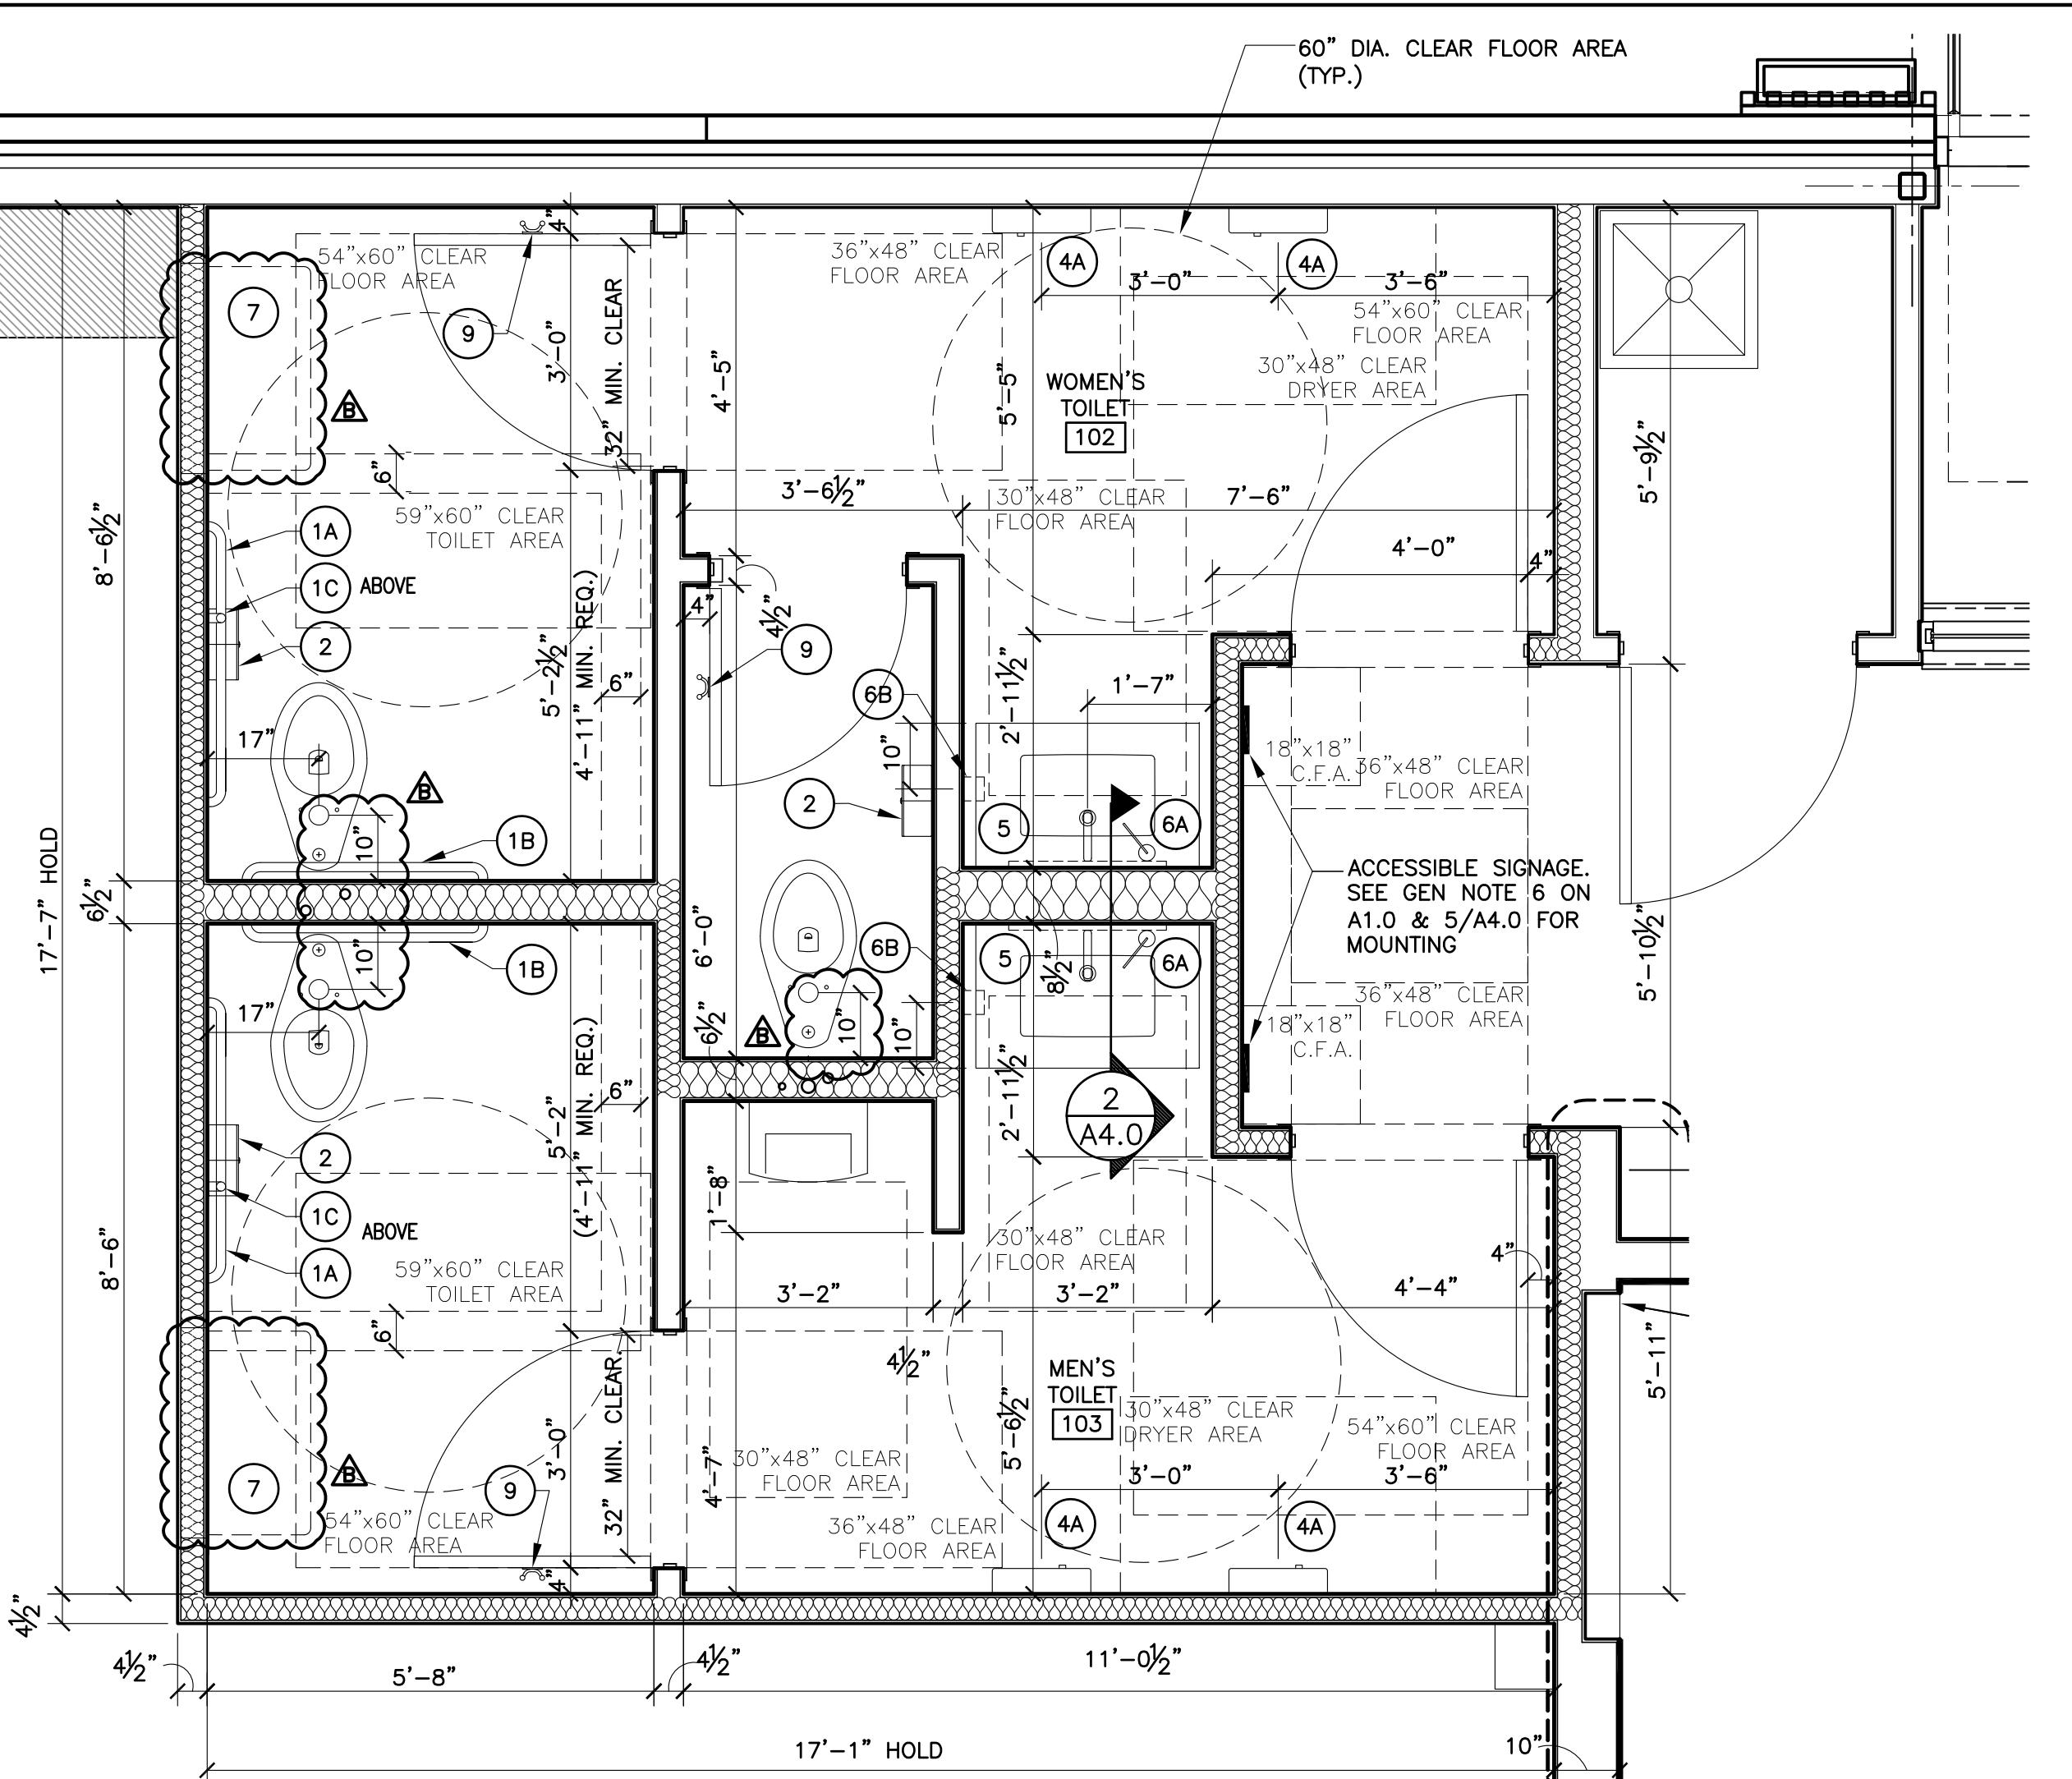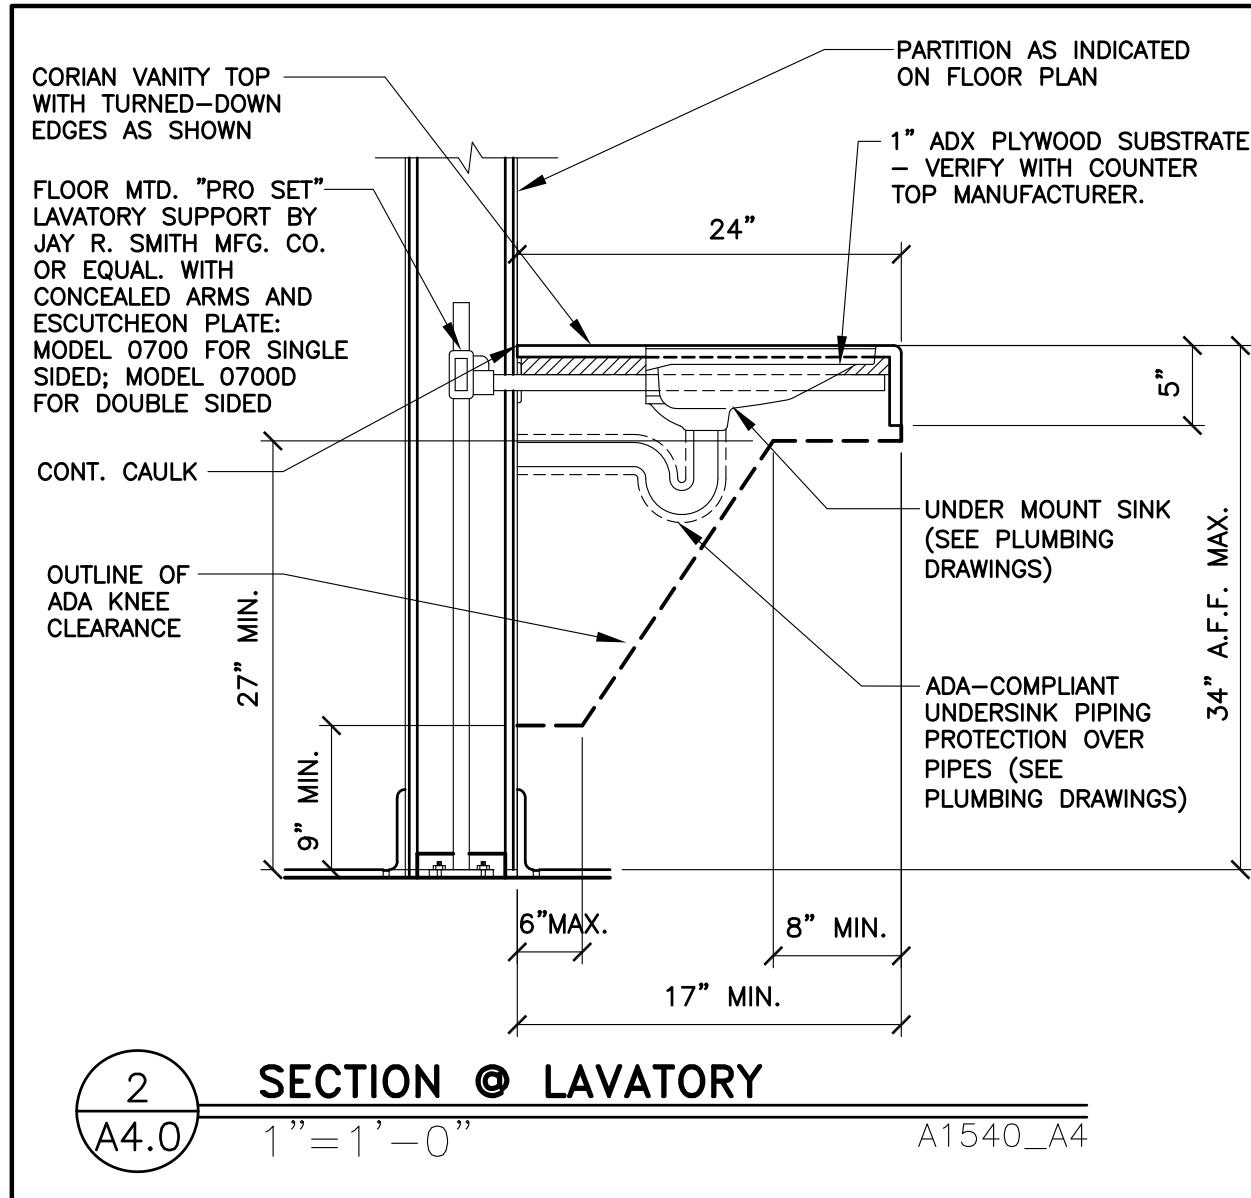


GRAPHICS SHOWN ARE FOR REFERENCE ONLY.
GC TO PROVIDE ADA SIGNAGE PACKAGE AND INSTALL SIGNS AT LOCATIONS AND POSITIONS INDICATED IN PACKAGE OR AS REQUIRED BY LOCAL CODES. SIGNAGE PACKAGE SUPPLIED BY:

FORREST PERMA-SIGN
9292 1ST ST. BOX 588
NEW ROCHELLE, NY 10802
www.forsigns.com
1-800-214-8765

SIGNAGE NOTES:

- EACH EXIT DOOR SHALL HAVE A TAUCLE SIGN, INCLUDING RAISED LETTERS AND BRAILLE, STATING "EXIT" AND SHALL COMPLY WITH CHAPTER 7. ALL SIGNAGE SHALL CONFORM WITH ACCESSIBILITY GUIDELINES AND LOCAL GUIDELINES INCLUDING BUT NOT LIMITED TO PROPORTION, COLOR CONTRAST AND RELIEF AND GRADE 2 BRAILLE REQUIREMENTS.
- WHEN PERMANENT IDENTIFICATION IS PROVIDED FOR ROOMS AND SPACES, RAISED LETTERS SHALL BE PROVIDED AND SHALL BE ACCOMPANIED BY BRAILLE IN CONFORMANCE WITH CHAPTER 7. SIGNS SHALL BE INSTALLED ON THE WALL ADJACENT TO THE LATCH SIDE OF THE DOOR. WHERE THERE IS NO WALL SPACE ON THE LATCH SIDE, INCLUDING AT DOUBLE LEAF DOORS, SIGNS SHALL BE PLACED ON THE NEAREST ADJACENT WALL, PREFERABLY ON THE RIGHT. MOUNTING HEIGHT SHALL BE 60" ABOVE THE FINISHED FLOOR TO THE CENTERLINE OF THE SIGN. MOUNTING LOCATION SHALL BE DETERMINED SO THAT A PERSON MAY APPROACH WITHIN 3" OF SIGNAGE WITHOUT ENCOUNTERING PROTRUDING OBJECTS OR STANDING WITHIN THE SWING OF A DOOR.

ACCESSIBLE SIGNAGE
N.T.S.

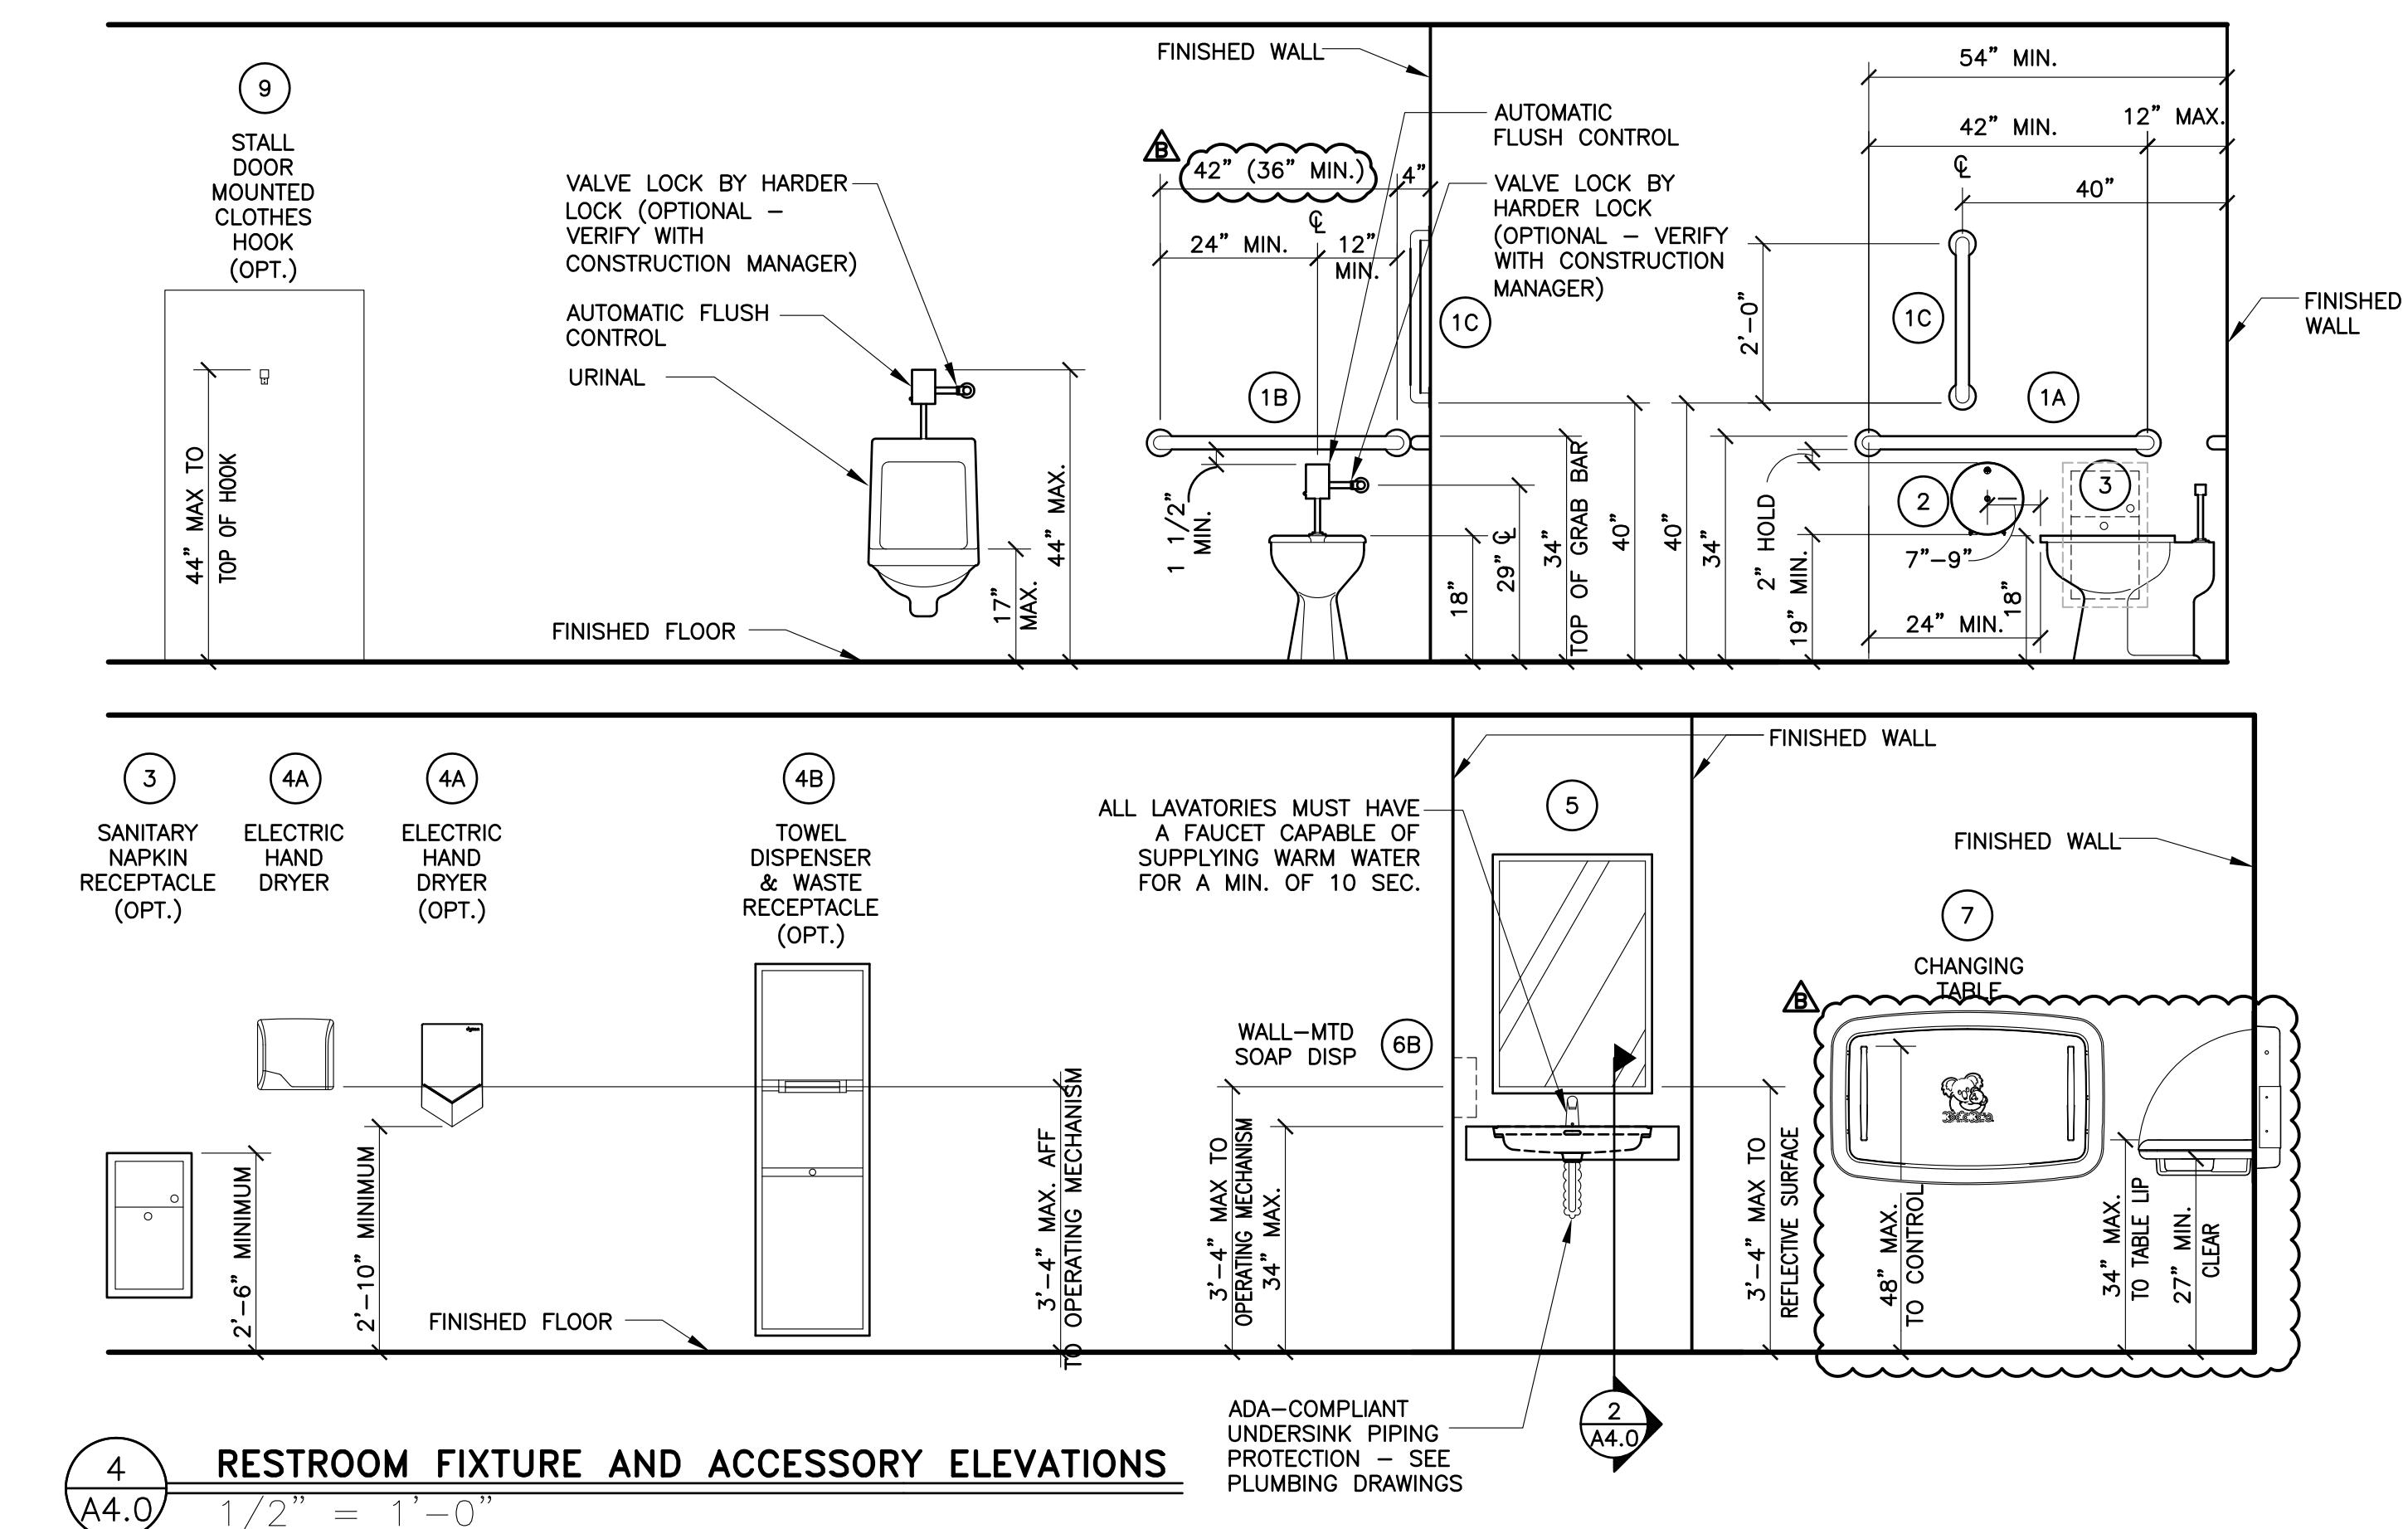

SHEET NO.	TITLE	DRAWN BY	STD ISSUE DATE	REVIEWED BY	DATE ISSUED	BY
015-0071.00.B	2019 STANDARD BUILDING - BB20	KO	2019-11	KO	01/23/20	DATA OPTIMIZATION
015-0071.00.B	4597F10-WOOD/WOOD					11/15/20 USD SAE SET REVIEW
015-0071.00.B	WOOD BEARING WALLS W/FIBER CEMENT SIDING & CI					05/05/20 CIVIL & PLAN REVIEW COMMENTS
015-0071.00.B	WOOD ROOF TRUSS FRAMING					01/23/20 PERMIT SET
015-0071.00.B	FIBER CEMENT PANEL/BATTEN/AUPOVIC PANEL/BRICK EXT. FINISH					01/13/20 USD PROGRESS SET REVIEW
015-0071.00.B	SITE ADDRESS					BY
015-0071.00.B	Registration Number					
015-0071.00.B	Date					
015-0071.00.B	REV					
015-0071.00.B	DATE					
015-0071.00.B	DESCRIPTION					
015-0071.00.B	NOTES:					
015-0071.00.B	1) SEE 4/A4.0 FOR ACCESSORY MOUNTING HEIGHTS					
015-0071.00.B	2) SELECT ONE ITEM FROM ITEM GROUPS 4 & 6, VERIFY WITH AREA CONSTRUCTION MANAGER.					
015-0071.00.B	3) CUT BACK-UP SUPPORTS BETWEEN STUDS SO FACE OF SUPPORT IS FLUSH W/WALL STUD					
3	RESTROOM ACCESSORY SCHEDULE	A4.0				

<p>CLOSURE DETAIL @ COOLER A4.1 1 1/2"=1'-0"</p>	<p>BATTEN TO BRICK TRANSITION A4.1 1 1/2"=1'-0"</p>	<p>DOOR JAMB @ F/C DOOR A4.1 1 1/2"=1'-0"</p>	<p>EXT.DORR JAMB DETAIL A4.1 1 1/2"=1'-0"</p>	<p>CREW WINDOW JAMB DETAIL A4.1 1 1/2"=1'-0"</p>
<p>ORDER WINDOW JAMB DETAIL A4.1 1 1/2"=1'-0"</p>	<p>EXPANSION JOINT DETAILS A4.1 1 1/2"=1'-0"</p>	<p>DETAIL @ COLUMN A4.1 1 1/2"=1'-0"</p>	<p>NOT USED A4.1 -</p>	<p>BATTEN TO FIBER CEMENT PANEL TRANSITION A4.1 1 1/2"=1'-0" 4597 ONLY</p>
<p>CORNER DETAIL @ ENTRY A4.1 1 1/2"=1'-0" 4597 ONLY</p>	<p>DETAIL @ COLUMN A4.1 1 1/2"=1'-0" 4597 ONLY</p>	<p>NOT USED A4.1 -</p>	<p>NOT USED A4.1 -</p>	<p>NOT USED A4.1 -</p>
<p>ALUMINUM BATTEN DETAIL A4.1 1/4"=1'-0"</p>	<p>SECTION A: PLAN DETAIL AT BATTENS SCALE: 3'=1'-0"</p> <p>ELEVATION DETAIL AT BATTENS SCALE: 1 1/2"=1'-0"</p> <p>ALL SUBSTRATE, HAT CHANNELS AND TRIM BY GC.</p>	<p>ELEVATION DETAIL AT BATTEN JOINTS SCALE: 1 1/2"=1'-0"</p> <p>PRIME AND PAINT ALL SIDES AND EDGES PRIOR TO INSTALLING</p>	<p>NOT USED A4.1 -</p>	<p>NOT USED A4.1 -</p>

I hereby certify that the above specification or drawing was prepared under my direct supervision and control and is registered with the State of Kansas.

[Signature]
Architect, Inc.

REPRISE
DESIGN

ARCHITECTURE & PLANNING,
12400 PORTLAND AVENUE SOUTH,
SUITE 100
BURNsville, MN 55337
EMAIL: DATA@REPRISEDESIGN.COM
PHONE: (952) 252-4042
FAX: (952) 252-4943

©2020 McDonald's USA, LLC
McDonald's USA, LLC
These drawings and specifications are the confidential and proprietary property of McDonald's USA, LLC and shall not be reproduced or distributed outside the contract documents without the express written consent of McDonald's USA, LLC. These drawings and specifications are intended for use on this specific project only. They are not to be used for any other purpose or in conjunction with its issue date and are not suitable for use on a different site or at a later time. Use of these drawings for reference or example on another project requires the services of an authorized McDonald's USA, LLC representative. Use of these drawings on other projects is not authorized.

RD#19175

DRAWN BY DIA STD ISSUE DATE 2019-11

REVIEWED BY KID DATE ISSUED 01/23/20

SITE ID 015-0071.000

SITE ADDRESS 605 SOUTH 7TH STREET, KANSAS CITY, KS

015-0071.000

015-0071.000


015-0071.000



015-0071.000



015-0071.000


015-0071.000



015-0071.000

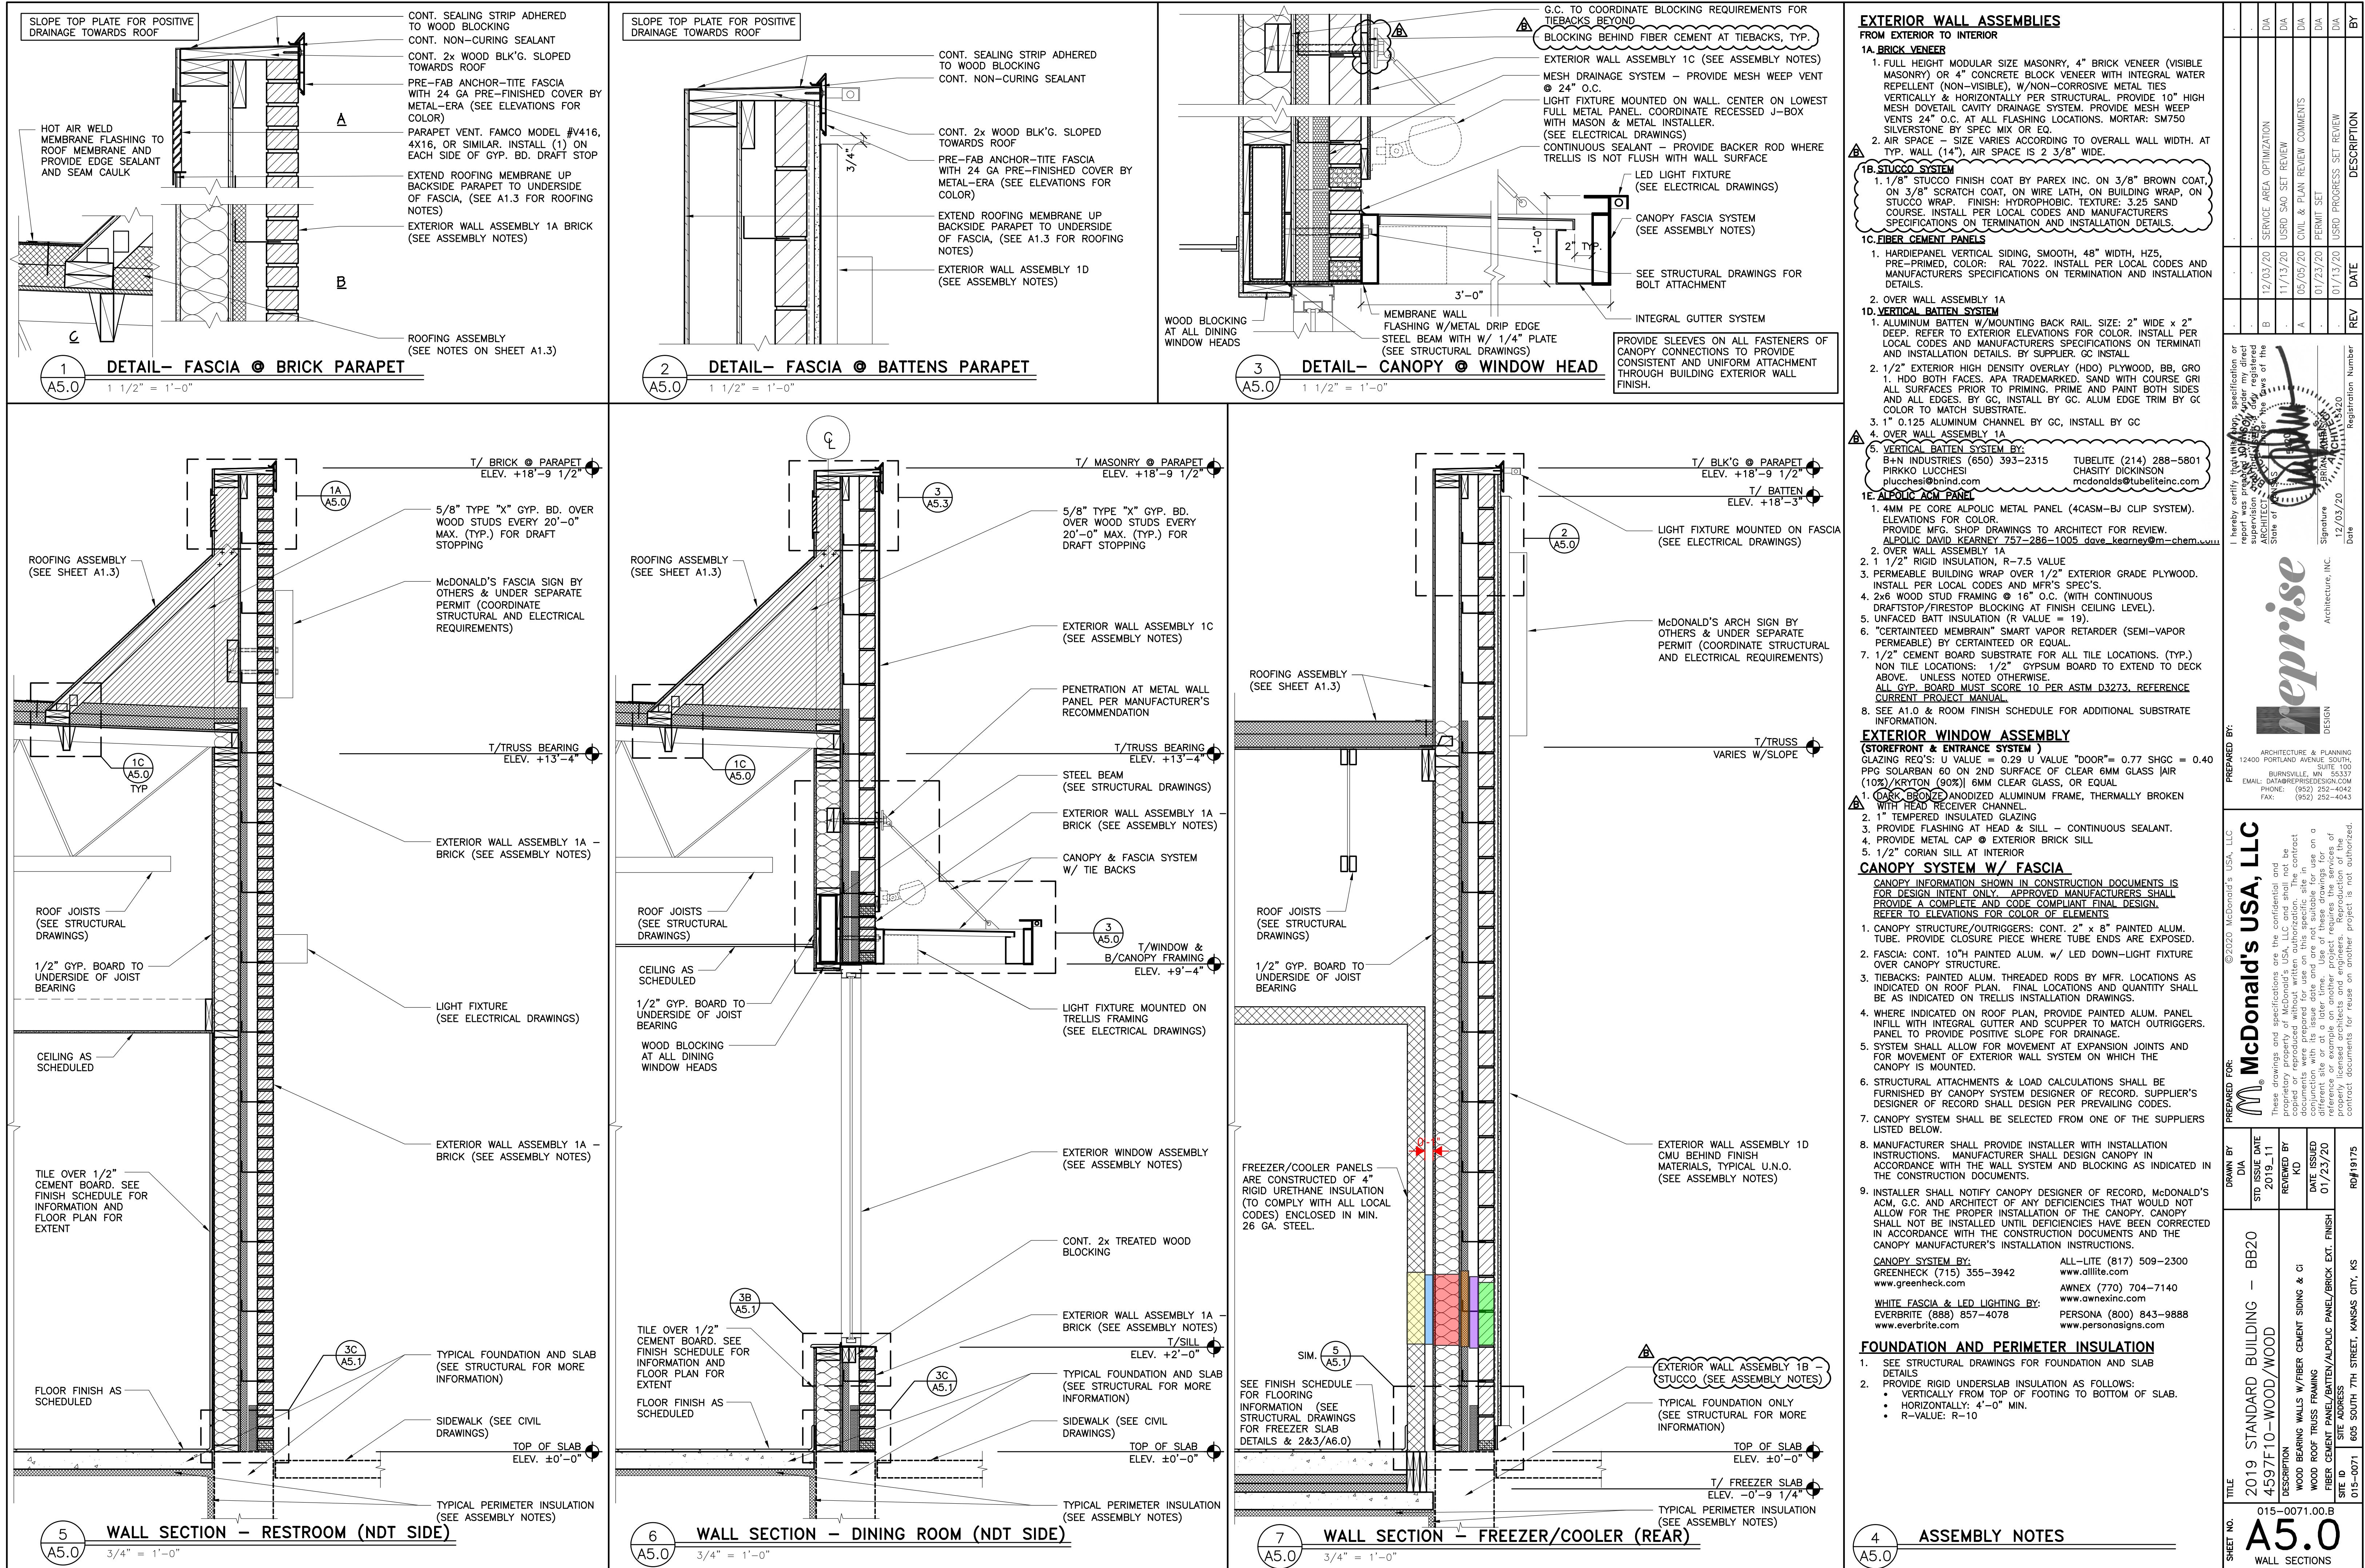

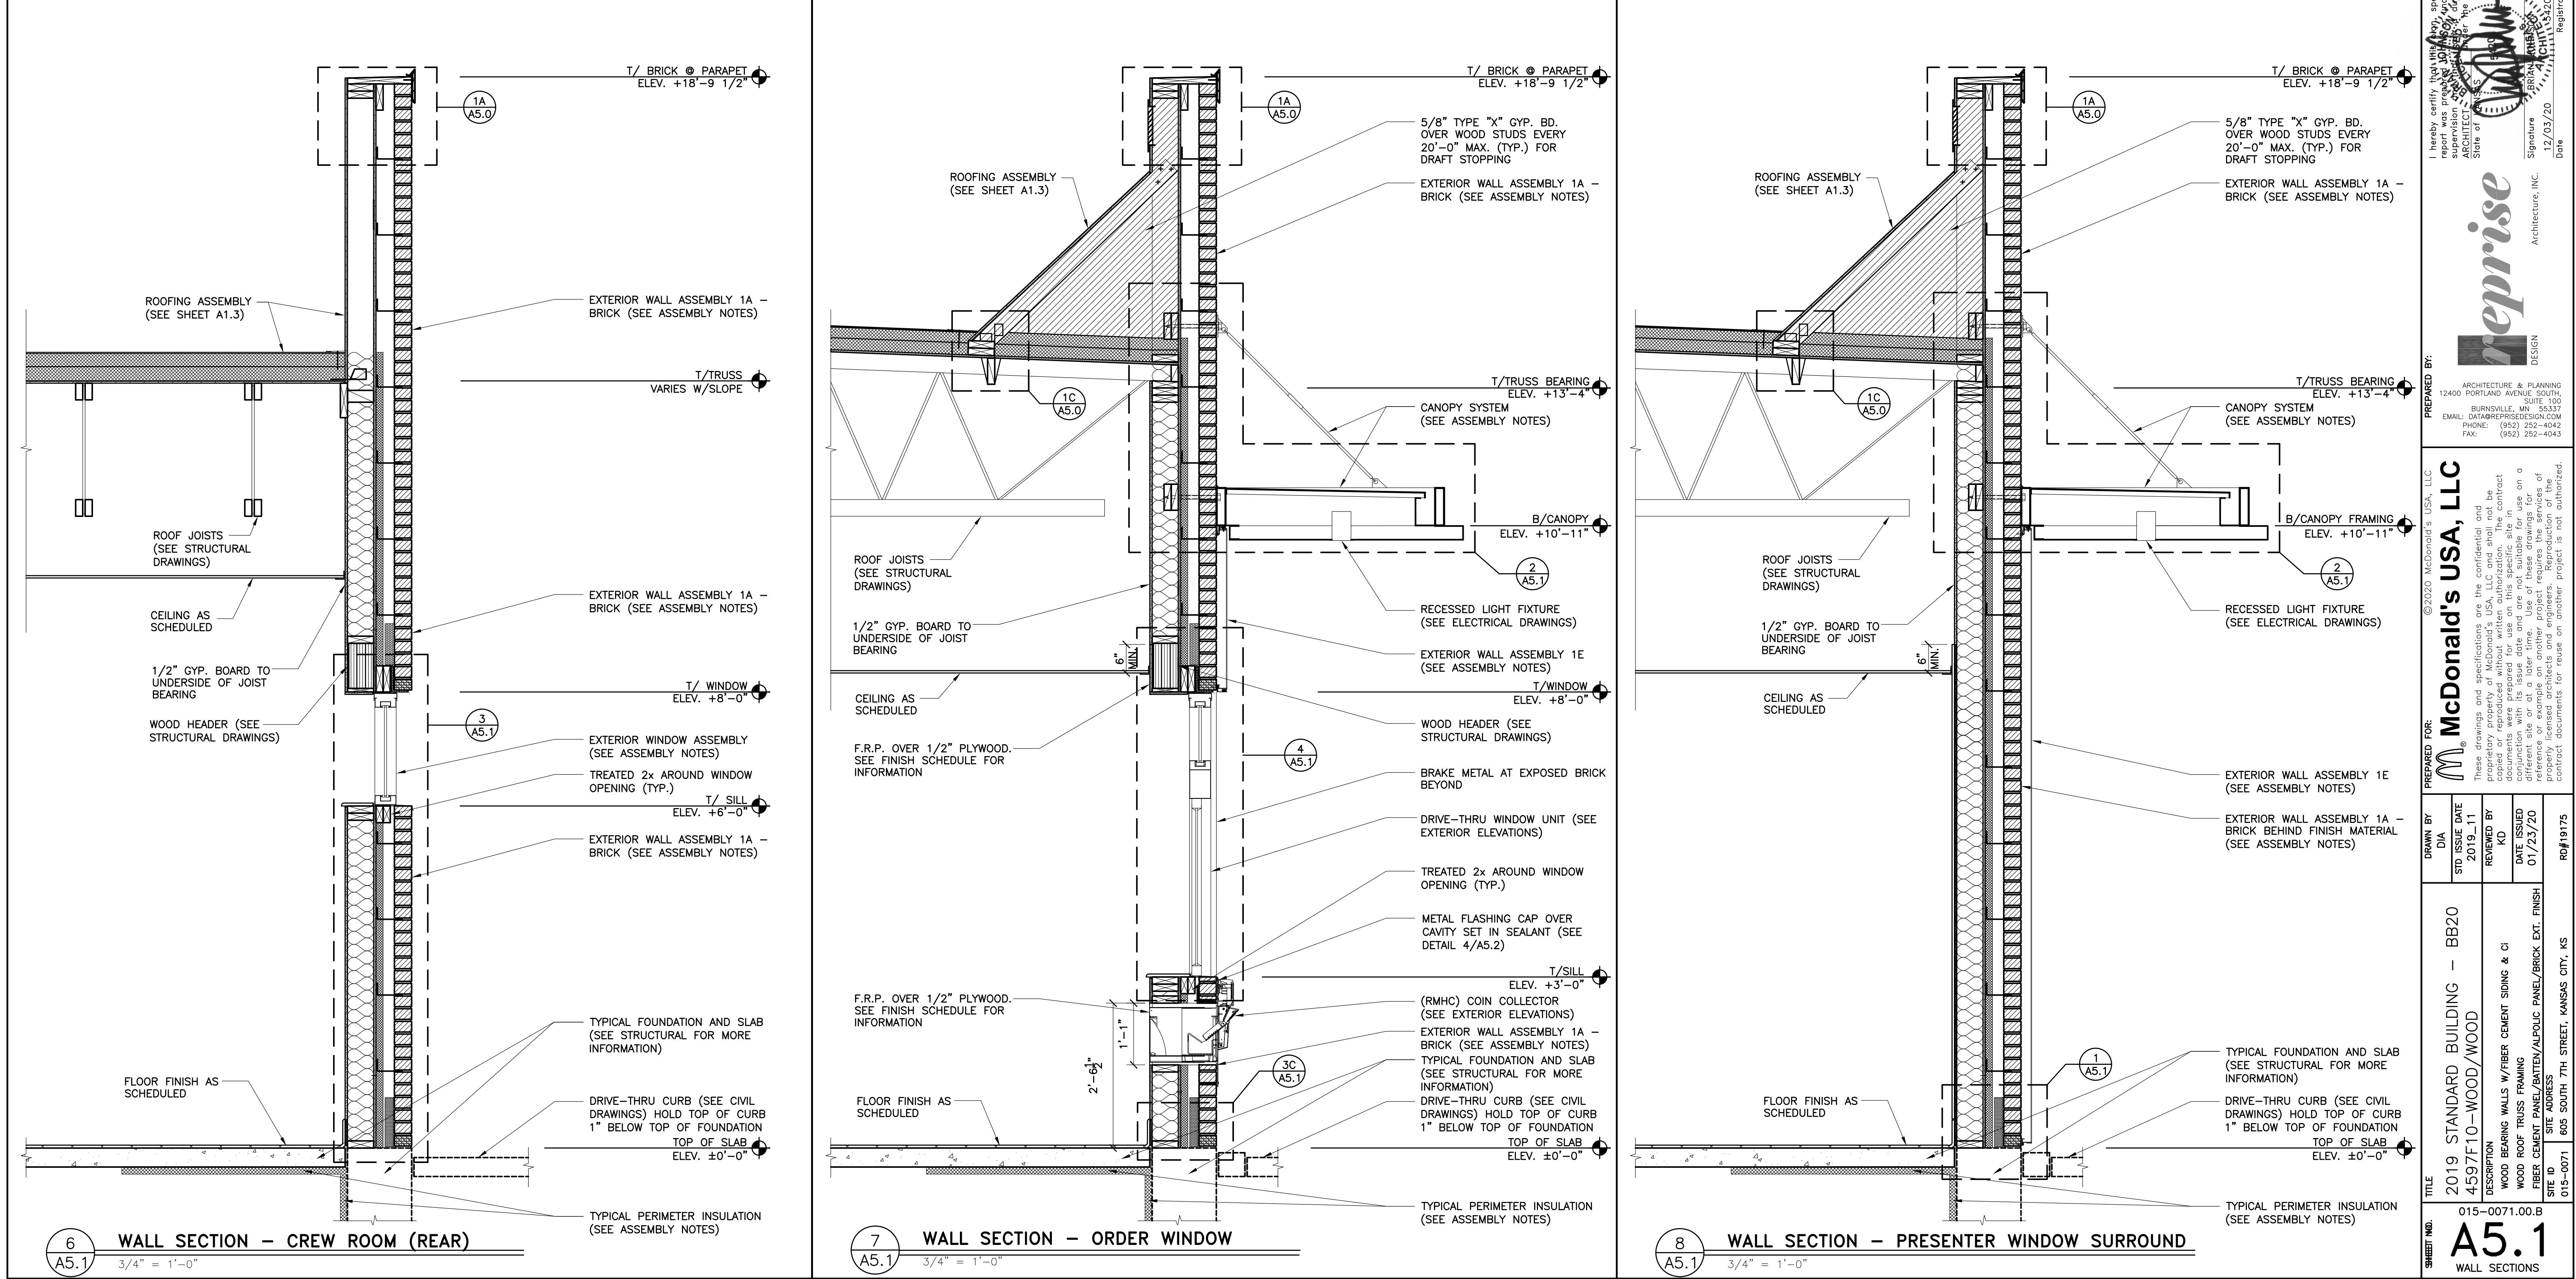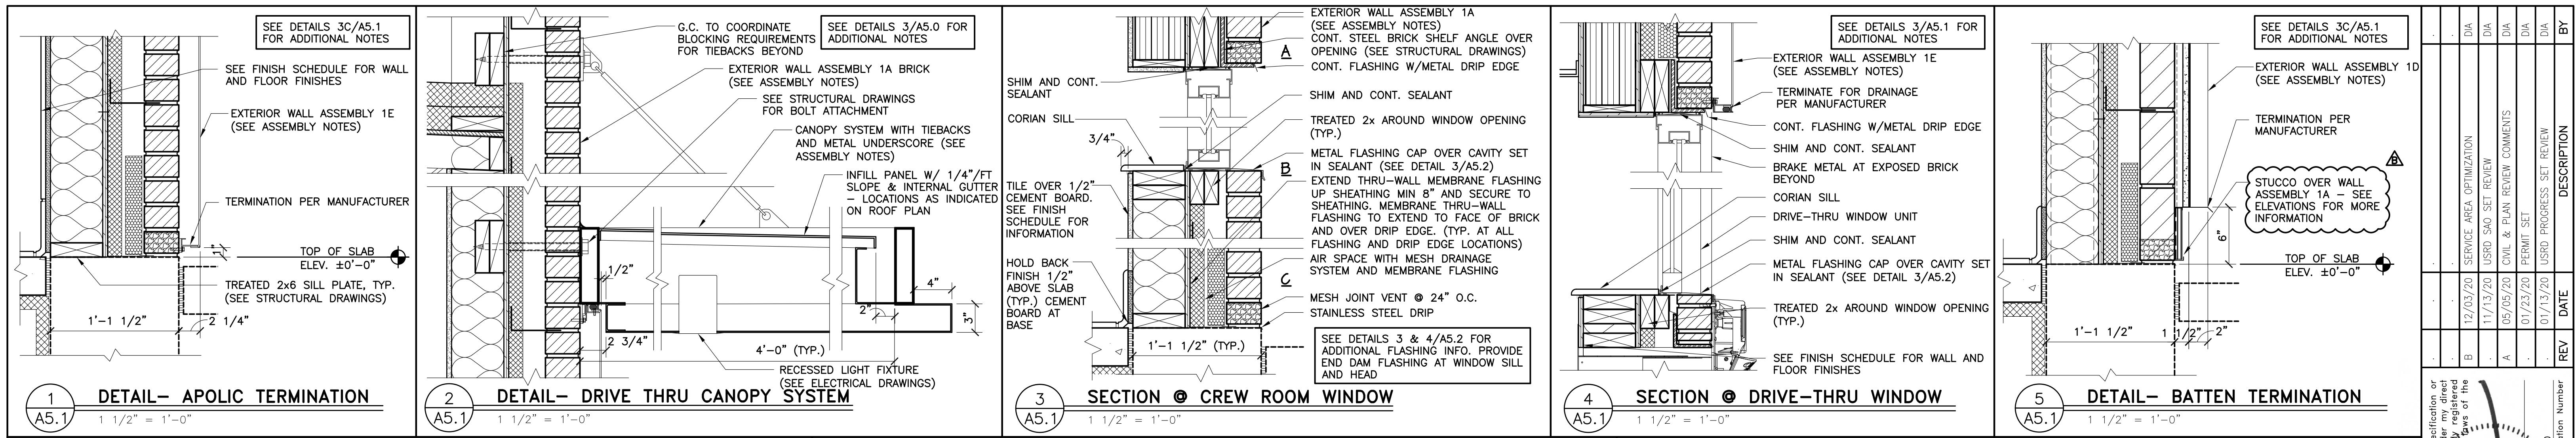

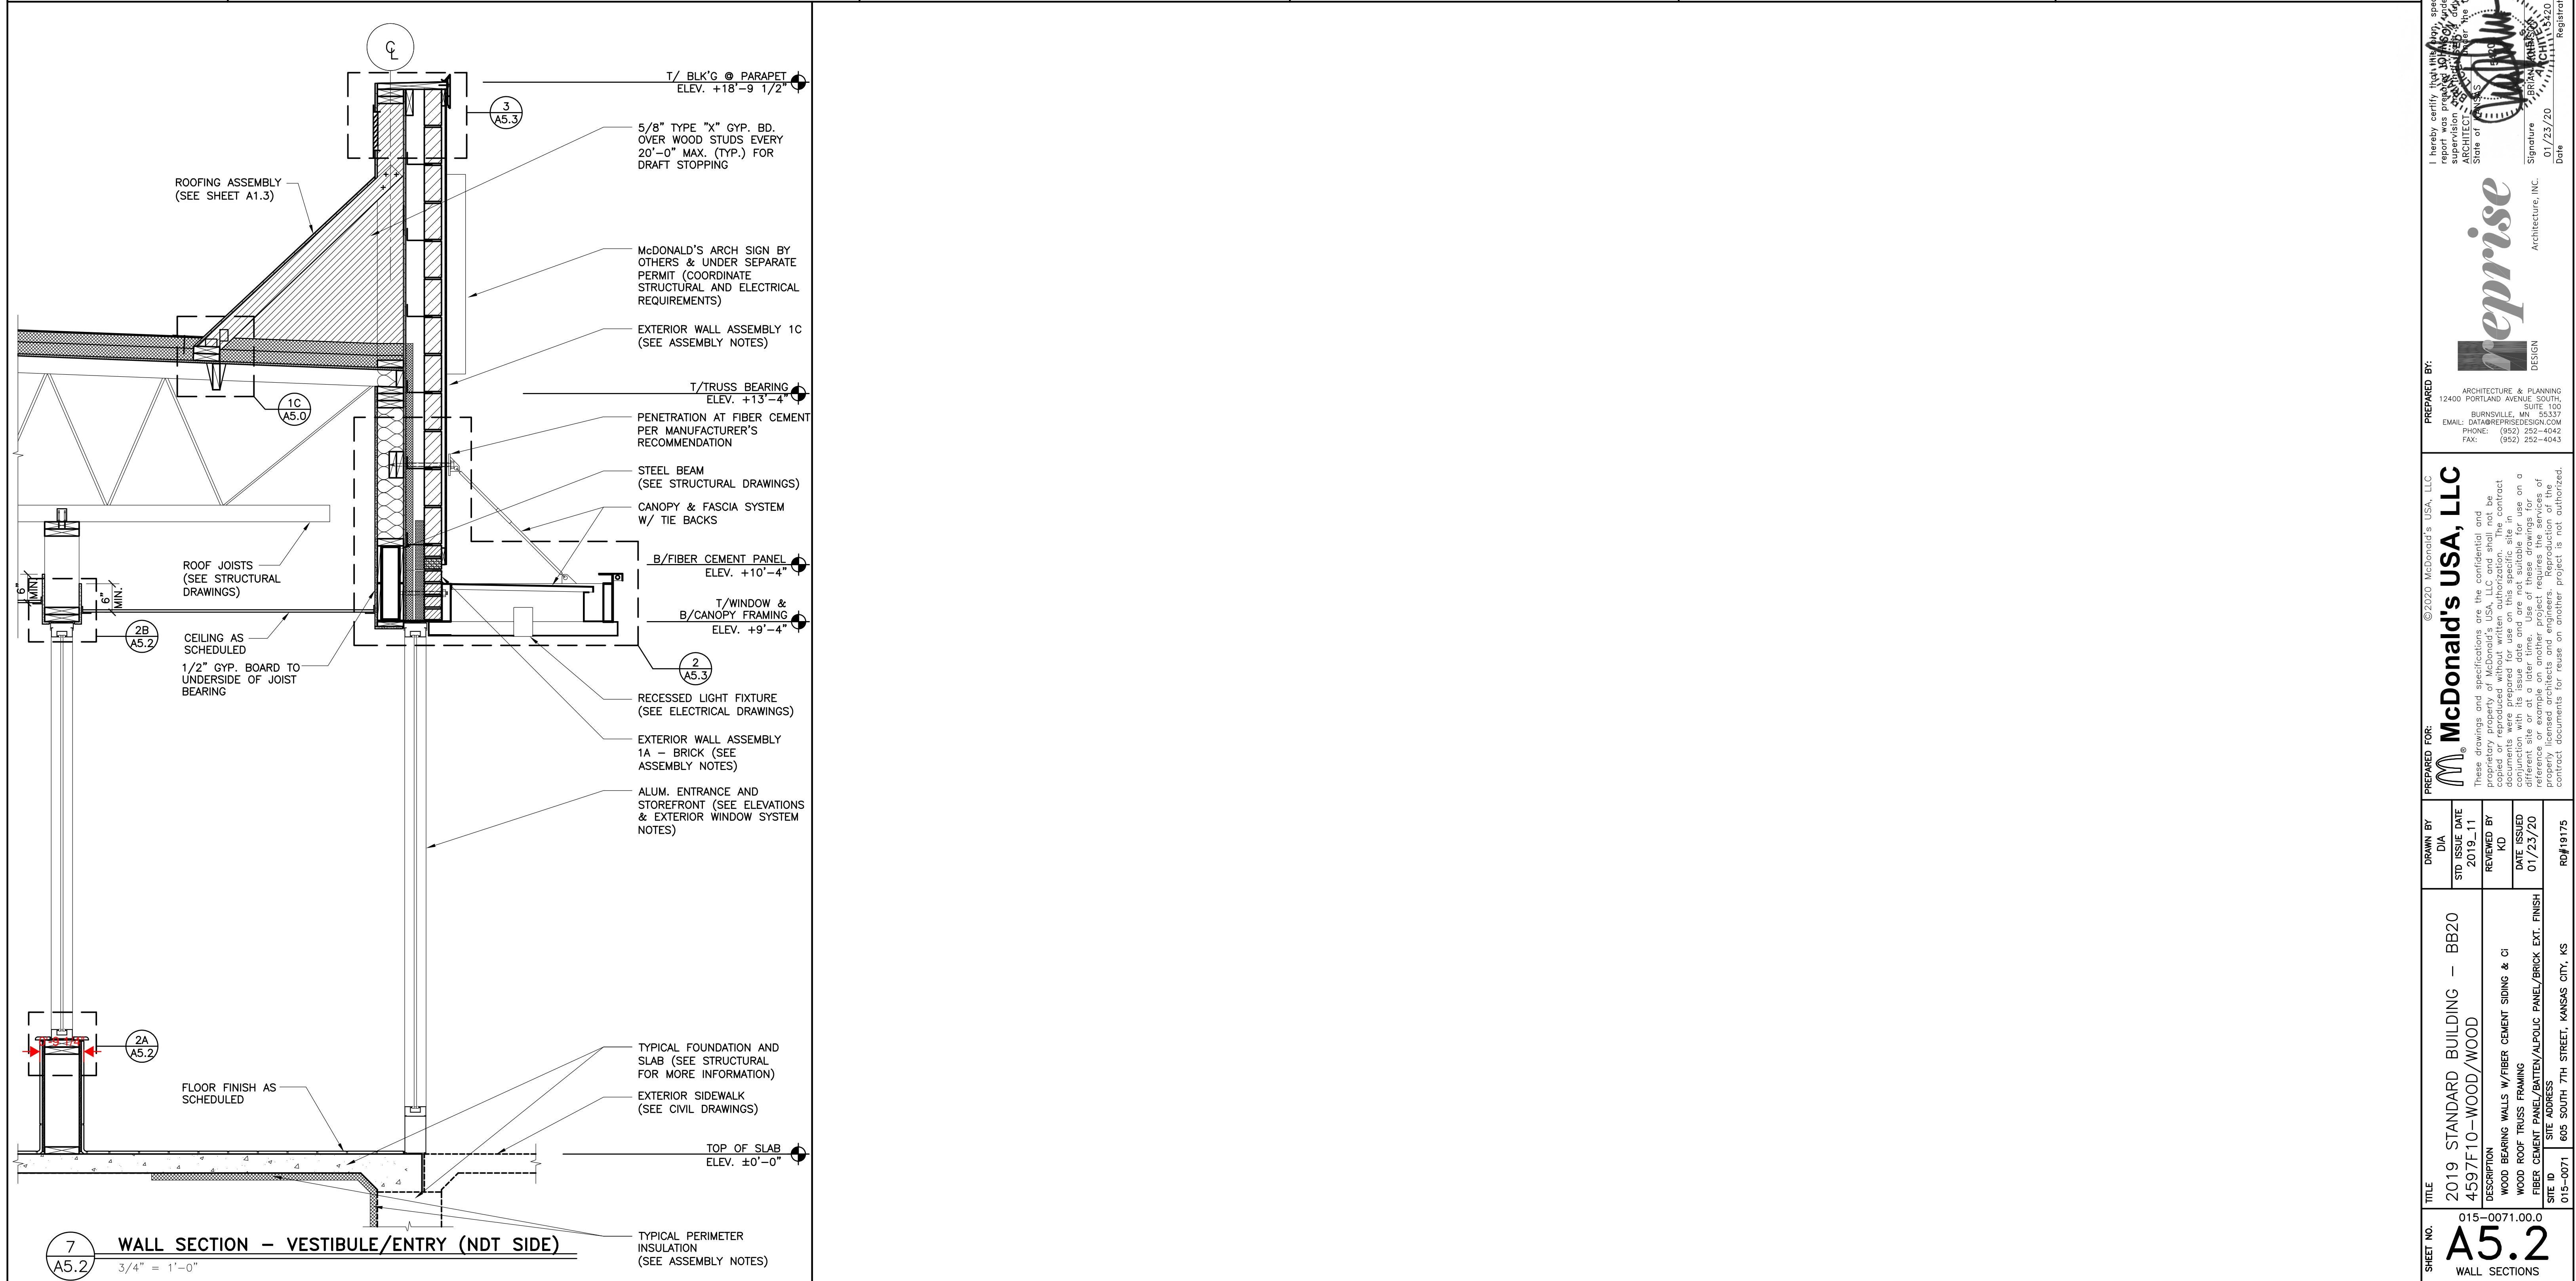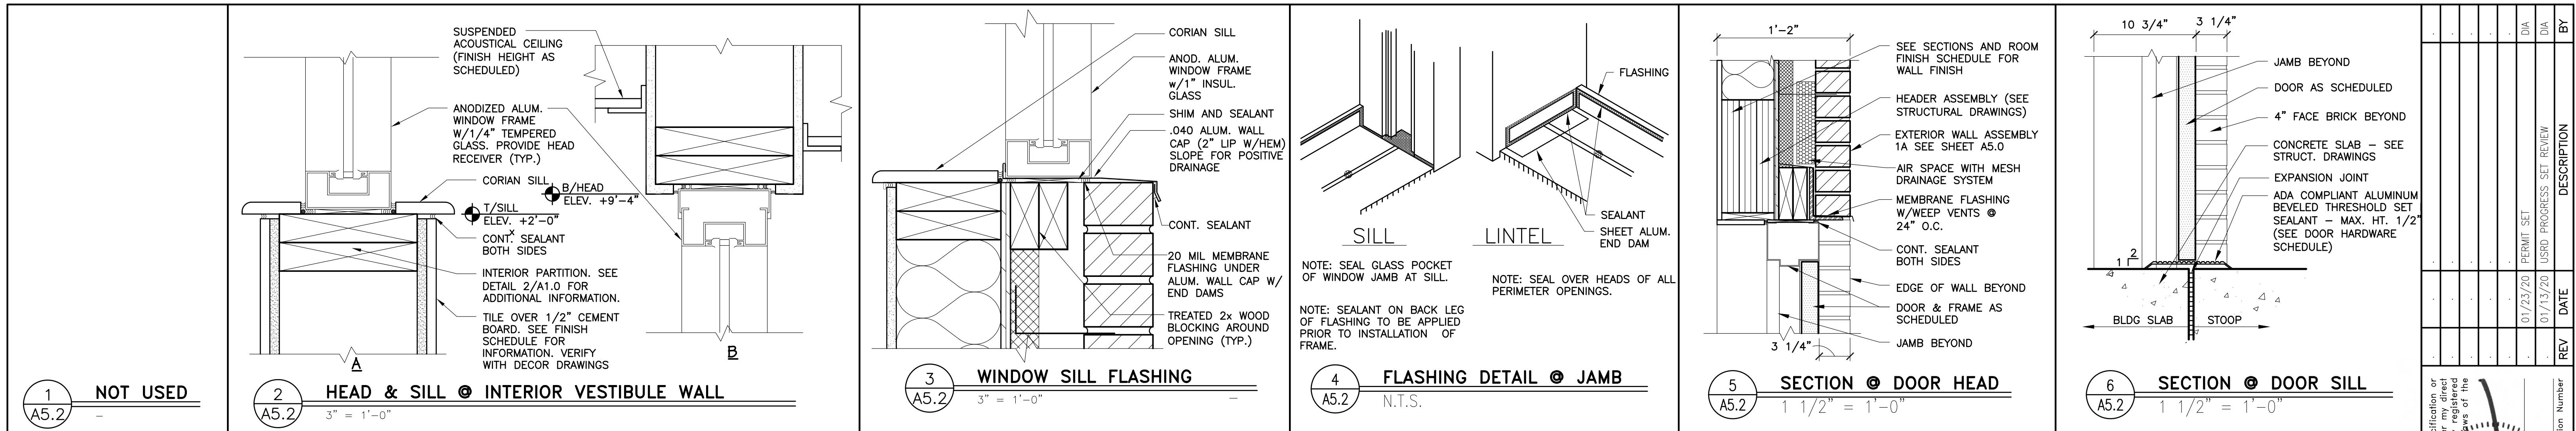

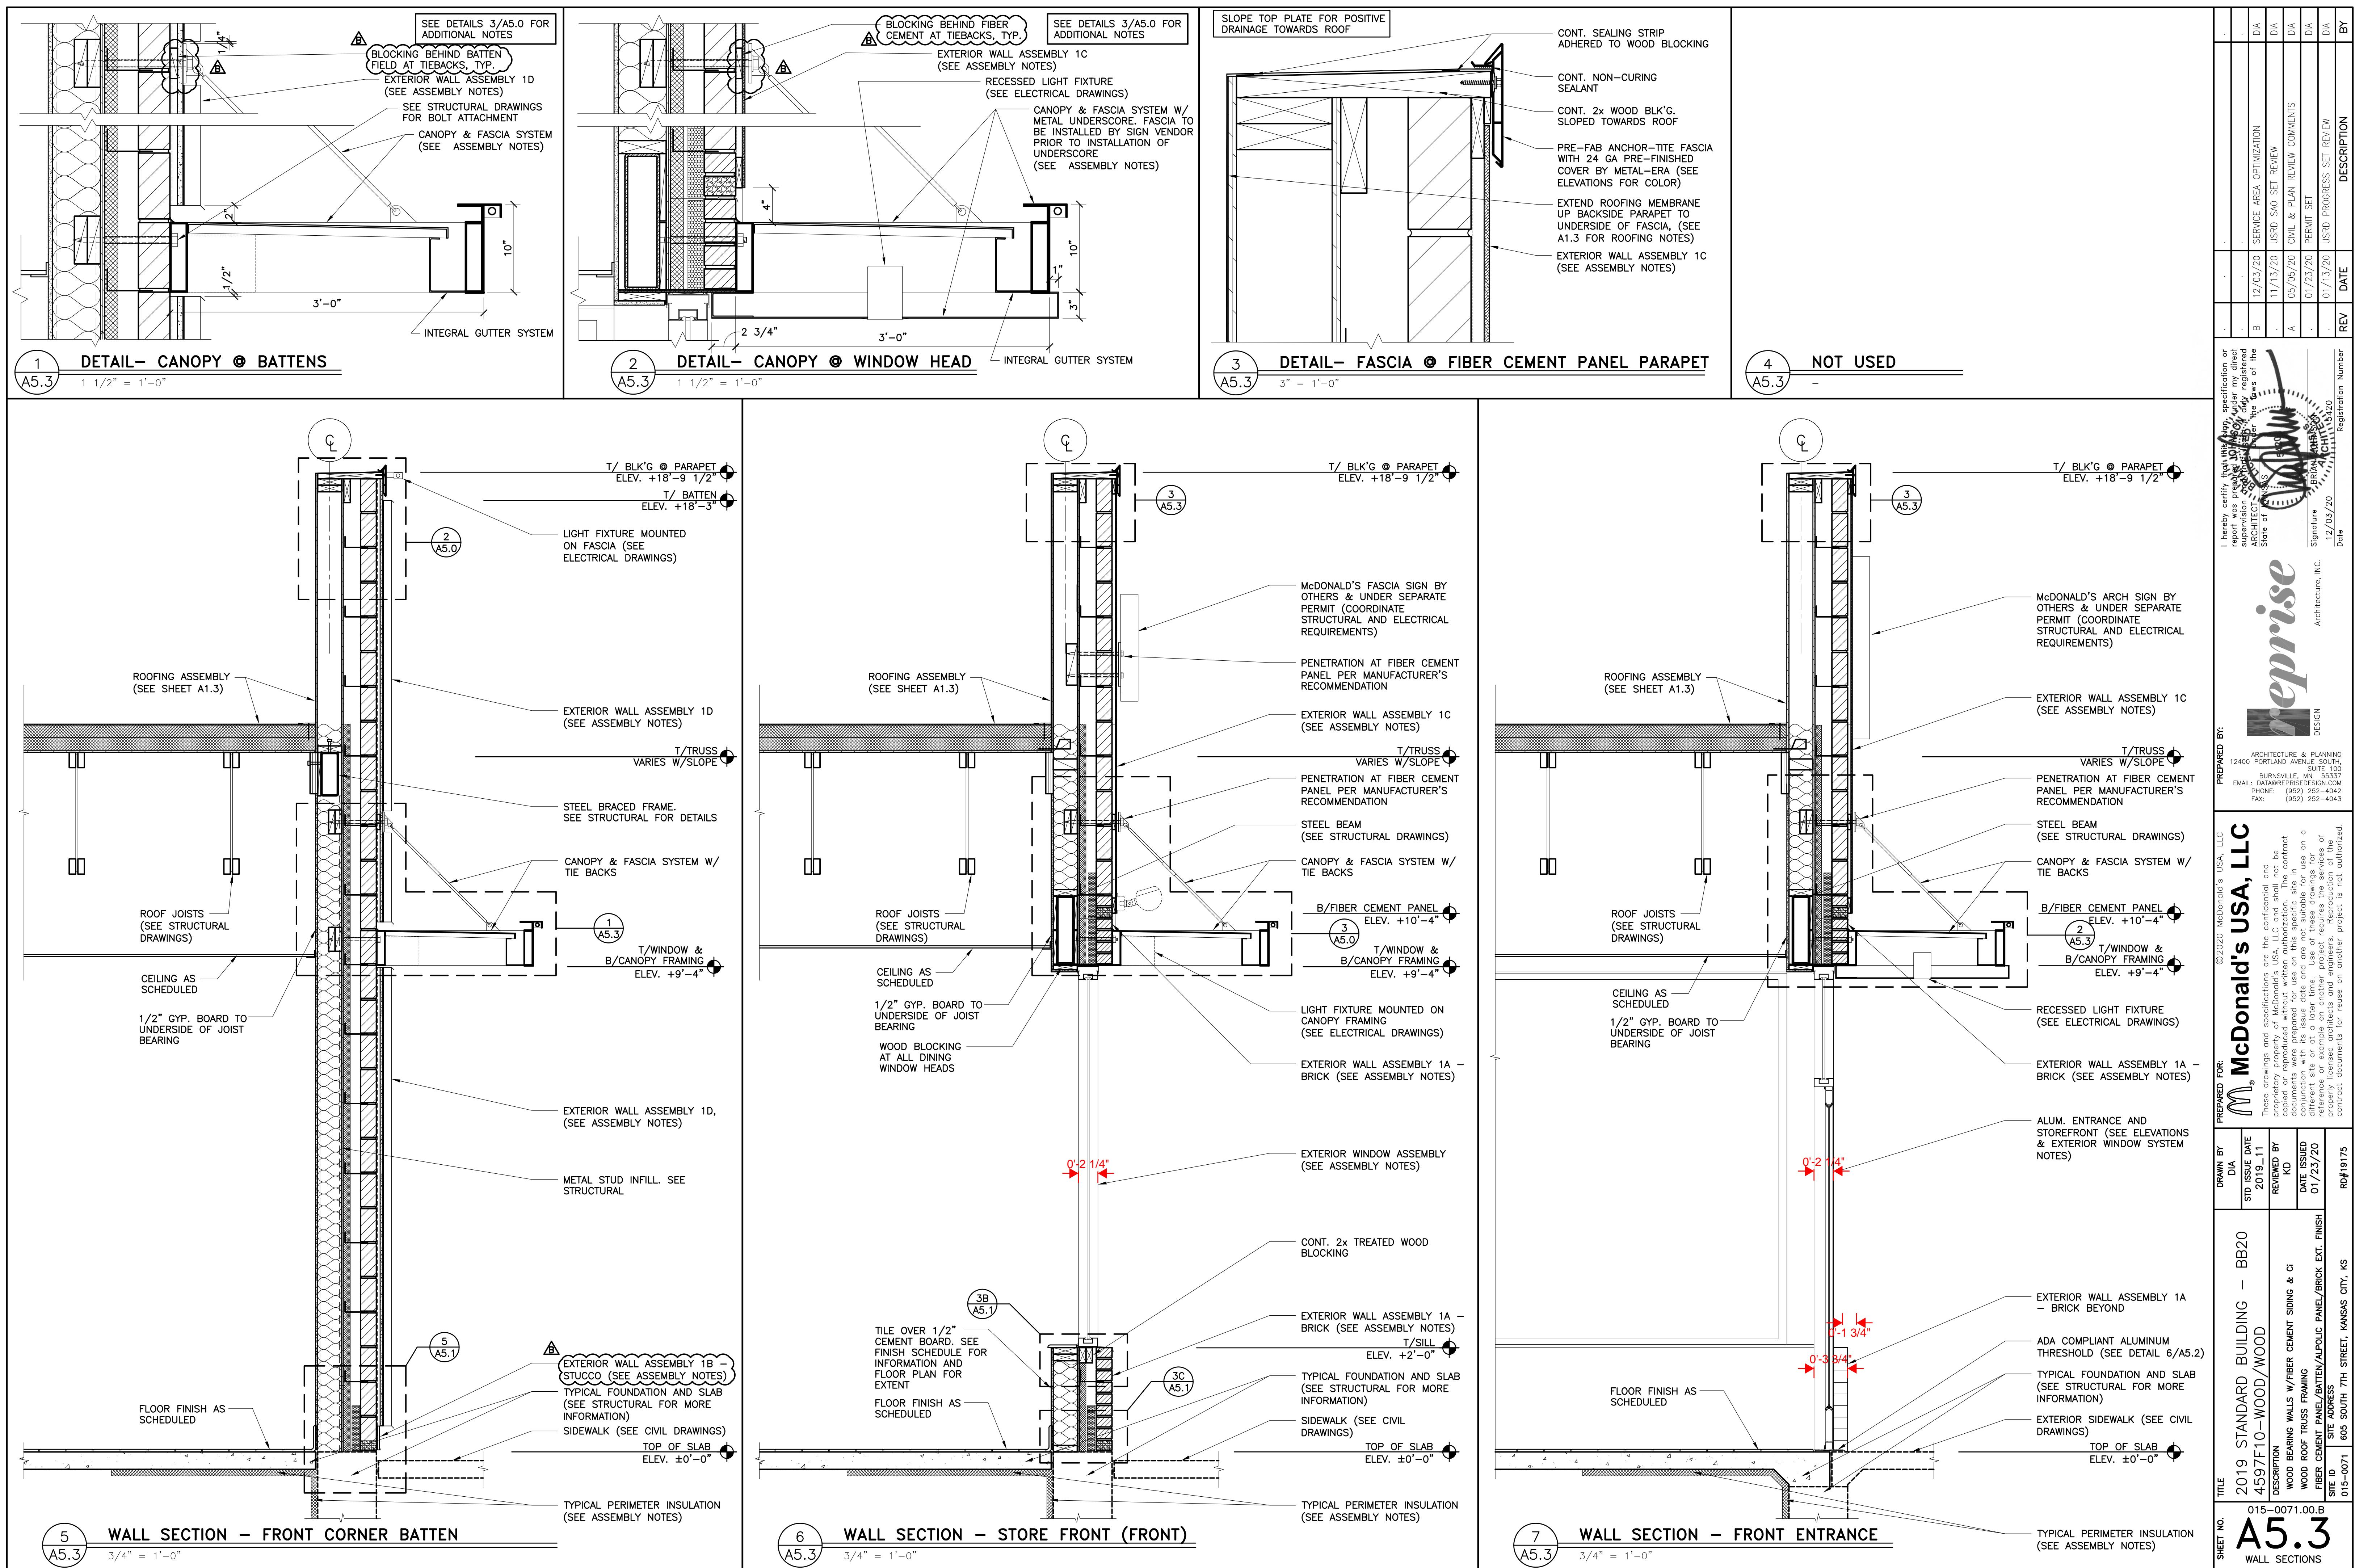


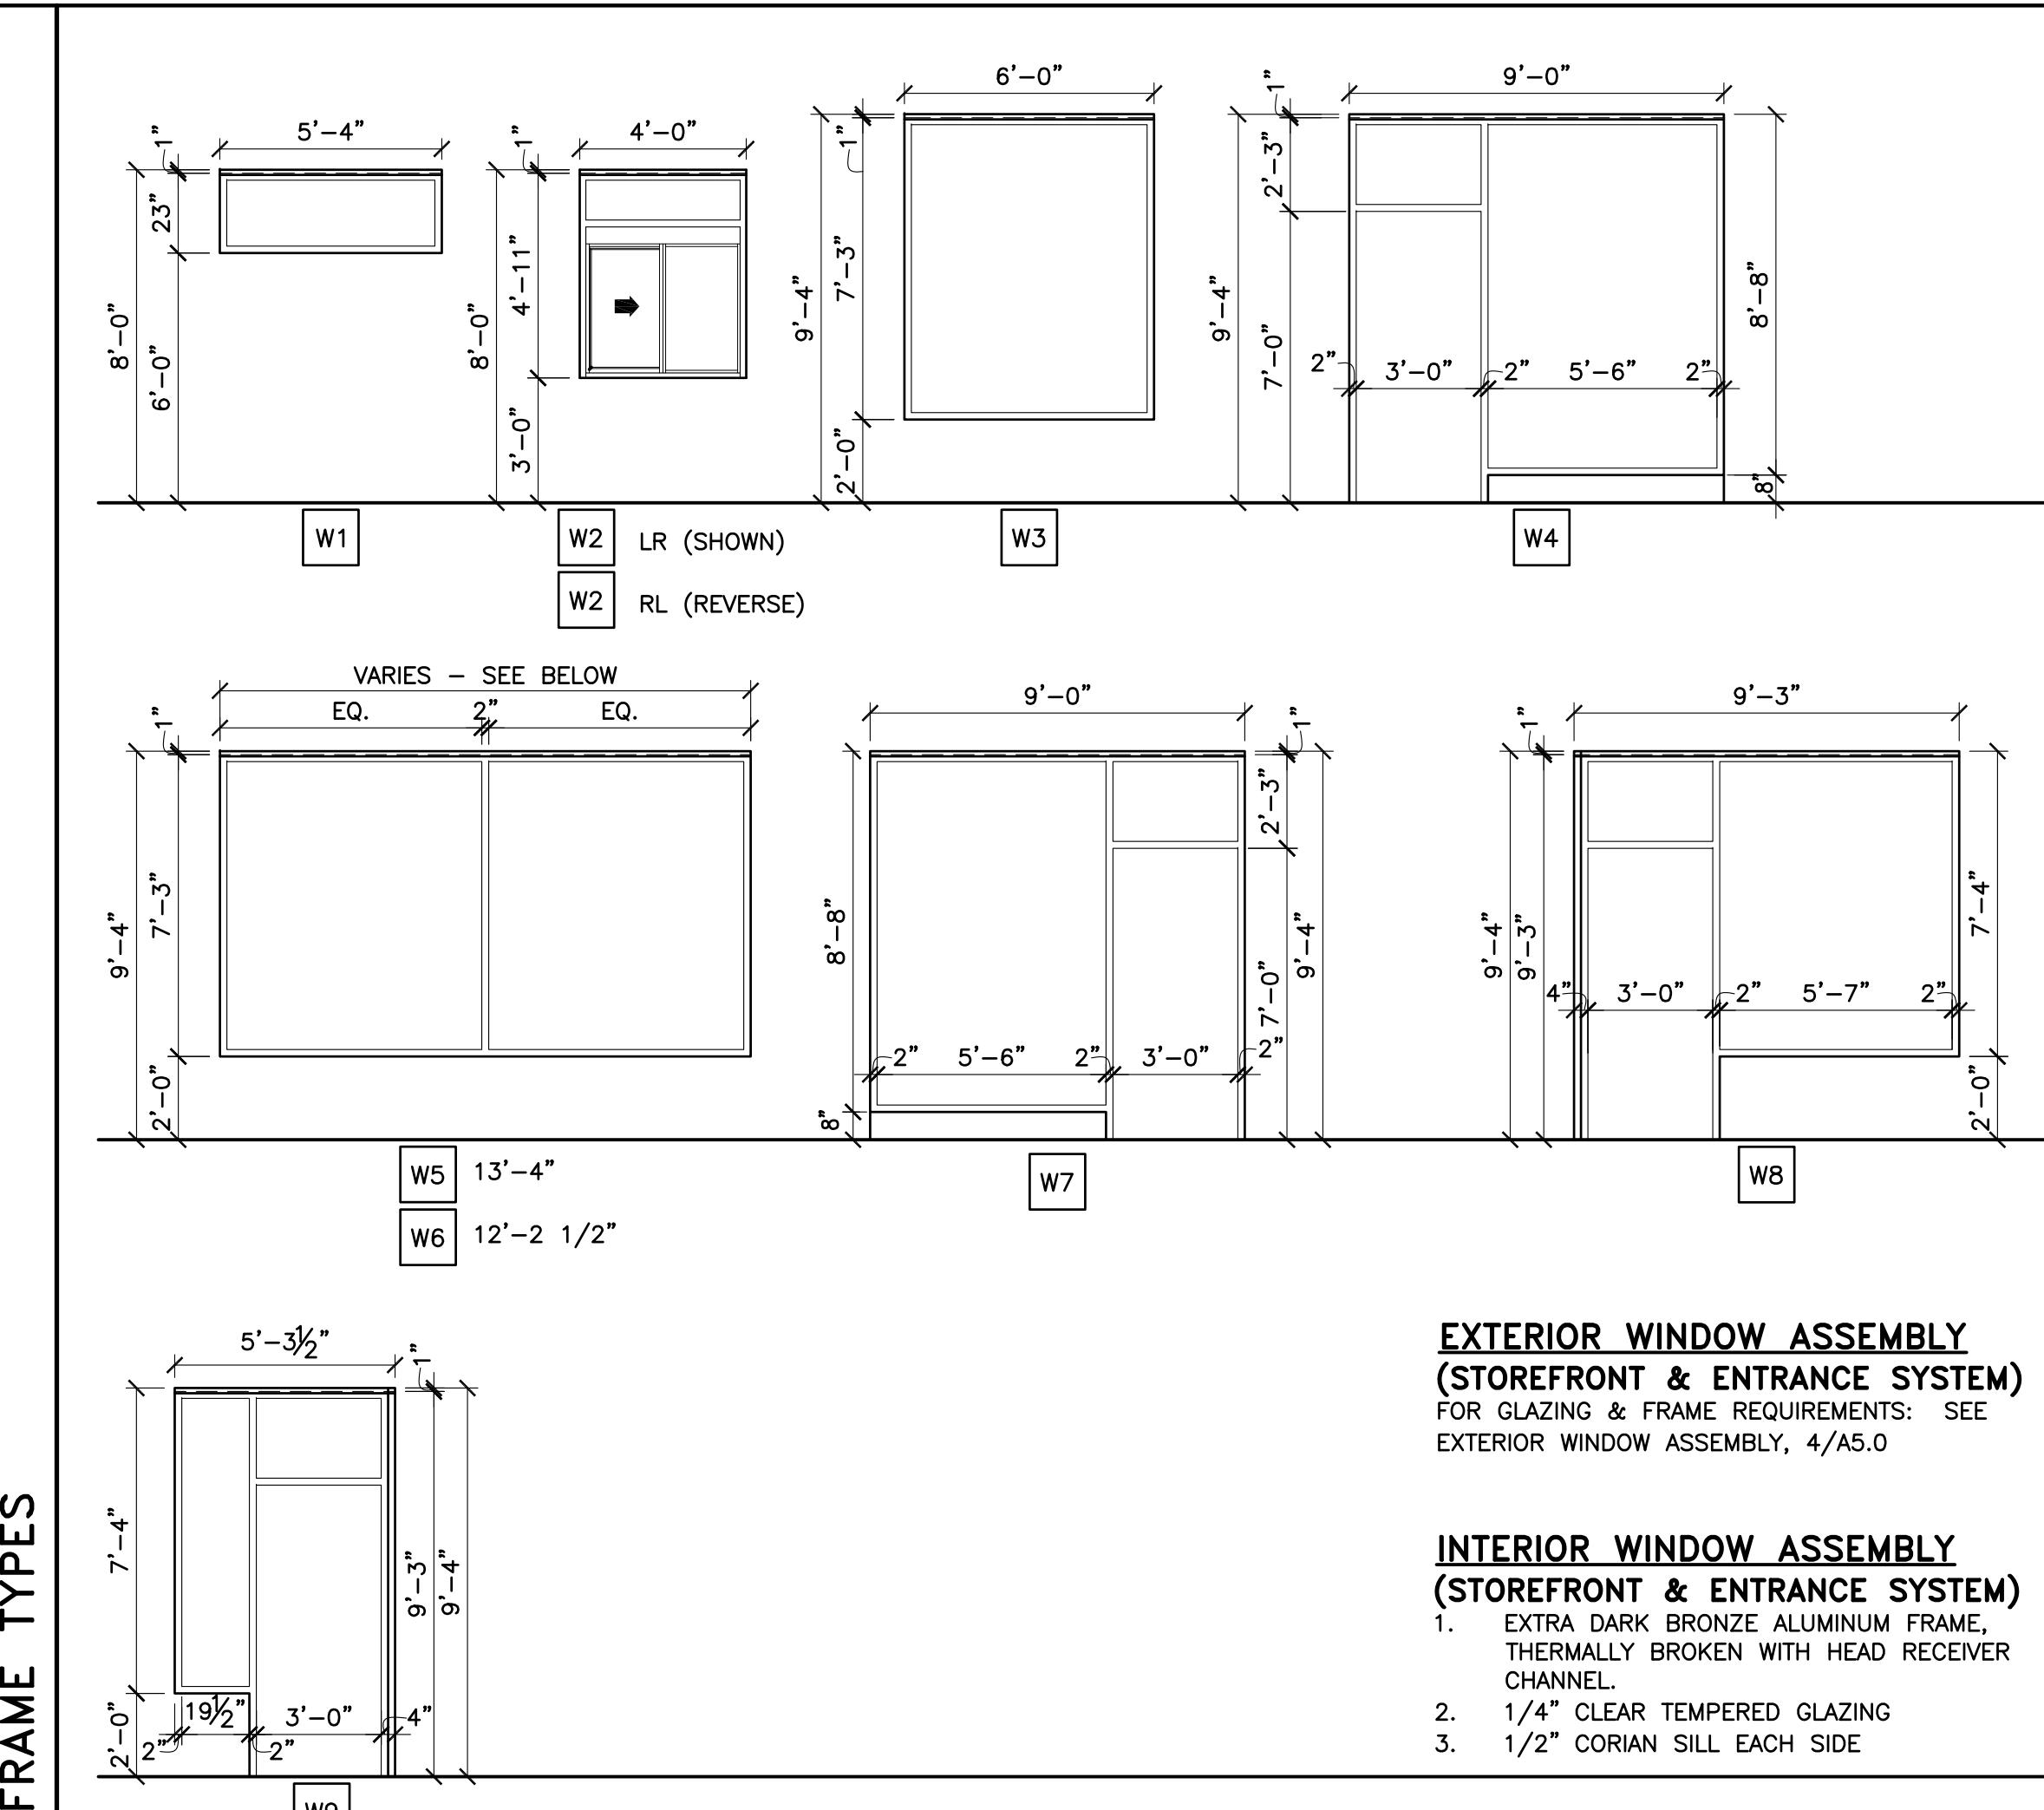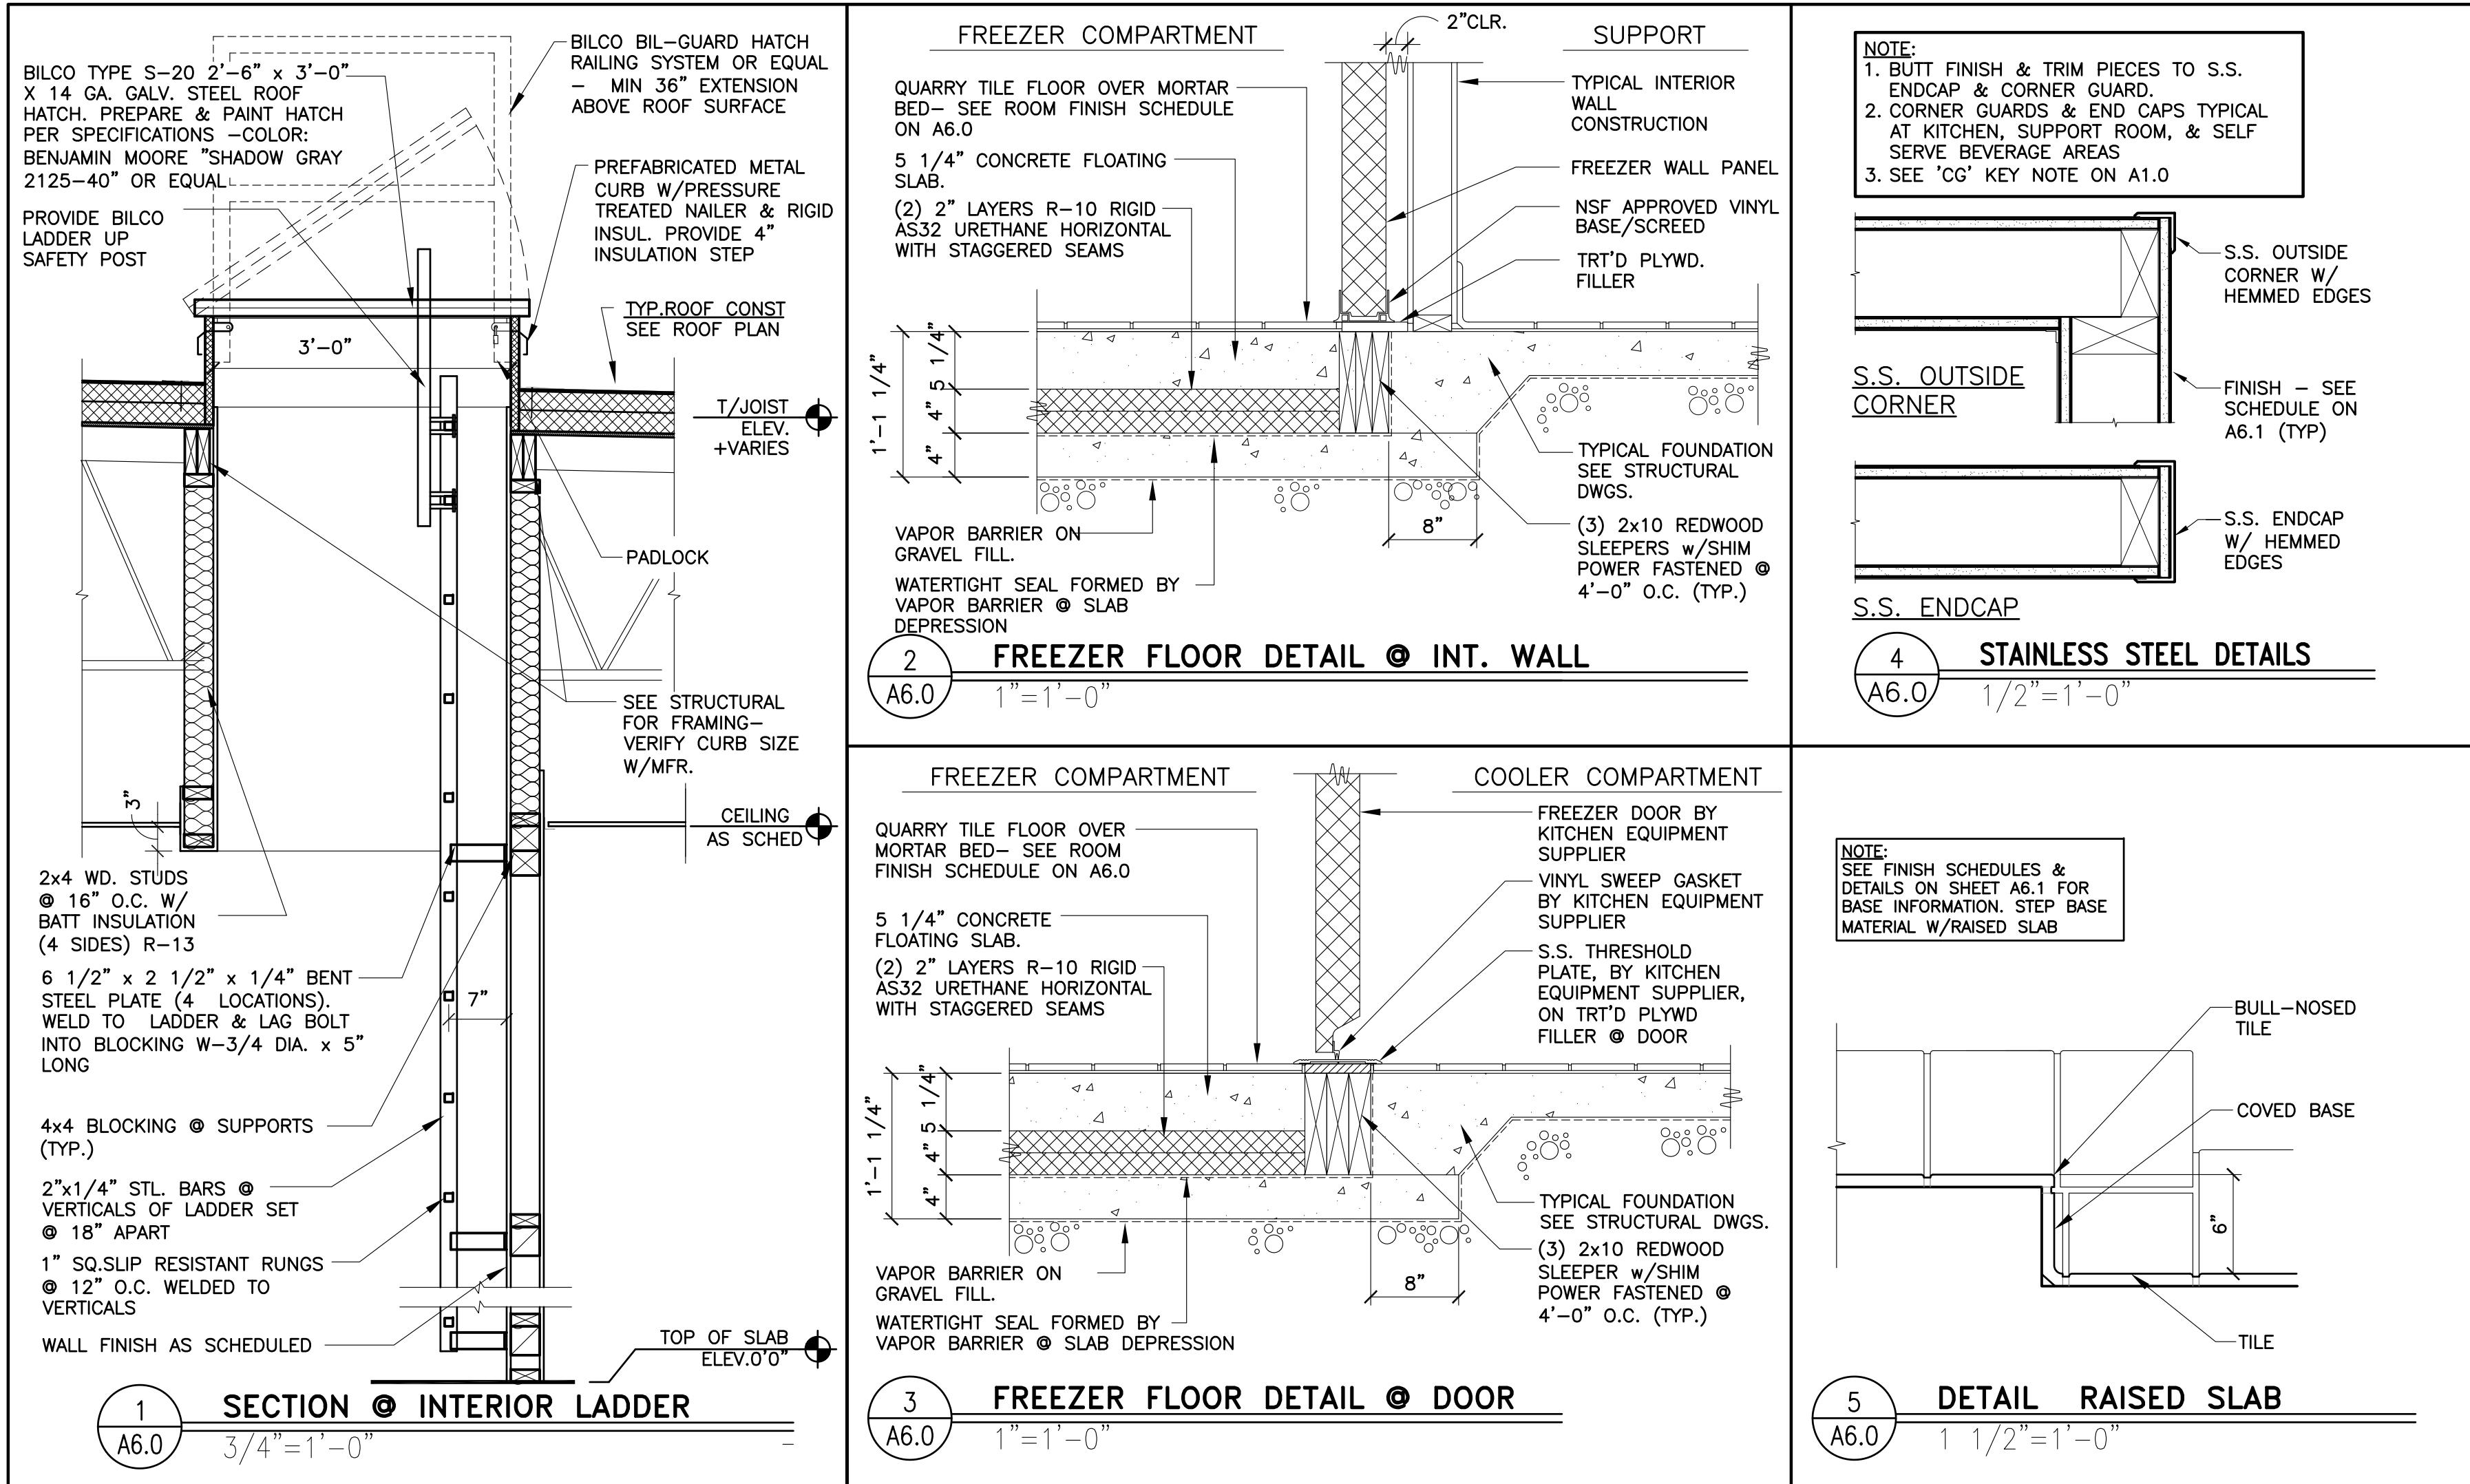

PREPARED BY:	DRAWN BY	DIA	STD ISSUE DATE	REV'D BY	DATE ISSUED	DESCRIPTION	SITE ID	TITLE	REV	DATE	BY	
McDonald's USA, LLC		2019-11		KO	01/23/20	WOOD BEARING WALLS W/FIBER CEMENT SIDING & CI WOOD ROOF TRUSS FRAMING FIBER CEMENT PANEL/BATTEN/AUPOIC PANEL/BRICK EXT. FINISH SITE ADDRESS: 605 SOUTH 7TH STREET, KANSAS CITY, KS 015-0071.00.B		A6.0			01/13/20	USD PROGRESS SET REVIEW
											BY	
<p>I hereby certify that this drawing, specification or detail was prepared under my direct supervision and direction by the employee(s) of the firm named above. I further declare that the original drawing was filed in the office of the State of Missouri, Kansas City, Missouri.</p> <p>Signature: Brian A. Achleitner Title: Architect Registration Number: 120320 Date: 12/03/20</p> <p>Signature: Brian A. Achleitner Title: Architect Registration Number: 120320 Date: 12/03/20</p>												
											BY	

GENERAL NOTES:

- ALL EXIT DOORS SHALL BE KEYLESS IN THE DIRECTION OF EGRESS.
- THE OPENING FORCE OF ALL EXTER. PUSH/PULL DOORS SHALL NOT EXCEED 8 1/2 LBS.
- THE OPENING FORCE OF ALL INTERIOR PUSH/PULL DOORS SHALL NOT EXCEED 5 LBS.
- PROVIDE PANIC HARDWARE FOR ALL EXTERIOR DOORS AS NOTED ON THE DOOR SCHEDULE.
- ALL DOOR HARDWARE SHALL NOT REQUIRE TIGHT GRASPING, TIGHT PINCHING OR TWISTING OF THE WRIST TO OPERATE.
- DOOR #1 & #1A - ENTRY DOOR/EMERGENCY EXIT (IA NOT USED)
- 1 EA CLOSER LCN 4041 x 18
- 2 EA HINGES OFFSET PIVOT ANSI -A-156.4 GRADE 1; PROVIDE EXPOSED PARTS OF ALUMINUM ALLOY AS SUPPLIED BY DOOR MANUFACTURER.
- 3 EA DOOR #1 ONLY PULL HANDLE ROUGHWOOD MFG. MODEL RM3301 SIZE: 1-1/4" DIA. OTC. 5"-10" FINISH; TO MATCH STOREFRONT DOOR, OFFSET MOUNTING TYPE 1X4D - THRU BOLT HEAVY DUTY
- 4 EA PANIC HARDWARE ADAMS RITE MFG. CO. 8800 SERIES WITH OUTSIDE CYLINDER (FINISH TO MATCH STOREFRONT DOOR).
- 5 EA THRESHOLD NATIONAL GUARD PRODUCTS, INC. SADDLE TYPE THRESHOLD 325, 36" WIDE X 1/2" RISE (ADA ACCESSIBLE).
- 6 EA WEATHER STRIPPING: PROVIDE COMPRESSION WEATHER STRIPPING AGAINST FIXED STOPS. AT OTHER EDGES PROVIDE SLIDING WEATHER STRIPPING RETAINED IN ADJUSTABLE STRIP MORTISED INTO DOOR EDGE. PROVIDE EPDM OR VINYL GASKET WEATHER STRIPPING IN BOTTOM EDGE AND ADJUSTABLE FOR CONTACT W/ THRESHOLD.
- 7 EA SIGN MOUNT ONTO DOOR, READ "THIS DOOR MUST REMAIN UNLOCKED WHENEVER THE DOOR IS OCCUPIED/DURING BUSINESS HOURS."
- DOOR #2 - VESTIBULE
- 1 EA CLOSER LCN 4041 x 18
- 2 EA HINGES OFFSET PIVOT ANSI -A-156.4 GRADE 1; BY DOOR MANUFACTURER.
- 3 EA PUSH/PULL HANDLE HAGER PUSH/PULL SET 1640/V/B.
- DOOR #3 - STORAGE DELIVERY
- 1 EA HINGE 780-112HD 83" ALUM HAGER
- 2 EA CLOSER 4111 H-CUSH ALUM LCN
- 3 EA PANIC 99750-LD 48" SP28 V.DURPRIN
- 4 EA TRIM 990DT US260 V.DURPRIN
- 5 EA EXIT ALARM FAX2500 FLUSH DETEX
- 6 EA LOCKGUARD CLP110 US320 DON-JO
- 7 EA TREADPLATE 24 X 46 UMCO
- 8 EA WTH/STP160V 48 X 84 N.GUARD
- 9 EA THRESHOLD 325HD 48" N.GUARD
- 10 EA SWEEP 101VA 48" N.GUARD
- 11 EA VIEW FRAME LVGLFD 9 X 9 DKB W/FLAP ON INSIDE N.GUARD
- DOOR #3A - FREEZER DELIVERY
- 1 EA HINGE 780-112HD 83" ALUM HAGER
- 2 EA DEADBOLT B661P 626 SCHLAGE
- 3 EA FULL W/H US260 HAGER
- 4 EA LOCKGUARD CLP110 US320 DON-JO
- 5 EA TREADPLATE 24 X 46 UMCO
- 6 EA WTH/STP160V 48 X 84 N.GUARD
- 7 EA THRESHOLD 325HD 48" N.GUARD
- 8 EA SWEEP 101VA 48" N.GUARD
- DOOR #4 - REAR EXIT
- 1 EA HINGE 780-112HD 83" ALUM HAGER
- 2 EA CLOSER 4111 H-CUSH ALUM LCN
- 3 EA PANIC 99750-LD 36" SP28 V.DURPRIN
- 4 EA TRIM 990DT US260 V.DURPRIN
- 5 EA EXIT ALARM FAX2500 FLUSH DETEX
- 6 EA LOCKGUARD CLP110 US320 DON-JO
- 7 EA TREADPLATE 24 X 34 UMCO
- 8 EA WTH/STP160V 36 X 84 N.GUARD
- 9 EA THRESHOLD 325HD 36" N.GUARD
- 10 EA SWEEP 101VA 36" N.GUARD
- 11 EA VIEW FRAME LVGLFD 9 X 9 DKB W/FLAP ON INSIDE N.GUARD

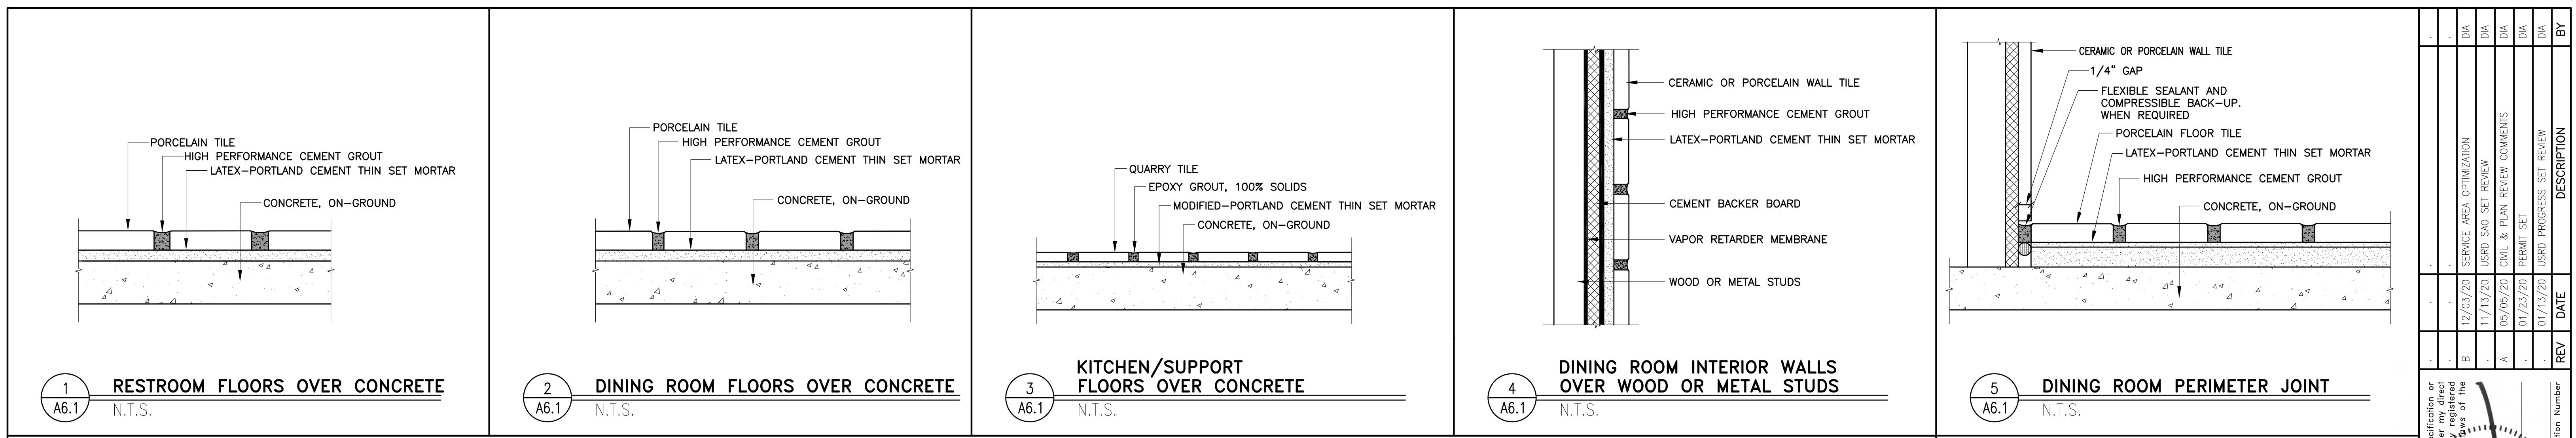



WALL TILE SCHEDULE					
MARK	ROOM NAME	WALL	MORTAR SETTING BED	GROUT	
100	CUSTOMER SERVICE	CERAMIC OR PORCELAIN WALL TILE (NOTE 4C)	LATEX-PORTLAND CEMENT THIN SET (MEDIUM BED)	HIGH PERFORMANCE CEMENT GROUT	GENERAL TILE NOTES: 1. REFERENCE: 2017 MCDONALD'S PROJECT MANUAL - SECTION 093000
101	DINING	CERAMIC OR PORCELAIN WALL TILE (NOTE 4B & 4C)	LATEX-PORTLAND CEMENT THIN SET (MEDIUM BED)	HIGH PERFORMANCE CEMENT GROUT	2. KITCHEN FLOOR TILE: TILE: CROSSVILLE 6"x6" "METROPOLITAN QUARRY BASICS ABRASIVE" GROUT: CHARCOAL #47 BY MAPEI KERAPOXY IEG BLACK #10 BY MAPEI (FOR OPTIONAL GREY TILE) COLOR: PURITAN GRAY EXTRA ABRASIVE 57XA (STANDARD) MAYFLOWER RED 31XA (OPTIONAL) - VERIFY W/ MCDONALD'S ACM
102	WOMEN'S TOILET	CERAMIC OR PORCELAIN WALL TILE (NOTE 4B)	LATEX-PORTLAND CEMENT THIN SET (MEDIUM BED)	HIGH PERFORMANCE CEMENT GROUT	3. DINING ROOM FLOOR TILE: MAIN & ACCENT: USE ONLY APPROVED TILE SERIES AND COLORS BY CROSSVILLE AND EUROWEST. VERIFY COLOR AND PATTERN PER INTERIOR DECOR DRAWINGS. A) MUST BE PER MCDONALD'S USA, LLC: STANDARDS FOR INTERIOR FLOOR TILE AND APPROVED TILE LIST. B) MUST MEET THE FOLLOWING: STATIC COEFFICIENT OF FRICTION (PER ASTM F1667-96) LEVEL SURFACES: MINIMUM 0.50 DRY AND WET (MCDONALD'S STANDARD) DYNAMIC COEFFICIENT OF FRICTION (PER ANSI A137.1 2012) LEVEL SURFACES: MINIMUM 0.5 DRY AND WET (MCDONALD'S STANDARD)
103	MEN'S TOILET	CERAMIC OR PORCELAIN WALL TILE (NOTE 4B)	LATEX-PORTLAND CEMENT THIN SET (MEDIUM BED)	HIGH PERFORMANCE CEMENT GROUT	4. TILE TRANSITION AND EDGE PROTECTION: A) TILE BASE (RESTROOM ONLY): SCHLUTER DILEX-AHK SERIES, BRUSHED STAINLESS STEEL. B) TILE EDGE PROTECTION (WALL TRANSITION): SCHLUTER-RONDEC-DB, SATIN ANODIZED ALUMINUM. C) TILE CORNER PROTECTION (OUTSIDE CORNER): SCHLUTER-RONDEC-AE, SATIN ANODIZED ALUMINUM. D) SEE INTERIOR DECOR DRAWINGS FOR ALL LOCATIONS.
104	SUPPORT	QUARRY TILE (NOTE 2)	COVED QUARRY TILE	MODIFIED-PORTLAND CEMENT THIN SET MORTAR (MEDIUM BED)	BEFORE FINAL INSPECTION, REMOVE PROTECTIVE COVERINGS AND PERFORM FINAL CLEANING.
105	KITCHEN	QUARRY TILE (NOTE 2)	COVED QUARRY TILE	MODIFIED-PORTLAND CEMENT THIN SET MORTAR (MEDIUM BED)	5. TILE CLEANER: DETERDEK, BY FILA SURFACE CARE PRODUCTS - NO SUBSTITUTIONS ALLOWED CAN BE ORDERED BY EUROWEST, CROSSVILLE, OR DIRECT FROM MANUFACTURER: FILA/DETREK POST INSTALLATION CLEANING REQUIRED ON ALL FLOOR TILE INSTALLATIONS PRIOR TO RESTAURANT TURN OVER.
106	PRESENTER-1	QUARRY TILE (NOTE 2)	COVED QUARRY TILE	MODIFIED-PORTLAND CEMENT THIN SET MORTAR (MEDIUM BED)	APPLY CLEANER PER MANUFACTURER'S WRITTEN INSTRUCTIONS. REFERENCE: MCDONALD'S PROJECT MANUAL - SECTION 09300 TILING INTERIOR.
107	ORDER	QUARRY TILE (NOTE 2)	COVED QUARRY TILE	MODIFIED-PORTLAND CEMENT THIN SET MORTAR (MEDIUM BED)	6. GROUT COLOR AND MANUFACTURER AS INDICATED ON SHEET A1.0 AND INTERIOR DECOR DRAWINGS.
108	MANAGER'S AREA	QUARRY TILE (NOTE 2)	COVED QUARRY TILE	MODIFIED-PORTLAND CEMENT THIN SET MORTAR (MEDIUM BED)	
109	CREW ROOM	QUARRY TILE (NOTE 2)	COVED QUARRY TILE	MODIFIED-PORTLAND CEMENT THIN SET MORTAR (MEDIUM BED)	
110	COOLER	QUARRY TILE (NOTE 2)	4" ALUM. COVED BASE	MODIFIED-PORTLAND CEMENT THIN SET MORTAR (MEDIUM BED)	
111	FREEZER	QUARRY TILE (NOTE 2)	4" ALUM. COVED BASE	MODIFIED-PORTLAND CEMENT THIN SET MORTAR (MEDIUM BED)	
112	COMPUTER CLOSET	QUARRY TILE (NOTE 2)	COVED QUARRY TILE	MODIFIED-PORTLAND CEMENT THIN SET MORTAR (MEDIUM BED)	
113	CREW ALCOVE	QUARRY TILE (NOTE 2)	COVED QUARRY TILE	MODIFIED-PORTLAND CEMENT THIN SET MORTAR (MEDIUM BED)	
114	JANITOR'S CLOSET	PORCELAIN FLOOR TILE (NOTE 3)	COVED QUARRY TILE	LATEX-PORTLAND CEMENT THIN SET (MEDIUM BED)	
115	VESTIBULE	PORCELAIN FLOOR TILE (NOTE 3)	NONE - WALL TILE	LATEX-PORTLAND CEMENT THIN SET (MEDIUM BED)	
116	PRESENTER-2	PORCELAIN FLOOR TILE (NOTE 3)	COVED QUARRY TILE	LATEX-PORTLAND CEMENT THIN SET (MEDIUM BED)	
117	CO2	N/A - SEE ROOM FINISH SCHEDULE	---	MODIFIED-PORTLAND CEMENT THIN SET MORTAR (MEDIUM BED)	


ROOM FINISH SCHEDULE					
MARK	ROOM NAME	WALLS	CEILING *	REMARKS	
100	CUSTOMER SERVICE	CEMENT BOARD	TILE **	SEE DECOR DRAWINGS, TILE AS NOTED ON A1.0	GENERAL FINISH NOTES: 1. ALL FINISH SURFACES OF WALL AND CEILING MATERIALS SHALL BE CLASS B AND SHALL HAVE A FLAME SPREAD RATING OF 26 TO 75 AND A SMOKE DENSITY OF 450 MAX. (PER IBC TABLE 803.9). 2. DECORATIVE MATERIALS SHALL BE FLAME RETARDANT AND MEET THE CRITERIA OF NFPA 701. 3. DECORATIVE MATERIAL SHALL NOT CONCEAL EXITS, EXIT LIGHTS, ALARM STATIONS, HOSE CABINETS, AND EXTINGUISHER LOCATIONS. 4. WHEN BUILDING TYPE IS A NON-COMBUSTIBLE CATEGORY, ALL PLYWOOD SHALL BE FIRE RETARDANT TREATED. 5. A. FRP OVER CEMENT BD BEHIND 3-COMP SINK TO HGT OF BACK SPASH. B. TILE WAINTSCOT TO 6' A.F.F. OVER CEMENT BD. OVER EXT GRADE PLYWOOD (NOTE 4) AT MOP SINKS 6. PROVIDE CEMENT BOARD BACKER OR EQUIVALENT AT ALL TILE LOCATIONS. 7. PROVIDE VAPOR BARRIER BEHIND PLYWOOD AT WALLS AND BEHIND GYP. AT CEILING * SEE CEILING PLAN FOR HEIGHTS & LAYOUTS ** WVC ON EXTERIOR WALL ASSEMBLIES TO BE PERFORATED
101	DINING	CEM BD/GYP BD	TILE/V.W.C. **	SEE DECOR DRAWINGS FOR EXTENT	
102	WOMEN'S TOILET	CEMENT BOARD	TILE	SEE DECOR DRAWINGS FOR EXTENT	
103	MEN'S TOILET	CEMENT BOARD	TILE	SEE DECOR DRAWINGS FOR EXTENT	
104	SUPPORT	1/2" PLYWD (NOTE 4)	FRP	STAINLESS STEEL CORNERS	SEE SHEET A1.0 FOR EXTENT OF CEMENT BOARD, SS OR CT
105	KITCHEN	1/2" PLYWD (NOTE 4)	FRP	STAINLESS STEEL CORNERS, TILE OVER CEM BD AS NOTED ON A1.0	
106	PRESENTER-1	CEM BD, 1/2" PLYWD (NOTE 4)	TILE	TILE AS NOTED ON A1.0	
107	ORDER	1/2" PLYWD (NOTE 4)	FRP	2'x2' VINYL-FACED LAY-IN	
108	MANAGER'S AREA	1/2" PLYWD (NOTE 4)	FRP	2'x2' VINYL-FACED LAY-IN	
109	CREW ROOM	CEM BD/GYP BD	TILE/V.W.C. **	2'x2' ACOUST. LAY-IN	
110	COOLER	N/A	PRE-FAB METAL SKIN PANEL	SEE DECOR DRAWINGS FOR EXTENT	
111	FREEZER	N/A	PRE-FAB METAL SKIN PANEL	PRE-FAB METAL SKIN PANEL	
112	COMPUTER CLOSET	1/2" PLYWD (NOTE 4)	FRP	PRE-FAB METAL SKIN PANEL	
113	CREW ALCOVE	1/2" PLYWD (NOTE 4)	FRP	PAINTED GYP. BD.	SEE SHEET A1.0 FOR EXTENT OF CEMENT BOARD, SS OR CT
114	JANITOR'S CLOSET	1/2" PLYWD (NOTE 4)	FRP	STAINLESS STEEL CORNERS, TILE OVER CEM BD AS NOTED ON A1.0	EXT GRADE PLYWOOD (NOTE 4) SEE NOTE 5B
115	VESTIBULE	CEM BD/GYP BD	TILE/V.W.C. **	SEE DECOR DRAWINGS FOR EXTENT	OPTIONAL PEDIMAT. SEE DETAIL 7/A6.1. VERIFY WITH MCD CONSTRUCTION MANGER
116	PRESENTER-2	CEM BD, 1/2" PLYWD (NOTE 4)	TILE	TILE AS NOTED ON A1.0	2'x2' VINYL-FACED LAY-IN
117	CO2	1/2" PLYWD (NOTE 4)	FRP	PAINTED GYP. BD.	2'x2' VINYL-FACED LAY-IN



I hereby certify that this drawing, specification or
report was prepared under my direction
and supervision by [Signature] under the laws of the
State of [State].

PREPARED BY:	12/03/20	SERVICE AREA OPTIMIZATION	DA	
BY:	B	11/15/20	USD SAO SET REVIEW	DA
BY:	A	05/05/20	CIVIL & PLAN REVIEW COMMENTS	DA
BY:	C	01/23/20	PERMIT SET	DA
BY:	D	01/13/20	USD PROGRESS SET REVIEW	DA
BY:	E	12/03/20	DESIGN	DA
McDonald's USA, LLC	12400 ARCHITECTURE & PLANNING, PORTLAND AVENUE SOUTH, BURNSVILLE, MN 55337 PHONE: (952) 252-4042 FAX: (952) 252-4943	© McDonald's USA, LLC	McDonald's USA, LLC Architects, Inc.	Signature: [Signature]
PREPARED FOR:	McDonald's USA, LLC	McDonald's USA, LLC Architects, Inc.	Design	Design
DRAWN BY:	DIA	12400 ARCHITECTURE & PLANNING, PORTLAND AVENUE SOUTH, BURNSVILLE, MN 55337 EMAIL: DATAREP@DESIGN.COM PHONE: (952) 252-4042 FAX: (952) 252-4943	McDonald's USA, LLC Architects, Inc.	Design
STD ISSUE DATE:	2019-11	These drawings and specifications are the confidential and proprietary property of McDonald's USA, LLC and shall not be copied or otherwise reproduced without the express written conjunction with its issue date and are not suitable for use on any other project. These drawings and specifications are intended for use on this specific project only. Any unauthorized use or disclosure of these drawings and specifications is strictly prohibited.	McDonald's USA, LLC Architects, Inc.	Design
REVIEWED BY:	KO	McDonald's USA, LLC Architects, Inc.	Design	Design
DATE ISSUED:	01/23/20	McDonald's USA, LLC Architects, Inc.	Design	Design
SITE ADDRESS:	605 SOUTH 7TH STREET, KANSAS CITY, KS 015-0071	McDonald's USA, LLC Architects, Inc.	Design	Design
SHEET NO.:	2019 STANDARD BUILDING - BB20 459710-WOOD/WOOD	McDonald's USA, LLC Architects, Inc.	Design	Design
DESCRIPTION:	WOOD BEARING WALLS W/FIBER CEMENT SIDING & CI WOOD ROOF TRUSS FRAMING FIBER CEMENT PANEL/BALFOUR PANEL/BRICK EXTR. FINISH	McDonald's USA, LLC Architects, Inc.	Design	Design
NOTE:	SEE A1.0 FOR PARTITION TYPE AND ROOM FINISH SCHEDULE FOR WALL FINISH	McDonald's USA, LLC Architects, Inc.	Design	Design
RECESSED MOP SINK. SEE STRUCTURAL DRAWINGS FOR SIZE AND LOCATION	1 1/2"	McDonald's USA, LLC Architects, Inc.	Design	Design
WATERPROOF MEMBRANE TO BE APPLIED AT SUMP AREA AND 1'-0" PERIMETER AT JOINING FLOOR AND WALL AREAS	6'	McDonald's USA, LLC Architects, Inc.	Design	Design
PRE-FAB MOP SINK BY ADVANCE TABCO AVAILABLE AS AN ALTERNATE OPTION. SEE PA1 WHERE PRE-FAB MOP SINK USED. (DEPTH TO BE 8-7/8" TO ACCOMMODATE FACTORY BUILT MOP SINK DIMENSIONS.)	1 1/2" = 1'-0"	McDonald's USA, LLC Architects, Inc.	Design	Design
SEE PLUMBING DRAWINGS FOR DRAIN SPECIFICATION	8	McDonald's USA, LLC Architects, Inc.	Design	Design
MOP SINK	A6.1	McDonald's USA, LLC Architects, Inc.	Design	Design
FINISH SCHEDULES	A6.1	McDonald's USA, LLC Architects, Inc.	Design	Design

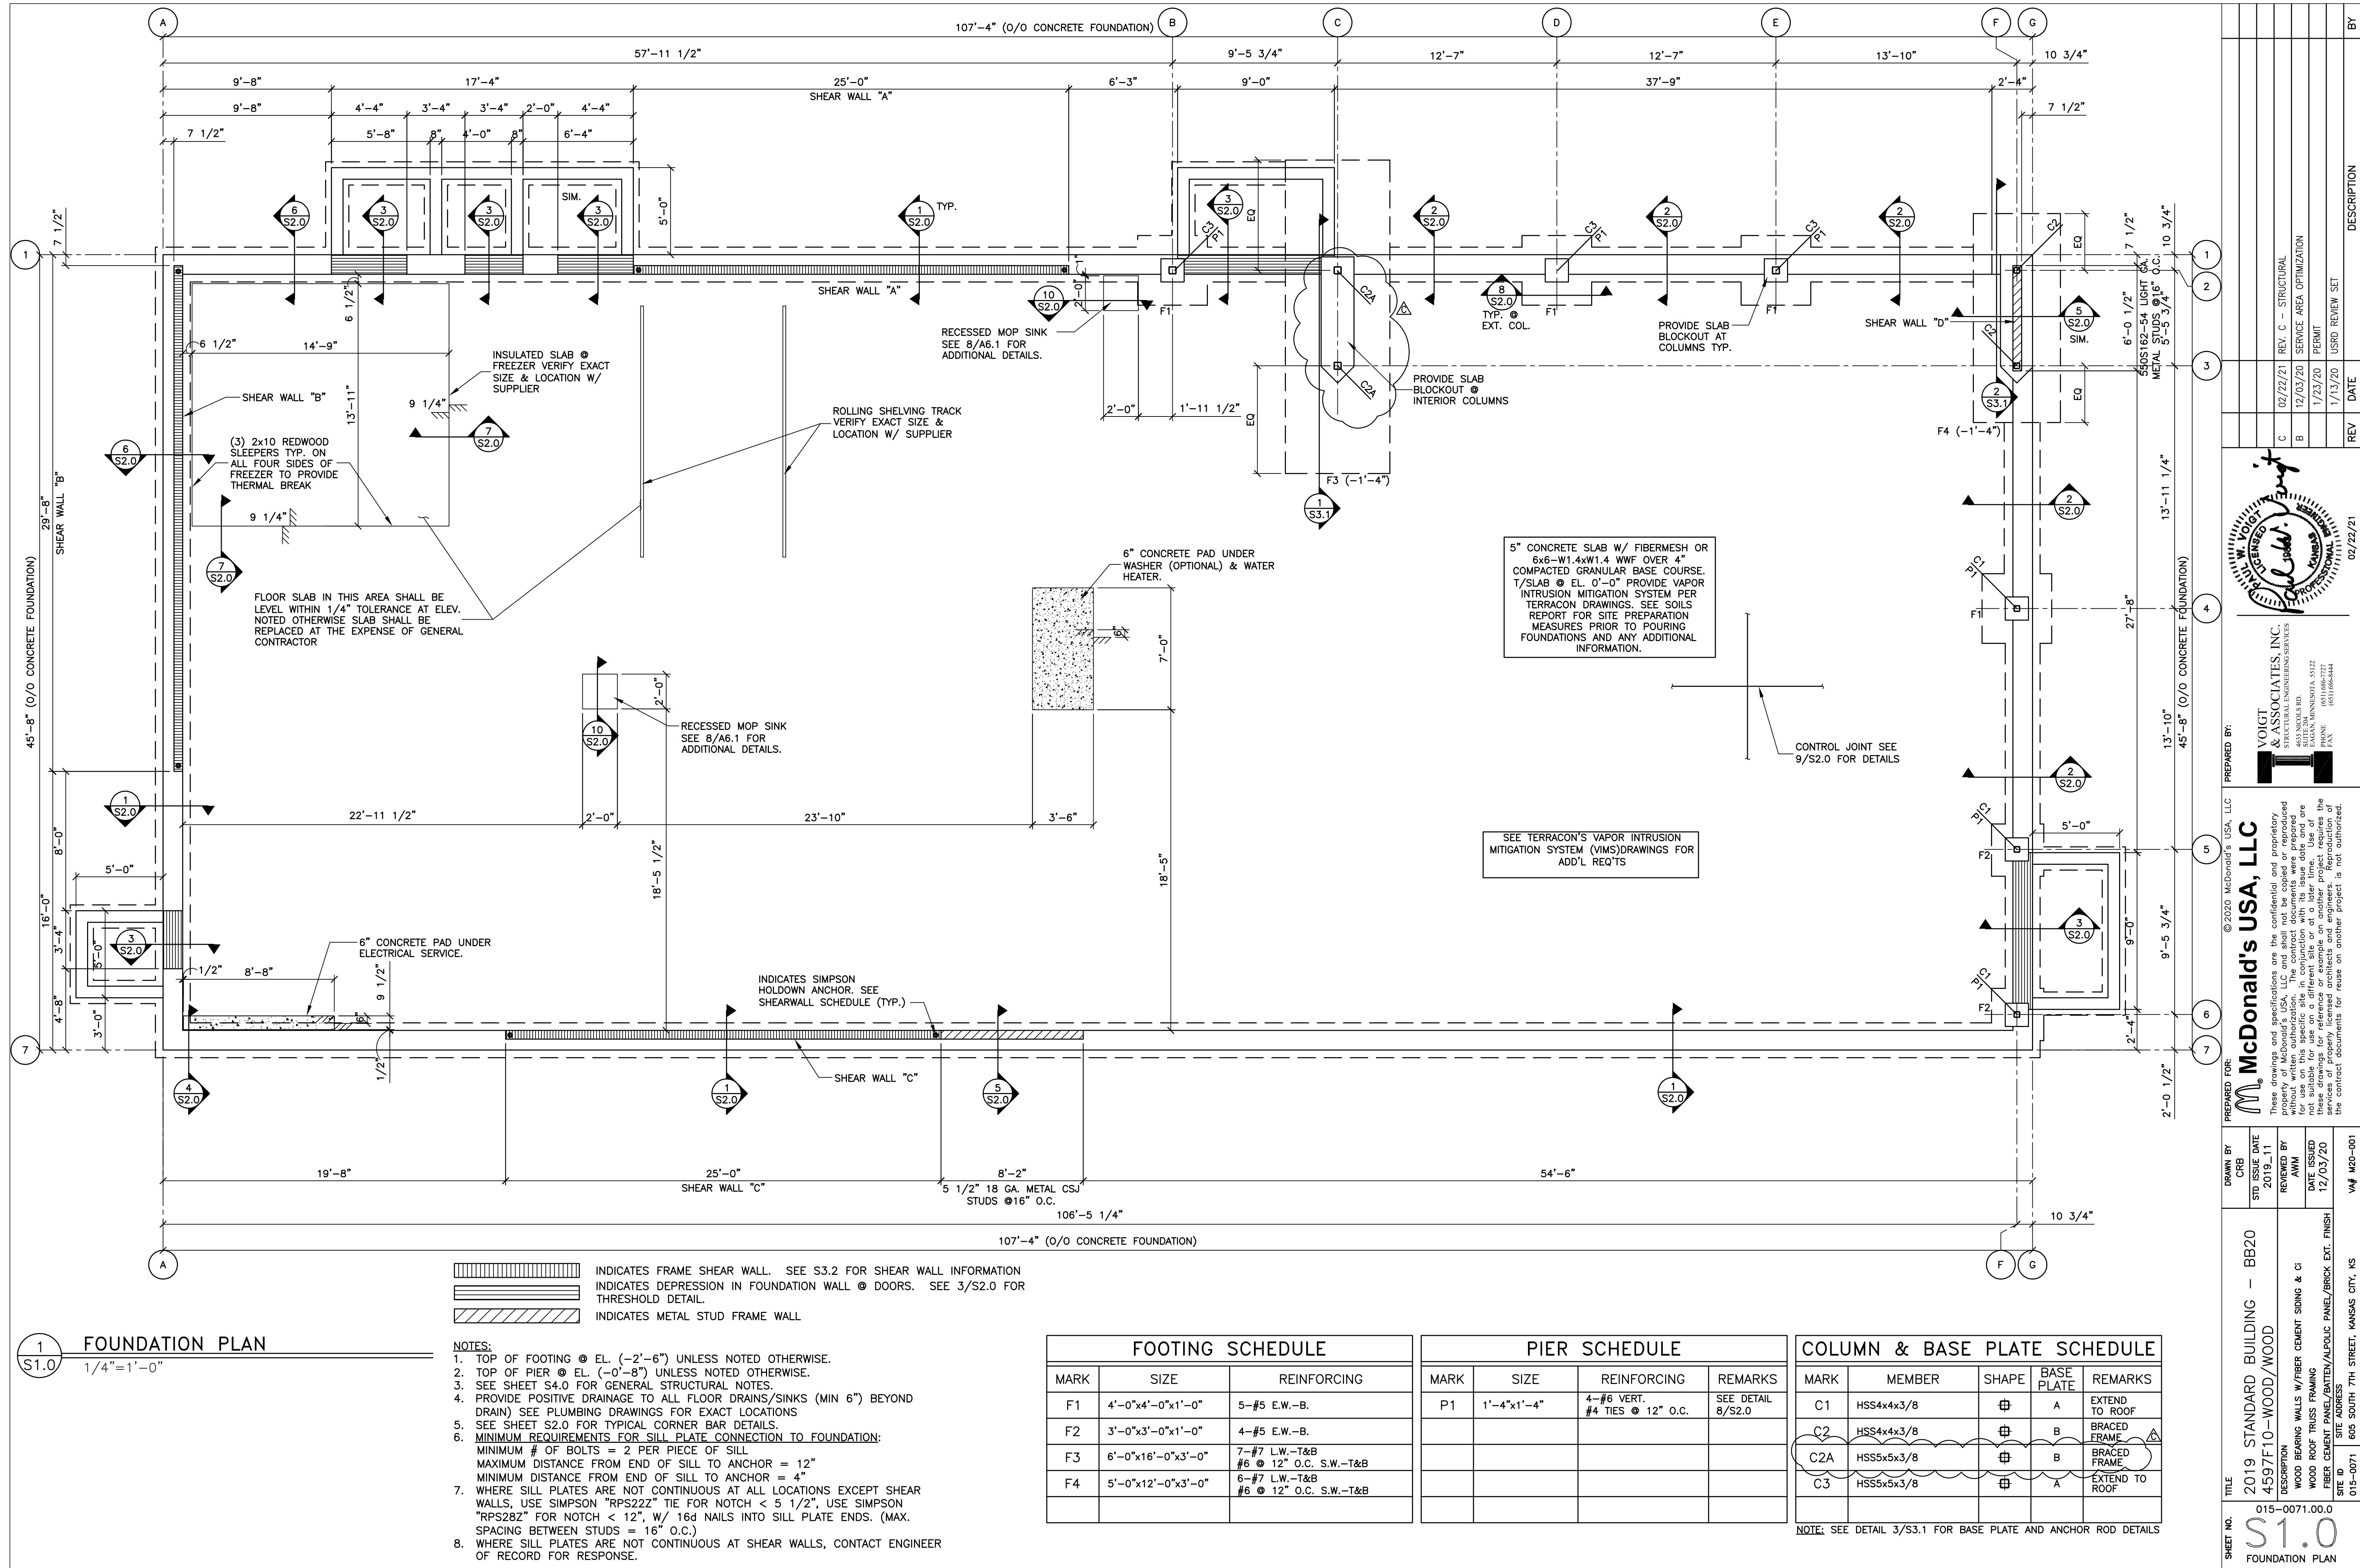


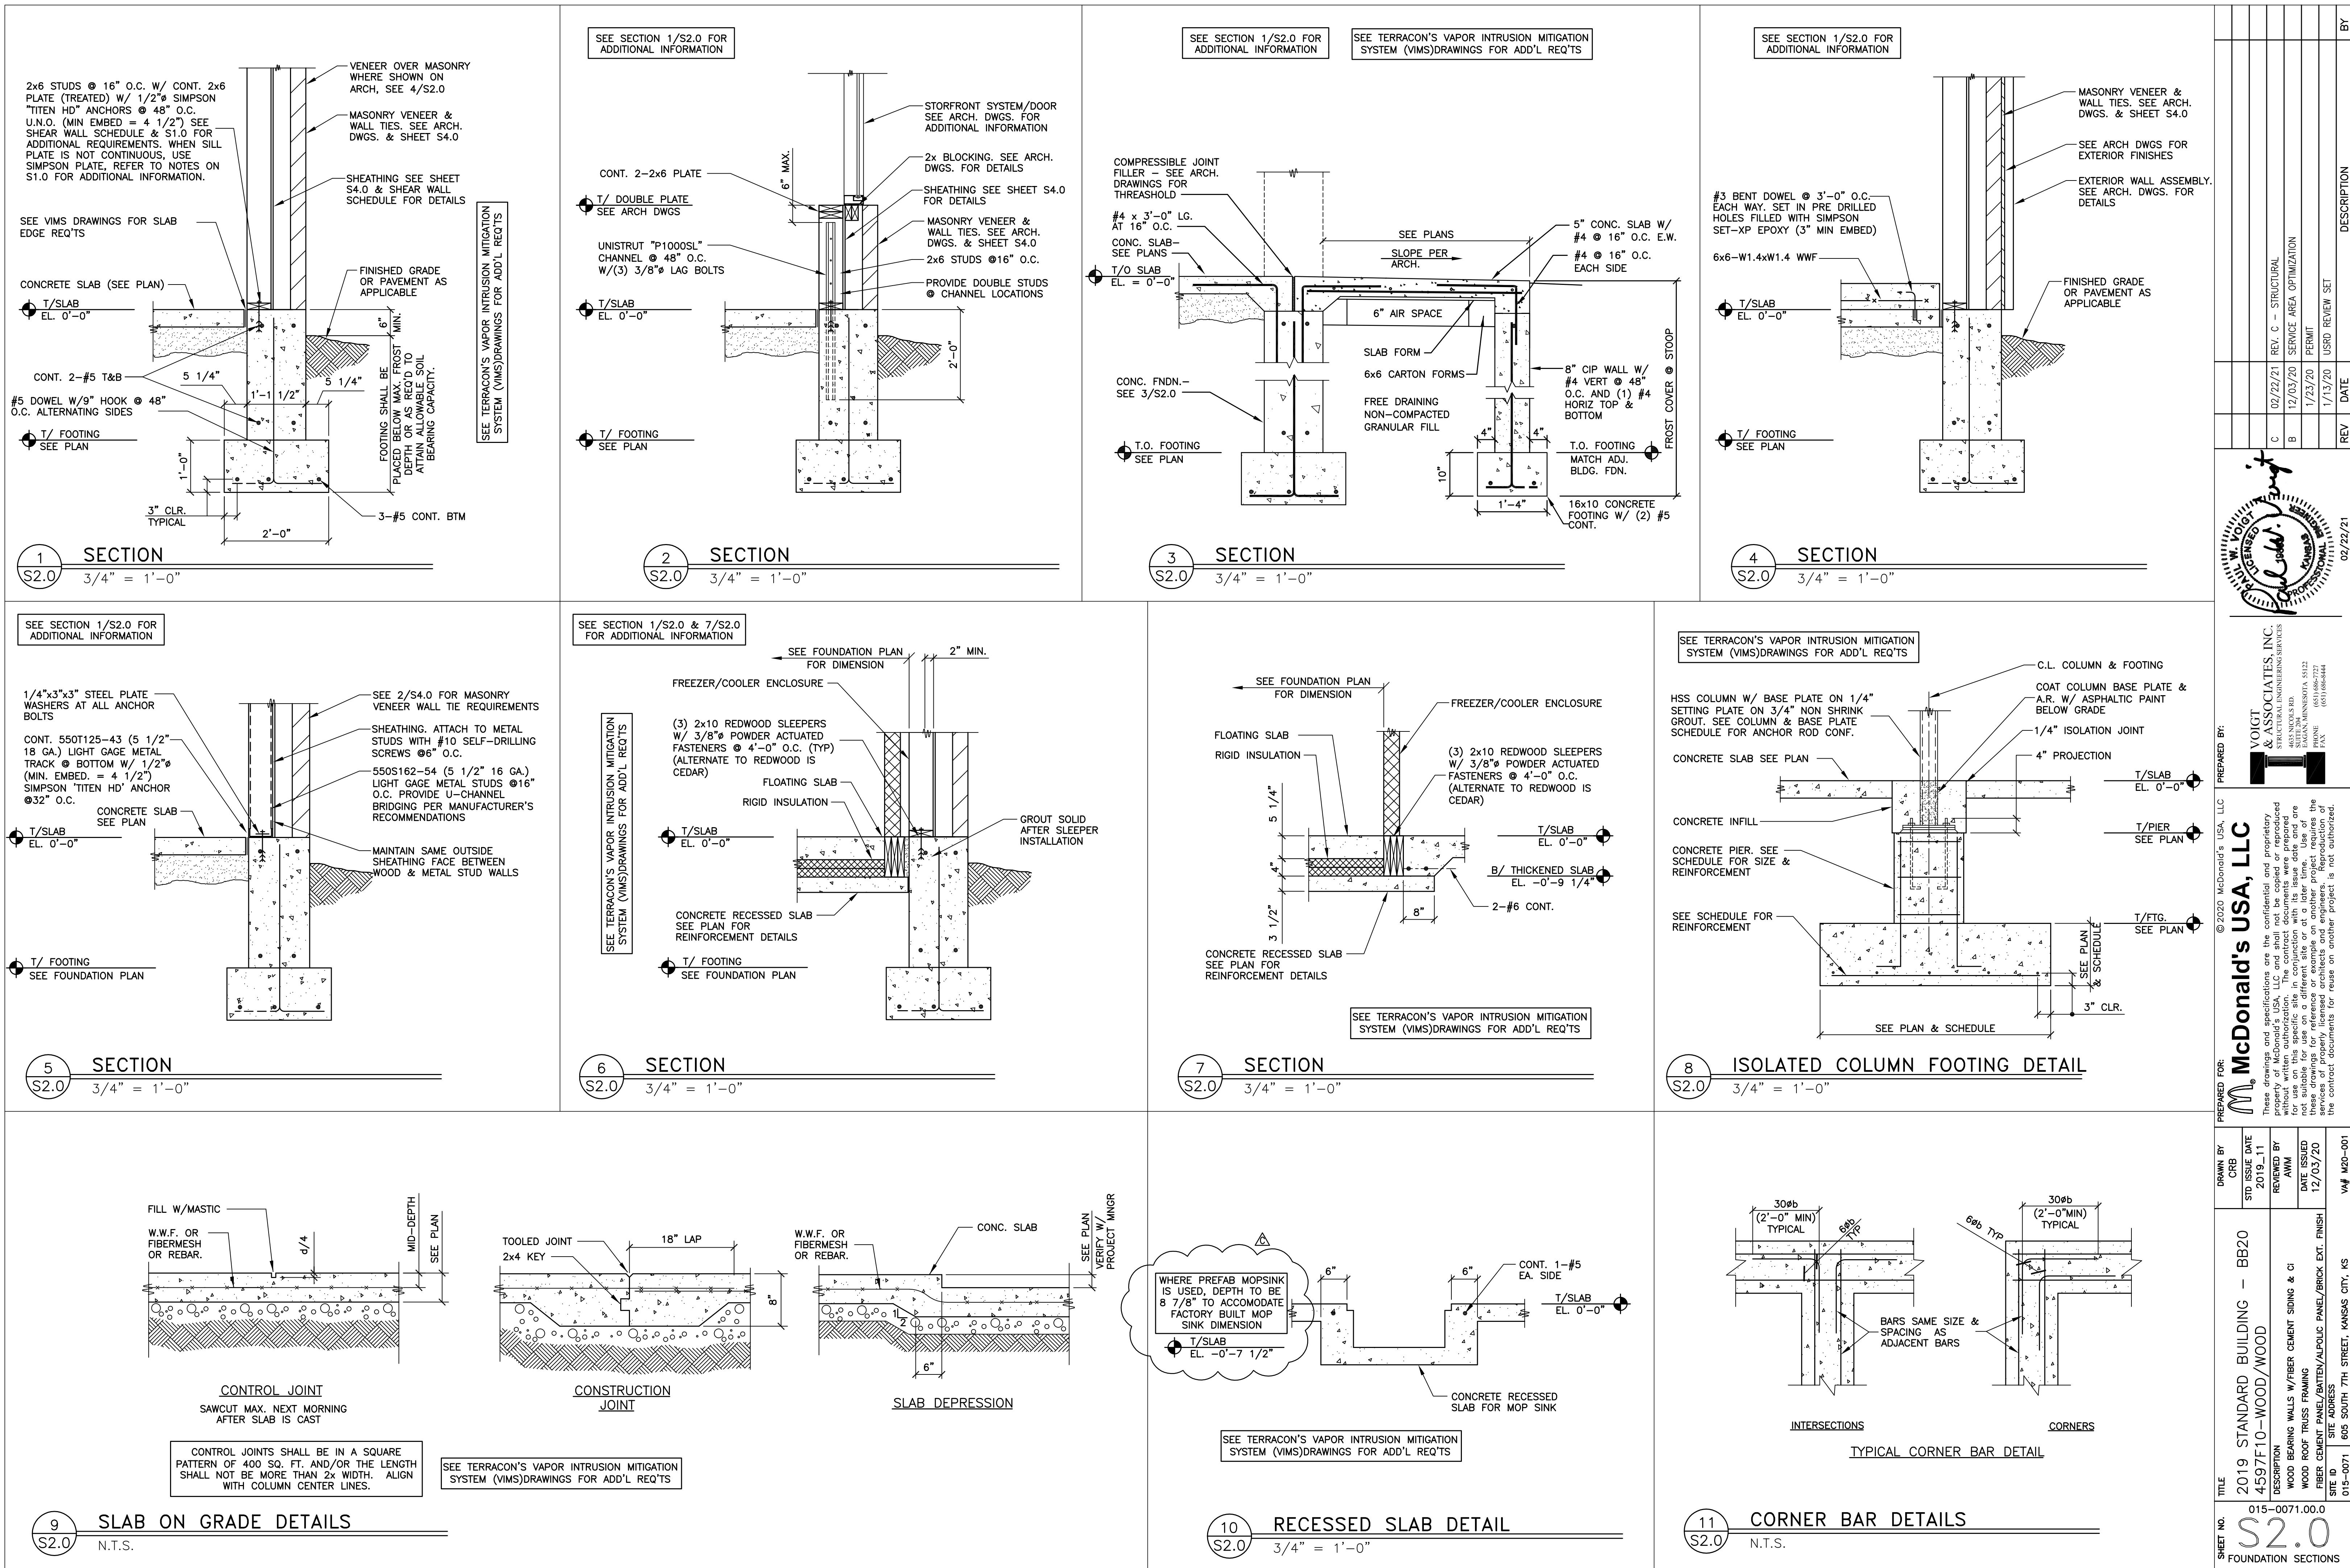

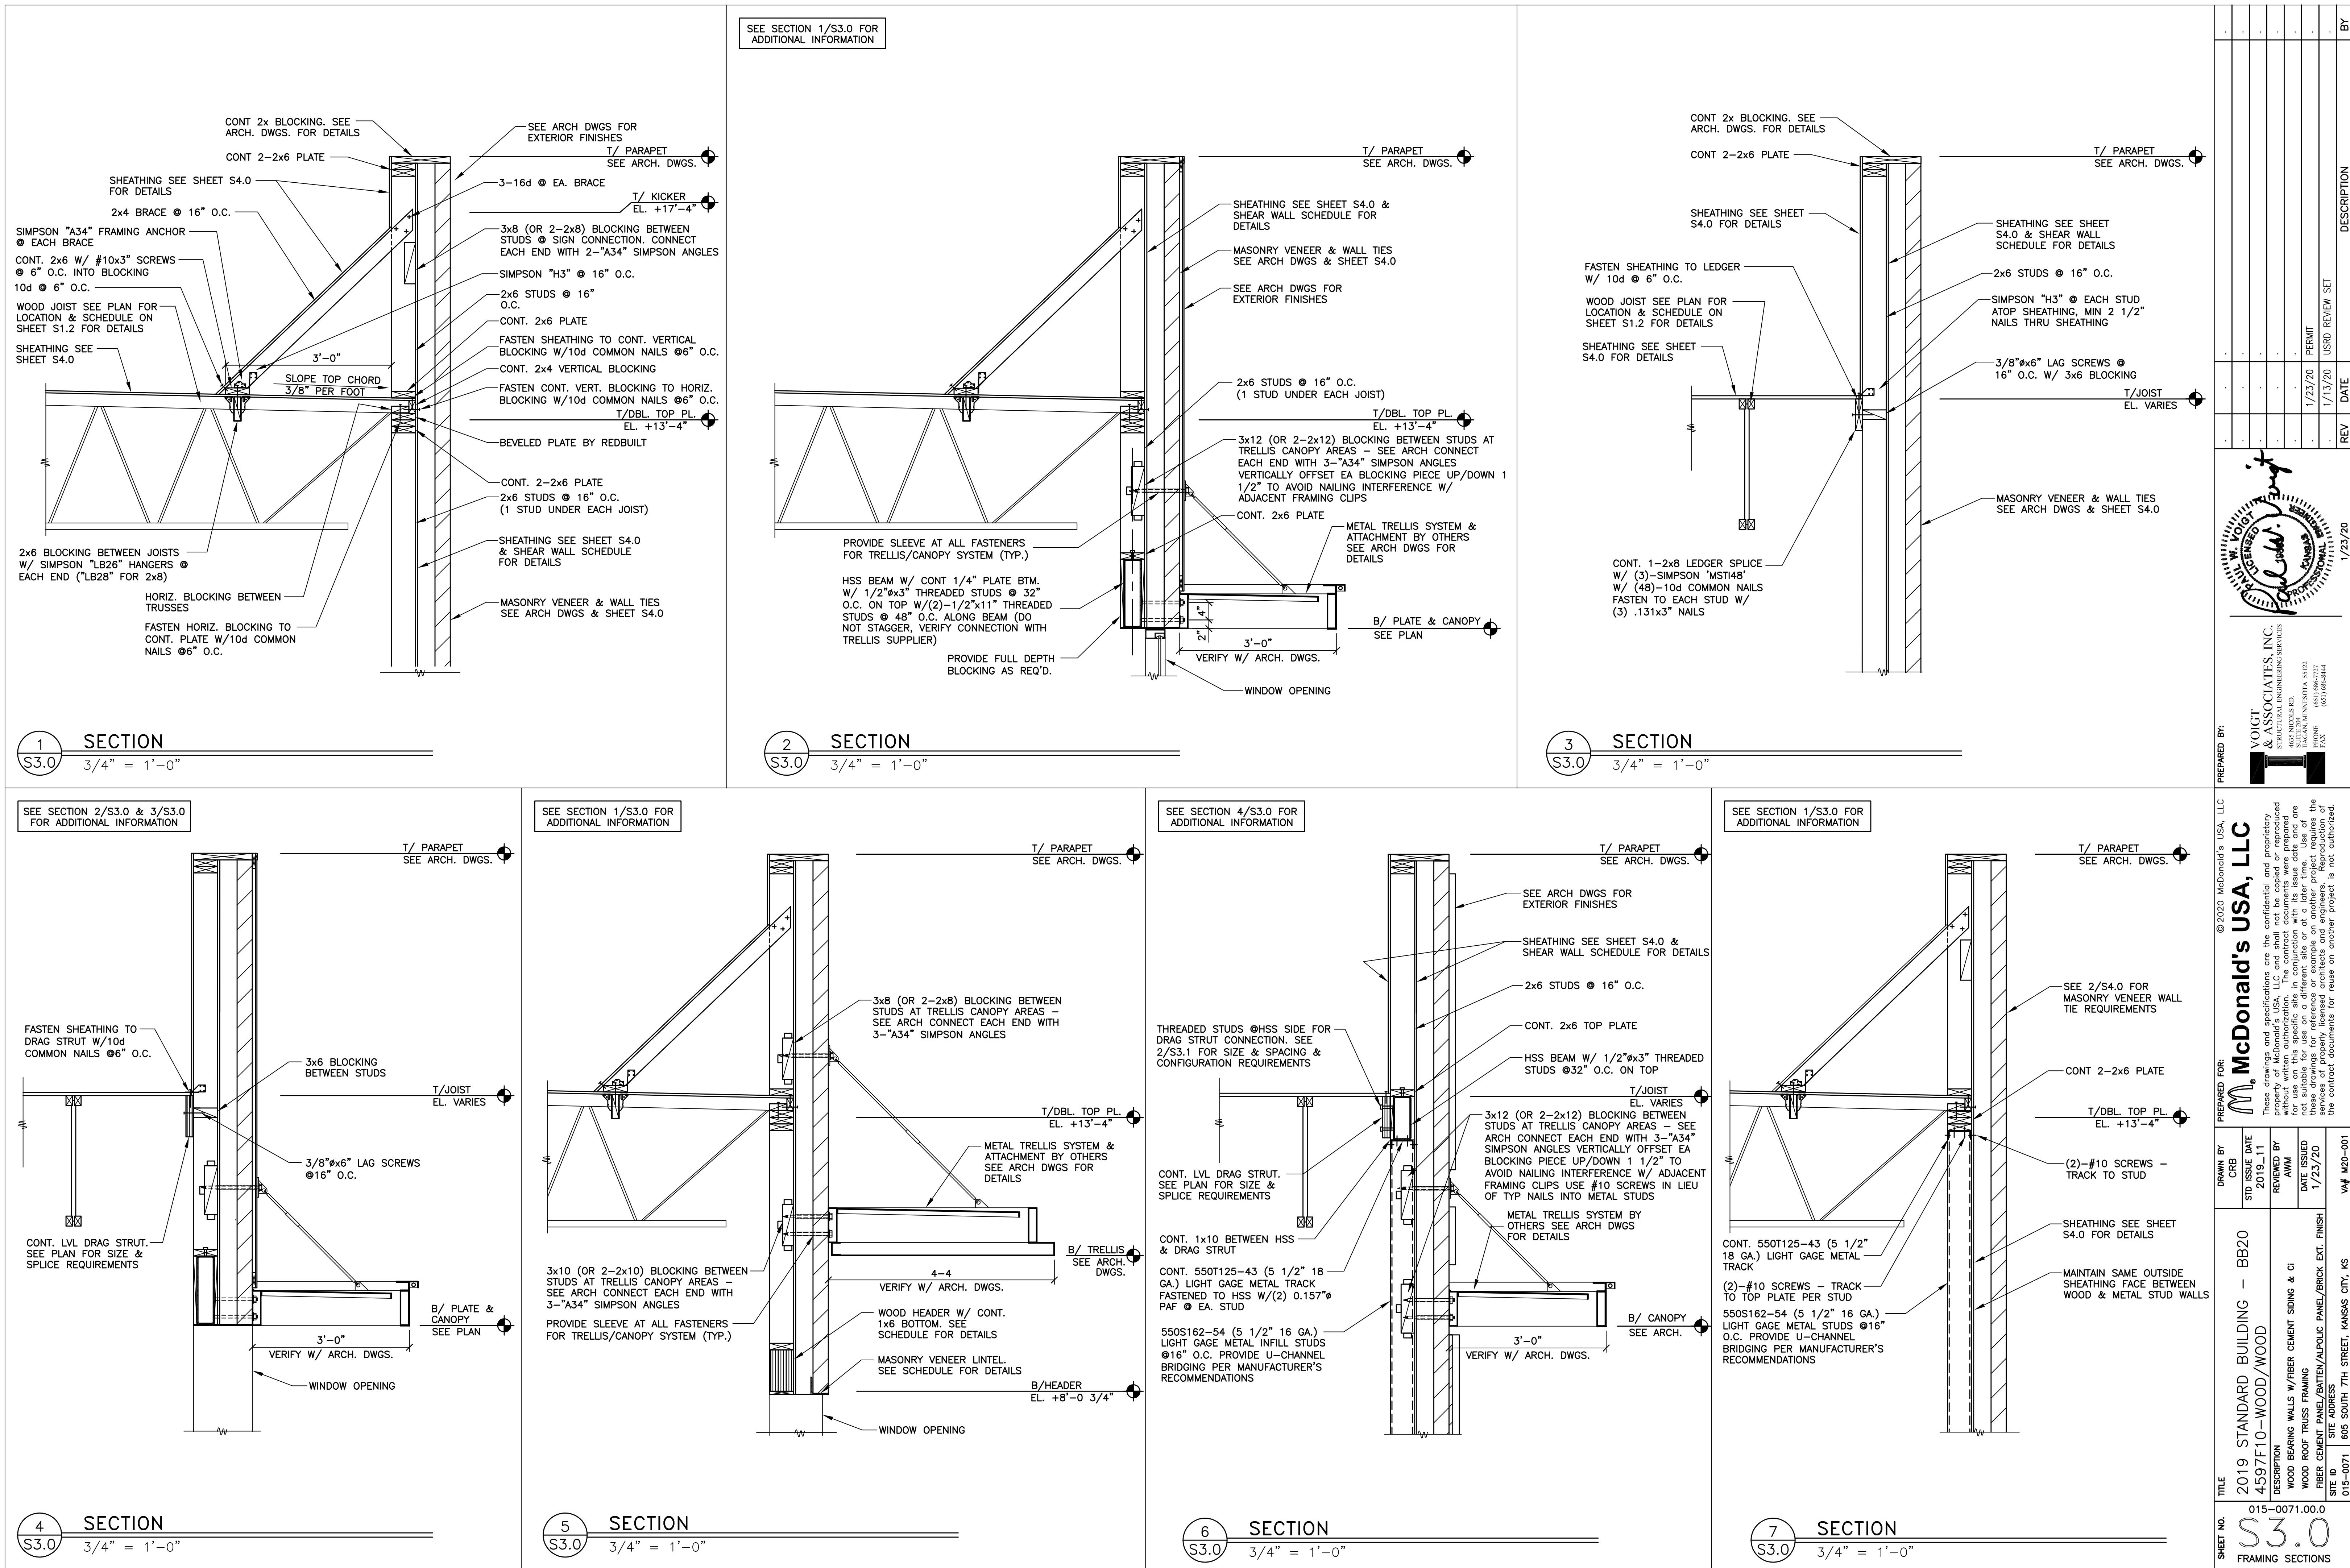

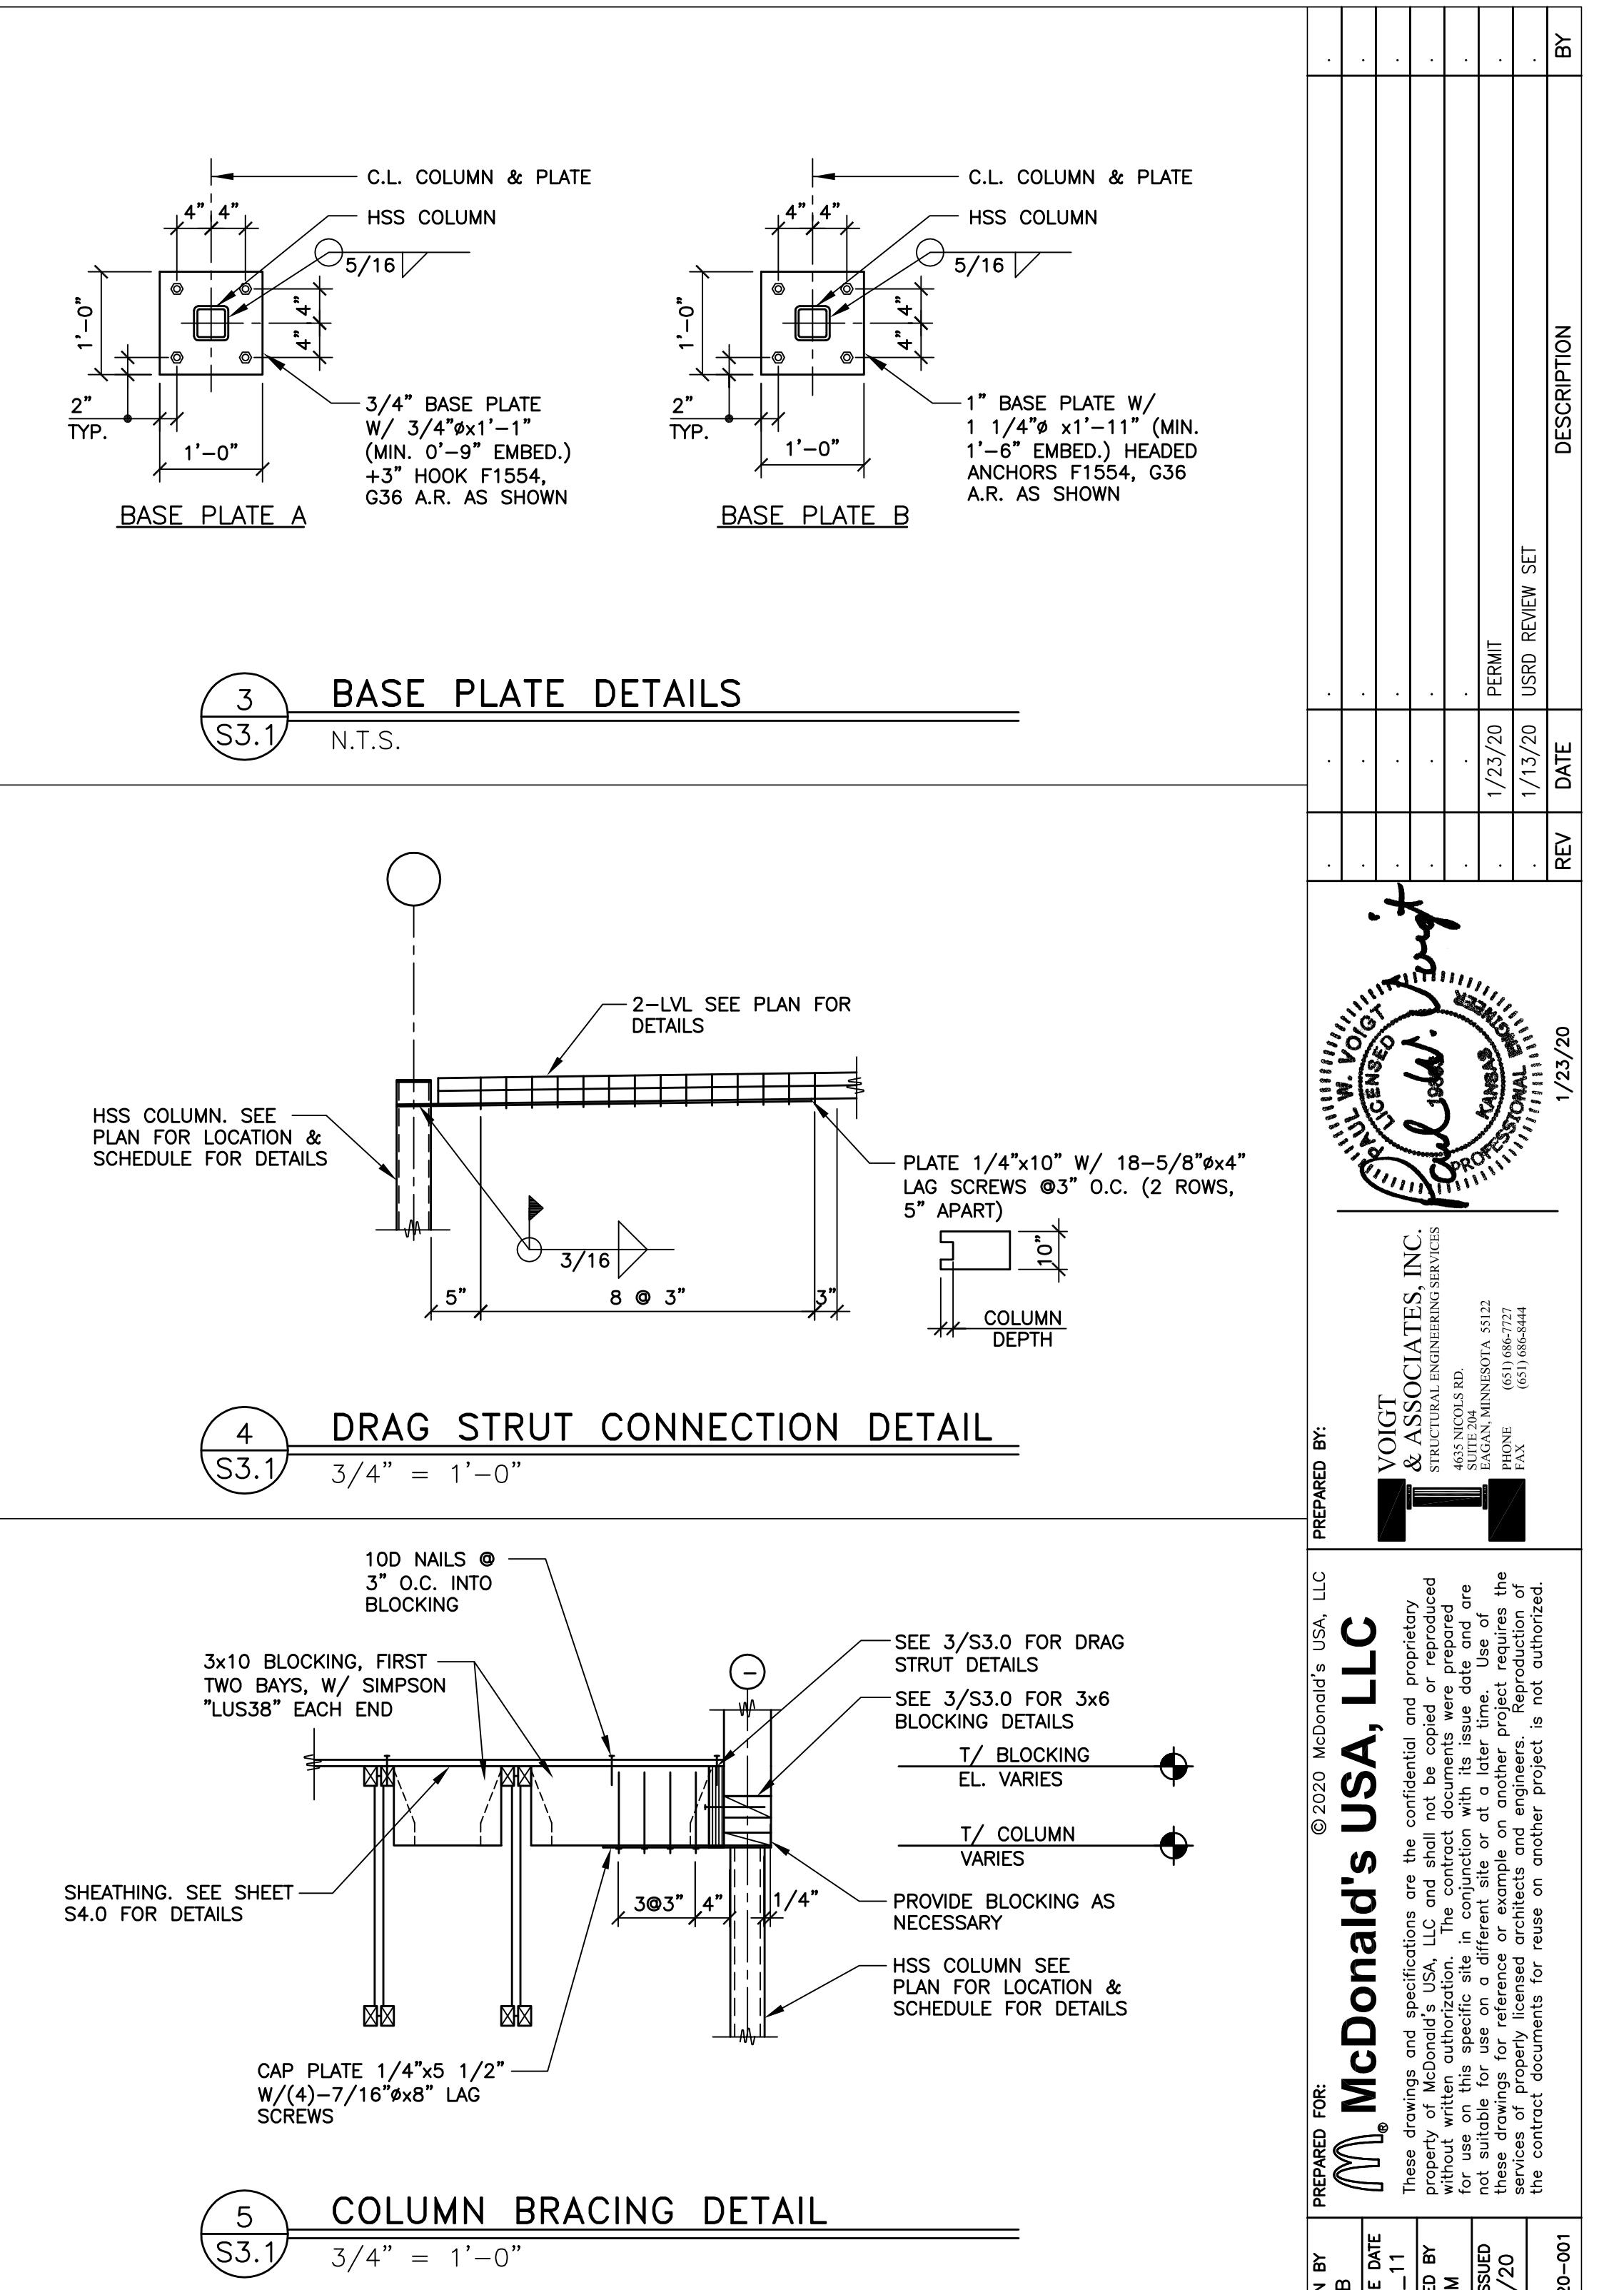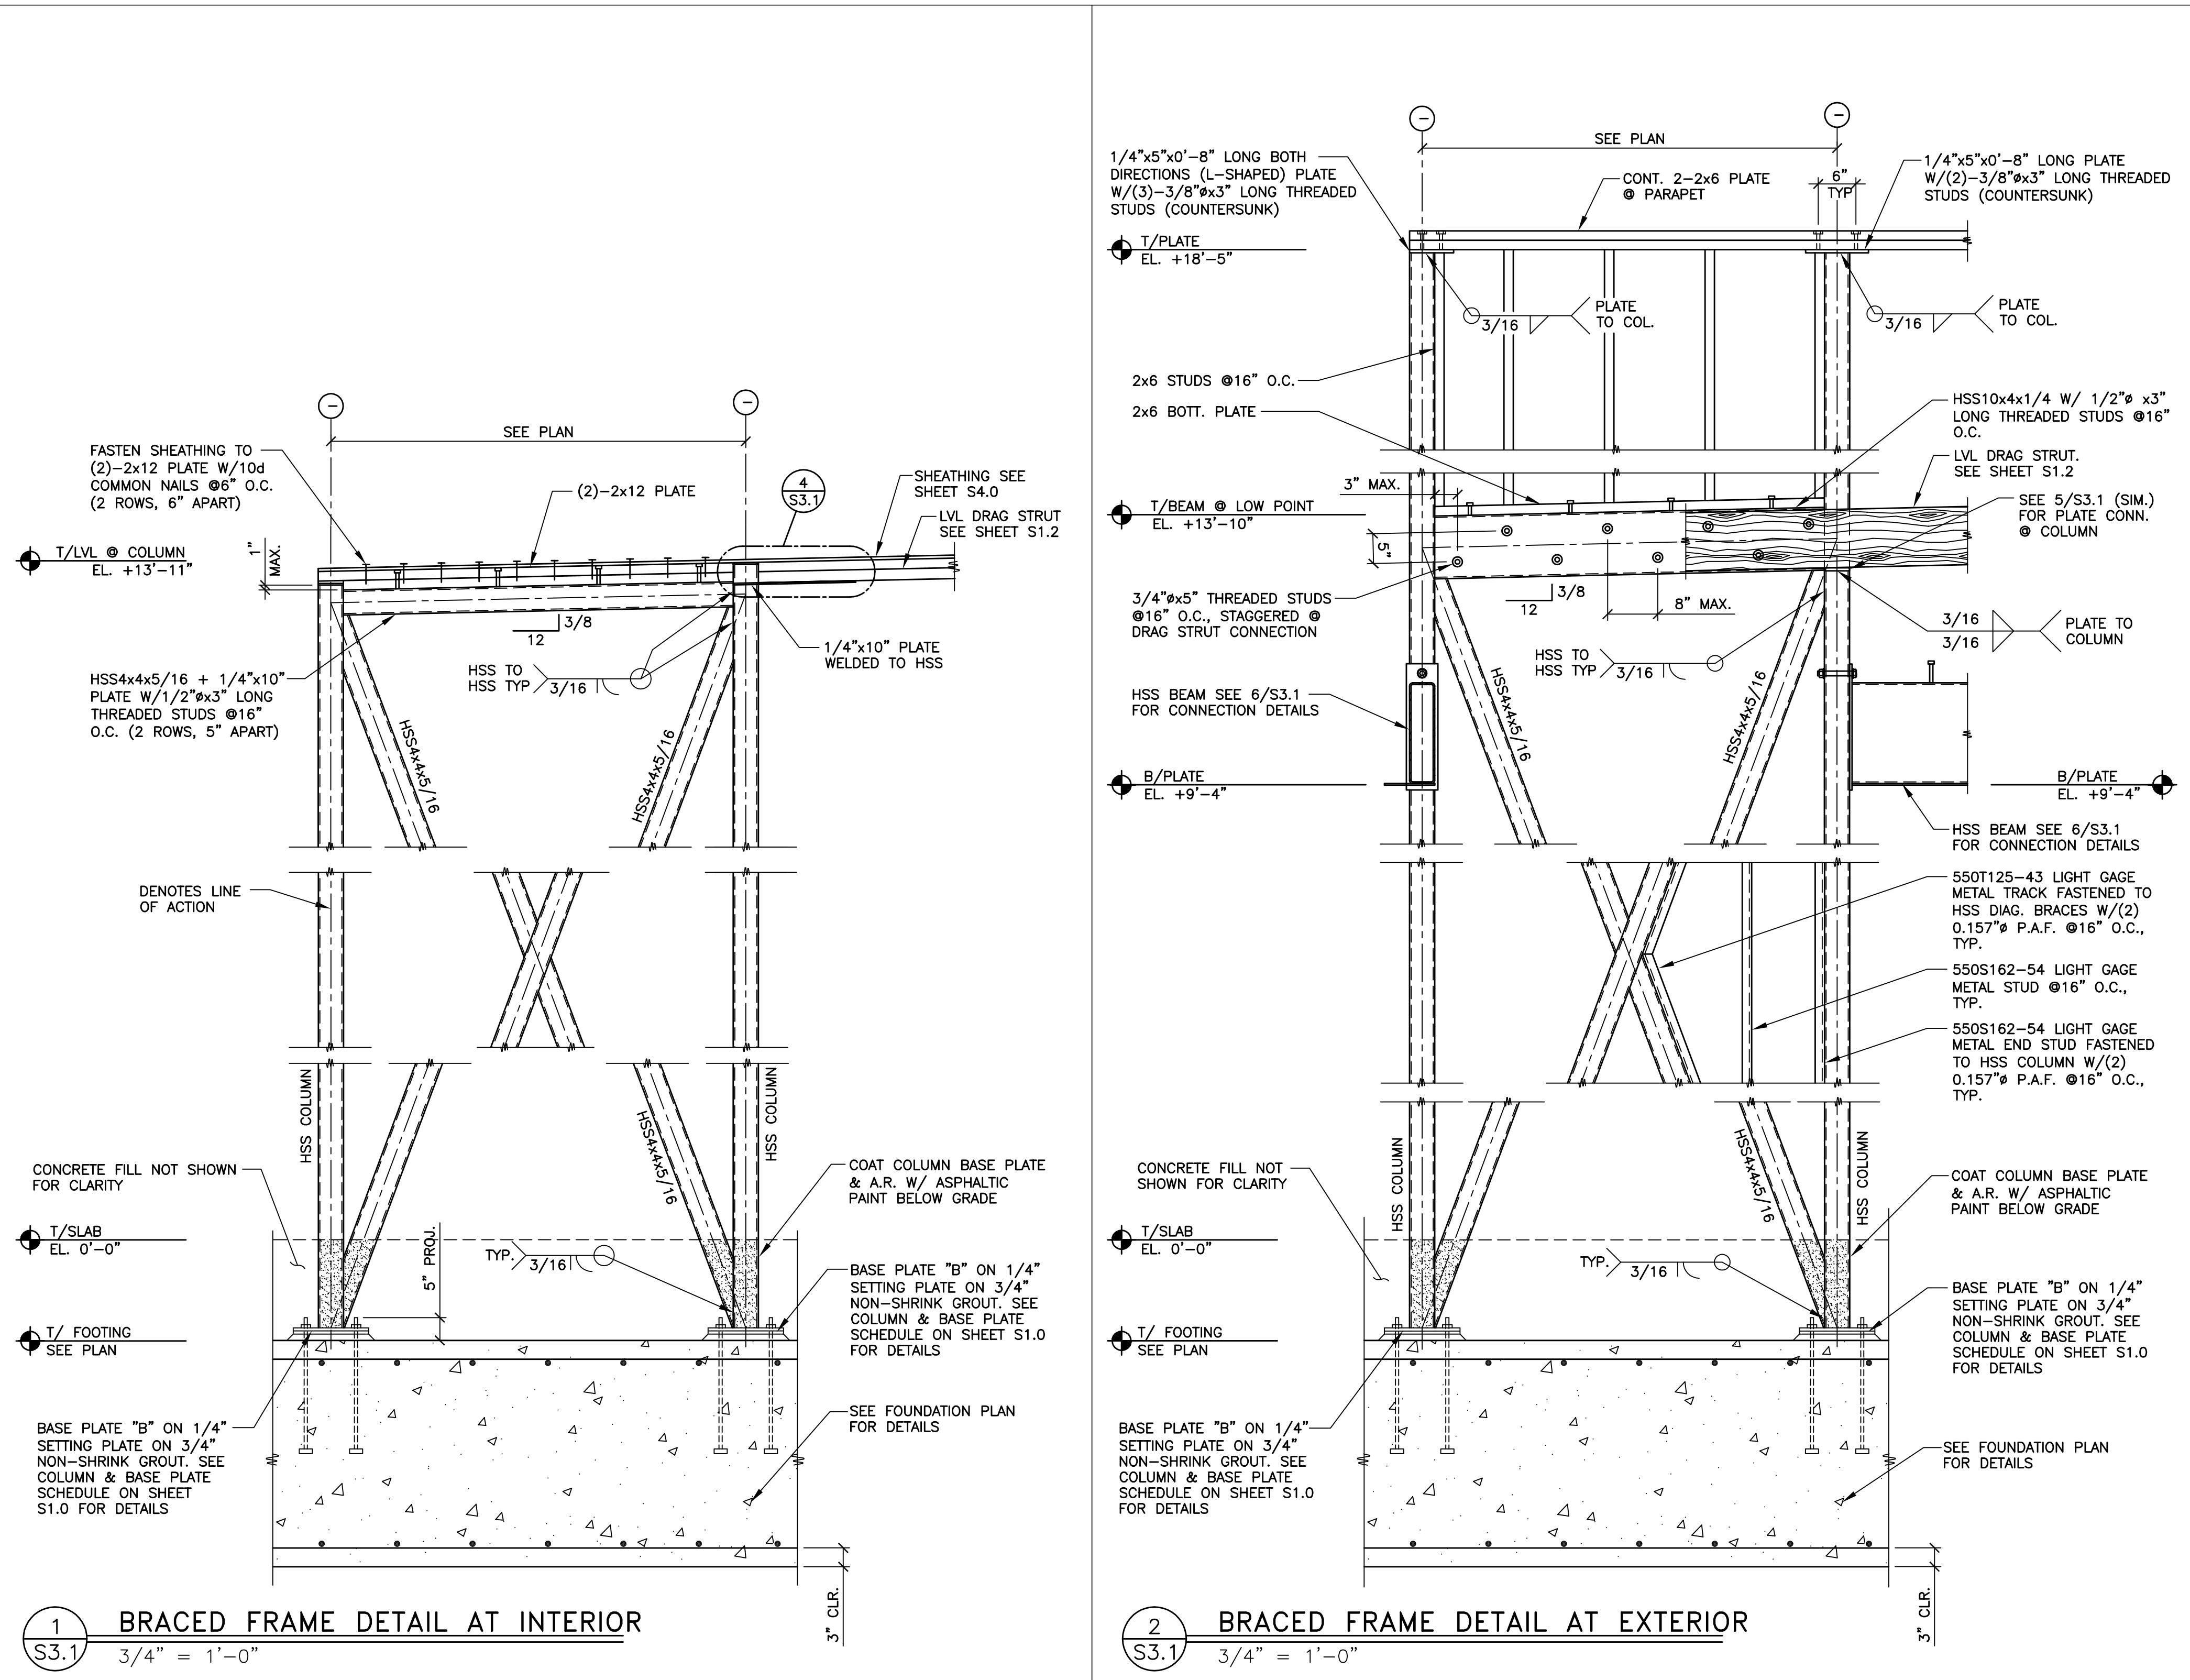

SHEET NO.	TITLE	DRAWN BY	CRB	STD ISSUE DATE	2019-11	REVIEWED BY	AVW	DATE ISSUED	1/23/20	PERMIT
015-0071.00.0	2019 STANDARD BUILDING - BB20 459-7F10-WOOD/WOOD	STRUCTURAL ENGINEERING SERVICES	4635 NICOLIS RD. EAST MINNEAPOLIS, MN 55422 (612) 295-1222 (612) 867-4444	WOOD BEARING WALLS W/ FIBER CEMENT SIDING & CI WOOD ROOF TRUSS FRAMING FIBER CEMENT PANEL/BATTEN/ALUMINUM/BRICK EXTERIOR FINISH	1/11/20	USRD REVIEW SET		REV DATE	1/23/20	BY

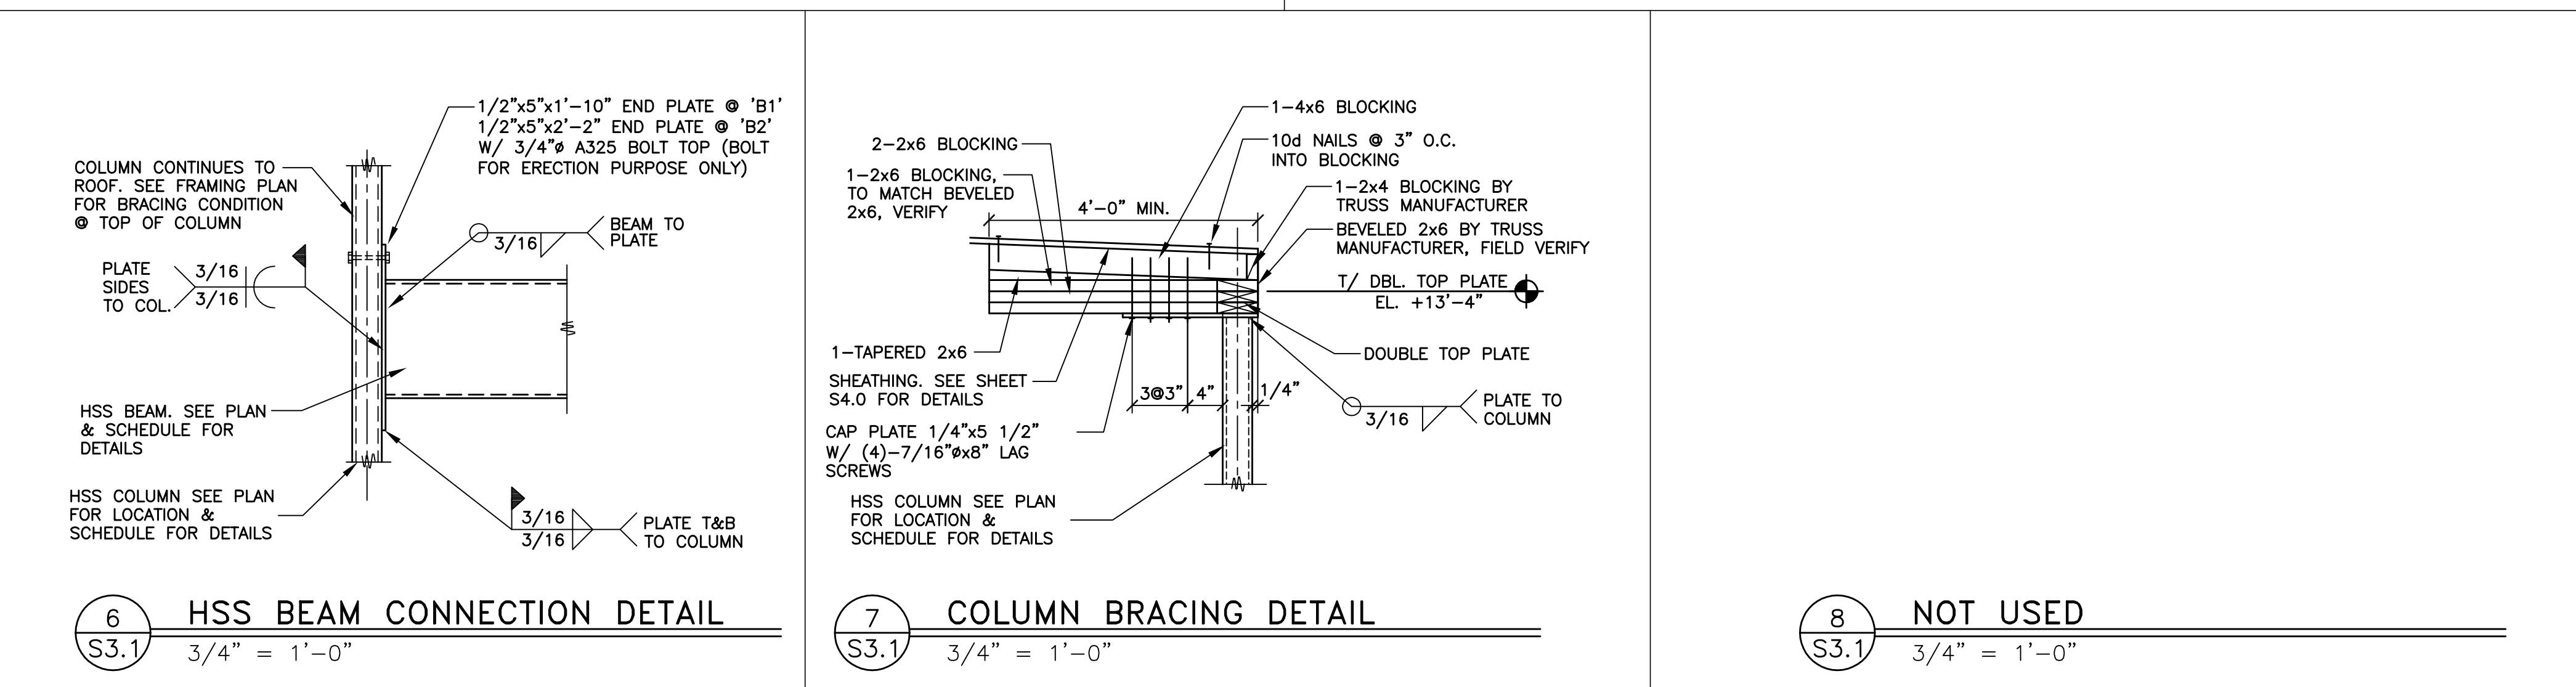


015-0071.00.0	S3.1 STEEL DETAILS
---------------	-----------------------



W. VOIGT
PROFESSIONAL
ENGINEER
KANSAS CITY, KS
1/23/20

VOIGT
& ASSOCIATES, INC.
STRUCTURAL ENGINEERING SERVICES
4635 NICOLIS RD.
EAST MINNEAPOLIS, MN 55422
(612) 295-1222
(612) 867-4444



©2020 McDonald's USA, LLC
These drawings and specifications are the confidential and proprietary property of McDonald's USA, LLC and shall not be copied or reproduced without written authorization. In the event that these drawings and specifications are not suitable for use on a different site or for reference or example on another project, the services of properly licensed architects and engineers, or the authorized contractor, documents for reuse on another project is not authorized.

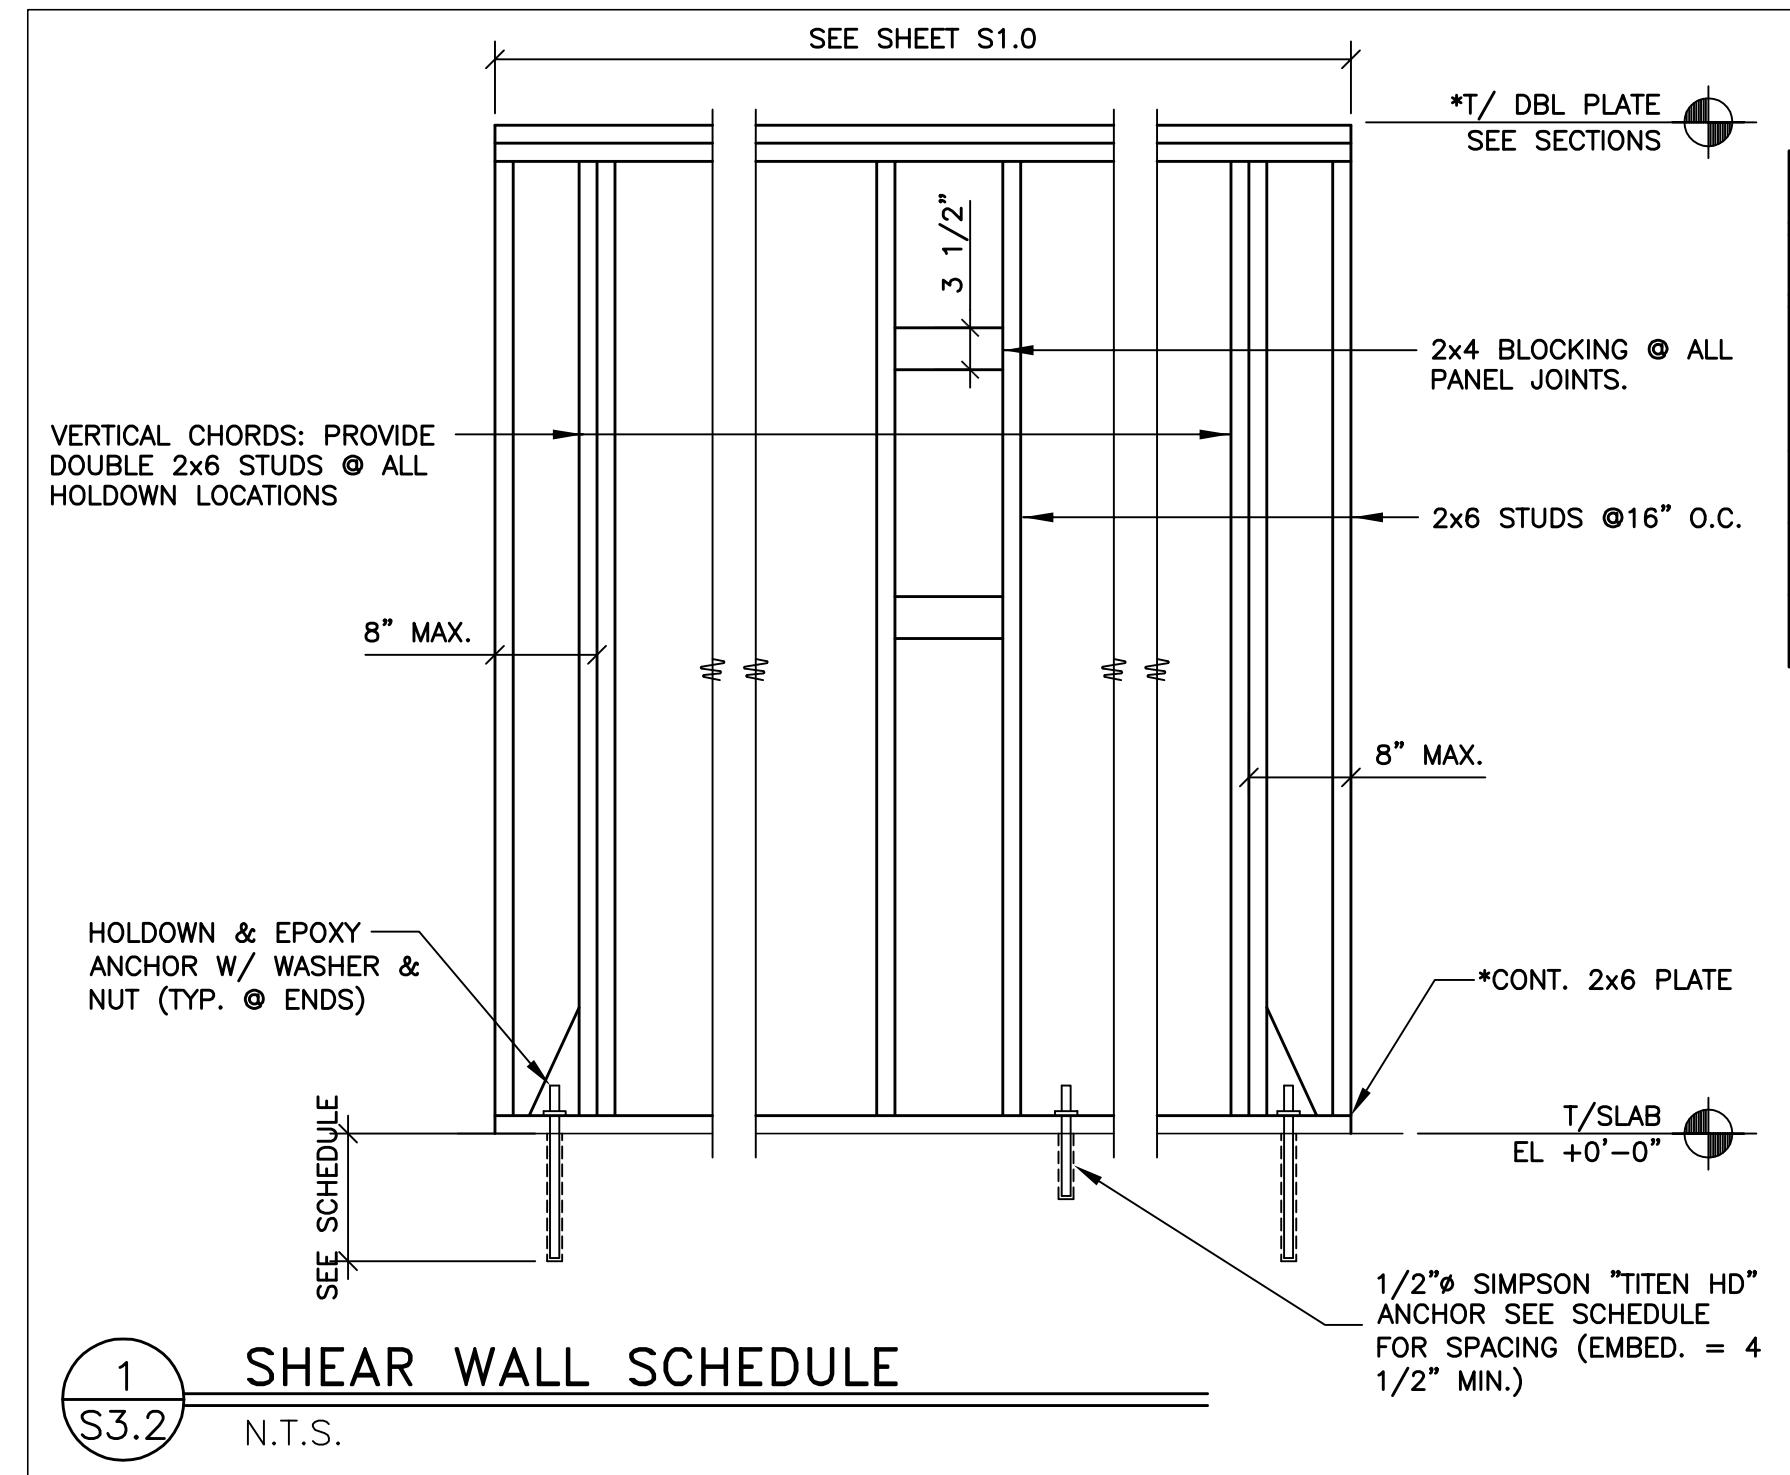

SHEAR WALL SCHEDULE						
WIND: 115 MPH (EXPOSURE C) SEISMIC: Sds = 11.8%, Sd1 = 10.1%						
MARK	SHEATHING	SHEATHING NAIL SIZE	SPACING @ PANEL EDGES	HOLDDOWN*** ANCHORS	ANCHOR BOLT SPACING	REMARKS
A	1-15/32"	8d	6"	1-HDUB-SDS2.5 7/8" EPOXY ANCH.	32"	15" MIN. EMBED. ON HOLDDOWN ANCHORS.
B	1-15/32"	8d	6"	1-HDUB-SDS2.5 7/8" EPOXY ANCH.	32"	15" MIN. EMBED. ON HOLDDOWN ANCHORS.
C	1-15/32"	8d	6"	1-HDUB-SDS2.5 7/8" EPOXY ANCH.	32"	15" MIN. EMBED. ON HOLDDOWN ANCHORS.

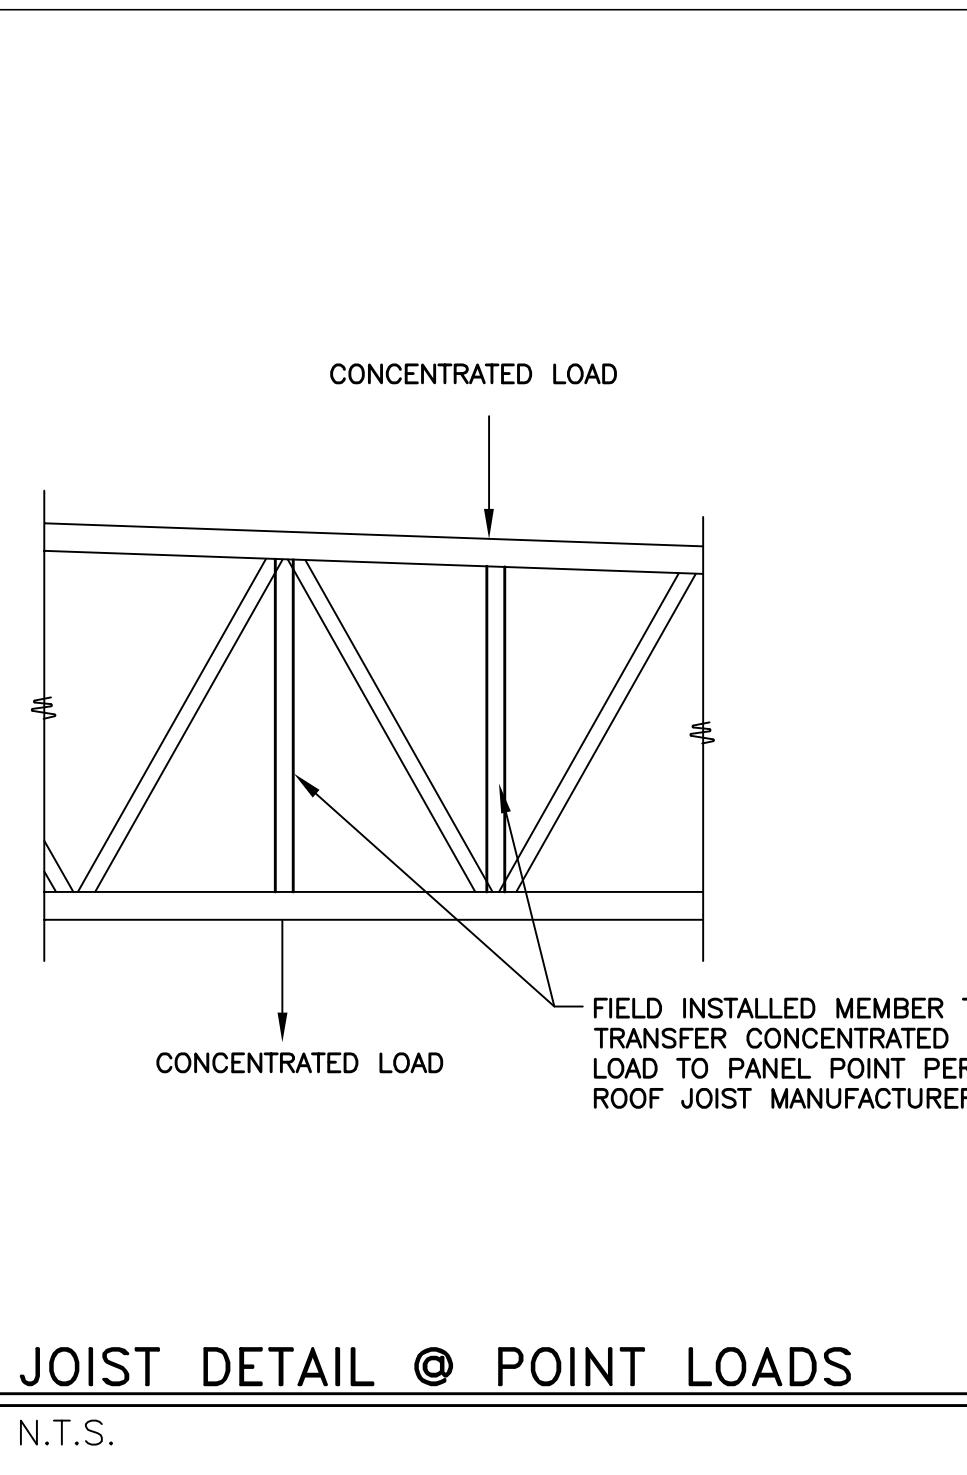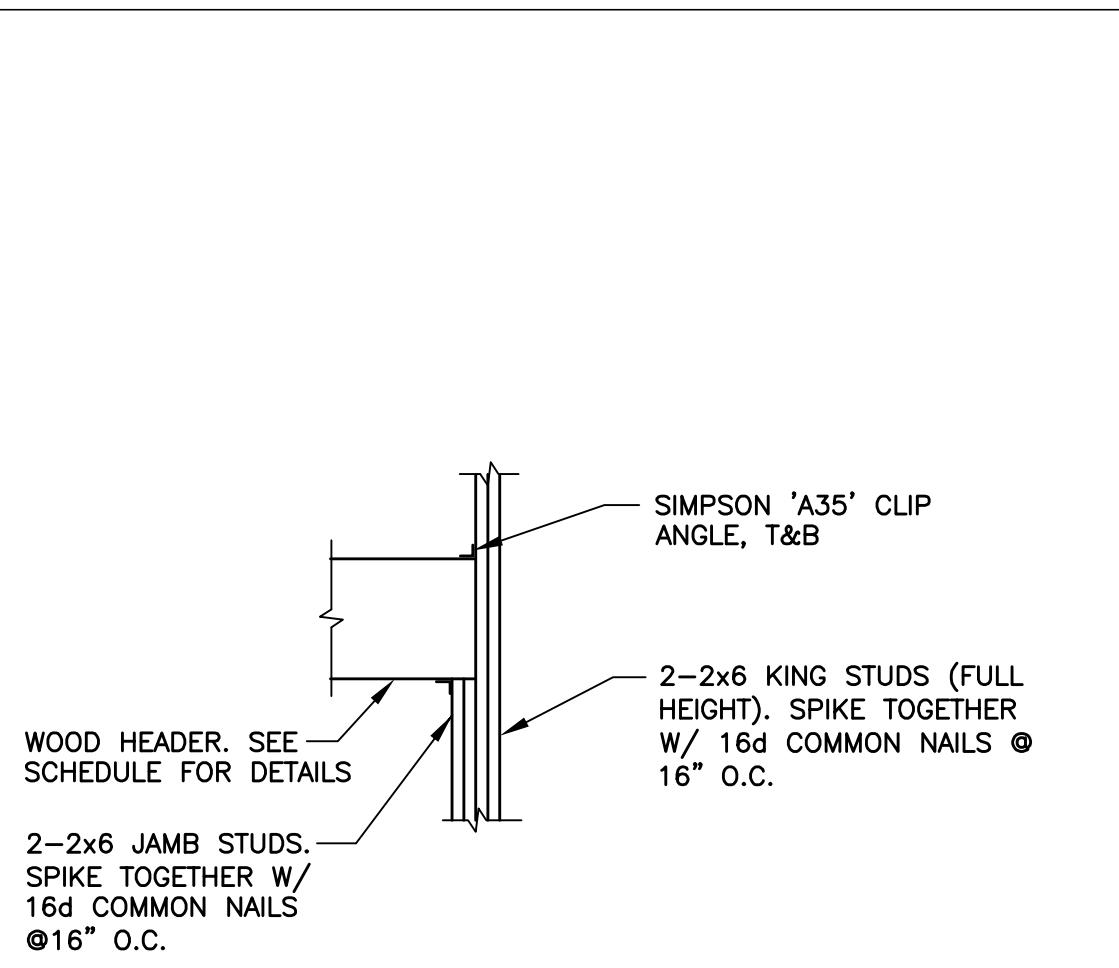


SHEET NO.	TITLE	DRAWN BY	PREPARED BY:
015-0071.00-0	2019 STANDARD BUILDING - BB20	CRB	McDonald's USA, LLC
	459-710-WOOD/WOOD	STD ISSUE DATE 2019-11	PREPARED BY: W.Voigt & ASSOCIATES, INC. STRUCTURAL ENGINEERING SERVICES 4635 NICOLLS RD. ELGIN, ILLINOIS 60122 PHONE: (630) 867-2722 FAX: (630) 867-4444
		REV'D BY AVM	
		DATE ISSUED 1/23/20	PERMIT 1/13/20 USD REVIEW SET
		REV. DATE	BY

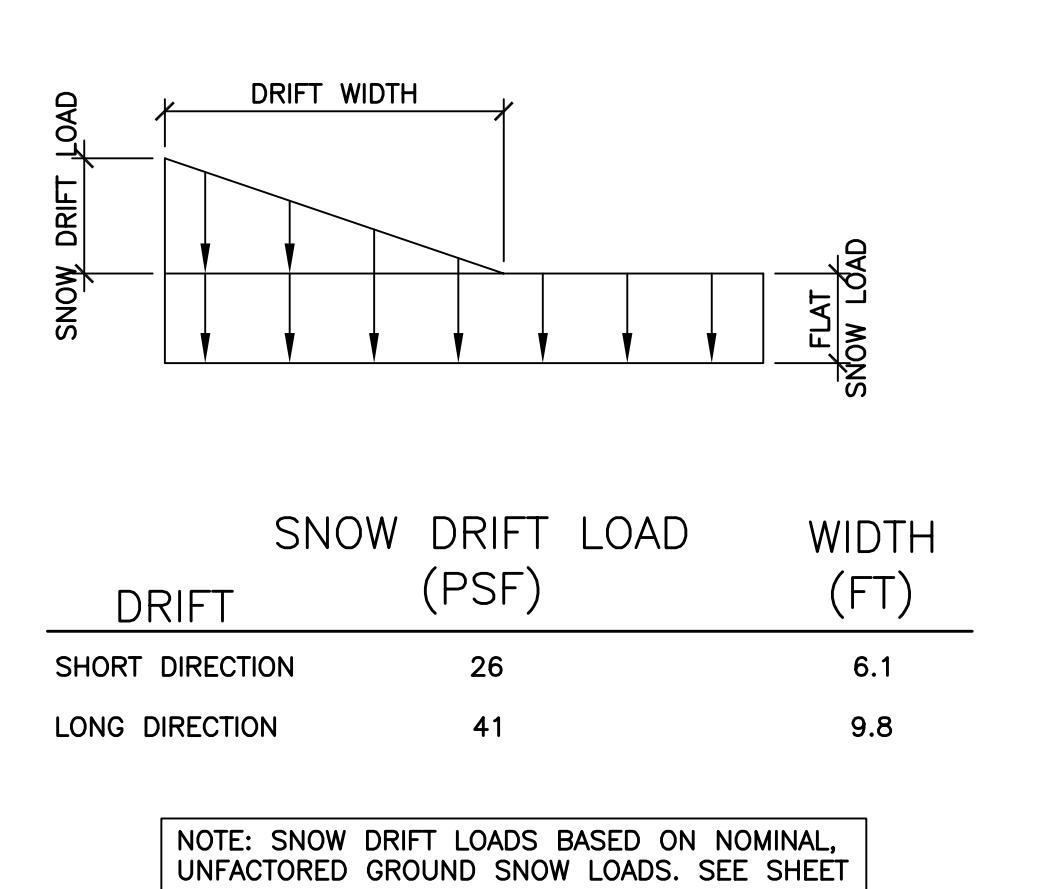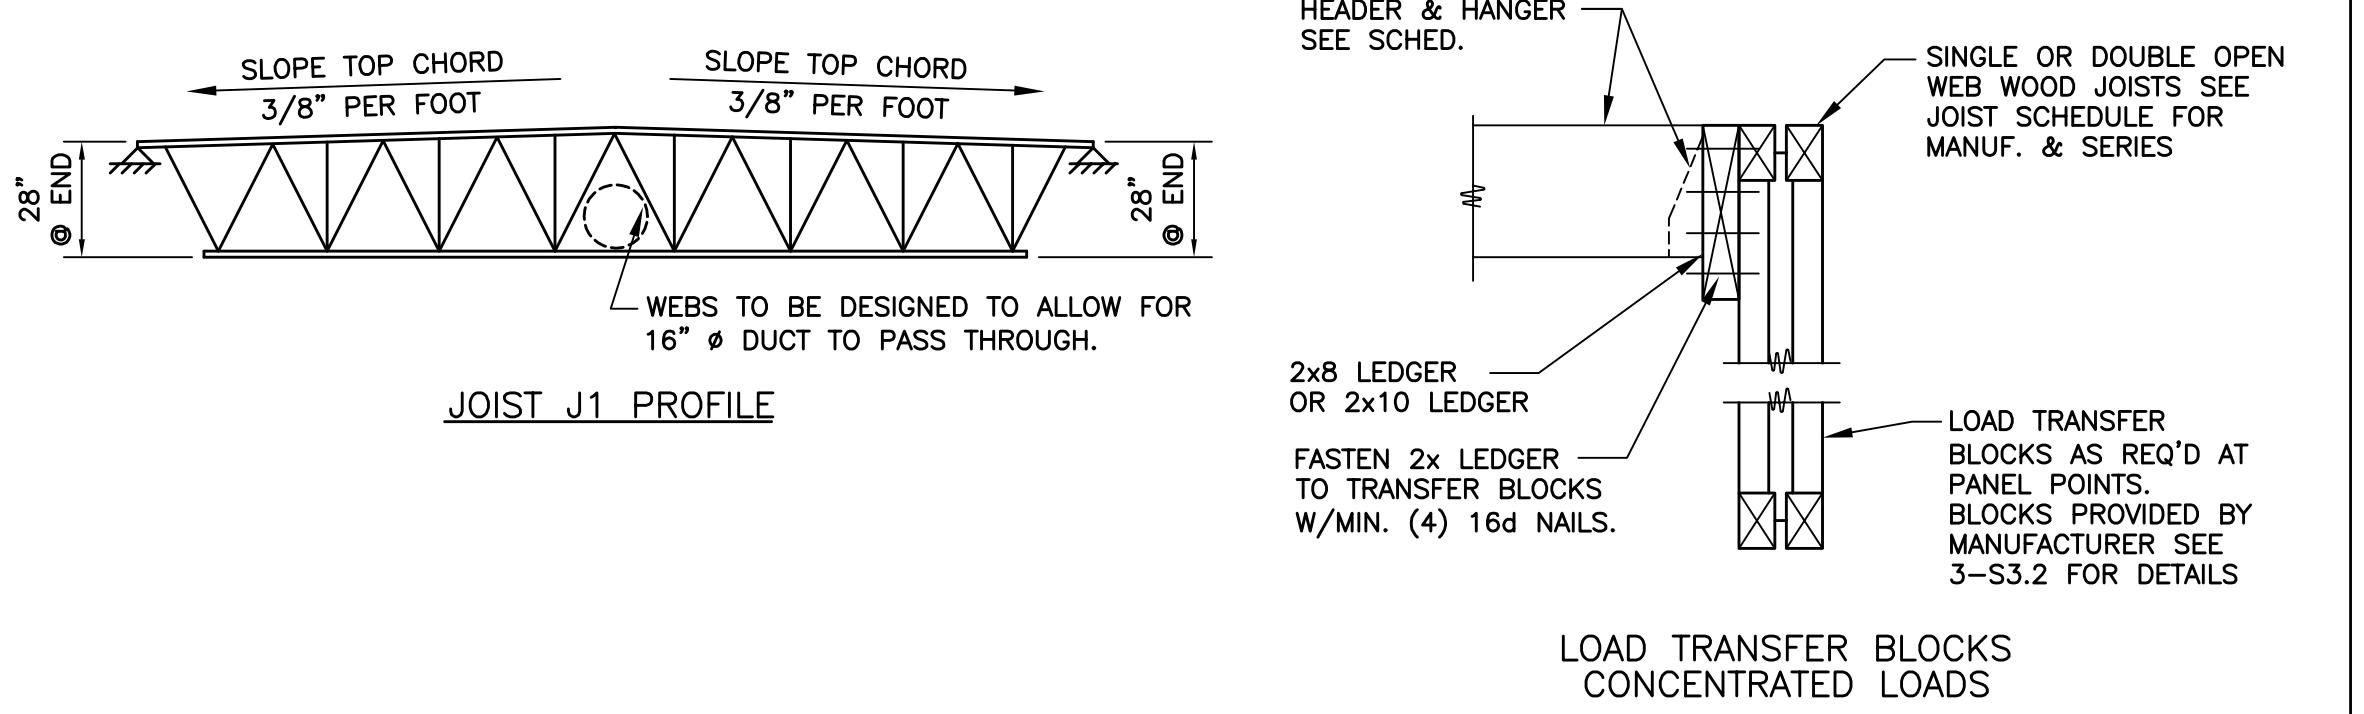


JOIST NOTES
N.T.S.

SNOW DRIFT DIAGRAM/SCHEDULE
N.T.S.

NOT USED
3/4" = 1'-0"

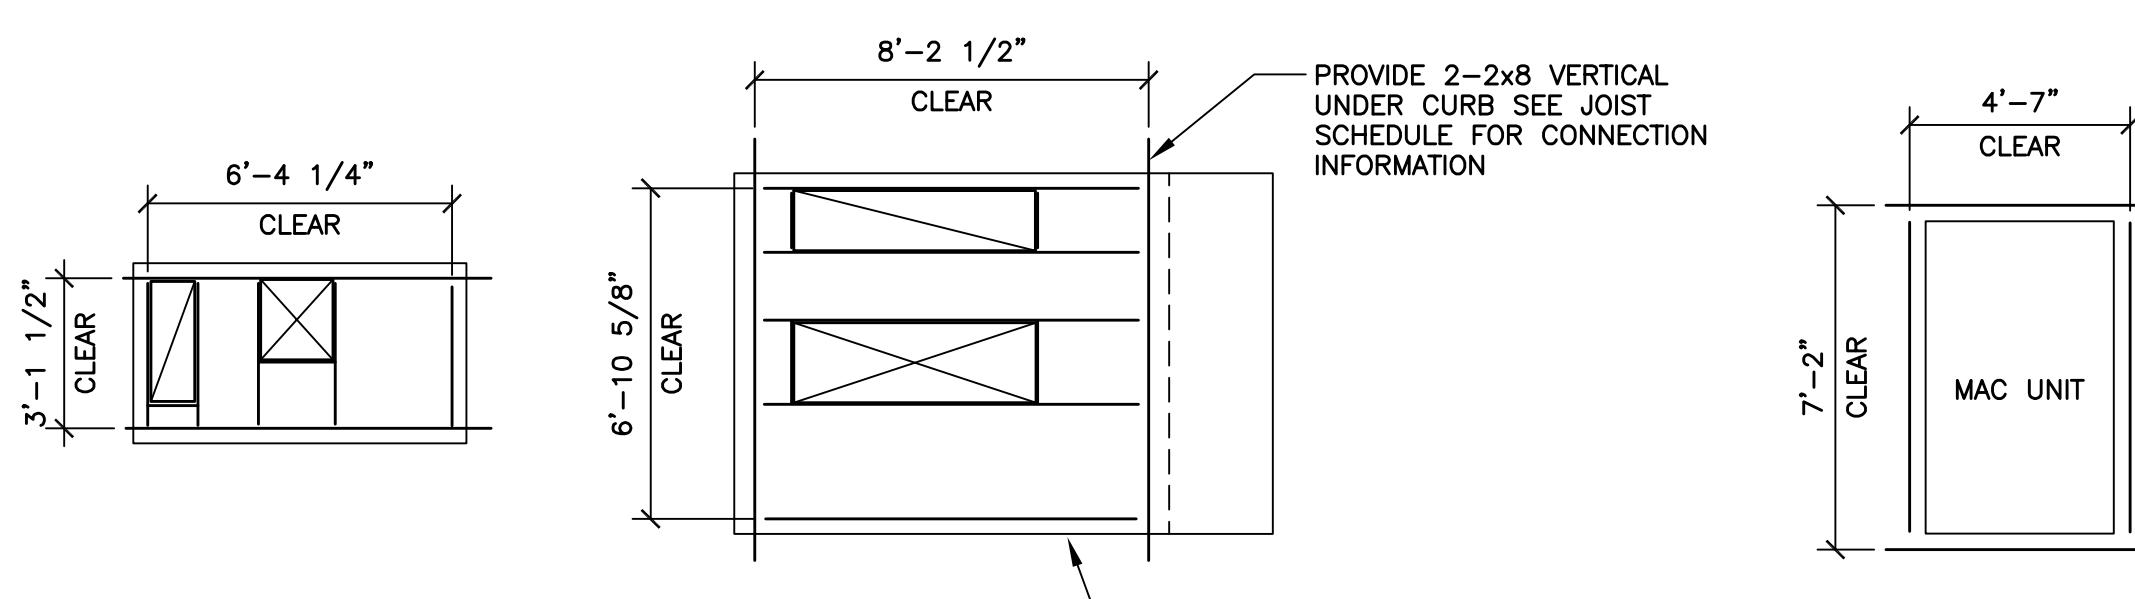

ROOF TOP UNIT CLEARANCES
1/4" = 1'-0"

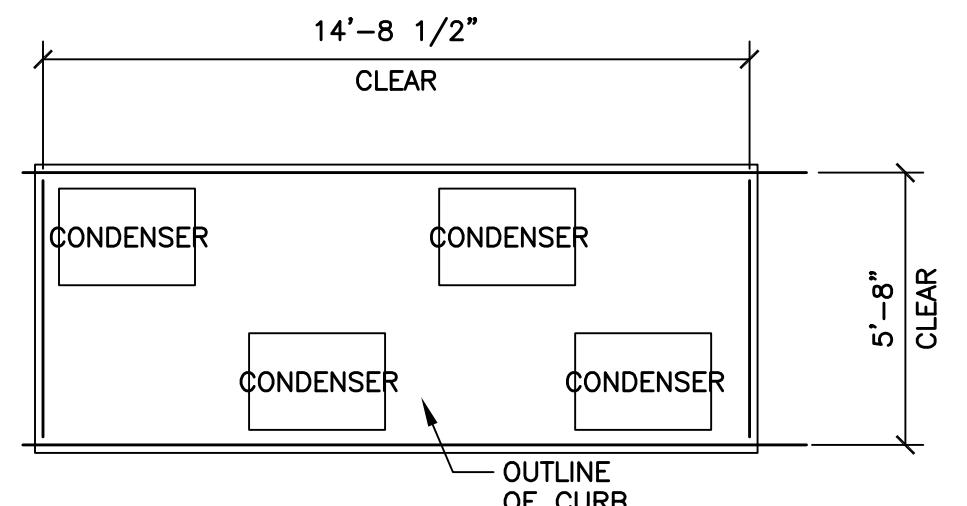

NOT USED
N.T.S.

NOT USED
N.T.S.

SHEET NO.	TITLE	DRAWN BY	PREPARED BY:
015-0071.00-0	2019 STANDARD BUILDING - BB20	CRB	McDonald's USA, LLC
	459-710-WOOD/WOOD	STD ISSUE DATE 2019-11	PREPARED BY: W.Voigt & ASSOCIATES, INC. STRUCTURAL ENGINEERING SERVICES 4635 NICOLLS RD. ELGIN, ILLINOIS 60122 PHONE: (630) 867-2722 FAX: (630) 867-4444
		REV'D BY AVM	
		DATE ISSUED 1/23/20	PERMIT 1/13/20 USD REVIEW SET
		REV. DATE	BY

S3.2
DETAILS

STRUCTURAL GENERAL NOTES:

DESIGN AND LOADING

1. THE STRUCTURAL DESIGN OF THIS BUILDING WAS BASED ON THE DESIGN CRITERIA:
 - A. BUILDING CODE: 2012 INTERNATIONAL BUILDING CODE
 - B. FLOOR:
 - LIVE LOAD: 125 PSF
 - DEAD LOAD: 20 PSF
 - SNOW: GROUND LOAD: 20 PSF
FLAT ROOF LOAD: 20 PSF
SNOW EXPOSURE FACTOR, CE: 1.0
IMPORTANCE FACTOR, I: 1.0
THERMAL COEFFICIENT, CT: 1.0
 - C. WIND:
 - BASIC WIND SPEED: 115 MPH (3-SECOND GUST ULTIMATE)
IMPORTANCE FACTOR: 1.00
BUILDING OCCUPANCY CATEGORY: II
WIND EXPOSURE: C
PRESSURES PER ASCE7
 - D. SEISMIC:
 - OCCUPANCY CATEGORY: II
IMPORTANCE FACTOR: 1.00
SITE CLASS: D
 $SS = 0.1116, S_1 = 0.0636$
 $SDS = 0.118, SD_1 = 0.101$
DESIGN CATEGORY: B
PLYWOOD SHEAR WALLS ($R = 6.5$)
OSCBF ($R = 3.25$)
 $C_{s1} = 0.018, C_{s2} = 0.036$
DESIGN BASE SHEAR = SEE CALCULATIONS
ANALYSIS PROCEDURE: EQUIVALENT LATERAL FORCE PROCEDURE
 - E. FLOOD LOAD: N/A
 - F. SPECIAL LOADS: N/A

FOUNDATION NOTES

1. THE FOUNDATION DESIGN OF THIS BUILDING WAS BASED ON THE FOLLOWING CRITERIA:

- A. MINIMUM ALLOWABLE SOIL BEARING CAPACITY = 2000 PSF.
- B. RECOMMENDED BY OLSSON, INC - IN THEIR REPORT #019-1175 DATED 5-22-19, ANY FILL REQUIRED BELOW SLABS ON GRADE OR FOOTINGS SHALL BE COMPAKTED AS REQUIRED BY THE SOILS REPORT NOTED IN ITEM #2.

2. ALL EXTERIOR FOOTINGS SHALL EXTEND BELOW THE MAXIMUM ANTICIPATED DEPTH OF FROST.

3. THE CONTRACTOR SHALL NOTIFY THE ARCHITECT OR ENGINEER OF RECORD IMMEDIATELY IN THE EVENT THAT THE SOILS CONDITIONS ENCOUNTERED VARY FROM THOSE SHOWN ON THE BORING LOGS.

4. ALL FOUNDATION EXCAVATIONS SHALL BE INSPECTED BY A SOILS TESTING LABORATORY PRIOR TO PLACEMENT OF CONCRETE.

CONCRETE AND REINFORCING

1. ALL CONCRETE SHALL BE IN ACCORDANCE WITH THE "AMERICAN CONCRETE INSTITUTE BUILDING CODE" (ACI 318) AND WITH "SPECIFICATIONS FOR STRUCTURAL CONCRETE FOR BUILDINGS" (ACI 301) LATEST EDITIONS.
2. ALL NORMAL WEIGHT CONCRETE (145 PCF) SHALL OBTAIN A MINIMUM 28 DAY COMPRESSIVE STRENGTH OF 3000 PSI (3500 PSI FOR SLABS).
3. ALL CONCRETE SUBJECT TO EXTERIOR EXPOSURE SHALL BE AIR ENTRAINED AS RECOMMENDED BY ACI 318.
4. TEST CYLINDERS SHALL BE MADE AND TESTED AS OUTLINED IN CHAPTER 16 OF ACI-301.
5. REINFORCING BARS SHALL BE DEFORMED BARS OF NEW BILLET STEEL CONFORMING TO ASTM A-615, GRADE 60. WELDED WIRE FABRIC SHALL CONFORM TO ASTM A-185. ALL REINFORCING AND ACCESSORIES SHALL BE DETAILED AND PLACED IN ACCORDANCE WITH ACI STANDARD 315 AND 315R.
6. PROVIDE ALL ACCESSORIES NECESSARY TO SUPPORT REINFORCEMENT AT POSITIONS SHOWN ON THE PLANS AND DETAILS. PLASTIC COATED ACCESSORIES SHALL BE USED IN ALL EXPOSED CONCRETE WORK.
7. THE GENERAL CONTRACTOR SHALL CHECK WITH ARCHITECTURAL, MECHANICAL AND ELECTRICAL DRAWINGS AND THE SUB-CONTRACTORS FOR OPENINGS, SLEEVES, ANCHORS, HANGERS, INSERTS, SLAB DEPRESSIONS AND OTHER ITEMS RELATED TO THE CONCRETE WORK AND SHALL ASSUME RESPONSIBILITY FOR THEIR PROPER LOCATION.

STRUCTURAL STEEL

1. STRUCTURAL STEEL SHALL BE DETAILED, FABRICATED AND ERECTED IN CONFORMANCE WITH THE AISC360 "SPECIFICATION FOR STRUCTURAL STEEL". SEISMIC DESIGN OF STRUCTURAL STEEL STRUCTURES SHALL CONFORM TO AISC 341.
2. STRUCTURAL STEEL SHALL CONFORM TO THE FOLLOWING ASTM SPECIFICATIONS:

- A. ANCHOR RODS F1554, GRADE 36
- B. HIGH STRENGTH STRUCTURAL BOLTS A325-N U.N.O.
- C. STRUCTURAL SHAPES (W) A992
- D. STRUCTURAL SHAPES (M, S, C, MC, PLATES) A36
- E. STRUCTURAL SHAPES (HP) A572
- F. STRUCTURAL TUBING (HSS) A500 GRADE B
- G. STRUCTURAL ANGLES A36

3. ALL WELDING ELECTRODES SHALL BE E70-XX. ALL SHOP AND FIELD WELDING SHALL BE MADE IN ACCORDANCE WITH A.W.S. D1.1 "CODE FOR WELDING IN BUILDING CONSTRUCTION" AND SHALL BE MADE BY CERTIFIED WELDERS.

LAMINATED VENEER LUMBER (LVL)

1. ALL BEAMS SHALL BE MANUFACTURED WITH LAMINATED VENEER LUMBER AND WATERPROOF ADHESIVES.
2. SIZE, MANUFACTURER & SERIES OF ALL LVL MEMBERS SHALL BE AS SHOWN ON DRAWINGS.
3. ANY SUBSTITUTIONS MUST BE APPROVED IN WRITING BY ENGINEER OR ARCHITECT OF RECORD.
4. PROVIDE 3" MINIMUM BEARING OR AS SPECIFIED ON PLANS. REFER TO PLANS FOR FASTENING OF MULTIPLE PIECE BEAMS.

OPEN WEB WOOD JOISTS

1. OPEN WEB WOOD JOISTS SHALL BE MANUFACTURED WITH MACHINE STRESS RATED TOP AND BOTTOM CHORDS. WEBS SHALL BE TUBULAR STEEL MEMBERS PER MANUFACTURERS' SPECIFICATIONS.
2. SIZE, MANUFACTURER & SERIES OF ALL OPEN WEB JOISTS SHALL BE AS SHOWN ON DRAWINGS. ANY SUBSTITUTIONS MUST BE APPROVED IN WRITING BY ENGINEER OR ARCHITECT OF RECORD.
3. PROVIDE 3 1/2" MINIMUM BEARING OR AS SPECIFIED ON PLANS. SHIM AS REQUIRED TO PROVIDE FULL BEARING AND LEVEL SUPPORT.
4. DO NOT CUT TOP OR BOTTOM CHORDS.
5. ALL HANGERS AND FRAMING CONNECTORS SHOWN ARE MANUFACTURED BY SIMPSON STRONG TIE. ANY SUBSTITUTIONS MUST BE APPROVED IN WRITING BY ENGINEER OR ARCHITECT OF RECORD.
6. REFER TO PLANS FOR WEB STIFFENER AND CONCENTRATED LOAD REQUIREMENTS.
7. REFER TO MANUFACTURERS' INSTALLATION GUIDE FOR JOIST BRACING DURING ERECTION. REFER TO MANUFACTURERS' INSTALLATION GUIDE FOR JOIST BRIDGING REQUIREMENTS.

SAWN LUMBER

1. ALL GRADES OF LUMBER INDICATED ON STRUCTURAL DRAWINGS SHALL BE RATED BY THE SOUTHERN PINE INSPECTION BUREAU (SPIB), OR THE WESTERN WOOD PRODUCTS ASSOCIATION (WWPA). LUMBER GRADES SHALL BE AS FOLLOWS, WITH A MAXIMUM MOISTURE CONTENT OF 19%:
 - A. SOUTHERN PINE NO. 1.
 - B. DOUGLAS FIR-LARCH NO. 1.
 - C. HEM-FIR NORTH NO. 1
2. BOLT HEADS AND NUTS BEARING ON WOOD SHALL BE PROVIDED WITH STANDARD CUT WASHERS. ALL WOOD IN CONTACT WITH CONCRETE OR MASONRY SHALL BE PRESSURE TREATED.
3. MINIMUM NAILED CONNECTIONS FOR WOOD FRAMING MEMBERS SHALL BE IN ACCORDANCE WITH THE LOCAL BUILDING CODE OR TABLE 2304.9.1 OF THE INTERNATIONAL BUILDING CODE IF NO OTHER CRITERIA IS GIVEN.
4. CONNECTORS SHOWN ON THE DETAILS ARE MANUFACTURED BY SIMPSON. WRITTEN APPROVAL BY ENGINEER REQUIRED FOR SUBSTITUTIONS.

ROOF & WALL SHEATHING

1. ALL SHEATHING SHALL CONFORM TO AMERICAN PLYWOOD ASSOCIATION (APA) DESIGN SPECIFICATIONS, LATEST EDITION. SHEATHING SHALL BE CONTINUOUS OVER THREE ADJACENT SPANS MINIMUM.
2. WALL SHEATHING SHALL BE 15/32" (1/2" NOMINAL) APA RATED SHEATHING, EXPOSURE 1, 32/16. ALL WALL SHEATHING SHALL BE FASTENED TO SUPPORTING MEMBERS W/ 8d COMMON NAILS @ 6" O.C. AT PANEL EDGES AND 12" O.C. AT INTERMEDIATE SUPPORTS, U.N.O.
3. ROOF SHEATHING SHALL BE 23/32" (3/4" NOMINAL) APA RATED SHEATHING, EXPOSURE 1, 48/24. ALL ROOF SHEATHING SHALL BE FASTENED TO SUPPORTING MEMBERS W/ 10d COMMON NAILS @ 6" O.C. AT PANEL EDGES, AND 12" O.C. AT INTERMEDIATE SUPPORTS. U.N.O.

LIGHT GAGE METAL FRAMING

1. 16 GA. AND HEAVIER STUDS SHALL HAVE A MINIMUM YIELD STRESS OF 50,000 PSI. 18 GA. AND LIGHTER STUDS AND TRACKS SHALL HAVE A MINIMUM YIELD STRESS OF 33,000 PSI.
2. STUDS AND TRACKS SHALL BE 18 GA. MINIMUM U.N.O. THEY SHALL BE MANUFACTURED BY DIETRICH INDUSTRIES, INC. OR APPROVED EQUAL.

3. PROVIDE DOUBLE STUDS FOR FULL HEIGHT OF WALL EACH SIDE OF ALL OPENINGS UNLESS OTHERWISE NOTED. WELD STUDS TO EACH OTHER WITH 1 1/2" LONG 1/8" FILLET WELDS AT 12" O.C. EACH SIDE. PROVIDE STUD TRACK AT EACH HEAD AND SILL.

4. REFER TO PLANS AND DETAILS FOR CONNECTION OF STUD WALLS TO FOUNDATION, FLOOR OR ROOF.

SHOP DRAWINGS

1. SHOP DRAWING SUBMITTALS SHALL BE SUBMITTED ELECTRONICALLY.
2. SHOP DRAWINGS SHALL BE REVIEWED BY CONTRACTOR TO VERIFY THAT SUBMITTAL IS COMPLETE PRIOR TO SUBMITTING TO ARCHITECT/ENGINEER.
3. DRAWINGS CREATED BY THE ENGINEER OF RECORD CANNOT BE REPRODUCED AND/OR USED AS A SHOP DRAWING SUBMITTAL. SHOP DRAWING SUBMITTALS SHALL INCLUDE THE FOLLOWING:
 - A. CONCRETE MIX DESIGN
 - B. FOUNDATION REINFORCING BARS
 - C. STRUCTURAL STEEL
 - D. OPEN WEB JOISTS AND CALCULATIONS
 - E. ROOF SHEATHING
 - F. TRELLIS SYSTEM & CALCULATIONS
 - G. LAMINATED VENEER LUMBER (LVL)
 - H. SAWN LUMBER AND CONNECTORS

SPECIAL INSPECTIONS

1. SPECIAL INSPECTIONS SHALL BE PERFORMED IN ACCORDANCE WITH SECTION 1705 OF IBC AND THE OWNER SHALL EMPLOY ONE OR MORE SPECIAL INSPECTORS TO PROVIDE INSPECTIONS DURING CONSTRUCTION ON THE TYPES OF WORK LISTED UNDER SECTION 1705. THE FOLLOWING AREAS OF WORK REQUIRE SPECIAL INSPECTIONS IN ACCORDANCE WITH THE LISTED 2012 INTERNATIONAL BUILDING CODE SECTIONS/LOCATIONS:
 - A. SOILS - SECTION 1705.6 PER TABLE 1705.6
 - B. CONCRETE - SECTION 1705.3 PER TABLE 1705.3
 - C. STEEL - SECTION 1705.2 (SEE AISC 360.10)

MISCELLANEOUS

1. ALL DIMENSIONS ON STRUCTURAL DRAWINGS TO BE CHECKED AGAINST ARCHITECTURAL, MECHANICAL AND ELECTRICAL DRAWINGS BY THE GENERAL CONTRACTOR AND ANY DISCREPANCIES ARE TO BE REPORTED TO THE ARCHITECT IMMEDIATELY.
2. THE CONTRACTOR SHALL ASSUME RESPONSIBILITY, UNRELIEVED BY REVIEW OF SHOP DRAWINGS OR PERIODIC OBSERVATION OF CONSTRUCTION, FOR COMPLIANCE WITH THE CONTRACT DOCUMENTS, FOR FABRICATION PROCESSES AND CONSTRUCTION TECHNIQUES, AND FOR SAFE CONDITIONS ON THE JOB SITE.
3. DO NOT SCALE THE DRAWINGS.

CONCRETE BLOCK JOINT REINFORCEMENT

ALL CONCRETE BLOCK WALLS TO RECEIVE THE FOLLOWING JOINT REINFORCEMENT:
LADDER TYPE JOINT REINFORCING WITH SIDE AND CROSS RODS WITH WIRE SIZE (W2.8 OR 3/16") SPACED 16" O.C. VERTICALLY. (HOHMANN & BARNARD 220 "SUPER HEAVY DUTY" OR EQUAL) SIMILAR FOR CONCRETE BRICK PRODUCTS.

1 CONCRETE BLOCK JOINT REINFORCEMENT

VENEEER TIE REQUIREMENTS:

1. USE THE FOLLOWING:
VENEEER TIES W/ WIRE SIZE (W2.8 OR 3/16") SPACED 16" O.C. VERTICALLY AND 32" HORIZONTALLY. ADDITIONAL TIES ALONG ALL OPENINGS GREATER THAN 16" ARE REQUIRED TO BE LOCATED WITHIN 12" OF OPENING AND SPACED 36" O.C. MAX. AROUND OPENING PERIMETER. (HOHMANN & BARNARD VBT-VEE-BYNA TIE WITH DW10-HS ANCHOR PLATE OR EQUAL).

2 VENEER TIE REQUIREMENTS

McDonald's USA, LLC

©2020 McDonald's USA, LLC

PREPARED BY: 

These drawings and specifications are the confidential and proprietary property of McDonald's USA, LLC and shall not be copied or reproduced without written authorization. The contract documents were prepared specifically for this project and are not to be used on another project or at a later time. Use of these drawings for reference or example on another project requires the services of property licensed architects and engineers. Reproduction of the contract documents for reuse on another project is not authorized.

©2020 McDonald's USA, LLC

PREPARED FOR:

STRUCTURAL ENGINEERING SERVICES

4635 NICOLS RD.

ELLIOTTSBURG, MD 20822

PHONE: (619) 667-2727

FAX: (619) 667-4444

1/23/20

REV: DATE

1/23/20

USRD REVIEW SET

PERMIT


1/23/20

REV: DATE

1/23/20

DESCRIPTION

BY

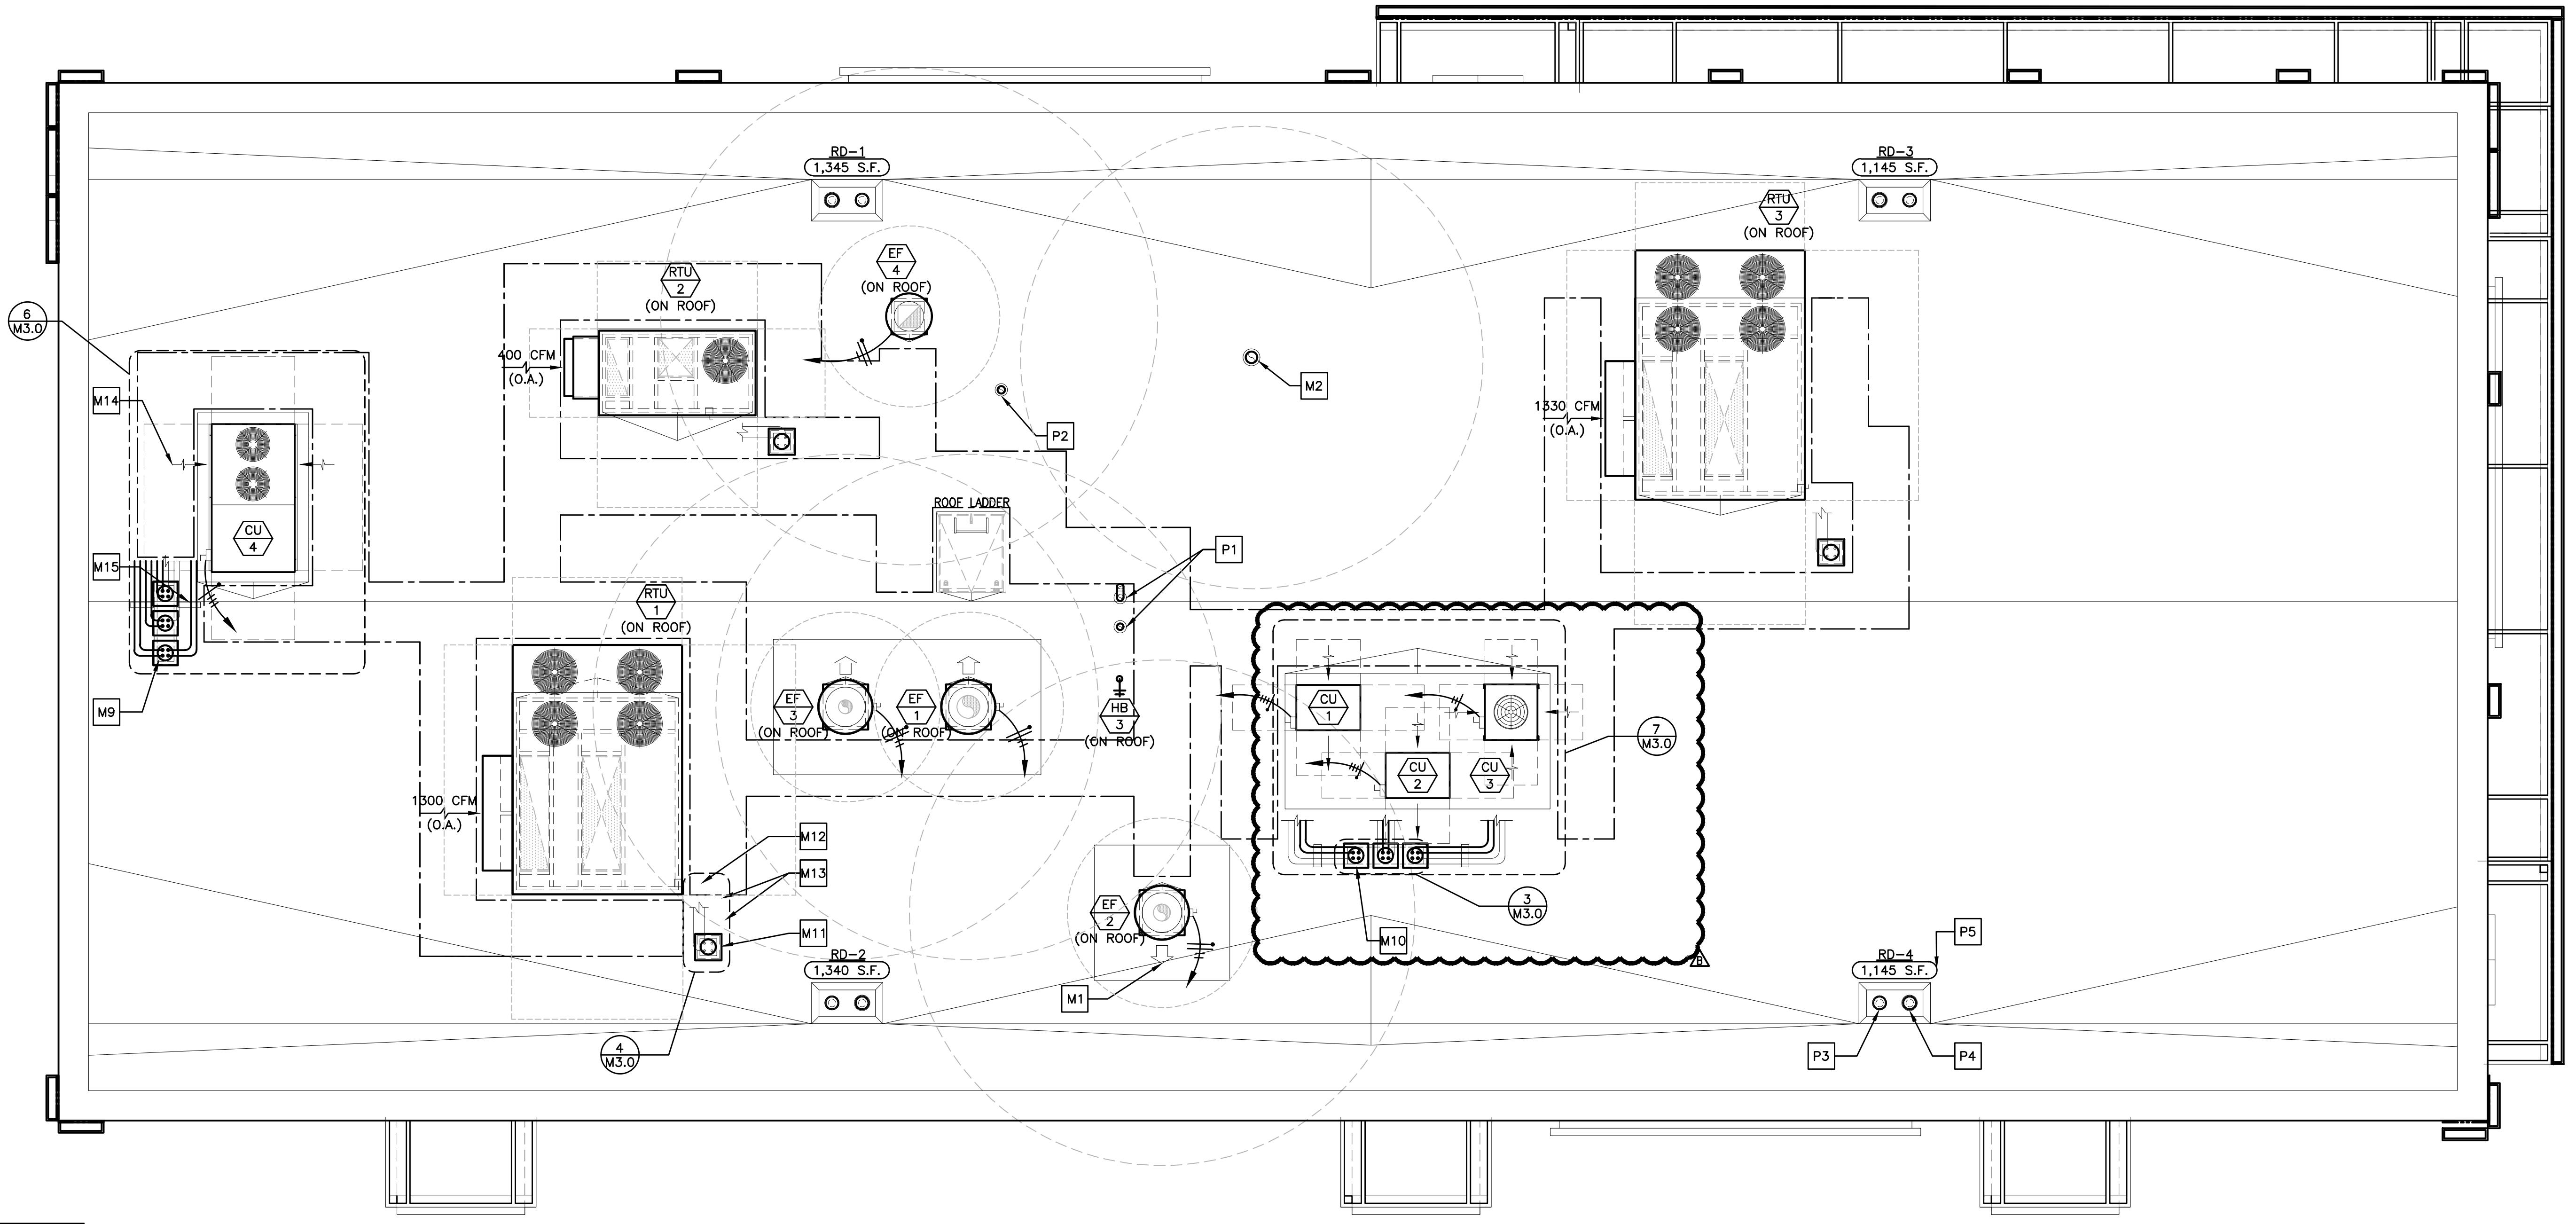

1 ROOF PLAN
M1.0 1/4"=1'-0"

DRAWING NOTES

- ROOFTOP EQUIPMENT LOCATIONS SHOWN ARE GENERAL. ACTUAL LOCATIONS SHALL BE COORDINATED WITH THE STRUCTURAL DRAWINGS.
- ROOF OPENINGS FOR ROOFTOP UNITS AND EXHAUST FANS SHALL BE COORDINATED WITH THE MANUFACTURER.
- ROOF OPENINGS FOR PIPE PORTALS SHALL ONLY BE LARGE ENOUGH TO ALLOW PIPE AND CONDUIT PENETRATIONS. PIPE PORTAL CURB SHALL BE FILLED WITH AS MUCH BATT INSULATION AS POSSIBLE.
- PRIOR TO INSTALLING THE TOP OF THE EQUIPMENT PLATFORM, INSIDE OF THE PLATFORM SHALL BE INSULATED WITH AS MUCH BATT INSULATION AS POSSIBLE.

DRAWINGS AND SPECIFICATIONS ARE TO BE CONSIDERED AS SUPPLEMENTING EACH OTHER. WORK SPECIFIED BUT NOT SHOWN ON DRAWINGS, OR SHOWN ON DRAWINGS BUT NOT SPECIFIED, SHALL BE PERFORMED OR FURNISHED AS THOUGH MENTIONED IN BOTH SPECIFICATIONS AND DRAWINGS, IF NOT OTHERWISE DIRECTED. INSTALLATION OF ALL SYSTEMS AND EQUIPMENT SHALL BE IN ACCORDANCE WITH APPLICABLE CODES AND IN ACCORDANCE WITH MANUFACTURER'S INSTALLATION INSTRUCTIONS. WHERE WORK DESCRIBED IN THE SPECIFICATIONS IS IN CONFLICT WITH THE WORK SHOWN ON THE DRAWINGS, THE CONTRACTOR SHALL SUPPLY THE GREATER QUANTITY, QUALITY AND COST VIA THE BID AND CONTACT THE ENGINEER FOR CLARIFICATION ON DIRECTION PRIOR TO INSTALLATION.

PRIOR TO BD, THE CONTRACTOR SHALL REVIEW THE MECHANICAL, ELECTRICAL AND KITCHEN EQUIPMENT DRAWINGS. THE CONTRACTOR SHALL INCLUDE IN HIS BID ALL RELEVANT WORK IN THE ENTIRE SET OF DOCUMENTS AND REPORT ALL DISCREPANCIES BETWEEN THESE DRAWINGS TO THE ENGINEER PRIOR TO BIDDING FOR CLARIFICATION. IF DISCREPANCIES REMAIN UNRESOLVED DUE TO A SHORT TIME FRAME, THE CONTRACTOR SHALL INCLUDE THE MOST WORK AND THE HIGHER COSTS IN THE BID. SOLUTIONS TO UNREPORTED DISCREPANCIES WILL BE DETERMINED BY THE ARCHITECT/ENGINEER, WITH NO ADDITIONAL COMPENSATION DUE TO THE CONTRACTOR.

KEYED NOTES

M1 ARROW INDICATES DIRECTION OF EXHAUST FAN HINGE SWING (TYP.)
 M2 6"Ø ALUMINUM EXHAUST DUCT FROM EXHAUST FAN (EF-5). PROVIDE PORTALS PLUS PLASTI-FLASH WITH C-126 CAP (OR EQUAL) FOR ROOF PENETRATION.
 M3 NOT USED
 M4 NOT USED
 M5 NOT USED
 M6 NOT USED
 M7 NOT USED
 M8 NOT USED
 M9 ROOF PIPE PORTAL FOR MAC UNIT
 M10 ROOF PIPE PORTAL FOR CONDENSING UNITS
 M11 ROOF PIPE PORTAL FOR ROOFTOP UNITS (TYP. 3 PLACES)
 M12 GAS PIPING FROM ROOF PORTAL TO ROOFTOP UNIT SHALL BE COATED WITH A CORROSION RESISTANT PAINT (SEE GAS PIPING NOTES)
 M13 GAS PRESSURE REGULATOR AND SHUT-OFF VALVE (TYP.)
 M14 ARROW INDICATES DIRECTION OF AIRFLOW FOR CONDENSING OR ROOFTOP UNIT AIR INTAKE (TYP.)
 M15 REFRIGERANT PIPING SUPPORT AS REQUIRED. PROVIDE ROOFTOP BLOX MODEL RTB-01 (OR EQUAL) AND ALL NECESSARY ACCESSORIES FOR PROPER PIPE AND CONDUIT SUPPORT. PROVIDE GALVANIZED PIPE SHIELD TO PROTECT INSULATION AT ALL SUPPORTS.

PIPE PORTAL SCHEDULE


MANUFACTURER	CURB DIMENSIONS	CURB TYPE	CAP TYPE (QTY)	SERVES
RPS	12"x12"x11"H	RC-2A	N18 (1)	RTU-1 THROUGH RTU-3
RPS	43"x12"x13"H	RC-2A	N18 (3)	CU-4
RPS	27"x12"x13"H	RC-2A	N18 (2)	CU-1 THROUGH CU-3

SEQUENCE OF OPERATION

THERMOSTAT SETTINGS		
MODE	FAN	SETPOINTS
OCCUPIED	ON	COOLING 70°F HEATING 70°F
UNOCCUPIED	AUTO	90°F 55°F
HUMIDITY SETPOINT (FOR DEHUMIDIFICATION UNITS ONLY)		
DEMAND CONTROL VENTILATION		
CO2 (FOR DCV)	MINIMUM 400 PPM	MAXIMUM 1000 PPM

- RTU-1, RTU-2 & RTU-3:
 1. OCCUPIED MODE SHALL BEGIN AS FOLLOWS:
 • RTU-1: 1.5 HOURS BEFORE OPEN
 • RTU-2: 1 HOUR BEFORE OPEN
 • RTU-3: 30 MINUTES BEFORE OPEN
 2. ROOFTOP UNIT FAN SHALL RUN CONTINUOUSLY DURING OCCUPIED MODE
 3. ECONOMIZER SHALL BE OPEN DURING OCCUPIED MODE (OUTDOOR AIR THROUGH ROOFTOP UNITS SERVES AS MAKE-UP AIR FOR THE KITCHEN EXHAUST SYSTEM) – REFER TO E3.2 FOR HOOD/FAN INTERLOCK DETAILS.
 4. UNOCCUPIED MODE SHALL BEGIN ONE (1) HOUR AFTER STORE CLOSES
 5. DURING UNOCCUPIED MODE, ECONOMIZER IS CLOSED AND HEATING, COOLING AND FAN OPERATE IN AUTO MODE (ON DEMAND)

SHEET NO.	TITLE	DRAWN BY	REVIEWED BY
015-0071.00.B	2019 STANDARD BUILDING - BB20 4597F10-WOOD/WOOD	M.J.W 2019-11	W.L.W 2019-11
DESCRIPTION		STD ISSUE DATE	
WOOD BEARING WALLS W/ FIBER CEMENT SIDING & CI WOOD ROOF TRUSS FRAMING FIBER CEMENT PANEL/BATTEN/ALPOLIC PANEL/BRICK EXT. FINISH		01/23/20	
SITE ID	SITE ADDRESS	REV DATE	
015-0071	605 SOUTH 7TH STREET, KANSAS CITY, KS	M1.0	
DRAWN BY: McDonald's USA, LLC PREPARED BY: Michael Weber, PE CONSULTING ENGINEERS 3801.0037 Emmanuelson-podas Emmanuelson-Pods, Inc. Edina, MN 55439 (952) 930-0050 www.epinc.com			
REVIEWED BY: 12/03/20			
DATE: 12/03/20			
DESCRIPTION: SERVICE AREA OPTIMIZATION			
REV DATE: 11/13/20			
DATE: 05/05/20			
DESCRIPTION: CIVIL & PLAN REVIEW COMMENTS			
REV DATE: 01/23/20			
DESCRIPTION: PERMIT SET			
REV DATE: 01/13/20			
DESCRIPTION: PROGRESS SET REVIEW			
REV DATE: BY			

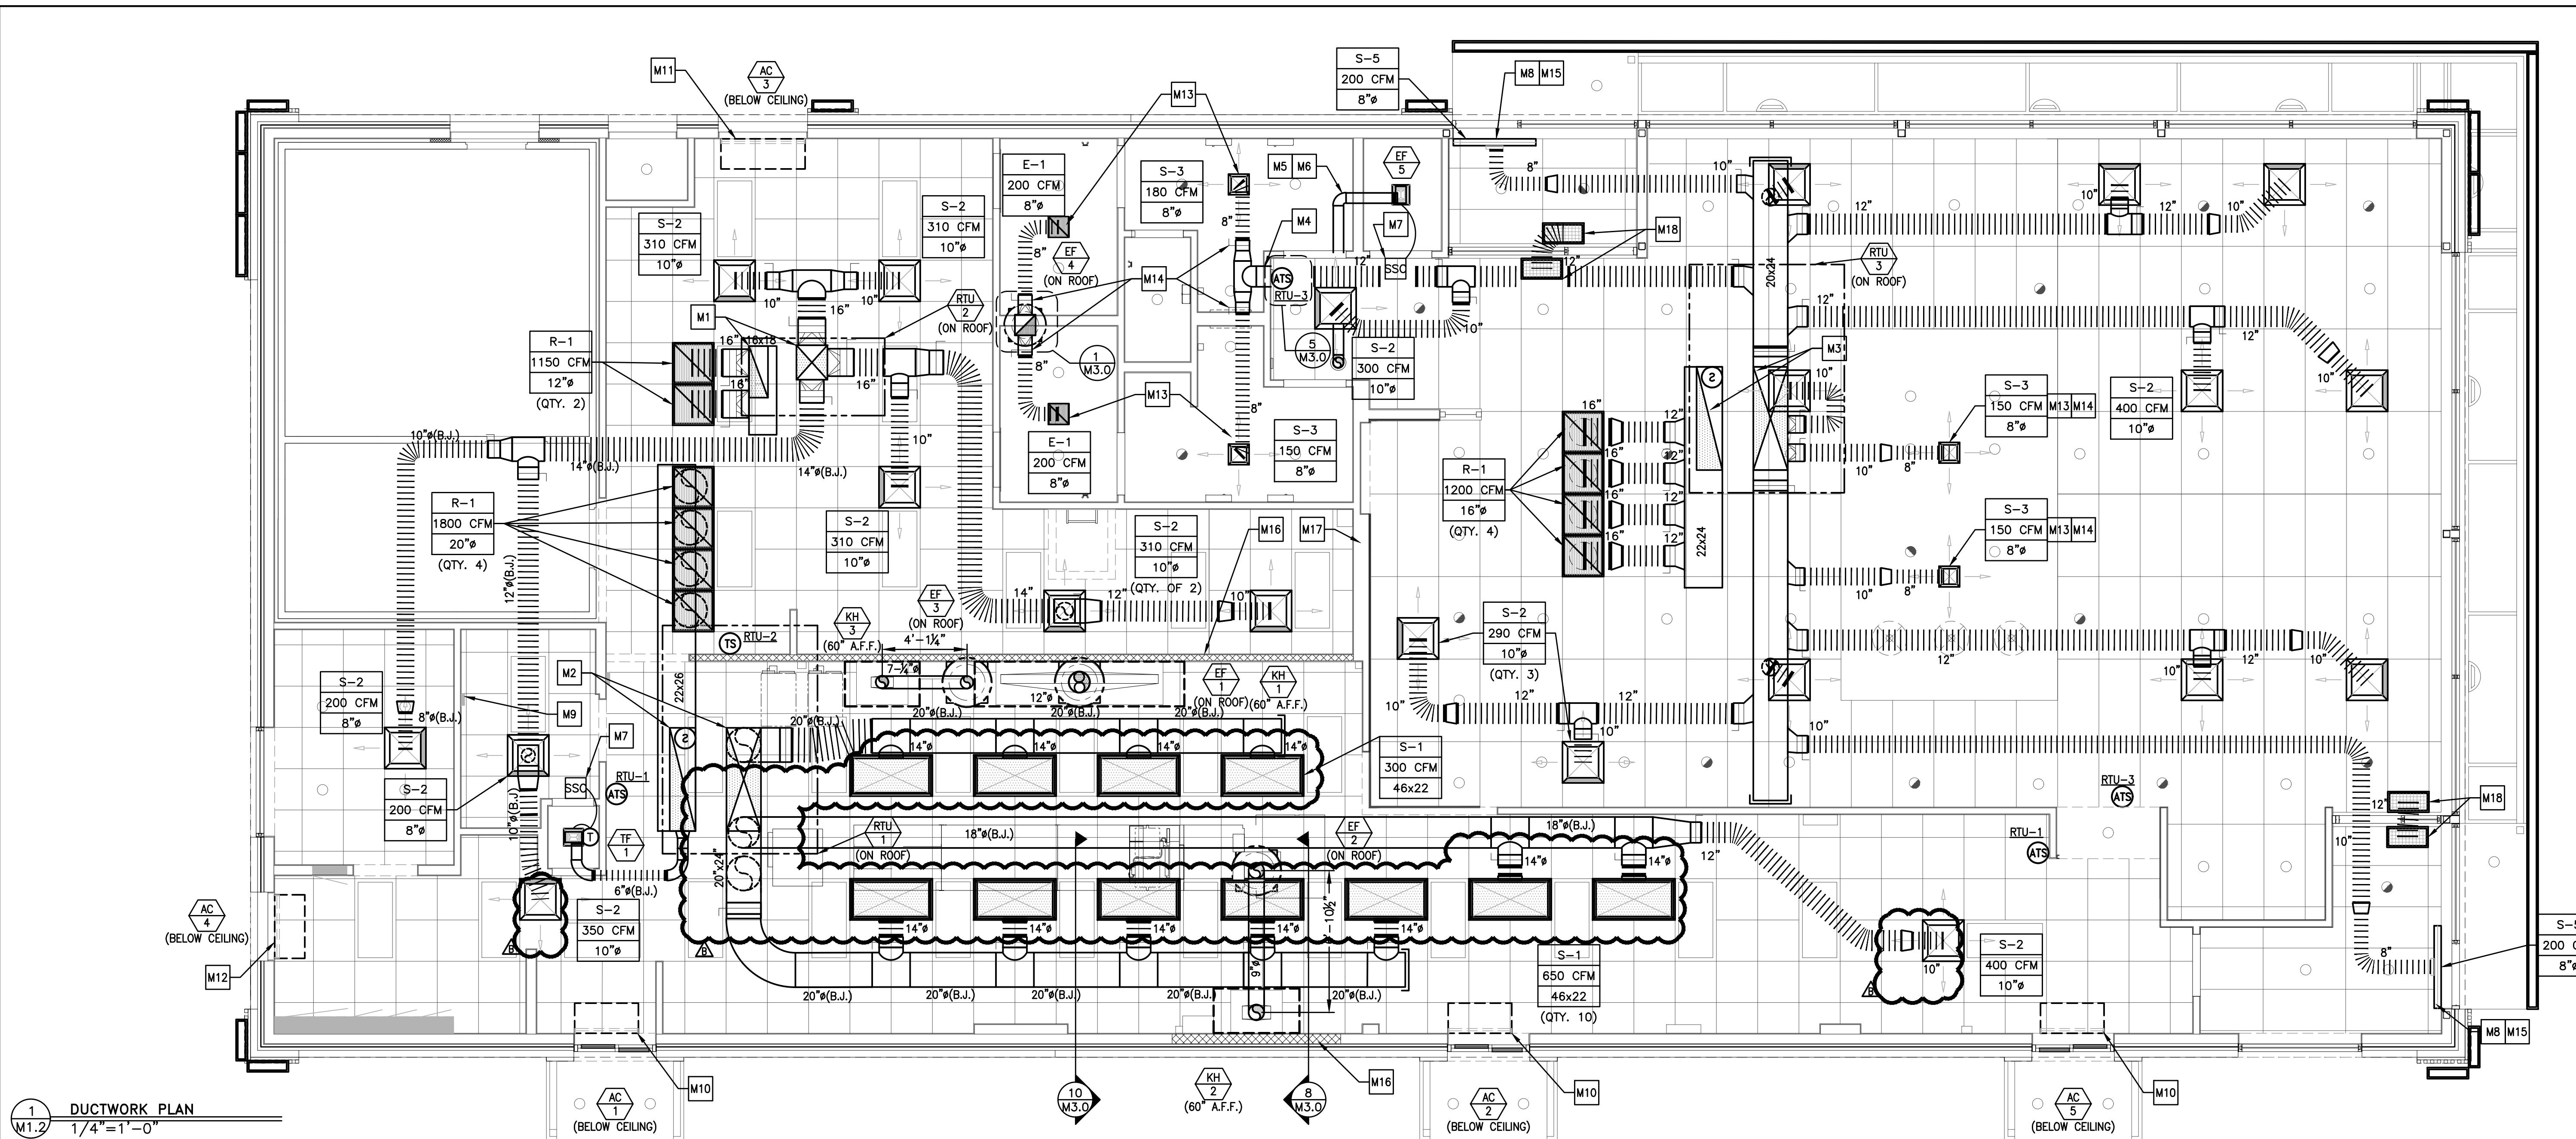

DRAWING NOTES

- ALL DUCTWORK SHALL BE RUN BETWEEN OR THROUGH THE JOISTS UNLESS NOTED OTHERWISE. DUCTWORK DESIGNATED WITH (B.J.) SHALL BE RUN BELOW THE JOISTS.
- DUCT SIZES SHOWN ARE INTERNAL FREE AREA DIMENSIONS UNLESS NOTED OTHERWISE.
- ALL SHEET METAL DUCTWORK SHALL BE EXTERNALLY INSULATED. INSULATION IS NOT SHOWN FOR CLARITY. SEE MECHANICAL NOTES FOR INSULATION REQUIREMENTS.
- CARBON STEEL KITCHEN EXHAUST DUCTWORK SHALL BE EXTERNALLY INSULATED. INSULATION NOT SHOWN FOR CLARITY. SEE MECHANICAL NOTES AND DETAILS FOR INSULATION REQUIREMENTS.
- RETURN AIRFLOW VOLUME SHOWN ON PLAN IS FOR DUCTWORK SIZING PURPOSES WHEN THE UNIT IS IN RECIRCULATION (UNOCCUPIED) MODE.
- DIFFUSERS IN DINING ROOM ARE SPECIFIC TO THE DECOR PLAN SHOWN. DIFFERENT CEILING LAYOUTS MAY REQUIRE A DIFFERENT DIFFUSER TYPES, QUANTITIES, LOCATIONS AND FINISHES/COLORS.

KEYED NOTES

- M1 18x20 SUPPLY AND 11x30 RETURN DUCT DROPS FROM ROOFTOP UNIT (RTU-2)
- M2 20x60 SUPPLY AND 15x60 RETURN DUCT DROPS FROM ROOFTOP UNIT (RTU-1)
- M3 20x60 SUPPLY AND 15x60 RETURN DUCT DROPS FROM ROOFTOP UNIT (RTU-3)
- M4 PROVIDE SHEET METAL DUCT AT ALL DRAFTSTOP WALL PENETRATIONS (TYP.) (WHERE REQUIRED BY CODE.)
- M5 6"Ø ALUMINUM DUCT FROM EXHAUST FAN UP THROUGH ROOF
- M6 EXTERNALLY INSULATE EXHAUST DUCT FROM FAN TO ROOF PENETRATION
- M7 STEADY STATE SPEED CONTROLLER FOR CEILING MOUNTED EXHAUST FAN. STEADY STATE SPEED CONTROLLER SHALL BE INSTALLED OVER SUSPENDED CEILING FOR ACCESS. DO NOT INSTALL OVER AREAS WITH DRYWALL CEILINGS.
- M8 SET DIFFUSER (S-5) FOR VERTICAL AIR THROW PATTERN (TYP.)
- M9 BUILDING AUTOMATION SYSTEM LOCATION. SEE LIGHTING CONTROL DETAILS ON SHEET E4.1.
- M10 MOUNT AIR CURTAIN TIGHT TO CEILING
- M11 MOUNT AIR CURTAIN WITH BOTTOM OF UNIT AT TOP OF DOOR FRAME
- M12 MOUNT AIR CURTAIN WITH BOTTOM OF UNIT ABOVE DOOR FRAME AND TOP OF SWITCHGEAR TO MEET 3'-0"
- M13 MINIMUM SWITCHGEAR'S CLEARANCE REQUIREMENT
- FOR DIFFUSERS INSTALLED IN DRYWALL CEILINGS, VOLUME DAMPER IS INTEGRAL TO DIFFUSER AND ADJUSTABLE AT FACE OF DIFFUSER (SEE NOTE 18 UNDER "VENTILATION SYSTEMS" ON DRAWING M4.0 AND AIR DEVICE SCHEDULE ON DRAWING M4.1)
- M14 FOR DIFFUSERS INSTALLED IN DRYWALL CEILINGS, INSTALL HIGH-EFFICIENCY TAKE-OFFS WITH VOLUME DAMPER IN FULL-OPEN POSITION TO FACILITATE BALANCING AT FACE OF DIFFUSER.
- M15 GENERAL CONTRACTOR SHALL PROVIDE ADDITIONAL T-BAR FRAME TO PROPERLY LOCATE DIFFUSER AS SHOWN. AIR STREAM FROM DIFFUSER SHALL COVER ENTIRE DOOR OPENING.
- M16 NONCOMBUSTIBLE WALL CONSTRUCTION BEHIND TYPE I KITCHEN HOODS. REFER TO SHEET A1.0 FOR MORE INFORMATION.
- M17 CONTRACTOR TO PROVIDE LOUVRED RETURN AIR BEHIND EACH MENU BOARD.

M18 PROVIDE TITUS 50F OR EQUAL, 24x12 OPEN CEILING GRATE PAINTED TO MATCH CEILING. PROVIDE PLASTER FRAMING FOR DRYWALL CEILING APPLICATIONS.

2015 IMC SECTION 403.3 - VENTILATION SCHEDULE

UNIT	AREA SERVED	AREA FT ²	CFM/PERSON	CFM/FT ³	PEOPLE OR PEOPLE/1000 FT ³	UNCORRECTED REQUIRED O/A CFM	Ez*	REQUIRED O/A CFM (Vot)**	ACTUAL O/A CFM	REQUIRED EXHAUST CFM	ACTUAL EXHAUST CFM
RTU-1	PRESENTER	352	5	0.06	4	42	0.8	0.90			
	KITCHEN	682	7.5	0.18	18		0.8				
RTU-2	SUPPORT	574	0	0.12	0	69	0.8	0.90	-	-	
	MANAGER'S OFFICE	59	5	0.06	1	9	0.8		-	-	
	CREW ROOM	99	5	0.06	5	31	0.8		-	-	
	ORDER	140	5	0.06	7	43	0.8		-	-	
RTU-3	DINING	1759	7.5	0.18	95	1030	0.8	0.91	151	168	400
	PRESENTER	0	5	0.06	0	0	0.8		-	-	
	VESTIBULE 1	90	0	0.06	0	5	0.8		-	-	
	VESTIBULE 2	53	0	0.06	0	3	0.8		-	-	
	WOMEN'S	136	0	0.06	0	8	0.8		-	-	
	MEN'S	122	0	0.06	0	7	0.8		-	-	
RTU-4	PLAYPLACE	0	7.5	0.18	0	1054		0.96	1080	1330	
	EATERY	1000	7.5	0.18	100	1080	0.8		0	0	
EF-1, 2 & 3	KITCHEN	682	-	0.7	-	-	-	-	-	477	2405
EF-4	WOMEN'S	136	-	-	-	-	-	-	100	200	
EF-6	MEN'S	122	-	-	-	-	-	-	100	200	
	PLAYPLACE (UNISEX)	0	-	-	-	-	-	-	0	0	


* Zone Air Distribution Effectiveness Based on ASHRAE 62.1 Table 6.2 for Ceiling Supply of Warm Air 15° F or More Above Space Temperature and Ceiling Return (IMC Table 403.3.1.2)

** Ventilation System Efficiency Based on ASHRAE 62.1 Table 6.3 and Section 6.2.5 (IMC Section 403.3.2 MZ)

*** Corrected Required O/A Intake Required for System Calculated Based on ASHRAE 62.1 Section 6.2 (IMC Section 403.3)

TITLE	2019 STANDARD BUILDING - BB20	STD ISSUE DATE	2019-11	REVIEWED BY	WLW
DESCRIPTION	4597F10-WOOD/WOOD	DATE ISSUED	01-23-20		
WOOD BEARING WALLS W/FIBER CEMENT SIDING & CI		PERMIT SET			
WOOD ROOF TRUSS FRAMING		PROGRESS SET REVIEW			
FIBER CEMENT PANEL/BATTEN/ALPOLIC PANEL/BRICK EXT. FINISH		REV. DATE			
SITE ID	015-0071.00.B				
SHEET NO.	M1.2				
DUCTWORK PLAN					

DESCRIPTION	BY
W.L.W.	12/03/20
W.L.W.	11/13/20
W.L.W.	05/05/20
W.L.W.	01/23/20
W.L.W.	01/13/20

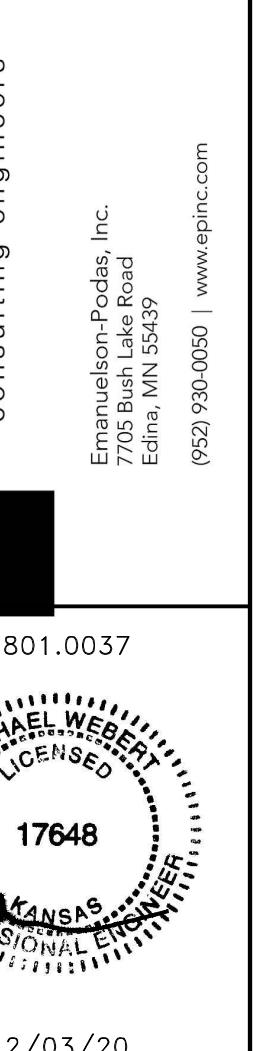


© 2020 McDonald's USA, LLC
These drawings and specifications are the confidential and proprietary property of McDonald's USA, LLC and shall not be copied or reproduced in whole or in part without the express written consent of McDonald's USA, LLC and its licensors. These drawings and specifications are issued in confidence and are not suitable for use on this specific site or on a later time or for another project. Use of these drawings for reference or example on another project requires the services of properly licensed architects and engineers. Reproduction of the contact documents for reuse on another project is not authorized.

PREPARED FOR:
McDonald's USA, LLC
These drawings and specifications are the confidential and proprietary property of McDonald's USA, LLC and shall not be copied or reproduced in whole or in part without the express written consent of McDonald's USA, LLC and its licensors. These drawings and specifications are issued in confidence and are not suitable for use on this specific site or on a later time or for another project. Use of these drawings for reference or example on another project requires the services of properly licensed architects and engineers. Reproduction of the contact documents for reuse on another project is not authorized.

NOTES:
1. BALANCING TOLERANCES ARE AS FOLLOWS:
HOODS: 0% TO +10%
OUTDOOR AIR: 0% TO +10%
SUPPLY AND RETURN AIR DIFFUSERS: -10% TO +10%
TOILET EXHAUST: -10% TO +10%
2. BALANCE ROOFTOP UNIT SUPPLY AND RETURN AIR PRIOR TO TURNING ON EXHAUST FANS.
3. EXHAUST HOODS SHALL BE BALANCED WITH A 4" VANE ANEMOMETER.
4. RTU BLOWER TO RUN CONTINUOUSLY DURING OCCUPIED HOURS.
REFER TO SEQUENCE OF OPERATIONS ON M1.0 AND E3.2 FOR HOOD/FAN INTERLOCK DETAILS.

HEATING SCHEDULE			
EQUIPMENT	INPUT (kW)	OUTPUT (BTU/HR)	REQUIRED HEAT (BTU/HR)
ROOFTOP UNIT (RTU-1)	39	133,107	110,956
ROOFTOP UNIT (RTU-2)	13	44,369	42,383
ROOFTOP UNIT (RTU-3)	52	177,476	140,516
TOTALS	104	354,952	293,855

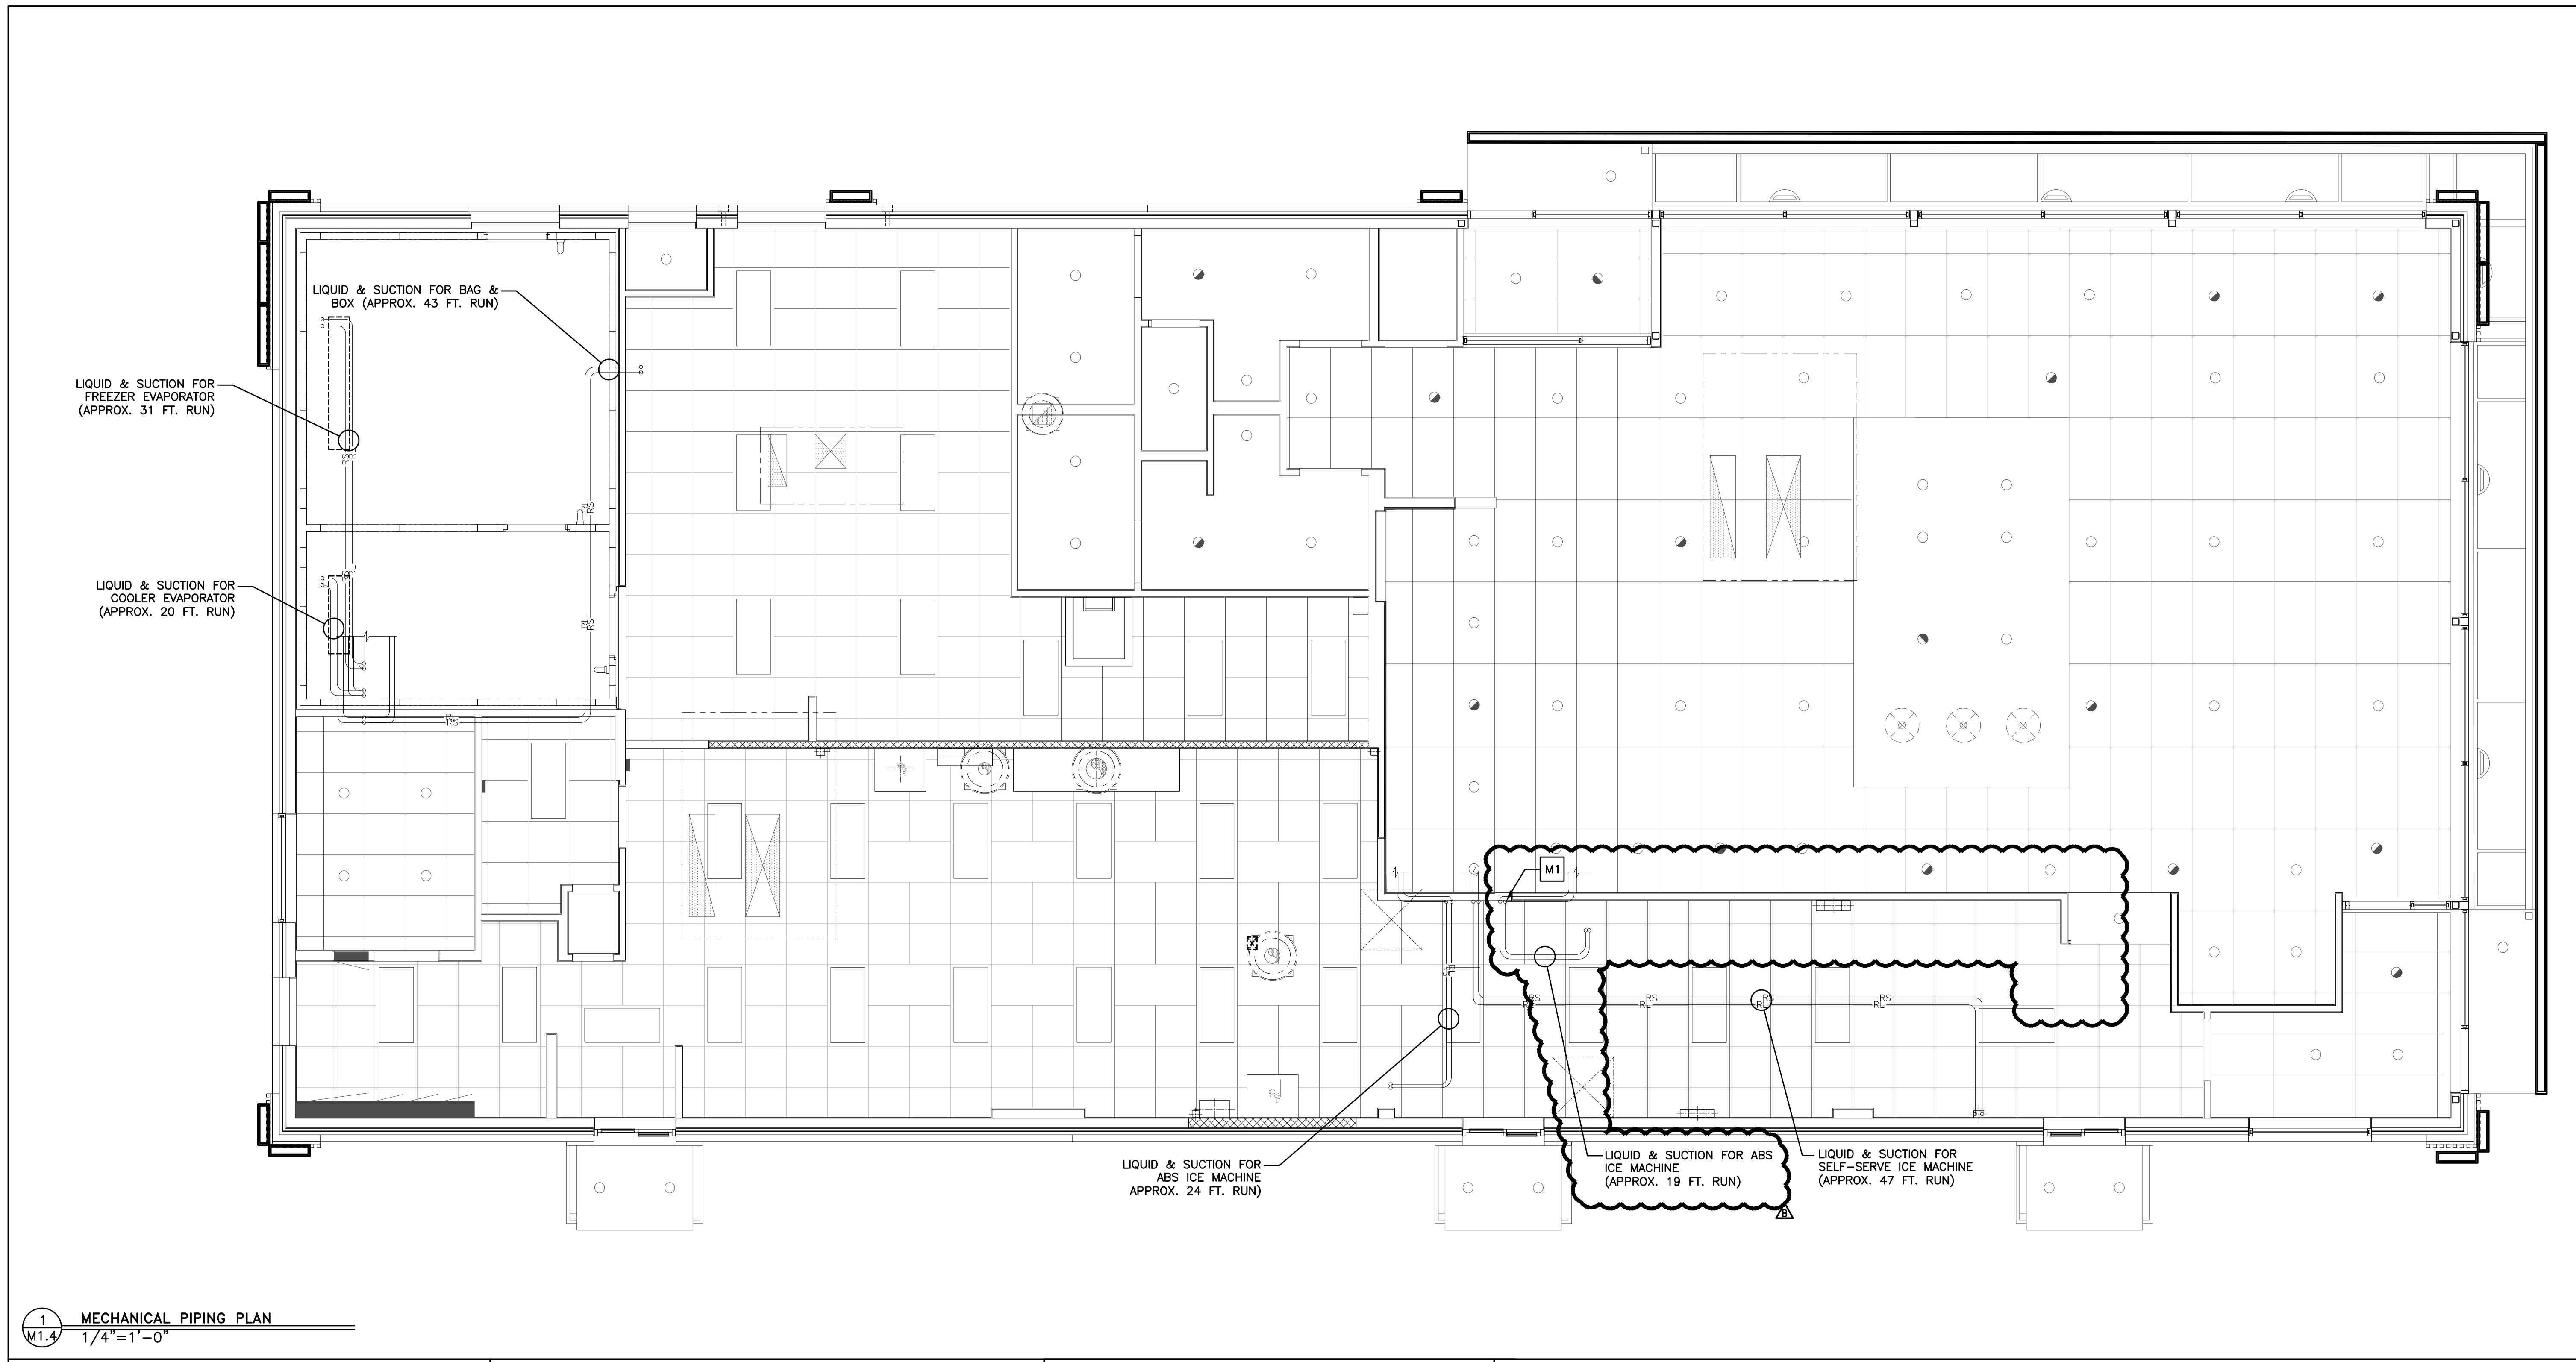

M1.4 MECHANICAL PIPING PLAN
1/4"=1'-0"

DRAWING NOTES

1. GAS PIPING LENGTHS ARE APPROXIMATE AND ARE SHOWN FOR SIZING PURPOSES ONLY.
2. REFRIGERANT PIPE SIZES SHALL BE PER MANUFACTURER'S INSTALLATION INSTRUCTIONS.


KEYED NOTES

- M1 REFRIGERANT LIQUID AND SUCTION LINES UP THROUGH ROOF TO CONDENSING UNITS (TYP. 6 PLACES - SEE DETAIL 3 ON DRAWING M3.0)

SHEET NO.	TITLE	PREPARED BY:	REVIEWED BY:	DATE ISSUED:	PERIODIC REVIEW:	DESCRIPTION:	BY:
015-0071.00.B	2019 STANDARD BUILDING - BB20 4597F10-WOOD/WOOD	M.J.W. 2019-11	W.L.W. 12/03/20			SERVICE AREA OPTIMIZATION	
						11/13/20 USD/SD SET REVIEW	
						05/05/20 CIVIL & PLAN REVIEW COMMENTS	
						01/23/20 PERMIT SET	
						01/13/20 PROGRESS SET REVIEW	
						REV DATE	DESCRIPTION

ep emanuelson-podas
consulting engineers

3801.0037

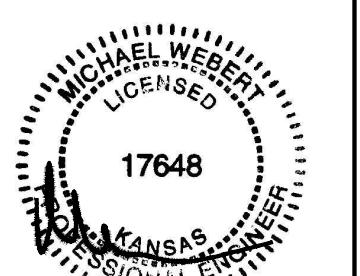

12/03/20

17648

KANSAS STATE BOARD OF EXAMINERS
FOR ARCHITECTS, ENGINEERS,
AND LAND SURVEYORS

12/03/20

17648

12/03/20

17648

12/03/20


17648

12/03/20


17648

12/03/20


17648</p

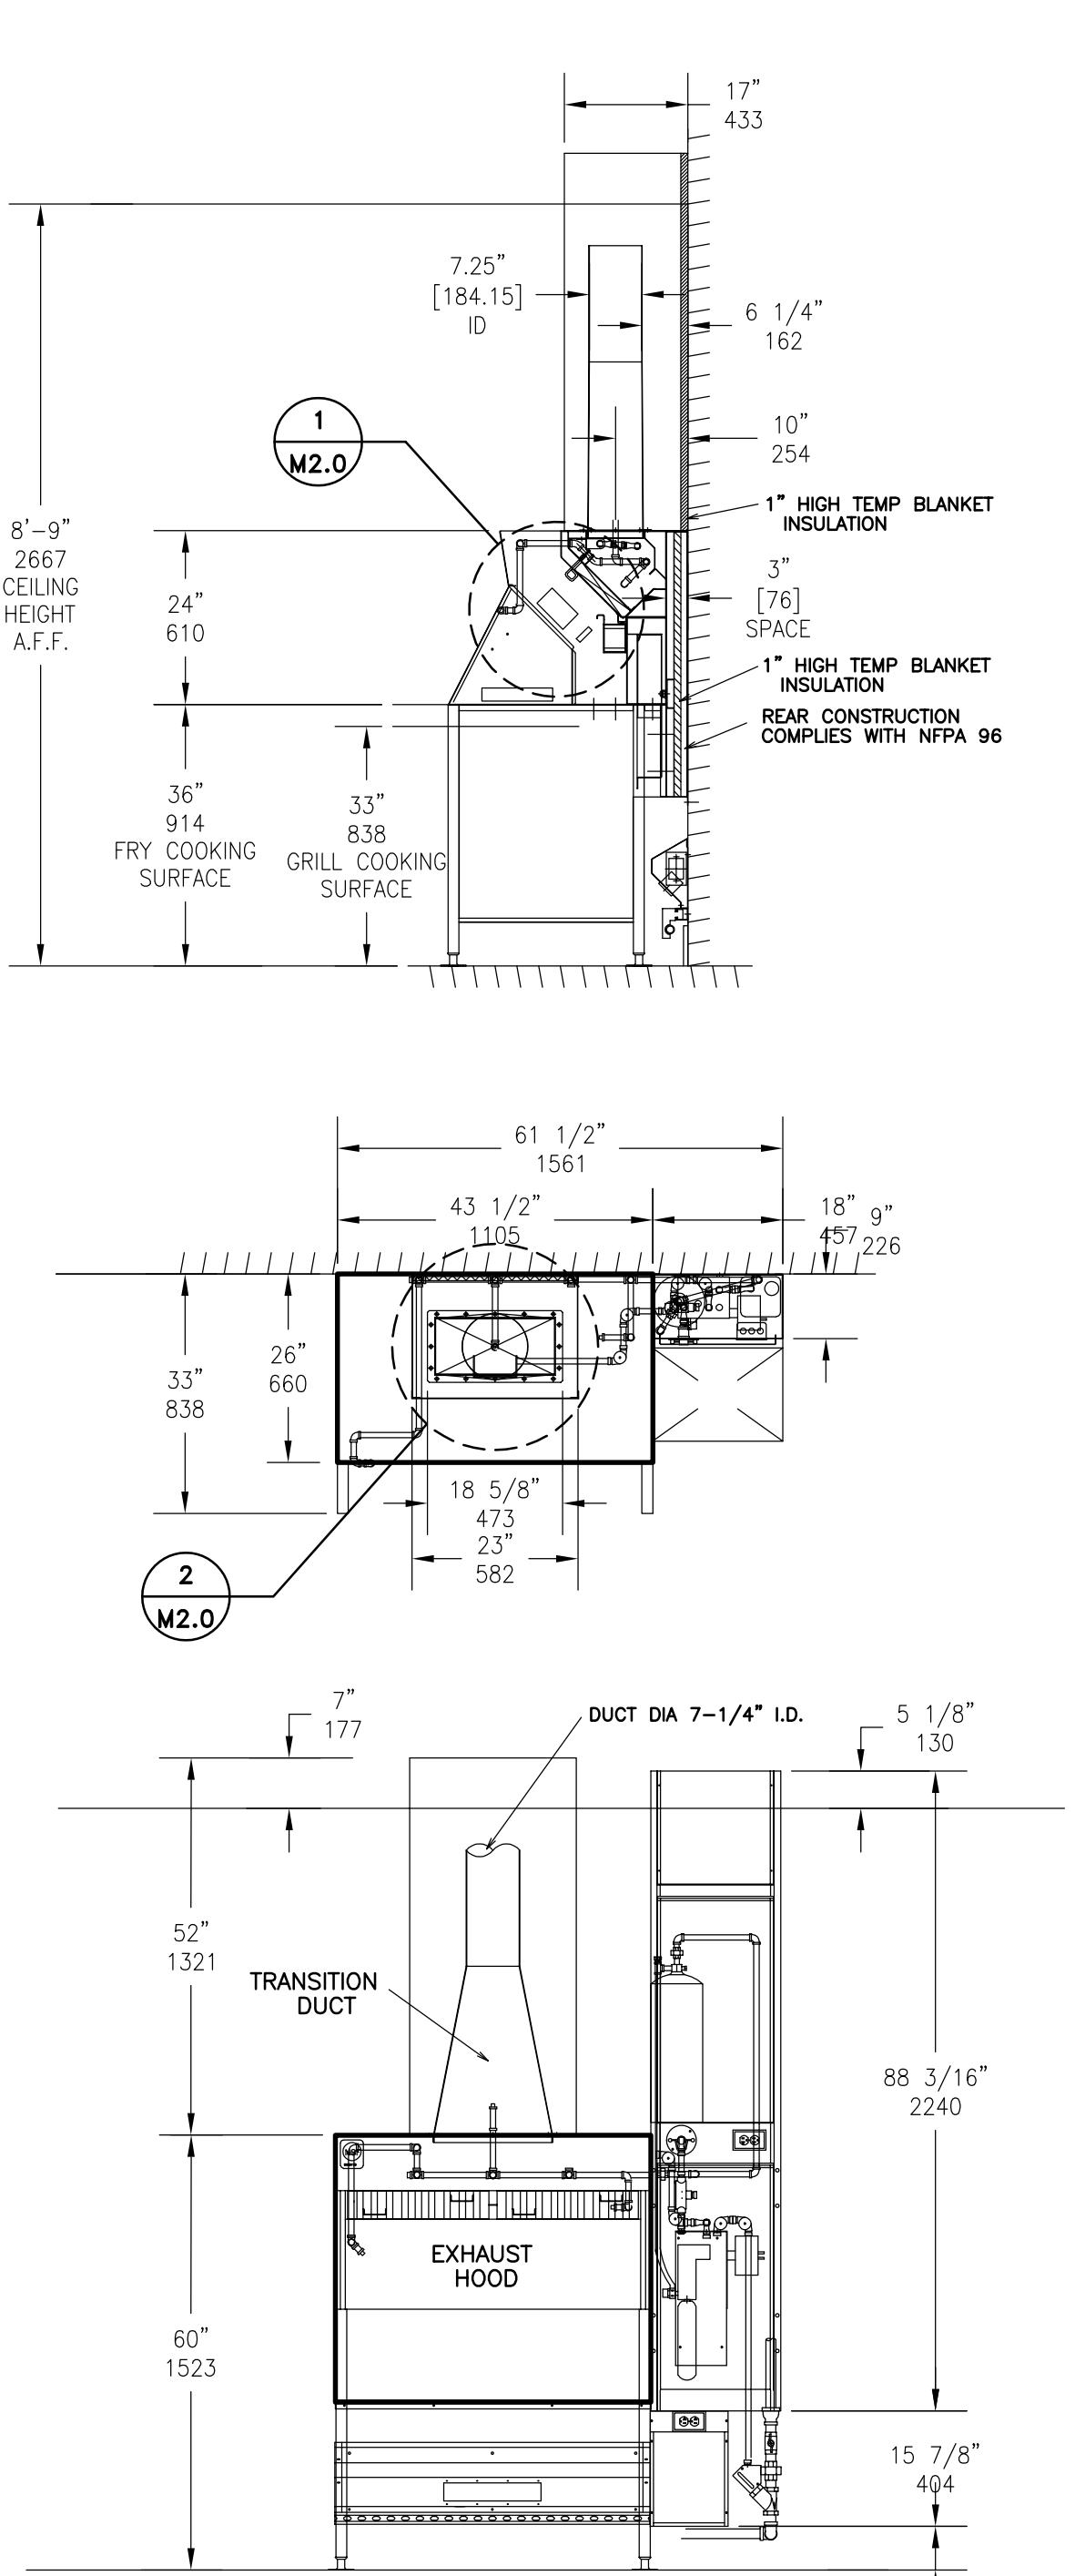


KITCHEN EXHAUST HOOD
TAG: KH-3 (SEE KITCHEN EXHAUST HOOD SCHEDULE)
SCALE: $\frac{1}{2}''=1'-0''$

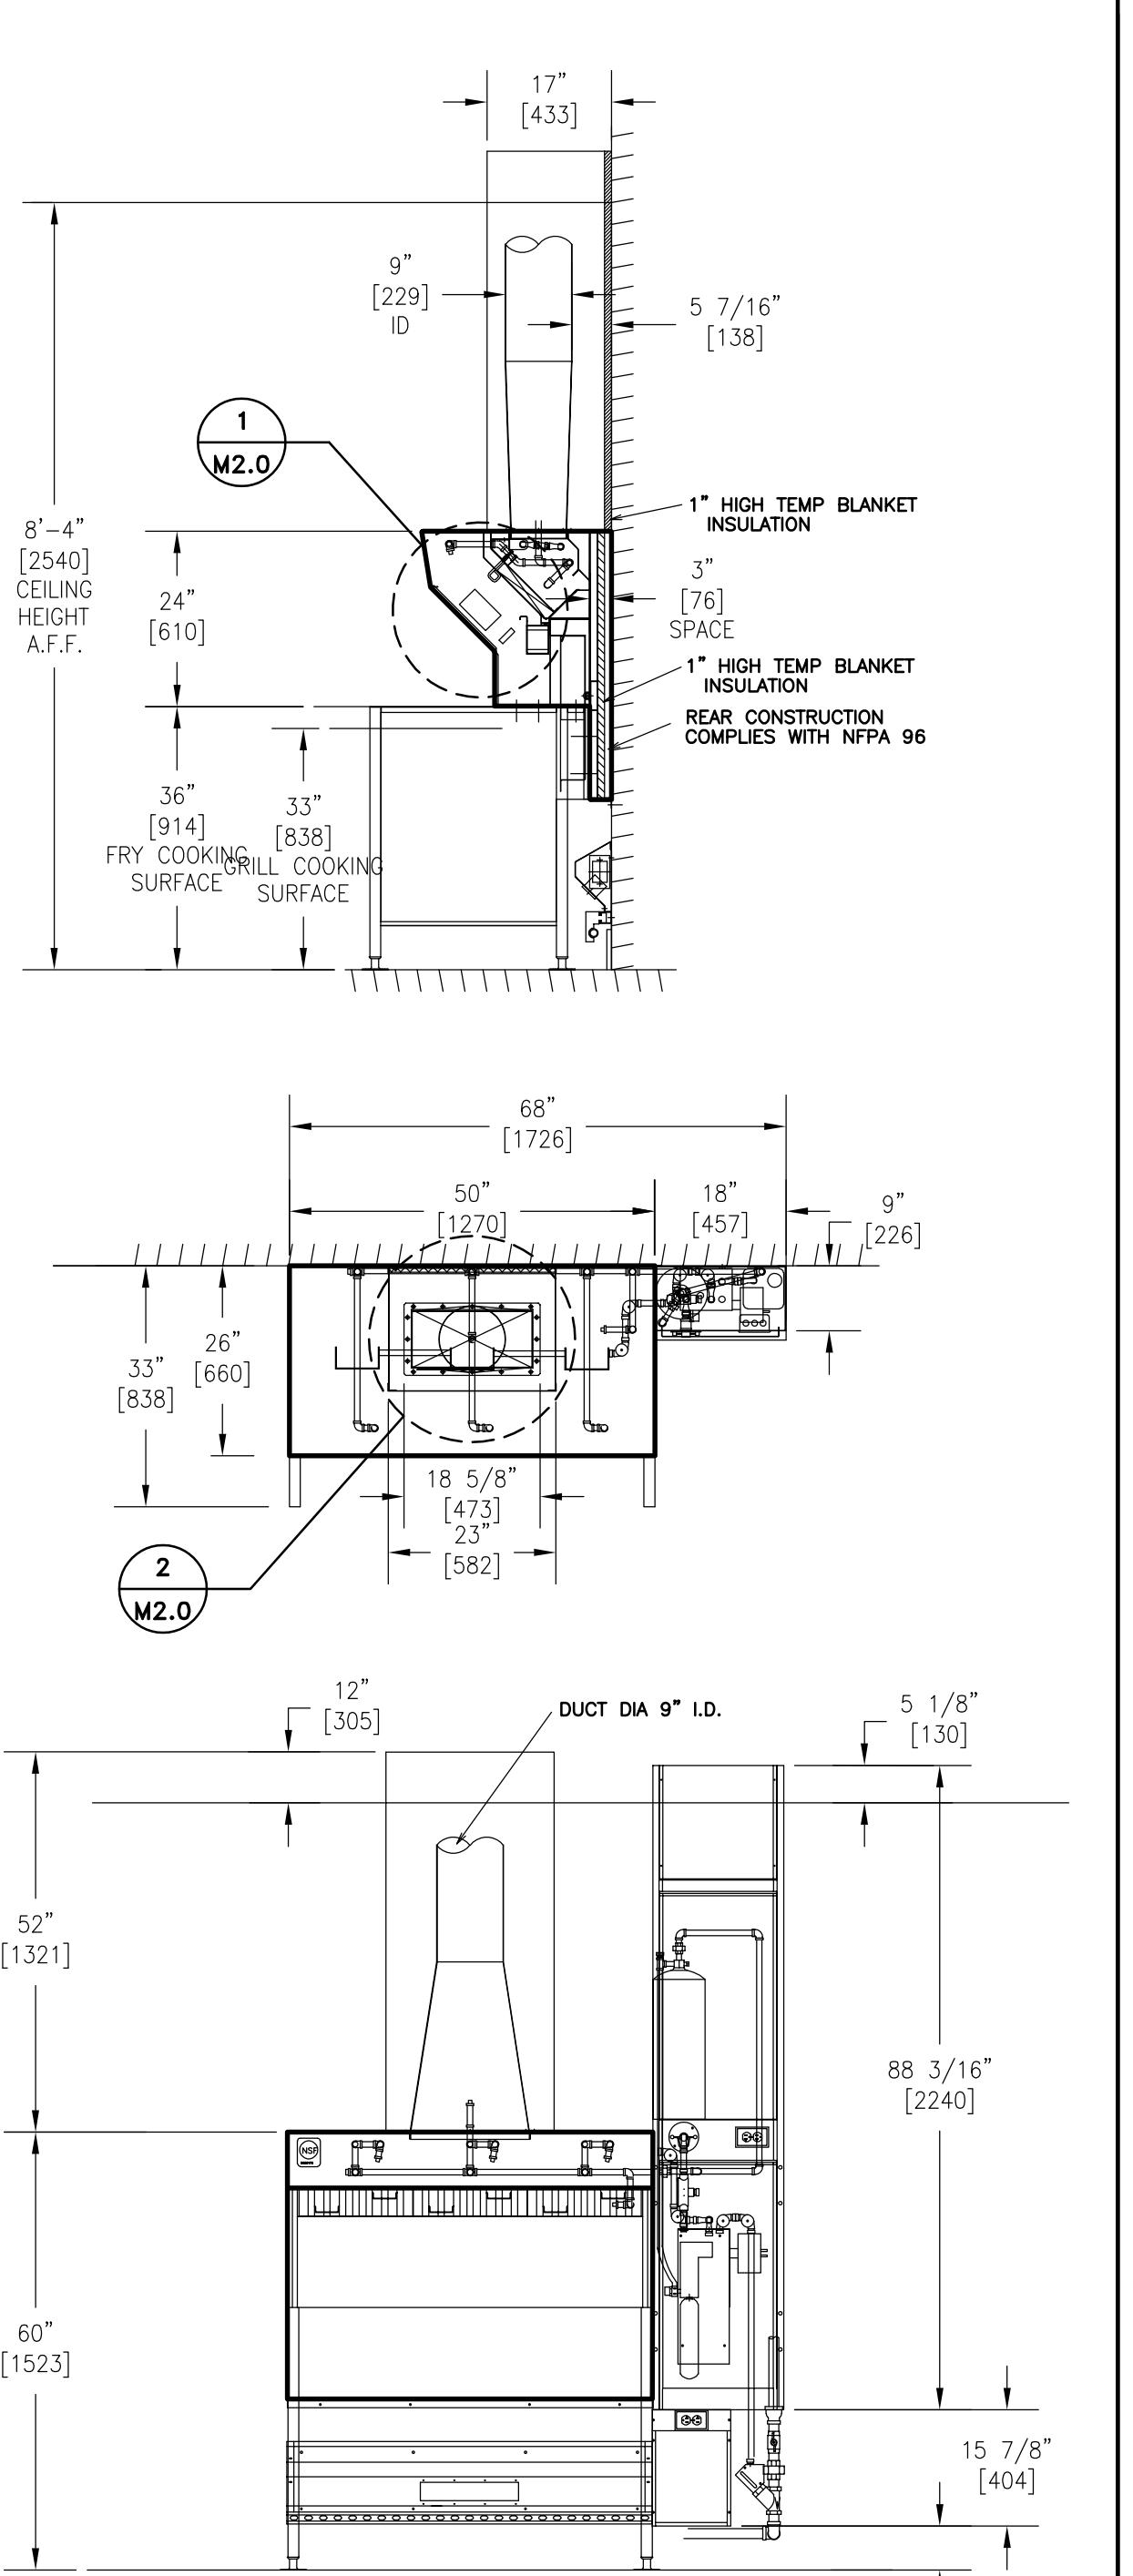


KITCHEN EXHAUST HOOD
TAG: KH-2, KH-3 (SEE KITCHEN EXHAUST HOOD SCHEDULE)
SCALE: $\frac{1}{2}''=1'-0''$

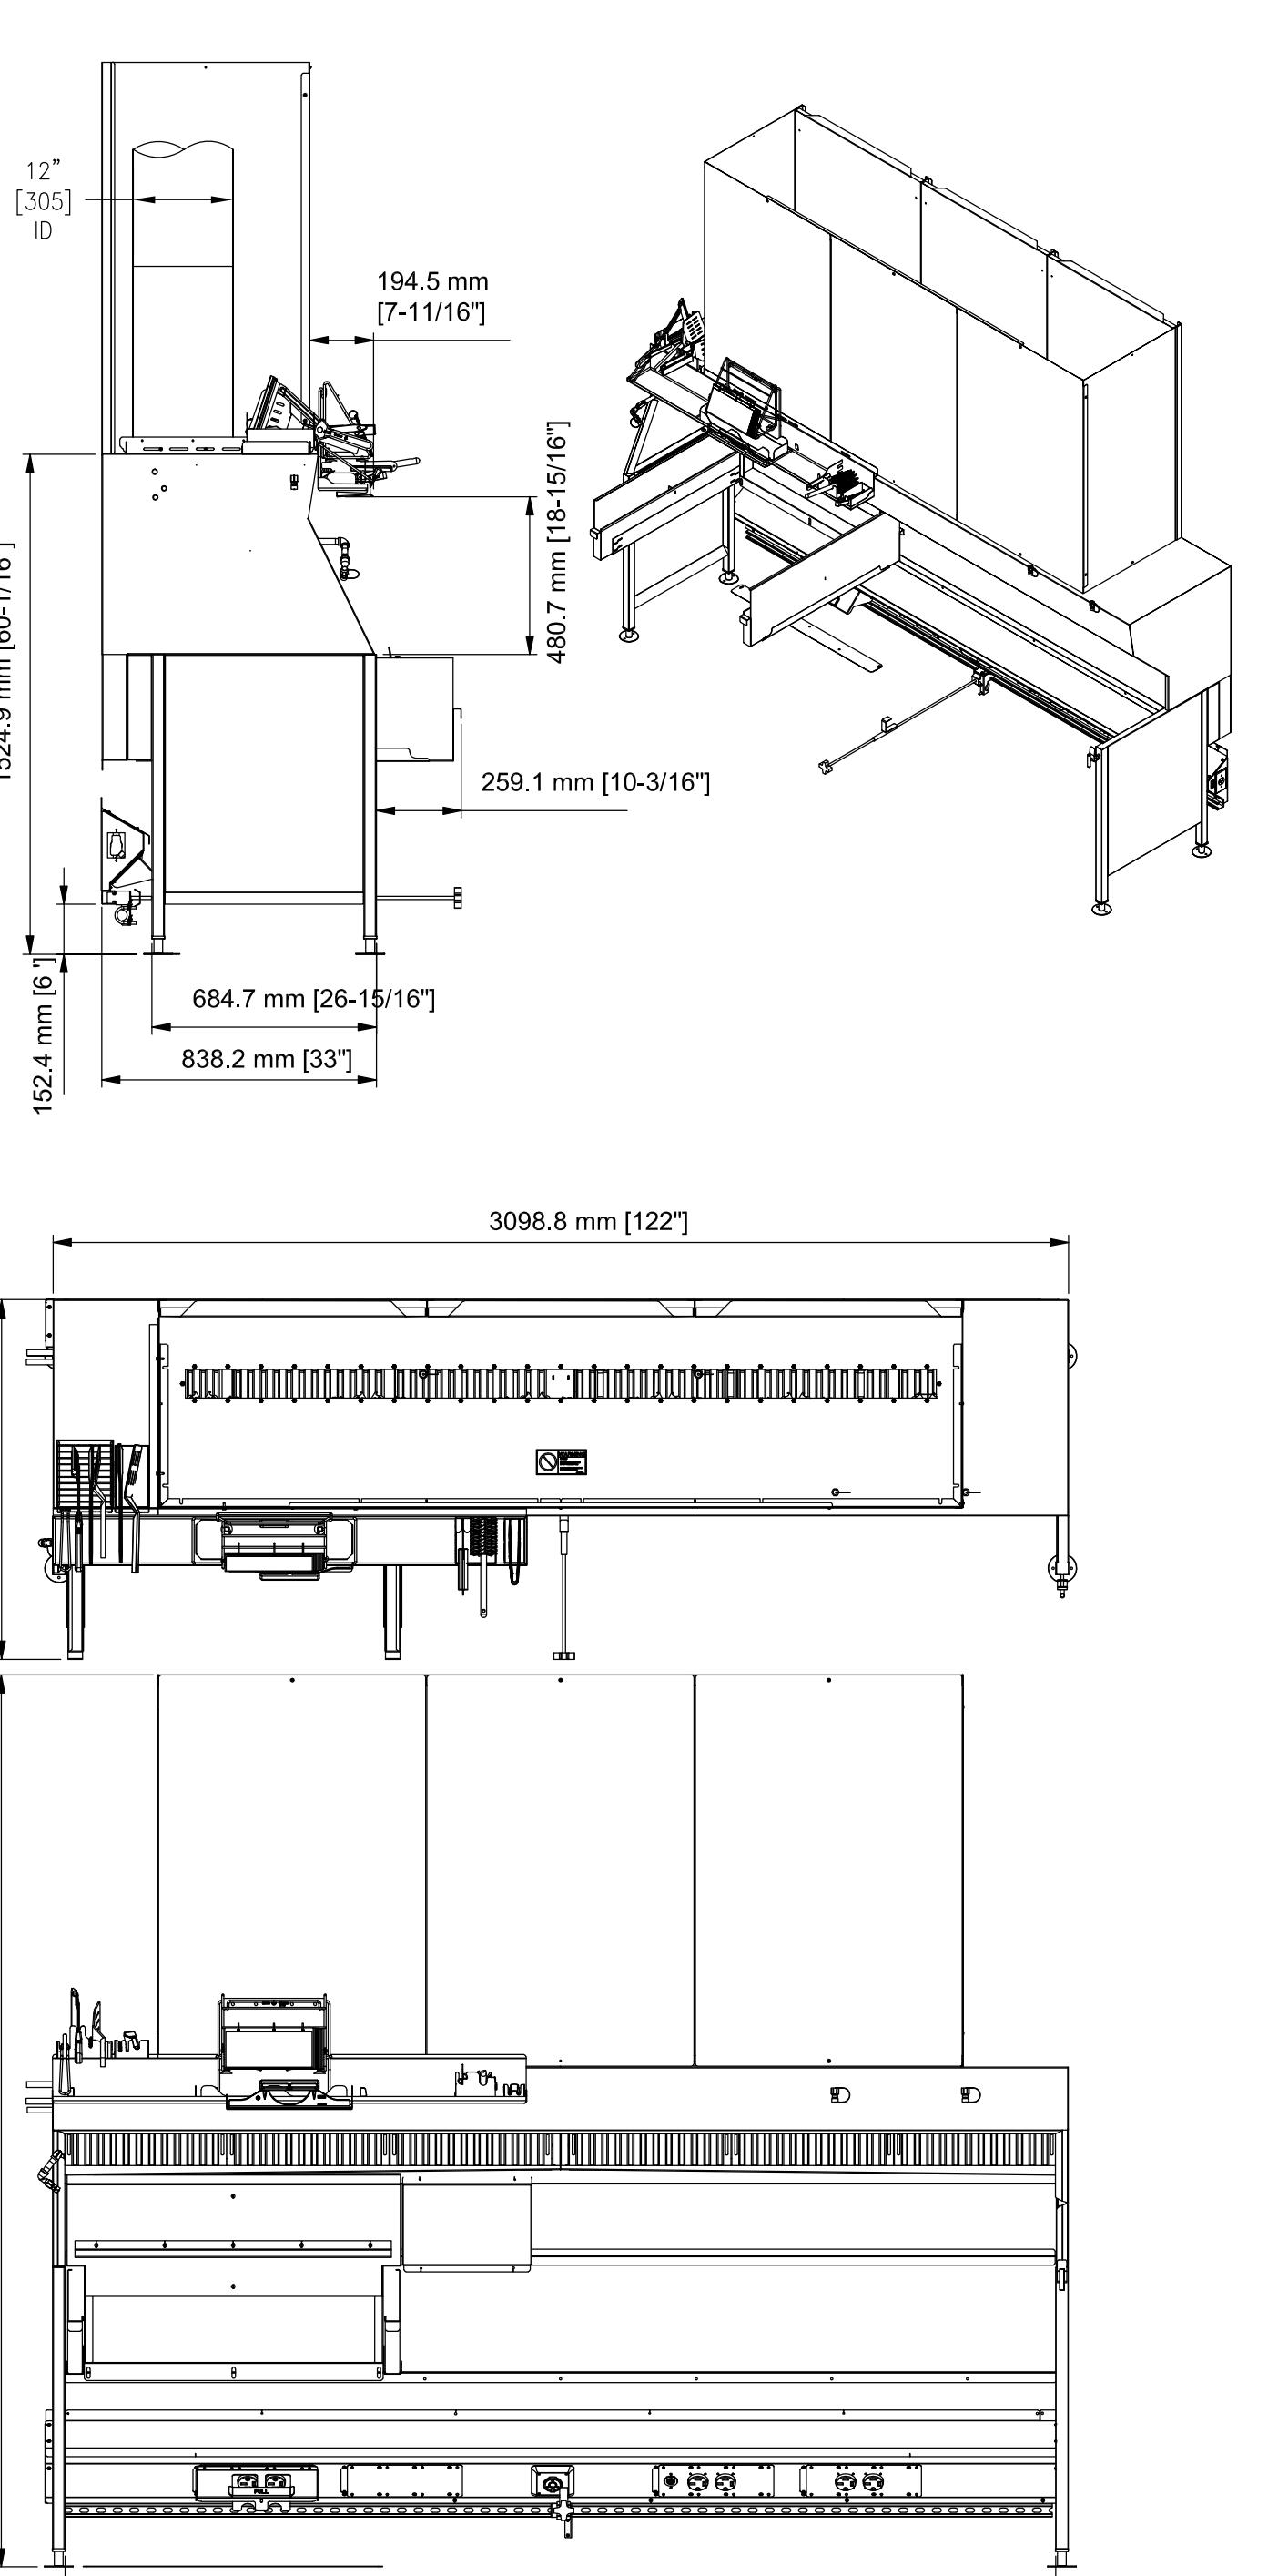

KITCHEN EXHAUST HOOD
TAG: KH-1 (SEE KITCHEN EXHAUST HOOD SCHEDULE)
SCALE: $\frac{1}{2}''=1'-0''$

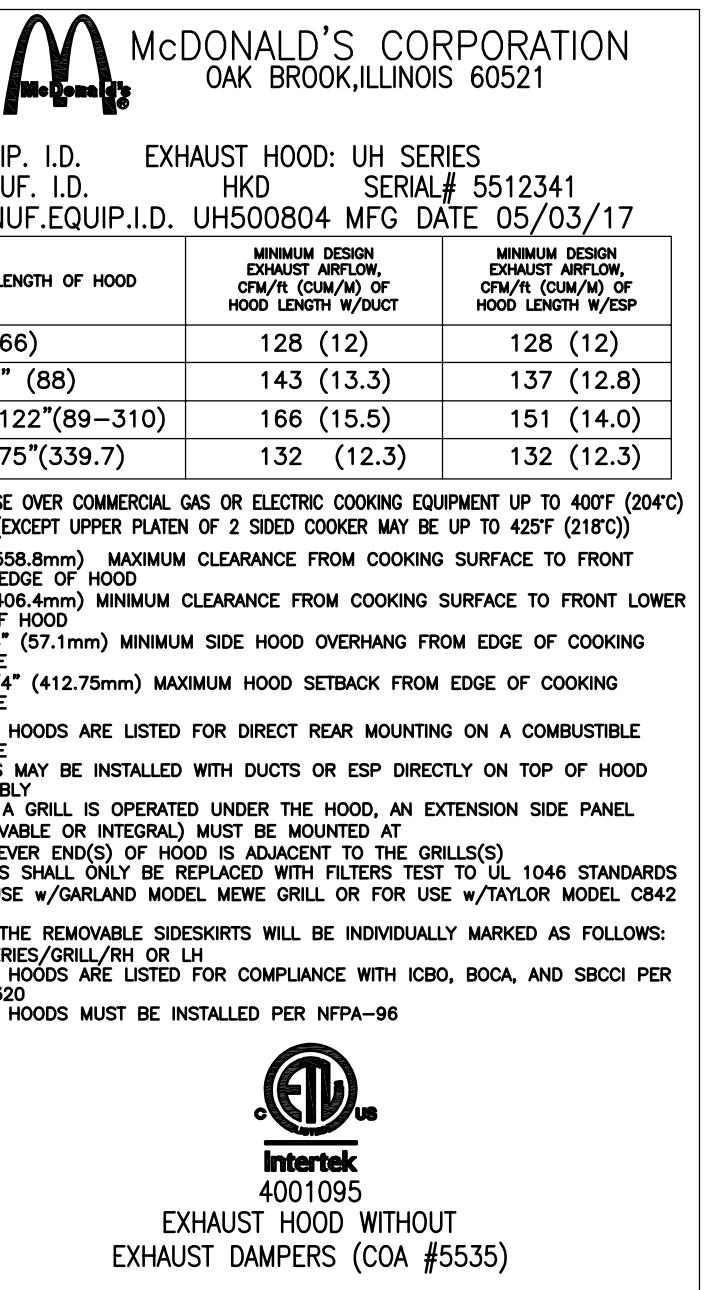

DETAIL
UL LABEL
SCALE: NONE

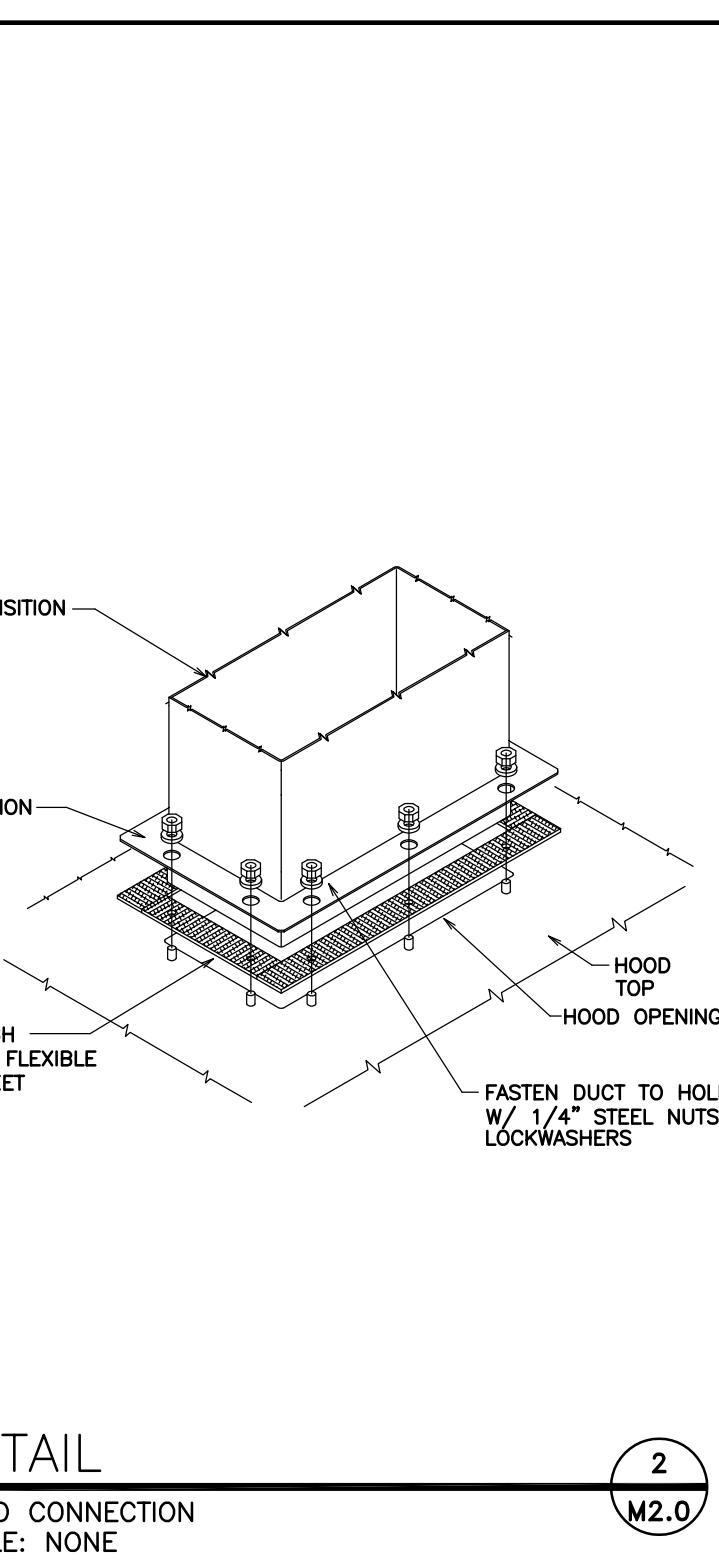

DETAIL
HOOD CONNECTION
SCALE: NONE

OWNER SELECTED EQUIPMENT WITH
MANUFACTURER CUT SHEET
FOR INFORMATION PURPOSES ONLY

TITLE	2019 STANDARD BUILDING - BB20	STD ISSUE DATE	2019-11	REVIEWED BY	WLW
DESCRIPTION	WOOD BEARING WALLS W/FIBER CEMENT SIDING & CI				
	WOOD ROOF TRUSS FRAMING				
	FIBER CEMENT PANEL/BATTEN/ALUMINUM/BRICK EXTER. FINISH				
SHEET NO.	015-0071.00.0	SITE ID	015-0071	SITE ADDRESS	605 SOUTH 7TH STREET, KANSAS CITY, KS
					REV. DATE
					BY

3801.0037

17648


01/23/20

*MICHAEL WEBER
LICENSED
PROFESSIONAL ENGINEER
KANSAS STATE BOARD
REGISTRATION #17648*


PREPARED BY: **McDonald's USA, LLC**

© 2020 McDonald's USA, LLC

These drawings and specifications are the confidential and proprietary property of McDonald's USA, LLC and shall not be copied or reproduced for use on this specific site or on another site or at a later time. Use of these drawings for reference or example on another project requires the services of a properly licensed architect or engineer. Reproduction of the contract documents for reuse on another project is not authorized.

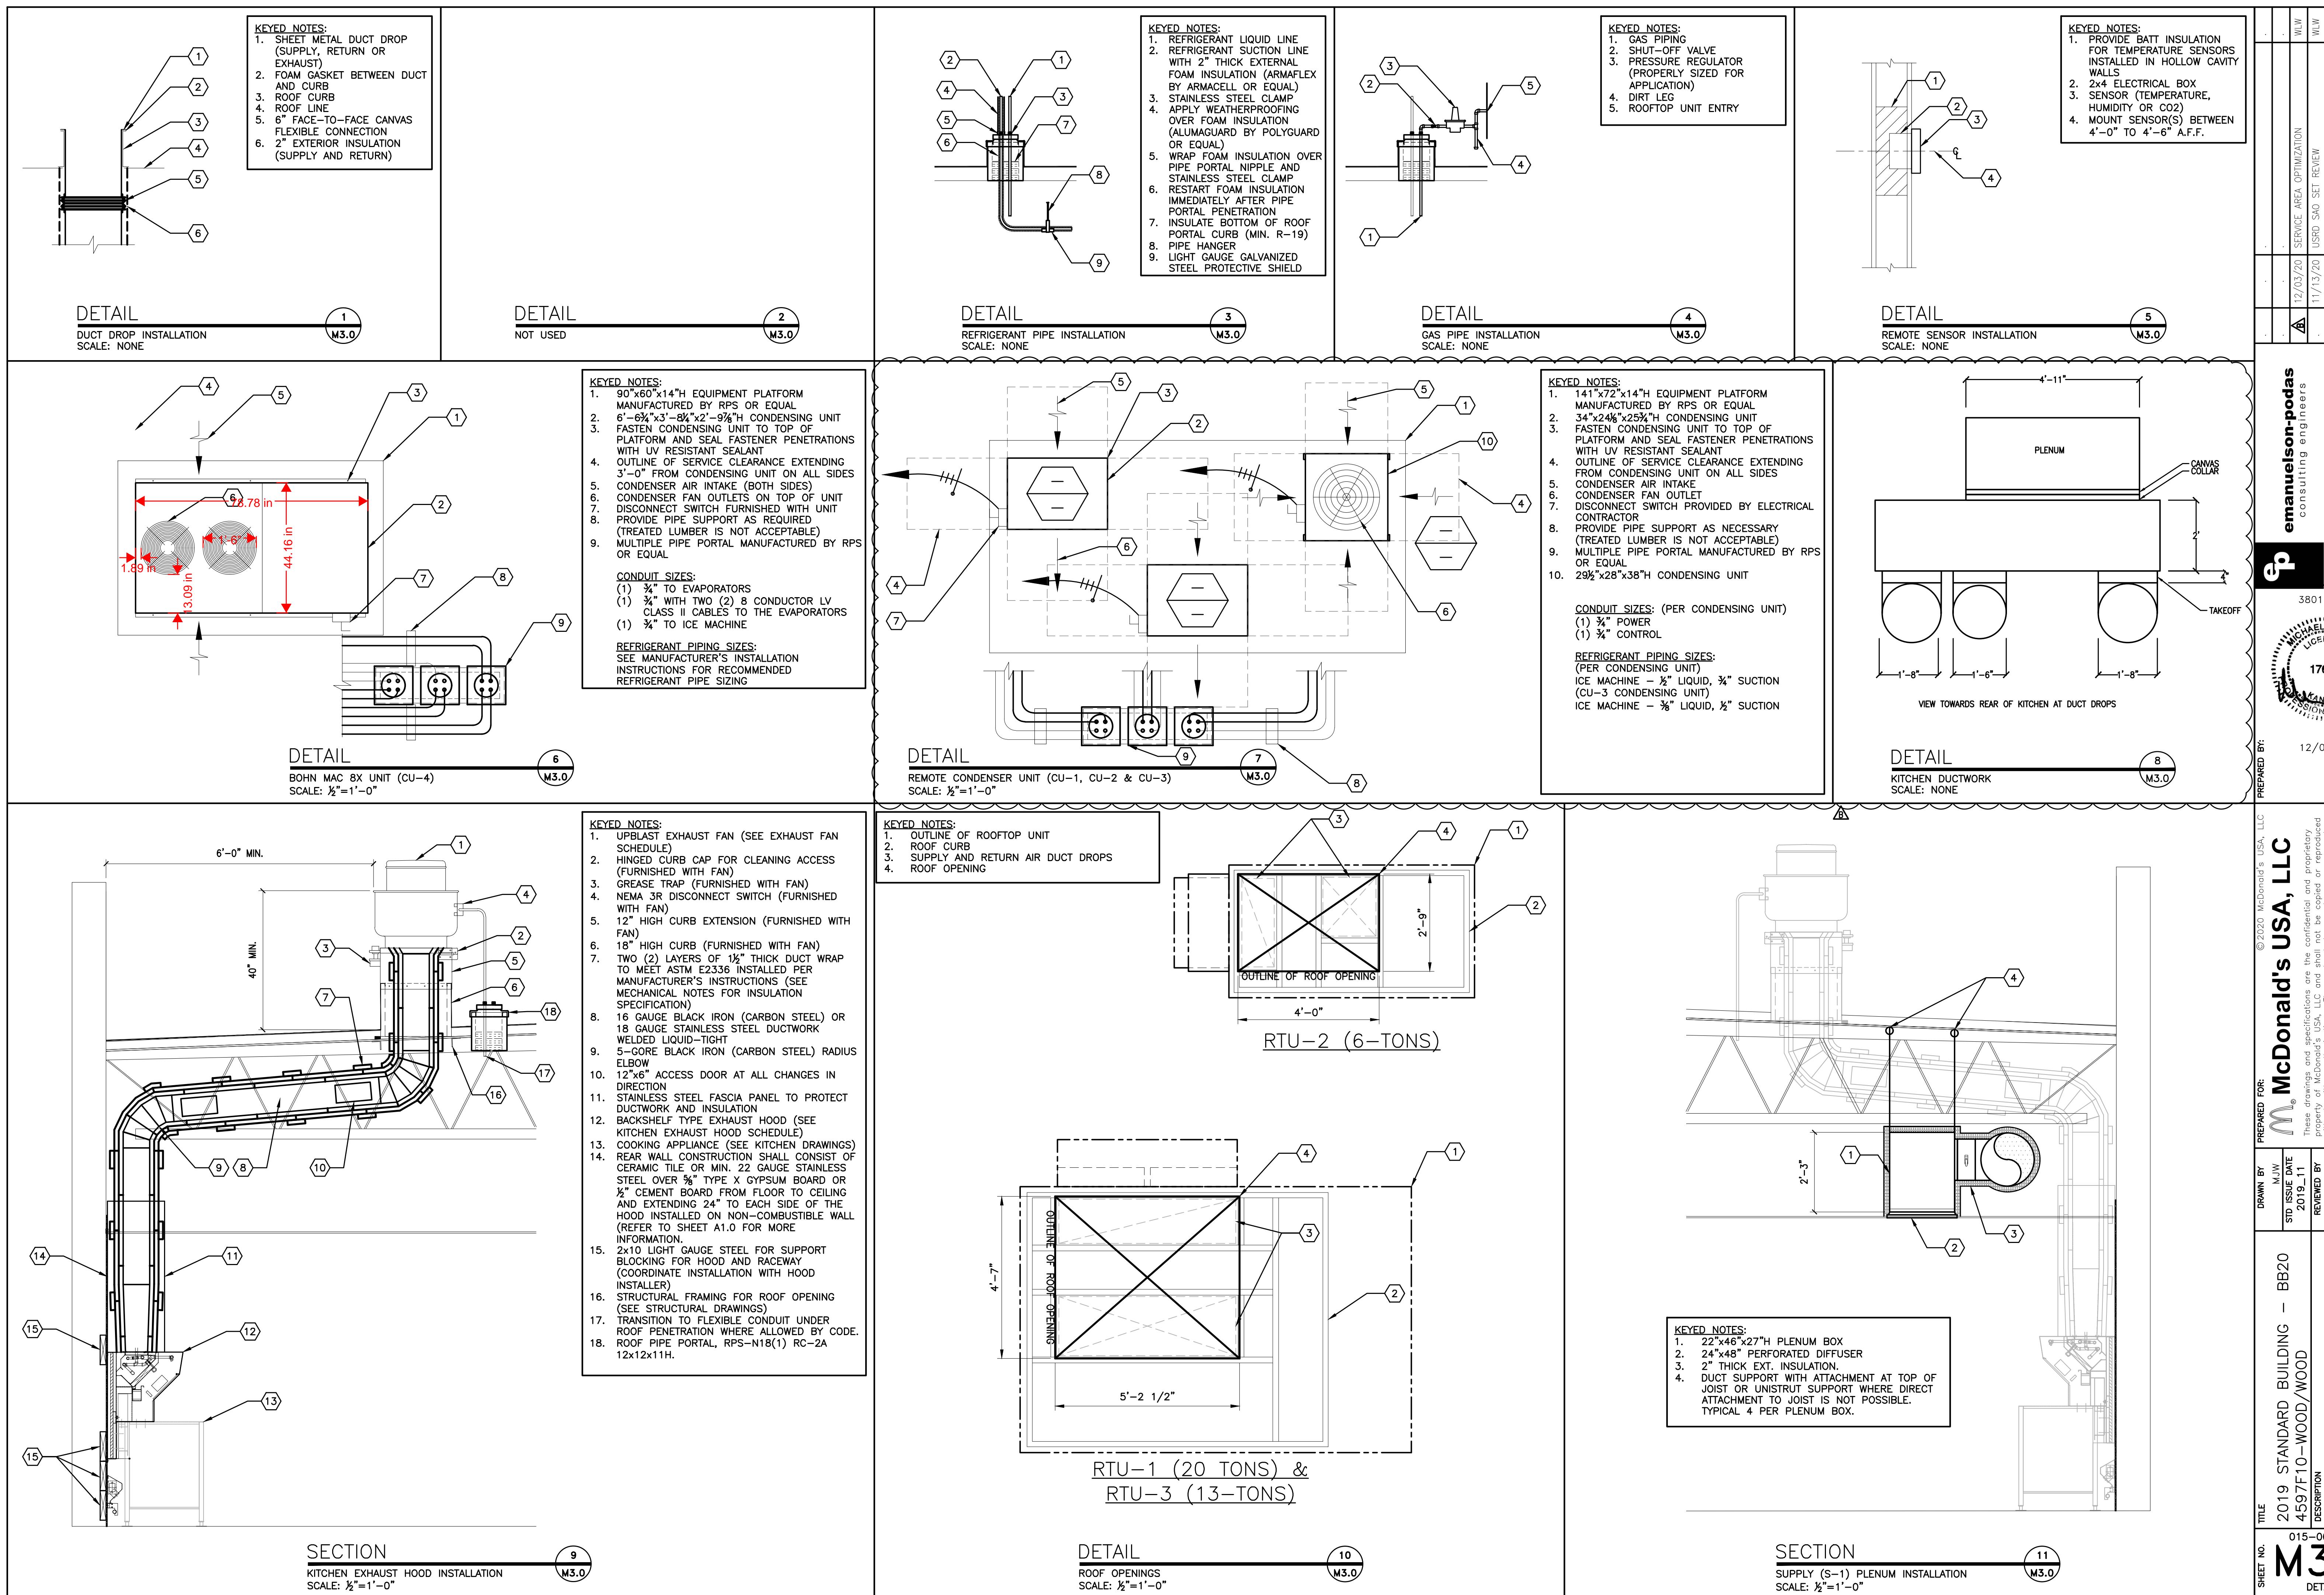

MECHANICAL NOTES		LEGEND	ABBREVIATIONS																																																																																																								
<p>GENERAL:</p> <ol style="list-style-type: none"> ALL WORK PERFORMED SHALL BE IN ACCORDANCE WITH ALL LOCAL CODES AND ACCEPTABLE TO THE AUTHORITY HAVING JURISDICTION. ALL DIMENSIONS, CLEARANCES AND TOLERANCES SHALL BE VERIFIED PRIOR TO INSTALLATION. ALL MATERIALS, FIXTURES AND EQUIPMENT USED SHALL BE IN ACCORDANCE WITH McDONALD'S SPECIFICATIONS. SPECIFICATIONS ARE CONTAINED WITHIN THESE DRAWINGS AND THE McDONALD'S PROJECT MANUAL. ANY CONTRACTOR IN NEED OF A COPY OF THE McDONALD'S PROJECT MANUAL SHALL CONTACT THE McDONALD'S AREA CONSTRUCTION MANAGER. ANY VARIANCE FROM THE McDONALD'S SPECIFICATIONS SHALL BE REVIEWED AND APPROVED BY THE ENGINEER-OF-RECORD. ALL EQUIPMENT SHALL BE INSTALLED IN ACCORDANCE WITH ITS LISTING AND/OR THE MANUFACTURER'S INSTALLATION INSTRUCTIONS. SEE COORDINATION SCHEDULE FOR ADDITIONAL SCOPE OF WORK. PRIOR TO BUILDING TURNOVER, A COMPLETE START-UP, TEST, ADJUST AND BALANCE SHALL BE PERFORMED ON ALL MECHANICAL SYSTEMS. THIS WORK SHALL BE PERFORMED BY A CERTIFIED TEST AND BALANCE CONTRACTOR. A CERTIFIED TEST AND BALANCE CONTRACTOR CAN BE FOUND BY VISITING: HTTP://WWW.ABCHQ.COM/DIRECTORY, HTTP://WWW.NEBC.ORG/DIRECTORY.HTM, HTTP://WWW.TABCERTIFIED.ORG/SITE/CONTENT/CONTRACTORS/SEARCH UPON COMPLETION OF THE PUNCHLIST, THE MECHANICAL CONTRACTOR AND TEST AND BALANCE CONTRACTOR SHALL SUBMIT REDLINED OR AS-BUILT DRAWINGS ALONG WITH THE TEST AND BALANCE REPORT AND ALL EQUIPMENT OPERATION AND MAINTENANCE MANUALS TO THE McDONALD'S AREA CONSTRUCTION MANAGER. A MINIMUM OF TWO (2) COPIES SHALL BE PROVIDED, ONE (1) FOR REGIONAL RECORDS AND ONE (1) FOR THE RESTAURANT. ALL PENETRATIONS OF FIRE-RATED WALLS SHALL BE FIRESTOPPED WITH AN APPROVED AND LISTED FIRESTOPPING SYSTEM. <p>VENTILATION SYSTEMS:</p> <ol style="list-style-type: none"> ALL SHEET METAL DUCTWORK SHALL BE FABRICATED AND INSTALLED IN ACCORDANCE WITH LOCAL CODES AND SMACNA STANDARDS. ALL DUCTWORK DIMENSIONS ARE INTERNAL FREE AREA DIMENSIONS AND SIZED FOR 0.1" W.C. PER 100 FT. OF DUCT. ALL SHEET METAL DUCTWORK SHALL BE CONSTRUCTED IN ACCORDANCE WITH SMACNA TABLES FOR 2" W.C. AND SHALL BE SUPPORTED WITH AN APPROVED HANGER AT INTERVALS NOT EXCEEDING 10 FT. ALL DUCT DROPS INTO THE BUILDING SHALL BE INSTALLED WITH FLEXIBLE CONNECTIONS TO ISOLATE THE DUCTWORK SYSTEM FROM NOISE AND VIBRATION. FLEXIBLE CONNECTIONS SHALL BE TESTED IN ACCORDANCE WITH UL 181 AND LISTED AS CLASS 0 OR CLASS 1. ALL DUCT DROPS INTO THE BUILDING SHALL BE OFFSET AS NECESSARY TO ALLOW FOR THE CLEAR INSTALLATION OF THE EXTERNAL DUCTWORK INSULATION. ALL DUCTWORK BRANCHES SHALL BE SUPPLIED WITH A VOLUME DAMPER FOR BALANCING. VOLUME DAMPER SHALL HAVE A 2" OFFSET TO ACCOMMODATE EXTERNAL INSULATION. TAKE-OFFS FROM RECTANGULAR TO ROUND DUCT SHALL BE DUCTMATE STRAIGHT-SIDED OR CENTER HIGH-EFFICIENCY TAKE-OFFS WITH A 2" DAMPER STAND-OFF TO ACCOMMODATE FOR EXTERNAL INSULATION. ALL DUCTWORK JOINTS, LONGITUDINAL AND TRANSVERSE SEAMS SHALL BE SEALED WITH WELDS, GASKETS, MASTICS (ADHESIVES), TAPES, ETC. ALL SEALANT MATERIALS SHALL BE LISTED IN ACCORDANCE WITH UL 181A OR 181B. ALL SUPPLY AND RETURN SHEET METAL DUCTWORK LOCATED WITHIN THE CEILING SPACE SHALL BE EXTERNALLY INSULATED. INSULATION SHALL BE 2" THICK MICROLITE XG-100 BY JOHNS MANVILLE OR EQUAL. ALL SUPPLY AND RETURN SHEET METAL DUCTWORK LOCATED OUTSIDE OF THE BUILDING SHALL BE INTERNALLY LINED WITH A 1" THICK FIBERGLASS (MIN. R-4.2) AND EXTERNALLY INSULATED WITH A 1/2" THICK RIGID POLYSTYRENE, POLYURETHANE OR POLYISOCYANURATE BOARD (MIN. R-7.5). INTERNAL FIBERGLASS INSULATION SHALL BE LINATEX BY JOHNS MANVILLE OR EQUAL. EXTERNAL RIGID BOARD INSULATION SHALL BE THERMAPINK BY OWENS CORNING OR EQUAL. ALL EXPOSED SPIRAL DUCTWORK SHALL BE INTERNALLY INSULATED TO PREVENT CONDENSATION (MIN. R-4.3). INTERNAL INSULATION SHALL BE 1" THICK SPIRACOUSTIC PLUS BY JOHNS MANVILLE OR EQUAL. ALL DUCTWORK PENETRATIONS THROUGH FIRE-RATED WALLS, BARRIERS OR PARTITIONS SHALL BE PROTECTED WITH A FIRE DAMPER. THE PERIMETER OF THE FIRE DAMPER SHALL BE FIRESTOPPED WITH AN APPROVED AND LISTED FIRESTOPPING MATERIAL. ALL EXTERIOR SHEET METAL DUCTWORK SHALL BE EXTERNALLY WRAPPED WITH AN APPROVED WEATHERPROOFING MATERIAL TO PROTECT AGAINST WATER PENETRATION AND CORROSION. SIDES AND TOP OF EXTERNAL WEATHERPROOFING SHALL BE ALUMAGUARD 60 MIL UV BARIER BY POLYGUARD OR EQUAL. BOTTOM OF EXTERNAL WEATHERPROOFING SHALL BE VAPORGUARD 5 MIL MEMBRANE BY POLYGUARD OR EQUAL. ALL FLEXIBLE DUCTWORK, METALLIC AND NONMETALLIC, SHALL CONFORM TO THE FOLLOWING: <ul style="list-style-type: none"> A. 2" THICK INSULATION (R-6.0) B. INTEGRAL VAPOR BARRIER C. LISTED AND LABELED UL 181, CLASS 0 OR CLASS 1 D. INSTALLED IN ACCORDANCE WITH: <ul style="list-style-type: none"> i. SMACNA STANDARDS, ii. AIR DIFFUSION COUNCIL INSTALLATION GUIDELINES, AND/OR iii. MANUFACTURER'S INSTALLATION INSTRUCTIONS FLEXIBLE DUCTWORK SHALL NOT PENETRATE WALLS. SHEET METAL DUCTWORK IS REQUIRED AT ALL FIRE-RATED AND DRAFTSTOP WALL PENETRATIONS. ALL COVERINGS, LININGS AND ADHESIVES (TAPES, ETC.) SHALL HAVE A FLAME-Spread INDEX NOT GREATER THAN 25 AND A SMOKE-DEVELOPED INDEX NOT GREATER THAN 50. DUCT-MOUNTED SMOKE DETECTORS SHALL BE INSTALLED IN SYSTEMS WITH DESIGN CAPACITY GREATER THAN 2,000 CFM. SEE MECHANICAL DRAWINGS FOR LOCATIONS OF SMOKE DETECTORS. DUCT-MOUNTED SMOKE DETECTORS ARE NOT REQUIRED WHEN THE BUILDING IS PROTECTED THROUGHOUT BY AREA SMOKE DETECTORS CONNECTED TO A FIRE ALARM SYSTEM WHERE THE FIRE ALARM SYSTEM IS DESIGNED TO SHUT DOWN THE ROOFTOP UNITS. ALL SUPPLY AIR DIFFUSERS SHALL BE INSULATED TO PREVENT CONDENSATION. ALL AIR DEVICES LOCATED IN DRYWALL CEILINGS SHALL BE SUPPLIED WITH AN INTEGRAL VOLUME DAMPER ACCESSIBLE FROM THE AIR DEVICE FACE TO FACILITATE BALANCING. ALL OUTDOOR AIR INTAKES SHALL BE LOCATED A MINIMUM OF 10 FT. HORIZONTALLY FROM ANY SOURCE OF CONTAMINATION SUCH AS EXHAUST FANS, PLUMBING VENTS, WATER HEATER FLUES, ETC. WHERE A CONTAMINANT SOURCE IS LOCATED WITHIN 10 FT. OF AN INTAKE, THE INTAKE OPENING SHALL BE LOCATED A MINIMUM OF 2 FT. BELOW THE CONTAMINANT SOURCE. 		<p>LEGEND</p> <table border="1"> <tr> <td></td> <td>TEMPERATURE SENSOR</td> <td>ACM</td> <td>AREA CONSTRUCTION MANAGER</td> </tr> <tr> <td></td> <td>AVERAGING TEMPERATURE SENSOR</td> <td>B.J.</td> <td>BELOW JOISTS</td> </tr> <tr> <td></td> <td>CO2 SENSOR FOR ROOFTOP UNIT DEMAND CONTROL VENTILATION</td> <td>BSI</td> <td>BEVERAGE SYSTEM INSTALLER</td> </tr> <tr> <td></td> <td>HUMIDITY SENSOR</td> <td>DCV</td> <td>DEMAND CONTROL VENTILATION</td> </tr> <tr> <td></td> <td>THERMOSTAT</td> <td>E.A.</td> <td>EXHAUST AIR</td> </tr> <tr> <td></td> <td>SMOKE DETECTOR</td> <td>EC</td> <td>ELECTRICAL CONTRACTOR</td> </tr> <tr> <td></td> <td>EQUIPMENT TAG</td> <td>FAC</td> <td>FIRE ALARM CONTRACTOR</td> </tr> <tr> <td></td> <td>DIFFUSER INFORMATION LINE 1: TAG LINE 2: AIRFLOW LINE 3: NECK SIZE</td> <td>FOB</td> <td>FLAT ON BOTTOM</td> </tr> <tr> <td></td> <td>FOT</td> <td>FLAT ON TOP</td> <td></td> </tr> <tr> <td></td> <td>SUPPLY AIR DUCT (VERTICAL)</td> <td>FPC</td> <td>FIRE PROTECTION CONTRACTOR</td> </tr> <tr> <td></td> <td>RETURN OR EXHAUST AIR DUCT (VERTICAL)</td> <td>I.D.</td> <td>INSIDE DIMENSION</td> </tr> <tr> <td></td> <td>ROUND DUCT (VERTICAL)</td> <td>KES</td> <td>KITCHEN EQUIPMENT SUPPLIER</td> </tr> <tr> <td></td> <td>STEADY-STATE SPEED CONTROLLER</td> <td>M.A. (S)</td> <td>MIXED AIR - SUMMER</td> </tr> <tr> <td></td> <td>PLAQUE DIFFUSER (SHADED AREA DESIGNATES BLANK-OFF PANEL LOCATION)</td> <td>M.A. (W)</td> <td>MIXED AIR - WINTER</td> </tr> <tr> <td></td> <td>LINEAR SLOT DIFFUSER</td> <td>MC</td> <td>MECHANICAL CONTRACTOR</td> </tr> <tr> <td></td> <td>O.A.</td> <td>O.D.</td> <td>OUTDOOR AIR</td> </tr> <tr> <td></td> <td>LOUVERED FACE DIFFUSER</td> <td>O/O</td> <td>OWNER/OPERATOR</td> </tr> <tr> <td></td> <td>CEILING-MOUNTED EXHAUST FAN</td> <td>R.A.</td> <td>RETURN AIR</td> </tr> <tr> <td></td> <td>SPIN-IN COLLAR WITH VOLUME DAMPER</td> <td>RC</td> <td>REFRIGERATION CONTRACTOR</td> </tr> <tr> <td></td> <td>VOLUME DAMPER</td> <td>S.A.</td> <td>SUPPLY AIR</td> </tr> <tr> <td></td> <td>FLEXIBLE DUCTWORK</td> <td>S.P.</td> <td>STATIC PRESSURE</td> </tr> <tr> <td></td> <td>PERFORATED FACE DIFFUSER</td> <td>TAB</td> <td>TEST AND BALANCE CONTRACTOR</td> </tr> <tr> <td></td> <td>SHEET METAL TEE WITH CAP</td> <td></td> <td></td> </tr> </table>		TEMPERATURE SENSOR	ACM	AREA CONSTRUCTION MANAGER		AVERAGING TEMPERATURE SENSOR	B.J.	BELOW JOISTS		CO2 SENSOR FOR ROOFTOP UNIT DEMAND CONTROL VENTILATION	BSI	BEVERAGE SYSTEM INSTALLER		HUMIDITY SENSOR	DCV	DEMAND CONTROL VENTILATION		THERMOSTAT	E.A.	EXHAUST AIR		SMOKE DETECTOR	EC	ELECTRICAL CONTRACTOR		EQUIPMENT TAG	FAC	FIRE ALARM CONTRACTOR		DIFFUSER INFORMATION LINE 1: TAG LINE 2: AIRFLOW LINE 3: NECK SIZE	FOB	FLAT ON BOTTOM		FOT	FLAT ON TOP			SUPPLY AIR DUCT (VERTICAL)	FPC	FIRE PROTECTION CONTRACTOR		RETURN OR EXHAUST AIR DUCT (VERTICAL)	I.D.	INSIDE DIMENSION		ROUND DUCT (VERTICAL)	KES	KITCHEN EQUIPMENT SUPPLIER		STEADY-STATE SPEED CONTROLLER	M.A. (S)	MIXED AIR - SUMMER		PLAQUE DIFFUSER (SHADED AREA DESIGNATES BLANK-OFF PANEL LOCATION)	M.A. (W)	MIXED AIR - WINTER		LINEAR SLOT DIFFUSER	MC	MECHANICAL CONTRACTOR		O.A.	O.D.	OUTDOOR AIR		LOUVERED FACE DIFFUSER	O/O	OWNER/OPERATOR		CEILING-MOUNTED EXHAUST FAN	R.A.	RETURN AIR		SPIN-IN COLLAR WITH VOLUME DAMPER	RC	REFRIGERATION CONTRACTOR		VOLUME DAMPER	S.A.	SUPPLY AIR		FLEXIBLE DUCTWORK	S.P.	STATIC PRESSURE		PERFORATED FACE DIFFUSER	TAB	TEST AND BALANCE CONTRACTOR		SHEET METAL TEE WITH CAP			<p>ABBREVIATIONS</p> <table border="1"> <tr> <td>W.L.W.</td> <td>W.L.W.</td> <td>W.L.W.</td> <td>BY</td> </tr> <tr> <td>01/23/20</td> <td>01/13/20</td> <td>01/23/20</td> <td>REV DATE</td> </tr> <tr> <td>PERMIT SET</td> <td>PROGRESS SET REVIEW</td> <td>USD</td> <td>DESCRIPTION</td> </tr> </table>	W.L.W.	W.L.W.	W.L.W.	BY	01/23/20	01/13/20	01/23/20	REV DATE	PERMIT SET	PROGRESS SET REVIEW	USD	DESCRIPTION
	TEMPERATURE SENSOR	ACM	AREA CONSTRUCTION MANAGER																																																																																																								
	AVERAGING TEMPERATURE SENSOR	B.J.	BELOW JOISTS																																																																																																								
	CO2 SENSOR FOR ROOFTOP UNIT DEMAND CONTROL VENTILATION	BSI	BEVERAGE SYSTEM INSTALLER																																																																																																								
	HUMIDITY SENSOR	DCV	DEMAND CONTROL VENTILATION																																																																																																								
	THERMOSTAT	E.A.	EXHAUST AIR																																																																																																								
	SMOKE DETECTOR	EC	ELECTRICAL CONTRACTOR																																																																																																								
	EQUIPMENT TAG	FAC	FIRE ALARM CONTRACTOR																																																																																																								
	DIFFUSER INFORMATION LINE 1: TAG LINE 2: AIRFLOW LINE 3: NECK SIZE	FOB	FLAT ON BOTTOM																																																																																																								
	FOT	FLAT ON TOP																																																																																																									
	SUPPLY AIR DUCT (VERTICAL)	FPC	FIRE PROTECTION CONTRACTOR																																																																																																								
	RETURN OR EXHAUST AIR DUCT (VERTICAL)	I.D.	INSIDE DIMENSION																																																																																																								
	ROUND DUCT (VERTICAL)	KES	KITCHEN EQUIPMENT SUPPLIER																																																																																																								
	STEADY-STATE SPEED CONTROLLER	M.A. (S)	MIXED AIR - SUMMER																																																																																																								
	PLAQUE DIFFUSER (SHADED AREA DESIGNATES BLANK-OFF PANEL LOCATION)	M.A. (W)	MIXED AIR - WINTER																																																																																																								
	LINEAR SLOT DIFFUSER	MC	MECHANICAL CONTRACTOR																																																																																																								
	O.A.	O.D.	OUTDOOR AIR																																																																																																								
	LOUVERED FACE DIFFUSER	O/O	OWNER/OPERATOR																																																																																																								
	CEILING-MOUNTED EXHAUST FAN	R.A.	RETURN AIR																																																																																																								
	SPIN-IN COLLAR WITH VOLUME DAMPER	RC	REFRIGERATION CONTRACTOR																																																																																																								
	VOLUME DAMPER	S.A.	SUPPLY AIR																																																																																																								
	FLEXIBLE DUCTWORK	S.P.	STATIC PRESSURE																																																																																																								
	PERFORATED FACE DIFFUSER	TAB	TEST AND BALANCE CONTRACTOR																																																																																																								
	SHEET METAL TEE WITH CAP																																																																																																										
W.L.W.	W.L.W.	W.L.W.	BY																																																																																																								
01/23/20	01/13/20	01/23/20	REV DATE																																																																																																								
PERMIT SET	PROGRESS SET REVIEW	USD	DESCRIPTION																																																																																																								
		<p>Emmanuelson-Podas, Inc. 100 N Main Street, Suite 100 Edina, MN 55439 (612) 990-0050 www.eppinc.com</p>																																																																																																									
		<p>PREPARED BY:</p> <p>McDonald's USA, LLC</p> <p>PREPARED FOR:</p> <p>Michael Webster, Licensed Professional Mechanical Engineer, Kansas City, Missouri</p> <p>17648</p> <p>01/23/20</p>																																																																																																									
		<p>DRAWN BY:</p> <p>M.J.W.</p> <p>STD ISSUE DATE: 2019-11</p> <p>REVIEWED BY:</p> <p>W.L.W.</p> <p>DATE ISSUED: 01-23-20</p> <p>DESCRIPTION:</p> <p>2019 STANDARD BUILDING - BB20 4597F10-WOOD/WOOD WOOD BEARING WALLS W/FIBER CEMENT SIDING & CI FIBER CEMENT PANEL/BATTEN/ALPOLIC PANEL/BRICK EXT. FINISH FIBER ROOF TRUSS FRAMING SITE ADDRESS: 605 SOUTH 7TH STREET, KANSAS CITY, KS SITE ID: 015-0071 SHEET NO. 015-0071 TITLE: 2019 STANDARD BUILDING - BB20 015-0071.00.0 M4.0 GENERAL NOTES</p>																																																																																																									

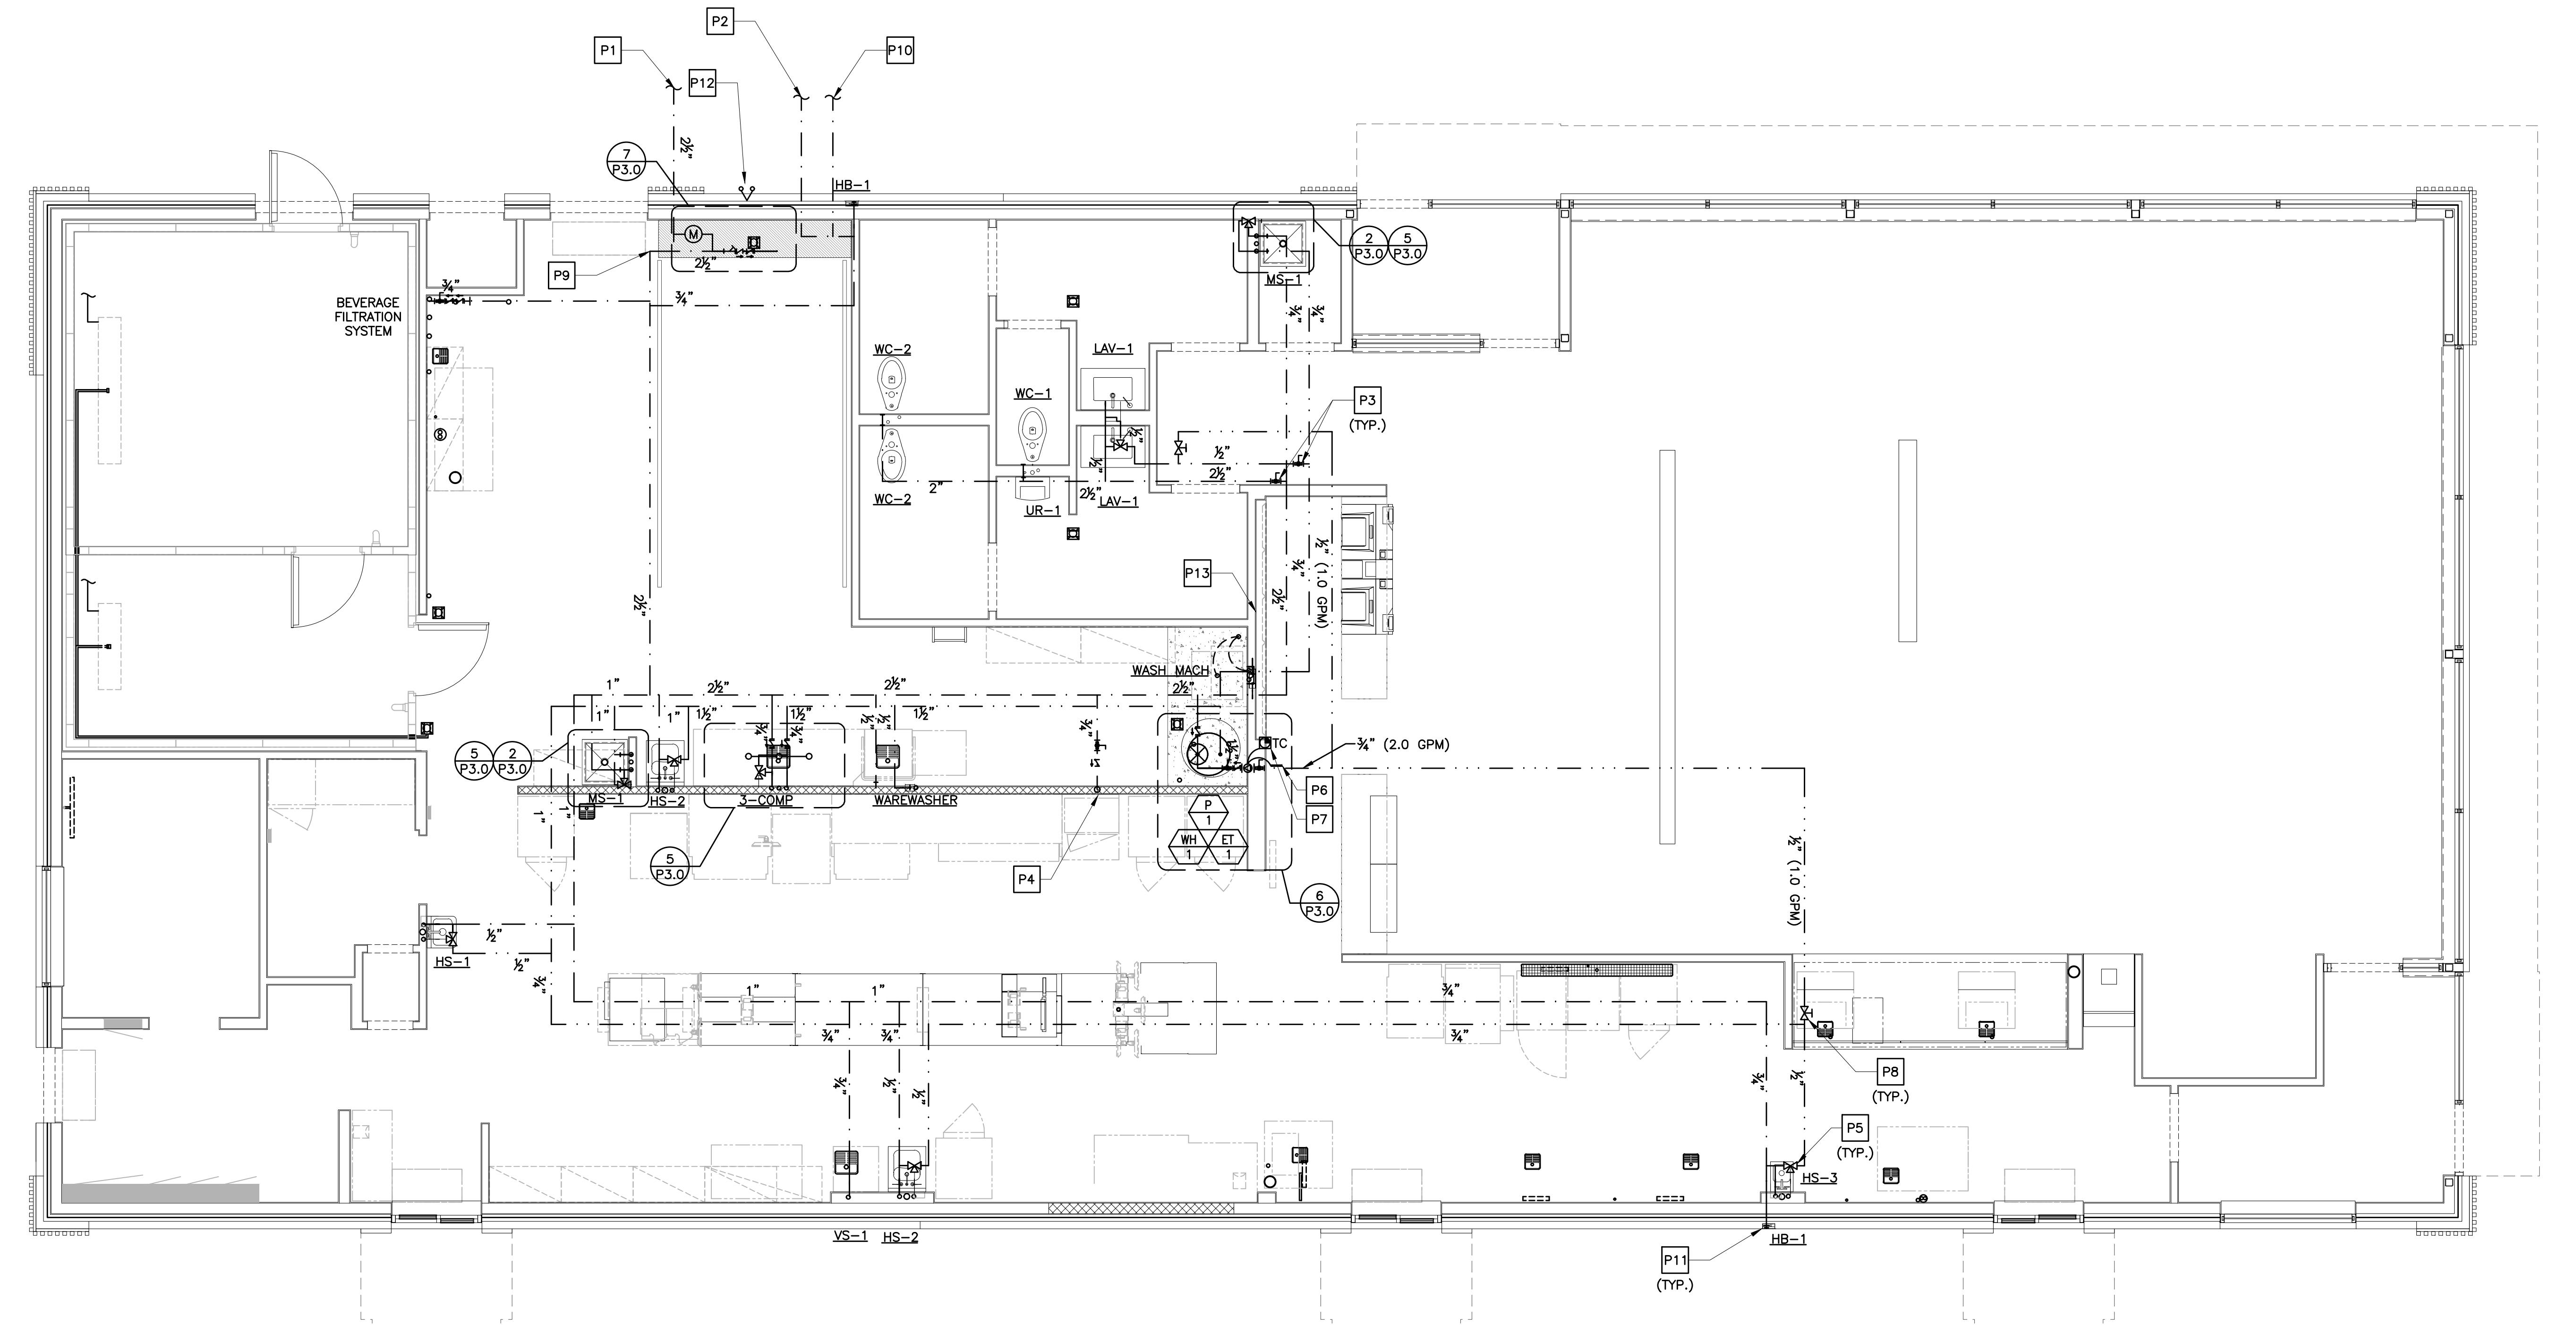

1 DOMESTIC WATER PIPING PLAN
P1.0 1/4"=1'-0"

DRAWING NOTES

1. PIPING ROUTES AS SHOWN ARE GENERAL AND MAY VARY DUE TO FIELD CONDITIONS. COORDINATE ALL PIPE ROUTES WITH OTHER TRADES.
2. ALL WATER DISTRIBUTION PIPING SHALL BE INSULATED. INSULATION NOT SHOWN FOR CLARITY. SEE PLUMBING NOTES FOR INSULATION REQUIREMENTS.
3. ALL OUTDOOR UTILITIES MOUNTED ON THE WALL MUST BE PAINTED TO MATCH THE BUILDING

DRAWINGS AND SPECIFICATIONS ARE TO BE CONSIDERED AS SUPPLEMENTING EACH OTHER. WORK SPECIFIED BUT NOT SHOWN ON DRAWINGS, OR SHOWN ON DRAWINGS BUT NOT SPECIFIED, SHALL BE PERFORMED OR FURNISHED AS THOUGH MENTIONED IN BOTH SPECIFICATIONS AND DRAWINGS. IF NOT OTHERWISE DIRECTED, INSTALLATION OF ALL SYSTEMS AND EQUIPMENT SHALL BE IN ACCORDANCE WITH APPLICABLE CODES AND IN ACCORDANCE WITH MANUFACTURER'S INSTALLATION INSTRUCTIONS. WHERE WORK DESCRIBED IN THE SPECIFICATIONS IS IN CONFLICT WITH THE WORK SHOWN ON THE DRAWINGS, THE CONTRACTOR SHALL SUPPLY THE GREATER QUANTITY, QUALITY AND COST VIA THE BID AND CONTACT THE ENGINEER FOR CLARIFICATION ON DIRECTION PRIOR TO INSTALLATION.

PRIOR TO BID, THE CONTRACTOR SHALL REVIEW THE MECHANICAL, ELECTRICAL AND KITCHEN EQUIPMENT DRAWINGS. THE CONTRACTOR SHALL INCLUDE IN HIS BID ALL RELEVANT WORK IN THE ENTIRE SET OF DOCUMENTS AND REPORT ALL DISCREPANCIES BETWEEN THESE DRAWINGS TO THE ENGINEER PRIOR TO BIDDING FOR CLARIFICATION. DISCREPANCIES REMAIN UNRESOLVED DUE TO A SHORT TIME FRAME, THE CONTRACTOR SHALL INCLUDE THE MOST WORK AND THE HIGHER COSTS IN THE BID. SOLUTIONS TO UNREPORTED DISCREPANCIES WILL BE DETERMINED BY THE ARCHITECT/ENGINEER, WITH NO ADDITIONAL COMPENSATION DUE TO THE CONTRACTOR.

KEYED NOTES

- P1 INCOMING UNDERGROUND WATER SERVICE (SEE SITE PLAN FOR CONTINUATION). WATER PIPING FROM THIS POINT TO CEILING PENETRATION INSIDE BUILDING SHALL BE COPPER.
- P2 COLD WATER UNDERGROUND TO YARD HYDRANT (HB-2) IN TRASH CORRAL. SEE SITE PLAN FOR CONTINUATION.
- P3 SHUT-OFF VALVE FOR RESTROOM AND HOSE BIBB ISOLATION. SEE VALVE SCHEDULE. ALL LOCATE IN AREAS WITH DRYWALL CEILINGS.
- P4 1/4" COLD WATER UP TO ROOF HYDRANT.
- P5 MIXING VALVE LOCATIONS SHOWN FOR INFORMATIONAL PURPOSES. SEE DETAIL 3 ON DRAWING P3.0 FOR MIXING VALVE INSTALLATION DETAILS.
- P6 PIPE-MOUNTED AQUASTAT TO SHUT PUMP DOWN WHEN RECIRCULATION TEMPERATURE REACHES 140°F. SEE DETAIL 6 ON DRAWING P3.0.
- P7 TIME CLOCK TO SHUT PUMP AND WATER HEATER DOWN DURING UNOCCUPIED HOURS. SEE ELECTRICAL DRAWINGS FOR WIRING DETAIL.
- P8 BALANCING VALVE FOR RECIRCULATION SYSTEM. SEE VALVE SCHEDULE. ALL BALANCING VALVES SHALL BE LOCATED OVER SUSPENDED CEILINGS FOR ACCESSIBILITY. DO NOT LOCATE IN AREAS WITH DRYWALL CEILINGS.
- P9 WATER PIPING AFTER CEILING PENETRATION CAN TRANSITION TO CPVC WHERE PERMITTED BY CODE.
- P10 VERIFY IRRIGATION SYSTEM, PROVIDE WATER LINE WITH BACKFLOW PREVENTER, VERIFY EXACT LOCATION WITH LANDSCAPE. 1" SEWER DEDUCT METER AND BACKFLOW ASSEMBLY.
- P11 PROVIDE FREEZE PROOF HYDRANT.

FIRE DEPARTMENT SIAMESE CONNECTION. SPRINKLER CONTRACTOR SHALL ROUTE LINE IN ACCESSIBLE CEILING SPACE FROM CONNECTION TO FIRE SPRINKLER SERVICE. MAKE ALL CONNECTIONS REQUIRED. VERIFY PIPE SIZE AND LOCATION OF SIAMESE WITH CIVIL AND FIRE MARSHALL. PROVIDED BY OTHERS. COORDINATE LOCATION OF SIAMESE CONNECTION WITH FIRE SPRINKLER SHEETS.

P13 PROPERLY SEAL ALL PIPE PENETRATIONS THROUGH ANY FIRE WALL(TYP)


SUPPLY PIPE SIZING - UPC

Fixture Type	SIZE	SUPPLY HW	SUPPLY CW	QUANTITY	TOTAL
URINAL	1 IN.	0	20	1	20
WATER CLOSET	1 IN.	0	90	3	90
LAVATORY SINK	1/2 IN.	1	1	2	2
WASH SINK (HAND SINK)	1/2 IN.	2	2	4	8
MOP SINK	3/4 IN.	3	3	2	6
VEGETABLE SINK	3/4 IN.	0	3	1	3
3-COMP SINK	3/4 IN.	3	3	1	3
WASHING MACHINE	3/4 IN.	4	4	1	4
DISH WASHER	3/4 IN.	1.5	1.5	1	3
HOSE BIB	3/4 IN.	0	2.5	4	5.5
LAWN SPRINKLER	1/2 IN.	0	1	4	4
WATER FILTRATION SYSTEM	3/4 IN.	0	1	3	3
CLEANING FAUCET	1/2 IN.	2	2	0	0
TOTAL					151.5

IF YOU HAVE ANY QUESTIONS REGARDING THE PLANS, PLEASE CALL THE DESIGNER.

DESIGNER: Wendy Wenborg
PHONE/FAX: 952-540-4047
EMAIL: wwwenborg@epinc.com

PREPARED BY:	emmanuelson-podas
CONSULTING ENGINEERS	Emmanuelson-Podas, Inc. Edina, MN 55439 (612) 990-0050 www.epinc.com
DATE:	05/05/20
REV:	01/13/20
DESCRIPTION:	BY

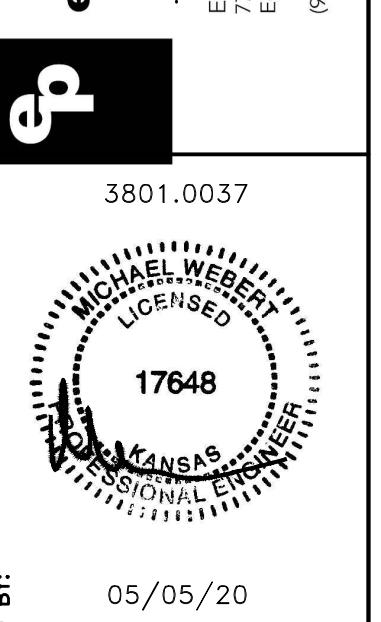


05/05/20

© 2020 McDonald's USA, LLC
McDonald's USA, LLC
These drawings and specifications are the confidential and proprietary property of McDonald's USA, LLC and shall not be copied or reproduced for use on this specific site in conjunction with the issuance of another permit or license. Use of these drawings for reference or example on another project requires the services of properly licensed architects and engineers. Reproduction of the contract documents for reuse on another project is not authorized.

TITLE:	2019 STANDARD BUILDING - BB20
DESCRIPTION:	4597F10-WOOD/WOOD
STD ISSUE DATE:	2019-11
REVIEWED BY:	WLW
DATE ISSUED:	01-23-20
SITE ID:	015-0071
SITE ADDRESS:	605 SOUTH 7TH STREET, KANSAS CITY, KS
REF#:	19175

SHEET NO. P1.0
DOMESTIC WATER PIPING

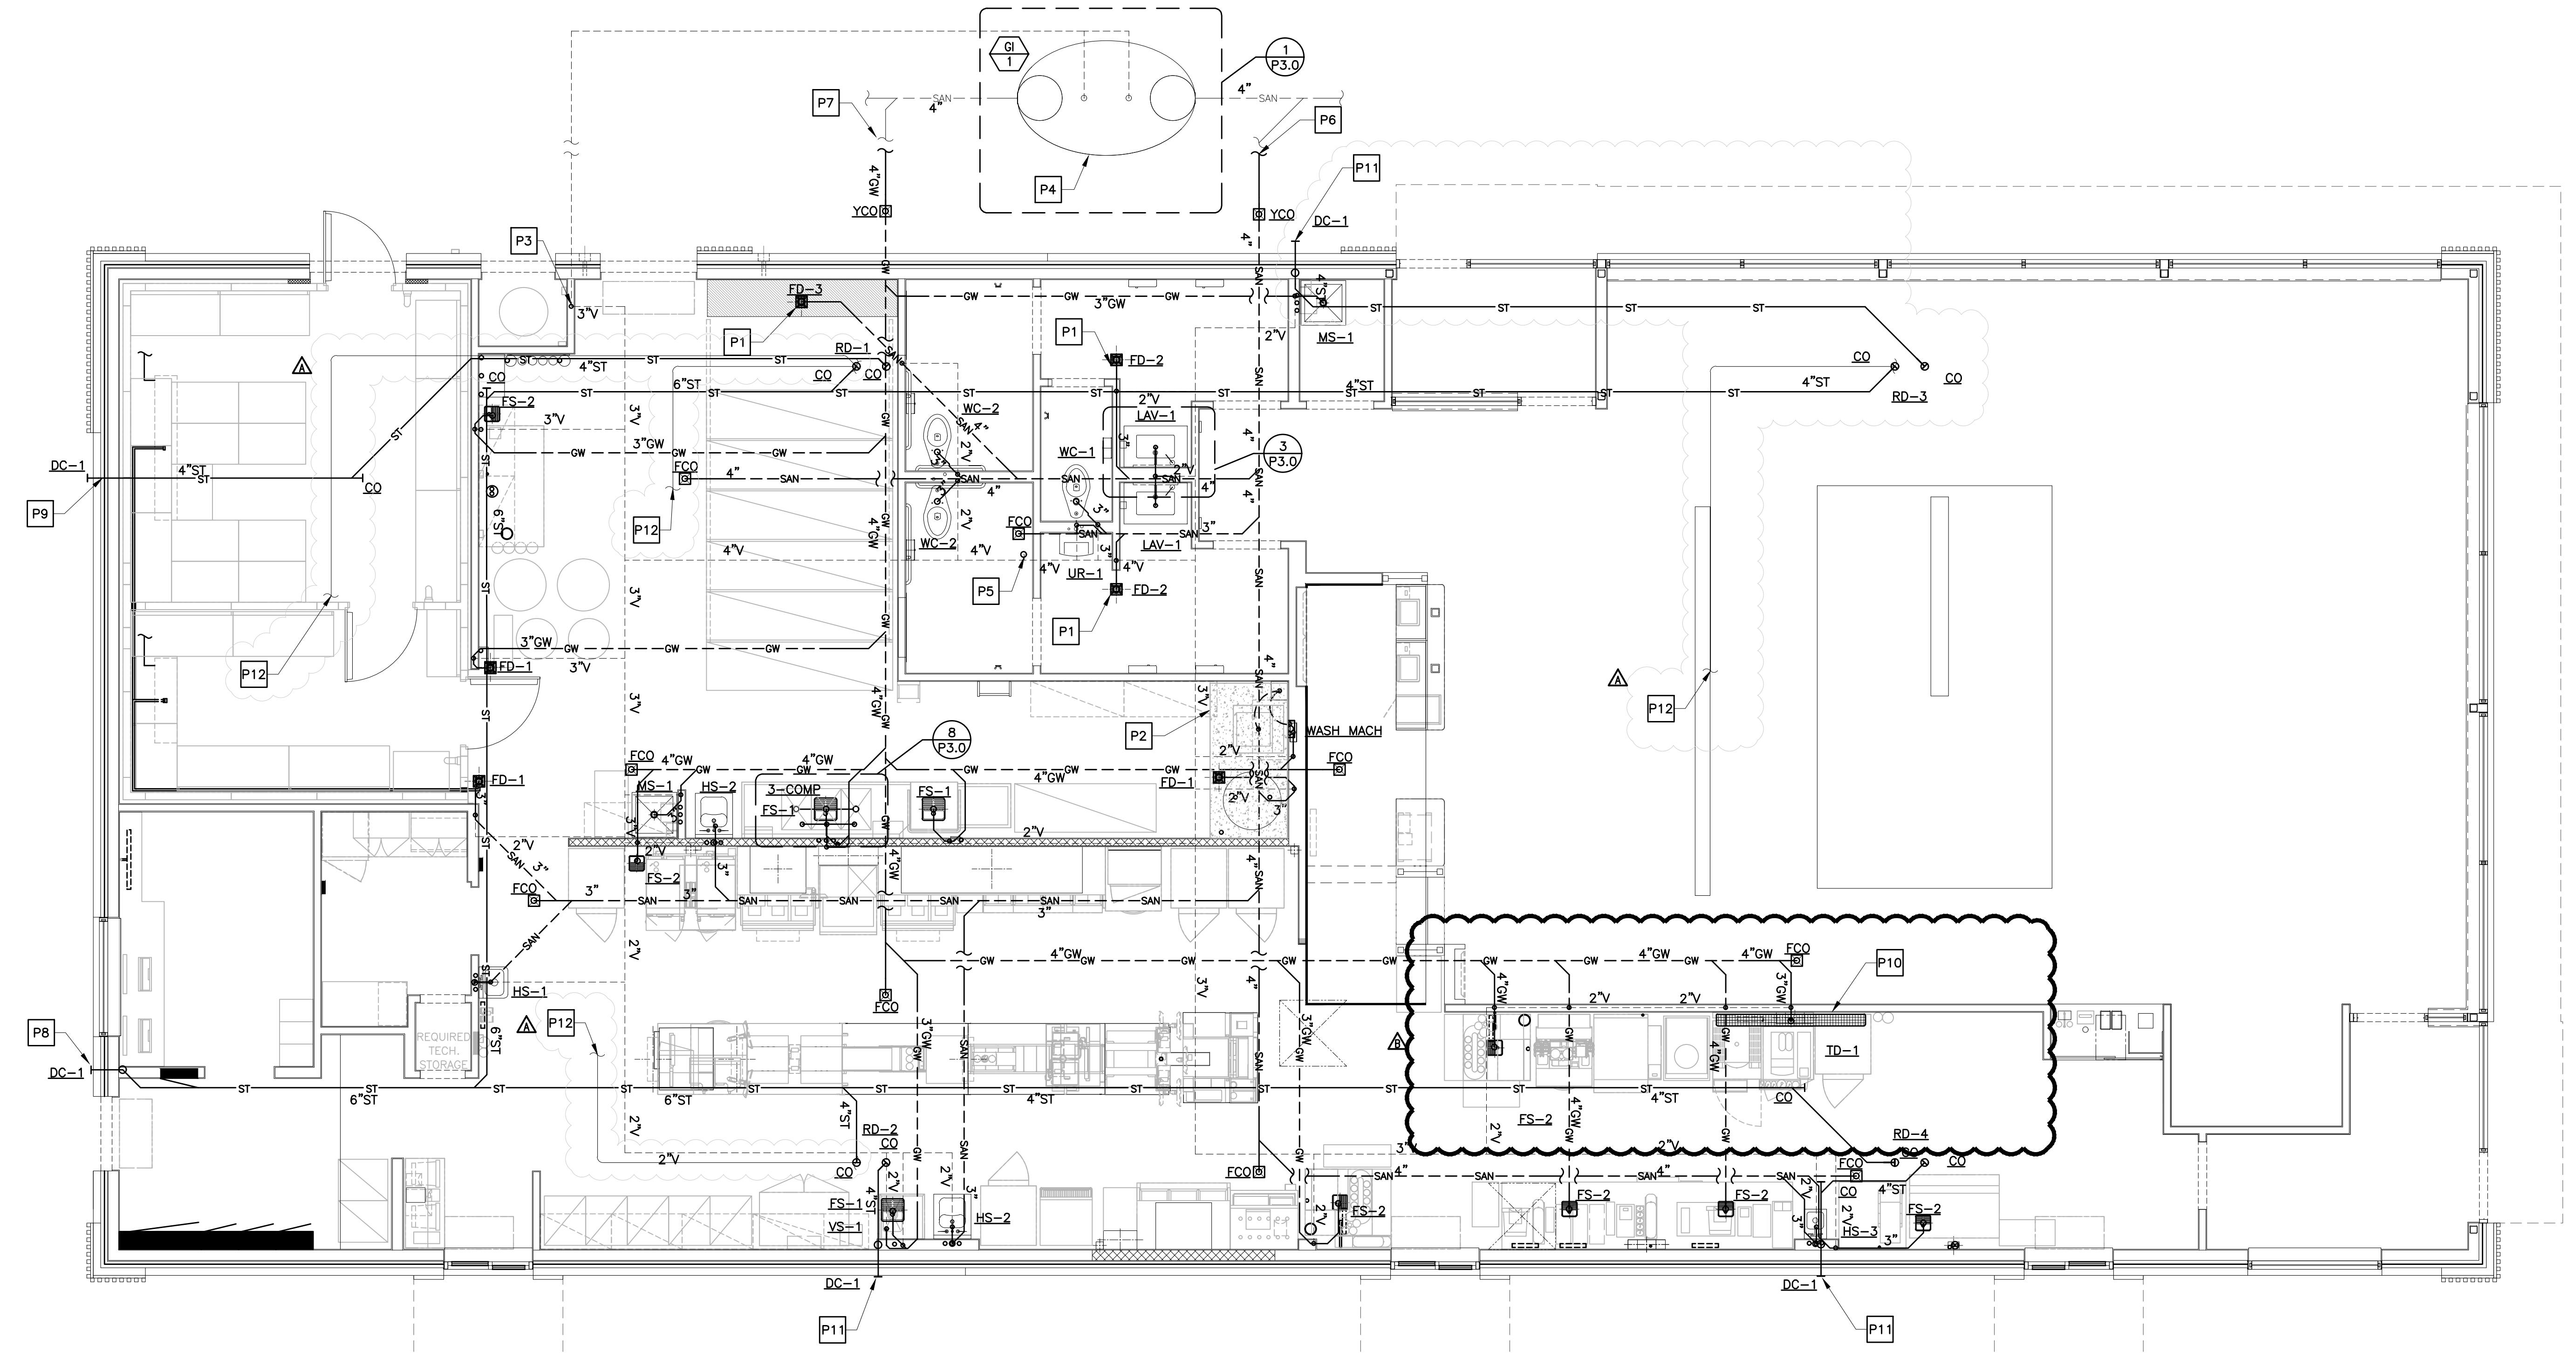

1 WASTE & VENT PIPING PLAN
P1.2 1/4"=1'-0"

DRAWING NOTES

1. PIPING ROUTES ARE GENERAL AND MAY VARY DUE TO FIELD CONDITIONS. COORDINATE ALL PIPE ROUTES WITH OTHER TRADES.
2. WALL CLEAN-OUTS FOR WASTE PIPING NOT SHOWN FOR CLARITY. SEE GENERAL NOTES FOR REQUIREMENTS.
3. ONLY MAIN FLOOR CLEAN-OUTS ARE SHOWN FOR CLARITY. SEE GENERAL NOTES FOR REQUIREMENTS.
4. ALL HORIZONTAL STORM DRAINAGE PIPING SHALL BE INSULATED TO PREVENT CONDENSATION. INSULATION NOT SHOWN FOR CLARITY. SEE PLUMBING NOTES FOR INSULATION REQUIREMENTS.=

KEYED NOTES

- P1 PROVIDE PROSET TRAP GUARD® OR TRAP PRIMER FOR FLOOR DRAIN OR FLOOR SINK.
- P2 TOP OF CONCRETE SLAB IS 0'-6" A.F.F.
- P3 VENT FROM GREASE INTERCEPTOR. SEE SITE PLAN FOR CONTINUATION. COORDINATE PIPE ROUTING WITH LOCATION OF GREASE INTERCEPTOR.
- P4 GREASE INTERCEPTOR LOCATION SHOWN FOR REFERENCE ONLY. COORDINATE GREASE INTERCEPTOR LOCATION WITH CIVIL ENGINEER AND SITE CONTRACTOR.
- P5 4"x5" VENT THROUGH ROOF
- P6 SANITARY LINE TO SANITARY SEWER. SEE SITE PLAN FOR CONTINUATION.
- P7 GREASE LINE TO EXTERIOR GREASE INTERCEPTOR. SEE SITE PLAN FOR CONTINUATION
- P8 TERMINATE BOTTOM OF PRIMARY STORM DRAIN A MINIMUM OF 12" ABOVE GRADE WITH DOWNSPOUT COVER.
- P9 TERMINATE OVERFLOW DRAIN AS HIGH AS POSSIBLE WITH DOWNSPOUT COVER.
- P10 REFERENCE MANUFACTURER INSTALLATION GUIDE FOR LAYOUT GUIDELINES PRIOR TO INSTALL AND POURING THE SLAB
- P11 TERMINATE BOTTOM OF OVERFLOW DRAIN A MINIMUM OF 12" ABOVE GRADE WITH DOWNSPOUT COVER.
- P12 ROUTE CONDENSATE TO ROOF DRAIN AS SHOWN

WASTE PIPE SIZING - UPC

Fixture Type	TRAP SIZE	DFU	QUANTITY	TOTAL
URINAL	2 IN.	2	1	2
WATER CLOSET	3 IN.	4	3	12
LAVATORY SINK	1 1/4 IN.	1	2	2
WASH SINK (HAND SINK)	1 1/2 IN.	2	4	8
FLOOR DRAIN OR SINK	3 IN.	6	5	30
FLOOR DRAIN OR SINK	4 IN.	8	1	8
FLOOR DRAIN EMERGENCY	3 IN.	0	0	0
TOTAL				62

GREASE PIPE SIZING - UPC

MOP SINK	3 IN.	3	2	6
FLOOR DRAIN OR SINK	3 IN.	6	10	60
TRENCH DRAIN	4 IN.	8	1	8
WASHING MACHINE	2 IN.	1	3	3
TOTAL				77

STORM PIPE SIZING

RAINFALL = 4 IN./HR
VERTICAL LEADERS


ROOF AREA	SIZE
RD-1	1,345
RD-2	1,340
RD-3	1,145
RD-4	1,145
TOTAL	4,975

HORIZONTAL PIPING (SLOPE X" PER FOOT)

ROOF AREA	SIZE
RD-1	1,345
RD-2	1,340
RD-3	1,145
RD-4	1,145
TOTAL	4,975


DESCRIPTION	REV DATE
W.L.W. SERVICE AREA OPTIMIZATION	12/03/20
W.L.W. USD: SAO SET REVIEW	11/13/20
W.L.W. CIVIL & PLAN REVIEW COMMENTS	05/05/20
W.L.W. PERMIT SET	01/23/20
W.L.W. PROGRESS SET REVIEW	01/13/20
W.L.W. REV DATE	

emmanuelson-podas consulting engineers
380.00.037
Michael Weber
LICENSED
17648
KANSAS STATE BOARD OF ENGINEERS
12/03/20

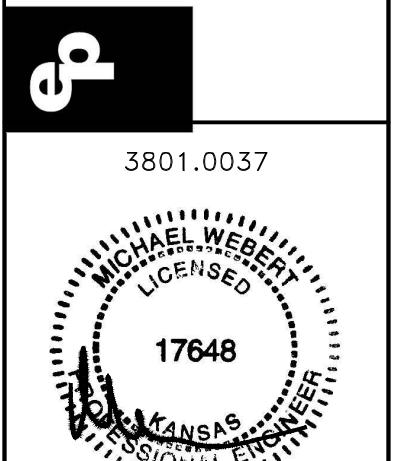

© 2020 McDonald's USA, LLC
PREPARED BY:
McDonald's USA, LLC
These drawings and specifications are the confidential and proprietary property of McDonald's USA, LLC and shall not be copied or reproduced for use on this specific site in construction with the issuance of one or more other sets of drawings for reference or example on another project. Use of these drawings for reference or example on another project requires the services of properly licensed architects and engineers. Reproduction of the contract documents for reuse on another project is not authorized.

TITLE	STD ISSUE DATE	REVIEWED BY	DATE ISSUED	DESCRIPTION
2019 STANDARD BUILDING - BB20	2019-11	W.L.W.	01-23-20	4597F10-WOOD/WOOD
DESCRIPTION				WOOD BEARING WALLS W/ FIBER CEMENT SIDING & CI WOOD ROOF TRUSS FRAMING FIBER CEMENT PANEL/BATTEN/ALPOLIC PANEL/BRICK EXT. FINISH
SITE ID				SITE ADDRESS 605 SOUTH 7TH STREET, KANSAS CITY, KS
SHEET NO.				015-0071.00.B P1.2 WASTE, VENT & STORM PIPING

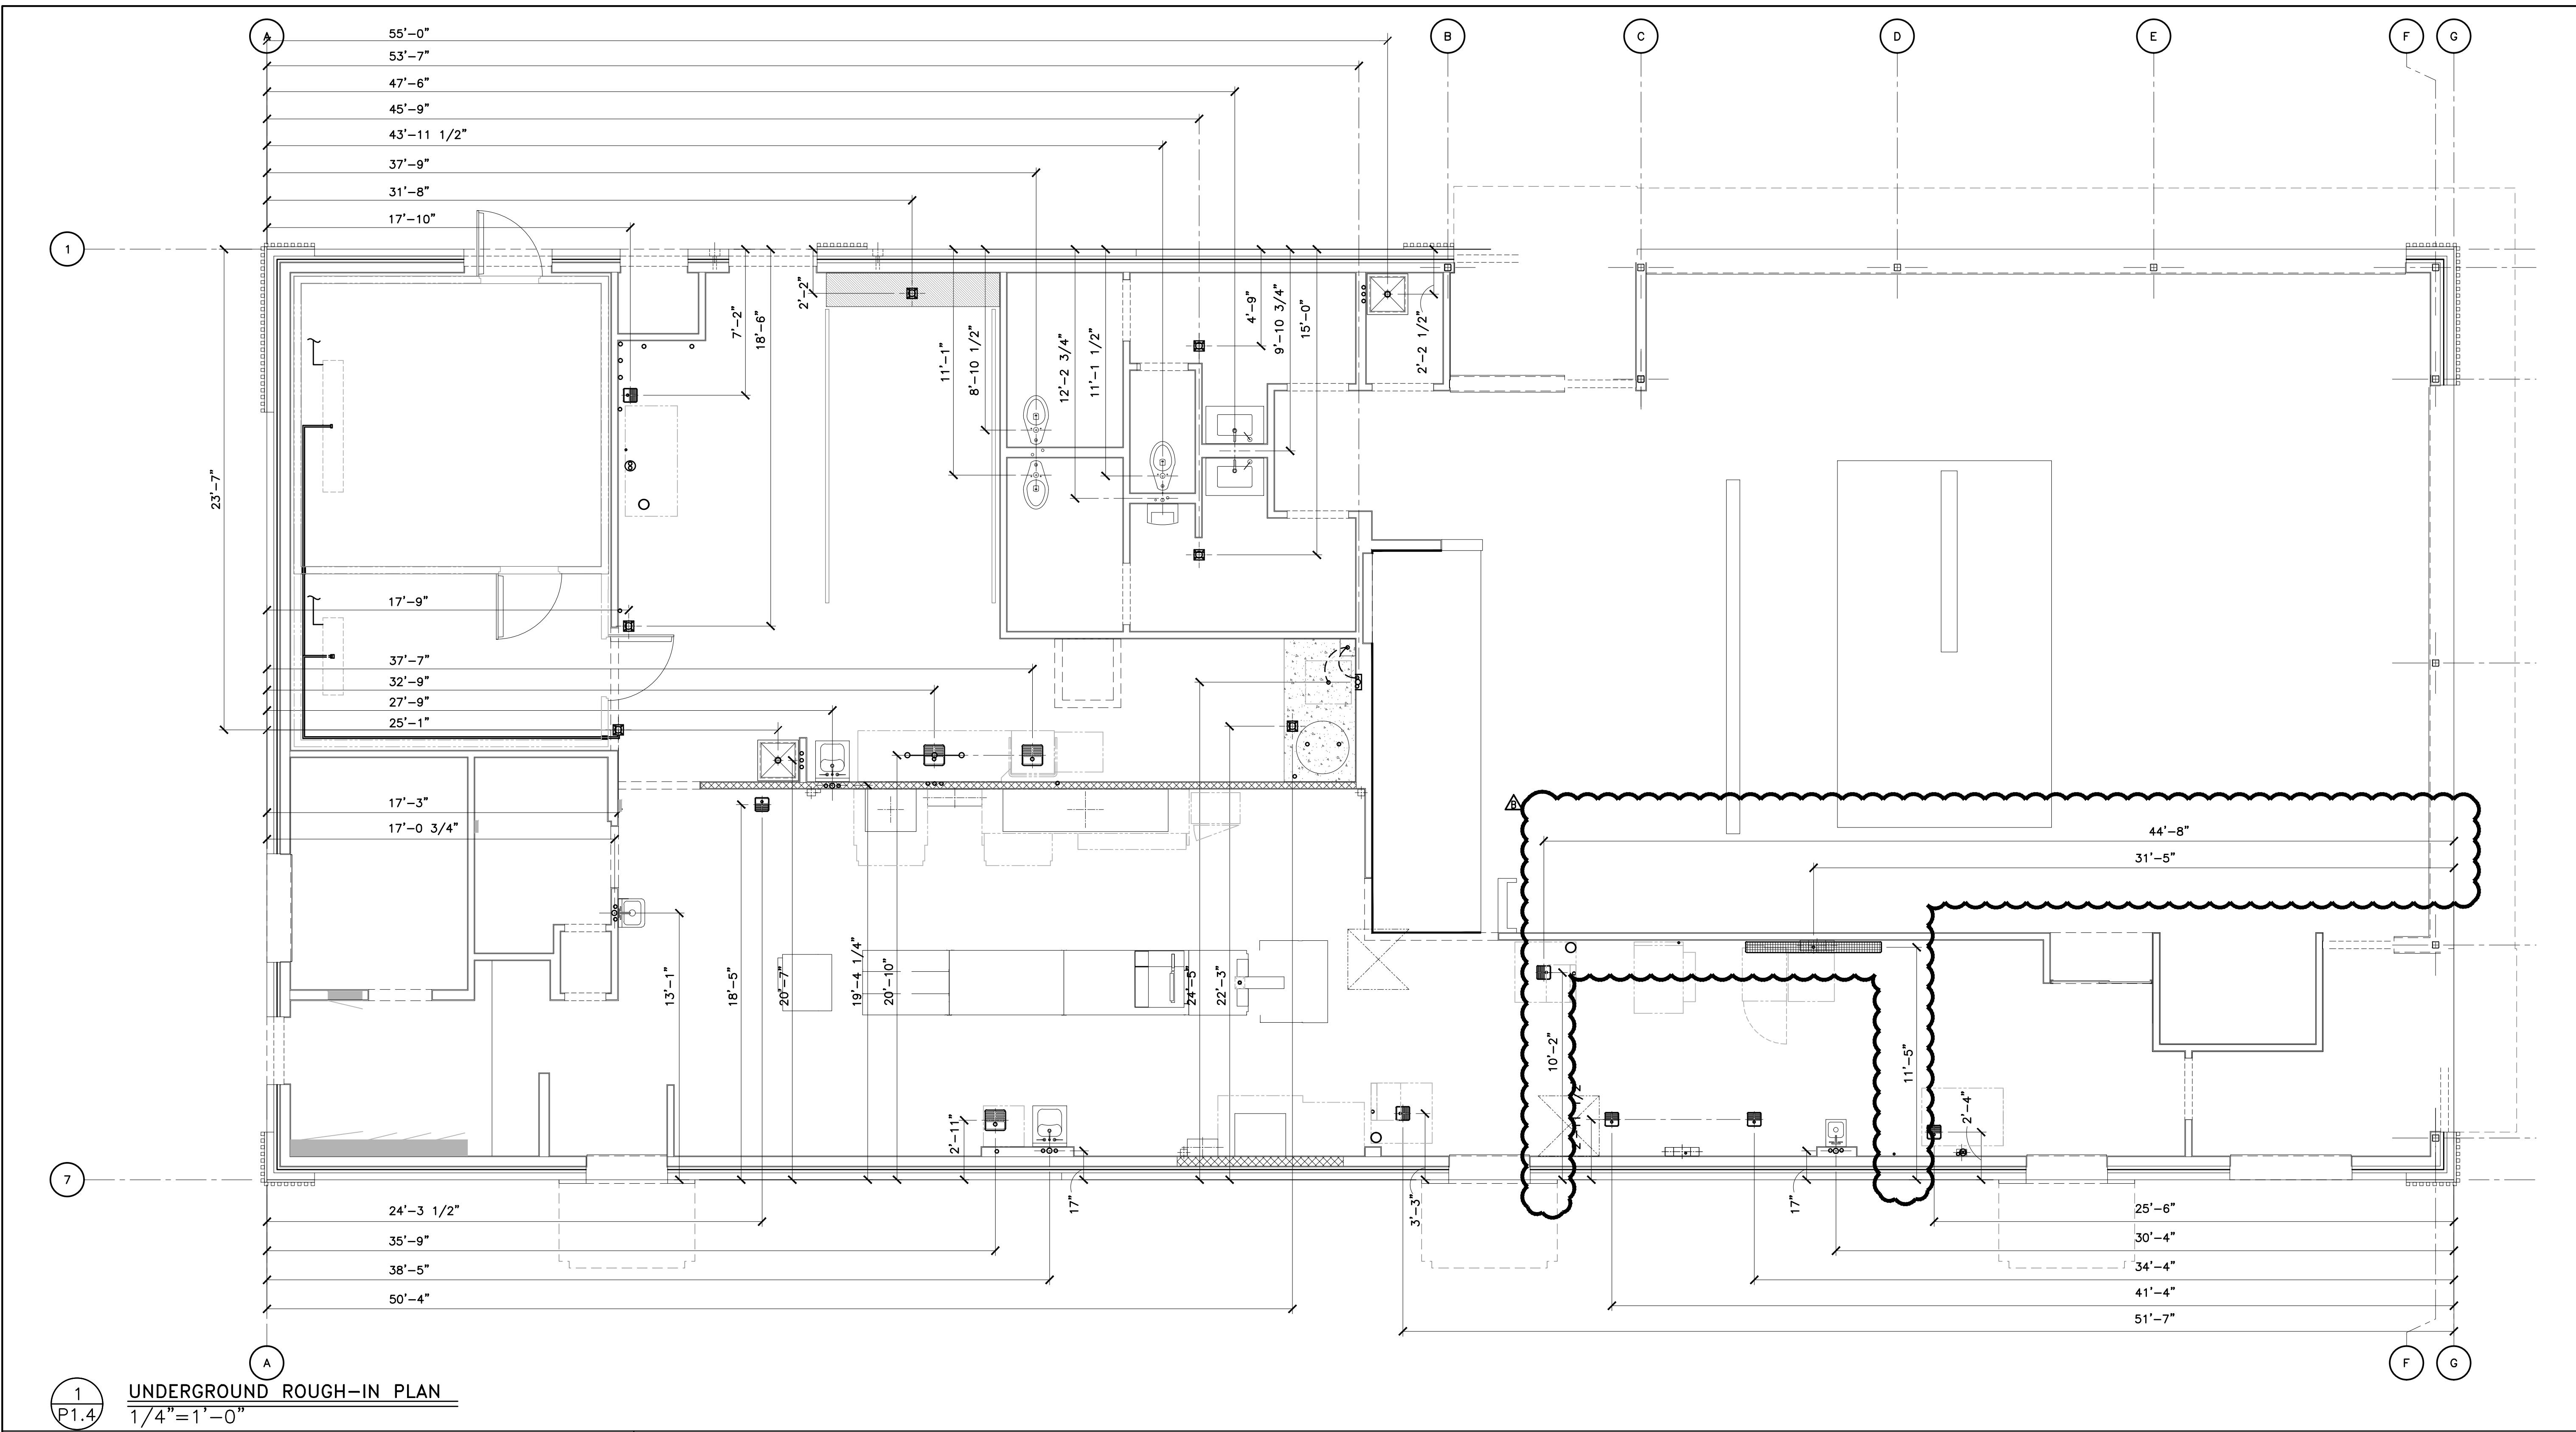


P1.4 UNDERGROUND ROUGH-IN PLAN
1/4"=1'-0"

DRAWING NOTES

1. THIS PLAN IS PROVIDED AS A GUIDE FOR THE PLUMBING CONTRACTOR. ALL DIMENSIONS ARE ROUNDED TO THE NEAREST $\frac{1}{4}$ ", AND ARE TAKEN FROM ARCHITECTURAL GRID LINES.

SHEET NO.	TITLE	PREPARED BY:	REVIEWED BY:	DATE ISSUED:	DESCRIPTION	REV. DATE	BY
015-0071.00.B	2019 STANDARD BUILDING - BB20 4597F10-WOOD/WOOD	M.J.W. 2019-11	W.L.W. 11/13/20	12/03/20	SERVICE AREA OPTIMIZATION		


emmanuelson-podas
consulting engineers
3801.0037
Emmanuel-Podas, Inc.
Edna, IN 46549
(920) 930-0050 | www.epinc.com

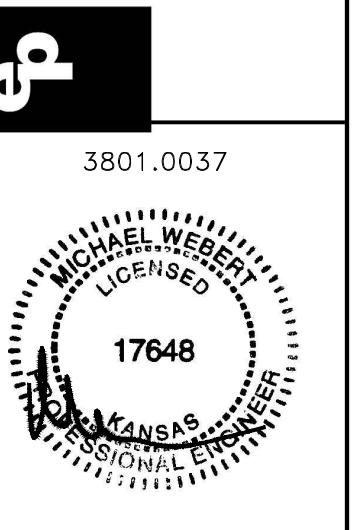

© 2020 McDonald's USA, LLC
McDonald's USA, LLC
These drawings and specifications are the confidential and proprietary property of McDonald's USA, LLC and shall not be copied or reproduced for use on this specific site in conjunction with the issuance date and are not suitable for use on a different site or at a later time. Use of these drawings for reference or example on another project requires the services of a properly licensed architect or engineer. Reproduction of the contract documents for reuse on another project is not authorized.

SHEET NO.	TITLE	DRAWN BY:	PREPARED BY:	REVIEWED BY:	DATE ISSUED:	DESCRIPTION	REV. DATE	BY
015-0071.00.B	2019 STANDARD BUILDING - BB20 4597F10-WOOD/WOOD	M.J.W. 2019-11	W.L.W. 11/13/20	12/03/20	WOOD BEARING WALLS W/FIBER CEMENT SIDING & CI WOOD ROOF TRUSS FRAMING FIBER CEMENT PANEL/BATTEN/ALPOLIC PANEL/BRICK EXT. FINISH	Michael Weber 17648 12/03/20		

SEE SHEET P1.6 FOR OVERHEAD
DIMENSIONS AND PLUMBING SCHEDULE.
P1.4
UNDERGROUND ROUGH-IN

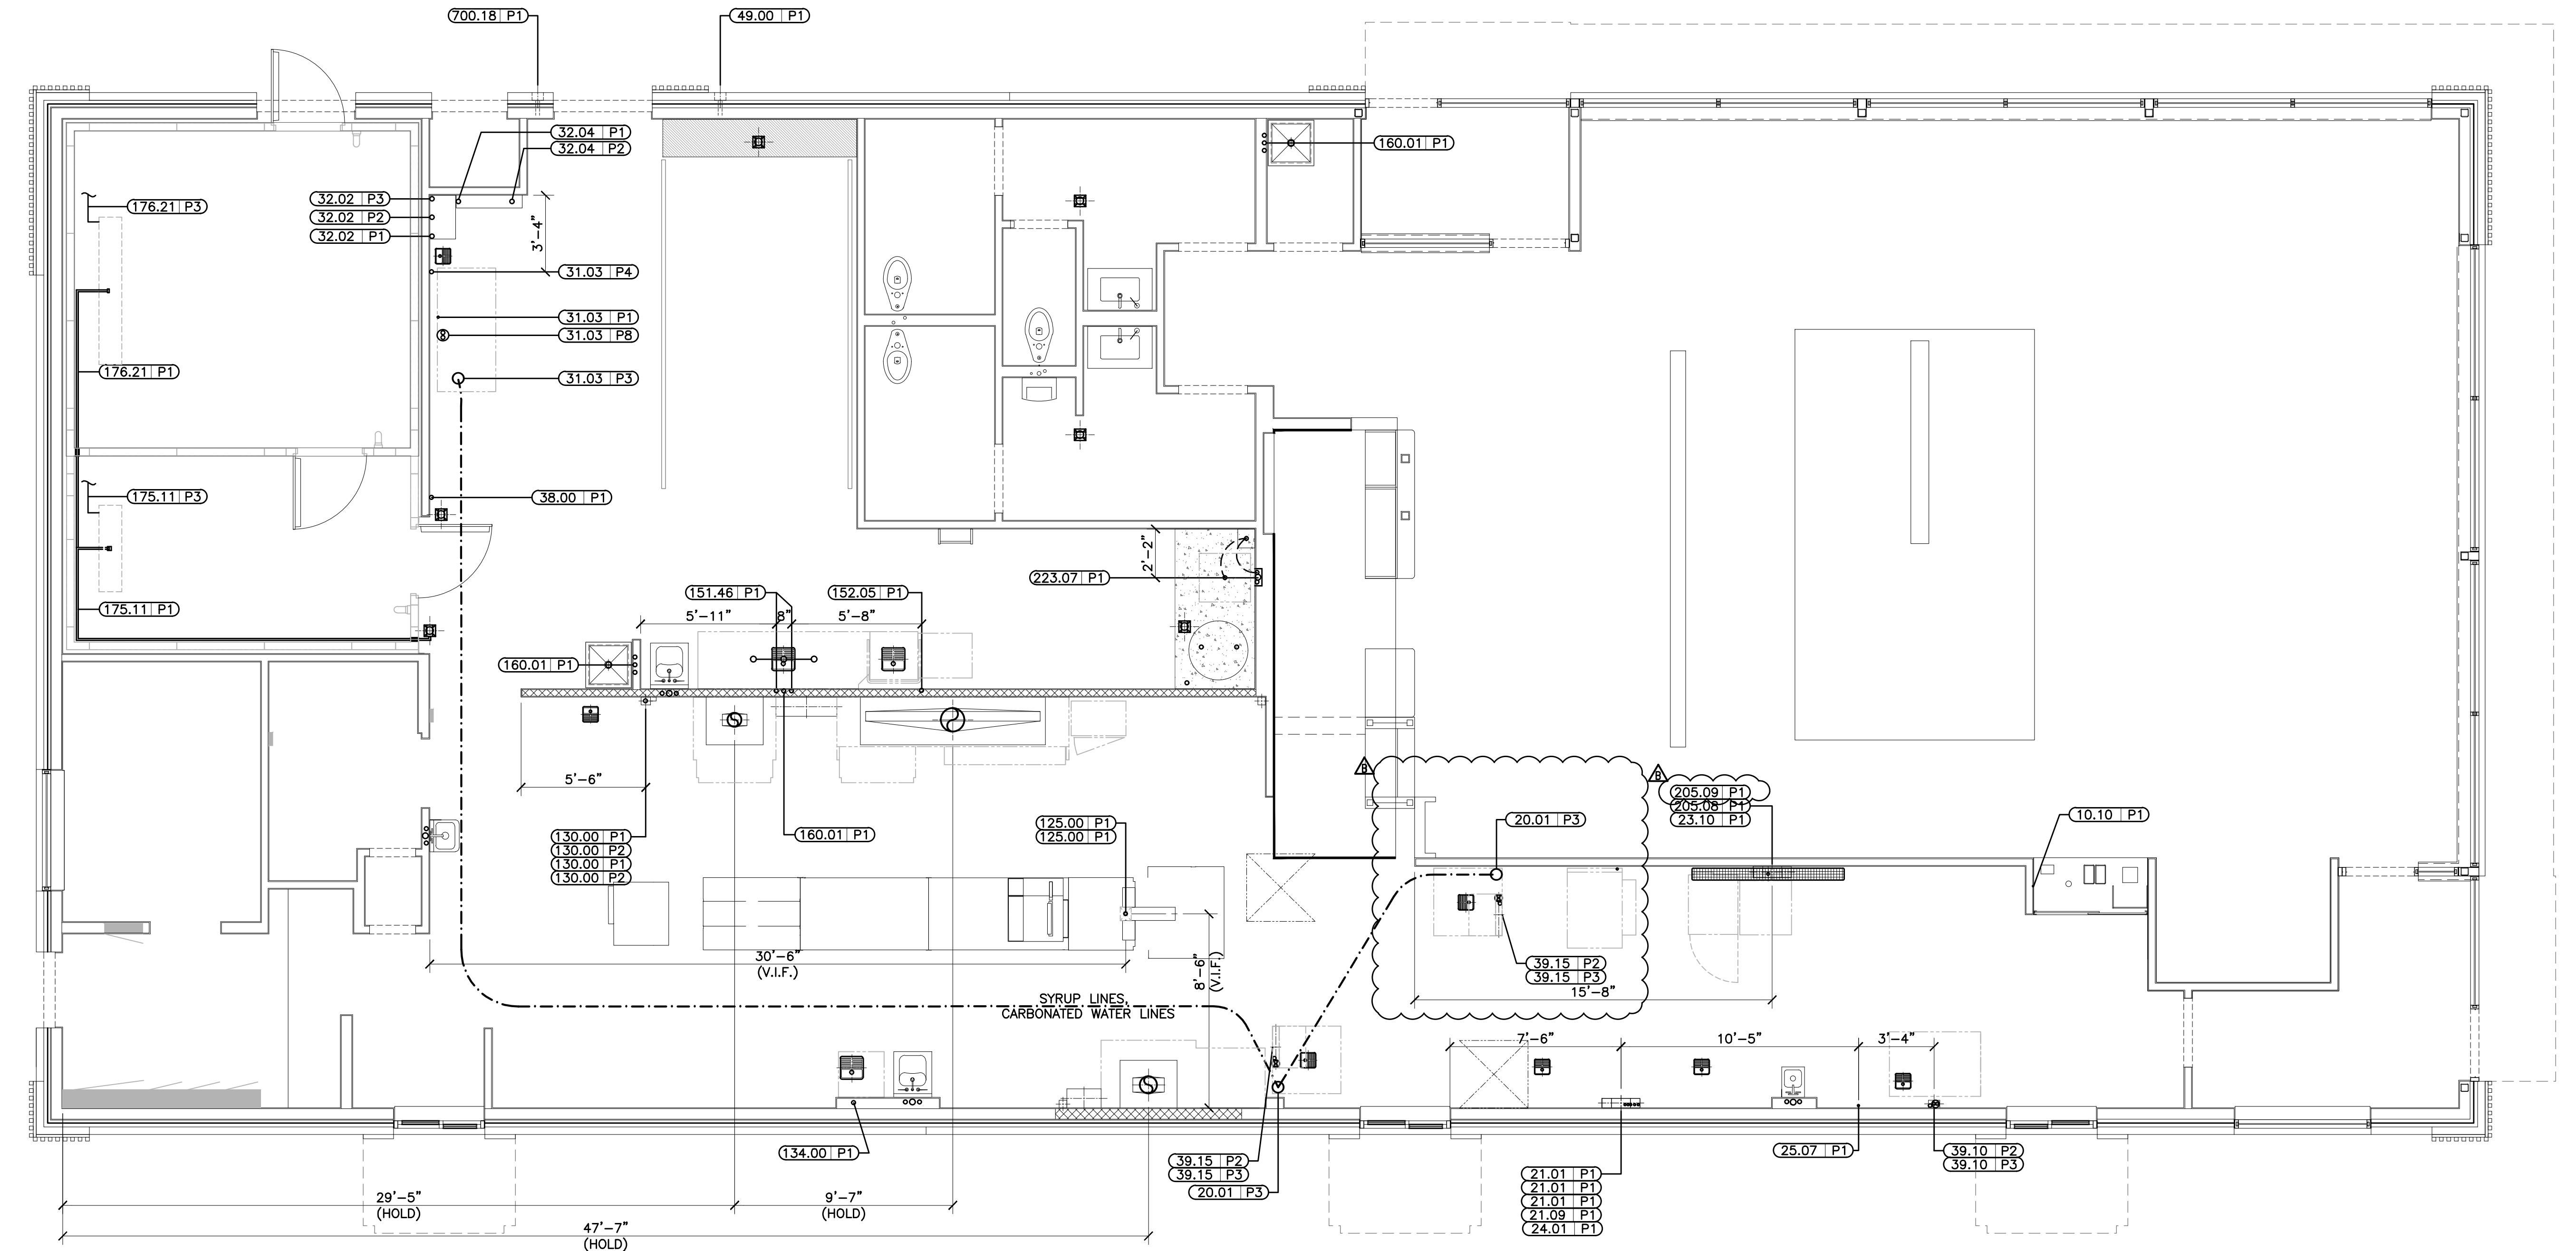

OVERHEAD ROUGH-IN PLAN
P1.6 1/4"=1'-0"

SEE SHEET P1.4 FOR
UNDERGROUND ROUGH-IN PLAN


VIF = Verify in Field
PC = Plumbing Contractor
BSI = Beverage System Installer

PLUMBING SCHEDULE

TAG #	QTY	DESCRIPTION	GAS TYPE	GAS BTU	GAS SIZE	HW	CW	MISC PLBG	HGT AFF	DRAIN	REQUIREMENTS & REMARKS
010.10P1	1	CO2 DRIVEN KETCHUP DISPENSERS	-	-	-	-	-	3/8" CO2	SEE RMKS	-	DN CHASE FROM BULK CO2 IF NO CHASE RUN IN 2"COND TO JB -BSI TO CONN CO2 LINE PER LOCAL CODES
020.01P3	2	AUTOMATED BEVERAGE SYSTEM 2.0	-	-	-	-	-	6" PVC CONDUIT	SEE RMKS	-	ABOVE CEILING FROM SODA SYSTEM - TERMINATE AT CHASE
021.01P1	1	COFFEE BREWER (GLASS DECANTERS)	-	-	-	-	1/4"	TRTD	-	SEE RMKS	DN CHASE FROM SODA SYSTEM - IF NO CHASE RUN IN 2"COND TO JB -BSI TO CONN CW LINE PER LOCAL CODES. 1/4" R.O. WATER OPTIONAL
021.09P1	1	HOT WATER DISPENSER	-	-	-	-	1/4"	-	SEE RMKS	-	DN CHASE FROM SODA SYSTEM - IF NO CHASE RUN IN 2"COND TO JB -BSI TO CONN CW LINE PER LOCAL CODES. 1/4" R.O. WATER OPTIONAL
023.10P1	1	ESPRESSO BREWER	-	-	-	-	3/8"	R.O.	-	SEE RMKS	DN CHASE FROM R.O. SYSTEM - IF NO CHASE RUN IN 2"COND TO JB -BSI TO CONN CW LINE PER LOCAL CODES
024.01P1	1	ORANGE JUICE DISPENSER	-	-	-	-	1/2"	FLTR	-	SEE RMKS	DN CHASE FROM SODA TOWER CW LINE W/ RECIRC/CHILLED INSULATED BUNDLE-BSI CONN CWLINE LOCAL CODES PERMITTING
025.07P1	1	INFUSION TEA BREWER - MIS	-	-	-	-	1/2"	TRTD	3/8" CO2	SEE RMKS	DN CHASE FROM SODA SYSTEM - IF NO CHASE RUN IN 2"COND TO JB -BSI TO CONN CW LINE PER LOCAL CODES
028.15P3	1	NOT USED	-	-	-	-	-	SODA BUNDLE	SEE RMKS	3/4" IND	DN CHASE FROM SODA SYSTEM - BSI TO MAKE FINAL CONNECTIONS PER LOCAL CODES
031.03P1	1	SODA SYSTEM PACKAGE B.I.B.(RECIRCULATING- 3 TOWERS)	-	-	-	-	-	3/8" OUTLET	SEE RMKS	-	FLEX LINE OVERHEAD TO VARIOUS EQUIP. BSI TO MAKE FINAL CONN PER LOCAL CODES
031.03P3	1	SODA SYSTEM PACKAGE B.I.B.(RECIRCULATING- 3 TOWERS)	-	-	-	-	-	SODA BUNDLE	SEE RMKS	-	OVERHEAD TO SODA TOWER CHASE(S) - BSI TO MAKE FINAL CONNECTIONS PER LOCAL CODES
031.03P4	1	SODA SYSTEM PACKAGE B.I.B.(RECIRCULATING- 3 TOWERS)	-	-	-	3/4"	-	1'-6"	3/4" IND	BSI TO MAKE CONNECTION FROM BACKFLOW PREVENTER (VERIFY HEIGHT IN FIELD)	-
031.03P8	1	SODA SYSTEM PACKAGE B.I.B.(RECIRCULATING- 3 TOWERS)	-	-	-	-	-	REFRIG LINES	SEE RMKS	-	FROM REMOTE CONDENSING UNIT
032.02P1	1	REVERSE OSMOSIS WATER FILTRATION SYSTEM	-	-	-	-	3/8"	-	SEE RMKS	-	FLEX LINE OVERHEAD FROM SODA SYSTEM - BSI TO MAKE FINAL CONN PER LOCAL CODES
032.02P2	1	REVERSE OSMOSIS WATER FILTRATION SYSTEM	-	-	-	-	-	3/8" OUTLET	SEE RMKS	-	FLEX LINE OVERHEAD TO RAPID STEAMER, ESPRESSO, AND COFFEE (OPT.) -BSI TO MAKE FINAL CONN PER LOCAL CODES
032.02P3	1	REVERSE OSMOSIS WATER FILTRATION SYSTEM	-	-	-	-	-	1/4"	-	-	-
032.04P1	1	WATER FILTRATION SYSTEM	-	-	-	-	-	3/4" INLET	6'-0"	-	-
032.04P2	1	WATER FILTRATION SYSTEM	-	-	-	-	-	3/4" OUTLET	-	-	3/4" GHT RINSE CONN. FLEX LINE OVHD. TO RAPID STEAMER, ESPRESSO, & COFFEE (OPT.) -BSI TO MAKE FINAL CONN PER LOCAL CODE
038.00P1	1	CLEAN IN PLACE PANEL	-	-	-	1/2"	FLTR	6'-0"	-	-	FOR CLEANING BULK COKE TANKS. INSTALL HEIGHT TO BOTTOM OF UNIT

PLUMBING SCHEDULE


TITLE	2019 STANDARD BUILDING - BB20	STD ISSUE DATE	2019-11	DRAWN BY	M.J.W	REVIEWED BY	WLW	DESCRIPTION
DESCRIPTION	WOOD BEARING WALLS W/FIBER CEMENT SIDING & CI	DATE ISSUED	01-23-20	PREPARED BY:	McDonald's USA, LLC	PREPARED BY:	emmanuelson-podas consulting engineers	These drawings and specifications are the confidential and proprietary property of McDonald's USA, LLC and shall not be copied or reproduced for use on this specific site in construction with the issued date and are not suitable for use on a different site or at a later time. Use of these drawings for reference or example on another project requires the services of properly licensed architects and engineers. Reproduction of the contract documents for reuse on another project is not authorized.
SITE ID	015-0071	SITE ADDRESS	605 SOUTH 7TH STREET, KANSAS CITY, KS	PERMIT SET	11/13/20	PERMIT SET	11/13/20	PERMIT SET
PERMIT SET	01/23/20	PROGRESS SET REVIEW	01/13/20	REV DATE	12/03/20	REV DATE	12/03/20	REV DATE
SHEET NO.	P1.6	OVERHEAD ROUGH-IN	OVERHEAD ROUGH-IN	BY	17648	BY	MICHAEL WEBER LICENSED	BY
015-0071.00.B	4597F10-WOOD/WOOD	015-0071	015-0071	015-0071	3801.0037	015-0071	3801.0037	015-0071

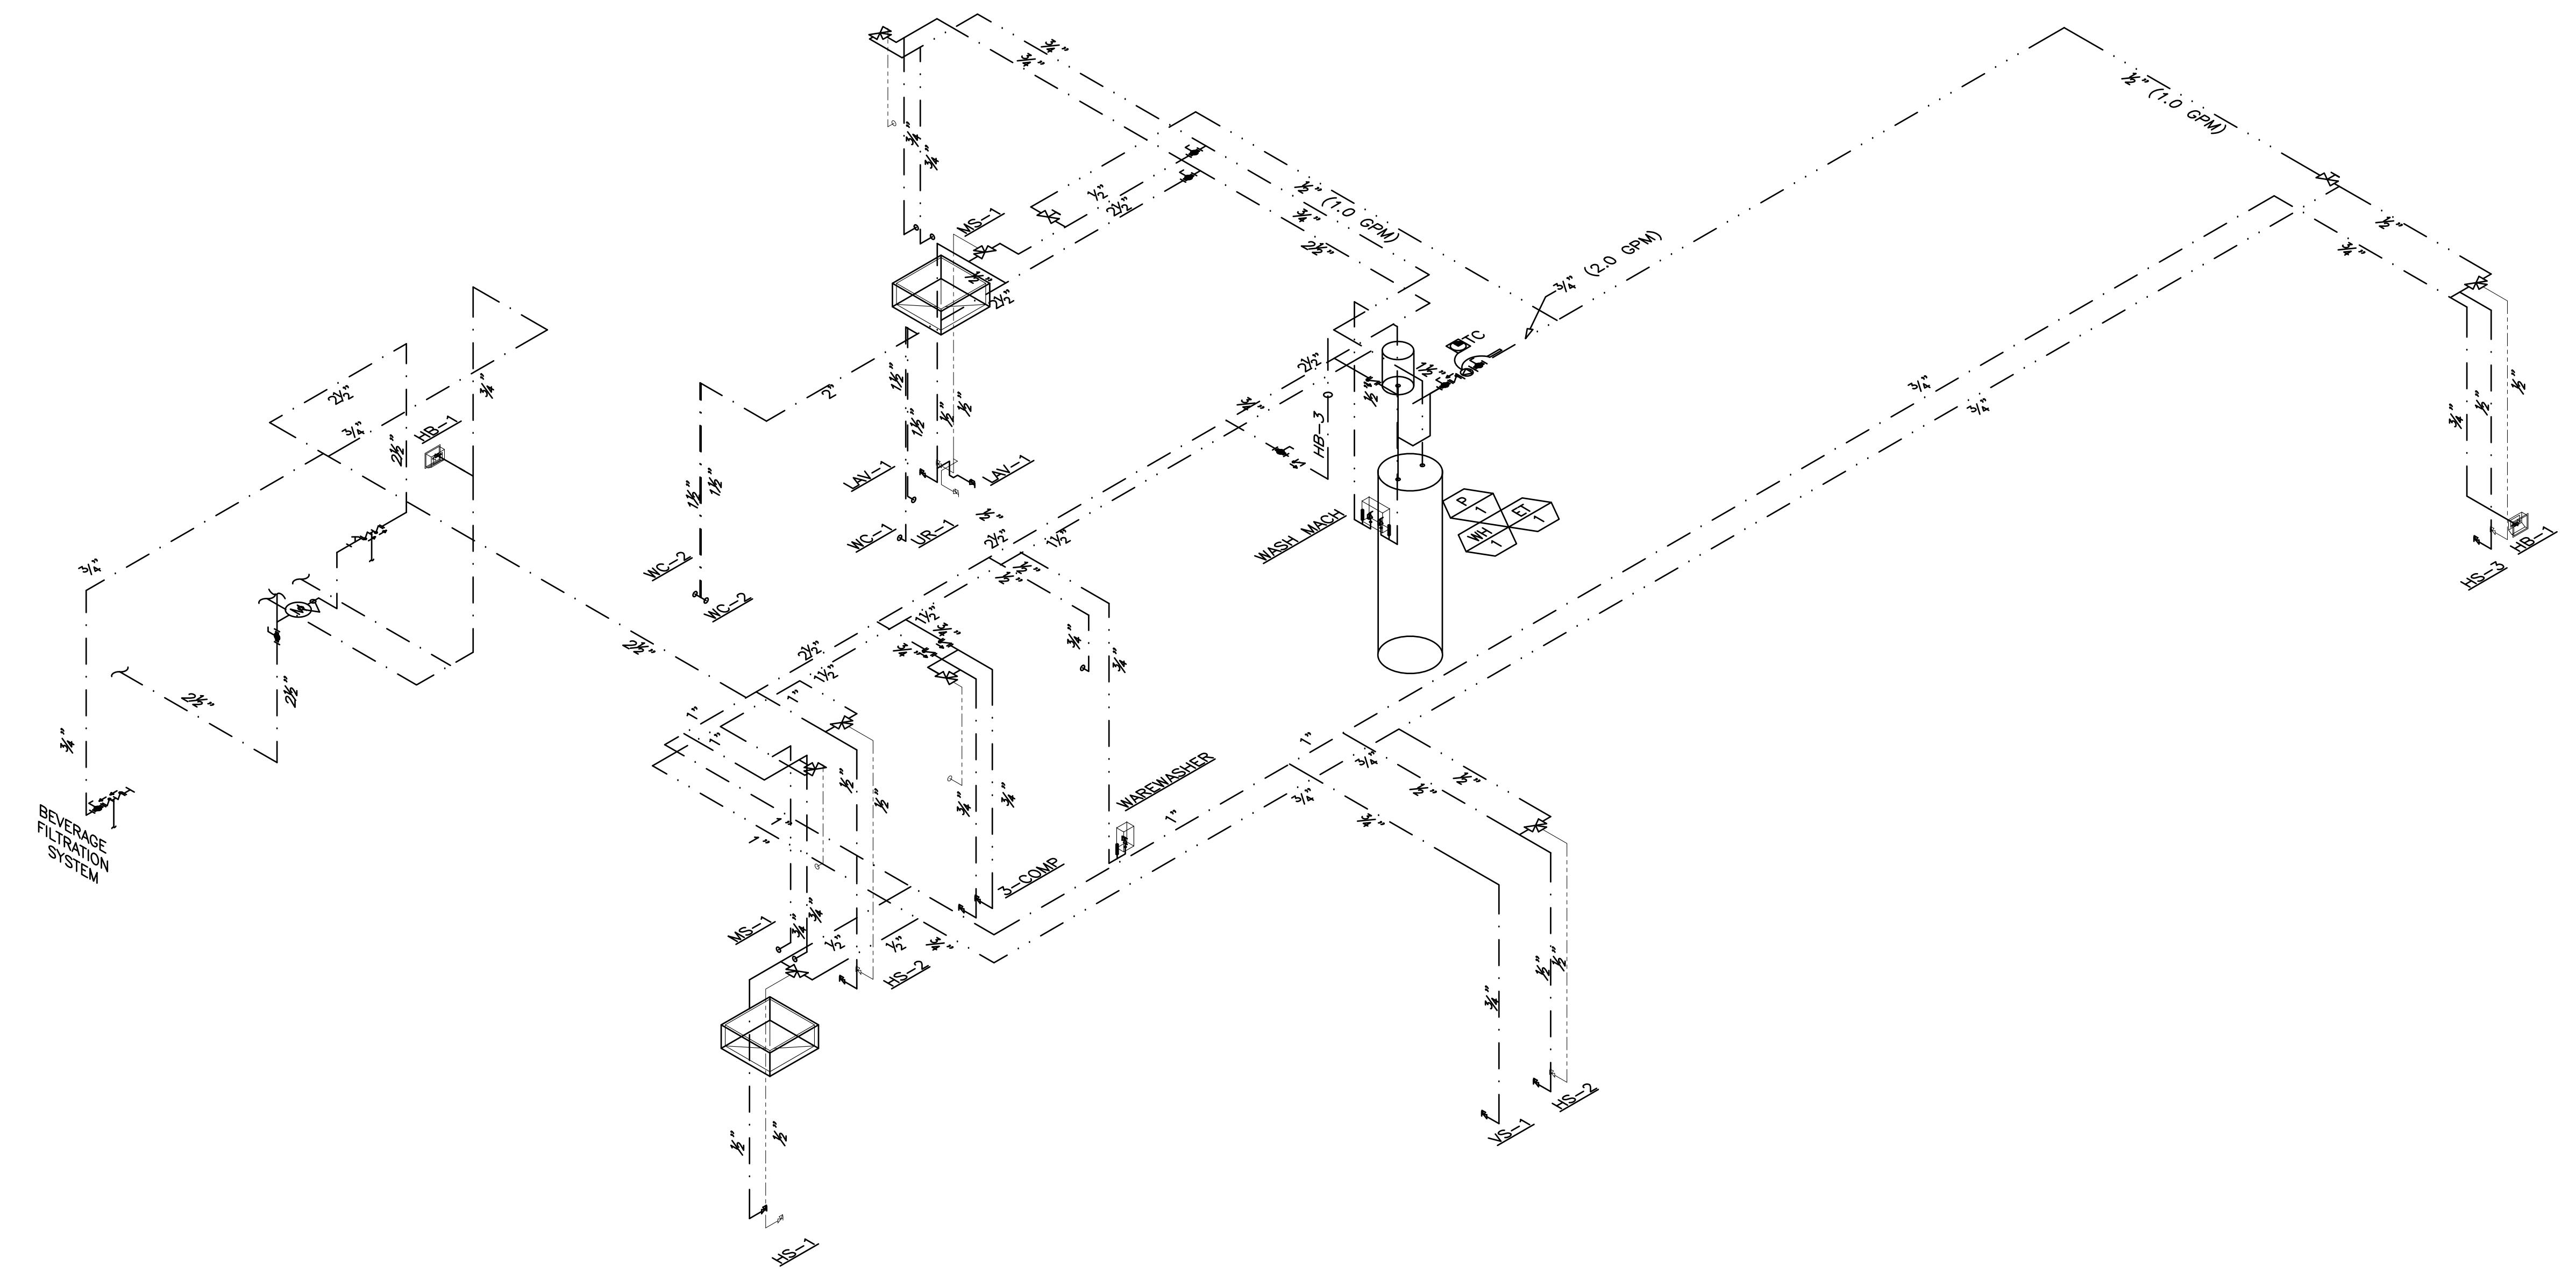

SHEET NO.	TITLE	DRAWN BY	PREPARED FOR:	REVIEWED BY	REVISED BY	DATE ISSUED	DATE ISSUED	DESCRIPTION	REV. DATE	BY
015-0071.00.0	2019 STANDARD BUILDING - BB20 4597F10-WOOD/WOOD	M.J.W STD ISSUE DATE 2019-11	© 2020 McDonald's USA, LLC McDonald's USA, LLC	W.L.W				These drawings and specifications are the confidential and proprietary property of McDonald's USA, LLC and shall not be copied or reproduced for use on this specific site in conjunction with its issuance, nor are they suitable for use on a different site or at a later time. Use of these drawings for reference or example on another project requires the services of properly licensed architects and engineers. Reproduction of the contract documents for reuse on another project is not authorized.		
	DESCRIPTION WOOD BEARING WALLS W/FIBER CEMENT SIDING & CI WOOD ROOF TRUSS FRAMING FIBER CEMENT PANEL/BATTEN/ALPOLIC PANEL/BRICK EXT. FINISH									
	SITE ID 015-0071	SITE ADDRESS 605 SOUTH 7TH STREET, KANSAS CITY, KS								
			R#1975							

Emmanuel-Podas Consulting Engineers	Emmanuel-Podas, Inc.	01/23/20 PERMIT SET
	Edens, MN 55459	01/13/20 USD PROGRESS SET REVIEW
	(952) 930-0050 www.epinc.com	REV. DATE


emmanuel-podas	3801.0037	01/23/20
	17648	
	MICHAEL WEBER LICENSED KANSAS PROFESSIONAL ENGINEER	
	01/23/20	

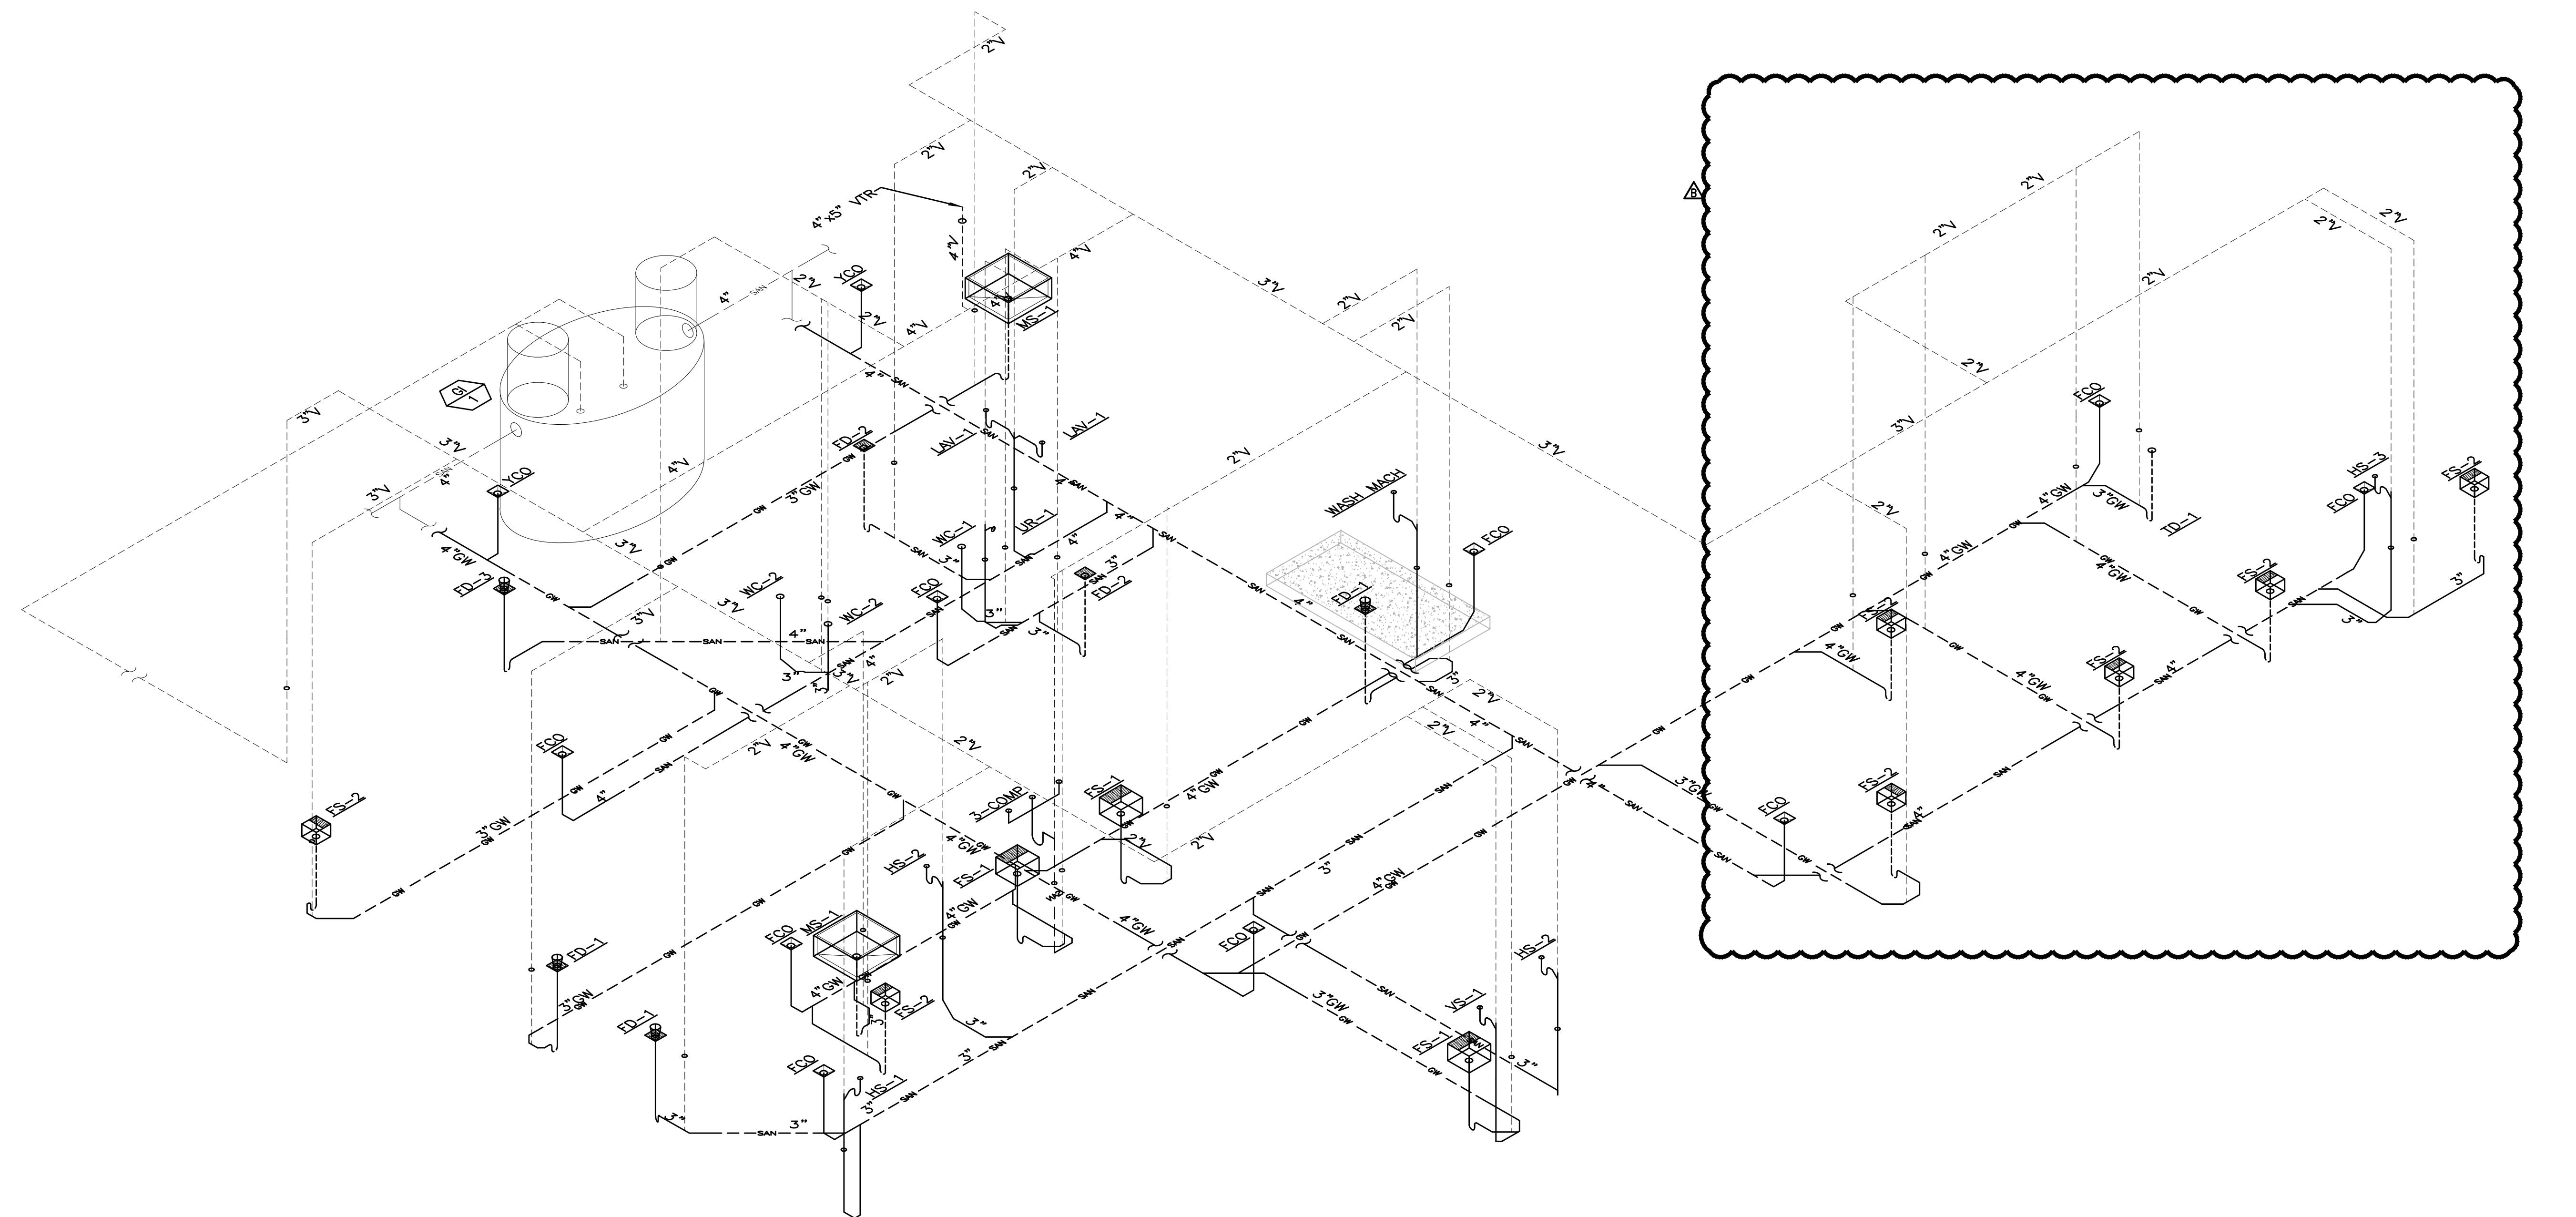

WASTE & VENT PIPING ISOMETRIC

P		McDonald's USA, LLC	
WASTE & VENT ISOMETRIC		2019 STANDARD BUILDING – BB20 4597F10-WOOD/WOOD	
015-0071.00.B		STD ISSUE DATE 2019_11	MJW
DESCRIPTION		REVIEWED BY WLW	LICENSED BY MICHAEL WEBER PROFESSIONAL ENGINEER 17648 KANSAS
WOOD BEARING WALLS W/FIBER CEMENT SIDING & Ci WOOD ROOF TRUSS FRAMING FIBER CEMENT PANEL/BATTEN/ALPOLIC PANEL/BRICK EXT. FINISH		DATE ISSUED 01-23-20	
SITE ID 015-0071	SITE ADDRESS 605 SOUTH 7TH STREET, KANSAS CITY, KS	REV RD#19175	DATE 12/03/20

P2.1

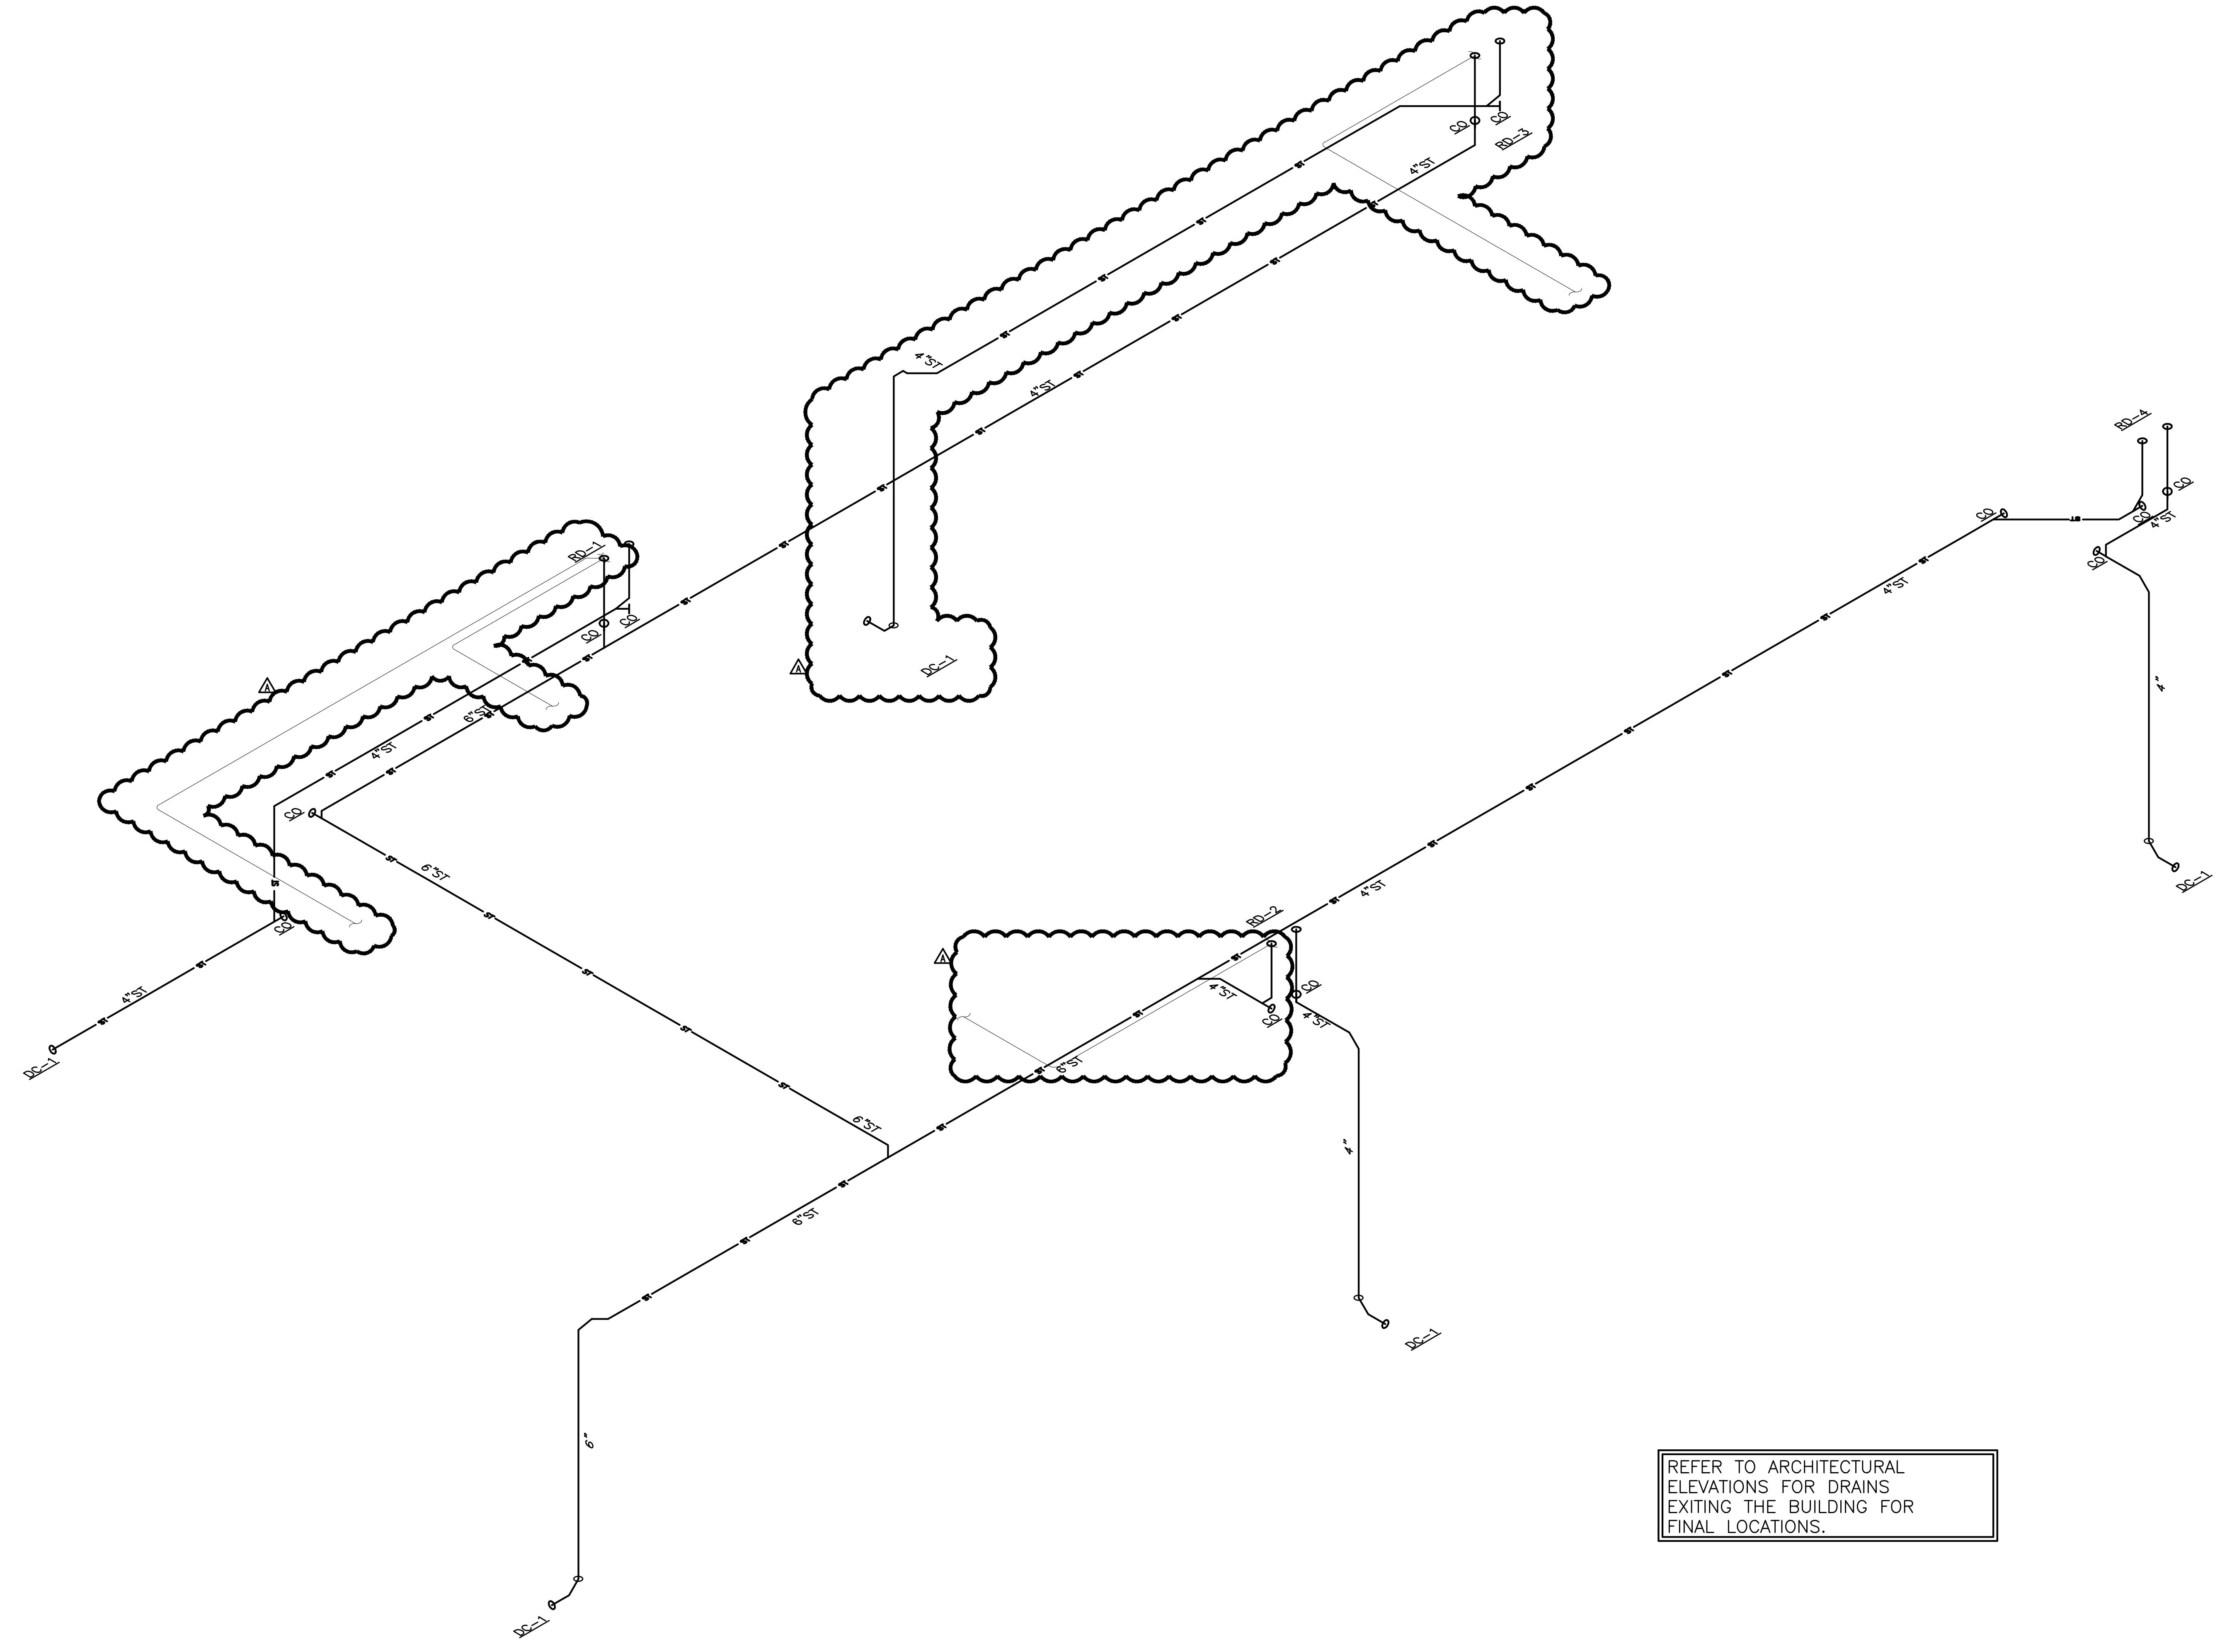


REFER TO ARCHITECTURAL
ELEVATIONS FOR DRAINS
EXITING THE BUILDING FOR
FINAL LOCATIONS.

1 STORM PIPING ISOMETRIC
P2.2 NO SCALE

2019 STANDARD BUILDING — BB20		STD ISSUE DATE 2019_11	REVIEWED BY WLW
4597F10—WOOD/WOOD		DATE ISSUED 01-23-20	
DESCRIPTION	WOOD BEARING WALLS W/FIBER CEMENT SIDING & Ci WOOD ROOF TRUSS FRAMING FIBER CEMENT PANEL/BATTEN/ALPOLIC PANEL/BRICK EXT. FINISH		
SITE ID	SITE ADDRESS		
015-0071	605 SOUTH 7TH STREET	KANSAS CITY	KS
015-0071.00.A			

P2.2
STORM ISOMETRIC


The logo for McDonald's USA, LLC. It features a stylized 'M' icon composed of three horizontal bars of increasing length from left to right. To the right of the icon, the text "McDonald's USA, LLC" is written in a bold, sans-serif font. A registered trademark symbol (®) is located at the bottom right of the 'LLC' text.

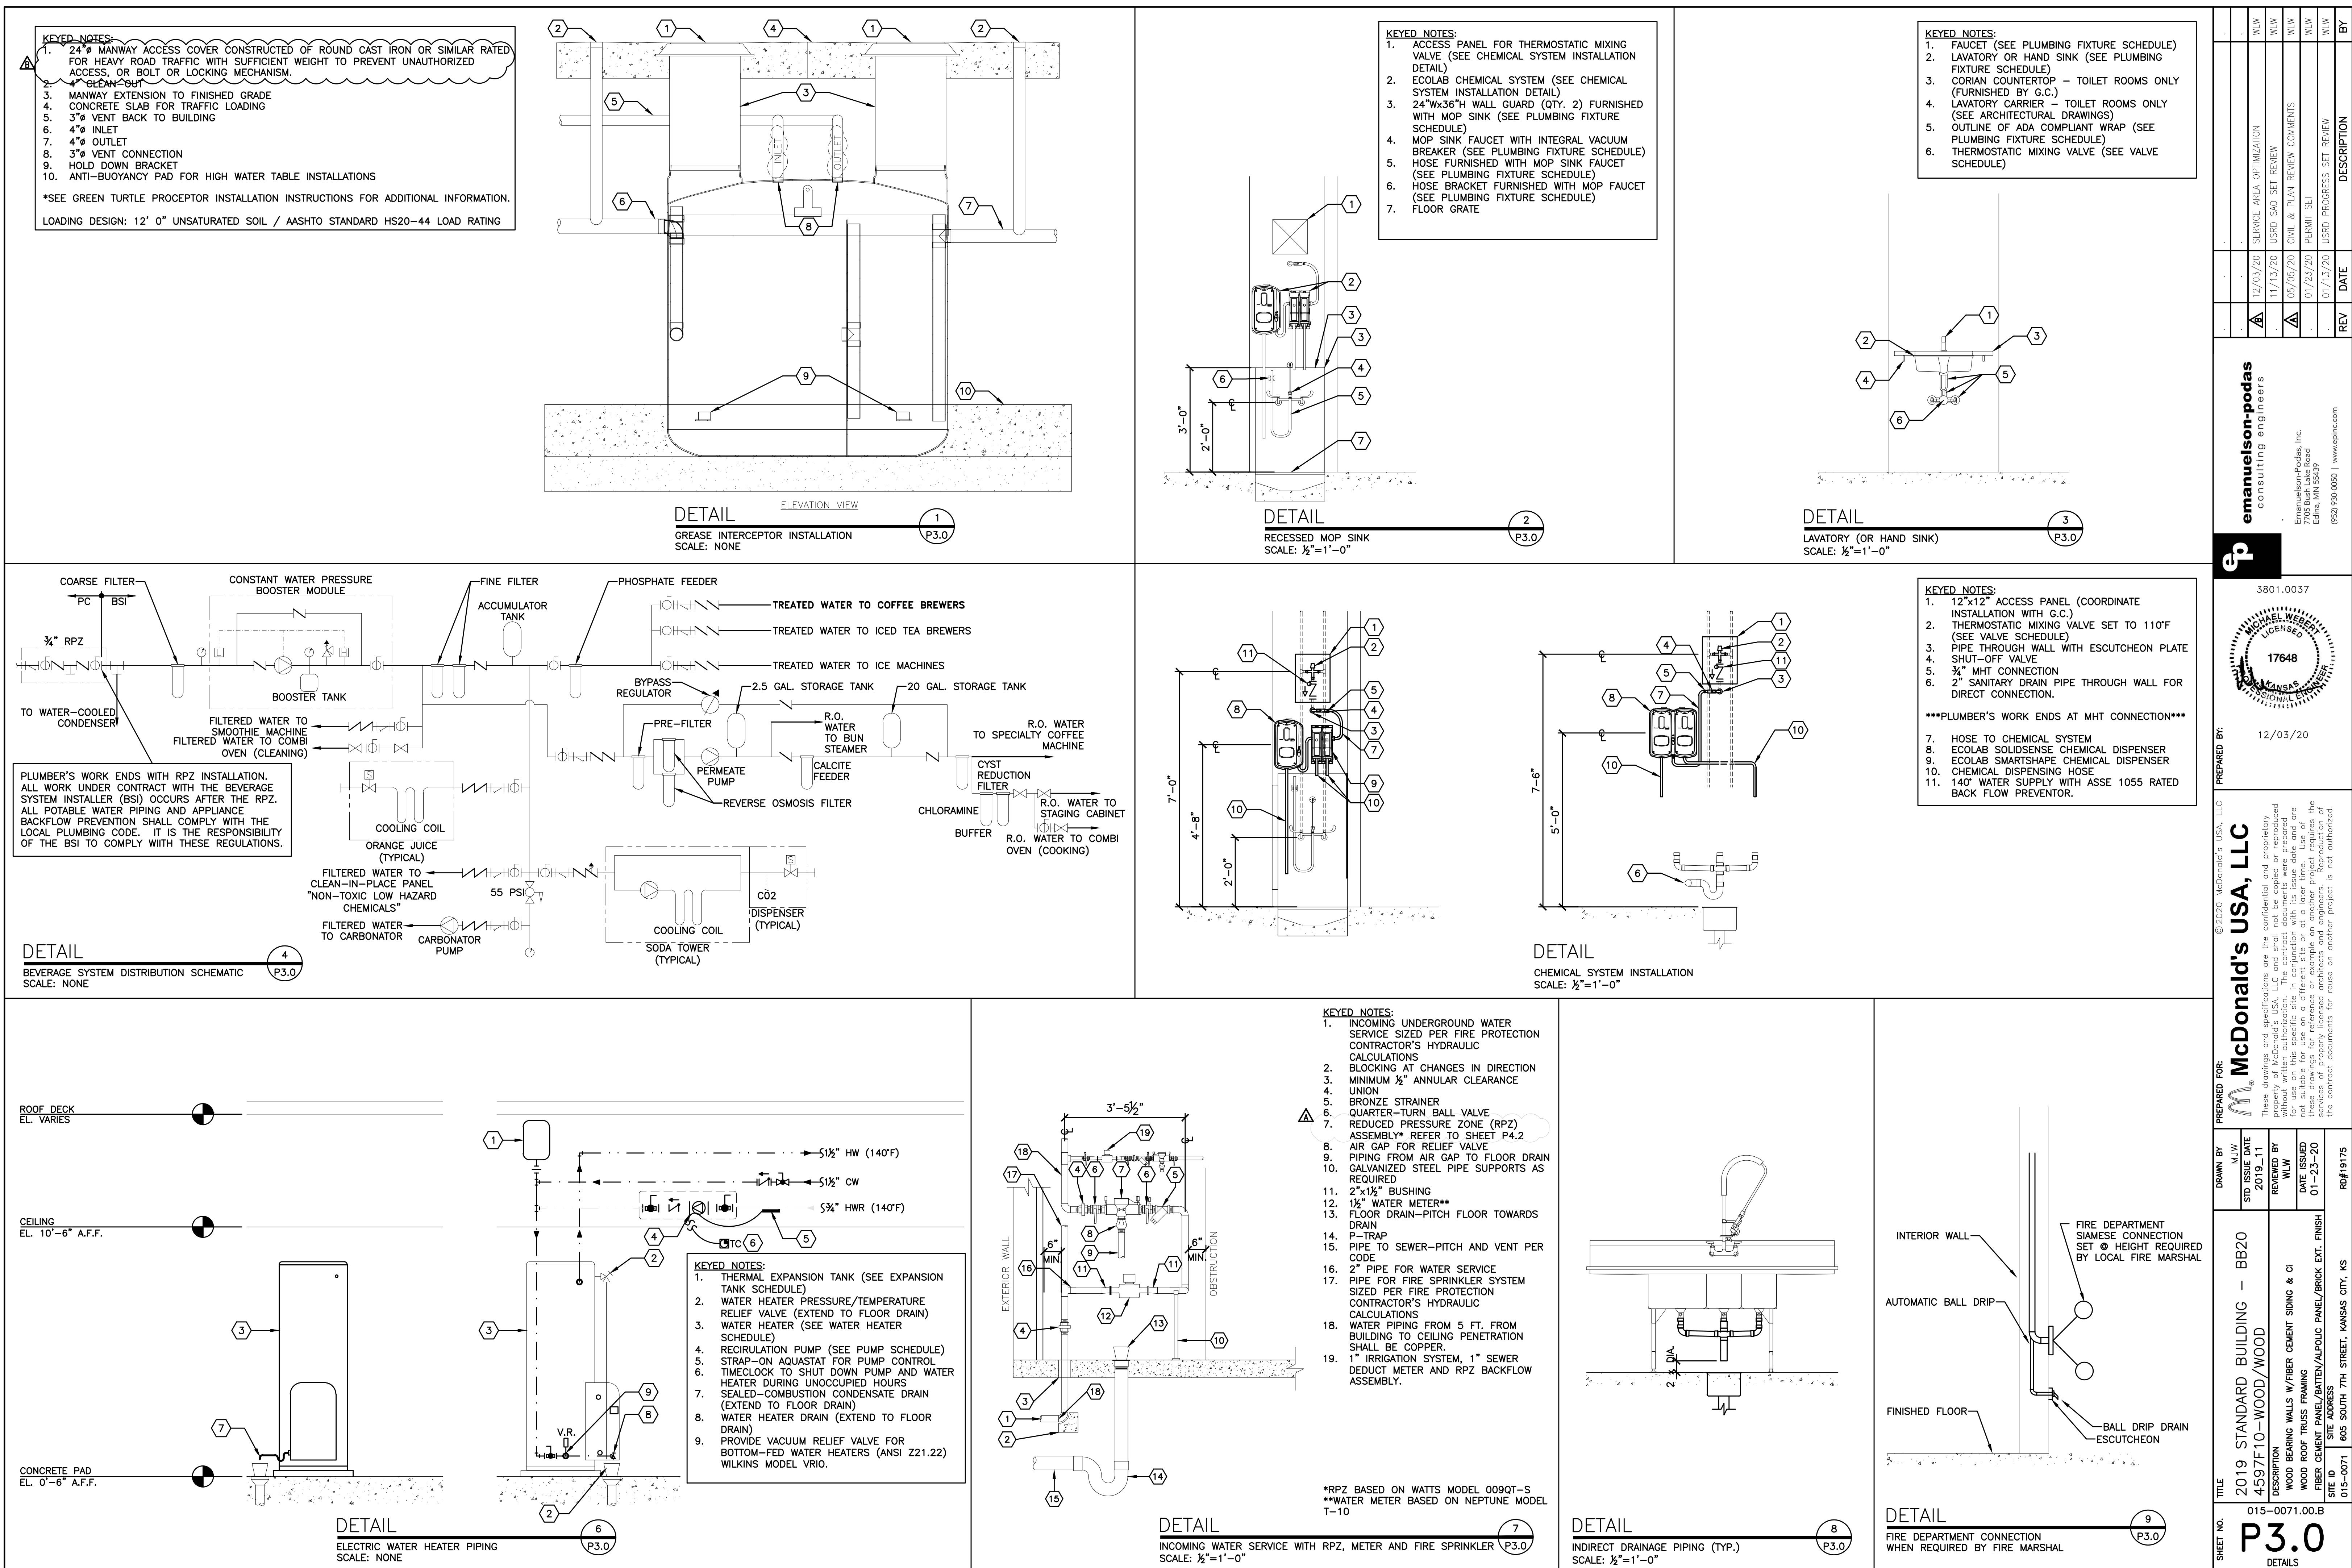

GENERAL PLUMBING NOTES		Grease Interceptor Sizing (MPC) DFU INTERCEPTOR VOLUME (GAL) 8 500 21 750 35 1000 90 1250 172 1500 216 2000 REQUIRED SIZE SIZE INSTALLED 1250 1500	LEGEND		ABBREVIATIONS																		
GENERAL:			— — — — —	COLD WATER PIPING	ACM	AREA CONSTRUCTION MANAGER																	
1. ALL WORK PERFORMED SHALL BE IN ACCORDANCE WITH ALL LOCAL CODES AND ACCEPTABLE TO THE AUTHORITY HAVING JURISDICTION.			— — — — —	TEMPERED WATER PIPING (110°F)	AVB	ATMOSPHERIC VACUUM BREAKER																	
2. ALL PLUMBING WORK SHALL BE PERFORMED BY A LICENSED PLUMBER.			— — — — —	HOT WATER PIPING (140°F)	BSI	BEVERAGE SYSTEM INSTALLER																	
3. ALL DIMENSIONS, CLEARANCES AND TOLERANCES SHALL BE VERIFIED PRIOR TO INSTALLATION. ALL ROUGH-IN LOCATIONS SHALL BE COORDINATED WITH THE MANUFACTURER'S SUBMITTAL INFORMATION.				RECIRCULATED HOT WATER PIPING	CO	CLEAN-OUT																	
4. ALL DIMENSIONAL INFORMATION IS AS FOLLOWS (UNLESS NOTED OTHERWISE): A. UNDERGROUND PIPE IS TO FOUNDATION B. OVERHEAD PIPE IS TO FINISHED WALL C. ELEVATIONS ARE TO FINISHED FLOOR				OVERHEAD LINES (BY P.C.)	DC	DOWNSPOUT COVER																	
5. ALL MATERIALS, FIXTURES AND EQUIPMENT USED SHALL BE IN ACCORDANCE WITH McDONALD'S SPECIFICATIONS. SPECIFICATIONS ARE CONTAINED WITHIN THESE DRAWINGS AND THE McDONALD'S PROJECT MANUAL. ANY CONTRACTOR IN NEED OF A COPY OF THE McDONALD'S PROJECT MANUAL SHALL CONTACT THE McDONALD'S AREA CONSTRUCTION MANAGER. ANY VARIANCE FROM THE McDONALD'S SPECIFICATIONS SHALL BE REVIEWED AND APPROVED BY THE ENGINEER-OF-RECORD.				— SAN — — — UNDERGROUND SANITARY PIPING	DFU	DRAINAGE FIXTURE UNIT(S)																	
6. SEE COORDINATION SCHEDULE FOR ADDITIONAL SCOPE OF WORK.				— GW — — — UNDERGROUND GREASE WASTE PIPING	EC	ELECTRICAL CONTRACTOR																	
7. ALL EQUIPMENT SHALL BE INSTALLED IN ACCORDANCE WITH ITS LISTING AND/OR THE MANUFACTURER'S INSTALLATION INSTRUCTIONS.				— — — — — VENT PIPING	FAC	FIRE ALARM CONTRACTOR																	
8. WHERE POOR SOIL CONDITIONS EXIST OR WHERE SUBSTANTIAL SETTLEMENT OF EITHER THE PIPING, THE BUILDING OR ADJACENT WALKS, PLANTERS, ETC., MAY OCCUR, THE CONTRACTOR SHALL PROVIDE ADEQUATE UNDERSLAB STAINLESS STEEL PIPE HANGERS OR APPROVED OTHER SUPPORT.			— ST — — — ABOVE GROUND STORM PIPING	FCO	FLOOR CLEAN-OUT																		
9. ALL PIPE SLEEVES SHALL BE PROPERLY SEALED AND INSULATED TO PREVENT HEAT LOSS AND SEEPAGE.		— — ST — — — UNDERGROUND STORM PIPING	FD	FLOOR DRAIN																			
10. ALL PIPE INSULATION SHALL BE PROTECTED FROM DAMAGE FROM PIPE HANGERS. PROTECTION SHALL BE LIGHT GAUGE GALVANIZED STEEL OR EQUAL.		⊕	HOSE BIBB	FPC	FIRE PROTECTION CONTRACTOR																		
11. ALL PENETRATIONS OF FIRE-RATED WALLS SHALL BE FIRESTOPPED WITH AN APPROVED AND LISTED FIRESTOPPING SYSTEM.		Z → OR Z ←	CHECK VALVE	FS	FLOOR SINK																		
SANITARY AND VENT SYSTEMS:		⊕	BALL VALVE	GC	GENERAL CONTRACTOR																		
1. THE BUILDING SANITARY PIPE SHALL BE LOCATED A MINIMUM OF 5 FT. FROM THE INCOMING WATER SERVICE, WHERE A 5 FT. SEPARATION IS NOT POSSIBLE, THE BOTTOM OF THE WATER SERVICE PIPE SHALL BE A MINIMUM OF 12 IN. ABOVE THE TOP OF THE HIGHEST POINT OF THE SANITARY PIPE.		⊗	THERMOSTATIC MIXING VALVE	GI	GREASE INTERCEPTOR																		
2. ALL SANITARY AND VENT PIPE SHALL BE PVC TYPE DWV, ABS OR PROTECTO 401 LINED CAST-IRON WHERE REQUIRED BY CODE.		□	FLOOR DRAIN	GPF	GALLONS PER FLUSH																		
3. ALL HORIZONTAL SANITARY PIPE SHALL BE INSTALLED WITH A MINIMUM PITCH OF $\frac{1}{4}$ " PER FOOT, OR IF THE (AHU) ALLOWS AS FOLLOWS:		□	CLEAN-OUT (FLOOR OR YARD)	GPM	GALLONS PER MINUTE																		
<table border="1"> <thead> <tr> <th>PIPE SIZE</th> <th>MIN. SLOPE</th> </tr> </thead> <tbody> <tr> <td>2$\frac{1}{2}$" OR LESS</td> <td>$\frac{1}{8}$" PER FT.</td> </tr> <tr> <td>3" TO 6"</td> <td>$\frac{1}{6}$" PER FT.</td> </tr> <tr> <td>8" OR LARGER</td> <td>$\frac{1}{16}$" PER FT.</td> </tr> </tbody> </table>		PIPE SIZE	MIN. SLOPE	2 $\frac{1}{2}$ " OR LESS	$\frac{1}{8}$ " PER FT.	3" TO 6"	$\frac{1}{6}$ " PER FT.	8" OR LARGER	$\frac{1}{16}$ " PER FT.	□	FLOOR SINK	GW	GREASE WASTE										
PIPE SIZE	MIN. SLOPE																						
2 $\frac{1}{2}$ " OR LESS	$\frac{1}{8}$ " PER FT.																						
3" TO 6"	$\frac{1}{6}$ " PER FT.																						
8" OR LARGER	$\frac{1}{16}$ " PER FT.																						
4. CLEANOUTS SHALL BE INSTALLED IN ALL HORIZONTAL DRAINAGE PIPE AND SHALL BE LOCATED NOT MORE THAN 100 FT. APART.		○	PRESSURE GUAGE	HS	HAND SINK																		
5. CLEANOUTS SHALL BE INSTALLED AT ALL CHANGES OF DIRECTION GREATER THAN 45 DEGREES. WHERE MORE THAN ONE CHANGE OF DIRECTION OCCURS IN A SINGLE PIPE RUN, ONLY ONE (1) CLEANOUT SHALL BE REQUIRED FOR EVERY 40 FEET OF DEVELOPED LENGTH.		□	LOW PRESSURE SWITCH	I.P.S.	IRON PIPE SIZE (ALSO NPS)																		
6. CLEANOUTS SHALL BE INSTALLED ON PIPES PRIOR TO ANY SLAB PENETRATION.		□	HIGH PRESSURE SWITCH	KEI	KITCHEN EQUIPMENT INSTALLER																		
7. WHERE PIPING IS LOCATED WITHIN WALL CAVITIES, ACCESS TO THE CLEANOUTS SHALL BE PROVIDED.		⊗	SOLENOID VALVE	KES	KITCHEN EQUIPMENT SUPPLIER																		
8. CLEANOUTS ON 6-IN. AND SMALLER PIPES SHALL BE PROVIDED WITH A CLEARANCE OF NOT LESS THAN 18 IN. CLEANOUTS ON 8-IN. AND LARGER PIPE SHALL BE PROVIDED WITH A CLEARANCE OF NOT LESS THAN 36 IN.		⊗	THREE-WAY VALVE	LAV	LAVATORY																		
9. ALL SUSPENDED SANITARY AND VENT PIPE SHALL BE SUPPORTED AS FOLLOWS:		○	PRESSURE REGULATOR	MC	MECHANICAL CONTRACTOR																		
<table border="1"> <thead> <tr> <th>MATERIAL</th> <th>MAX. HORIZ. SPACING</th> <th>MAX. VERT. SPACING</th> </tr> </thead> <tbody> <tr> <td>COPPER PIPE</td> <td>12 FT.</td> <td>10 FT.</td> </tr> <tr> <td>COPPER TUBING $\leq \frac{1}{2}$"</td> <td>6 FT.</td> <td>10 FT.</td> </tr> <tr> <td>COPPER TUBING $> \frac{1}{2}$"</td> <td>10 FT.</td> <td>10 FT.</td> </tr> <tr> <td>CPVC $\leq 1"$</td> <td>3 FT.</td> <td>10 FT.</td> </tr> <tr> <td>CPVC $\geq 1\frac{1}{2}"$</td> <td>4 FT.</td> <td>10 FT.</td> </tr> </tbody> </table>		MATERIAL	MAX. HORIZ. SPACING	MAX. VERT. SPACING	COPPER PIPE	12 FT.	10 FT.	COPPER TUBING $\leq \frac{1}{2}$ "	6 FT.	10 FT.	COPPER TUBING $> \frac{1}{2}$ "	10 FT.	10 FT.	CPVC $\leq 1"$	3 FT.	10 FT.	CPVC $\geq 1\frac{1}{2}"$	4 FT.	10 FT.	○	DUAL CHECK VALVE OR RPZ	MHT	MALE HOSE THREADS
MATERIAL	MAX. HORIZ. SPACING	MAX. VERT. SPACING																					
COPPER PIPE	12 FT.	10 FT.																					
COPPER TUBING $\leq \frac{1}{2}$ "	6 FT.	10 FT.																					
COPPER TUBING $> \frac{1}{2}$ "	10 FT.	10 FT.																					
CPVC $\leq 1"$	3 FT.	10 FT.																					
CPVC $\geq 1\frac{1}{2}"$	4 FT.	10 FT.																					
10. ALL PLUMBING FIXTURES SHALL BE VENTED AND THE MAXIMUM DISTANCE FROM THE FIXTURE TRAP TO THE VENT SHALL BE AS FOLLOWS:		○	DUAL CHECK VALVE WITH ATMOSPHERIC VENT	MS	MOP SINK																		
<table border="1"> <thead> <tr> <th>TRAP SIZE</th> <th>SLOPE</th> <th>DISTANCE</th> </tr> </thead> <tbody> <tr> <td>1$\frac{1}{2}$"</td> <td>$\frac{1}{8}$" PER FT.</td> <td>2'-6"</td> </tr> <tr> <td>2$\frac{1}{2}$"</td> <td>$\frac{1}{8}$" PER FT.</td> <td>3'-6"</td> </tr> <tr> <td>3"</td> <td>$\frac{1}{8}$" PER FT.</td> <td>5'-0"</td> </tr> <tr> <td>4" & LARGER</td> <td>$\frac{1}{8}$" PER FT.</td> <td>6'-0"</td> </tr> <tr> <td></td> <td></td> <td>10'-0"</td> </tr> </tbody> </table>		TRAP SIZE	SLOPE	DISTANCE	1 $\frac{1}{2}$ "	$\frac{1}{8}$ " PER FT.	2'-6"	2 $\frac{1}{2}$ "	$\frac{1}{8}$ " PER FT.	3'-6"	3"	$\frac{1}{8}$ " PER FT.	5'-0"	4" & LARGER	$\frac{1}{8}$ " PER FT.	6'-0"			10'-0"	○	STRAINER	NPS	NATIONAL PIPE THREAD STANDARD
TRAP SIZE	SLOPE	DISTANCE																					
1 $\frac{1}{2}$ "	$\frac{1}{8}$ " PER FT.	2'-6"																					
2 $\frac{1}{2}$ "	$\frac{1}{8}$ " PER FT.	3'-6"																					
3"	$\frac{1}{8}$ " PER FT.	5'-0"																					
4" & LARGER	$\frac{1}{8}$ " PER FT.	6'-0"																					
		10'-0"																					
11. ALL PLUMBING VENTS THROUGH THE ROOF SHALL TERMINATE A MINIMUM OF 12 INCHES ABOVE THE ROOF, AND SHALL BE LOCATED A MINIMUM OF 8 FT. FROM ANY PARAPET WALL. WHERE A VENT TERMINATES WITHIN 8 FT. OF A PARAPET WALL, THE VENT SHALL TERMINATE A MINIMUM OF 6 INCHES ABOVE THE PARAPET.		○	RELIEF VENT	NPT	NATIONAL PIPE THREAD TAPERED																		
12. ALL PLUMBING VENTS SHALL TERMINATE A MINIMUM OF 10 FT. HORIZONTALLY FROM ANY OUTDOOR AIR INTAKE. WHERE A PLUMBING VENT IS LOCATED WITHIN 10 FT. OF AN INTAKE, THE VENT SHALL TERMINATE A MINIMUM OF 3 FT. ABOVE THE INTAKE.		○	FULL-PORT BALL VALVE	O/O	OWNER/OPERATOR																		
13. ALL SIDE WALL VENT TERMINATIONS SHALL BE PROTECTED TO PREVENT BIRDS OR RODENTS FROM ENTERING OR BLOCKING THE VENT OPENING.		○	PUMP	OH	OVERHEAD																		
14. ALL FLOOR DRAINS THAT DO NOT SERVE EQUIPMENT SHALL BE PROTECTED AGAINST DRYING OUT EITHER THROUGH THE INSTALLATION OF A TRAP PRIMER, DEEP SEAL TRAP OR PROSTET TRAP GUARD. TRAP GUARD NOT ALLOWED IN KITCHEN AREA		○	BACK FLOW PREVENTER	P	PUMP																		
15. ALL APPLIANCES SHALL DRAIN TO AN APPROVED SANITARY WASTE RECEPTOR (FLOOR SINK OR FLOOR DRAIN WITH FUNNEL). INDIRECT DRAINAGE FROM AN APPLIANCE SHALL MAINTAIN AN AIR GAP BETWEEN THE PIPE OUTLET AND THE TOP OF THE RECEPTOR. THE MINIMUM DISTANCE BETWEEN THE PIPE OUTLET AND THE TOP OF THE RECEPTOR SHALL BE TWICE THE DIAMETER OF THE APPLIANCE DRAIN PIPE.		○	PLUMBING CONTRACTOR	PC	PLUMBING CONTRACTOR																		
16. THE PVC PLASTIC PIPING TO BE INSTALLED MUST COMPLY WITH ONE OF THE FOLLOWING ASTM STANDARDS: D2665, OR F891. THE INSTALLATION MUST COMPLY WITH ASTM STANDARD D2321		○	REFRIGERATION CONTRACTOR	RC	REFRIGERATION CONTRACTOR																		
17. ALL PLASTIC PIPE USED FOR DRAIN, WASTE, AND VENT SYSTEM (ABS, PVC) SHALL COMPLY WITH ASTM D2661 OR F268 (ABS) AND D2665, D2649 OR F891 (PVC). ABOVE GRADE HORIZONTAL RUNS OF PLASTIC WASTE AND VENT PIPE CAN NOT EXCEED 35 FEET IN TOTAL LENGTH, AND ABOVE GRADE VERTICAL STACKS CONSTRUCTED OF PLASTIC PIPE MAY EXCEED 35 FEET IN TOTAL HEIGHT ONLY IF AN APPROVED EXPANSION JOINT IS USED. SOLVENT WELD JOINTS IN PVC AND CPVC PIPE MUST INCLUDE USE OF PRIMER WHICH IS OF CONTRASTING COLOR TO THE PIPE AND CEMENT.		○	REDUCED PRESSURE PRINCIPLE BACKFLOW PREVENTER	RPZ	REDUCED PRESSURE PRINCIPLE BACKFLOW PREVENTER																		
18. CAST IRON PIPE USED FOR ABOVE GROUND WASTE SYSTEMS MUST MEET ANSI STANDARD A21.2, A21.6, A21.8, A40.5, OR ASTM STANDARD A-74.		○	SANITARY SEWER	SAN	SANITARY SEWER																		
		○	STORM SEWER	ST	STORM SEWER																		
		○	ANTI-SIPHON, SPILL RESISTANT VACUUM BREAKER	SVB	ANTI-SIPHON, SPILL RESISTANT VACUUM BREAKER																		
		○	TEST AND BALANCE CONTRACTOR	TAB	TEST AND BALANCE CONTRACTOR																		
		○	UNDERGROUND	UG	UNDERGROUND																		
		○	URINAL	UR	URINAL																		
		○	VENT	V	VENT																		
		○	WATER CLOSET	WC	WATER CLOSET																		
		○	WALL CLEAN-OUT	WCO	WALL CLEAN-OUT																		
		○	WATER SUPPLY FIXTURE UNIT(S)	WSFU	WATER SUPPLY FIXTURE UNIT(S)																		
		○	YARD CLEAN-OUT	YCO	YARD CLEAN-OUT																		

emmanuelson-podas
consulting engineers

Emmanuelson-Podas, Inc.
Edison, NJ 07003 | (973) 939-0050 | www.eppinc.com

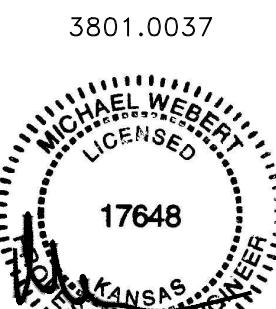

01/23/20

© 2020 McDonald's USA, LLC

These drawings and specifications are the confidential and proprietary property of McDonald's USA, LLC, and shall not be copied or reproduced, in whole or in part, or otherwise disclosed to others, except as specifically authorized in writing by McDonald's USA, LLC, or its authorized agents. These drawings and specifications are for use on this specific project in conjunction with its issuance date. Use of these drawings for reference or example on another project requires the services of properly licensed architects and engineers. Reproduction of these drawings and specifications for reuse on another project is not authorized.

PREPARED FOR:
McDonald's USA, LLC

PREPARED BY:
MICHAEL WEBSTER, P.E.

17648

01/23/20

01/23/20

COORDINATION SCHEDULE				
GENERAL REQUIREMENTS	FURNISH	INSTALL	FINAL CONNECTION	NOTES
MECHANICAL PERMIT	MC			1-3
HOT WORK (WELDING) PERMIT (IF APPLICABLE)	KES			1-3
REFRIGERATION PERMIT (IF APPLICABLE)	MC			1-3
PLUMBING PERMIT	PC			1-3
ELECTRICAL PERMIT	EC			1-3
FIRE SPRINKLER PERMIT (IF APPLICABLE)	FPC			1-3
FIRE ALARM PERMIT (IF APPLICABLE)	FAC			1-3
CONTRACTOR COORDINATION REQUIREMENTS				
HEATING & AIR-CONDITIONING				
ROOFTOP UNITS, INTAKE AND RELIEF	MC	MC		1-5, 17, 22
ROOF CURBS	MC	MC		1-3, 20, 22
GAS PIPING AND GAS PIPE KIT	PC	PC	PC	1-3, 14, 22-23
CONTROLS WIRING	MC	EC	EC	1-3, 19, 22, 24
POWER WIRING	EC	EC	EC	1-3, 19, 22, 24
CONDENSATE TRAP	MC	PC		1-3, 22-23
CONDENSATE PIPING (IF APPLICABLE)	PC	PC		1-3, 22-23
DUCT-MOUNTED SMOKE DETECTOR	MC	MC	EC	1-3, 22, 24
GENERAL EXHAUST SYSTEMS				
EXHAUST FANS	MC	MC		1-3, 17, 22
ROOF CURBS	MC	MC		1-3, 22
CONTROLS (WHERE APPLICABLE)	MC	EC	EC	1-3, 22, 24
POWER WIRING	EC	EC	EC	1-3, 22, 24
TEMPERATURE CONTROLS				
THERMOSTATS & SUBBASES	MC	MC	EC	1-3, 22, 24
REMOTE SENSORS (RH AND/OR TEMPERATURE)	MC	MC	EC	1-3, 22, 24
CONTROLS WIRING (WHERE APPLICABLE)	MC	EC	EC	1-3, 22, 24
POWER WIRING	EC	EC	EC	1-3, 22, 24
DUCTWORK AND ACCESSORIES				
GALVANIZED SHEET METAL DUCTWORK	MC	MC		1-3, 22
EXTERNAL INSULATION	MC	MC		1-3, 22
INTERNAL INSULATION (IF APPLICABLE)	MC	MC		1-3, 22
WEATHERPROOFING (IF APPLICABLE)	MC	MC		1-3, 22
SPIN-IN COLLARS	MC	MC		1-3, 22
FLEXIBLE DUCTWORK	MC	MC		1-3, 22
VOLUME/BALANCING DAMPERS	MC	MC		1-3, 22
FIRE DAMPERS (IF APPLICABLE)	MC	MC		1-3, 22
FIRESTOPPING (IF APPLICABLE)	MC	MC		1-3, 22
AIR DEVICES AND ACCESSORIES	MC	MC	MC	1-3, 7, 22, 28
PLUMBING SYSTEMS				
WATER HEATERS	PC	PC	PC	1-3, 11-12, 23
HOT AND COLD WATER PIPE	PC	PC	PC	1-3, 23
VENTS AND INTAKES	PC	PC	PC	1-3, 23
THERMOSTATIC MIXING VALVE	PC	PC	PC	1-3, 23
POWER AND CONTROL WIRING	EC	EC	EC	1-3, 23-24
KITCHEN EXHAUST SYSTEMS				
MCDONALD'S BACKSHELL EXHAUST HOODS	KES	KEI		1-3, 6, 22, 27
CANOPY EXHAUST HOODS (IF APPLICABLE)	KES	KEI		1-3, 6, 22, 27
BLACK IRON DUCTWORK	KES	KEI		1-3, 6, 22
STAINLESS STEEL DUCTWORK (IF APPLICABLE)	KES	KEI		1-3, 6, 22
ALUMINUM DUCTWORK (IF APPLICABLE)	KES	KEI		1-3, 6, 22
UL LISTED DUCT WRAP	MC	MC		1-3, 6, 22
FIRE-RATED DUCT ENCLOSURE (IF APPLICABLE)	GC	GC		1-3, 6, 20, 22
EXHAUST FANS	MC	MC		1-3, 6, 17, 22
ROOF CURBS	MC	MC		1-3, 6, 20, 22
CURB EXTENSIONS	MC	MC		1-3, 6, 22
CONTROLS (WHERE APPLICABLE)	EC	EC	EC	1-3, 6, 22, 24
POWER WIRING	EC	EC	EC	1-3, 6, 22, 24
FIRE SUPPRESSION SYSTEM	KES	KES	KES	1-3, 16, 22, 27
KITCHEN EQUIPMENT				
COOLER/FREEZER	KES	GC		1-3, 27
EVAPORATOR COILS	KES	MC		1-3, 27
CONDENSATE PIPING	PC	PC	PC	1-3, 23, 27
REMOTE CONDENSING UNIT (MAC)	KES	MC		1-3, 22, 27
ROOF CURBS	MC	MC		1-3, 22
REFRIGERANT PIPING	KES	MC	MC	1-3, 22, 27
POWER WIRING	EC	EC	EC	1-3, 22, 24, 27
CONTROL WIRING	EC	EC	EC	1-3, 24, 27
PIPE PORTALS	MC	MC		1-3, 22
ICE MACHINES	KES	KEI		1-3, 27
WATER SUPPLY PIPING	KES	KEI	BSI	1-3, 27
REMOTE CONDENSING UNITS	KES	MC		1-3, 22, 27
ROOF CURBS	MC	MC		1-3, 22, 27
REFRIGERANT PIPING	KES	MC	MC	1-3, 22, 27
POWER WIRING	EC	EC	EC	1-3, 22, 24, 27
CONTROL WIRING	KES	EC	EC	1-3, 24, 27
PIPE PORTALS	MC	MC		1-3, 22
GRILLS	KES	KES		1-3, 27
GAS PIPING (IF APPLICABLE)	PC	PC	PC	1-3, 23, 27
POWER WIRING	EC	EC	EC	1-3, 24, 27
CONTROL CABLE (6' CLAMSHELL ONLY)	MC	EC	EC	1-3, 23, 24, 27
FRIERS	KES	KES		1-3, 27
GAS PIPING (IF APPLICABLE)	PC	PC	PC	1-3, 23, 27
POWER WIRING	EC	EC	EC	1-3, 24, 27
3-COMPARTMENT SINK	KES	KES		1-3, 12, 27
FAUCETS AND PRE-RINSE SPRAYER	KES	KES		1-3, 27
WATER SUPPLY PIPING	PC	PC	PC	1-3, 23, 27
SANITARY DRAIN PIPING	PC	PC	PC	1-3, 23, 27
HAND SINKS	PC	PC		1-3, 23, 27
FAUCET	PC	PC		1-3, 23, 27
WATER SUPPLY PIPING	PC	PC	PC	1-3, 23, 27
SANITARY DRAIN PIPING	PC	PC	PC	1-3, 23, 27
WASHING MACHINE	KES	KES		1-3, 23, 27
WATER SUPPLY PIPING	PC	PC	PC	1-3, 23, 27
SANITARY DRAIN PIPING	PC	PC	PC	1-3, 23, 27
WARE WASHER	KES	KES		1-3, 23, 27
WATER SUPPLY PIPING	PC	PC	PC	1-3, 23, 27
SANITARY DRAIN PIPING	PC	PC	PC	1-3, 23, 27
MISCELLANEOUS ITEMS				
FIRE SPRINKLER SYSTEMS	FPC	FPC	FPC	1-3, 15, 25
HVAC EQUIPMENT START-UP	MC			1-3, 22
TEST, ADJUST AND BALANCE HVAC SYSTEMS	TAB			1-3, 22
DOOR GRILLES (IF APPLICABLE)	MC	GC		1-3, 20, 22
ROOF/WALL OPENINGS	GC			1-3, 20-24
APPLIANCE BACKFLOW PREVENTION	KES/BSI	PC	PC	1-3, 23, 27
CO2 DETECTION SYSTEM	MC	EC	EC	1-3, 22, 27

PUMP SCHEDULE

TAG	MANUFACTURER	MODEL	HP	V	Ø	Hz	ACCESSORIES
P-1	GRUNDFOS	UP 15-18 B7	1/25	120	1	60	1-3
ACCESORIES:							
1. 1. SEE ELECTRICAL DRAWINGS FOR 2. TIMECLOCK 3. AQUASTAT 4. CHECK VALVE							


WATER HEATER SCHEDULE

TAG	MANUFACTURER	MODEL	SIZE	HEATING	100°F DT	RECOV.	RECOVER						
							GAL.	TYPE	KW	GPH	Volts	Ø	Hz
WH-1	BRADFORD-WHITE	M-11-120A-54-3	119	L	223	208	3	60	150				
	A.O. SMITH	DRE-120-54	119	L	221								
ACCESORIES:													
1. NSF INSTALLATION KIT													

BACKFLOW PREVENTER SCHEDULE

TYPE	MFR.	MODEL	ASSE	LISTING	SERVES	LOCATION
AG FURN.	WITH CHEM. SYS.	1055B	CHEMICAL SYSTEM	DIN, RM, MOP SINK		
AG FURN.	WITH CHEM. SYS.	1055B	CHEMICAL SYSTEM	KITCHEN-MOP SINK		
AVB FURN.	WITH CHEM. SYS.	1001	CHEMICAL SYSTEM	SUPP., RM,-3-COMP		
AVB FURN.	WITH FAUCET	1012	WALL HYDRANT	SEE DRAWINGS		
VB FURN.	WITH HB	1022	YARD HYDRANT	TRASH CORRAL		
DCV FURN.	WITH HB	1052	ROOF HYDRANT	ROOF		
DCV FURN.	WITH HB	1052	SODA TOWERS AND SPEC. COFFEE	INCOPING WATER		
RPZ WILKINS 375KL-SXL-AG	1013	INCOMING WATER	SUPPORT ROOM			
RPZ WILKINS 375KL-AG	1013	FILTRATION SYSTEM	SUPPORT ROOM			
PVB WATTS WA800M4Q1-100	1020	IRRIGATION SYSTEM				

DO NOT SCALE DRAWING
WORK TO DIMENSIONS

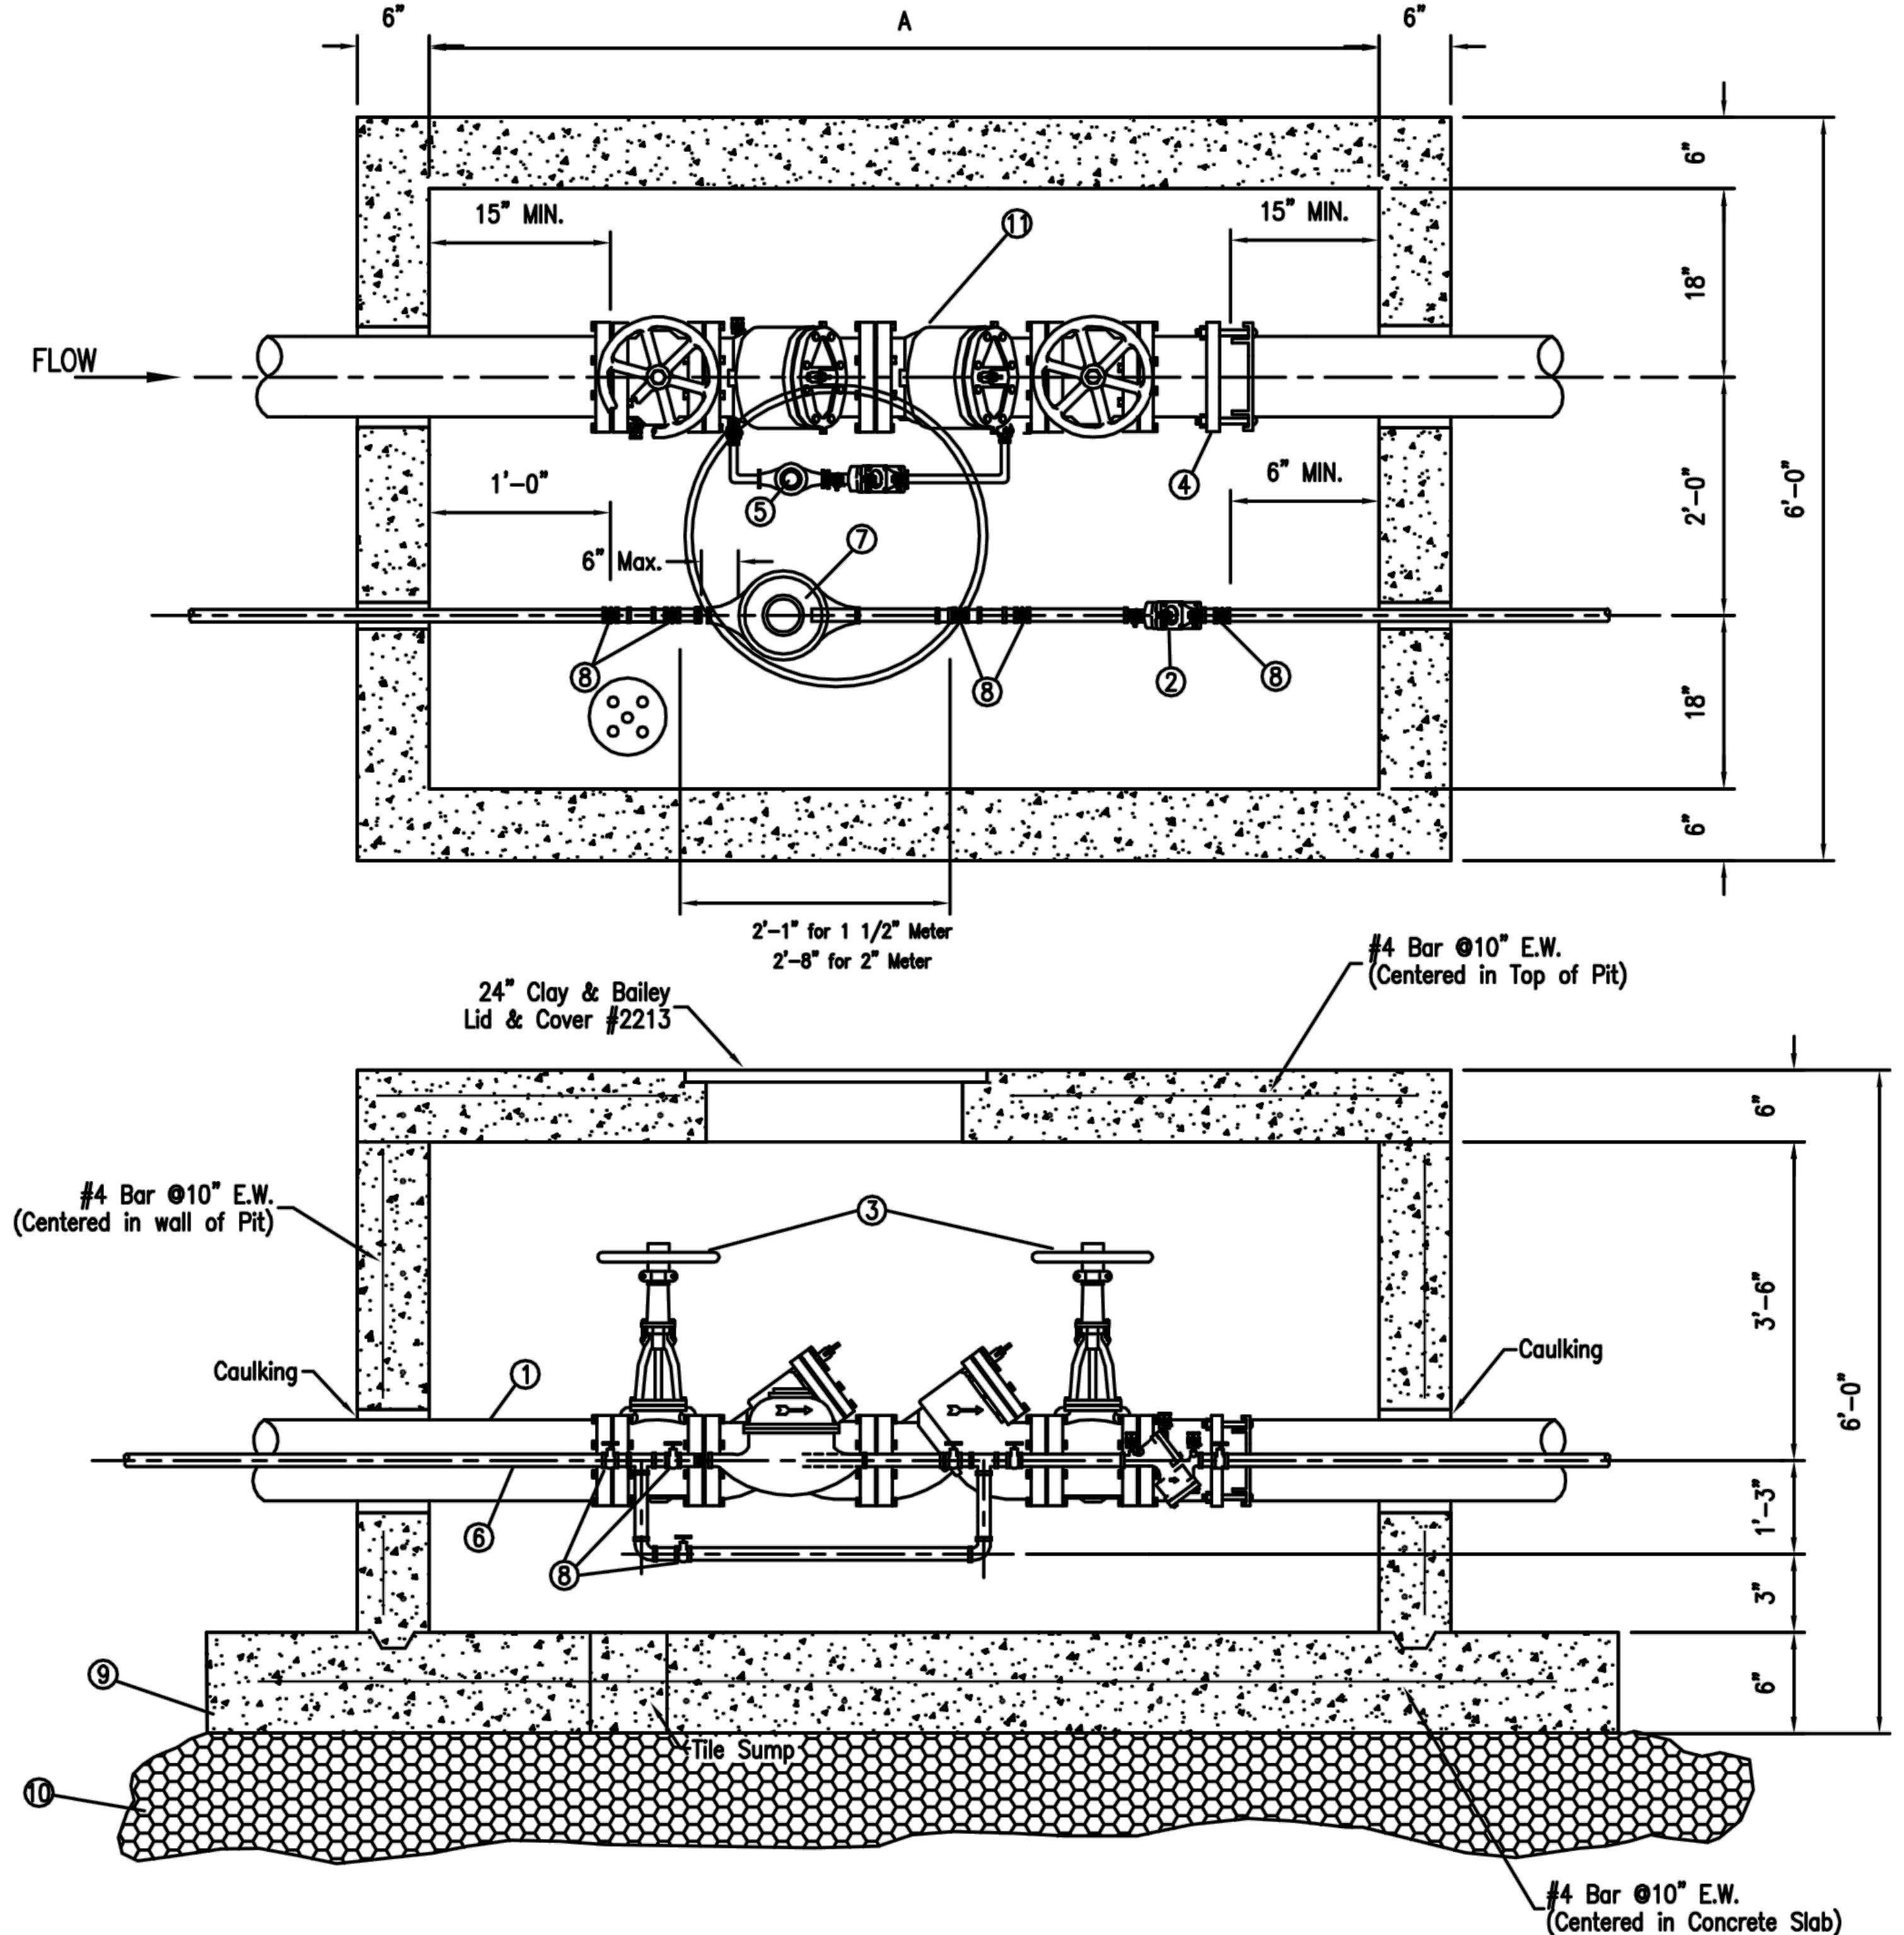

LEGEND

- (1) Pipe Spool (Flanged Ductile Iron Pipe).
- (2) Approved double check valve assembly with 4 test cocks (Fitted with brass plugs).
- (3) O.S.&Y Resilient seated gate valve.
- (4) Rockwell 913 Steel flanged coupling adapter or approved equal.
- (5) 5/8" box water meter, Badger Model #25 with read in cubic feet to meet B.P.U. specifications.
- (6) Brass pipe or rigid copper tubing (sweat).
- (7) Meter installed by B.P.U.
- (8) Wheel gate valve or resilient seated ball valve.
- (9) 10'-6"x 7'-0"x 6" Reinforced concrete slab.
- (10) 12" of 1/2" or 3/4" crushed rock.
- (11) Approved double check detector check valve assembly with 4 test cocks(Fitted with brass plugs)


NOTES

- 1 All backflow prevention assemblies shall be installed horizontally or as approved by BPU.
- 2 Dimension to be determined by unit installed.
- 3 AB-3, CA-5 or gravel will not be allowed as back fill material around water service.

BOARD OF PUBLIC UTILITIES
ENGINEERING & TECHNICAL SERVICES
KANSAS CITY, KANSAS
1 1/2"-2" Meter w/ 3", 4", & 6"
Double Check Detector Check
Valve Assembly

DRAWN	A.A.G.	DATE	4/1/92	ENGR.	APPV.	R.W.
APPV.		DATE		SHEET	9 OF 37	
REV.		DATE		DWG. NO.		
TRACED		DATE				
SCALE	NONE	W.O.				BF-009a

TITLE	DESCRIPTION	REVIEWED BY	DATE	DETAILS
2019 STANDARD BUILDING - BB20	WOOD BEARING WALLS W/ FIBER CEMENT SIDING & CI	WLW	05/05/20	CIVIL & PLAN REVIEW COMMENTS
4597F10-WOOD/WOOD	WOOD ROOF TRUSS FRAMING	WLW	01/23/20	PERMIT SET
	FIBER CEMENT PANEL/BATTEN/ALPOLIC PANEL/BRICK EXT. FINISH	WLW	01/13/20	PROGRESS SET REVIEW
015-0071.00-A	SITE ADDRESS	REV.	DATE	BY
015-0071	SITE ID			

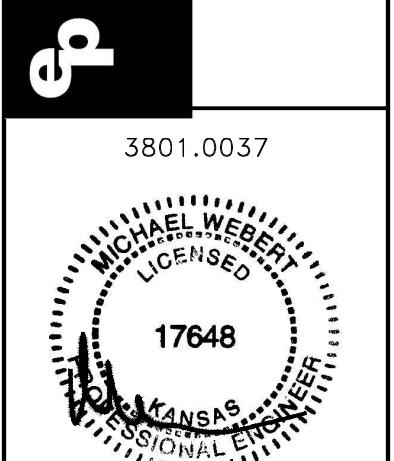


05/05/20

© 2020 McDonald's USA, LLC
McDonald's USA, LLC
PREPARED FOR:
These drawings and specifications are the confidential and proprietary property of McDonald's USA, LLC, and shall not be copied or reproduced for use on this specific site in conjunction with its issuance date and are not suitable for use on a different site or at a later time. Use of these drawings for reference or example on another project requires the services of properly licensed architects and engineers. Reproduction of the contract documents for reuse on another project is not authorized.

SHEET NO.	TITLE	DESCRIPTION	REVIEWED BY	DATE	DETAILS
P4.2	2019 STANDARD BUILDING - BB20	WOOD BEARING WALLS W/ FIBER CEMENT SIDING & CI	WLW	015-0071.00-A	

THE PURPOSE OF THIS SHEET IS TO PROVIDE A CHECKLIST AND VISUAL GUIDE SO THE INSTALLING EC CAN VERIFY THE WORK IS IN COMPLIANCE WITH MCDONALD'S SPECIFICATIONS THAT ARE CRITICAL TO THE PROPER FUNCTIONING OF OUR POINT OF SALE (POS) COMPUTER SYSTEMS.

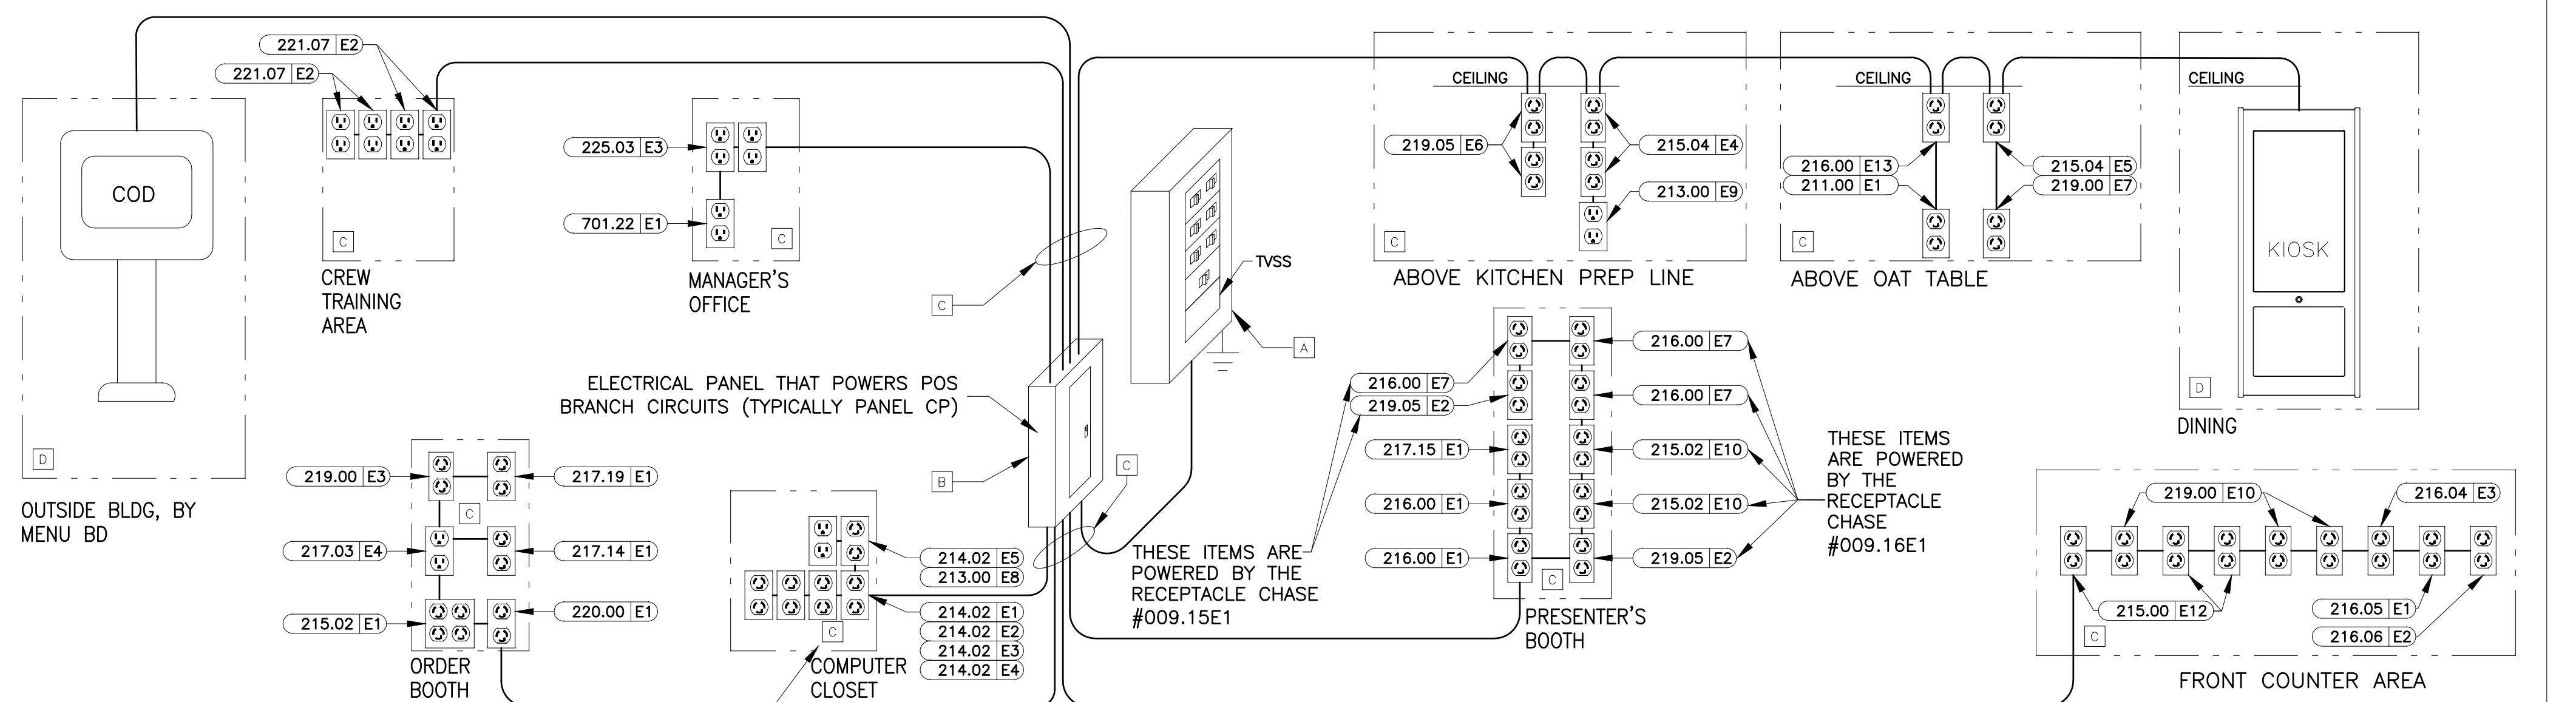

POS ELECTRICAL RISER DIAGRAM

THIS RISER DIAGRAM SHOWS THE ELECTRICAL ROUGH-INS REQUIRED FOR A TYPICAL POINT OF SALE (POS) SYSTEM IN A FREE STANDING 2 BOOTH RESTAURANT. VERIFY ALL POS ROUGH-INS AND MOUNTING HEIGHTS WITH THE ELECTRICAL ROUGH-IN PLAN, NOTES AND INFORMATION DRAWINGS.

LOW VOLTAGE CABLE MANAGEMENT SPECIFICATION

GENERAL/MATERIALS

- THE CC OR EC SHALL FURNISH AND INSTALL A COMPLETE LOW VOLTAGE CABLE MANAGEMENT SYSTEM UTILIZING CADDY-ERICO TYPE CAT-32 J-HOOK SUPPORTS (2-INCH DIAMETER LOOP MINIMUM). ALL J-HOOKS SHALL:
 - HAVE A MINIMUM BEARING SURFACE OF $\frac{1}{8}$ "
 - HAVE FLARED EDGES TO PREVENT DAMAGE TO HIGH PERFORMANCE CABLES,
 - HAVE AN ELECTRO-GALVANIZED FINISH,
 - HAVE 3/8" WIDE CABLE RETAINING STRAPS,
 - BE UL LISTED AND LABELED,
 - BEAR THE UL SYMBOL MARKING ON THE PART FOR IDENTIFICATION
 - BE INSTALLED PER THE MANUFACTURERS INSTALLATION INSTRUCTIONS.
- THE ENTIRE INSTALLATION SHALL BE IN COMPLIANCE WITH THE NATIONAL ELECTRICAL CODE (NEC), NEC SECTION 800, BICSI STANDARDS 568 & 569, ALL APPLICABLE NATIONAL, STATE, LOCAL, AND SAFETY CODES, AND MCDONALD'S SPECIFICATIONS.

INSTALLATION

- LOW VOLTAGE J-HOOK CABLE PATHWAY (FOR POS CABLING SYSTEM) SHALL BE PROVIDED FROM THE MANAGERS OFFICE (OR COMPUTER CLOSET) DATA CONDUIT STUB-UP LOCATION TO THE FOLLOWING DATA CONDUIT STUB-UP LOCATIONS (AS APPLICABLE):
 - FRONT COUNTER,
 - PRESENTERS BOOTH,
 - CASHIERS BOOTH,
 - THIRD DRIVE-THRU WINDOW(IF PRESENT).
 - CREW ROOM,
 - VALENCE WALL,
 - REMOTE ORDERING STATIONS,
 - NETPOF TELEPHONE PANEL LOCATION.
- CABLE SUPPORTS SHALL BE PROVIDED WITHIN 24 INCHES OF THESE STUB-UP LOCATIONS. ALL STUB-UP CONDUITS SHALL BE PROVIDED WITH AN INSULATED BUSHING TO PROTECT CABLES DURING INSTALLATION.
- ALL NON-POS LOW VOLTAGE CABLING SHALL BE INSTALLED IN A SEPARATE CABLE MANAGEMENT SYSTEM INDEPENDENT OF THE LOW-VOLTAGE CABLE MANAGEMENT SYSTEM UTILIZED FOR THE POS CABLING.
- THE POS INSTALLER SHALL BE RESPONSIBLE TO FURNISH AND INSTALL ALL LOW VOLTAGE CABLING REQUIRED FOR THE COMPLETE AND FULLY FUNCTIONAL OPERATION OF THE POS SYSTEM. ALL POS CABLING SHALL BE INSTALLED WITHIN THE LOW-VOLTAGE CABLE MANAGEMENT SYSTEM.

ELECTRICAL POS CERTIFICATION

AS OF THE DATE BELOW, I HEREBY CERTIFY THAT ALL ELECTRICAL WORK, ELECTRICAL SERVICE AND ELECTRICAL SYSTEMS, MATERIALS AND LABOR RELATED TO THE POS ELECTRICAL INSTALLATION IN WHICH THE UNDERSIGNED ARE DIRECTLY OR INDIRECTLY RESPONSIBLE HAVE BEEN PROPERLY INSTALLED IN FULL COMPLIANCE WITH ALL CONSTRUCTION DOCUMENTS AND ALL NFPA BUILDING, ELECTRICAL AND OTHER APPLICABLE CODES, ALONG WITH ALL OF THE REQUIREMENTS OUTLINED ON THIS DRAWING. I FURTHER CERTIFY THAT THE ELECTRIC SERVICE POWERING THE POS SYSTEM HAS BEEN PROPERLY INSTALLED BY A QUALIFIED ELECTRICIAN. SKILLED, KNOWLEDGEABLE AND TRAINED TO INSTALL ALL THE REQUIRED ELECTRICAL DISTRIBUTION COMPONENTS NECESSARY TO POWER THE POINT OF SALE (POS) SYSTEM.

GENERAL CONTRACTOR: _____
BY: _____
DATE: _____

ELECTRICAL CONTRACTOR: _____
BY: _____
DATE: _____

THE EC SHALL COMPLETE THE BELOW CHECKLIST TO VERIFY COMPLIANCE WITH MCDONALD'S SPECIFICATIONS.

IF YOU HAVE ANY QUESTIONS REGARDING THE PLANS, PLEASE CALL THE DESIGNER.
DESIGNER: Wendy Wenborg
PHONE: 952-540-4047
EMAIL: wwenborg@epinc.com

START HERE

A VISUALLY INSPECT THE MAIN ELECTRICAL PANEL (MDP)

YES NO N/A

- IS AN EQUIPMENT GROUND BAR INSTALLED SUCH THAT IT IS ELECTRICALLY CONNECTED TO THE PANEL?
- DO ALL NEUTRAL CONDUCTORS TERMINATE ONLY TO THE NEUTRAL BAR?
- DO ALL EQUIPMENT GROUND CONDUCTORS TERMINATE ONLY TO THE EQUIPMENT GROUND BAR?
- DOES THE ISOLATED GROUND CONDUCTOR (GREEN W/YELLOW STRIPE) TERMINATE ON THE EQUIPMENT GROUND BAR?
- IS THERE AN APPROPRIATE ELECTRICAL CONNECTION (BOND) BETWEEN THE NEUTRAL BAR AND THE EQUIPMENT GROUND BAR?
- DOES THE GROUNDING SYSTEM COMPLY WITH MCDONALD'S "BUILDING ELECTRICAL GROUNDING DETAIL"?
- IS A SURGE PROTECTOR INSTALLED THAT COMPLIES WITH MCDONALD'S "TVSS INSTALLATION GUIDE" OR DETAIL?
- ARE ALL ELECTRICAL CONNECTIONS (WIRING & BUSING) PROPERLY TIGHTENED?
- ARE ALL CIRCUIT BREAKERS CLEARLY LABELED?

B VISUALLY INSPECT THE PANEL "CP" THAT POWERS POS

YES NO N/A

- IS AN EQUIPMENT GROUND BAR INSTALLED SUCH THAT IT IS ELECTRICALLY CONNECTED TO THE PANEL?
- IS AN ISOLATED GROUND BAR INSTALLED SUCH THAT IT IS ELECTRICALLY INSULATED FROM THE PANEL?
- DO ALL NEUTRAL CONDUCTORS TERMINATE ONLY TO THE NEUTRAL BAR?
- DO ALL EQUIPMENT GROUND CONDUCTORS TERMINATE ONLY TO THE EQUIPMENT GROUND BAR?
- DO ALL ISOLATED GROUND CONDUCTORS (GREEN W/YELLOW STRIPE) TERMINATE ONLY TO THE ISOLATED GROUND BAR?
- ARE ALL ELECTRICAL CONNECTIONS (WIRING & BUSING) PROPERLY TIGHTENED?
- ARE ALL POS & COD CIRCUIT BREAKERS ON THE SAME PANEL?
- ARE ALL CIRCUIT BREAKERS CLEARLY LABELED?
- DO ALL POS & COD CIRCUIT BREAKERS HAVE A LOCKING MECHANISM ON THEIR HANDLES TO PREVENT THEM FROM BEING SHUT OFF BY MISTAKE?
- DOES THE FEEDER CIRCUIT FOR THIS SUBPANEL CONTAIN PHASE, NEUTRAL ONE EQUIPMENT GROUND AND ONE ISOLATED GROUND CONDUCTORS THAT ARE PROPERLY TERMINATED (SEE POS & COD ISO GND/DED CKT DETAIL)?

VISUALLY INSPECT ALL REMAINING ELECTRICAL SUBPANELS

YES NO N/A

- IS AN EQUIPMENT GROUND BAR INSTALLED SUCH THAT IT IS ELECTRICALLY CONNECTED TO THE PANEL?
- DO ALL NEUTRAL CONDUCTORS TERMINATE ONLY TO THE NEUTRAL BAR?
- DO ALL EQUIPMENT GROUND CONDUCTORS TERMINATE ONLY TO THE EQUIPMENT GROUND BAR?
- ARE ALL ELECTRICAL CONNECTIONS (WIRING & BUSING) PROPERLY TIGHTENED?
- ARE ALL CIRCUIT BREAKERS CLEARLY LABELED?
- DOES THE FEEDER CIRCUIT FOR THIS SUBPANEL CONTAIN PHASE, NEUTRAL AND ONE EQUIPMENT GROUND CONDUCTORS THAT ARE PROPERLY TERMINATED? (SEE BUILDING ELECTRICAL GROUNDING DETAIL)

REWORK ELECTRICAL SYSTEM TO BRING INTO COMPLIANCE WITH MCDONALD'S SPECIFICATIONS

C VISUALLY INSPECT THE POS BRANCH CIRCUITS

YES NO N/A


- ARE THE POS BRANCH CIRCUITS ROUTED IN THEIR OWN CONDUIT BY THEMSELVES?
- IF THE POS BRANCH CIRCUIT IS ROUTED ABOVE GRADE, IS IT IN A METALLIC CONDUIT?
- DOES EACH POS BRANCH CIRCUIT CONTAIN: ONE PHASE (BLACK COLORED INSULATION) ONE NEUTRAL (WHITE COLORED INSULATION) ONE EQUIPMENT GROUND (GREEN COLORED INSULATION) ONE ISOLATED GROUND (GREEN W/YELLOW STRIPE COLORED INSULATION).
- DO ALL POS BRANCH CIRCUITS TERMINATE AT EITHER AN IG4700, IG4710, IG5261, IG5262 RECEPTACLES OR ANY COMBINATION OF THESE?
- ARE ALL ELECTRICAL TERMINATIONS TO IG RECEPTACLES MADE WITH SOLID #12 AWG WIRE CAPTURED AROUND THE SCREW BARREL AND SUITABLY TIGHTENED?
- ARE ALL BRANCH CIRCUIT CONNECTIONS PROPERLY TIGHTENED?
- ARE THE CORRECT AMOUNT AND TYPE OF IG RECEPTACLES PROVIDED AS SHOWN IN THE ELECTRICAL ROUGH-IN PLAN, NOTES AND INFORMATION?
- DO ALL POS RECEPTACLES HAVE ORANGE "COMPUTER ONLY" COVERPLATES?
- DO ALL POS BRANCH CIRCUITS COMPLY WITH THE "POS & COD ISOLATED GND/DEDICATED CIRCUIT" DETAIL?

D VISUALLY INSPECT THE POS BRANCH CIRCUIT FOR THE COD

YES NO N/A

- ARE THE COD BRANCH CIRCUITS ROUTED IN THEIR OWN CONDUIT BY THEMSELVES?
- DOES EACH COD BRANCH CIRCUIT CONTAIN:
 - ONE PHASE (BLACK COLORED INSULATION),
 - ONE NEUTRAL (WHITE COLORED INSULATION),
 - ONE EQUIPMENT GROUND (GREEN COLORED INSULATION),
 - ONE ISOLATED GROUND (GREEN W/YELLOW STRIPE COLORED INSULATION).
- IS THE COD POWERED FROM THE SAME PANEL AS THE POS?
- DOES THE BREAKER FOR THE COD HAVE A LOCKING MECHANISM ON ITS HANDLE THAT WILL PREVENT IT FROM BEING SHUT OFF?
- DO THE COD BRANCH CIRCUIT(S) COMPLY WITH THE "POS & COD ISOLATED GND/DEDICATED CIRCUIT" DETAIL?
- IF THE COD HAS AN OPTICAL ISOLATOR, IS A STRAIGHT BLADE ISOLATED GROUND RECEPTACLE ON AN ISOLATE GROUND/DEDICATED CIRCUIT PROVIDED FOR IT?

TITLE	DESCRIPTION	DRAWN BY	REVIEWED BY	STD ISSUE DATE	DATE ISSUED	REV. DATE
2019 STANDARD BUILDING - BB20 4597F10-WOOD/WOOD	WOOD BEARING WALLS W/FIBER CEMENT SIDING & CI WOOD ROOF TRUSS FRAMING FIBER CEMENT PANEL/BATTEN/ALPOLIC PANEL/BRICK EXTER. FINISH	MRV	WLW	2019-11	01-23-20	R#1975
F1.0 POS RISER DIAGRAM						
SHEET NO.	015-0071.00.0	SITE ID	SITE ADDRESS			
Emanuelson-podas Consulting Engineers Emmanuelson-Podas, Inc. Edina, MN 55439 (612) 930-0050 www.epinc.com						
PREPARED BY:	MICHAEL WEBER LICENSED 17648 KANSAS CONTRACTOR ENGINEER 01/23/20					

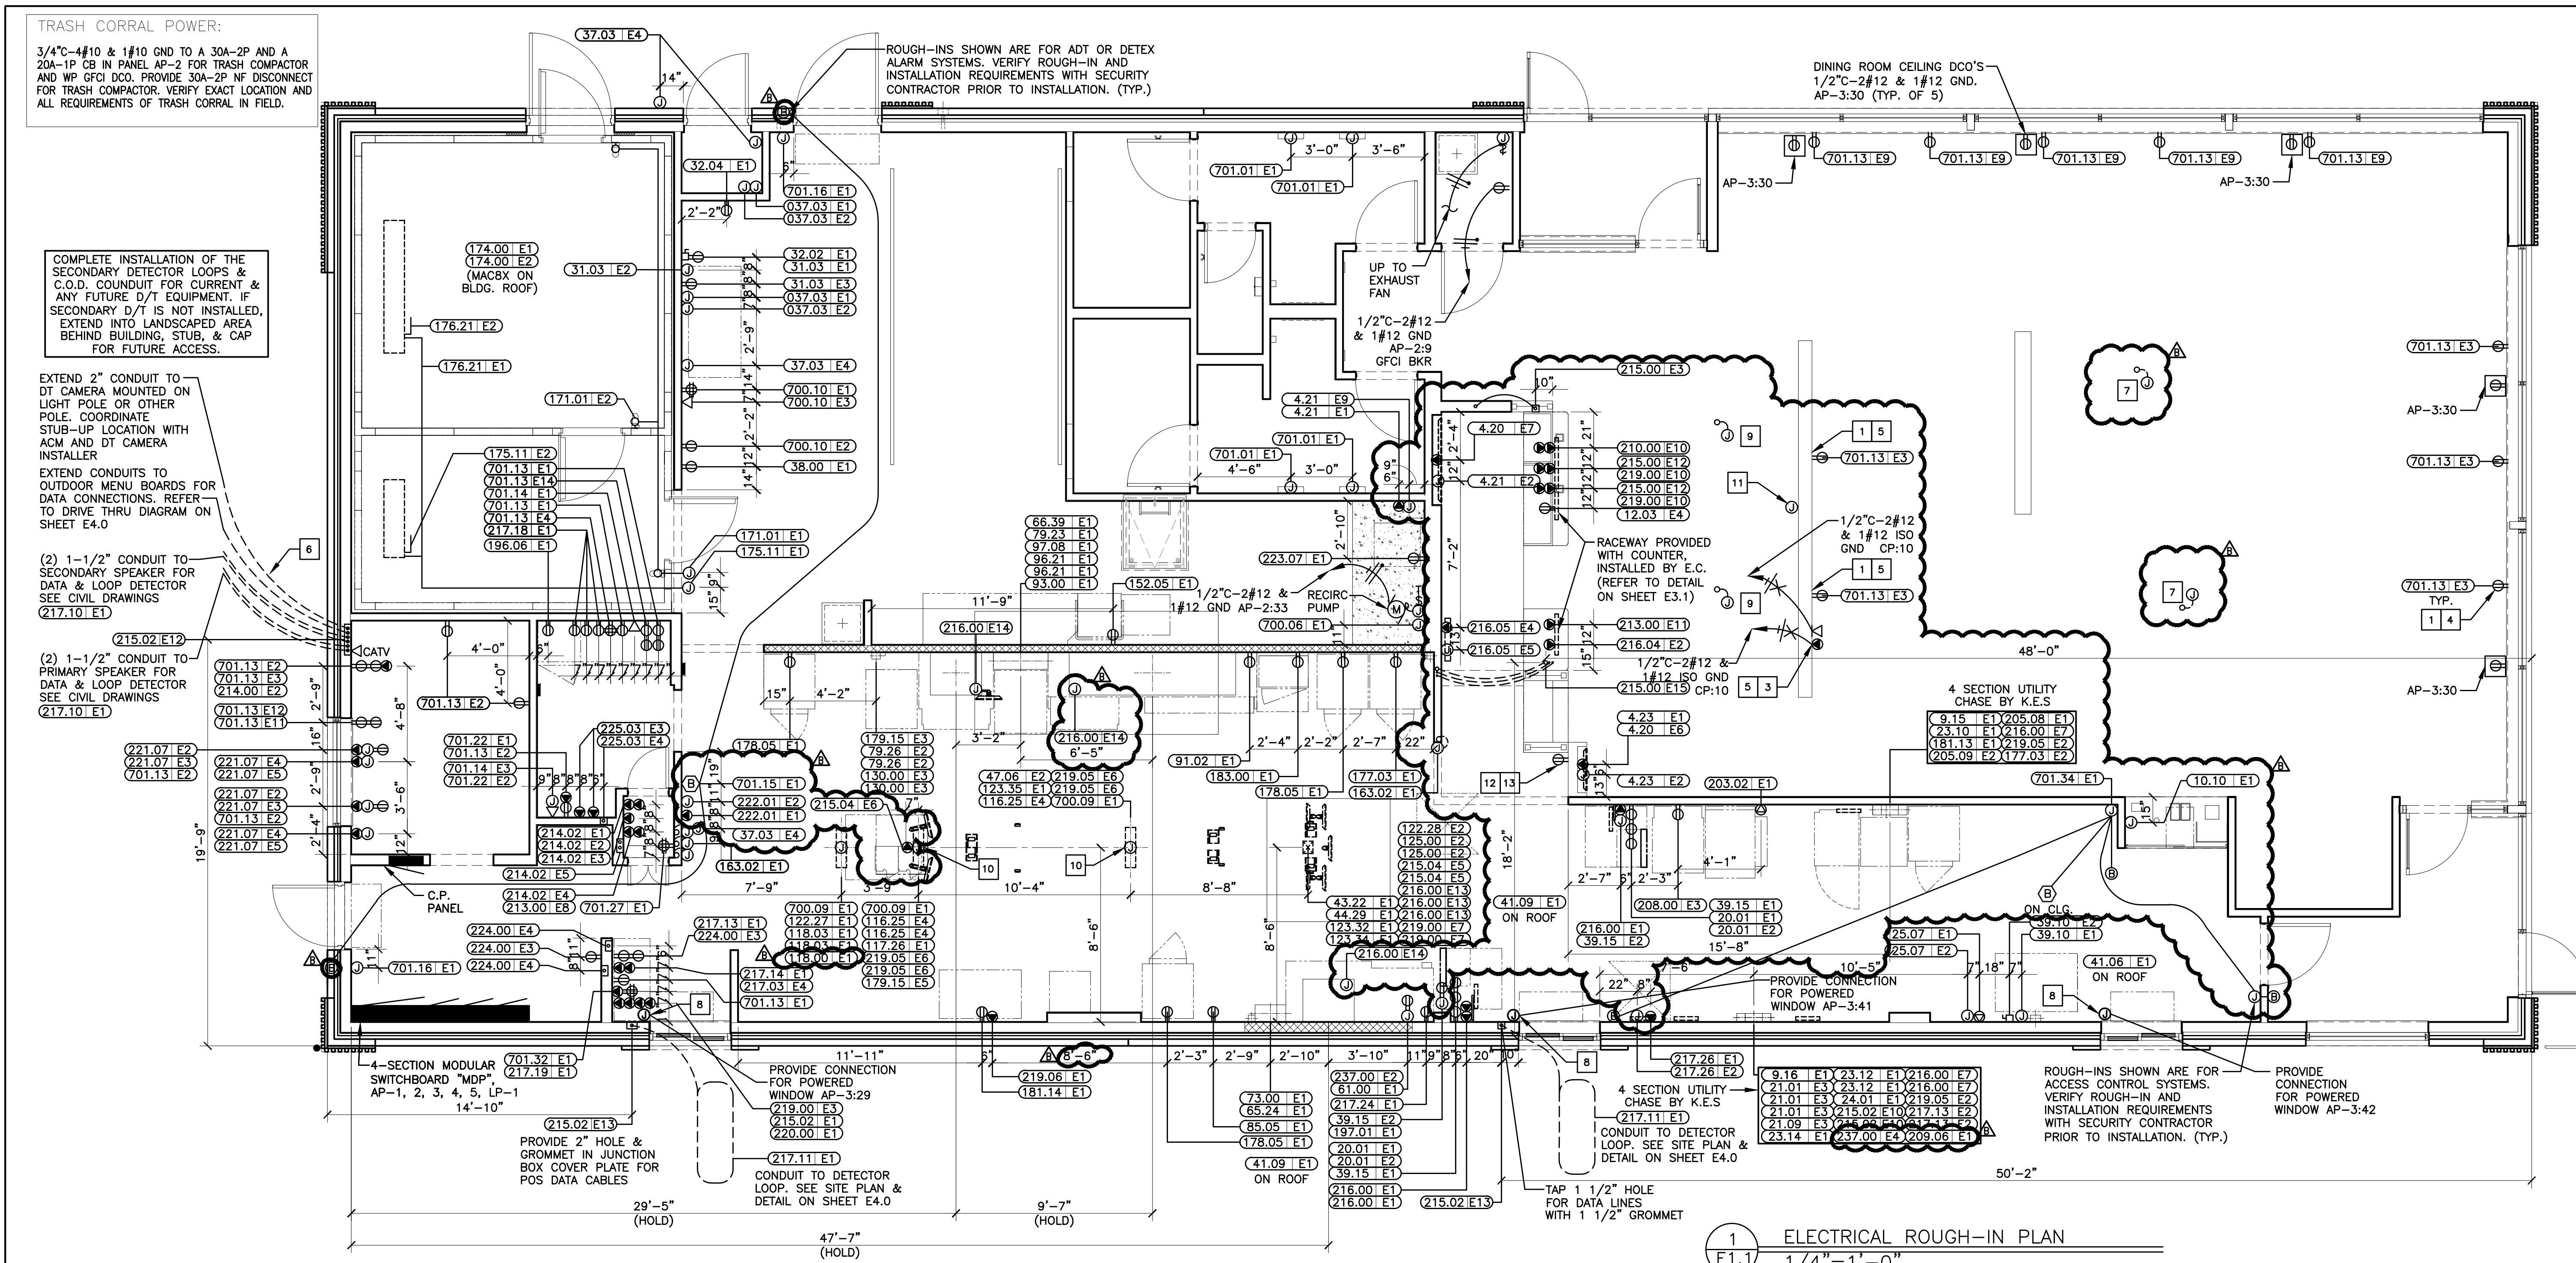

SYMBOLS AND ABBREVIATIONS

SYMBOL	DESCRIPTION	SYMBOL	DESCRIPTION
\$	SINGLE POLE SWITCH, 3W=THREE WAY SWITCH, K=KEYED SWITCHED, VS=VACANCY SENSOR	(B)	BUZZER
\$T	MANUAL SWITCH (T= THERMAL OVERLOADS)	(B)	BUTTON FOR BUZZER
□	TRANSFORMER	(O)	PULLBOX
○	JB WITH DUPLEX CONVENIENCE OUTLET (FLUSH WITH CEILING)	—	PANELBOARD
○	JB WITH SINGLE CONVENIENCE OUTLET	○	CIRCUIT BREAKER
○	JB WITH DUPLEX CONVENIENCE OUTLET	A	AMPERES
○	JB WITH TWO DUPLEX CONVENIENCE OUTLETS	ACM	AREA CONSTRUCTION MANAGER
○	JB WITH SPECIAL PURPOSE OUTLET	AFF	ABOVE FINISHED FLOOR
○	JB WITH ISOLATED GROUND OUTLET (IG) = IG4710, (IG) = IG5261, (IG) = IG4700A, (IG) = IG5262	C	CONDUIT
▲	INTERCOM STATION W/ 3/4" C- TO MAIN STATION	CCT	CIRCUIT
▲	TELEPHONE JACK	EC	ELECTRICAL CONTRACTOR
○	JUNCTION BOX - WALL OR CEILING MOUNTED	GC	GENERAL CONTRACTOR
□	DISCONNECT SWITCH	GFI/GFCI	GROUND FAULT CIRCUIT INTERRUPTER
○	STUB UP THRU ROOF	GND	GROUND
○	THERMOSTAT SENSOR W/ 1/2" C- UP TO CEILING SPACE	IG	ISOLATED GROUND
○	MOTOR CONNECTION	JB	JUNCTION BOX
—	CONDUIT RUN CONCEALED IN CEILING OR WALLS	KES	KITCHEN EQUIPMENT SUPPLIER
—	CONDUIT RUN IN FLOOR SLAB	MLO	MAIN LUGS ONLY
IIx	HOT (SHORT), NEUTRAL (LONG), EQUIP GRD (LONG WITH DOT), & 'X' DENOTES ISOLATED GRD	WP	WEATHERPROOF
○	J-BOX WITH FINAL EQUIPMENT CONNECTION	CO	CARBON MONOXIDE SENSOR
○	CEILING MOUNTED OCCUPANCY SENSOR		

ADT ROUGH-IN NOTES

1. COORDINATE EXACT INSTALLATION REQUIREMENTS WITH ADT PRIOR TO INSTALLATION TEL. 800-417-8238
2. EC SHALL PROVIDE A 2 GANG 3 25/32" X 3 25/32" X 3 1/2" D JUNCTION BOX AT DOOR FOR INSTALLATION OF DOOR ALARM UNIT. STUB 1/2" C ABOVE CEILING FROM JUNCTION BOX. PROVIDE 1/2" C FROM J-BOX TO DOOR MAGNETIC SWITCH LOCATION.
3. EC SHALL PROVIDE 4" X 4" JUNCTION BOX ABOVE CEILING FOR INSTALLATION OF LOW VOLTAGE TRANSFORMER. VERIFY EXACT LOCATION WITH ADT PRIOR TO INSTALLATION. PROVIDE 1/2" C-2#12 TO LOCKOUT TYPE CB IN PANEL LP-1.

GENERAL NOTES

1. SEE SHEET E3.0 FOR PANEL & CIRCUIT BREAKER ASSIGNMENT, VOLT/PH, FLA, BREAKER SIZE, COND/WIRE, RECEPTACLE TYPE, HEIGHT ABOVE FINISHED FLOOR, REQUIREMENTS & REMARKS FOR ALL ELECTRICAL EQUIPMENT.
2. SEE LOW VOLTAGE CABLE MANAGEMENT SPECIFICATION ON SHEET E1.0 FOR POS, DATA, AND SOUND SYSTEM REQUIREMENTS.
3. GC/EC SHALL COORDINATE LOCATION AND ALL REQUIREMENTS OF CT& METER CABINET WITH LOCAL UTILITY COMPANY. CT & METER CABINET SHALL NOT BE INSTALLED ON D/T SIDE OF BUILDING. GC SHALL PAINT TO MATCH BUILDING COLOR.

KEY NOTES

- 1 TAMPER RESISTANT GFCI DUPLEX RECEPTACLE IN PUBLIC AREAS. EC SHALL PROVIDE HUBBELL GFTRST* (*": AL=ALMOND, BK=BLACK, BR=BROWN, GR=GRAY, IV=IVORY, LA=LIGHT ALMOND, RD=RED, WH=WHITE). SPECIFIED RECEPTACLE BECOMES DE-ENERGIZED UPON FAILURE OF GFCI DEVICE. NO SUBSTITUTIONS.(TYPICAL)
- 2 SEE POS ELECTRICAL RISER DIAGRAM ON SHEET E1.0. (TYPICAL)
- 3 SEE NOTE FLAT PANEL TELEVISION NOTE ON SHEET E3.1.

KEY NOTES

- 4 PER THE AMERICAN WITH DISABILITIES ACT ACCESSIBILITY GUIDELINES (ADAAG), A MINIMUM OF ONE (1) ADA COMPLIANT ELECTRICAL RECEPTACLE SHALL BE INSTALLED AT AN ACCESSIBLE TABLE. GC/EC SHALL REFERENCE FINAL DECOR PLANS AND PROVIDE RECEPTACLES AS NECESSARY FOR COMPLIANCE. (TYPICAL)
- 5 COORDINATE LOCATION OF RECEPTACLES SO THAT RECEPTACLES ARE LOCATED ON FULL HEIGHT WALLS PER THE DECOR PLAN. STUB UP AND CIRCUIT IN HALF WALL FOR RECEPTACLES NOT ON FULL HEIGHT WALLS. CONFIRM FINAL LOCATIONS WITH DECOR DRAWINGS PRIOR TO ROUGH-IN.
- 6 IF MOUNTED TO A LIGHTING POLE, DT CAMERA SHALL ONLY BE INSTALLED ON A POLE WITH MAXIMUM OF (2) LIGHTING HEADS. PROVIDE ISOLATION OF DT CAMERA MOUNTING HARDWARE AND POLE TO PREVENT BI-METALLIC OR GALVANIC CORROSION.
- 7 E.C. TO PROVIDE AN ALLOWANCE IN BID TO PROVIDE TWO(2) FLEXIBLE POWER CONNECTIONS FOR POWER TO FURNITURE. FAMILY EXPERIENCE ELEMENTS AS PART OF THE DECOR PACKAGE. E.C. SHALL IDENTIFY EXACT LOCATIONS IN FIELD AND WITH DECOR DRAWINGS. PROVIDE ALL NECESSARY MATERIALS AND SUPPORT FOR A COMPLETE AND FULL NEC CODE COMPLIANT INSTALLATION. ALL COMPONENTS SHALL BE FED FROM A GFCI TYPE CIRCUIT BREAKER AND BRANCH CIRCUIT SHALL CONTAIN TWO PATHS OF GROUNDING (CONDUIT BODY AND AN INSULATED GROUNDING CONDUCTOR) TO COMPLY WITH McDONALD'S GROUNDING STANDARDS.
- 8 DRIVE THRU WINDOW POWER, CONFIRM REQUIREMENTS WITH MANUFACTURER DRAWINGS.
- 9 PROVIDE POWER WITHIN CEILING FOR CONNECTION TO SELF ORDER KIOSKS. COORDINATE EXACT LOCATION OF KIOSKS WITH DECOR DRAWINGS. PROVIDE 2#12, 1#12 GRD., & 1#12 ISOLATED GROUND ON A 20A DEDICATED CIRCUIT FED FROM THE CP PANEL FOR EVERY ONE (1) DOUBLE SIDED OR TWO (2) SINGLE SIDED KIOSKS.
- 10 VERIFY DROP CORDS AND RECEPTACLES DO NOT FALL BELOW HEIGHTS LISTED ON E3.0 ELECTRICAL SCHEDULE. RECEPTACLES SHOULD BE LOCATED AT HEIGHTS TO AVOID CONTACT WITH HOT APPLIANCES.

11 PROVIDE J-BOX ABOVE CEILING NEAR KIOSK FOR FUTURE DIGITAL MERCHANDISER. EXTEND CIRCUIT TO THIS LOCATION FROM DIGITAL MERCHANDISER NEAR SERVICE AREA. EXTEND J-HOOKS FROM SERVICE AREA FOR FUTURE DATA CABLES.

12 CONTRACTOR TO PUNCH HOLES IN SERVICE POD FOR CABLE AND CONDUIT ROUTING. UTILIZE BUSHINGS PROVIDED WITH SERVICE POD TO PROTECT CABLES

13 PROVIDE A 5-20R RECEPTACLE FOR DELIVERY POD DOWNLIGHT, F12DP. INSTALL RECEPTACLE AT 7'-6" AFF. PROVIDE 2#12, 1#12GRD IN 1/2" C TO A 20A CIRCUIT FROM THE LP PANEL. REFER TO LIGHTING PLAN FOR CIRCUIT NUMBER.

SHEET NO.	TITLE	2019 STANDARD BUILDING - BB20	DRAWN BY	MRL
			STD ISSUE DATE	2019-11
			REVIEWED BY	WLW
			DATE ISSUED	01-23-20
	DESCRIPTION	WOOD BEARING WALLS W/FIBER CEMENT SIDING & CI	FIBER CEMENT PANEL/BATTEN/ALPOLIC PANEL/BRICK EXTER. FINISH	RF#1975
SITE ID	SITE ADDRESS	605 SOUTH 7TH STREET, KANSAS CITY, KS		
015-0071.00.B	E 1.1	ROUGH-IN PLAN		


emanuelson-podas Consulting Engineers
Emmanuelson-Podas, Inc.
Edmond, OK 73034
(405) 930-0050 | www.epinc.com

Matthew W. Ellis
LICENSED
PROFESSIONAL ENGINEER
17667
12/03/20

© 2020 McDonald's USA, LLC
McDonald's USA, LLC
PREPARED BY:
McDonald's USA, LLC

PREPARED FOR:
McDonald's USA, LLC

These drawings and specifications are the confidential and proprietary property of McDonald's USA, LLC, and shall not be copied or reproduced without the express written consent of McDonald's USA, LLC. The issuance and use of these drawings and specifications are limited to the project for which they were issued. It is prohibited to copy or reproduce these drawings or any portion thereof for use on other projects or for any other purpose. Use of these drawings for reference or example on another project requires the services of a properly licensed architect or engineer. Reproduction of these drawings and specifications is not authorized.

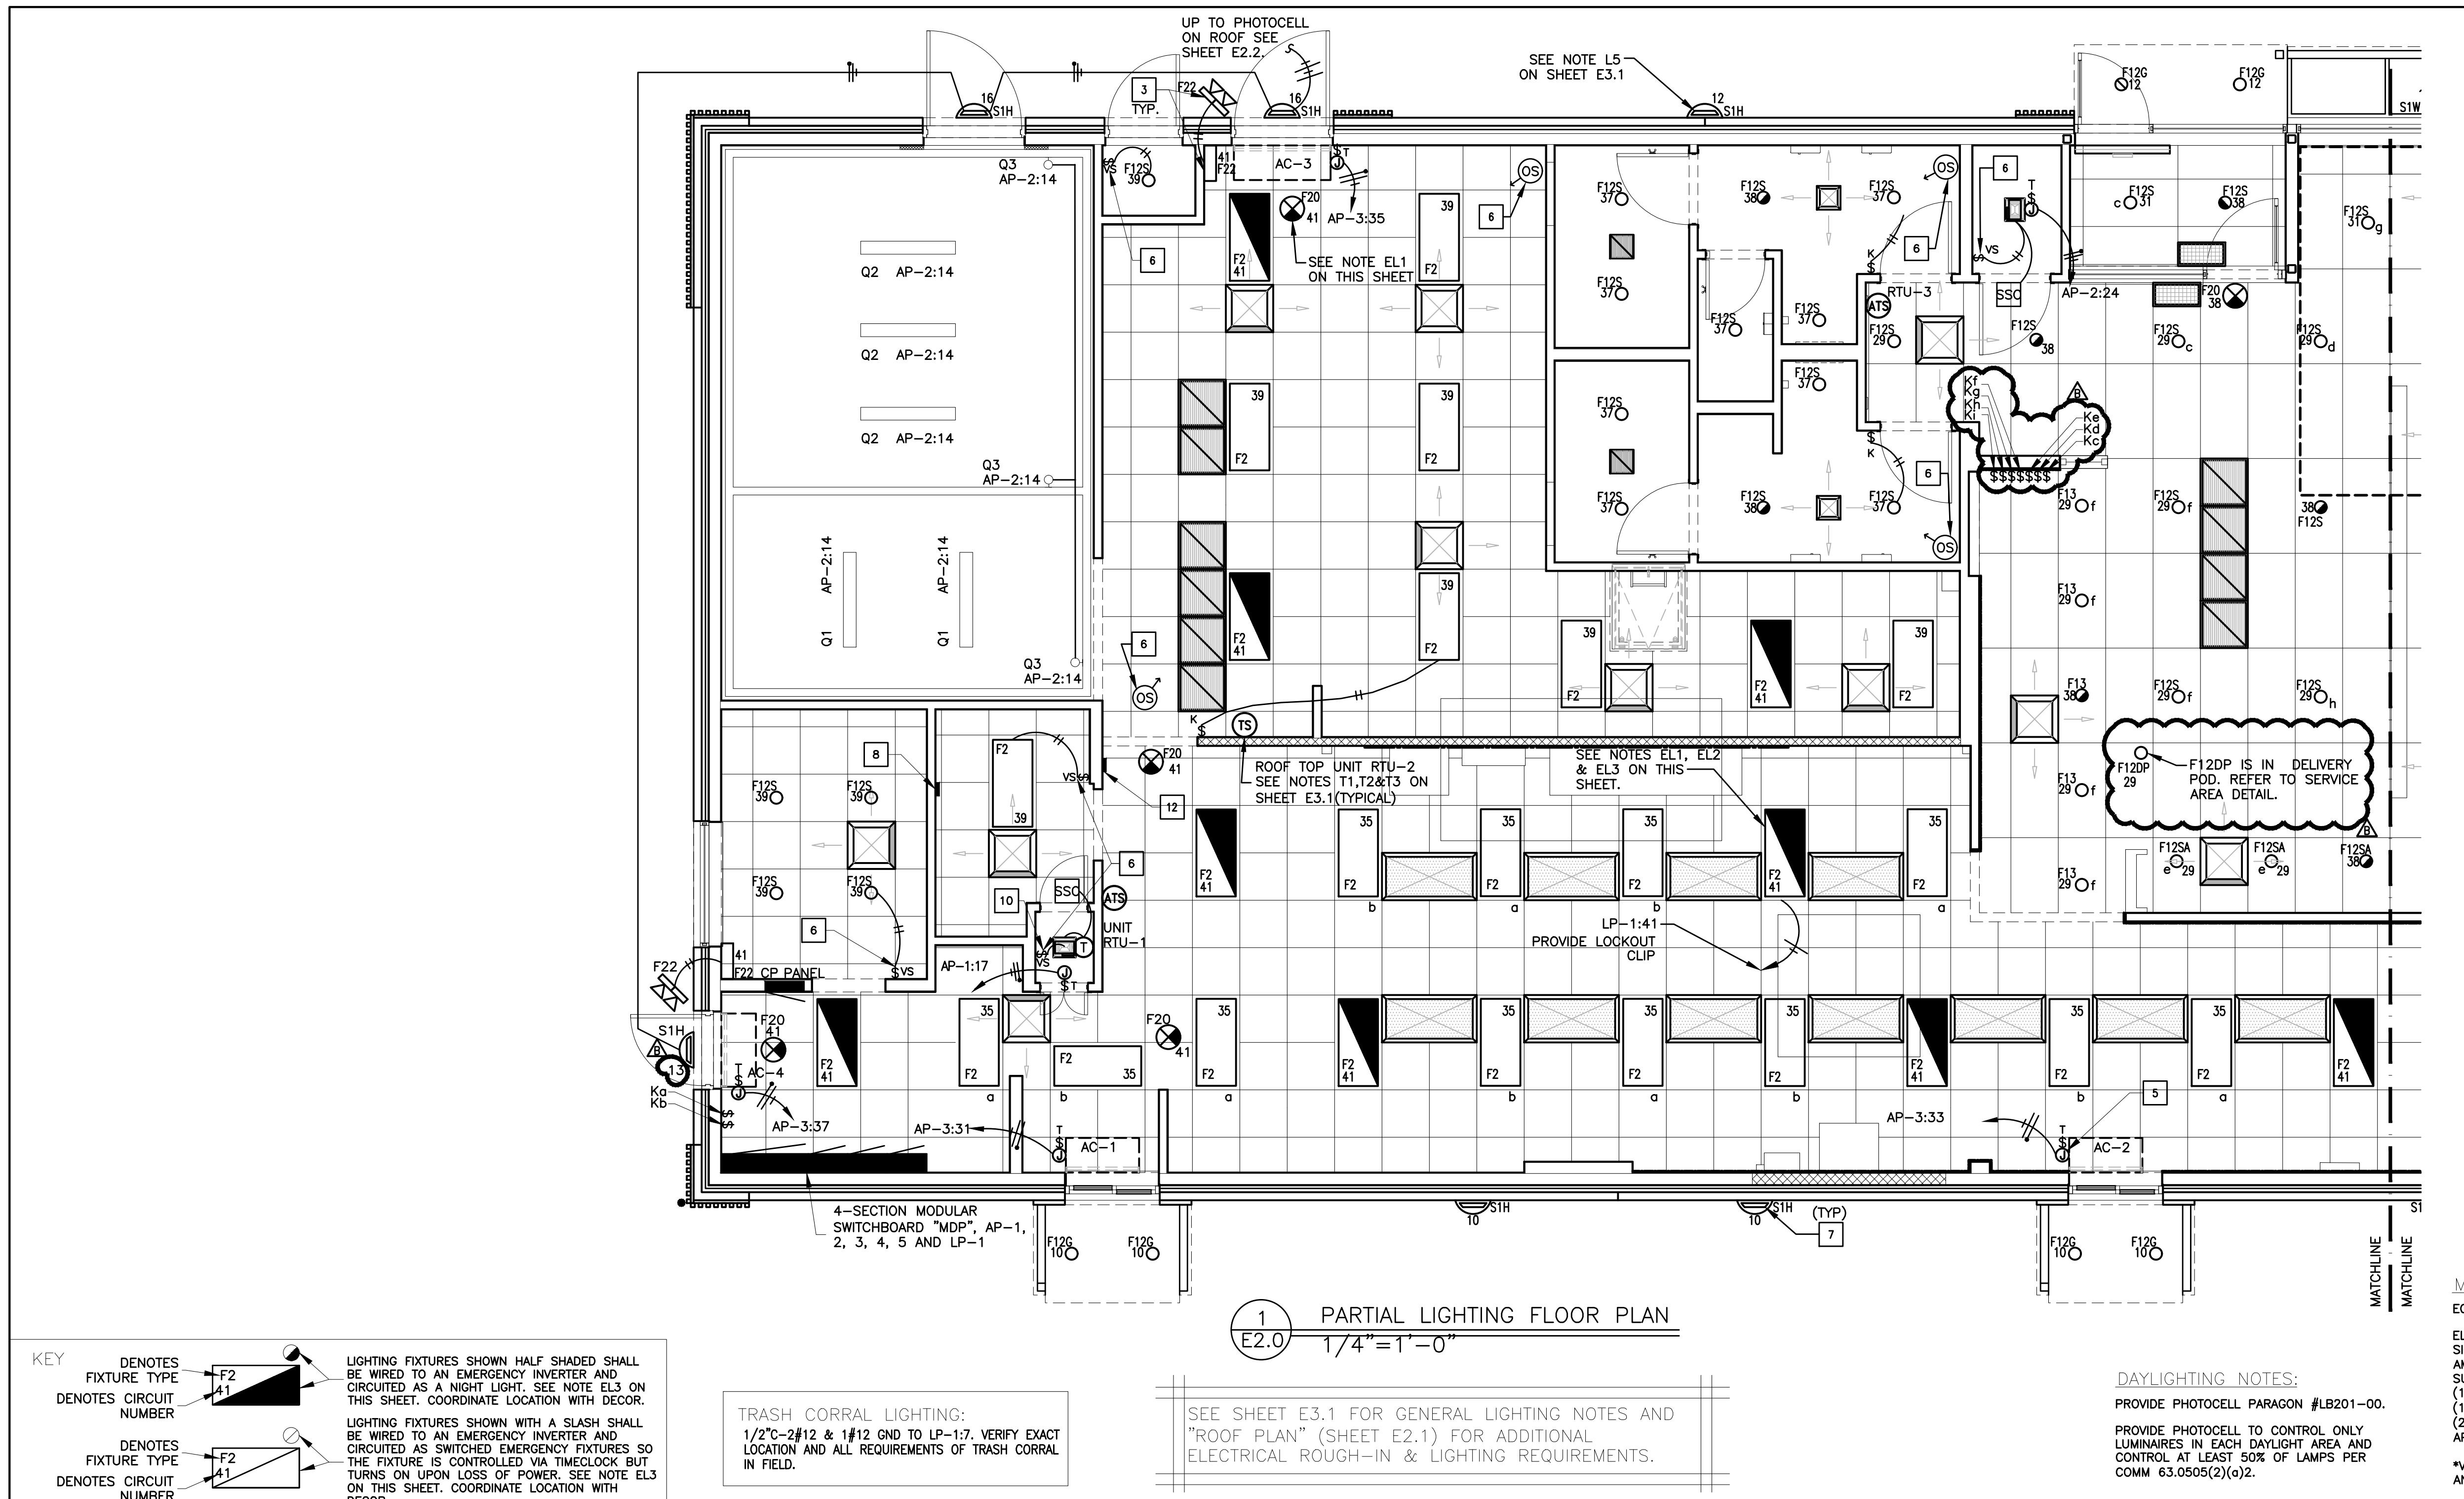

LIGHTING FIXTURE SCHEDULE:

MARK	SYMBOL	DESCRIPTION	DIFFUSER	LAMPS		BALLAST	MOUNTING	MANUFACTURER AND CATALOG NUMBER	Q1	REFRIGERATION LIGHTING	INTERNAL PRISMATIC LENS VAPOR TIGHT	81.1W	LED	-	SURFACE FREEZER/COOLER	METALUX 4VT2-LD4-8-DR-UNV-L835-CD1-WL-U
				WATTS	TYPE											
F2	□	2' X 4' GRID TROFFER	PRISMATIC ACRYLIC	44W	LED	-	RECESSED	SECURITY LIGHTING: # LCAT24-35HLC-EDU-WP-CK	Q2	REFRIGERATION LIGHTING	INTERNAL PRISMATIC LENS VAPOR TIGHT	38W	LED	-	SURFACE FREEZER/COOLER	METALUX 4VT2-LD4-4-DR-UNV-L835-CD1-WL-U
F12DP	○	4" LED DOWN LIGHT - GOLD TRIM - DELIVERY POD	9W	LED	-	RECESSED	SECURITY LIGHTING # LB4A-6LDDM-30K-9-GD/IBX4L-120	Q3	REFRIGERATION LIGHTING	INTERNAL PRISMATIC LENS VAPOR TIGHT	1-100	A16	-	SURFACE TO WALL FREEZER AND COOLER	KASON REFRIGERATION LIGHTING: 1802000002, WITH WIRE GUARD.	
F12G	○	6" LED DOWN LIGHT - SHALLOW HOUSING	12W	LED	-	RECESSED	SECURITY LIGHTING # LB6LEDA10L-50K-9-GD/RMNIC-QL	S1H	"DOWN ONLY" RADIAL WALL SCONCE - SILVER	TEMPERED GLASS	(1)-14W	LED	-	SURFACE TO WALL	SECURITY LIGHTING: #RWSC-36L-5K-D0-U-PS	
F12S	○	6" LED DOWN LIGHT	-	12W	LED	-	RECESSED	SECURITY LIGHTING # LB6LEDA10L-30K-9-SA/DBXOL-DM	S1W	"DOWN ONLY" RADIAL WALL SCONCE - WHITE	TEMPERED GLASS	(1)-14W	LED	-	SURFACE TO WALL	SECURITY LIGHTING: #RWSC-36L-5K-D0-U-WH
F12SA	○	6" LED ADJUSTABLE DOWN LIGHT	-	12W	LED	-	RECESSED	SECURITY LIGHTING # LB6LEDA10L-30K-9-SA/DBXOL-DM COORDINATE DOWN LIGHT TO BE USED IN DINING WITH PHOTOMETRIC								
F13	○	4" LED DOWN LIGHT	-	25W	LED	-	RECESSED	SECURITY LIGHTING # LF4SL-4LFSL20L-30K-SP-SL-DL-B24								
F14	○	ALPHABET PENDANT	-	(1)-8W	LED	-	PENDANT	SECURITY LIGHTING # MS-P-A-BM-108LED-CBC (TO BE VERIFIED WITH DECOR DRAWINGS)								
F20	○	EXIT SIGN WITH BATTERY BACKUP	-	1.8W	LED	-	SURFACE	SECURITY LIGHTING: EVEURWE. SEE NOTE LS2 ON THIS SHEET.								
F21	○	2 HEADED EMERGENCY BATTERY LIGHT	-	-	LED	-	SURFACE TO WALL OR CEILING	SECURITY LTG. #EV4D								
F22	○	EMER BATTERY & 2 REMOTE HEADS	-	-	LED	-	SURFACE TO WALL OR SOFFIT	SECURITY LTG. #EV4D-02L-0/EV0DB								
F23	○	2 HEADED EMERG LIGHT & 2 REMOTE HEAD IF REQ'D	-	-	LED	-	SURFACE TO WALL OR SOFFIT	SECURITY LTG. #EV4D/EV0DB								

LIGHTING SCHEDULE NOTES:

LS1. ORDER LED EXIT SIGNS WITH LETTER COLORS THAT COMPLY WITH LOCAL CODES.

- FOR RED LETTERS USE #EVE-U-R (UNIVERSAL),
- FOR GREEN LETTERS USE #EVE-U-G (UNIVERSAL), OR
IF THE ABOVE EXIT SIGNS DO NOT COMPLY WITH LOCAL CODES USE: LED SIGN WITH BATTERY BACKUP, LETTER SIZE, COLOR, TYPE & DIRECTIONAL ARROWS AS REQUIRED BY THE LOCAL AUTHORITIES.

LS2. ALL INTERIOR LIGHT FIXTURES SHALL BE 120 VOLT UNLESS NOTED OTHERWISE.

LS3. LIGHTING FIXTURES HAVE BEEN CHOSEN TO ACHIEVE MAXIMUM ENERGY CONSERVATION WHILE MAINTAINING ADEQUATE LEVEL OF ILLUMINATION. SPECIFICATIONS SHALL BE STRICTLY FOLLOWED. ANY DEVIATION FROM THE SPECIFICATIONS SHALL BE APPROVED IN WRITING BY McDONALD'S CORPORATION.

LS4. VERIFY DOWNLIGHT TO BE USED IN DINING WITH PHOTOMETRIC

ORDER ALL LIGHT FIXTURES FROM:

SECURITY LIGHTING SYSTEMS, INC.
PHONE: 1-800-LIGHT-IT
EMAIL: QUOTATIONS@SECURITYLIGHTING.COM

CS ILLUMINATIONS
PHONE: 760-477-1244
EMAIL: MCD@CSILLUMINATIONS.COM
WWW.CSILLUMINATIONS.COM/MCD


TITLE	2019 STANDARD BUILDING - BB20	STD ISSUE DATE	2019-11	REVIEWED BY	WLW
DESCRIPTION	4597F10-WOOD/WOOD	DATE ISSUED	01-23-20		
SITE ID	015-0071.00.B	SITE ADDRESS	605 SOUTH 7TH STREET, KANSAS CITY, KS		
SHEET NO.	E2.0	FILE NUMBER	R0f1975		
PREPARED BY:	McDonald's USA, LLC	PREPARED FOR:	McDonald's USA, LLC	© 2020 McDonald's USA, LLC	These drawings and specifications are the confidential and proprietary property of McDonald's USA, LLC and shall not be copied or reproduced without the express written consent of McDonald's USA, LLC. These drawings and specifications are intended for use on this specific site in conjunction with the issuance date and are not suitable for use on a different site or at a later time. Use of these drawings for reference or example on another project requires the services of properly licensed architects and engineers. Reproduction of the contract documents for reuse on another project is not authorized.
KEY NOTES	<ol style="list-style-type: none"> CENTER PENDANT LIGHTS OVER TABLES (TYPICAL) ALL SOFFIT LOCATIONS, LIGHTING, & SUPPLY GRILLS SHALL BE COORDINATED WITH DECOR COMPANY DRAWING PRIOR TO INSTALLATION. EC SHALL INSTALL AND CONFIGURE REMOTE EMERGENCY LIGHTING AT ALL EGGS EXTERIOR DOORS FOR MAXIMUM ILLUMINATION AT POINTS OF EGGS. INSTALL WP J-BOX WITHIN SOFFIT TO ALLOW A FLUSH INSTALLATION OF ANY EXTERIOR EMERGENCY EGGS (TYPICAL). OPTIONAL ADJUSTABLE WALL WASH FIXTURE TO ILLUMINATE LOGO OR GRAPHICS. EC SHALL VERIFY EXACT LOCATION SO AS TO ADEQUATELY ILLUMINATE McDONALD'S ARCH LOGO SIGN AND GRAPHICS. AIR CURTAIN UNIT, NON HEATED VERSION TO USE 1/2" C, 2#12, 1#12GRD. HEATED VERSION TO USE 1" C, 2#6, 1#10 GRD. (TYPICAL). PROVIDE DUAL TECHNOLOGY OCCUPANCY SENSOR OR VACANCY SENSOR SWITCH AS SHOWN, ORDER ALL SENSORS FROM: SECURITY LIGHTING SYSTEMS, INC. RADIAL WALL SCONCE. SEE NOTE L2 ON SHEET E3.1 AND ARCHITECTURAL ELEVATIONS ON SHEETS A2.0 & A2.1. (TYPICAL) BUILDING AUTOMATION SYSTEM LOCATION. SEE LIGHTING CONTROL DETAILS ON SHEET E4.1. PROVIDE DUAL-LITE LIGHTING INVERTER MODEL #LG125T FOR USE WITH TYPE F12S, F12SA & F12O FIXTURES SHOWN SHADED OR SLASHED. EC SHALL FIELD VERIFY EXACT QUANTITY AND LOCATION OF DEVICE PROVIDED. INSTALLATION OF EACH INVERTER SHALL VERIFY QUANTITY OF FIXTURES THAT CAN BE CONNECTED TO INVERTER WITHOUT EXCEEDING OPERATING CAPACITY OF UNIT AND PROVIDE ADDITIONAL CIRCUITS AND INVERTERS AS REQUIRED. (TYPICAL) CENTER VACANCY SENSOR SWITCH OPPOSITE COMPUTER RACK IN A LOCATION ACCESSIBLE FROM BOTH DOORS FOR CONTROL OF CEILING MOUNTED LIGHT, IN DATA ROOM. FAN CONTROLLED BY LOCAL THERMOSTAT. PROVIDE POWER FOR LIGHT WITHIN TOY DISPLAY. COORDINATE EXACT LOCATION WITH DECOR DRAWINGS. LIGHTING CONTACTORS IN NEMA 1 ENCLOSURE JUST BELOW CEILING. EC SHALL FIELD VERIFY 120 VOLT CONTROL CIRCUIT TO CONTACTOR PANEL. VERIFY EXACT LOCATION IN FIELD AND REFER TO DRAWING E4.1 FOR ADDITIONAL DETAILS. 				
BY	emmanuelson-podas consulting engineers	DATE	12/03/20	SERVICE AREA OPTIMIZATION	
BY	Emmanuelson-Podas, Inc.	DATE	11/17/20	USD: SAD SET REVIEW	
BY	Emmanuelson-Podas, Inc.	DATE	05/05/20	CIVIL & PLAN REVIEW COMMENTS	
BY	Emmanuelson-Podas, Inc.	DATE	01/23/20	PERMIT SET	
BY	Emmanuelson-Podas, Inc.	DATE	01/13/20	PROGRESS SET REVIEW	
BY	Emmanuelson-Podas, Inc.	DATE	REV	REVIEW	

*Matthew W. Ellis
LICENSED
PROFESSIONAL ENGINEER
17667
KANSAS CITY, MO
12/03/20*

PB = Pullbox
JB = Junction Box
EC = Electrical Contractor
VIF = Verify in Field

TAG #	QTY	DESCRIPTION	VOLT/PH	FLA	BRK SIZE	COND/WIRE	PNL/CCT	RECEP TYPE	HGT AFF	REQUIREMENTS & REMARKS
701.13E9	5	DCO - GENERAL PURPOSE	120/1	1.5	20A	1/2C-2#12	AP-2:42	5-20R	1'-6"	-
701.14E1	1	TELEPHONE	PHONE BOX	-	-	-	-	RJ-11C JACK	4'-6"	-
701.14E3	1	TELEPHONE	PHONE BOX	-	-	-	-	RJ-11C JACK	3'-6"	-
701.15E1	1	DOOR BUZZER	120/1	.5	20A	1/2C-2#12	LP-1:16	-	8'-0"	CONNECT TRANSFORMER TO POWER & ROUTE LOW VOLTAGE WIRES OVERHEAD TO DOOR BUTTON
701.16E1	2	DOOR ALARM	120/1	.5	20A	1/2C-2#12	LP-1:16	JB	SEE RMKS	JUNCTION BOX ABOVE CEILING, PROVIDE LOCKOUT ON CIRCUIT BREAKER HANDLE.
701.22E1	1	WAYPORT - WIRELESS INTERNET SERVER	120/1 ISOLATED	1.5	20A	1/2C-2#12IG	CP:2	IG5262	8'-0"	-
701.22E2	1	WAYPORT - WIRELESS INTERNET SERVER	DATA CABLE	-	-	-	-	JB	8'-0"	EXTEND 1" CONDUIT ABOVE CLG. W/BUSHING FOR DATA CABLE
701.27E1	1	DCO-SATELLITE MUSIC SYSTEM	120/1	1.0	20A	1/2C-2#12	AP-3:6	(2) 5-20R	3'-0"	PROVIDE DOUBLE DUPLEX WALL PLATE
701.32E1	1	REMOTE ORDER TAKER BATTERY PACK	120/1	2.0	20A	1/2C-2#12	AP-1:9	(2) 5-20R	4'-6"	PROVIDE DOUBLE DUPLEX WALL PLATE. FIELD VERIFY HEIGHT AND LOCATION WITH ACM
701.34E1	1	ACCESS CONTROL PANEL	120/1	2.0	20A	1/2C-2#12	LP-1:16	JB	8'-0"	ROUTE LOW VOLTAGE WIRES TO DOOR BUTTON, HORN AND DOOR STRIKE AS REQUIRED

ELECTRICAL SCHEDULE

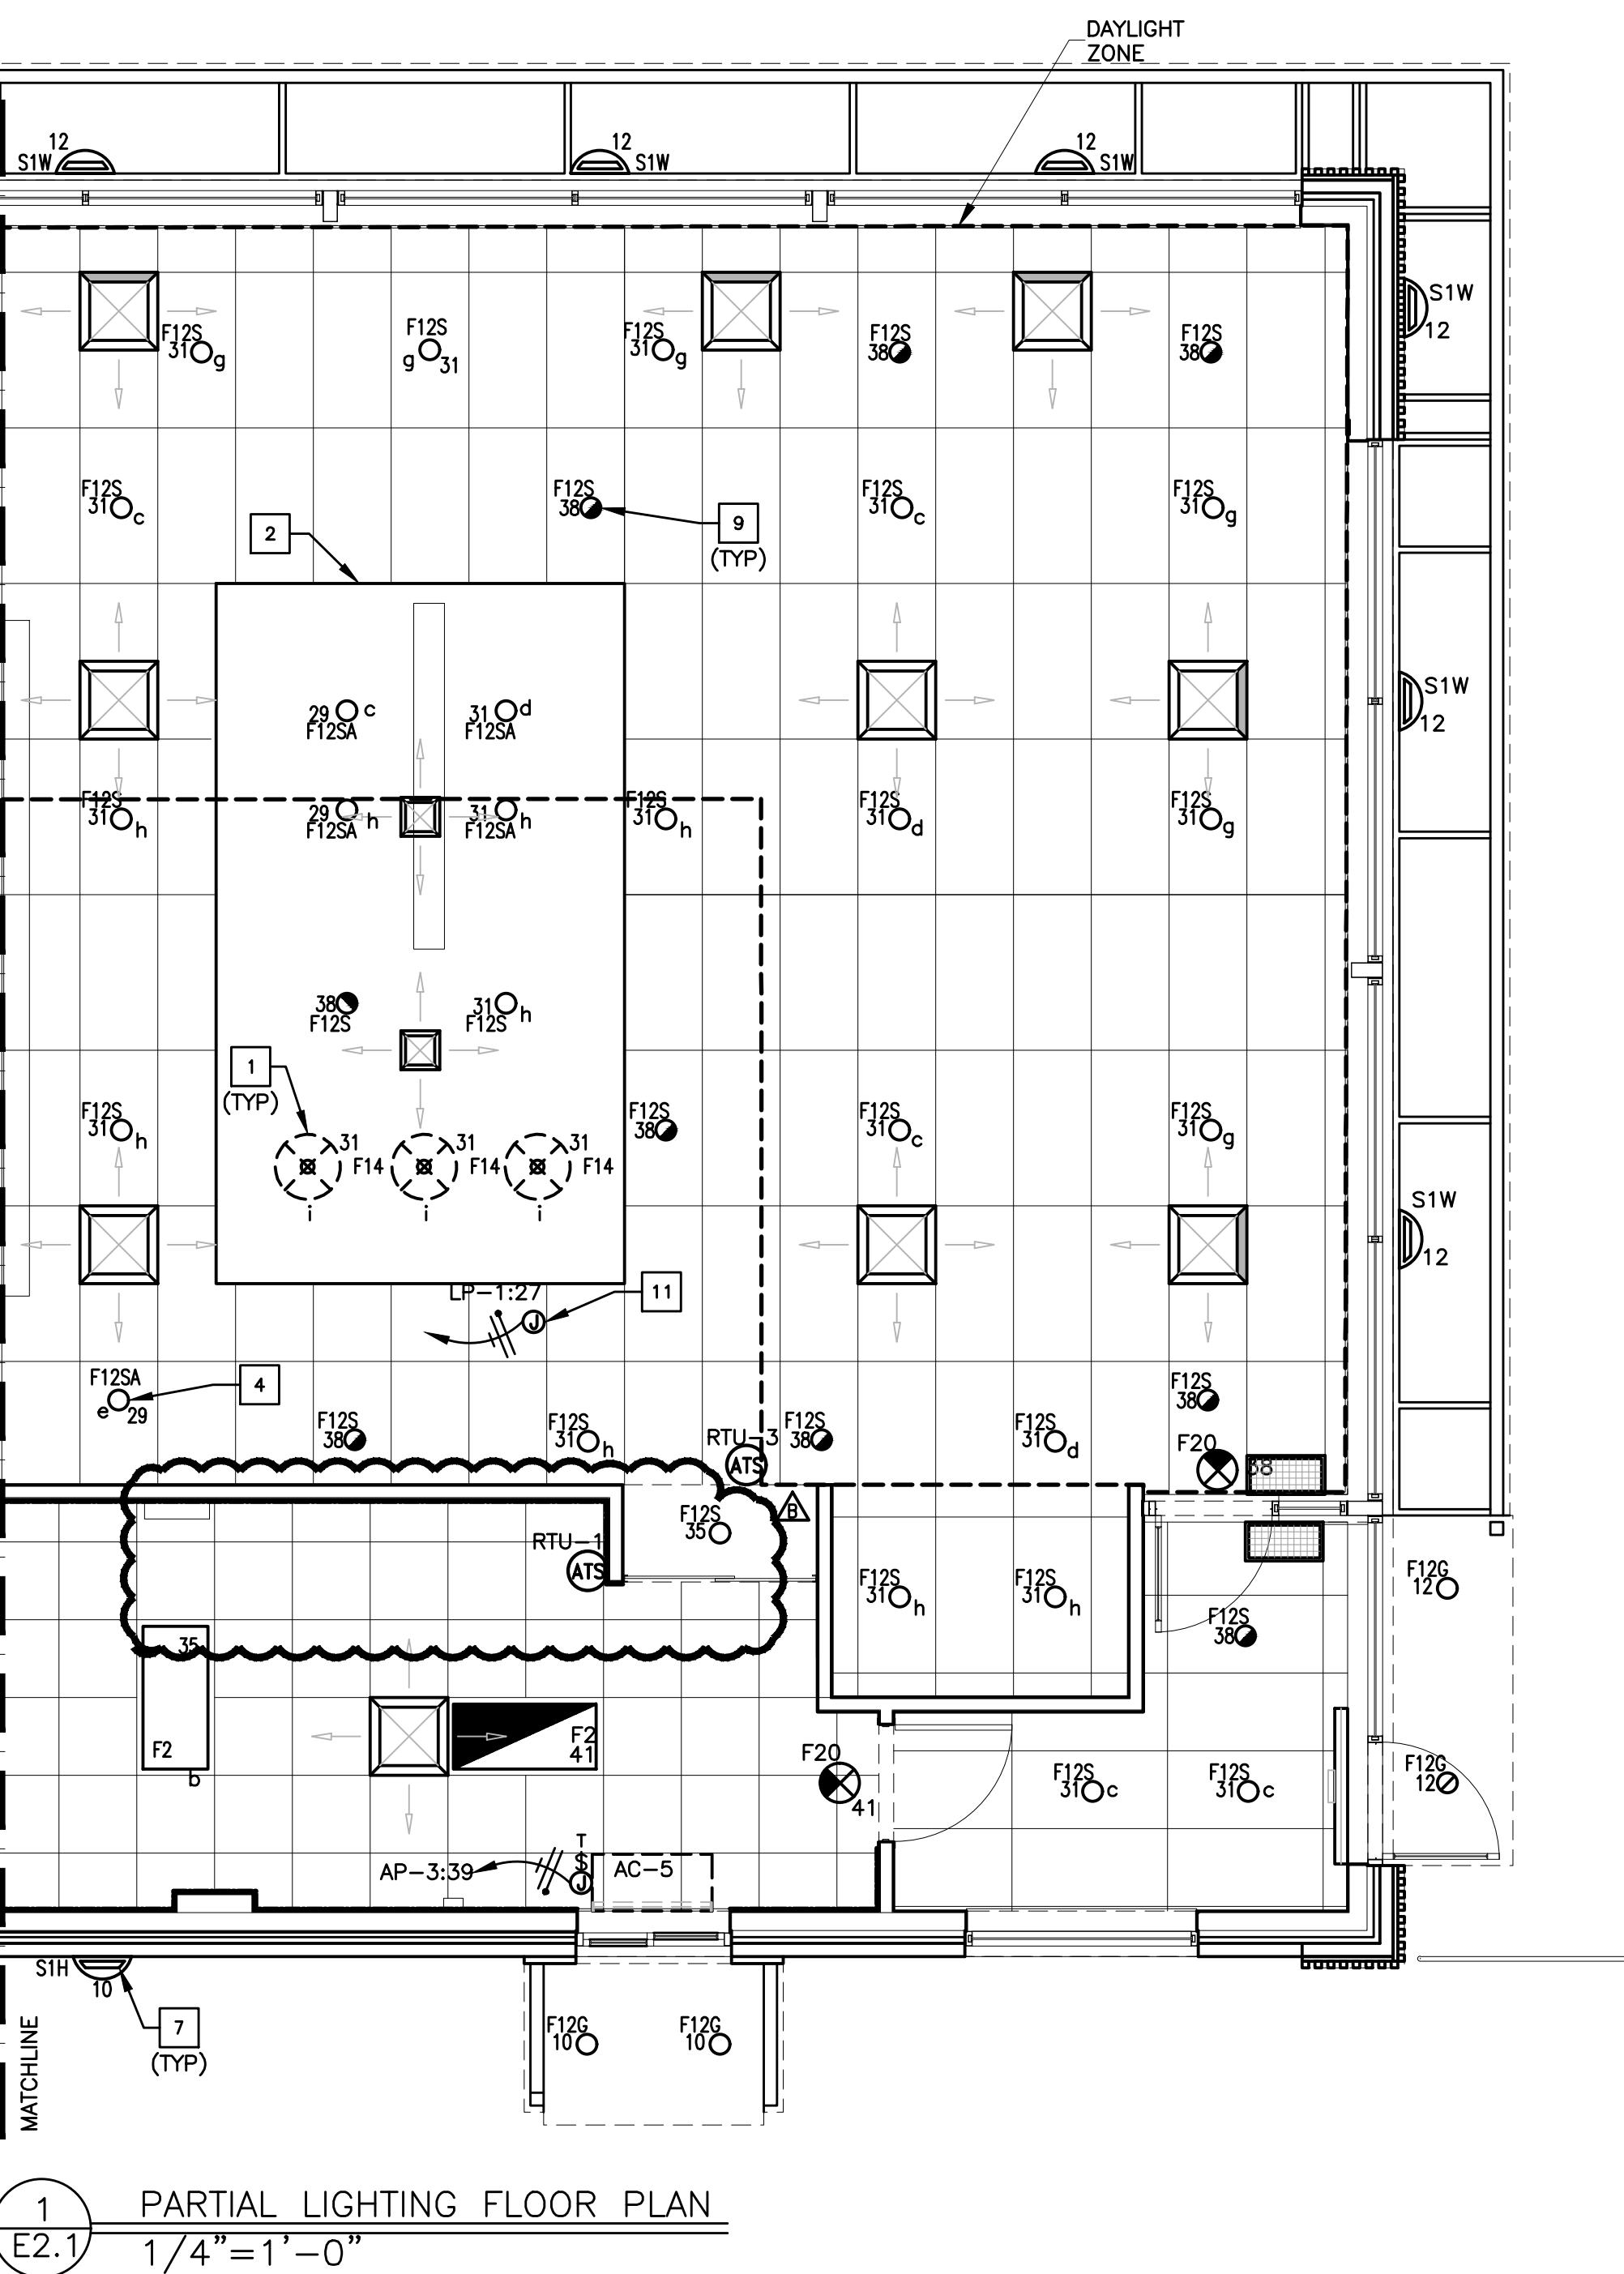

SHEET NO.	TITLE	DRAWN BY	PREPARED BY:	REVIEWED BY:	REVISED BY:	DATE ISSUED:				
015-0071.00.B	2019 STANDARD BUILDING - BB20 4597F10-WOOD/WOOD	MRL	McDonald's USA, LLC	Matthew W. Fullis LICENCED PROFESSIONAL ENGINEER 17667	W.L.W.	12/03/20	11/13/20	05/05/20	01/23/20	01/13/20
DESCRIPTION: WOOD BEARING WALLS W/FIBER CEMENT SIDING & CI WOOD ROOF TRUSS FRAMING FIBER CEMENT PANEL/BATTEN/ALPOLIC PANEL/BRICK EXT. FINISH										
SITE ID	SITE ADDRESS	RO#19175	Comments: 1. Service area optimization. 2. Civil & plan review comments. 3. Permit set. 4. Progress set review.							
BY DATE										

emanuelson-podas Consulting Engineers
Emmanuel-Podas, Inc.
Attn: Al N. Emmanuel
Edm., IN 46539
(920) 930-0050 | www.epinc.com


Matthew W. Fullis
LICENCED PROFESSIONAL ENGINEER
17667

12/03/20

© 2020 McDonald's USA, LLC
These drawings and specifications are the confidential and proprietary property of McDonald's USA, LLC and shall not be copied or reproduced for use on this specific site in conjunction with the issuance date and are not suitable for use on a different site or at a later time. Use of these drawings for reference or example on another project requires the services of properly licensed architects and engineers. Reproduction of the contract documents for reuse on another project is not authorized.

REFER TO E2.0 FOR NOTES. SEE SHEET E3.1 FOR GENERAL LIGHTING NOTES AND "ROOF PLAN" (SHEET E2.2) FOR ADDITIONAL ELECTRICAL ROUGH-IN & LIGHTING REQUIREMENTS.

E2.1
LIGHTING PLAN

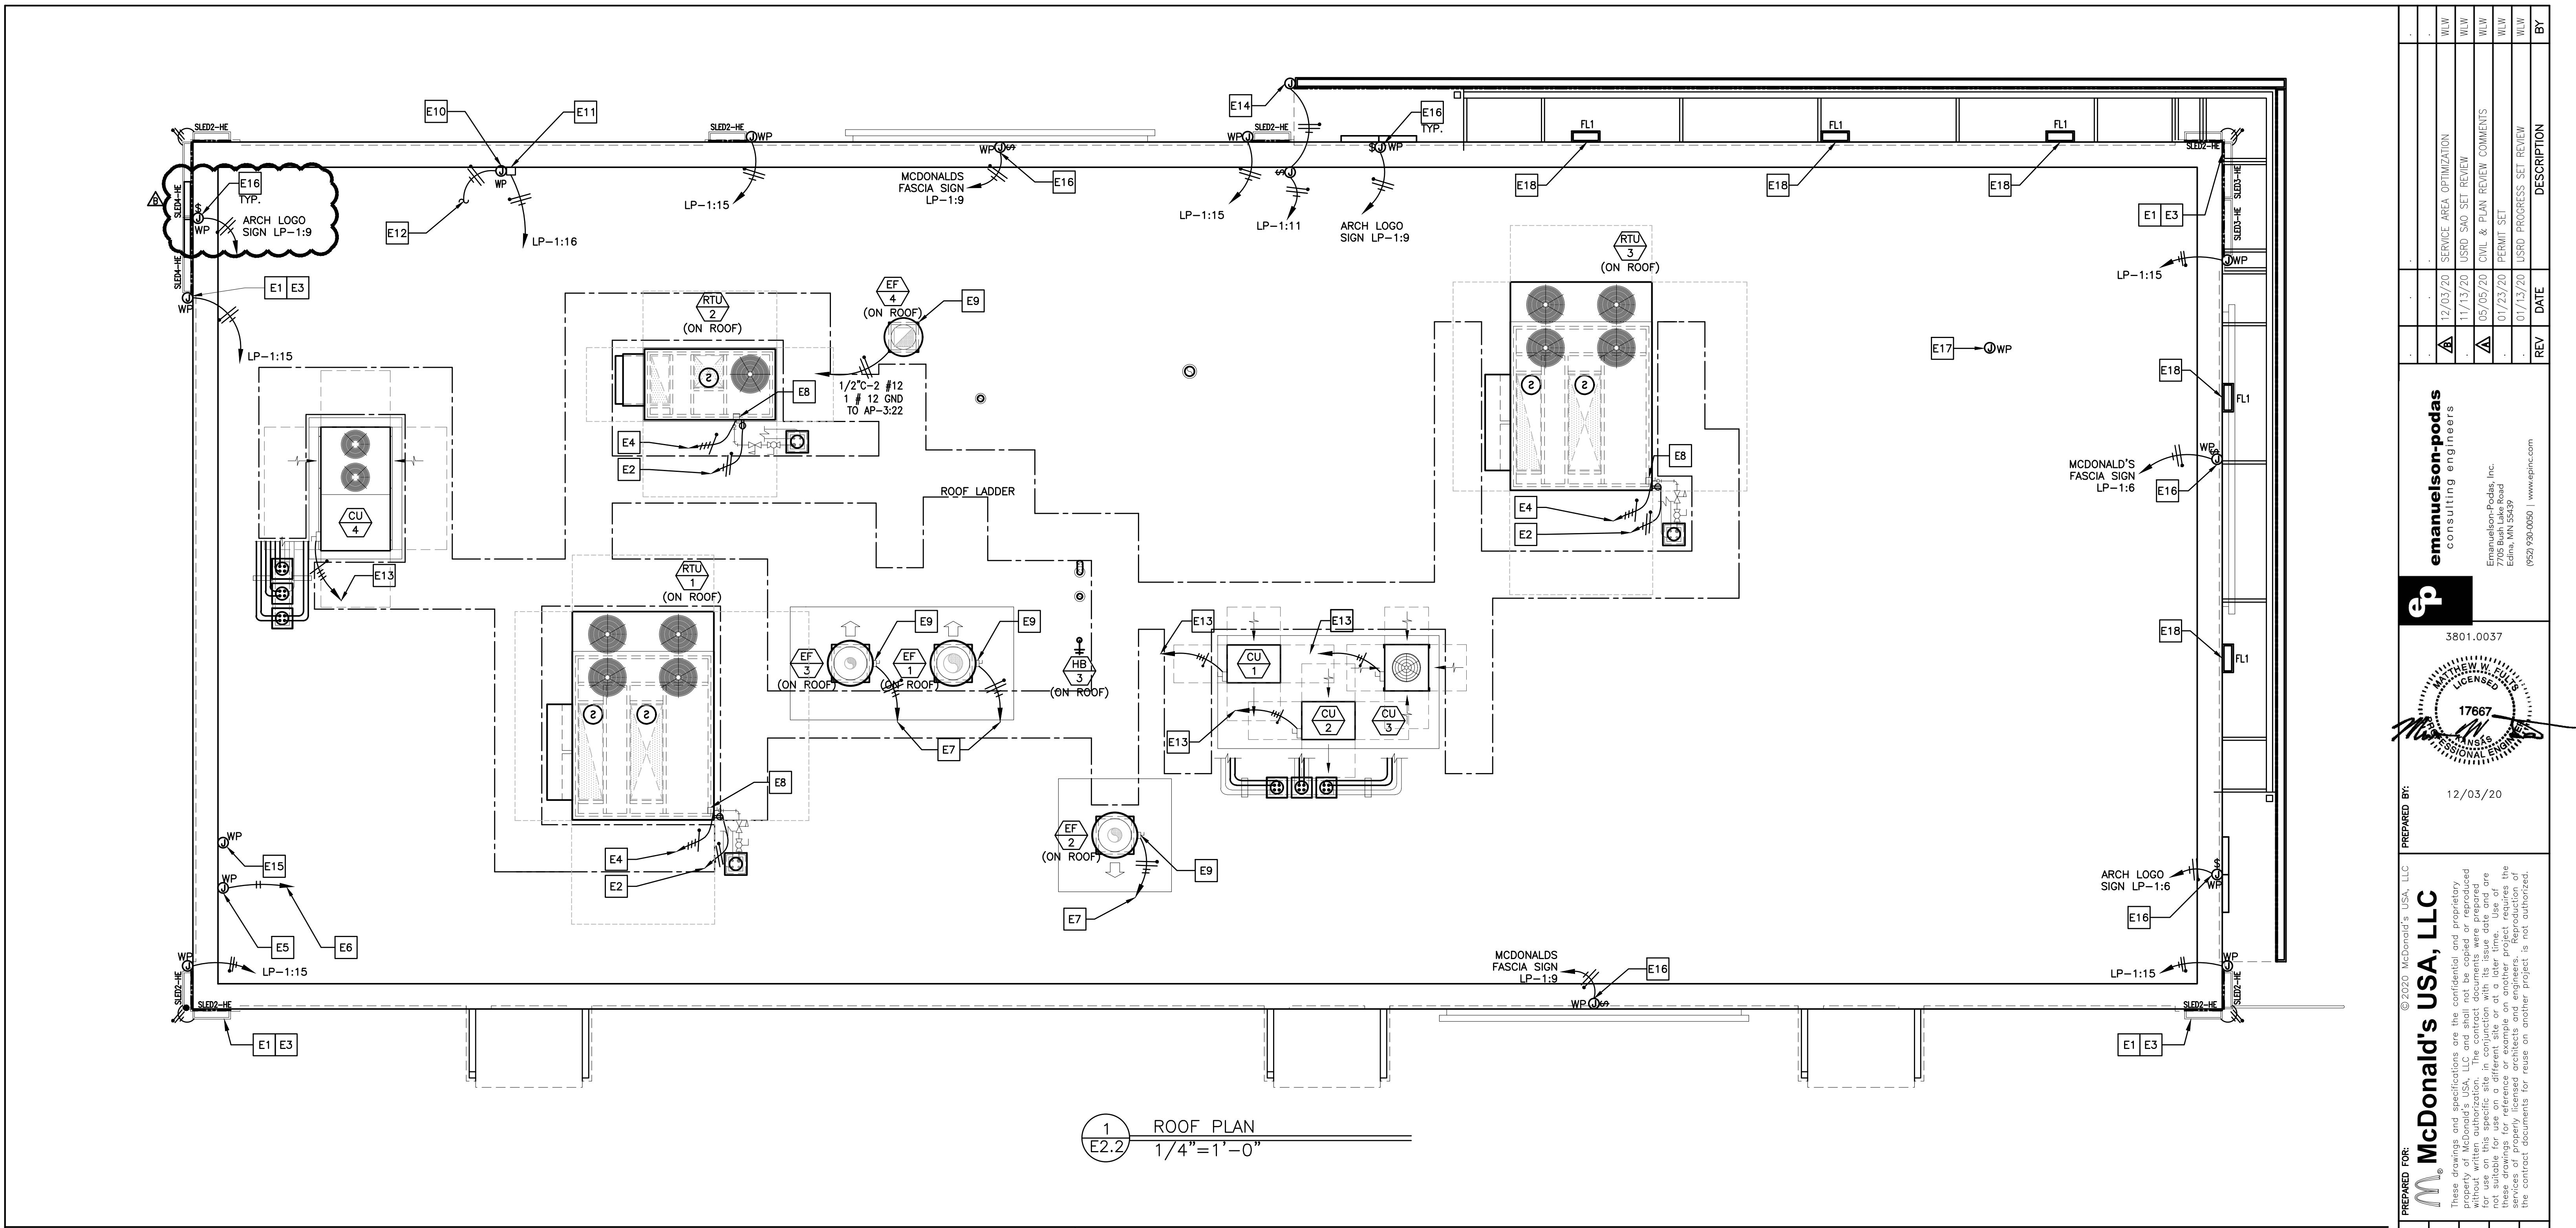

KEYED NOTES

- E1 EVERY LINEAR RUN OF SLED FIXTURES REQUIRES A DEDICATED WHIP KIT PROVIDED WITH FIXTURE. CONTRACTOR TO FIELD VERIFY FIXTURE MOUNTING HEIGHT, LOCATION, QUANTITY, FIXTURE LENGTHS, AND ALL ELECTRICAL CONNECTION REQUIREMENTS WITH SECURITY LIGHTING PRIOR TO ORDERING AND INSTALLATION (TYPICAL).
- E2 WEATHER PROOF RECEPTACLES WITH GFCI PROTECTION ARE PROVIDED AND MOUNTED WITHIN MOTOR HOUSING LOCATIONS PER NEC ARTICLE 210.63. CIRCUIT SHALL EMANATE FROM PANEL AP-3,CCT.#34.(TYPICAL).
- E3 SMOOTH BRACING IS REQUIRED FOR LED FIXTURE INSTALLATION UNDER COPING/FLASHING.(TYPICAL)
- E4 REFER TO SHEET E4.0 FOR CONDUIT AND WIRE SIZE.(TYPICAL)
- E5 E.C. SHALL PROVIDE A WEATHER-PROOF J-BOX ON INSIDE FACE OF PARAPET, MOUNTED 6" BELOW TOP OF PARAPET FOR LIGHTING CONTROL PANEL PHOTOCELL. (PHOTOCELL FURNISHED BY OTHERS AND INSTALLED BY EC). REFER TO LIGHTING CONTROL DETAILS ON E4.1
- E6 TO LIGHTING ENCLOSURE W/ TIMER. COORDINATE WITH LIGHTING CONTROL DETAILS ON SHEET E4.1
- E7 COOKING EQUIPMENT EXHAUST FANS. SEE SHEET E3.0 FOR ELECTRICAL REQUIREMENTS. SEE SHEET E3.2 FOR EXHAUST FAN INTERLOCK WIRING DIAGRAMS. (TYPICAL)
- E8 PROVIDE NEMA 3R DISCONNECT WITH CURRENT LIMITING FUSES TO COMPLY WITH NEC 110 AND 440. ELECTRICAL CONTRACTOR SHALL STUB UP THRU RACEWAY IN CURB TO ELIMINATE CONDUIT PENETRATION OF ROOFING. (TYPICAL)
- E9 EXTERNAL NEMA 3R MOUNTED ON SIDE OF FAN BY MANUFACTURER. ELECTRICAL CONTRACTOR SHALL STUB UP THRU ROOF AND PROVIDE FLEXIBLE WEATHERPROOF CONDUIT FROM ROOF PENETRATION TO DISCONNECT (TYPICAL).
- E10 E.C. SHALL PROVIDE A WEATHER-PROOF JUNCTION BOX ON INSIDE FACE OF PARAPET FOR PHOTOCELL INSTALLATION. MOUNT JB 6" BELOW TOP OF PARAPET. PHOTOCELL FURNISHED AND INSTALLED BY EC. MOUNT FACING NORTH.
- E11 PHOTOCELL ON ROOF (SEE SHEET E2.0 FOR CONTINUATION AT DOOR LOCATIONS).
- E12 TO SOFFIT LIGHT FIXTURES NEAR DOORS. SEE SHEET E2.0 FOR CONTINUATION. TYPICAL FOR CCT LP-1:16.
- E13 REMOTE CONDENSING UNITS. SEE SHEET E3.0 FOR WIRING AND CIRCUITRY REQUIREMENTS.
- E14 CANOPY LIGHT. LP-1:11 EC SHALL VERIFY EXACT SPECIFICATIONS AND LOCATION WITH MANUFACTURER. REMOTE POWER SUPPLIES ABOVE ACCESSIBLE CEILING WITHIN VESTIBULE. VERIFY EXACT INFEEF REQUIREMENTS IN THE FIELD. SEE NOTE L5 ON SHEET E3.1. (TYPICAL)
- E15 E.C. SHALL PROVIDE A WEATHER-PROOF JUNCTION BOX WITH 3/4" STUB DOWN TO CEILING SPACE WITH BUSHING FOR ROOF-TOP CAMERA OR SATELLITE. VERIFY EXACT LOCATION(S) WITH MCD AREA CONSTRUCTION MANAGER PRIOR TO INSTALLATION.
- E16 E.C. SHALL PROVIDE A JUNCTION BOX FOR ARCH LOGO / McDONALD'S FASCIA / PLAY-PLACE SIGN. SEE NOTE L1 ON SHEET E3.1. COORDINATE EXACT LOCATION IN FIELD WITH ACM. ALL SIGNS PROVIDED WITH INTEGRAL DISCONNECT SWITCH FROM MANUFACTURER.(TYPICAL)
- E17 E.C. SHALL PROVIDE A JUNCTION BOX FOR ROOF-TOP FLAG POLE LIGHTING. VERIFY LOCATION(S) WITH MCD PROJECT MANAGER PRIOR TO INSTALLATION.
- E18 FLOOD LIGHT MOUNTED ABOVE CANOPY. LP-1:11 EC SHALL VERIFY EXACT SPECIFICATIONS AND LOCATION WITH ARCHITECTURAL ELEVATIONS. VERIFY EXACT INFEEF REQUIREMENTS IN THE FIELD. SEE FLOOD LIGHT DETAIL ON SHEET E3.1. (TYPICAL)

DRAWING NOTES

1. SEE DRAWING M-4.0 FOR GENERAL MECHANICAL NOTES.
2. SEE DRAWINGS M-3.0 AND M-4.1 FOR MECHANICAL EQUIPMENT SCHEDULES AND DETAILS.
3. SEE DRAWING M-4.0 FOR MECHANICAL LEGEND.
4. SEE DRAWING K-2.1 FOR REMOTE CONDENSER AND MAC UNIT INFORMATION.
5. SEE ELECTRICAL DRAWINGS FOR ADDITIONAL INFORMATION.

LED FIXTURE SCHEDULE:

MARK	SYMBOL	DESCRIPTION	DIFFUSER	LAMPS WATTS PER Fixture	BALLAST	MOUNTING	MANUFACTURER AND CATALOG NUMBER
SLED3	■	DOWN ONLY ACCENT LIGHTING (SEE PLAN)	TEMPERED GLASS	1-30W PER Fixture	LED	-	SECURITY LIGHTING: SLED-HE-36-DO-U-I0-C16 CUSTOM BUILT FOR EXTERIOR ACCENT CHANNELS.
SLED2-HE	■	DOWN ONLY ACCENT LIGHTING (SEE PLAN)	TEMPERED GLASS	1-10W PER Fixture	LED	-	SECURITY LIGHTING: SLED-HE-24-DO-U-I0 CUSTOM BUILT FOR EXTERIOR ACCENT CHANNELS.
SLED3-HE	■	DOWN ONLY ACCENT LIGHTING (SEE PLAN)	TEMPERED GLASS	1-14W PER Fixture	LED	-	SECURITY LIGHTING: SLED-HE-36-DO-U-I0 CUSTOM BUILT FOR EXTERIOR ACCENT CHANNELS.
SLED4-HE	■	DOWN ONLY ACCENT LIGHTING (SEE PLAN)	TEMPERED GLASS	1-19W PER Fixture	LED	-	SECURITY LIGHTING: SLED-HE-48-DO-U-I0 CUSTOM BUILT FOR EXTERIOR ACCENT CHANNELS.
FL1	■	UP ONLY ACCENT LIGHTING (SEE PLAN)	TEMPERED GLASS	1-16W PER Fixture	LED	-	SECURITY LIGHTING: EL218-W-5-8L-5K-UV-I0-JW10

TITLE	2019 STANDARD BUILDING - BB20	DRAWN BY	MRL
DESCRIPTION	WOOD BEARING WALLS W/ FIBER CEMENT SIDING & CI	STD ISSUE DATE	2019-11
DESCRIPTION	WOOD ROOF TRUSS FRAMING	REVIEWED BY	WLW
DESCRIPTION	FIBER CEMENT PANEL/BATTEN/ALPOLIC PANEL/BRICK EXC. FINISH	DATE ISSUED	01-23-20
SITE ID	015-0071.00.B	SITE ADDRESS	605 SOUTH 7TH STREET, KANSAS CITY, KS
SHEET NO.	E2.2	REV #	1975

PB = Pullbox VIF = Verify
JB = Junction Box

ELECTRICAL SCHEDULE

EC = Electrical Contractor

PB = Pullbox VIF = Verify
JB = Junction Box

LECTRICAL SCHEDULE

EC = Electrical Contractor

emanelson-podas

E
7
E
(9)

e-
PRO
Mag

PROFESSIONAL ENGINEERS
OF CANADA

三

re
the
of
ed.

LLC

idential
be cop
documents
h its is
a later
another P
gineers.
project

卷之三

specification USA, LLC.
tion. The site in
a differ-
ence or
nsed ar-
for reu

McDo

⑤ The drawing
property of
about writing
use on
suitable
drawing
aces of
contract

MRL
E DATE

2019	REVIEWER WL	DATE IS 01-23	RD#19
------	----------------	------------------	-------

BB20

CITY, K
/BRICK

BUILDING


OD/V
W/FIBER
FRAMING
/BATTEN
LESS
H 7TH S

STANDARDS

459	DESCRIPTION	WOOD FIBER	SITE ID	015-00
-----	-------------	------------	---------	--------

0
E
ROU

100% 

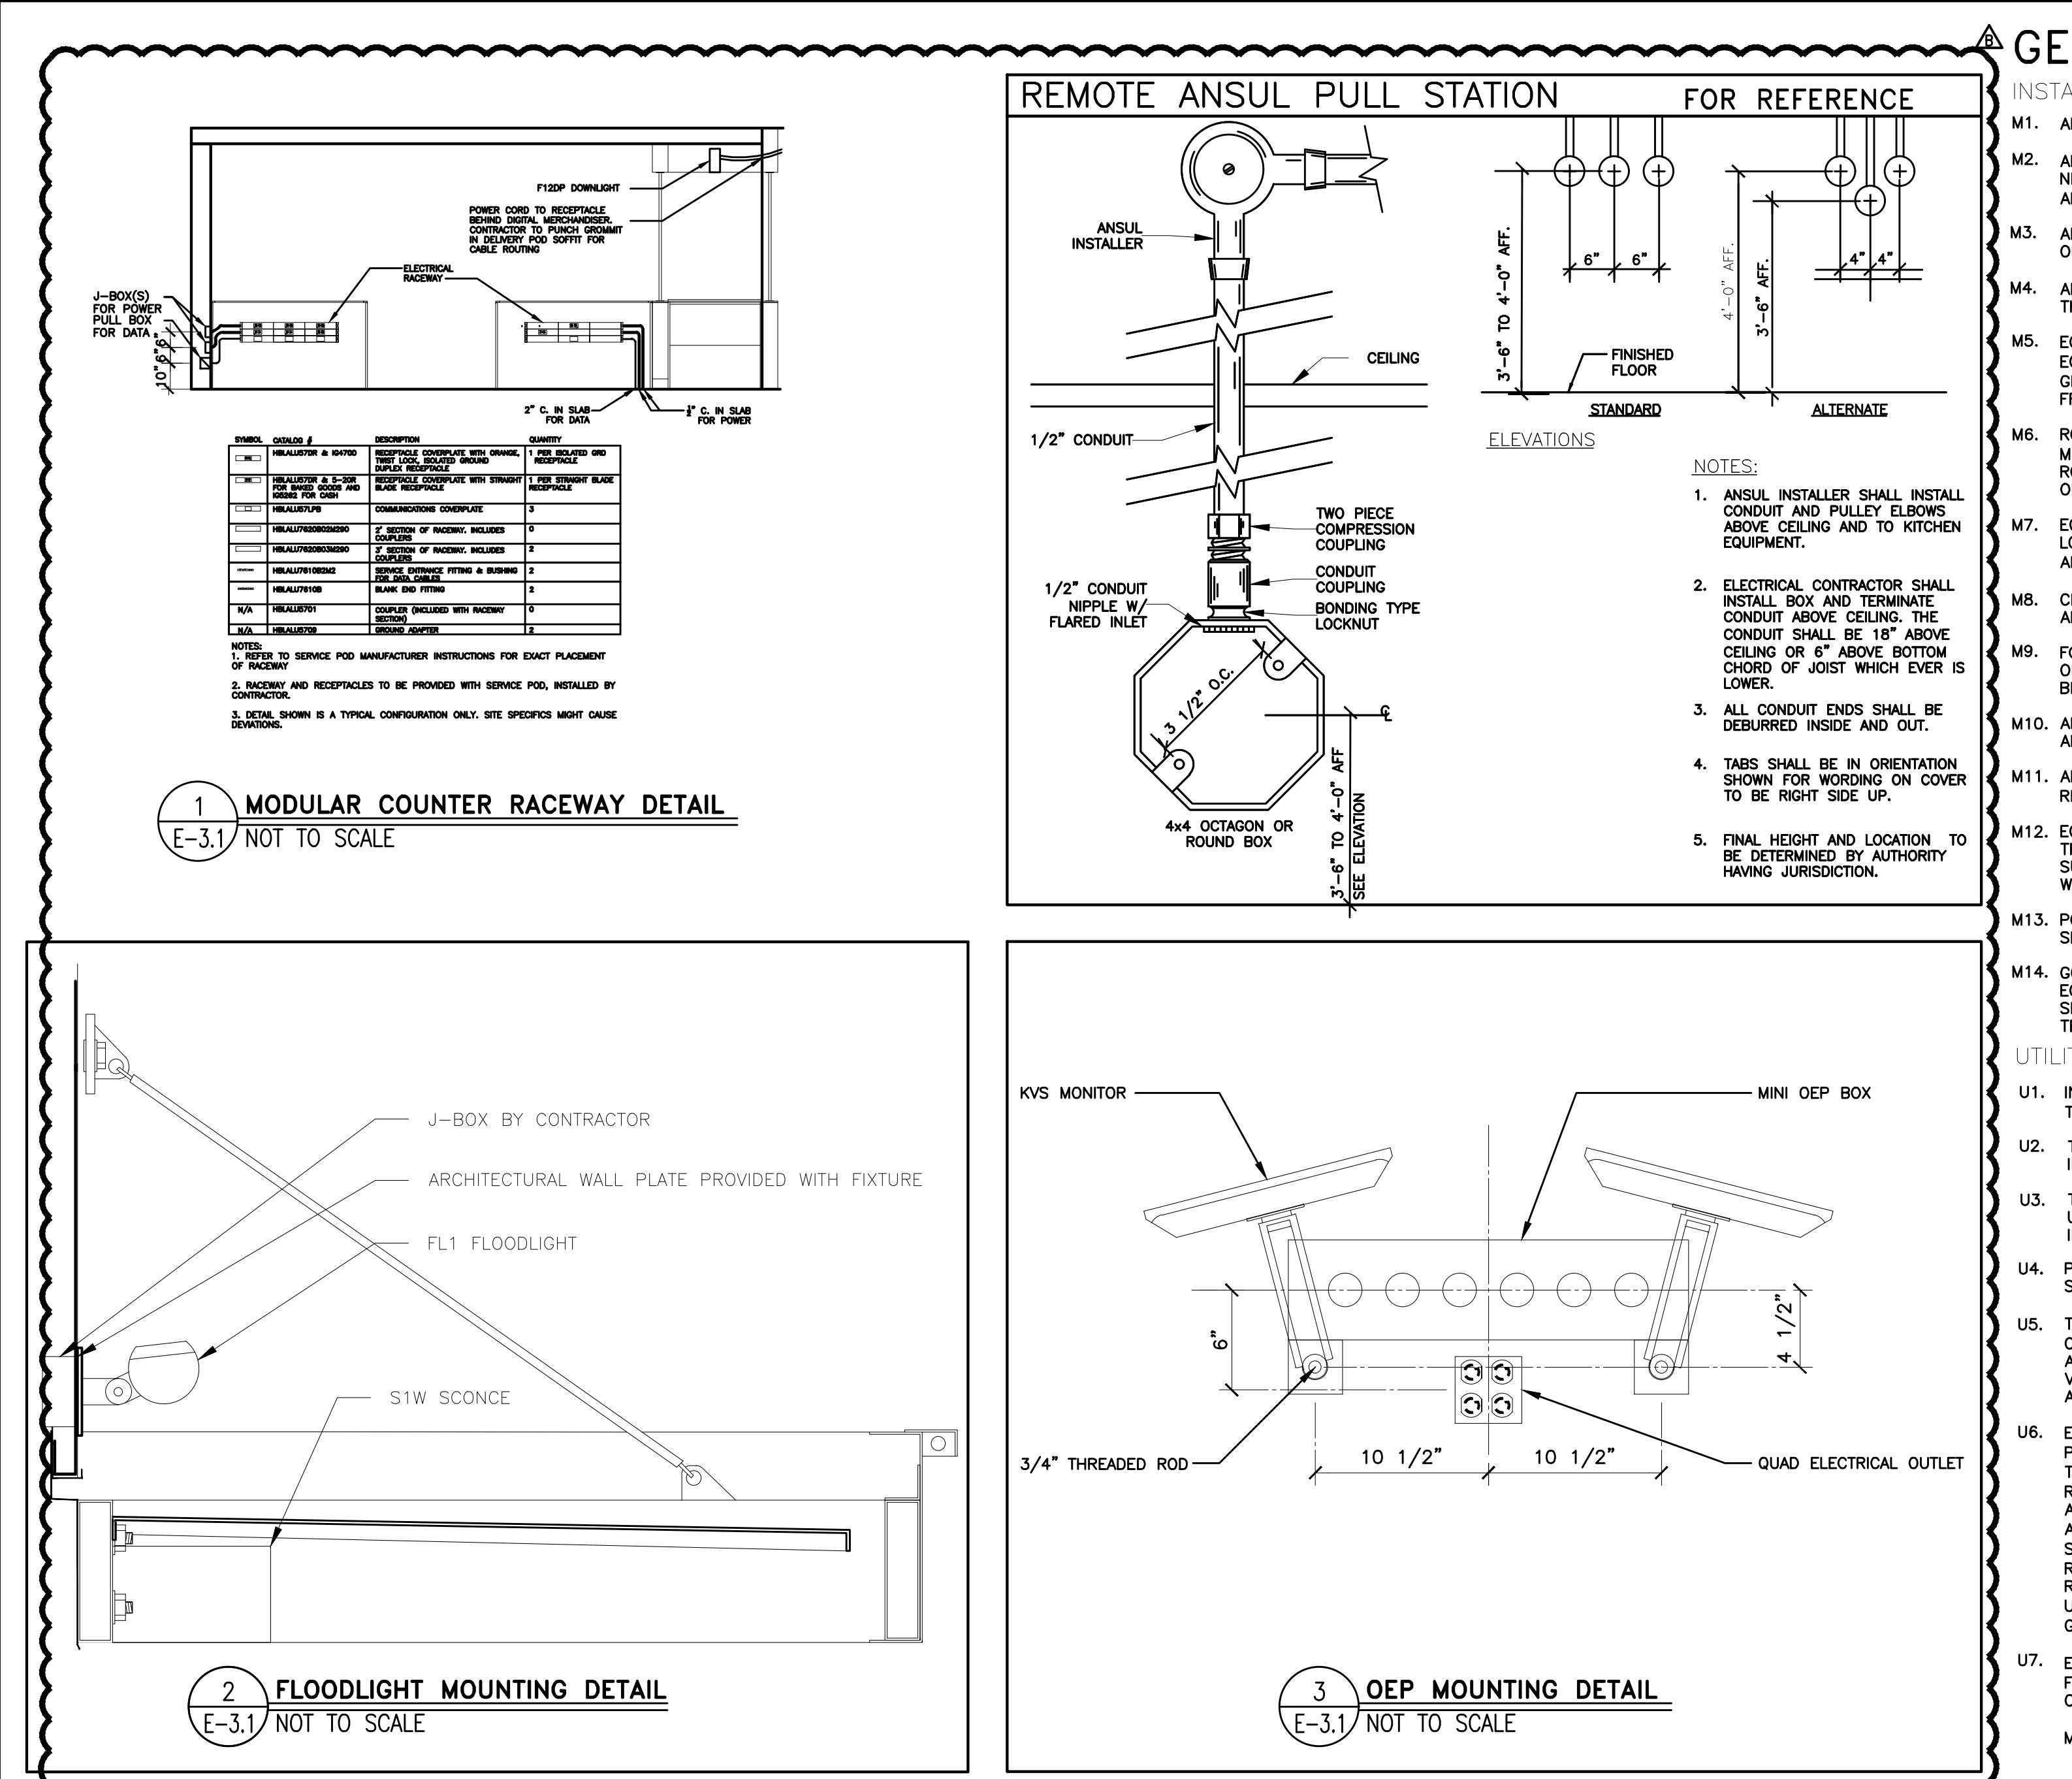

GENERAL ELECTRICAL NOTES:

INSTALLATION METHODS:

- ALL ELECTRICAL MATERIAL USED ON THIS PROJECT SHALL BE "UL" LISTED AND LABELED.
- ALL DIMENSIONS SHOWN ARE TAKEN FROM FACE OF GYP BOARD/PLYWOOD. THE EC SHALL MAKE NECESSARY DIMENSIONAL ALLOWANCES. ALL DIMENSIONS SHOWN ARE TO CENTER LINE OF OUTLET BOX AND/OR RECEPTACLE UNLESS NOTED OTHERWISE.
- ALL J-BOXES, DCOS, AND OTHER ELECTRICAL DEVICES SHOWN SHALL BE RECESSED INTO A WALL, FLOOR OR CEILING UNLESS SPECIFICALLY NOTED OTHERWISE.
- ALL RECEPTACLES (EXCEPT SPECIFIED HUBBELL PIN & SLEEVE TYPES) SHALL BE FURNISHED BY THE EC. THE RECEPTACLES INCLUDING PIN AND SLEEVE TYPE SHALL BE INSTALLED BY THE EC.
- EC SHALL PROVIDE STAINLESS STEEL COVER PLATES ON ALL RECEPTACLES AND J-BOXES. ADDITIONALLY, EC SHALL PROVIDE ORANGE NYLON COVER PLATES MARKED "COMPUTER ONLY" ON ALL ISOLATED GROUND/DEDICATED CIRCUIT RECEPTACLES. PURCHASE PJ8CO (ONE DUPLEX) OR PJ82CO (TWO DUPLEX) FROM HUBBELL.
- ROUGH-INS FOR OPTIONAL EQUIPMENT ARE SHOWN ON THESE SHEETS. EC SHALL VERIFY WITH MCDONALD'S PROJECT MANAGER WHICH OPTIONAL EQUIPMENT IS TO BE INCLUDED AND INSTALL OPTIONAL ROUGH-INS AS REQUIRED. PRICING FOR OPTIONAL ROUGH-INS SHALL BE INCLUDED IN BID AND CALLED OUT AS OPTIONAL.
- EC SHALL COORDINATE WITH KITCHEN EQUIPMENT SUPPLIER, MECHANICAL CONTRACTOR AND GC FOR FINAL LOCATIONS AND CONNECTION REQUIREMENTS OF ALL EQUIPMENT PRIOR TO INSTALLATION OF ANY CONDUIT AND/OR STUB-UP LOCATIONS.
- CEILING MOUNTED ECONOMY OEP BOX IS FURNISHED BY MCDONALD'S, AND INSTALLED BY THE GC. CORD AND PLUG SET FURNISHED BY KES AND INSTALLED BY THE EC.
- FOR GRILLS, FRYERS, AND ANSUL SYSTEMS, EC SHALL EXTEND CONDUIT AND CONDUCTORS DOWN CHASE OR WALL TO TERMINAL BLOCK MOUNTED ON EQUIPMENT AND MAKE FINAL CONNECTIONS TO TERMINAL BLOCKS.
- ALL HOLES IN THE FRONT COUNTER FOR THE POS CORDS AND CABLES SHALL BE LOCATED BY OWNER AND DRILLED BY GC.
- ALL ELECTRICAL CONDUCTORS SHALL BE CONNECTED TO RECEPTACLES USING ONLY THE TERMINAL SCREWS. RECEPTACLE BACK WIRE/QUICK CONNECTIONS SHALL NOT BE USED.
- EC SHALL PROVIDE 208V HEAT TRACE ON THE FREEZER EVAPORATOR CONDENSATE DRAIN LINE. HEAT TRACE SHALL OPERATE CONTINUOUSLY. EC SHALL WIRE HEAT TRACE TO FREEZER EVAPORATOR POWER SUPPLY. A SEPARATE CIRCUIT FOR HEAT TRACE IS NOT REQUIRED. VERIFY HEAT TRACE REQUIREMENTS WITH EVAPORATOR MANUFACTURER.
- POWER AND CONTROL CORDS ARE FURNISHED WITH KITCHEN APPLIANCES. THE EC SHALL CONNECT CORD SETS TO APPLIANCES AS REQUIRED.
- GC SHALL NOT INSTALL CEILING TILE IN AREAS OF THE BEVERAGE BAR REFRIGERATION LINES AND EQUIPMENT PENETRATION LOCATIONS UNTIL THE LINES HAVE BEEN INSTALLED. THE CEILING TILE INSTALLER SHALL RETURN AND INSTALL THE TILES AFTER THE REFRIGERATION LINES HAVE BEEN INSTALLED AND TESTED.

UTILITIES:

- INCOMING SERVICE SHALL BE 208Y/120V, 3 PHASE, 4 WIRE. ANY DEVIATIONS TO THIS SERVICE TYPE SHALL NOT BE PERMITTED UNLESS APPROVED IN WRITING BY MCDONALD'S.
- THE EC SHALL ARRANGE WITH THE ELECTRIC, TELEPHONE, AND OTHER UTILITY COMPANIES FOR INCOMING SERVICE REQUIREMENTS AND SHALL INCLUDE ALL COSTS IN BASE BID.
- THE EC SHALL VERIFY EXACT METHODS AND REQUIREMENTS FOR ELECTRICAL SERVICE WITH LOCAL UTILITY COMPANY. CURRENT TRANSFORMERS SHALL BE INSTALLED OUTSIDE RESTAURANT, LOCATE INSIDE ONLY IF REQUIRED BY UTILITY COMPANY OR LOCAL AUTHORITIES.
- PROVIDE CONCRETE PAD IF TRANSFORMER IS LOCATED ON GRADE AND PROVIDE SECONDARY SERVICE FEEDER AND CONDUITS TO PANEL MDP AS PER LOCAL UTILITY REQUIREMENTS.
- THE EC/GC/ACM SHALL OBTAIN AVAILABLE SHORT CIRCUIT CURRENT FROM THE LOCAL UTILITY COMPANY. THE EC/GC/ACM SHALL ADVISE IN WRITING (FAX SUPPLIER THE UTILITY LETTER) THE AVAILABLE AMOUNT OF FAULT CURRENT. THE PANELBOARD SUPPLIER SHALL BE RESPONSIBLE TO VERIFY THAT THE ELECTRICAL EQUIPMENT SHIPPED HAS APPROPRIATE ELECTRICAL RATINGS WHICH ARE EQUAL TO OR GREATER THAN THE AVAILABLE AMOUNT OF FAULT CURRENT AT THE SITE.
- EC AND ACM OR OWNER/OPERATOR AND ACM SHALL COORDINATE WITH LOCAL PHONE COMPANY TO PROVIDE A 10 PAIR (OR MORE) COUPLE TELEPHONE CABLE FROM THE TELEPHONE UTILITY EASEMENT TO THE RESTAURANT TELEPHONE DEMARCATON POINT. IF THE TELEPHONE PANEL/BOX IS LOCATED INSIDE THE RESTAURANT, EC SHALL PROVIDE (2) EMPTY 3/4" CONDUITS FROM THE TELEPHONE PANEL/BOX UP TO ABOVE THE CEILING FOR FUTURE TELEPHONE CABLE INSTALLATION. ADDITIONALLY, THE EC SHALL PROVIDE AN EMPTY 3/4" CONDUIT FROM THE TELEPHONE PANEL/BOX TO THE LOCATION OF THE FUTURE INTERNET SERVER (VERIFY LOCATION WITH PM). EC SHALL CONNECT, INSTALL AND INCOPRORATE ALL OTHER REQUIREMENTS NECESSARY FOR COMPLETE AND OPERATIONAL TELEPHONE SYSTEM(S) FOR THIS SITE. THE REMAINING UNUSED TELEPHONE CONDUCTOR PAIRS SHALL BE CAPPED AND LEFT IN PLACE FOR FUTURE USE. THE TELEPHONE PANEL/BOX SHALL BE GROUNDED AS SHOWN IN THE "BUILDING ELECTRICAL DRAWING DETAIL".
- EC SHALL PROVIDE A 4" SCHEDULE 40/80 PVC CONDUIT THAT IS SUITABLE FOR DIRECT BURIAL FROM BUILDING TO UTILITY EASEMENT/ROW IN UTILITY CABLING/CONDUIT TRENCH PROVIDED BY GC. CONDUIT SHALL RUN FROM INCOMING TELCOM LOCATION AT BUILDING TO TELECOM PEDESTAL LOCATION IN UTILITY EASEMENT/ROW. VERIFY EXACT LOCATIONS IN FIELD WITH AREA CONSTRUCTION MANAGER AND TELECOM UTILITY PROVIDER PRIOR TO INSTALLATION.

INSTALLATION NOTES:

- IF TELCOM CONDUIT IS TERMINATED WITHIN BUILDING, PVC SHALL TRANSITION TO HWG/RMC TYPE CONDUIT PRIOR TO RISING ABOVE FINISHED SLAB.
- PROVIDE THERMOPLASTIC BUSHINGS AT BOTH ENDS OF CONDUIT FOR CABLING PROTECTION.
- IF 90 DEGREE BENDS ARE REQUIRED, CONTRACTOR SHALL PROVIDE WIDE SWEEPING BENDS TO PREVENT BENDING/DAMAGE TO CABLE.
- ALL COMMUNICATIONS CABLING SHALL BE PULLED VIA THIS CONDUIT.
- INSTALL A MINIMUM OF 6 PULL WIRES IN CONDUIT TO ALLOW FOR THE INSTALLATION OF FUTURE CABLING. USE NON-DEGRADING POLYPROPYLENE OR MONOFILAMENT PLASTIC LINE OR #12 AWG SOLID COPPER CONDUCTOR. WIRES MUST NOT BE GREATER THAN 20% OF TENSILE STRENGTH. PROVIDE AT LEAST 12 INCHES OF SLACK AT EACH END OF PULL WIRE.
- AFTER INSTALLATION OF COMMUNICATIONS CABLING AND PULLSTRINGS/WIRES, CONTRACTOR SHALL SEAL BOTH ENDS OF CONDUIT TO PREVENT INTRUSION FROM WEATHER, RODENTS, DEBRIS, ETC. SEAL SHALL BE OF TYPE TO ALLOW FOR REMOVAL FOR INSTALLATION OF FUTURE CABLING

CONDUIT AND WIRE:

- THE FOLLOWING WIRING METHODS SHALL NOT BE USED: NON-METALLIC SHEATHED CABLE (ROMEX, NM, NMC, & NMS), ARMORED CABLE TYPE AC (BX), ELECTRICAL NON-METALLIC TUBING, TYPE ENT (SMURF-TUBE).
- CONDUTR RUNS MAY BE COMBINED EXCEPT WHERE ISOLATED GROUNDS ARE USED. IG CIRCUITS SHALL BE RUN IN SEPARATE CONDUITS. ALL HOME RUNS SHALL BE SIZED BASED ON DERATED CONDUCTOR AMPACITIES AND INCREASE CONDUIT AND WIRE SIZE AS REQUIRED BY NEC SECTION 310 REQUIREMENTS.
- CONDUTR SHALL HAVE A MAXIMUM OF 4 BENDS WITHOUT A JUNCTION BOX TO PREVENT DAMAGE TO CABLE DURING PULLING. THE EC SHALL PIGTAIL #12 PULL WIRE AT EACH END FOR INSTALLER TO PULL CABLE. ALL LOW VOLTAGE CONDUIT STUB-UPS SHALL BE PROVIDED WITH A BUSHING.
- MINIMUM WIRE SIZE SHALL BE #12 AWG COPPER UNLESS NOTED OTHERWISE. MINIMUM CONDUIT SIZE SHALL BE 1/2" UNLESS NOTED OTHERWISE. Wires installed outdoors shall be THW.
- CONDUCTORS #10 AWG AND SMALLER SHALL BE SOLID COPPER. CONDUCTORS #8 AND LARGER SHALL BE STRANDED COPPER. ALUMINUM CONDUCTORS SHALL NOT BE UTILIZED FOR FEEDER OR BRANCH CIRCUIT DISTRIBUTION.
- RACEWAYS SHALL BE ANY OF THE FOLLOWING MATERIALS, INSTALLED IN ACCORDANCE WITH ALL APPLICABLE CODES:

OUTDOORS: (FOR SPECIFIC APPLICATIONS AND APPROPRIATE FITTINGS, SEE TABLE W6)

- EXPOSED: RMC, IMC.
- CONCEALED: RMC, IMC.
- BELLOW GRADE: SINGLE RUN: RNC, RMC.
- BELLOW GRADE: GROUPED: RNC, RMC.
- CONNECTION TO VIBRATING EQUIPMENT (INCLUDING TRANSFORMERS AND HYDRAULIC, PNEUMATIC, ELECTRIC SOLENOID, OR MOTOR-DRIVEN EQUIPMENT): LFMC.
- BOXES AND ENCLOSURES: NEMA 250, TYPE 3R OR 4.

INDOORS: (FOR SPECIFIC APPLICATIONS AND APPROPRIATE FITTINGS, SEE TABLE W6)

- EXPOSED: EMT, IMC.
 - CONCEALED: EMT, IMC.
- (CONTINUED ON TOP)

- CONNECTION TO VIBRATING EQUIPMENT (INCLUDING TRANSFORMERS AND HYDRAULIC, PNEUMATIC, ELECTRIC SOLENOID, OR MOTOR-DRIVEN EQUIPMENT): FMC; EXCEPT USE LFMC IN DAMP OR WET LOCATIONS.
- DAMP OR WET LOCATIONS: RIGID STEEL CONDUIT.
- BOXES AND ENCLOSURES: NEMA 250, TYPE 1, EXCEPT AS FOLLOWS: A. DAMP, WET OR KITCHEN LOCATIONS: NEMA 250, TYPE 4, STAINLESS STEEL.

TABLE W6:

LOCATION	208V.	480V.	LOW ENERGY*
INDOORS	< 1" EMT COMPRESS. FTGS >1.25" IMC THREADED FTGS	IMC THREADED FTGS	EMT COMPR. FTGS
OUTDOORS	RMC OR IMC THREADED FTGS	RMC OR IMC THREADED FTGS	
CONCEALED			
WALLS	<2" EMT SET SCREW FTGS >2.5" IMC THREADED FTGS	<2" EMT SET SCREW FTGS >2.5" IMC THREADED FTGS	EMT 1/2" - 2" SET SCREW FTGS 2.5" - 4" COMPR. FTGS
AIR HANDLING CEILING/SPACE	<2" EMT COMP. FTGS >2.5" IMC THREADED. FTGS	<2" EMT COMP. FTGS < 2.5" IMC THREADED. FTGS	EMT COMP. FTGS
NON-AIR HANDLING CEILING/SPACE	<2" EMT SET SCREW FTGS >2.5" IMC THREADED. FTGS	<2" EMT COMP. FTGS >2.5" IMC THREADED. FTGS	EMT 1/2" - 2" SET SCREW FTGS 2.5" - 4" COMP. FTGS
BELLOW GRADE			
INTERIOR	IMC THREADED FTGS OR SCHEDULE 40 OR 80 PVC	IMC THREADED FTGS	IMC THREADED FTGS SCHEDULE 40 OR 80 PVC
EXTERIOR	SCHEDULE 40 OR 80 PVC OR RMC THREADED FTGS	SCHEDULE 40 OR 80 PVC OR RMC THREADED FTGS	SCHEDULE 40 OR 80 PVC OR RMC THREADED FTGS

W7. ALL CONDUITS PENETRATING THE FREEZER/COOLER BOX SHALL BE SEALED IN COMPLIANCE NEC SECTION 300 AND THE FREEZER/COOLER BOX MANUFACTURERS REQUIREMENTS.

W8. PROVIDE THREE (3) 3/4" EMPTY CONDUITS FROM PANEL LP-1 UP TO THE CEILING SPACE AND CAP FOR FUTURE USE.

GROUNDING:

- ALL BRANCH AND FEEDER CIRCUITS SHALL BE GROUNDED BY TWO METHODS. THE FIRST METHOD SHALL INCLUDE AN INSULATED COPPER EQUIPMENT GROUNDING CONDUCTOR CONTAINED WITHIN THE SAME CONDUIT AS THE PHASE CIRCUIT CONDUCTORS AND SIZED PER NEC SECTION 250 REQUIREMENTS. THIS INSULATED EQUIPMENT GROUNDING CONDUCTOR SHALL HAVE ONE END PROPERLY TERMINATED AT THE EQUIPMENT GROUND BUS IN THE CORRESPONDING CIRCUIT BREAKER PANEL, AND THE OTHER END TERMINATED AT THE GROUNDING CONTACT OF A GROUNDING RECEPTACLE AND TO THE JUNCTION BOX OR TO AN EQUIPMENT CABINET, APPLICABLE. THE SECOND METHOD PROVIDES EQUIPMENT GROUNDING VIA METALLIC CONDUIT THAT IS CONNECTED AND TERMINATED IN FITTINGS LISTED FOR GROUNDING PER NEC SECTION 250 REQUIREMENTS. BOTH GROUNDING METHODS ARE REQUIRED IN A MCDONALD'S RESTAURANT. ISOLATED GROUND SHALL BE INSTALLED WHERE INDICATED ON PLAN AND AS SHOWN IN POS ISOLATED GROUND/DEDICATED CIRCUIT DETAIL ON SHEET E4.2.
- THE BUILDING GROUNDING SYSTEM SHALL COMPLY WITH NEC ARTICLE 250. MCDONALD'S SPECIFICATIONS, AND SHEET E4.2. CAUTION: IT IS A SAFETY HAZARD AND AN NEC VIOLATION TO HAVE ANY NEUTRAL TO GROUND CONNECTIONS BEYOND THE MAIN ELECTRICAL DISCONNECT MEANS. MCDONALD'S GROUNDING STANDARDS PURPOSELY EXCEED THOSE GIVEN BY THE NEC. THE EC SHALL PROVIDE A BUILDING GROUNDING SYSTEM MEETING NEC SECTION 250 REQUIREMENTS AS WELL AS MCDONALD'S STANDARDS.
- EC SHALL REFER TO "POS ISOLATED GROUND/DEDICATED CIRCUIT DETAIL, SHEET E4.2, FOR REQUIRED WIRING REQUIREMENTS OF COMPUTER PANEL CP."
- METAL RACEWAYS CONTAINING A GROUNDING ELECTRODE CONDUCTOR SHALL BE BONDED AT BOTH ENDS AS REQUIRED BY NEC SECTION 250 REQUIREMENTS.

TEMPERATURE CONTROLS:

- REMOTE TEMPERATURE SENSORS: EC SHALL PROVIDE 1/2" CONDUIT FROM JUNCTION BOX ABOVE CEILING DOWN TO SENSOR MOUNTED AT 4'-0" TO 4'-6" AFF.
- SEE DETAIL ON SHEET M3.0 FOR SENSOR MOUNTING DETAIL. LOCATION OF WALL MOUNTED TEMPERATURE SENSORS ARE SHOWN ON SHEET M1.2 AND E2.0.
- WHEN WIRING FOR PROGRAMMABLE THERMOSTATS AND REMOTE SENSORS IS NOT IN A CONDUIT, THE WIRING SHALL BE RUN TO THE UNDERSIDE OF THE ROOF DECK. NONE OF THE WIRING SHALL BE ROUTED OVER FLUORESCENT BALASTS, POWER BOXES OR IN A CONDUIT WITH LINE VOLTAGE WIRING AS ELECTRICAL INTERFERENCE (NOISE) WILL CAUSE ERRATIC CONTROL OPERATION. ALL THERMOSTATS SHALL BE MOUNTED 4'-0" AFF.

FLAT PANEL TELEVISIONS:

- EC SHALL PROVIDE A DUPLEX RECEPTACLE AND A LOW VOLTAGE BROADBAND CONNECTION FOR THE INSTALLATION OF FLAT PANEL TELEVISIONS. COORDINATE EXACT LOCATIONS WITH DECOR COMPANY. FOR BROADBAND CONNECTION, EC SHALL PROVIDE A 4 X 4 BOX WITH A 3/4" CONDUIT STUB-UP WITH A BUSHING INTO ACCESSIBLE CEILING SPACE.

ELECTRICAL PANELS:

- THE EC SHALL BE RESPONSIBLE FOR BALANCING THE LOADS ON ALL PANELS.
- THE EC SHALL PROVIDE ELECTRICAL SERVICE TO THE EQUIPMENT MOUNTED BREAKER PANEL. SEE ELECTRICAL ROUGH-IN PLAN AND SCHEDULE FOR ALL REQUIREMENTS.
- THE EC SHALL BE RESPONSIBLE FOR THE PROPER IDENTIFICATION AND LABELING OF ALL CIRCUIT BREAKERS. EACH PANEL SHALL BE PROVIDED WITH AN ACCURATE TYPEWRITTEN CIRCUIT DIRECTORY AT THE CONCLUSION OF THE PROJECT AND PRIOR TO RESTAURANT OPENING.

SECURITY AND DRIVE-THRU CAMERAS:

- EC TO PROVIDE ELECTRICAL POWER AND COMMUNICATION CONDUITS FOR BUILDING MOUNTED SECURITY AND DRIVE THRU CAMERAS. COORDINATE FINAL LOCATIONS WITH SECURITY AND DRIVE THRU CAMERA INSTALLERS.


LIGHTING:



- PROVIDE A WEATHERPROOF JUNCTION BOX IN PARAPET FOR FASCIA SIGN. FINAL CONNECTION BY OTHERS.
- COORDINATE THE LOCATION OF JUNCTION BOX (IN THE WALL) WITH THE OPENING IN TRELLIS (FOR THE LIGHT FIXTURE WIRES). THE LOCATION OF THE JUNCTION BOX AND THE OPENING IN THE TRELLIS SHALL BE ALIGNED FOR THE LIGHT FIXTURE TO BE INSTALLED PROPERLY. COORDINATE INSTALLATION OF JUNCTION BOX AND ANY NECESSARY OPENINGS IN TRELLIS WITH GC AND TRELLIS/CANOPY MANUFACTURER. SEE LIGHT FIXTURE INSTALLATION INSTRUCTIONS FOR REQUIREMENTS REGARDING MOUNTING BRACKETS FOR USE IN C-CHANNEL TRELLISES.
- EC SHALL FIELD VERIFY THAT LIGHT FIXTURES DO NOT OBSTRUCT OR CONFLICT WITH THE WORK OF OTHER TRADES. IF A DISCREPANCY IS FOUND, THE EC SHALL IMMEDIATELY NOTIFY THE GC BEFORE THE INSTALLATION OF SUCH FIXTURE(S). EC SHALL COORDINATE LOCATIONS OF ALL LIGHT FIXTURES IN DINING AREA WITH FINAL SEATING AND DECOR PLANS.
- IF PC-POS CASH REGISTER SYSTEM IS INSTALLED, EC SHALL RELOCATE FIXTURES ABOVE FRONT COUNTER TO AVOID GLARE ON THE CASH REGISTER SCREENS. EC SHALL INSTALL CABLE WHIP TO FIXTURES SO THAT FIXTURE MAY BE RELOCATED FOUR FEET WITHOUT DISCONNECTING CABLE WHIP.
- EC SHALL COORDINATE LOCATION OF ALL EXTERIOR LIGHTS TO AVOID INTERFERENCE WITH ANY CORBELS, TRUSSES, BEAMS OR OTHER SPECIAL EXTERIOR TREATMENTS. INSTALL LIGHT FIXTURES WITH CORRECT ORIENTATION PER MANUFACTURER'S INSTRUCTIONS.
- THE USE OF INTERLOCK TYPE "MC" CABLE IN LENGTHS OF 6 FEET OR LESS (WHERE PERMITTED BY LOCAL CODES) SHALL BE ALLOWED FOR WIRING TO INTERIOR LIGHTING FIXTURES. "ROMEX" OR "BX" SHALL NOT BE USED.
- EC SHALL VERIFY THAT NOT MORE THAN 3% VOLTAGE DROP EXISTS FROM THE LIGHTING PANEL TO ANY EXTERIOR LIGHTING FIXTURE OR SIGN/BALLET.
- WHERE MCDONALD'S RESTAURANT HAS A PLAYPLACE, THE EC SHALL COORDINATE EXACT LOCATION OF PLAYPLACE LIGHTING WITH PLAYPLACE TOY VENDOR FOR MAXIMUM ILLUMINATION AND SAFETY PER THE FINAL LOCATION OF THE PLAYPLACE TOY. LIGHTING FIXTURES SHALL NOT BE MOUNTED TO THE TOY OR ANY PART OF THE TOY STRUCTURE.
- EC SHALL VERIFY ALL TAP SETTINGS FOR H.I.D. LIGHTING FIXTURES AND MAKE ANY NECESSARY CORRECTIONS PRIOR TO INSTALLATION.

PREPARED BY:		© 2020 McDonald's USA, LLC	
McDonald's USA, LLC		These drawings and specifications are the confidential and proprietary property of McDonald's USA, LLC and shall not be copied or reproduced without the express written consent of McDonald's USA, LLC. These drawings and specifications are to be used only in connection with the project for which they were prepared. They are not suitable for use on a different site or at a later time. Use of these drawings for reference or example on another project requires the prior written permission of the project's architect and engineer. Reproduction of these contract documents for reuse on another project is not authorized.	
DRAWN BY: MRL		STD ISSUE DATE: 2019-11	REVIEWED BY: WLW
TITLE: 2019 STANDARD BUILDING - BB20		DATE ISSUED: 01-23-20	FILE# 1975
DESCRIPTION: 4597F10-WOOD/WOOD		SITE ID: 015-0071.00-B	SITE ADDRESS: 605 SOUTH 7TH STREET, KANSAS CITY, KS
SHEET NO. E3.1		NOTES & DETAILS	

Matthew W. Ellis
LICENSED
PROFESSIONAL ENGINEER
17667
KANSAS
12/03/20







Emmanuelson-podas
consulting engineers
Emmanuelson-Podas, Inc.
Edna, IN 46528
(920) 930-0050 | www.eppinc.com

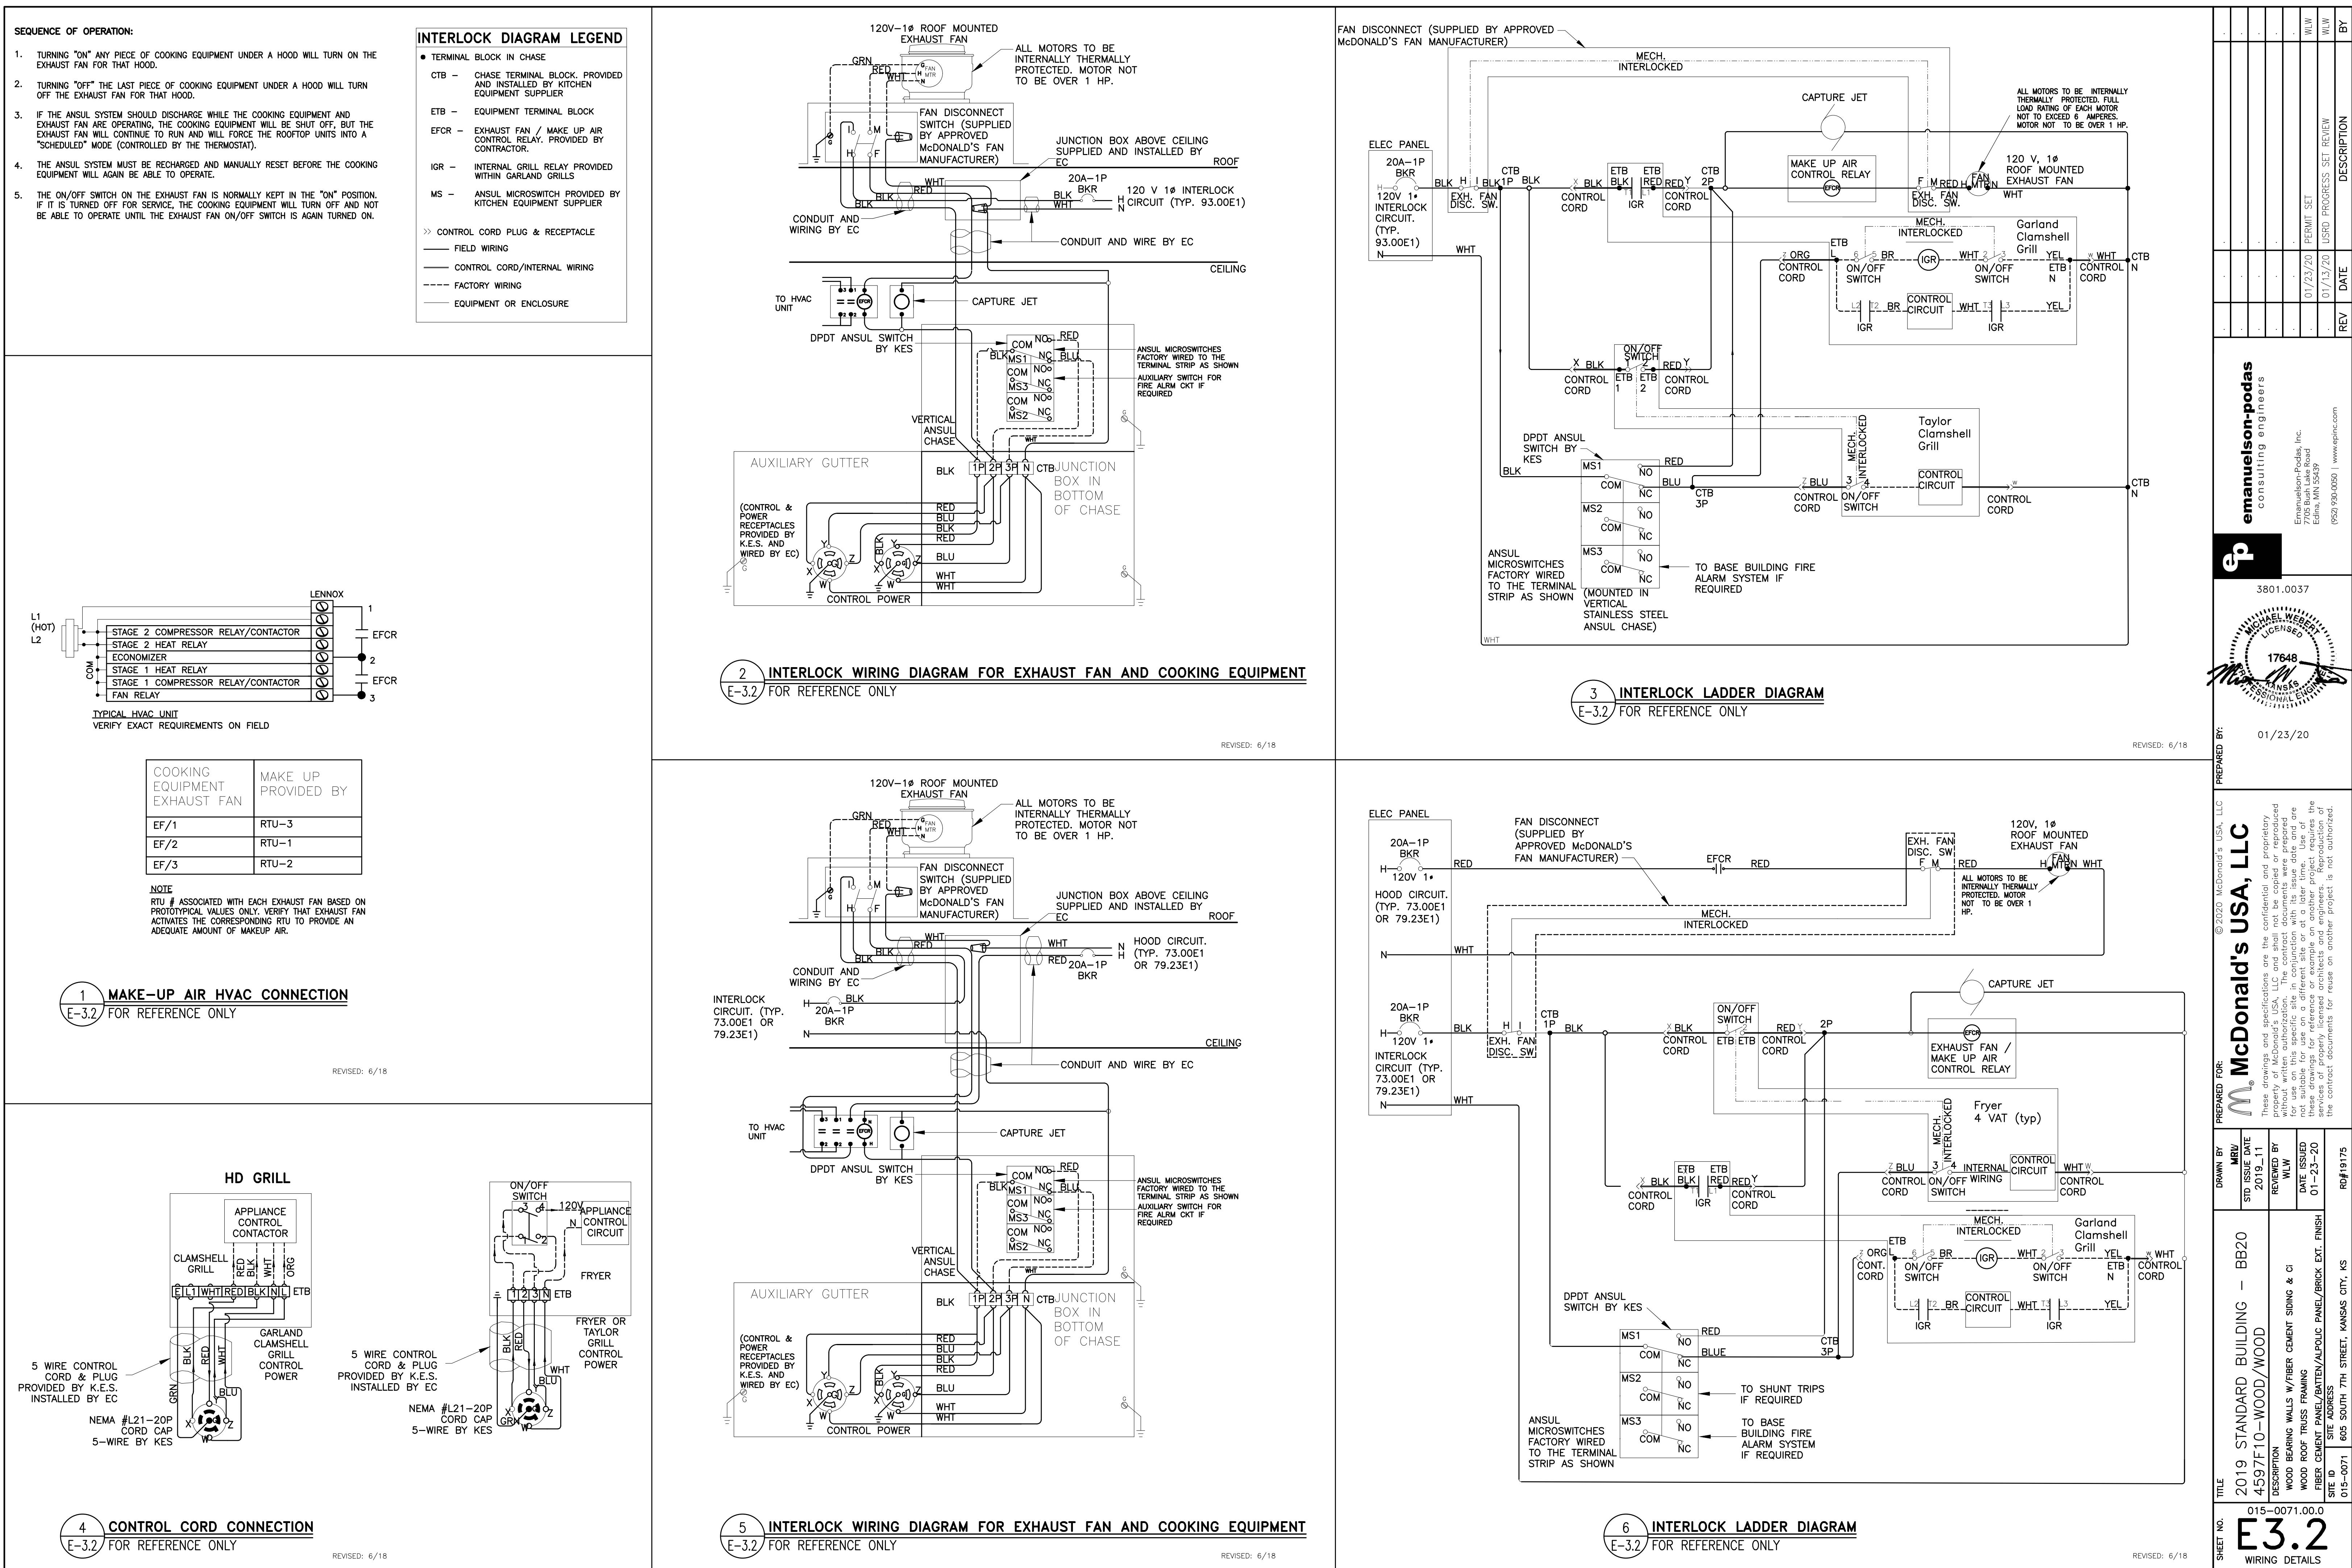

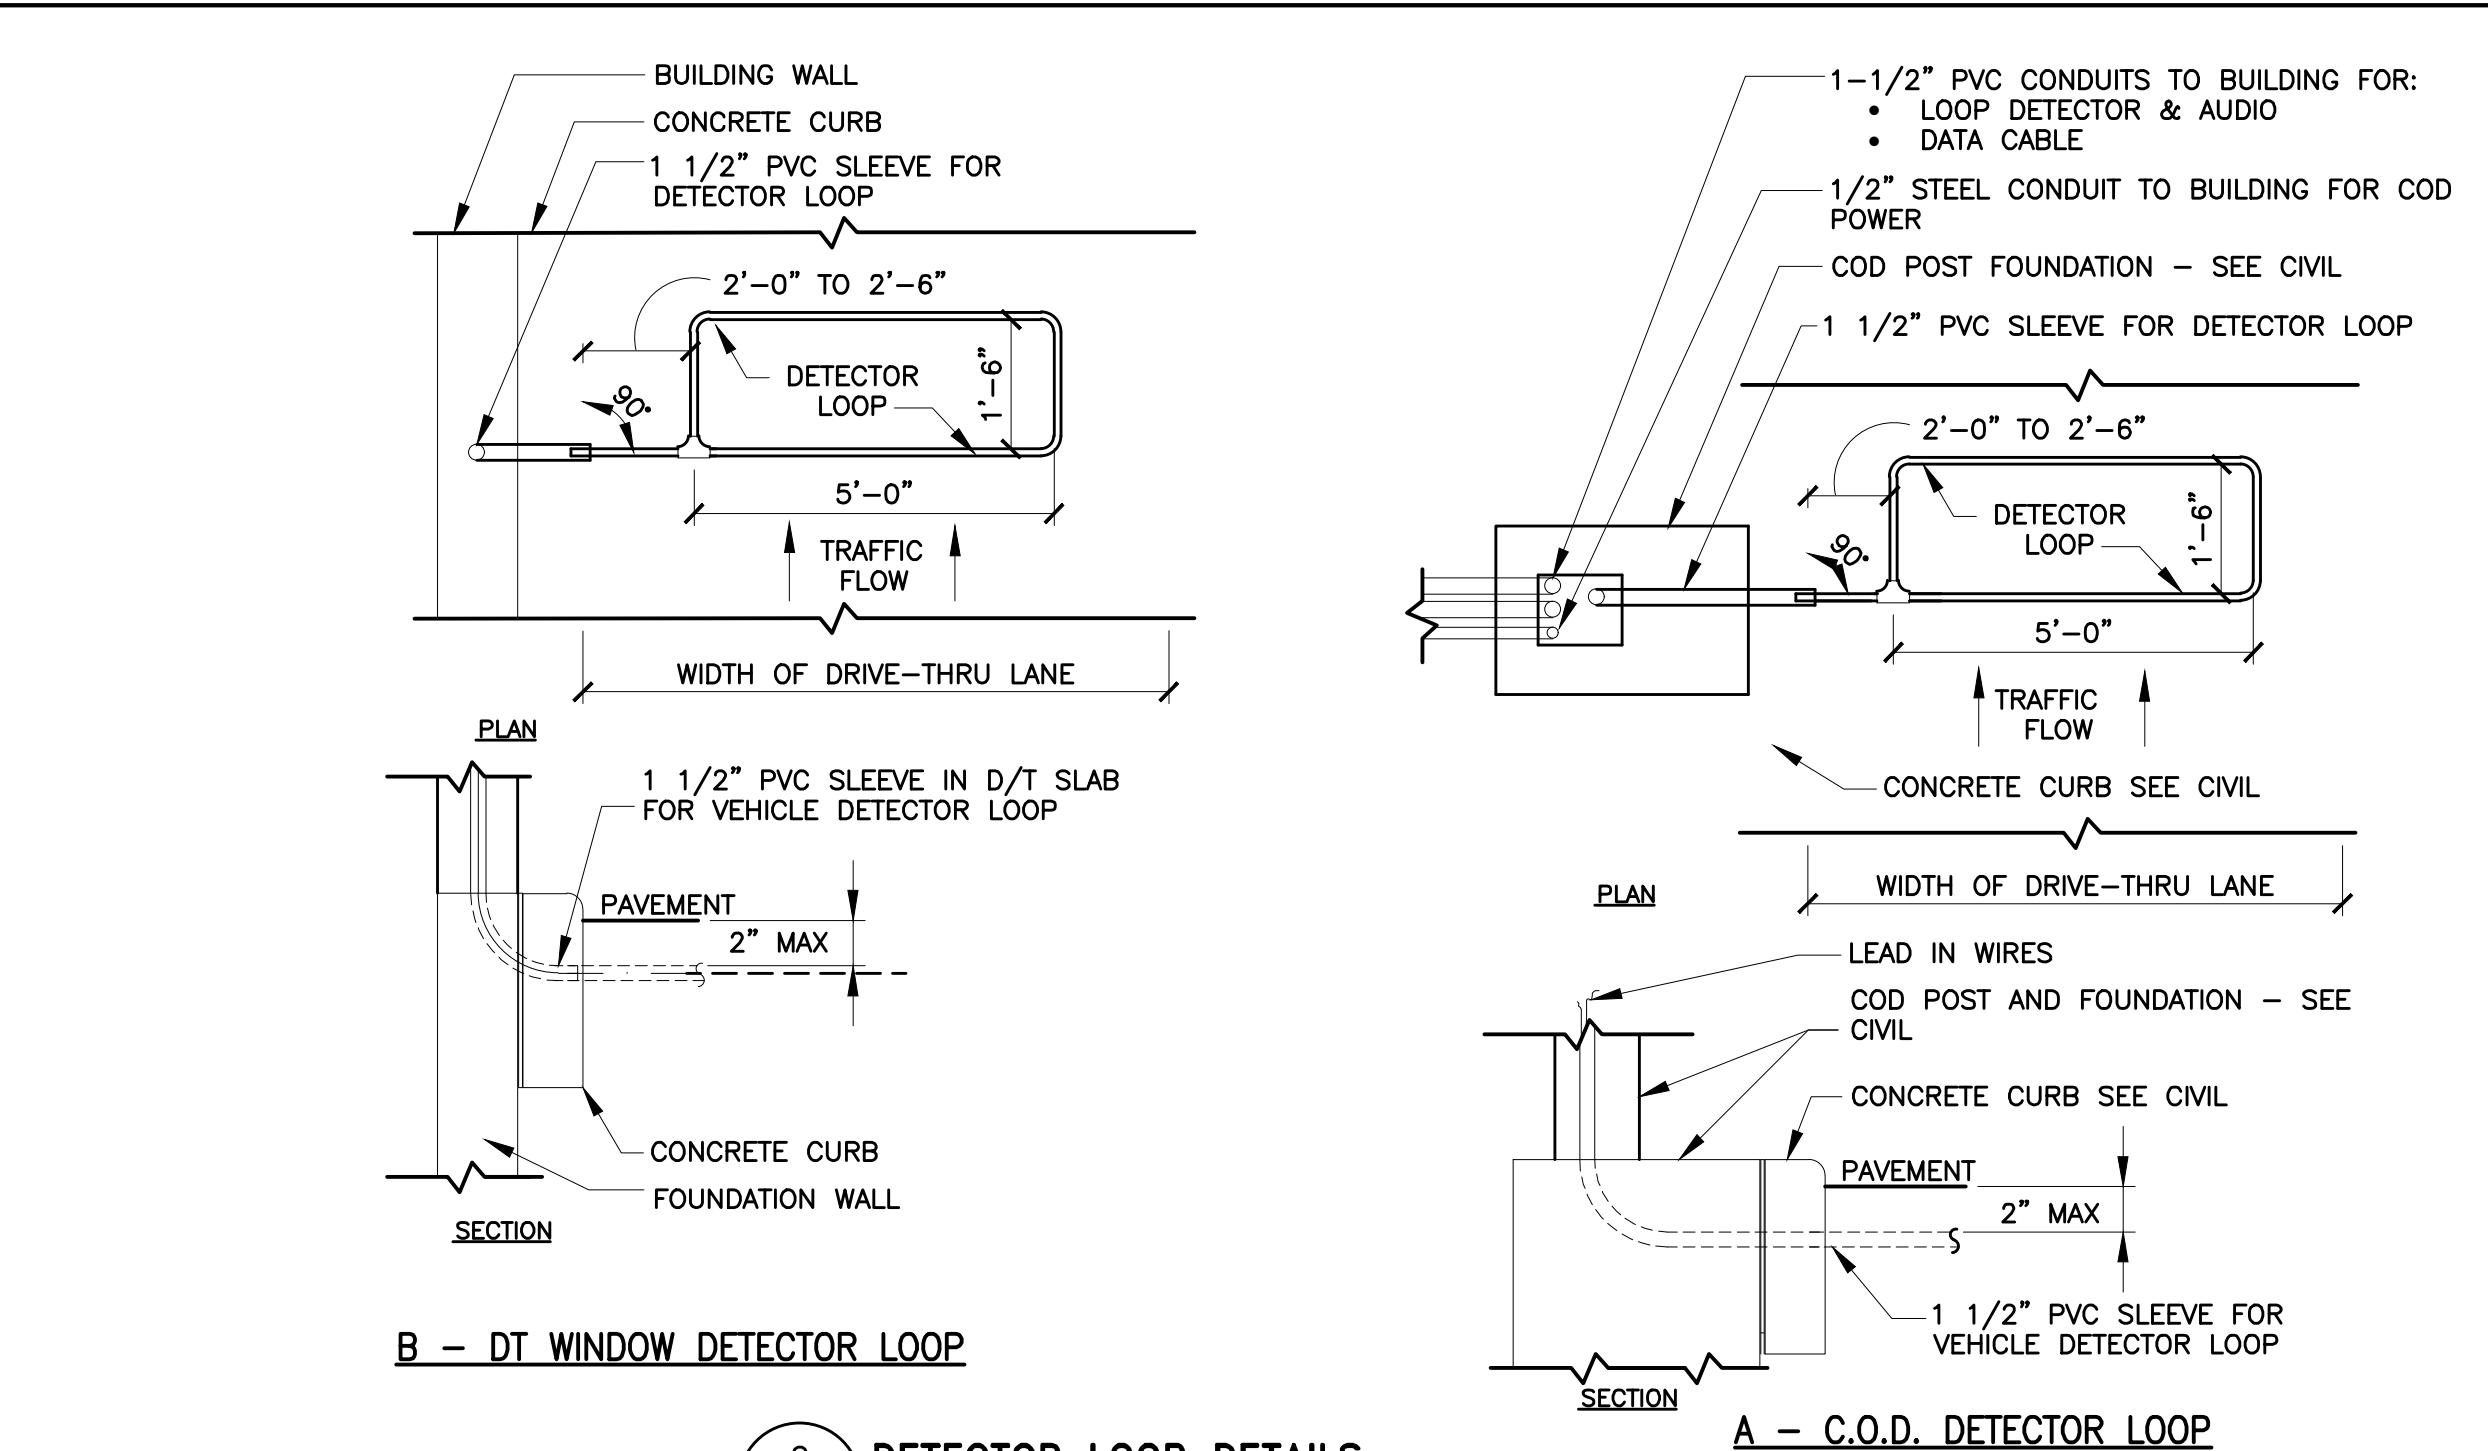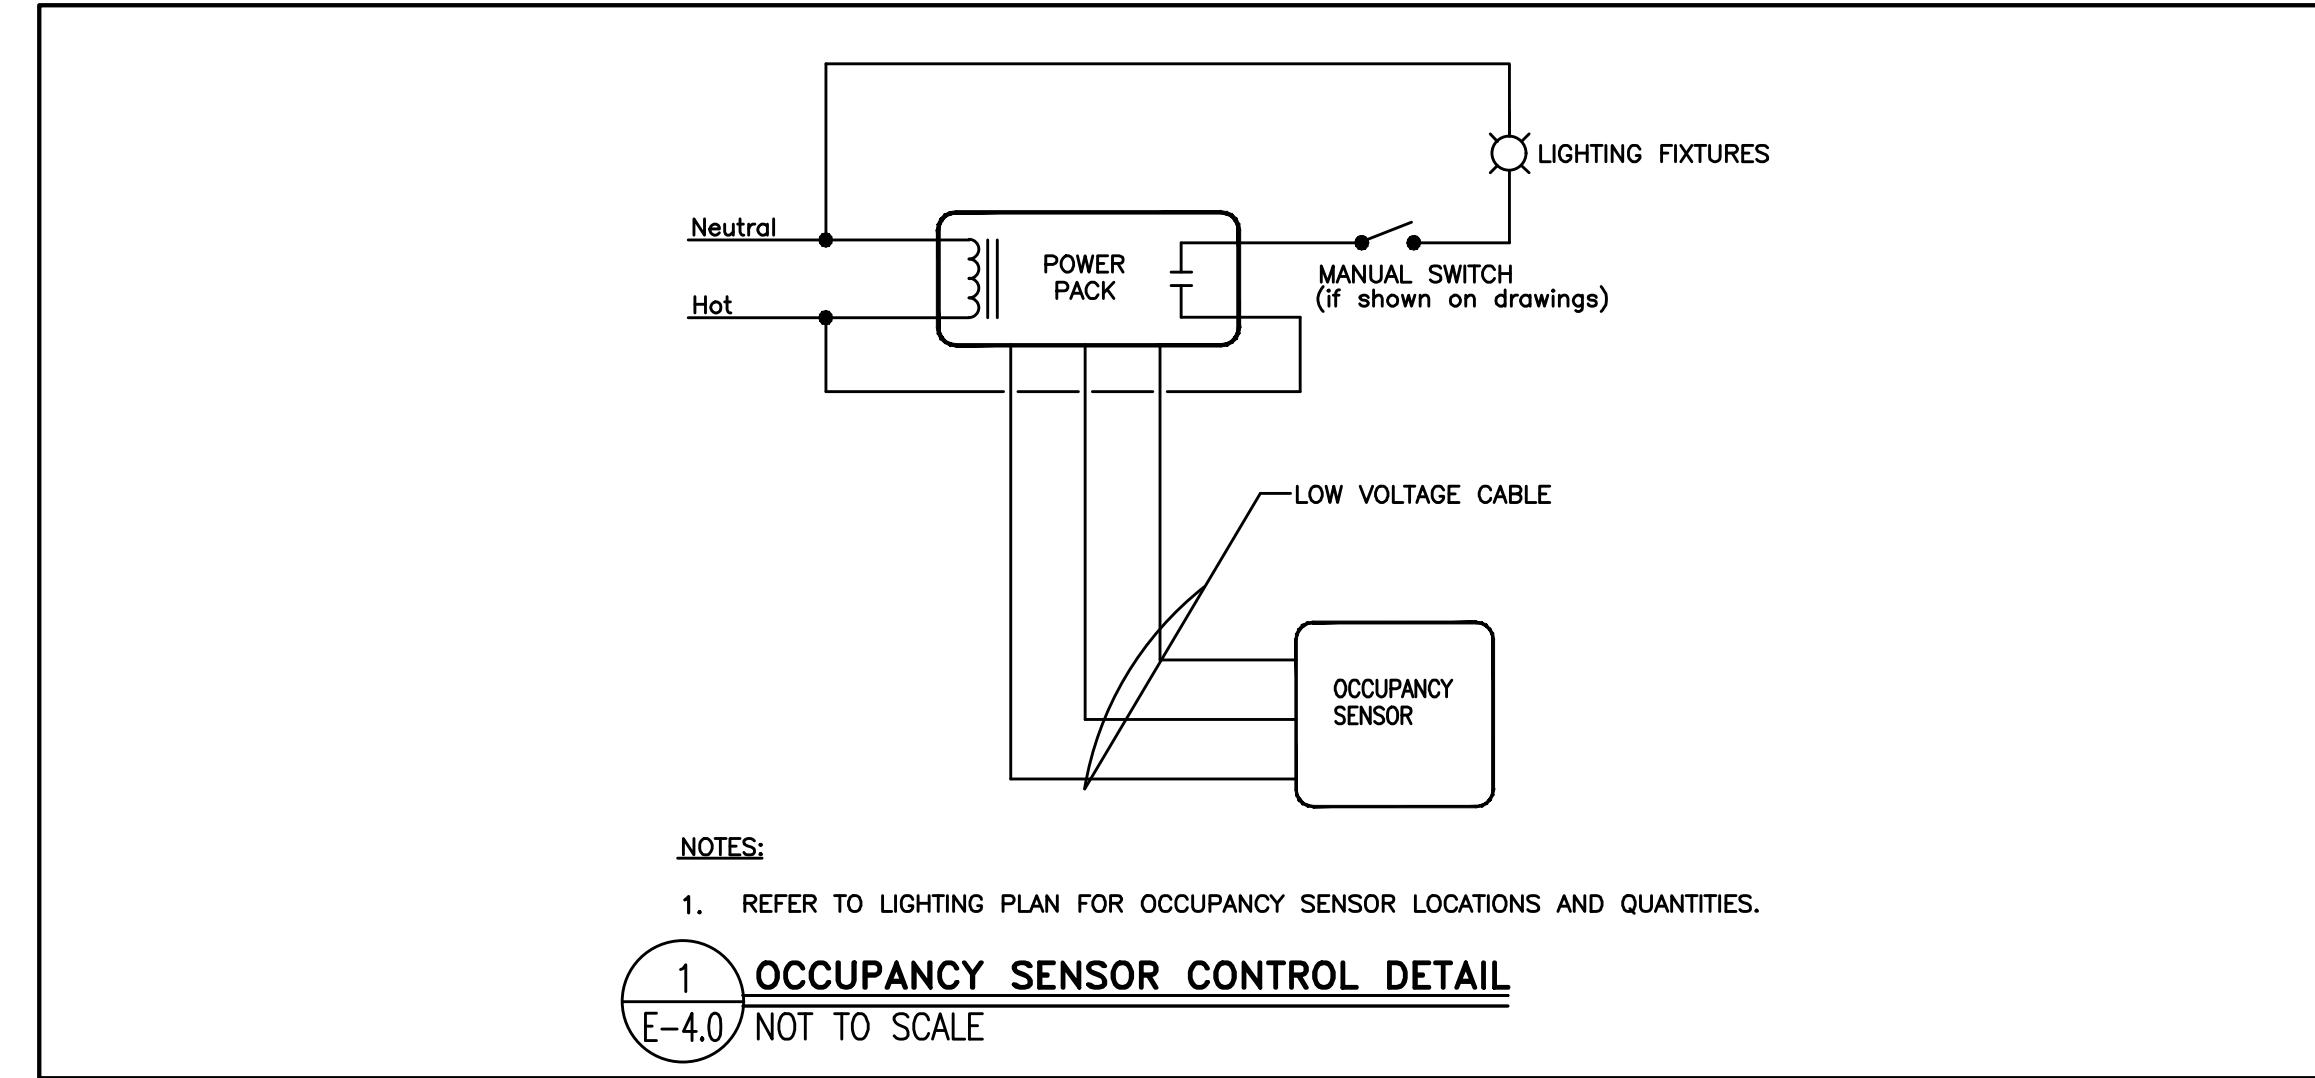


NOTES

1. VERIFY CONDUIT SIZES AND LAYOUT WITH DETECTOR LOOP MANUFACTURER.
2. CENTER VEHICLE DETECTOR LOOP (ITEM # 217.11E1) IN DRIVE THRU LANE. INSTALL PER MFR. RECOMMENDATIONS.
3. SEE CIVIL FOR DIMENSIONS OF DRIVE-THRU LANE CONCRETE PAD FOR DETECTOR LOOP.
4. NO STEEL (REBAR OR ELECTRICAL WIRE) SHALL BE USED WITHIN 2' OF LOOP.
5. DETECTOR LOOP MANUFACTURERS:
DETECTOR LOOPS MAY BE BY ONE OF THE FOLLOWINGS COMPANIES OR EQUAL.
3M: 1-800-328-0033
HME: 1-800-848-4468
6. DETECTOR LOOP MATERIAL:
PVC TUBING 1/2" I.D. 100 PSI LOOP MADE FROM ONE LENGTH OF THIN FOURTEEN GAUGE STRANDED WIRE. LEAD-IN IS PRE-TWISTED AT FACTORY.
7. DETECTOR LOOP CONSTRUCTION:
FORMED WITH ONE CONTINUOUS LENGTH OF PVC WITH NO SHARP CORNERS AS DETAILED. WIRE LOOPED, FORMED, & PIGTAILED AS DETAILED.

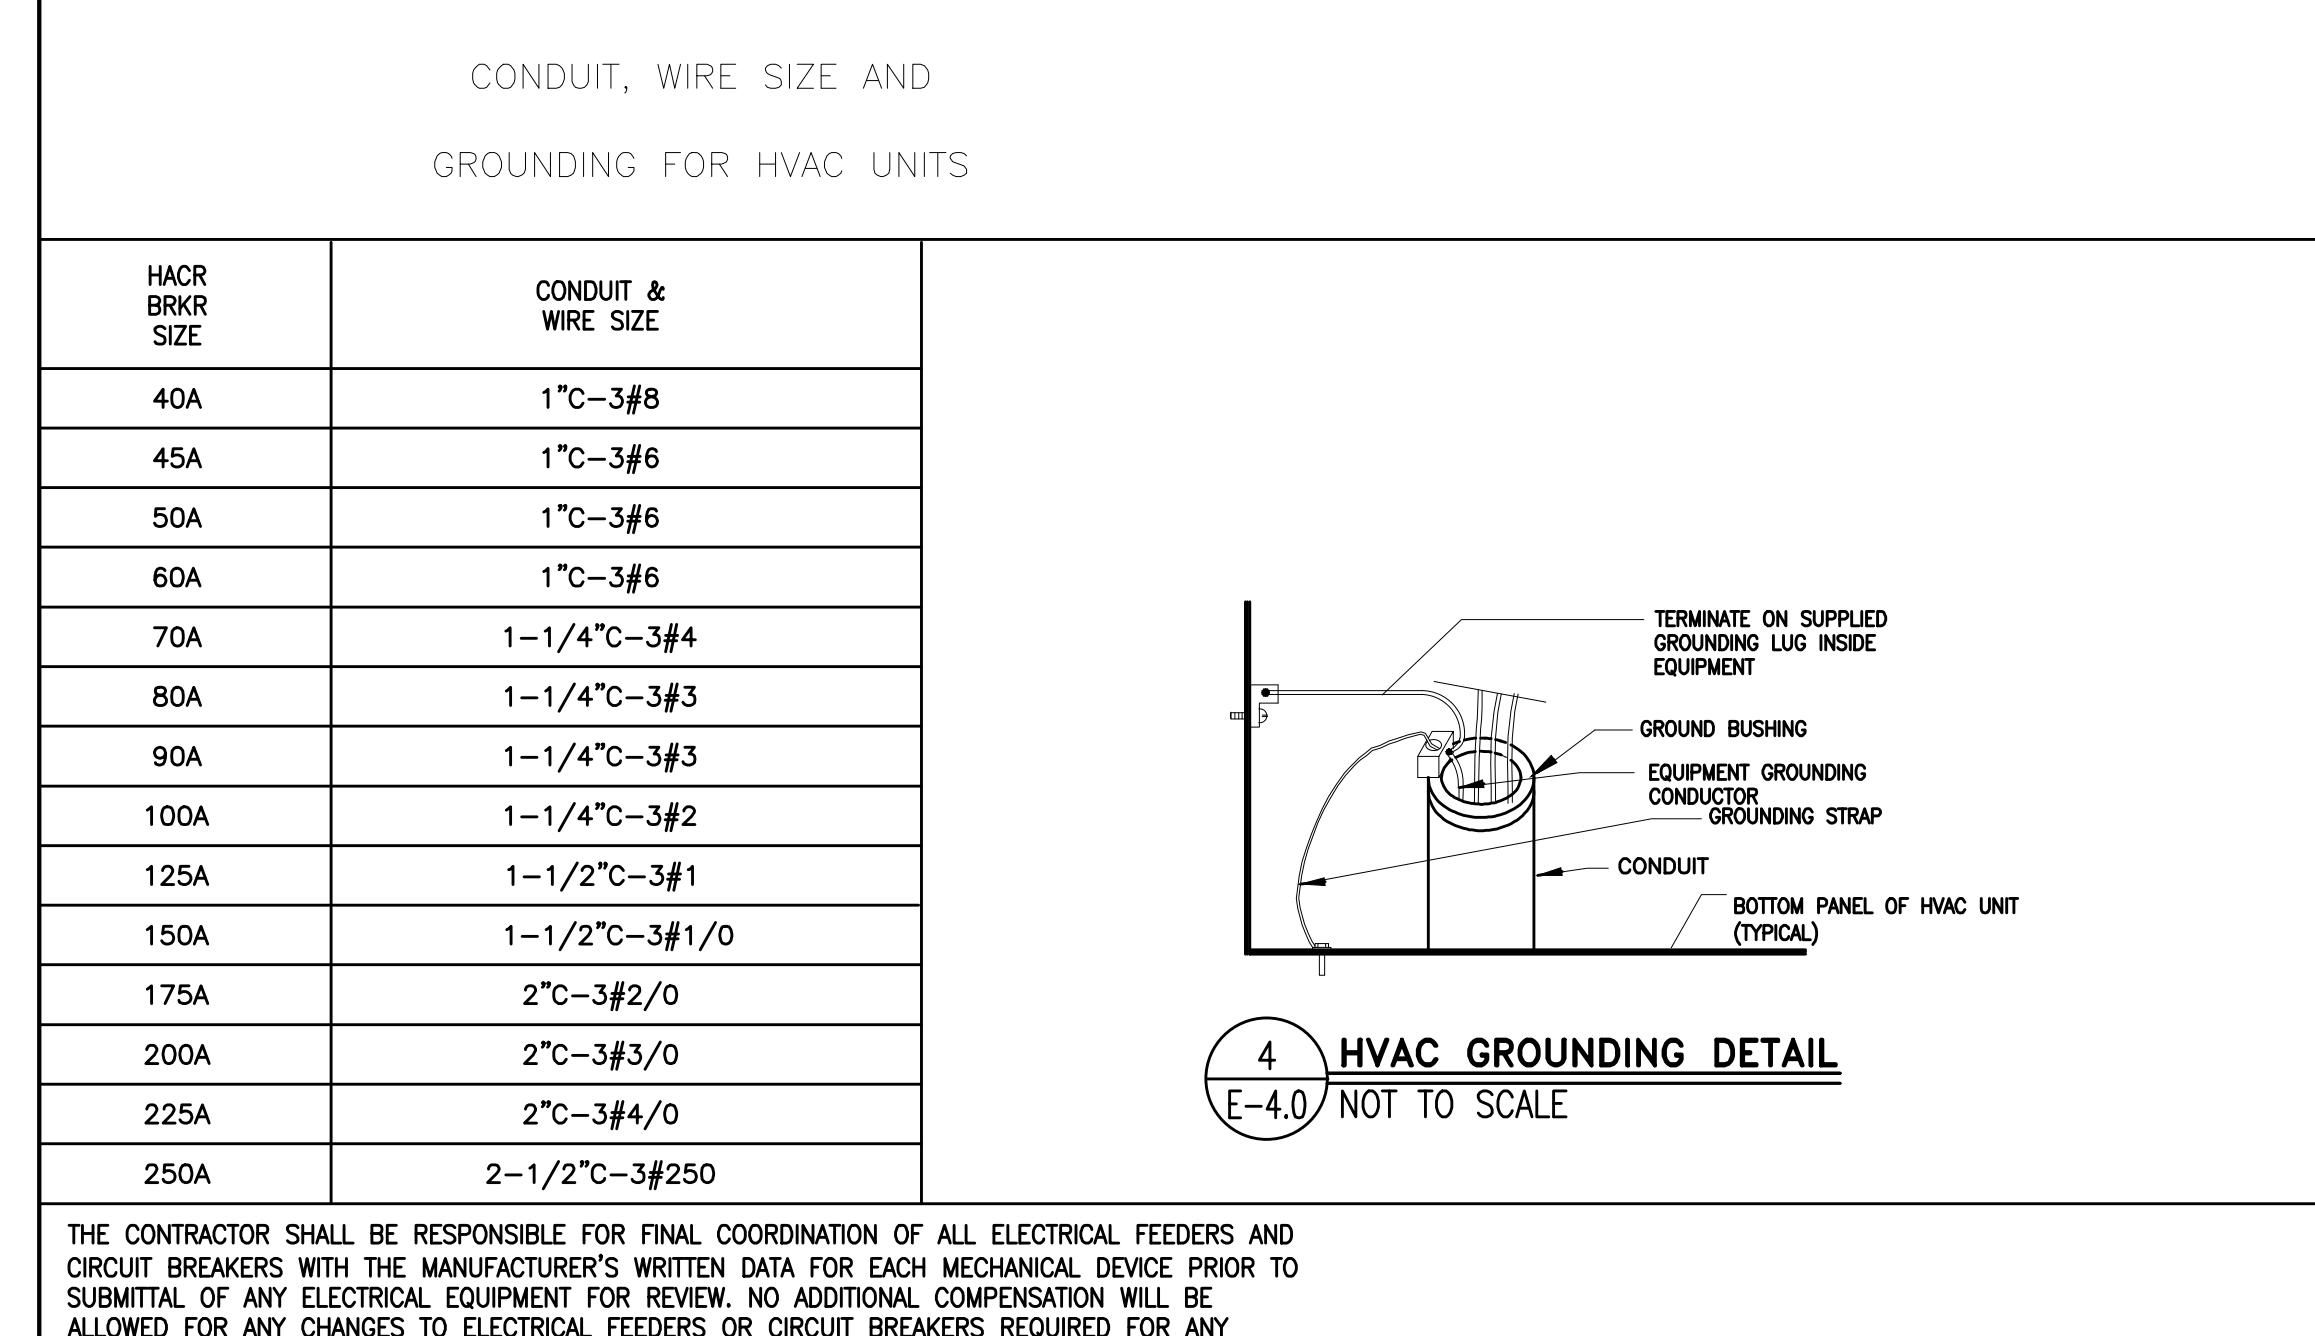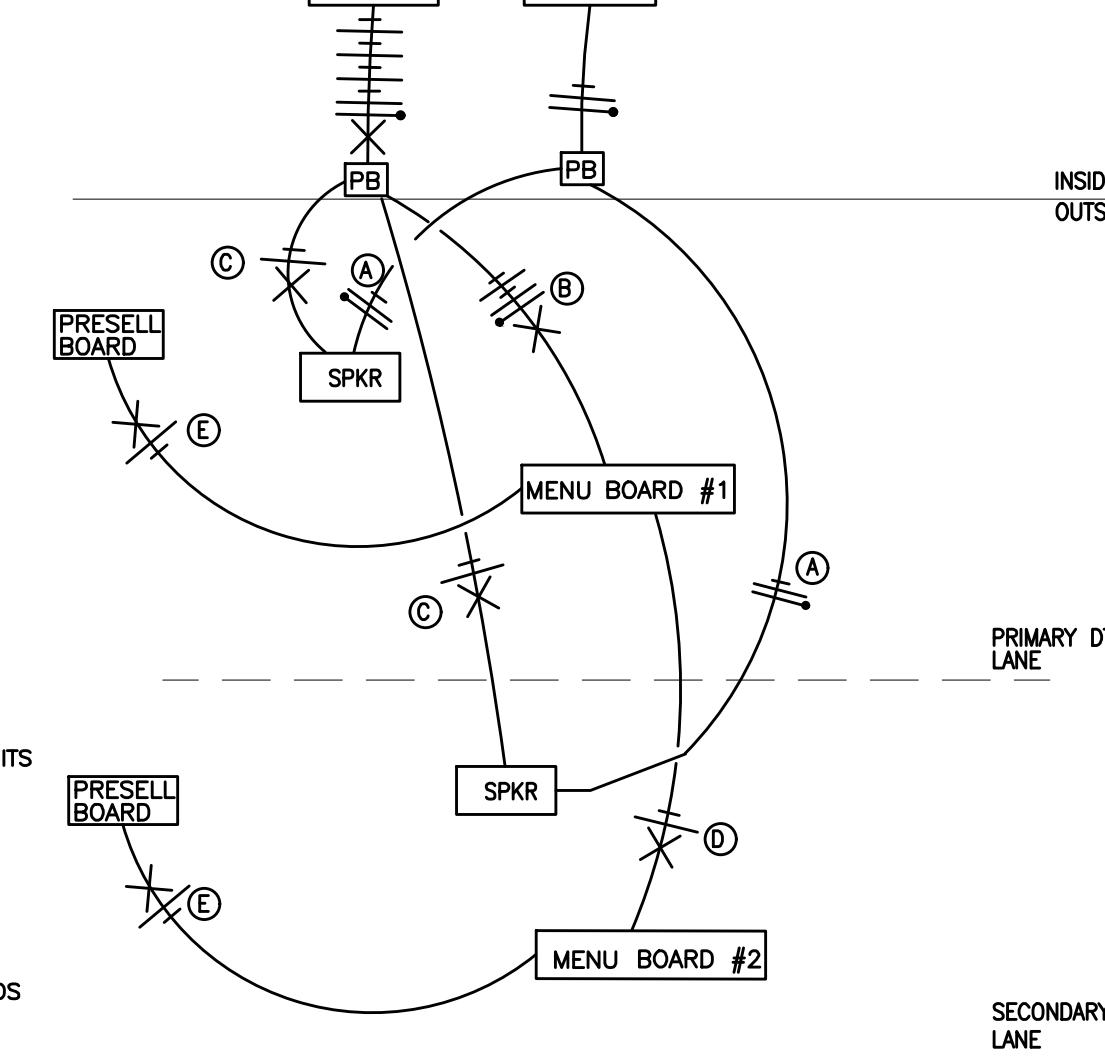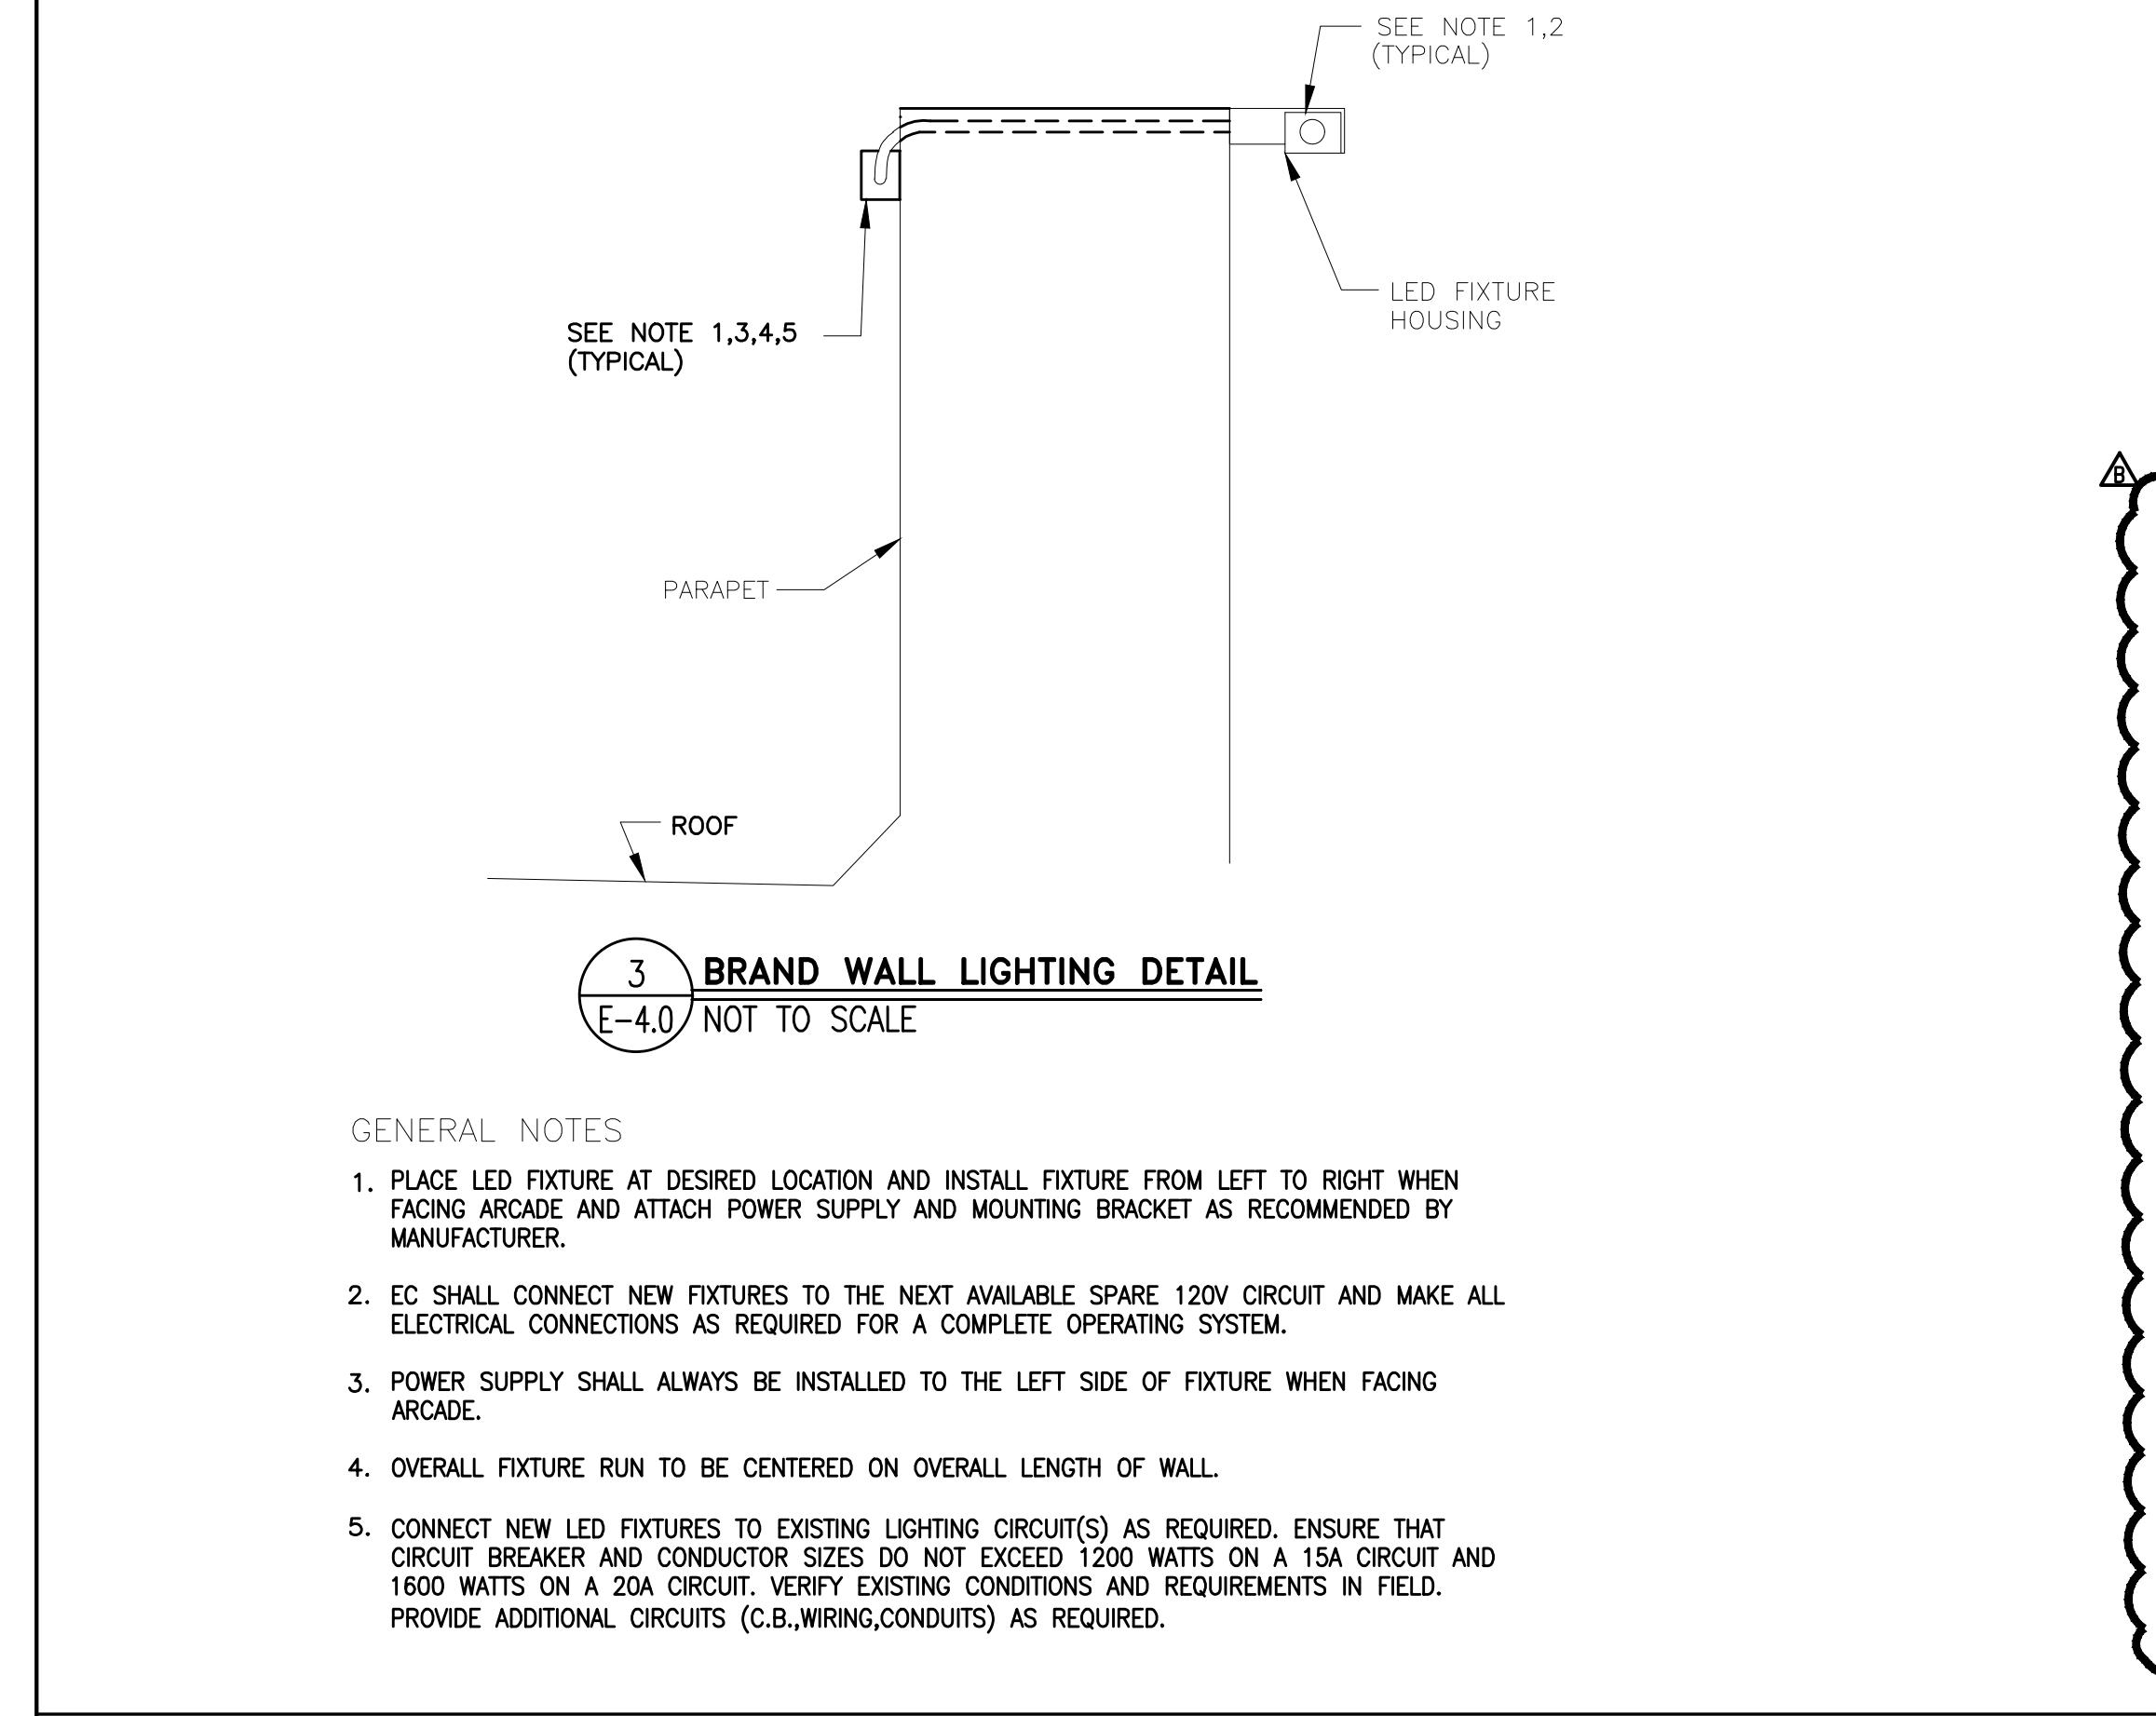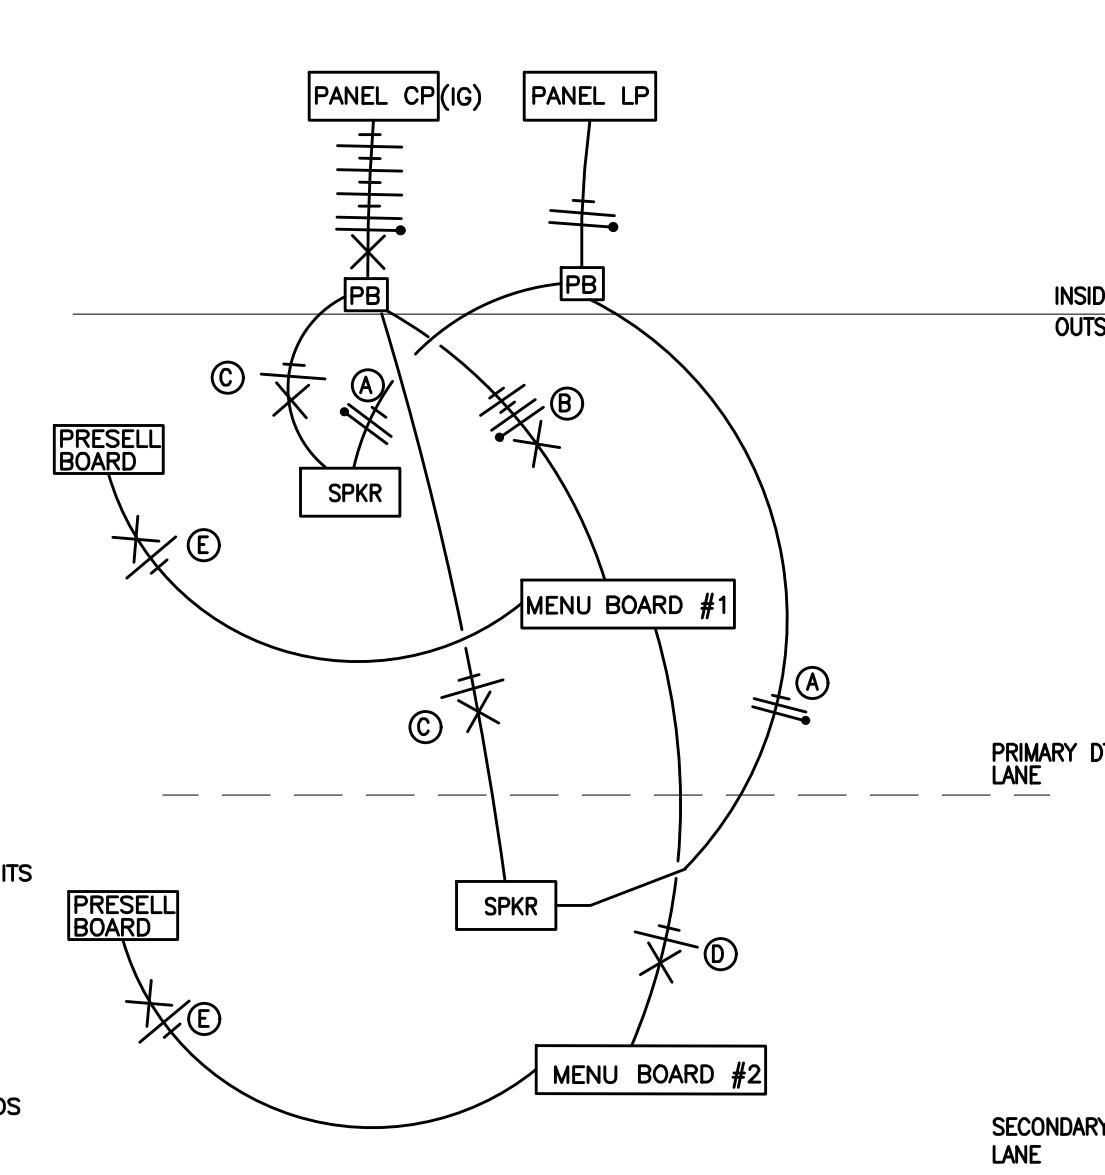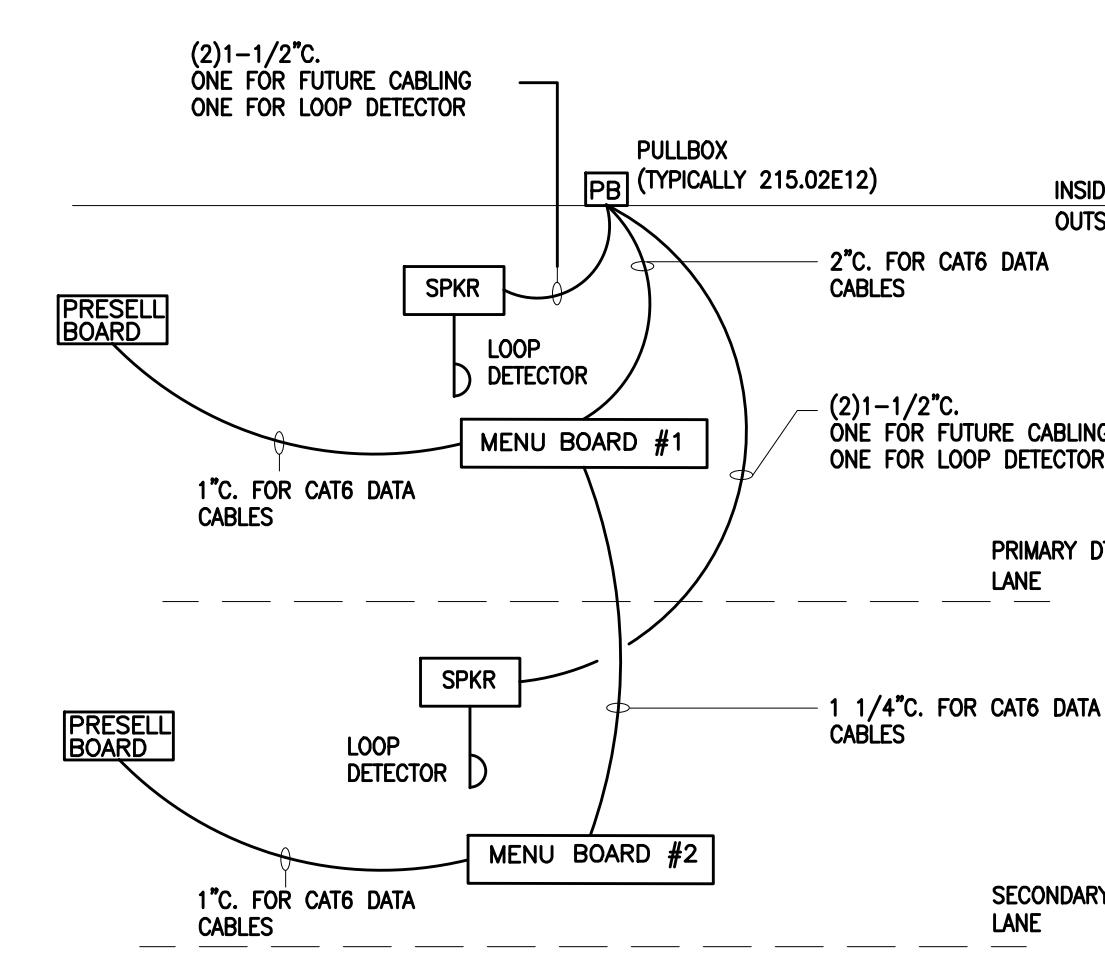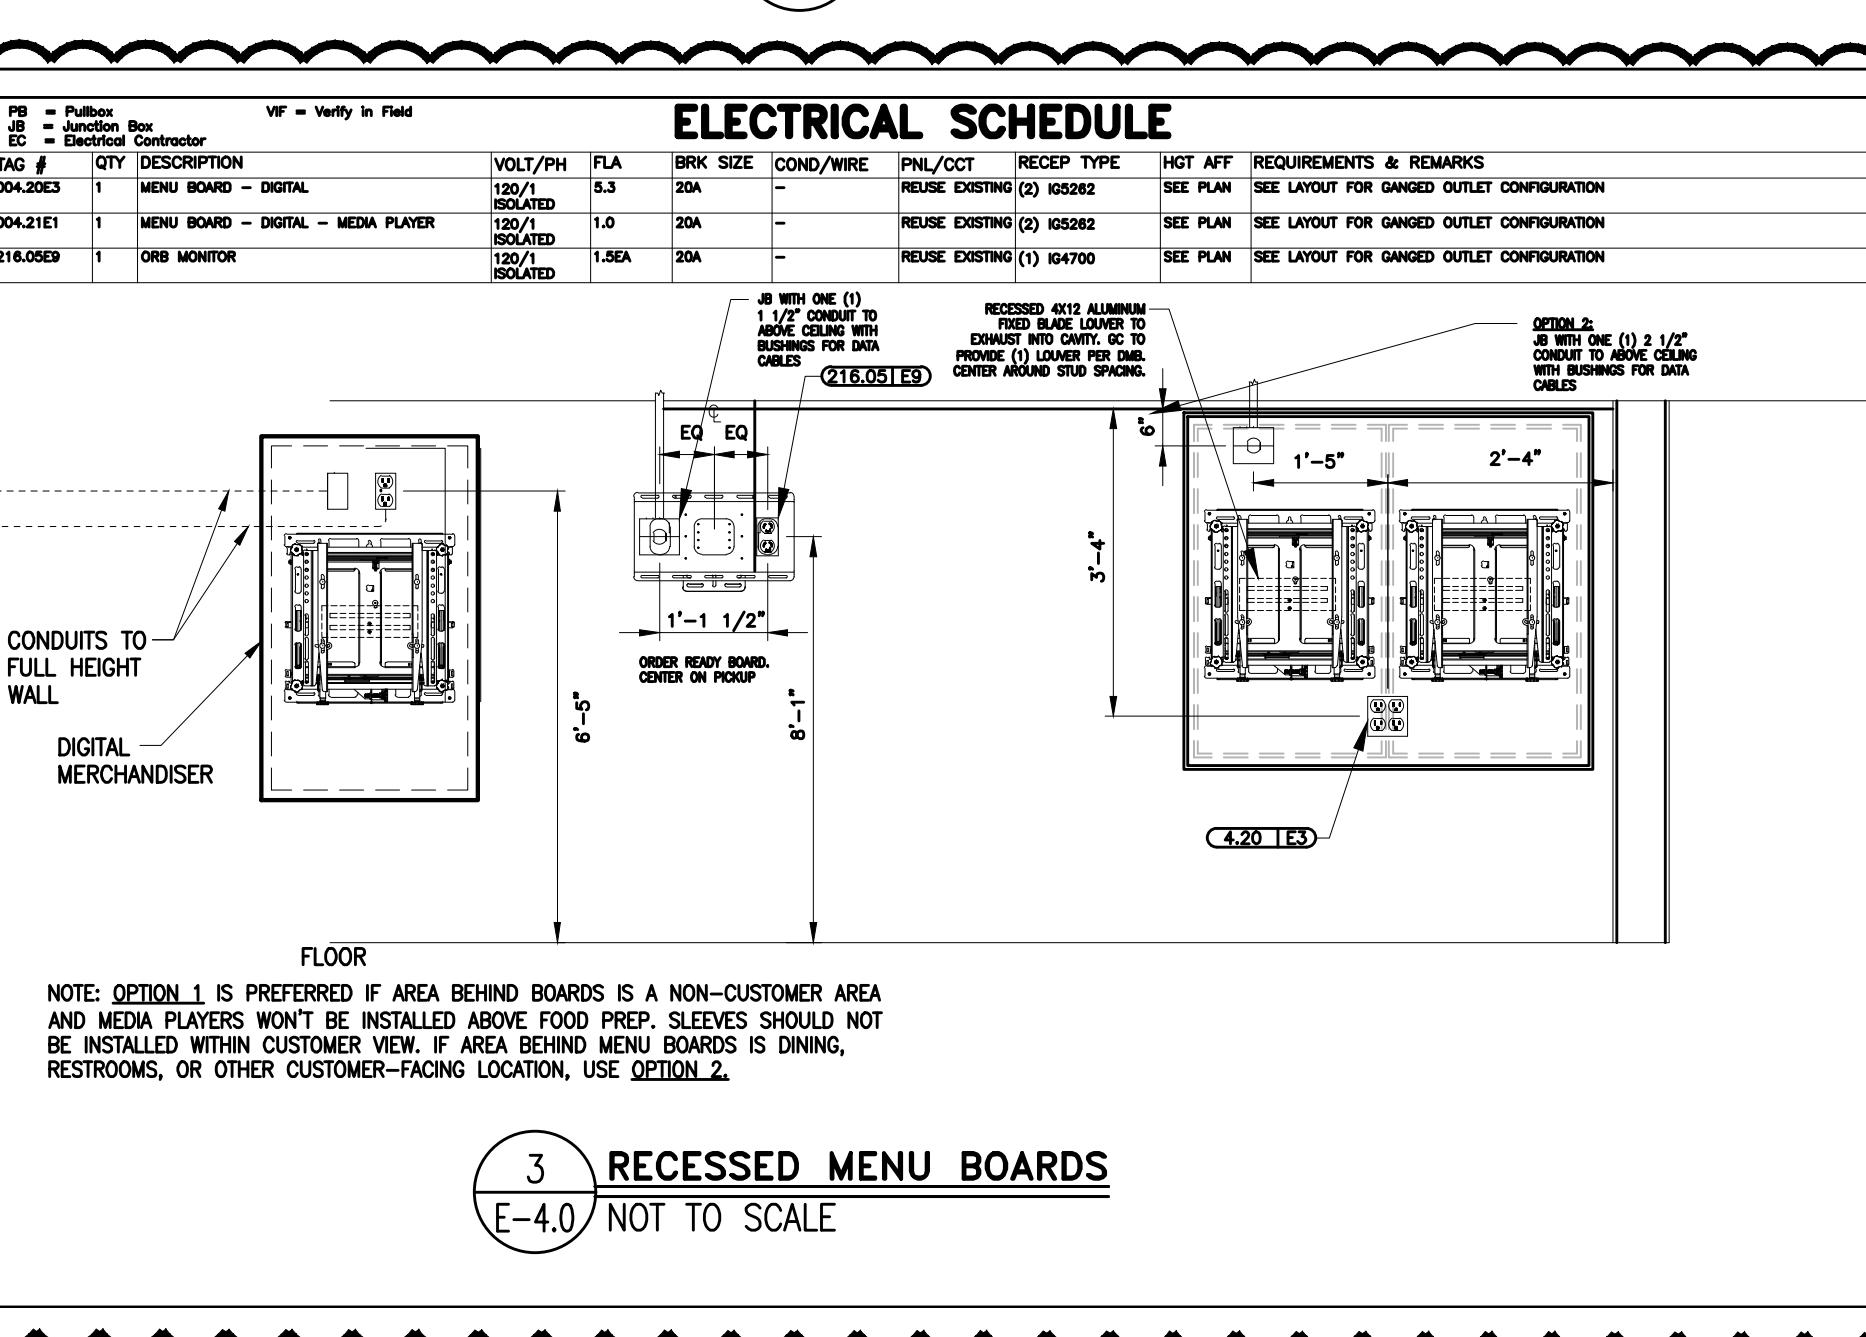

LIGHTING CONTROL SYSTEM

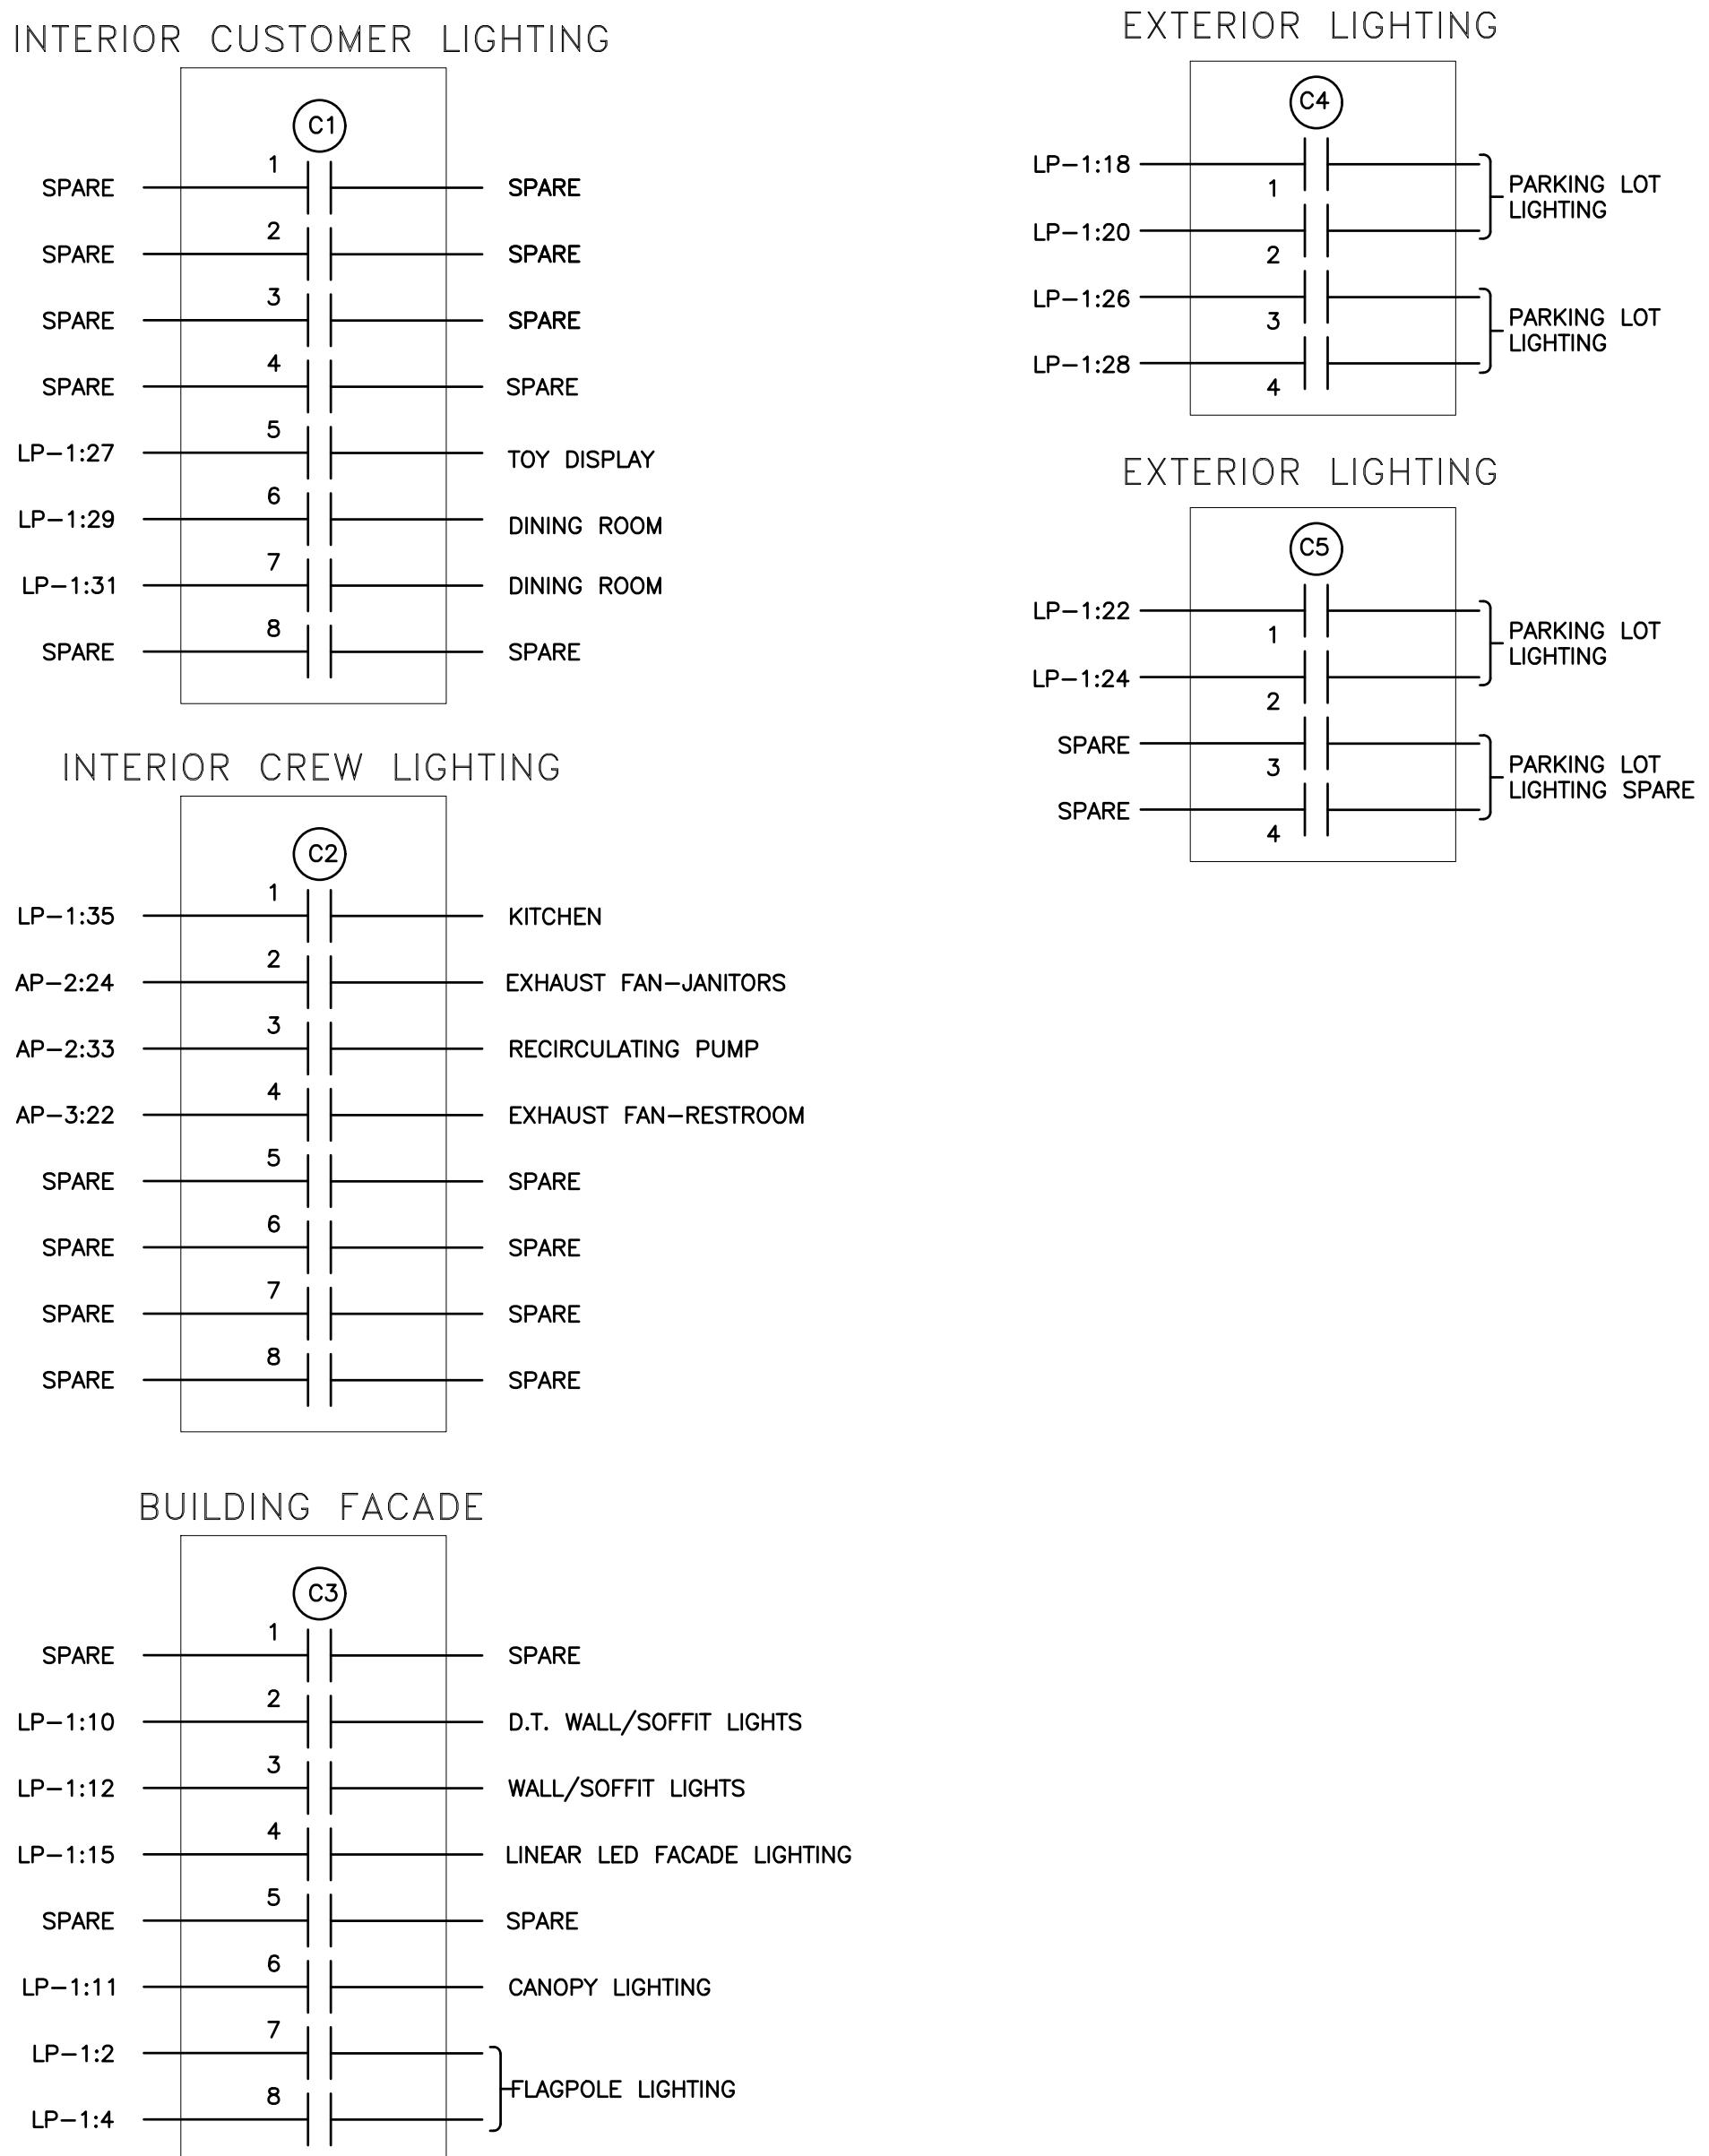

LIGHTING CONTROL NOTES:

LIGHTING CONTROL NOTES

- LC1. CONTACTOR DETAILS ARE DIAGRAMMATIC ONLY AND ARE SHOWN WITH TYPICAL LOADS AND CIRCUIT ASSIGNMENTS. LOADS, CIRCUIT ASSIGNMENTS AND NUMBER OF CONTACTORS MAY VARY BY RESTAURANT LOCATION AND PER EMS SUPPLIERS SYSTEMS. VERIFY EXACT REQUIREMENTS WITH EMS INSTALLATION DETAILS, SITE PLANS, ELECTRICAL PANEL SCHEDULES AND ACM. EC SHALL MAKE ALL MODIFICATIONS AS REQUIRED. FINAL INSTALLATION SHALL BE FULLY NEC AND ENERGY CODE COMPLIANT.
- LC2. ELECTRICAL CONTRACTOR SHALL FURNISH AND INSTALL ALL WIRING, CONNECTIONS, TERMINATIONS, ETC. THAT ARE NOT PROVIDED BY THE EMS SUPPLIER FOR A COMPLETE, FULLY OPERATIONAL AND CODE COMPLIANT LIGHTING CONTROL SYSTEM.

- LC3. ALL COMPONENTS FOR THIS LIGHTING CONTROL SYSTEM SHALL BE INSTALLED BY THE ELECTRICAL CONTRACTOR. SEE BOXED NOTE BELOW FOR OPTIONS.
- LC4. ALL COMPONENTS SHALL BE UL LISTED AND LABELED AND THE SYSTEM SHALL COMPLY WITH ALL LOCAL, STATE AND FEDERAL ENERGY CODE REQUIREMENTS.
- LC5. ALL CONTACTORS SHALL BE LOCATED IN A NEMA 1 ENCLOSURE WITH SCREW TYPE COVER MOUNTED DIRECTLY ABOVE LIGHTING PANEL OR SWITCHGEAR SO AS TO BE ACCESSIBLE.
- LC6. ALL CONTACTORS SHALL BE RATED FOR 30 AMP LOADS UNLESS NOTED OTHERWISE AND SHALL BE HID RATED WHERE REQUIRED.
- LC7. COIL VoltAGES FOR ALL CONTACTORS SHALL BE 120 VOLT UNLESS NOTED OTHERWISE.

LIGHTING CONTROL INSTALLATION OPTIONS


- OPTION 1 (STANDARD) CONTACTORS AND CONTACTOR ENCLOSURE FOR THIS LIGHTING CONTROL SYSTEM SHALL BE FURNISHED BY THE EMS SUPPLIER AND INSTALLED BY THE ELECTRICAL CONTRACTOR ON SITE FOR A COMPLETE AND FULLY FUNCTIONAL SYSTEM.
- OPTION 2 (OPTIONAL) LIGHTING CONTROL CAN BE ACCOMPLISHED VIA UTILIZATION OF A SMART TYPE BREAKER PANEL REPLACING STANDARD PANEL LP-1. PANEL SHALL UTILIZE AN INTEGRAL MOTOR OPERATED CIRCUIT BREAKERS OR AN INTEGRAL CIRCUIT BREAKER/CONTACTOR TYPE COMBINATION DEVICE WITH AN INTEGRAL PROGRAMMING CONTROL MODULE AND SHALL BE ORDERED THROUGH OUR ELECTRICAL EQUIPMENT NATIONAL ACCOUNT PROGRAM (SIEMENS OR SQUARE-D) THROUGH OUR CONSTRUCTION PURCHASING TEAM.

BUILDING AUTOMATION SYSTEM NOTES

- BAS1. THE DIAGRAM SHOWN ABOVE IS SCHEMATIC IN NATURE AND SHOWS THE GENERAL REQUIREMENTS FOR THE INSTALLATION OF THE BUILDING AUTOMATION SYSTEM. EXACT EQUIPMENT REQUIREMENTS AND QUANTITIES WILL VARY PER SITE. G.C., M.C., T.C.C. AND E.C. SHALL COORDINATE ALL EXACT EQUIPMENT AND INSTALLATION REQUIREMENTS WITH SUPPLIER PRIOR TO SUBMITTING BID FOR A COMPLETE AND FULLY FUNCTIONAL SYSTEM.
- BAS2. THE BUILDING AUTOMATION SYSTEM ALSO HAS ADDITIONAL OPTIONS AVAILABLE SUCH AS MONITORING DOOR CONTACTS (RESTROOM & COOLER FREEZER), ENERGY METER, COOLER/FREEZER TEMP, ADDITIONAL OPTIONS MAY BE SELECTED ON CENTRAL PURCHASING PROJECT DETAIL FORM. G.C., M.C., T.C.C. AND E.C. SHALL COORDINATE ALL EXACT INSTALLATION REQUIREMENTS WITH SUPPLIER PRIOR TO SUBMITTING BID FOR A COMPLETE AND FULLY FUNCTIONAL SYSTEM.
- BAS3. ELECTRICAL CONTRACTOR SHALL FURNISH AND INSTALL ALL LINE AND LOW VOLTAGE WIRING AND CONNECTIONS, INCLUDING BUT NOT LIMITED TO CONTROL POWER TO ALL BAS COMPONENTS AND POWER CIRCUITRY WIRING OF ALL LIGHTING CONTACTORS. COORDINATE INSTALLATION WITH SITE SPECIFIC BAS INSTALLATION DETAILS PROVIDED BY SUPPLIER.

BUILDING AUTOMATION SYSTEM

INSTALLATION & TECHNICAL ASSISTANCE INFORMATION:
LENNOX BAS: McD@CCBAC.com

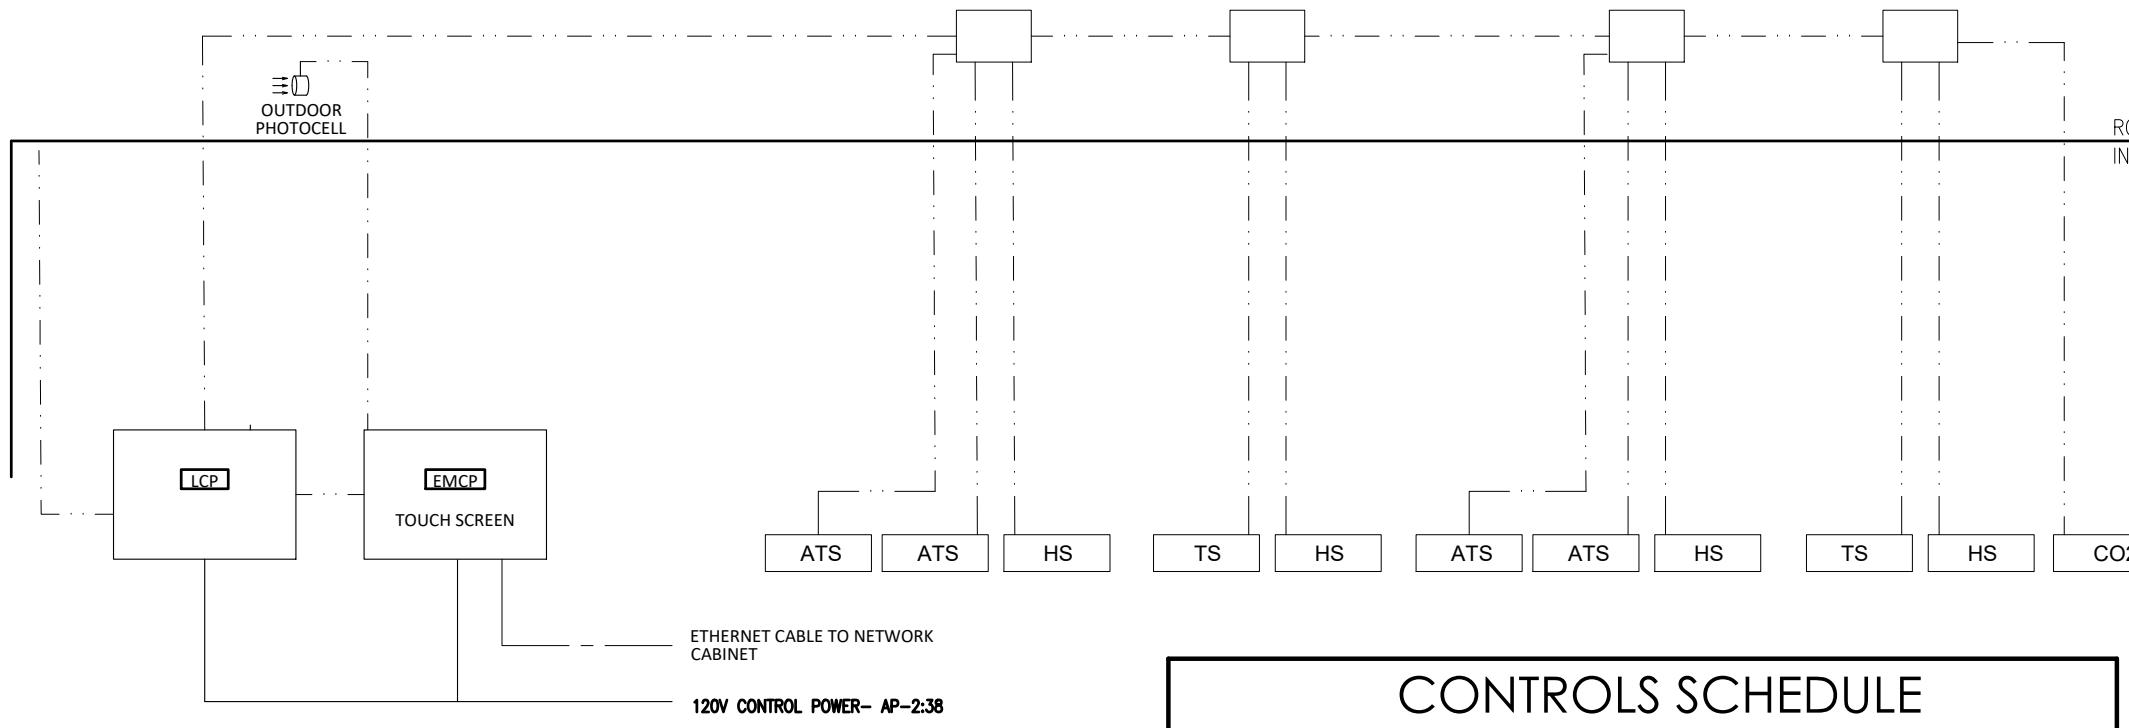

PROVIDE AND INSTALL DATA OUTLET NEXT TO BAS PANEL. REMOTE COMMISSIONING IS NOT POSSIBLE WITHOUT DATA CONNECTION.

INSTALLATION NOTES:

1. PROVIDE, INSTALL AND SECURE ALL NECESSARY CABLE & CONDUIT PER BAS DRAWINGS AND SPECIFICATIONS.
2. MOUNT ALL BAS CONTROL ENCLOSURES.
3. PERFORM ALL LOW VOLTAGE TERMINATIONS.
4. ROUGH-IN, INSTALLATION AND WIRING FOR TEMPERATURE SENSORS AND TOUCHSCREEN PER PLAN LOCATIONS.
5. PROVIDE POWER CIRCUITS INTO CONTROL CANS PER BAS DETAILS.
6. COORDINATE WITH SUPPLIER TO SCHEDULE REMOTE COMMISSIONING.
7. CORRECT ALL PUNCH LIST ITEMS FOUND DURING REMOTE COMMISSIONING.

- NOTES:
1. FOR TS, HS AND ATS LOCATIONS, REFER TO M1.2


WIRE LEGEND	
MARK	WIRE/CABLE TYPE
—	CAT 5E
— — —	18 AWG CONDUCTORS

emmanuelson-podas	consulting engineers
Emmanuelson-Podas, Inc.	Edina, MN 55439
(952) 939-0050 www.epinc.com	
3801.0037	

01/23/20

MICHAEL WEBER
LICENSED
17648
KANSAS
CONTRACTOR
ENGINEER

INSTALLATION & TECHNICAL ASSISTANCE INFORMATION:
TRANE BAS: McDcontrols@Trane.com

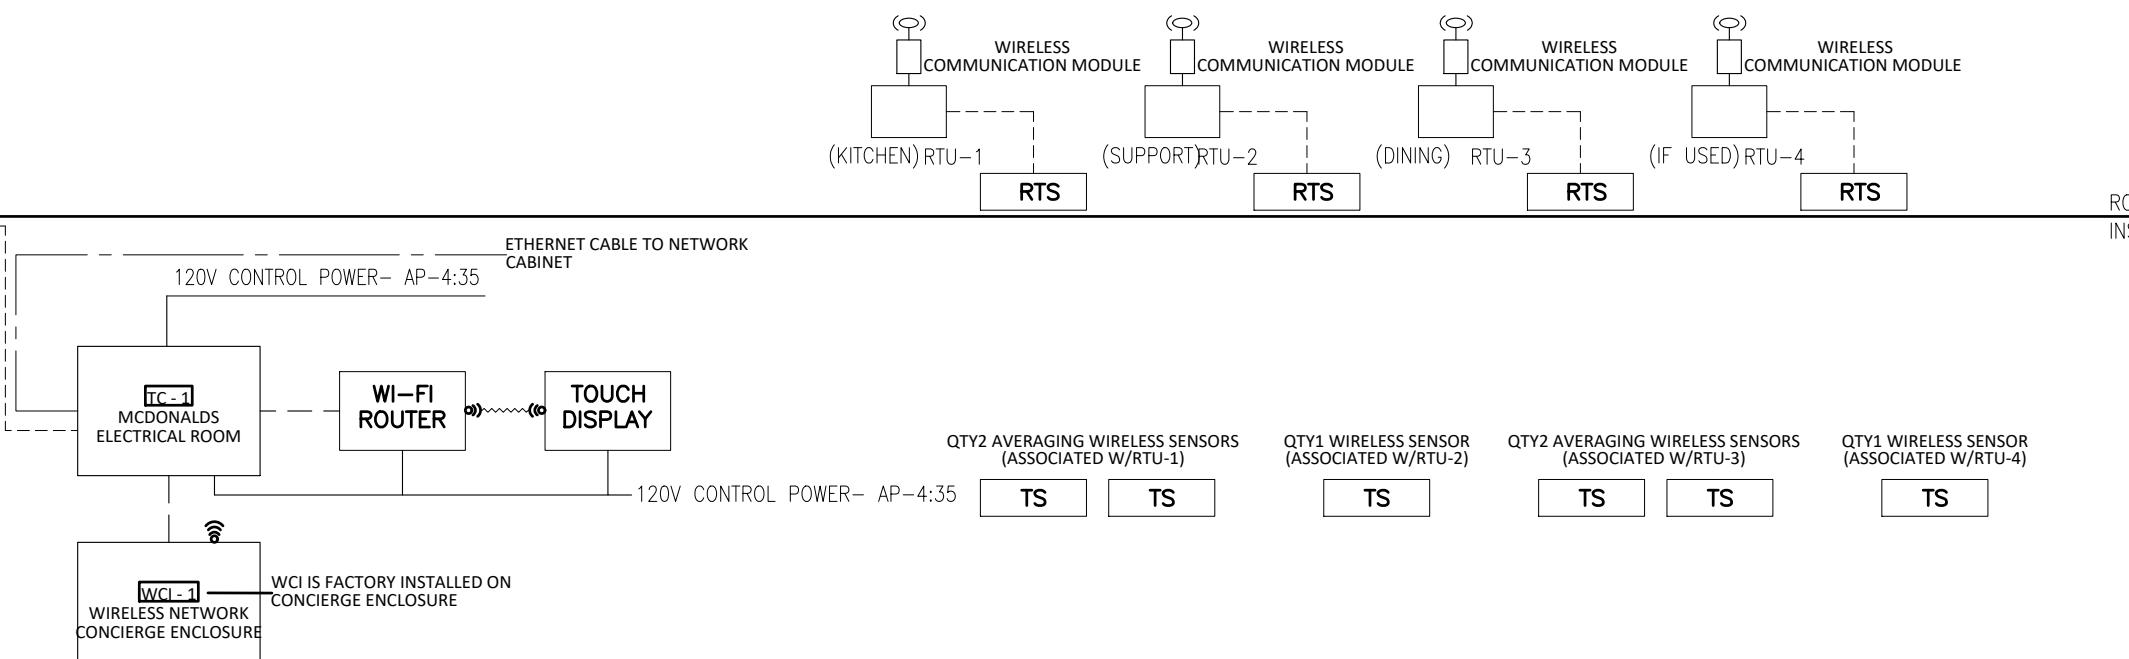

PROVIDE AND INSTALL DATA OUTLET NEXT TO BAS PANEL. REMOTE COMMISSIONING IS NOT POSSIBLE WITHOUT DATA CONNECTION.

INSTALLATION NOTES:

1. PROVIDE, INSTALL AND SECURE ALL NECESSARY CABLE & CONDUIT PER BAS DRAWINGS AND SPECIFICATIONS.
2. MOUNT ALL BAS CONTROL ENCLOSURES.
3. PERFORM ALL LOW VOLTAGE TERMINATIONS.
4. ROUGH-IN, INSTALLATION AND WIRING FOR TEMPERATURE SENSORS AND TOUCHSCREEN PER PLAN LOCATIONS.
5. PROVIDE POWER CIRCUITS INTO CONTROL CANS PER BAS DETAILS.
6. COORDINATE WITH SUPPLIER TO SCHEDULE REMOTE COMMISSIONING.
7. CORRECT ALL PUNCH LIST ITEMS FOUND DURING REMOTE COMMISSIONING.


- NOTES:
1. FOR TS LOCATIONS, REFER TO M1.2
2. RTS TO BE MOUNTED IN RETURN AIR DUCT OF RTU

WIRE LEGEND	
MARK	WIRE/CABLE TYPE
—	CAT 5E
— — —	18 AWG CONDUCTORS

© 2020 McDonald's USA, LLC	PREPARED BY:
McDonald's USA, LLC	
These drawings and specifications are the confidential and proprietary property of McDonald's USA, LLC, and shall not be copied or reproduced for use on other projects or sites. These drawings and specifications are for use on this specific site in conjunction with its issuance date and are not suitable for use on a different site or at a later time. Use of these drawings for reference or example on another project requires the services of a licensed architect or engineer. Reproduction of the contract documents for reuse on another project is not authorized.	
SHEET NO.	015-0071.00.0
TITLE	2019 STANDARD BUILDING - BB20
DESCRIPTION	WOOD BEARING WALLS W/ FIBER CEMENT SIDING & CI WOOD ROOF TRUSS FRAMING FIBER CEMENT PANEL/BRICK EXTERNS. SITE ADDRESS 605 SOUTH 7TH STREET, KANSAS CITY, KS
STD ISSUE DATE	2019-11
REVIEWED BY	MLW
DATE ISSUED	01-23-20
REV	R#1975

MLO, A/C: NOTES D6, D7, & D8, Mounting: MDP, NEMA 1							
WATTS			PANEL AP-1				
A	B	C	DESCRIPTION	REQ	PLS	NO.	NO. PLS
1532			DCO - General Purpose	G	20A-1	1	2 20A-2
720			DCO - General Purpose	G	20A-1	3	4 I
	1200		DCO - General Purpose	G	20A-1	5	6 20A-1
120			Safe - (mp) DCO Gen Purp	L	20A-1	7	8 20A-1
240			Remote Order Battery	G	20A-1	9	10 20A-1
960			Merge/audio sys/drvr mon(sa)	G	20A-1	11	12 20A-1
	1140		Washer	G	15A-1	13	14 20A-2
1800			Hand held Order	G	20A-1	15	16 I
	120		Computer Room (TF1)	G	20A-1	17	18 30A-3
2246			Espresso Brewer	G	30A-2	19	20 I
	2246		3-Vat fryer exstn hd interlock	G	20A-1	23	24 20A-1
1200			Reach in Freezer-SW	G	20A-1	25	26 20A-2 H
1080			Frozen fry dispenser (fy wall)	G	20A-1	27	28 I
	2112		4-Vat fryer exstn hd interlock	G	20A-1	29	30 20A-1
1884			Fry bagging station 36" (fy wall)	L,G	20A-1	31	32 15A-3 H
60			Hand Wash Timer	G	20A-1	33	34 I
	1200		Reach in Freezer-SW	G	20A-1	35	36 I
132			Ice machine - 1000 lb	G	15A-1	37	38 15A-3 H
	132		Ice machine - 1000 lb	G	15A-1	39	40 I
1656			4-Vat fryer exstn hd interlock	G	20A-1	41	42 I
							Total Connect 17178 14064 17700
							Connect Amps 136 Amps
							Demand Amps 98 Amps
							Total Connect 17178 14064 17700
							Connect Amps 136 Amps
							Demand Amps 98 Amps


MLO, A/C: NOTES D6,D7,&D8, Mounting: MDP, NEMA 1							
WATTS			PANEL AP-5				
A	B	C	DESCRIPTION	REQ	PLS	NO.	NO. PLS
			Spare	20A-1	1	2 20A-1	
1477			Universal Holding Cabinet - 2S	G	20A-2	3	4 20A-1
	1477			I	1	5 6 20A-1	
1477			Pie Display	G	20A-2	7	8 50A-3
1477			Pie Display	G	4 - VAT LOV Fryer - Elec. S/S/S	4668	
1477			I	1	9 10 I		
1477			I	1	I I		
1477			UHC Table Hub & Spoke	G	20A-1	11	12 I
1477			Spoke	G	13	14 50A-3	
1477			Spoke	G	4 - VAT LOV Fryer - Elec. S/S/S	4668	
1477			I	1	17 18 I		
1477			Spare	20A-1	19	20 50A-3	
1477			4 - VAT LOV Fryer - Elec. S/S/S	G	4668		
1477			I	1	I I		
1477			Space	G	23	24 I	
1477			Space	G	25	26 50A-3	
1477			Space	G	4 - VAT LOV Fryer - Elec. S/S/S	4668	
1477			I	1	27 28 I		
1477			Space	G	29	30 I	
1477			Space	G	31	32 20A-1	
1477			Spare	G	33	34 20A-1	
1477			Spare	G	35	36 20A-1	
1477			Spare	G	37	38 I	
1477			Spare	G	39	40 I	
1477			Spare	G	41	42 I	
							Total Connect 20341 23666 22430
							Connect Amps 185 Amps
							Demand Amps 120 Amps

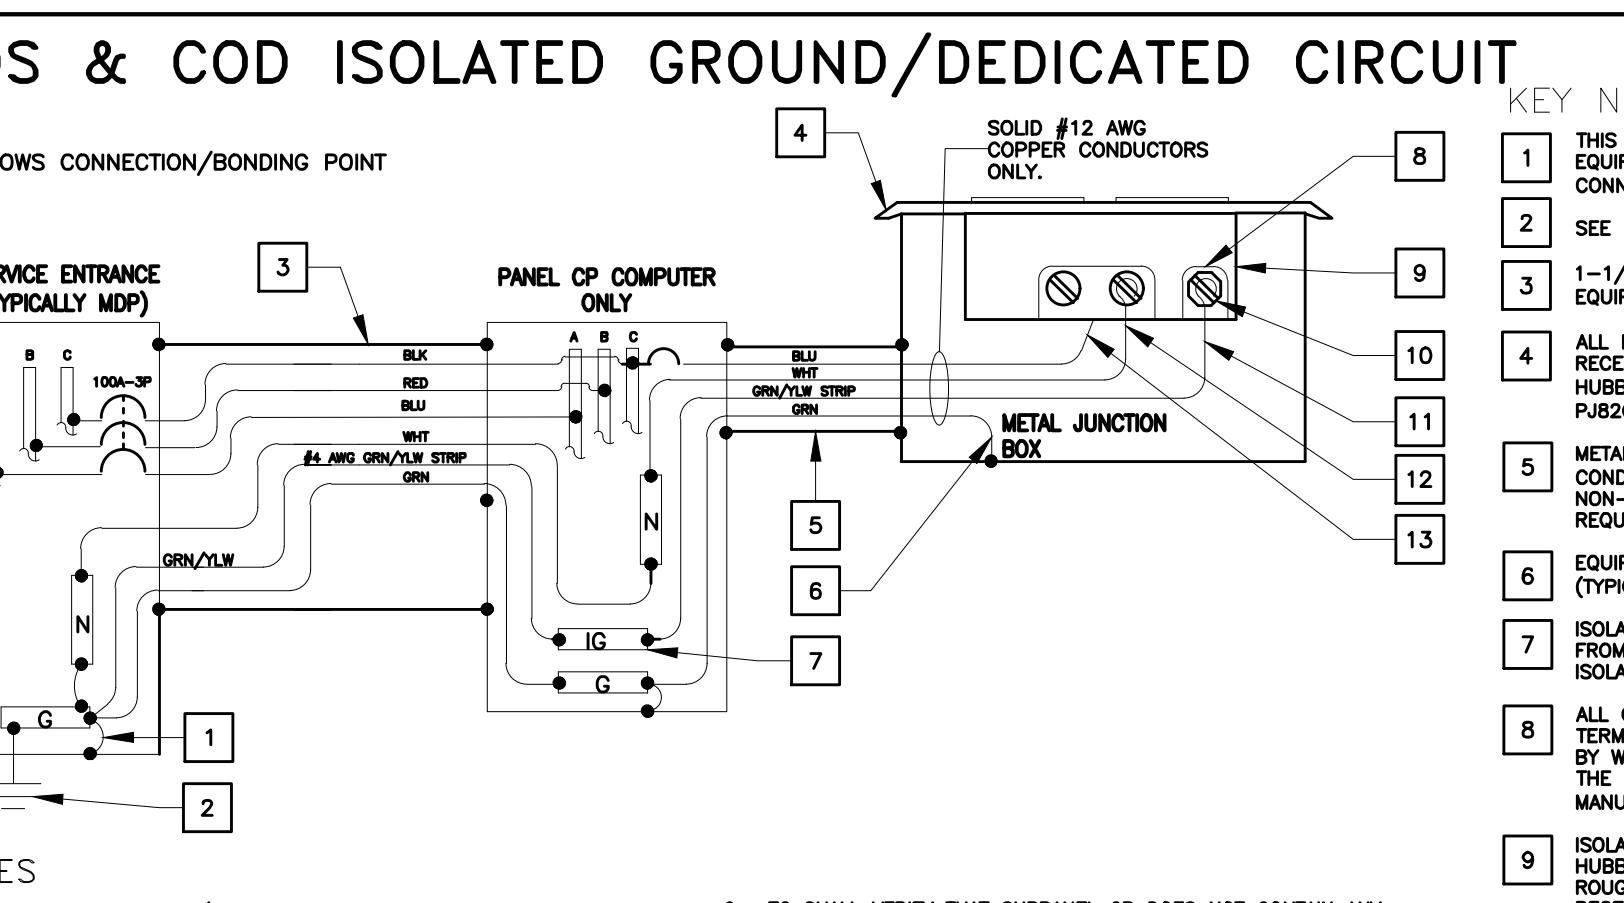

BY DATE	DESCRIPTION	REV DATE
12/03/20	SERVICE AREA OPTIMIZATION	11/31/20
05/05/20	USD, SD, SET REVIEW	05/05/20
01/23/20	CIVIL & PLAN REVIEW COMMENTS	01/23/20
01/13/20	PERMIT SET REVIEW	01/13/20
	PROGRESS SET REVIEW	
	REVIEW	

MLO, A/C: NOTES D6,D7,&D8, Mounting: MDP, NEMA 1							
WATTS			PANEL AP-2				
A	B	C	DESCRIPTION	REQ	PLS	NO.	NO. PLS
1536			Ice machine 1400LB	H	20A-3	1	2 20A-1
1536			Janitor EF	I	1	3 4 20A-1	
	1536		DCO - General Purpose	G	20A-1	5	6 20A-1
624			Soda tower-cold plate/soft servl	G	20A-1	7	8 20A-1
180			Janitor's closet	G	20A-1	9	10 20A-2 H
			Spare	L	20A-1	11	12 I
1848			Hot Water Dispenser	G	20A-1	13	14 20A-1
864			Bulk oil system (sup area)	G	20A-1	15	16 20A-1
	1668		Clim gnt exhaust hd interlock	G	20A-1	17	18 20A-2
840			Meat freezer	G	20A-1	19	20 I
120			Clean in place panel	G	20A-1	21	22 20A-1
490			Reverse Osmosis Filtration	G	20A-1	23	24 20A-1
1200			DCO in Trash Corral	G	20A-1	25	26 20A-1
1032			Bulk oil sys - support area (sa)	G	20A-1	27	28 20A-2 G
684			BIC Machine	G	20A-1	29	30 I
120			Refrigerator - Single Wide	G	20A-1	31	32 20A-2 G
	384		Recip pump	G	20A-1	33	34 I
1632			Soda syst pack (support area)	G	20A-1	35	36 20A-1
3120			Soda syst pack (support area)	G	30A-3	37	38 20A-1
3120				G	20A-1	39	40 20A-1
	3120						Total Connect 14578 14306 18433
							Connect Amps 131 Amps
							Demand Amps 92 Amps

MLO, A/C: NOTES D6,D7,&D8, Mounting: flush, NEMA 1							
WATTS			PANEL LP-1				
A	B	C	DESCRIPTION	REQ	POLES	NO.	NO. POLES
			Spare	20A-1	1	2 20A-1	
			Spare	20A-1	3	4 20A-1	
			Spare	20A-1	5	6 20A-1	
100			Trash Corral Lighting	S	20A-1	7	8 20A-1
	294		Back, DT & Non DT Signage	S	20A-1	9	10 20A-1
	193		Flood Lights & Canopy lights	S	20A-1	11	12 20A-1
86</							

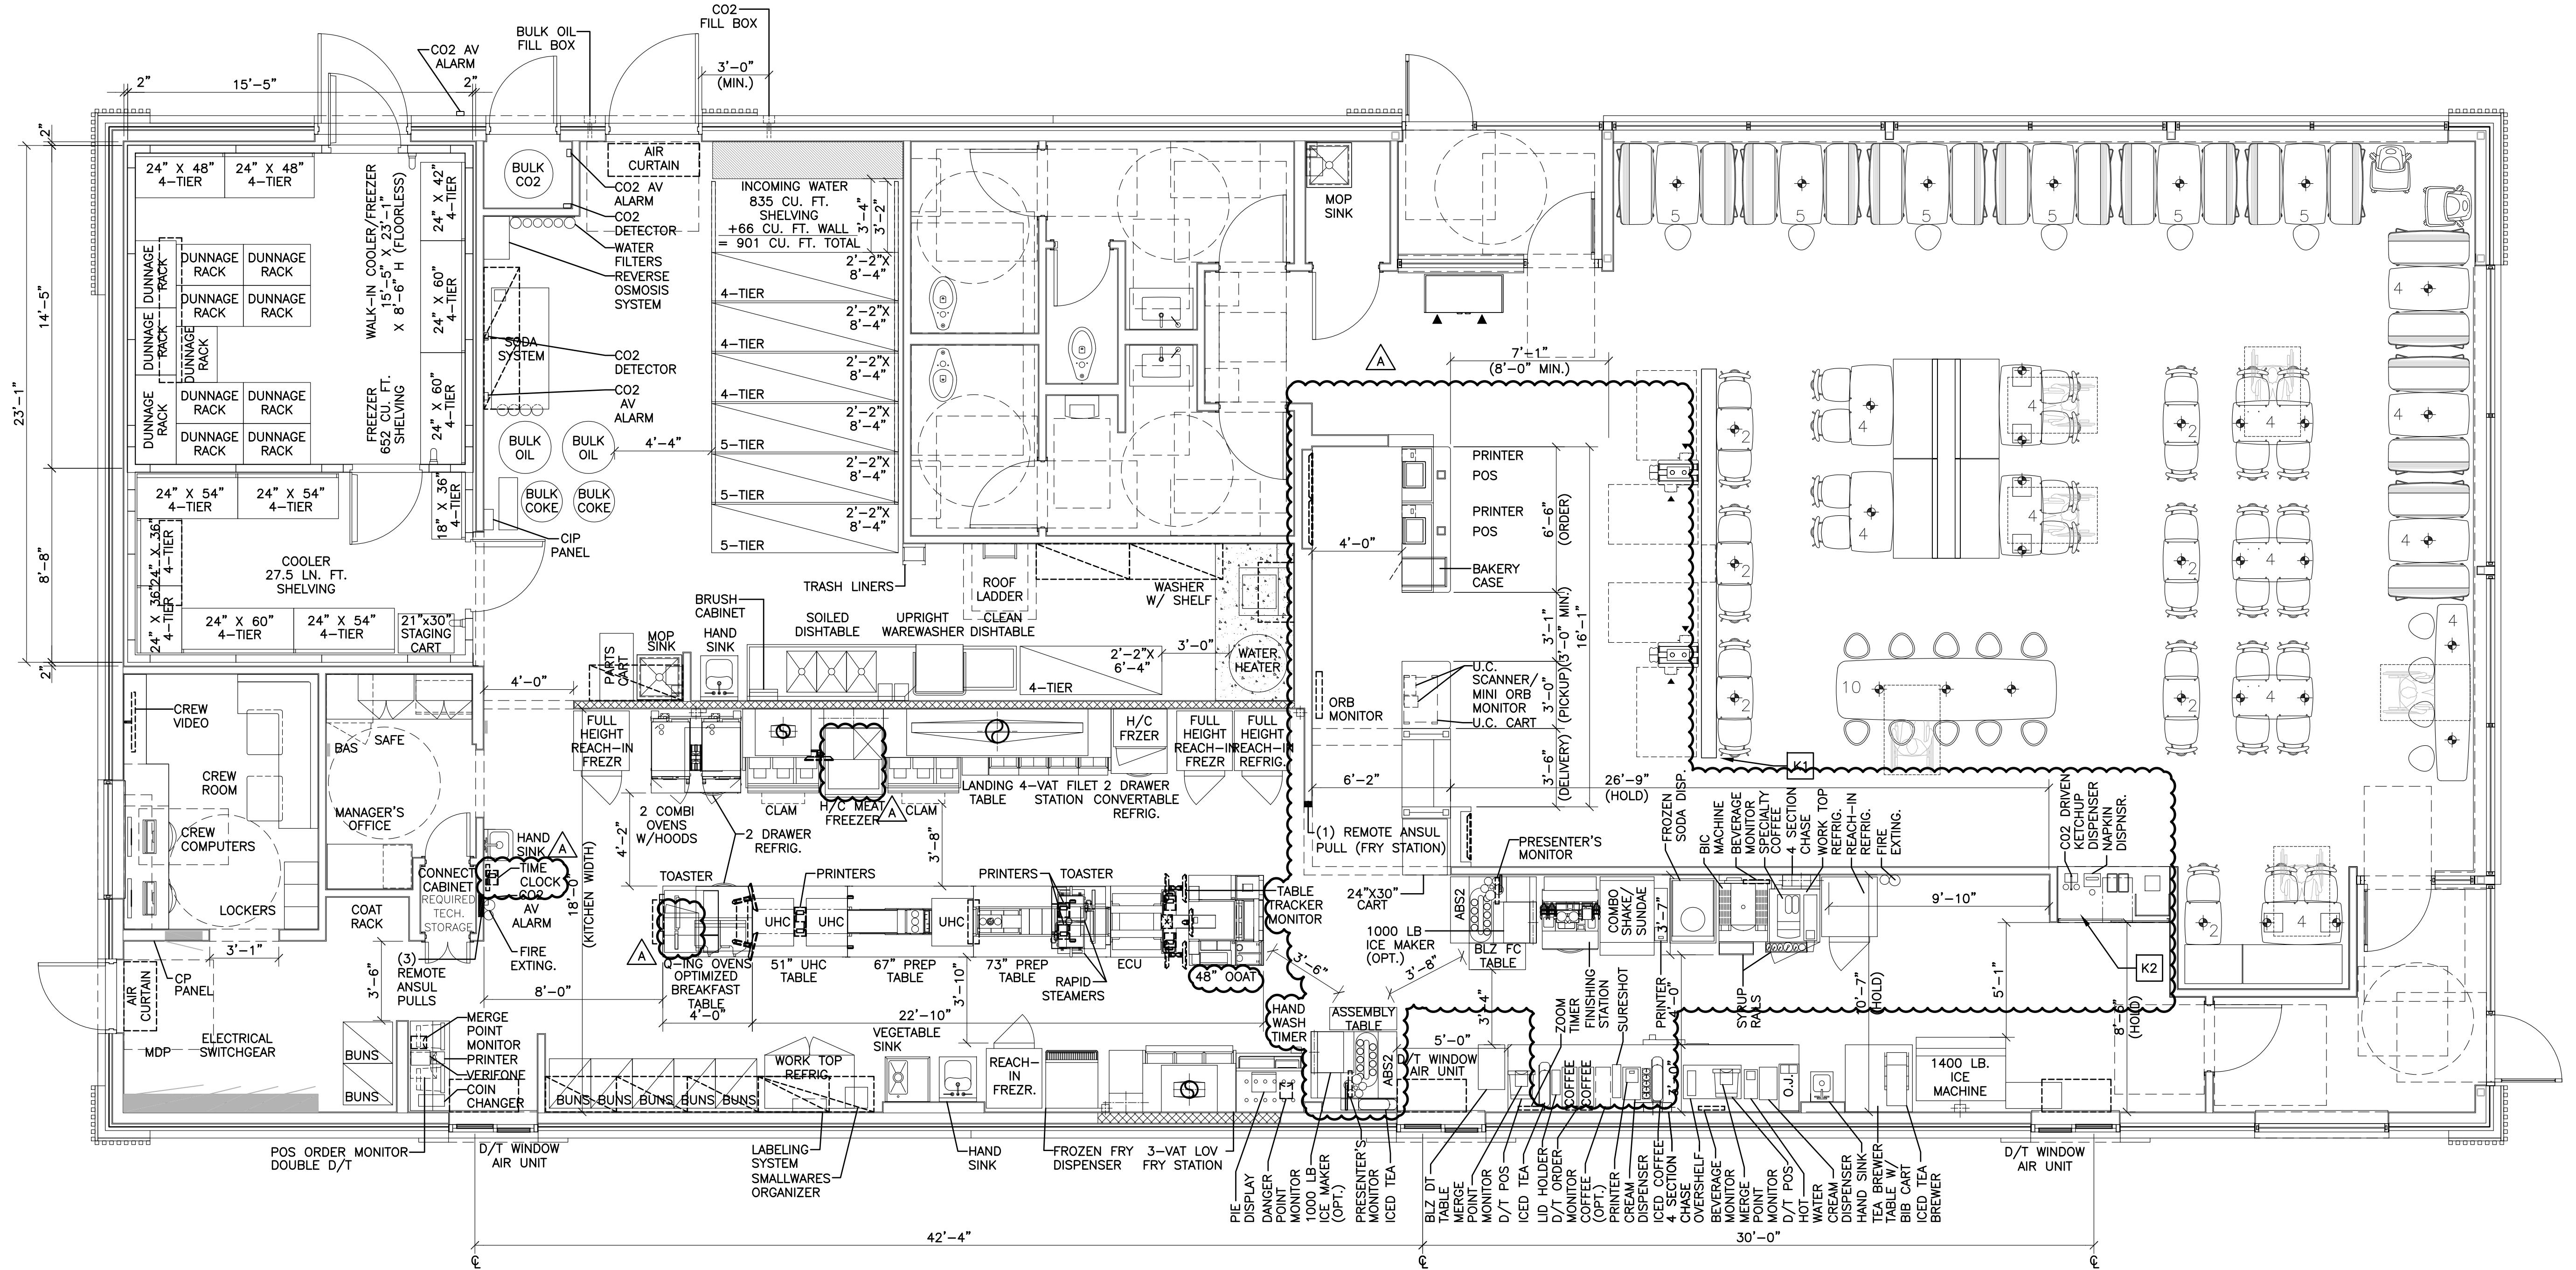

KITCHEN COVER SHEET

1
K1.0 1/4" = 1'-0"

KEYED NOTES

K1 SEATING AND KIOSKS MUST BE 5'-0" CLEAR FROM BEVERAGE CELL WALL



K2 KES TO ENSURE AMENITY TOWER EQUIPMENT PLACEMENT MEETS ADA REQUIREMENTS

DRAWN BY: PREPARED FOR: © 2019 McDonald's USA, LLC McDonald's USA, LLC

These drawings and specifications are the confidential and proprietary property of McDonald's USA, LLC and shall not be copied or reproduced without the express written consent of McDonald's USA, LLC. They are for use on this specific site in connection with its issued date and are not suitable for use on a different site or at a later time. Use of these drawings for reference or example on another project requires the services of properly licensed architects and engineers. Reproduction of the contract documents for use on another project is not authorized.

SHEET NO.	TITLE	DRAWN BY	STD ISSUE DATE	REVIEWED BY	DATE ISSUED	REV. DATE	DESCRIPTION	ADDRESS	BY
015-0071.000 015-0071	2019 STANDARD BUILDING - BB20 4597-WOOD/WOOD	RH	2019-11	RH	11 15 2019		WOOD BEARING WALLS W/4" BRICK EXTERIOR FINISH & CI WOOD ROOF TRUSS FRAMING ELLS/BATTEN/METAL PANEL/BRICK EXTERIOR FINISH	605 South 7th St, Kansas City, KS	

K1.0
KITCHEN COVER SHT

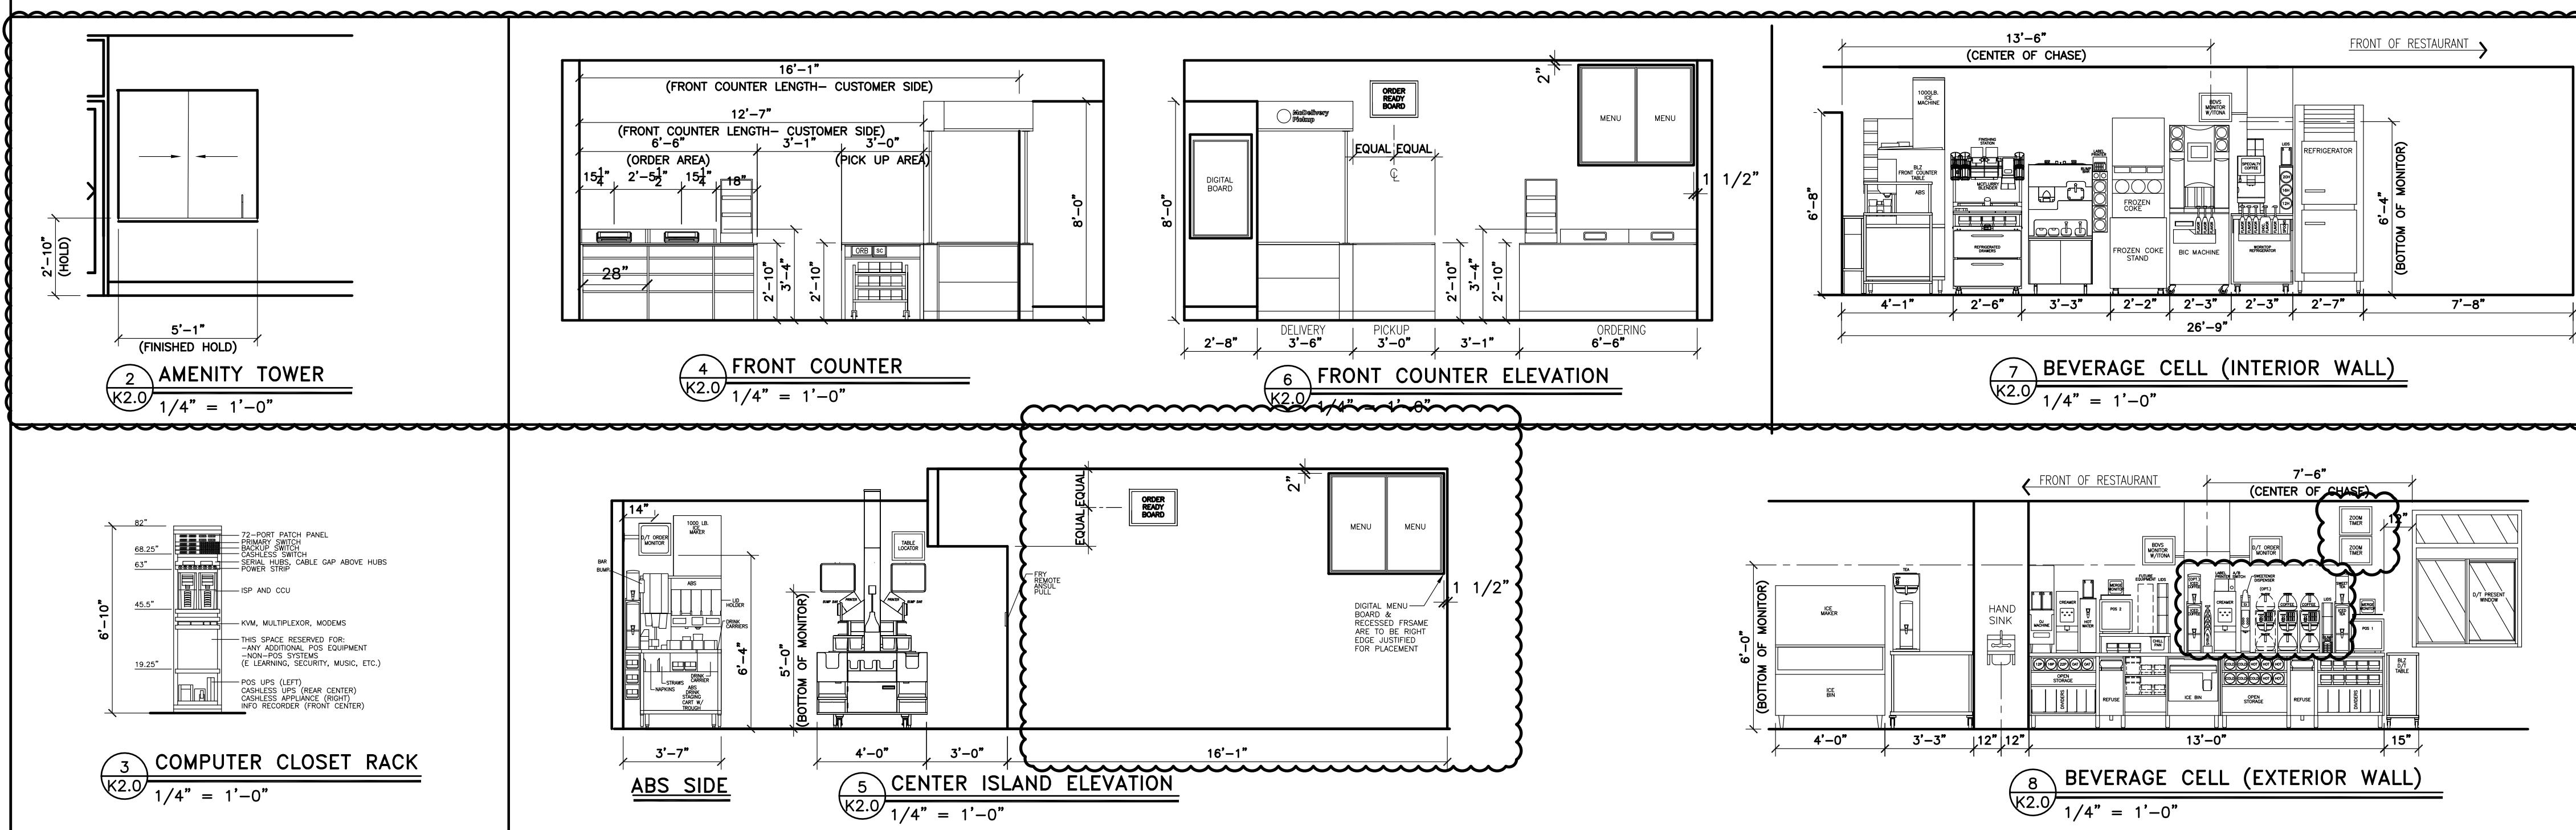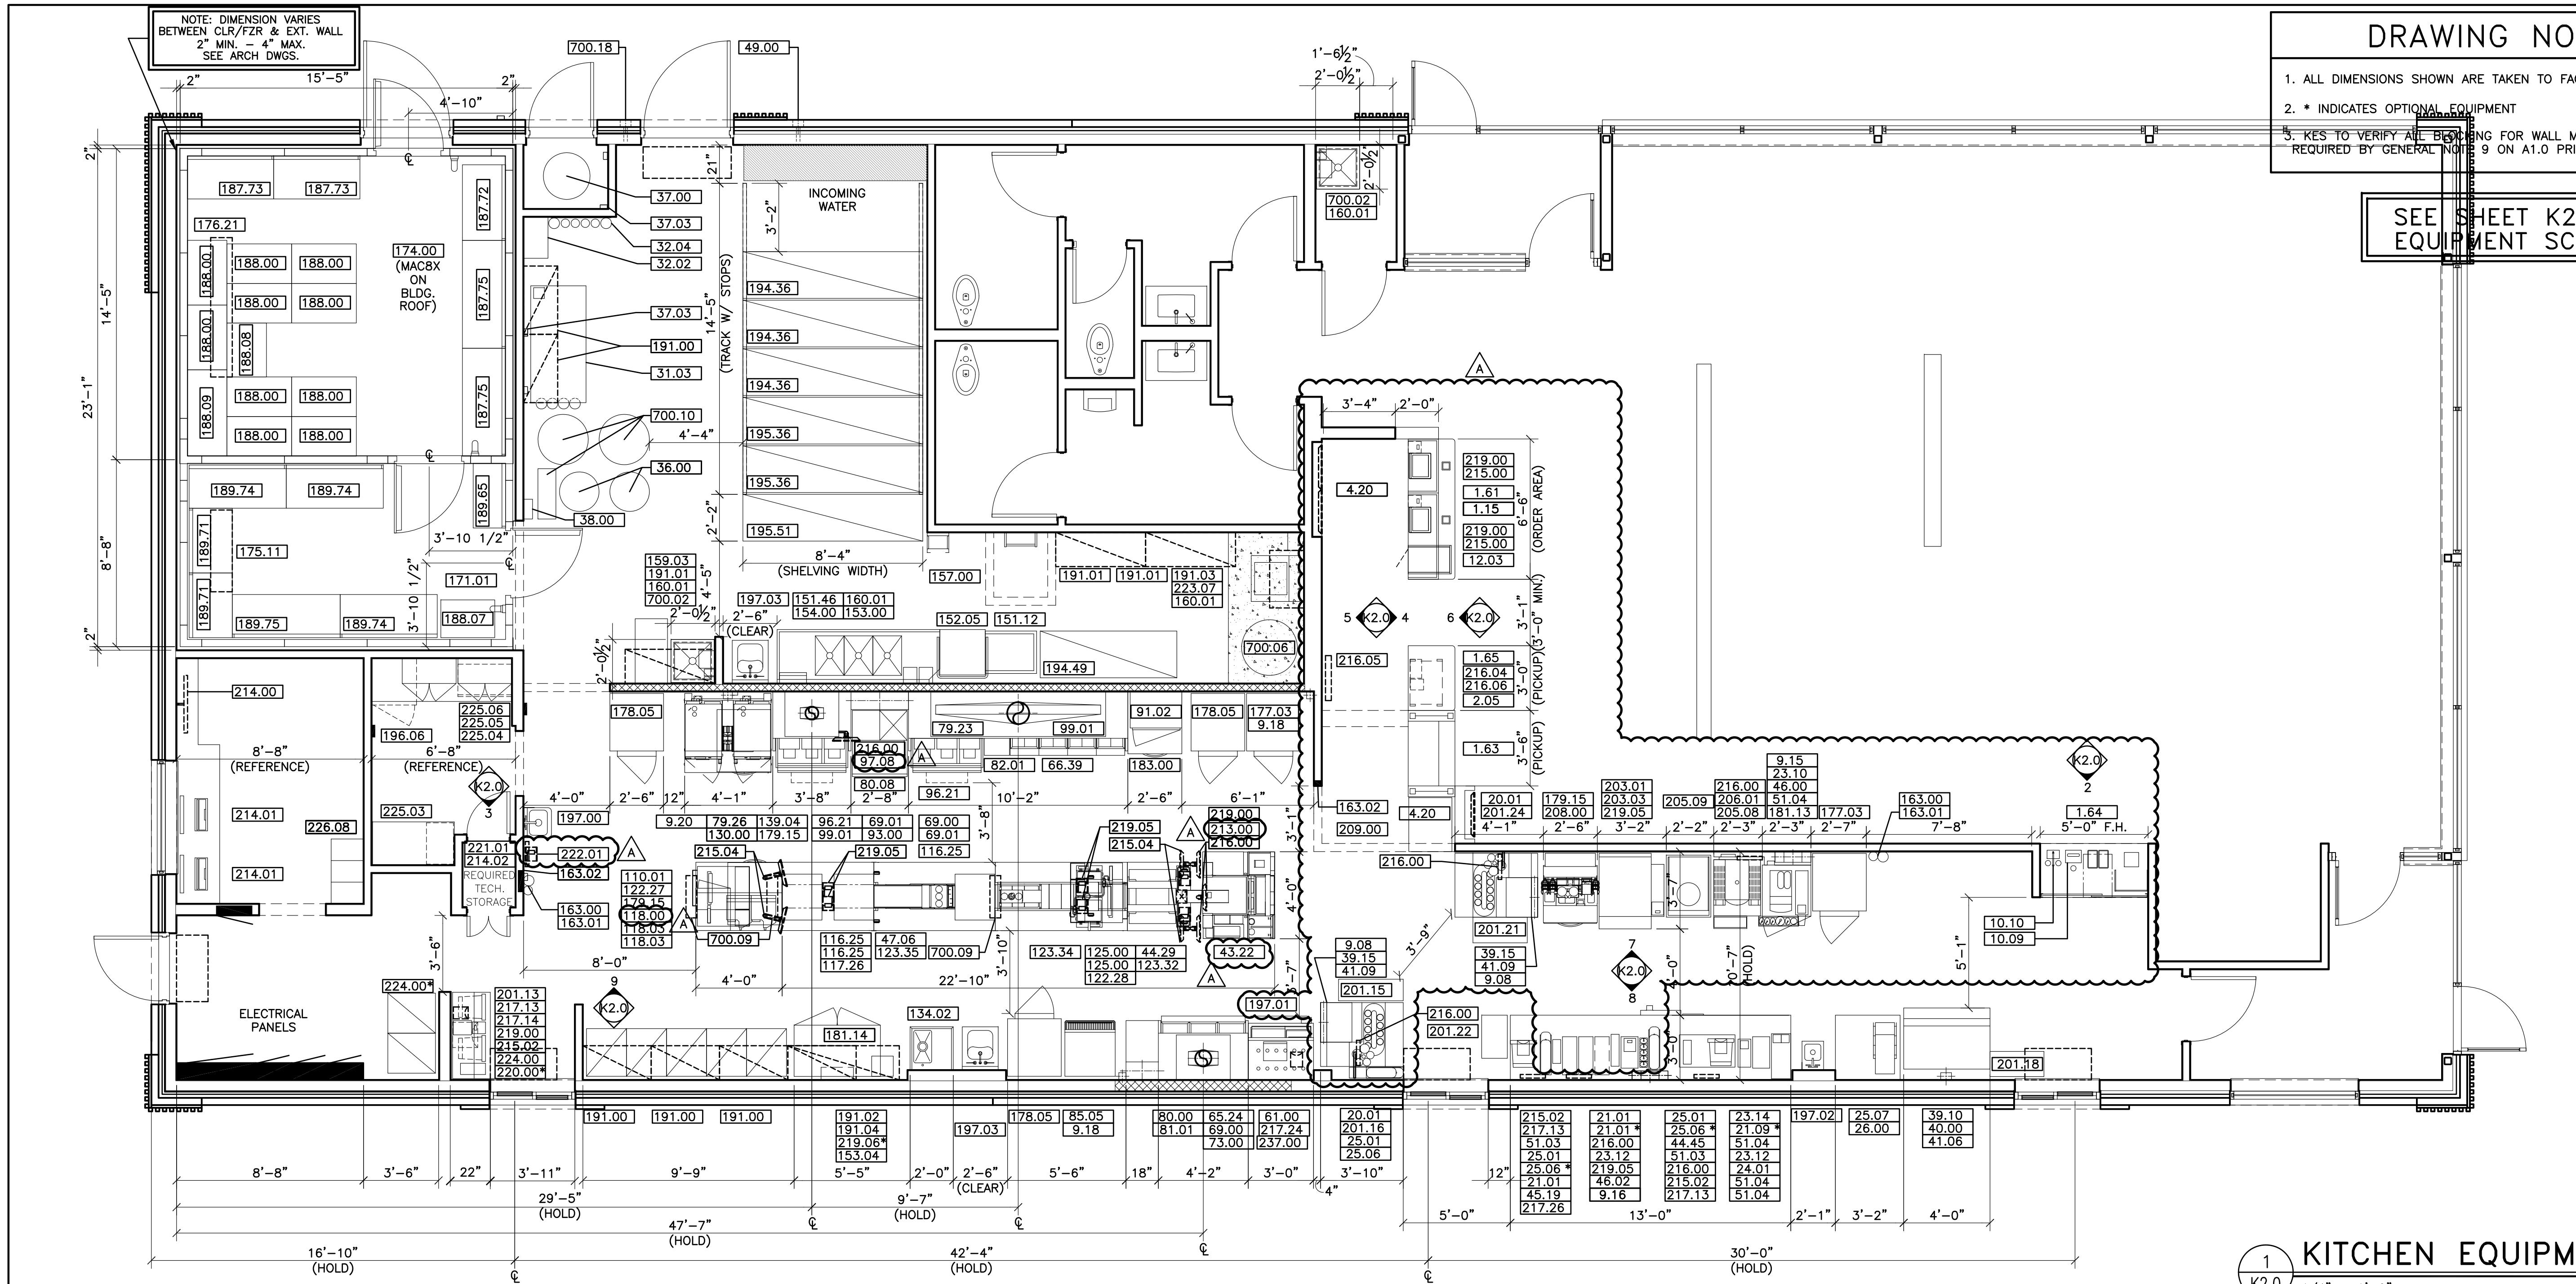

SHEET NO.	TITLE	DRAWN BY	DRAWN FOR:	STD ISSUE DATE	REVIEWED BY	DATE ISSUED	BY
015-0071.00.0	2019 STANDARD BUILDING - BB20 4597-WOOD/WOOD	RH	M® McDonald's USA, LLC	2019-11	RH	11 15 2019	

DESCRIPTION: WOOD BEARING WALLS W/4" BRICK EXTERIOR FINISH & GI
WOOD ROOF TRUSSES FRAMING
EL.F.S./BATTE/METAL PANEL/BRICK EXTERIOR FINISH
ADDRESS: 605 South 7th St. Kansas City KS
SITE ID: 015-0071

= Optional Equipment
CC = General Contractor
R = Relocated Equipment

EQUIPMENT SCHEDULE

ITEM	O	QTY	DESCRIPTION	MANUFACTURER	MODEL #	UL	NSF	FURNISHED	GENERAL REMARKS	SPECIAL REQUIREMENTS
1.15	3	SERVICE POD COUNTER PLUS BASE EXTENSION	DECOR	MFC-6	-	2	KES	-		
1.61	1	SERVICE POD - 6"	DECOR	SEE PLAN	-	2	KES	-		
1.63	1	McDELIVERY PICKUP COUNTER	DECOR	SEE PLAN	-	2	KES	-		
1.64	1	AMENITY TOWER	DECOR	SEE PLAN	-	2	KES	-		
1.65	1	PICKUP POD - 36"	DECOR	SEE PLAN	-	2	KES	-		
2.05	1	UNDER COUNTER CART - 24 W x 18 D FRONT	INTERMETRO	DC 8-DMS	-	2	KES	-		
4.20	3	WENBOARD - DIGITAL	LG	495H7DB	-	-	AT&T	-		
9.05	2	UTILITY CHASE - ICE MAKER ON ABS VERSION	KES	5"x8"x23"	-	2	KES	CONCEALS WATER AND CONDENSING UNIT LINES		
9.15	1	UTILITY CHASE - FFDT INTERIOR WALL	KES	20"x5"x76"	-	2	KES	4 SECTION CHASE FOR BUYOUT RECEPTACLES, POS, CO2 AND WATER		
9.16	2	UTILITY CHASE - FFDT EXTERIOR WALL	KES	20"x5"x76"	-	2	KES	4 SECTION CHASE FOR BUYOUT RECEPTACLES, POS AND WATER		
9.18	2	UTILITY CHASE - WALL VERSION	KES	4"x4"x82"	-	2	KES	CHASE FOR BULK OIL LINES, MOUNT AT 2'-0"		
9.20	1	UTILITY CHASE - COMBI CELL	KES	4"x8"x84"	-	2	KES	CHASE FOR BUYOUT RECEPTACLES AND WATER		
10.09	1	NAPKIN DISPENSER - DROP-IN	GEORGIA PACIFIC	54219	-	2	KES			
10.10	1	CO2 DRIVEN KETCHUP DISPENSER	PERFECTION	MCD-1	-	2	KES			
12.03	1	BAKED GOODS DISPLAY CASE - 14"	ANTUNES	DC-14	-	2	KES			
20.01	2	AUTOMATED BEVERAGE SYSTEM 2.0	MI CORNELIUS	821058990101	-	-	KES	INSTALLATION KIT INCLUDES STAINLESS STEEL CHASE & DATA LINE		
21.01	3	COFFEE BREWER (THERMAL POTS)	BUNN-O-MATIC	AIXOM-DV-3	E32066	4	KES	W/ELECTRONIC CONTROLLER FOR CONVERSION TO LOW OR HIGH VOLTAGE		
21.09	1	HOT WATER DISPENSER	BUNN-O-MATIC	HW2	E32066	4	KES	-		
23.10	1	ESPRESSO BREWER	FRANKE	FM850	-	4	KES	-		
23.12	2	COFFEE CREAM DISPENSER	SURESHOT	AC110-PC-51	E217698	20	KES	-		
23.14	1	SUGAR/SWEETENER DISPENSER	SURESHOT	AC2-6P-30	E217698	18	KES	-		
24.01	1	ORANGE JUICE DISPENSER	TAYLOR	C009	-	18	KES	-		
25.01	3	SIMLINE ICED BEVERAGE DISPENSER	BUNN-O-MATIC	TDO-N	E32066	4	KES	KES TO VERIFY EXACT QUANTITY PER MARKET		
25.06	3	SIMLINE ICED BEVERAGE DISPENSER - SHORT	BUNN-O-MATIC	TDO-N LP	E32066	4	KES	KES TO VERIFY EXACT QUANTITY PER MARKET		
25.07	1	INFUSION TEA BREWER - MIS	BUNN-O-MATIC	ITCB-DV	E32066	4	KES	PROVIDED WITH BREWER, INSTALLATION KIT AND TDO-N BOOSTER		
26.00	1	TEA BREWER TABLE - 30"x36"	ISS SHELVING	WST1756C	-	2	KES	-		
31.03	1	SODA SYSTEM PACKAGE B.I.B.RECIRCULATING - 3 TOWERS) - REMOTE	MULTIPLEX	500GR04	E121876	18	KES	-		
32.02	1	REVERSE OSMOSIS WATER FILTRATION SYSTEM - EVERPURE	EVERPURE	ENVI-RO-600	-	-	KES	FOR COFFEE MAKER, ESPRESSO MACHINE, AND RAPID BUN STEAMER		
32.04	1	WATER FILTRATION SYSTEM	EVERPURE	EV9337-26	-	-	KES	-		
36.00	2	BULK COKE	CHART INDUSTRIES	10667511	-	18	MANUFACTURER	SYRUP LINES BY CHART INDUSTRIES		
37.00	1	BULK CO2 - 750 LB.	CHART INDUSTRIES	CARBO-MAX 750	-	-	MANUFACTURER	-		
37.03	2	CO2 SAFETY SYSTEM	SEE RMKS	-	-	-	KES	SEE MECHANICAL DRAWINGS	INCLUDES DETECTOR AND (4) AV ALARMS	
38.00	1	CLEAN IN PLACE PANEL	CHART INDUSTRIES	10667431	-	18	MANUFACTURER	MOUNT 6" x 7" BOX @ 6"-0" AFF TO BOX CENTER LINE		
39.10	1	ICE MACHINE - 1400 LB.	MANITOWOC	IY1494N3/ B970	SA4027	12	KES	USE HEADMASTER KIT KG0221		
39.15	2	ICE MACHINE - 1000 LB.	MANITOWOC	IB1094YC	SA4027	12	KES	CONDENSER: ICD-1195-263		
40.00	1	ICE MACHINE CHASE	KES	4"x6"x48"	-	2	KES	CONCEALS WATER AND CONDENSING UNIT LINES		
41.06	1	ICE MACHINE REMOTE CONDENSER - 1400 LB	MANITOWOC	JC-1395	SA4027	12	KES	-		
41.09	2	ICE MACHINE REMOTE CONDENSER - 1000 LB	MANITOWOC	JCD-1195-263	SA4027	12	KES	-		
43.22	1	OPTIMIZED ORDER ASSEMBLY TABLE	KES	OOAT 48X48	E152097	2	KES	-		
44.25	1	BREAKER PANEL - 125 AMP - 3 PHASE EQUIPMENT MOUNTED	KES	-	-	-	KES	-		
44.45	1	MEDIUM RISER SHELF - 31" TO 43"	KES	-	-	2	KES	-		
45.19	1	MODULAR BEVERAGE CABINET - 13"-0"	KES	-	-	2	KES	-		
46.00	1	CUP DISPENSER VERTICAL 3 CUP	KES	-	-	2	KES	-		
46.02	1	SYRUP BOTTLE RACK - (5) SYRUP PUMPS	PRONTO	-	-	2	KES	-		
47.06	1	CHILLED RAIL	KES	-	-	7	KES	LOCATED UNDER PREP TABLE OVERSHELF SEE EXTERIOR ELEVATIONS FOR MOUNTING HEIGHT, INSTALLED BY GC		
49.00	1	C02 FILL BOX - 6 1/2"W x 18"H	CHART INDUSTRIES	8512629	-	-	MANUFACTURER	-		
51.03	2	CUP LID HOLDER 3 HIGH S/S	KES	-	-	2	KES	-		
51.04	4	CUP LID HOLDER SINGLE STACK 8" HIGH	KES	-	-	2	KES	-		
51.05	1	FRY BAGGING STATION 36"	KES	FBO1-4	E99018	2	KES	-		
61.00	1	3-VAT LOV FRYER - ELECTRIC - F/F/F	FRYMASTER	BIELA14+BCSD	E44571	4	KES	-		
66.39	1	4-VAT LOV FRYER - ELECTRIC - S/S/S	FRYMASTER	BIELA4+4-BCSD	E44571	4	KES	-		
69.00	2	CAPTURE JET PLenum - FRYER	HALTON	CJF-F	MH27607	2	KES	ATTACH TO UNIVERSAL EXHAUST HOOD		
69.01	2	CAPTURE JET PLenum - GRILL	HALTON	CJF-G	MH27607	2	KES	ATTACH TO UNIVERSAL EXHAUST HOOD		
73.00	1	UNIVERSAL EXHAUST HOOD FULL-CLAM/4-VAT FRYER	KES	UH-50	MH12755	2	KES	-		
79.26	2	VENTLESS HOOD FOR COMBI OVEN	HALTON	COV	E325060	2	KES	-		
80.00	1	MECHANICAL CHASE	KES	9"x18" SCGL	E163328	2	KES	-		
80.08	1	MECHANICAL CHASE	KES	9"x32" SCGL	E163328	2	KES	-		
81.01	1	PRODUCT LANDING SHELF - SOLID TOP	KES	-	-	2	KES	-		
82.01	1	LANDING TABLE WITH POWER	KES	-	-	2	KES	-		
85.05	1	FROZEN FRY DISPENSER	RAM	280-FP	E140753	4	KES	-		
91.02	1	WALL MOUNT FREEZER UNIT-SINGLE WIDE-HIGH CAPACITY	KES	HCWF1	SAT7329	7	KES	AIR-COOLED, SELF-CONTAINED - MOUNT BOTTOM AT 51" AFF	HCWF1.99A INSTALL HARDWARE KIT REQUIRED	
93.00	1	UNIVERSAL EXHAUST HOOD FULL-CLAM GRILL	KES	UH-43	MH12755	2	KES	-		
96.21	2	36" NEXT GEN 3-PLATE CLAMSHELL GRILL - ELECTRIC	GARLAND	ME-3PX	E28898	4	KES	-		
97.08	1	MEAT FREEZER - DOUBLE WID - HIGH	KES	HCFM30B-RH	SA6032 S	2	KES	AIR-COOLED, SELF-CONTAINED		
99.01	2	GRILL TOOL ORGANIZER - 43" HOOD	KES	-	-	2	KES	-		
10.01	1	OPTIMIZED BREAKFAST TABLE	KES	OBT	-	2	KES	-		
116.25	3	UNIVERSAL HOLDING CABINET - HIGH DENSITY	PRINCE CASTLE	UHC6PT-22MCD	-	4	KES	ETL RATINGS: SAFETY = 3197509CHI-003, SANITATION = 3197509CHI-004		
117.26	1	UHC TABLE HUB & SPOKE - 2 SIDED - 51"D	KES	-	-	2	KES	-		
18.00	1	DING OVEN - PIN & SLEEVE	AMANA	MC23MPW2	E40456	4	KES	-		
118.05	2	QING OVEN - PIN & SLEEVE	ACP	MCMO24	-	4	KES	-		
122.27	1	NEXGEN UNIVERSAL RADIANT TOASTER - PIN	ANTUNES	HRT-5H	-	4	KES	-		
122.28	1	NEXT GEN. UNIVERSAL CONTACT TOASTER - PIN	ANTUNES	HCT-5H	-	4	KES	-		
123.32	1	HUB & SPOKE ELECTRIC COMMUNICATION UTILITY	KES	ECU	-	2	KES	-		
123.34	1	PREP TABLE - HD - 2-SIDED OPL - 38"D x 67 1/2" - PIN & SLEEVE W/REF.	KES	-	-	2	KES	-		
125.00	2	RAPID BUN STEAMER	PRINCE CASTLE	625-MFY	-	4	KES	-		
130.00	2	COMBI OVEN	MANITOWOC	MS510-2083LCMD-1	-	4	KES	-		
134.02	1	VEGETABLE SINK	KES	SKO-4	-	2	KES	-		
139.04	1	COMBI OVEN STAND - DOUBLE WIDE	KES	-	-	2	KES	-		
151.12	1	CLEAN DISHABLE - LEFT HAND - 28.23"	KES	SK-SPL	-	2	KES	-		
151.46	1	SOILED DISHABLE - RIGHT HAND - 90.5" WIDE	KES	SK-SPL	-	2	KES	-		
152.05	1	WAREWASHER	ECOLAB	OSR TSC	E5956	3	MANUFACTURER	PROVIDE VAPOR VENT - REQUIRED		
153.00	1	SCULLERY SHELVING KIT - 3 TIER - 14" x 36"	INTERMETRO	SHSS-4	-	2	KES			