


IF YOU HAVE ANY QUESTIONS REGARDING THE PLANS, PLEASE CALL THE DESIGNER.

DESIGNER: Wendy Wenborg
PHONE: 952-540-4047
EMAIL: wwenborg@epinc.com

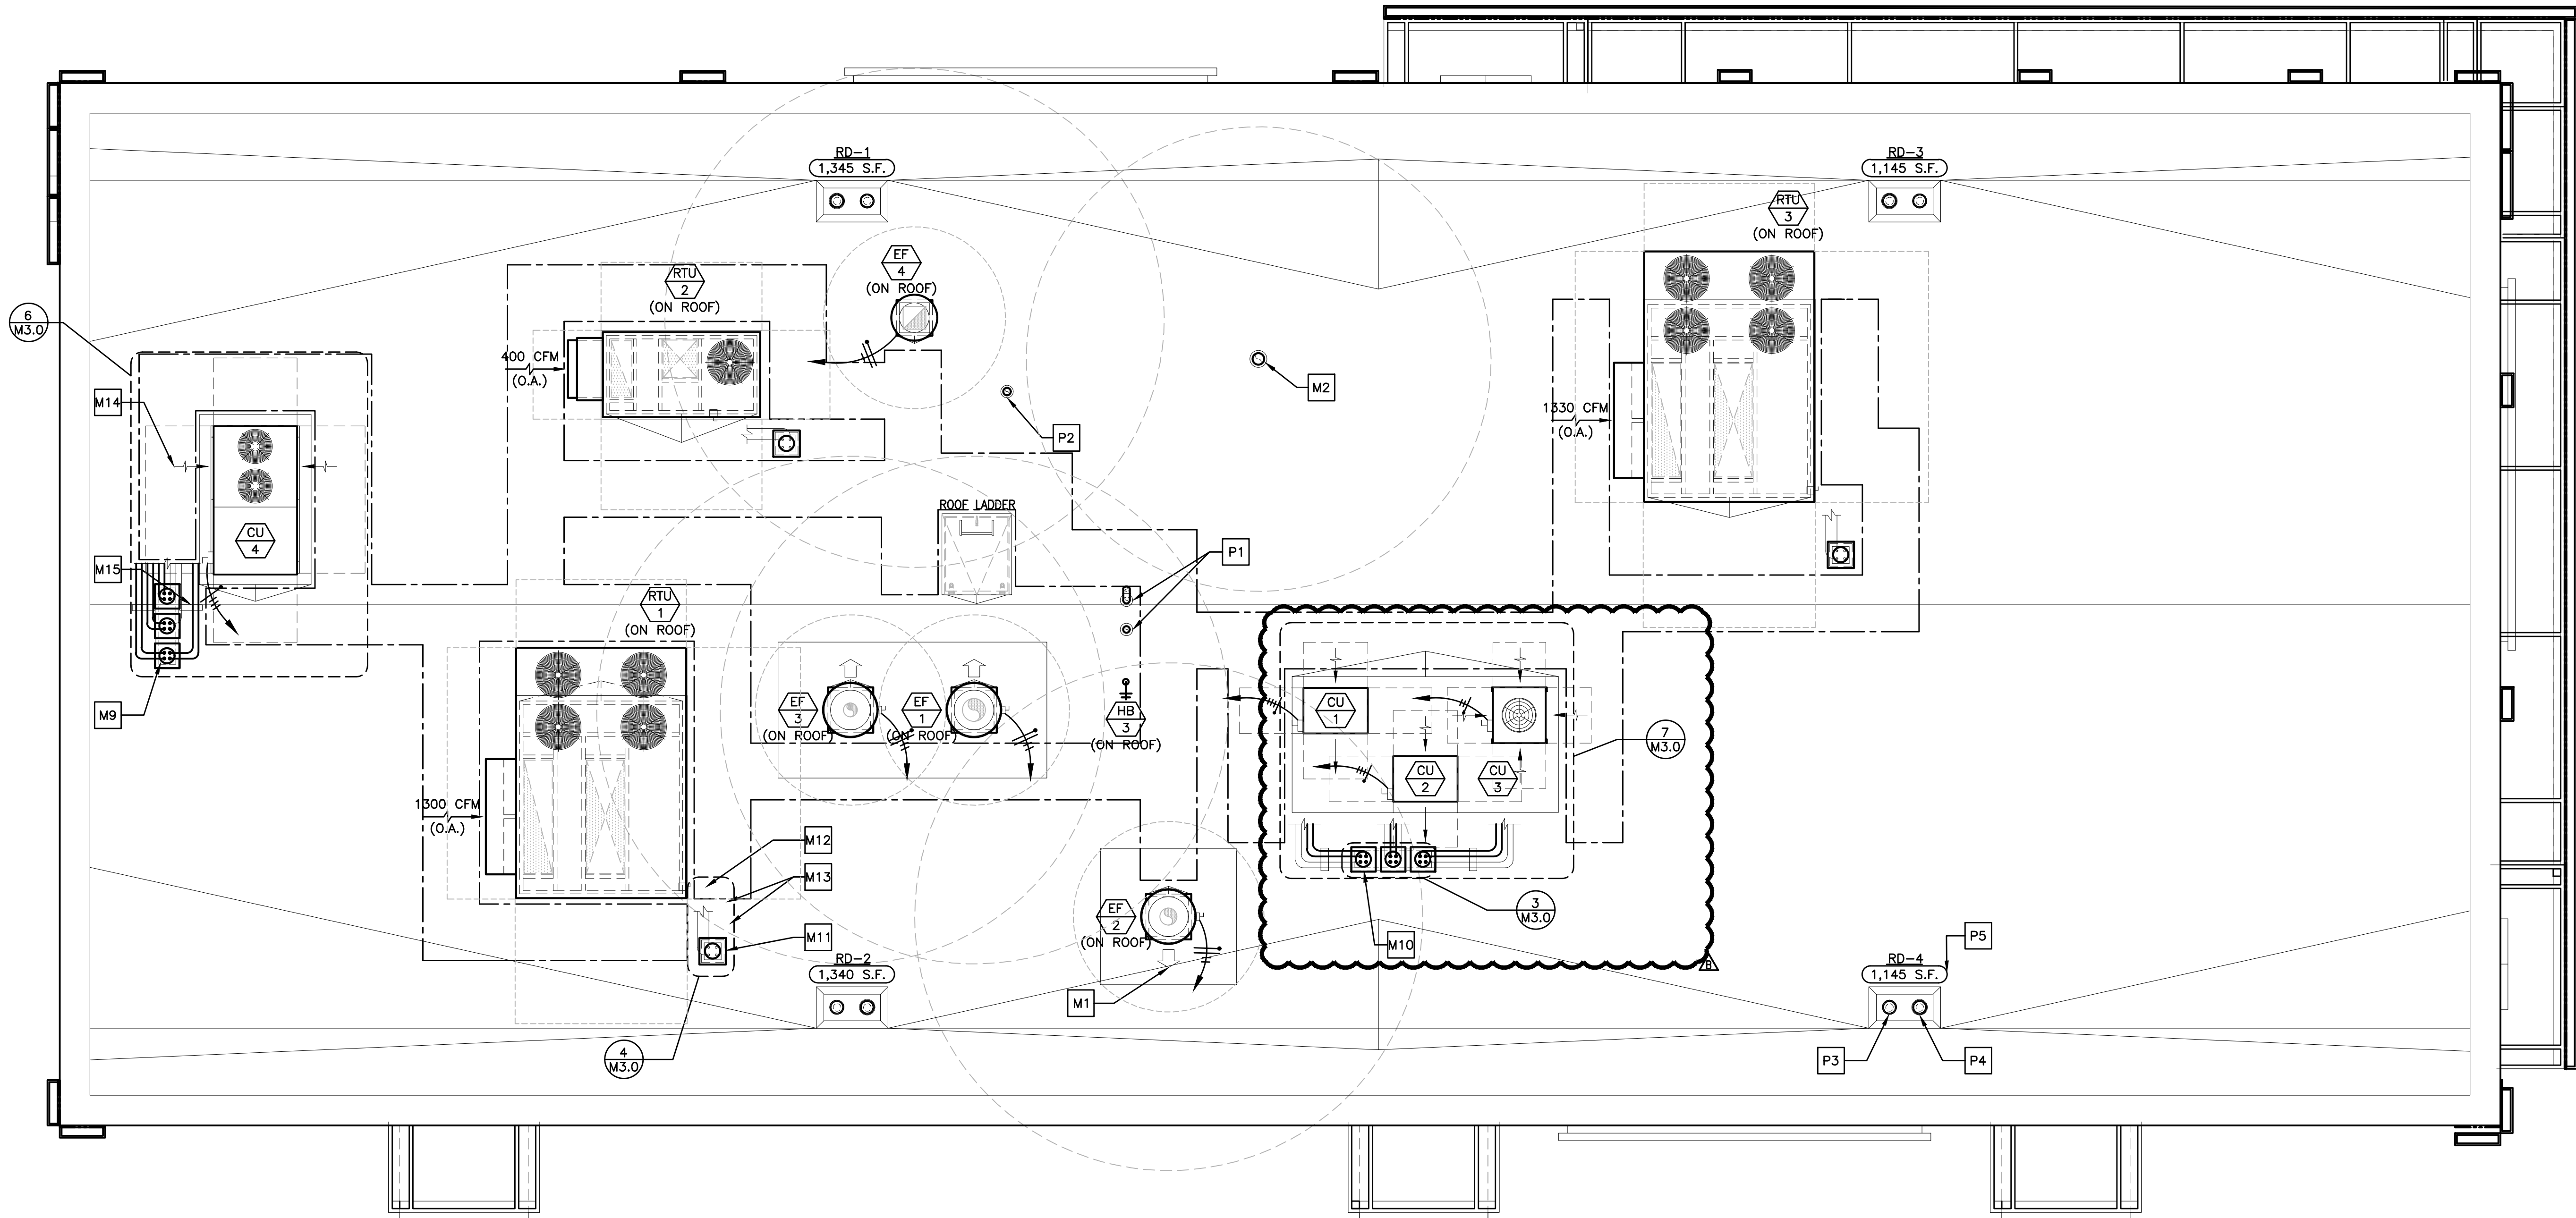

1 ROOF PLAN
1/4"=1'-0"

DRAWING NOTES

- ROOFTOP EQUIPMENT LOCATIONS SHOWN ARE GENERAL. ACTUAL LOCATIONS SHALL BE COORDINATED WITH THE STRUCTURAL DRAWINGS.
- ROOF OPENINGS FOR ROOFTOP UNITS AND EXHAUST FANS SHALL BE COORDINATED WITH THE MANUFACTURER.
- ROOF OPENINGS FOR PIPE PORTALS SHALL ONLY BE LARGE ENOUGH TO ALLOW PIPE AND CONDUIT PENETRATIONS. PIPE PORTAL CURB SHALL BE FILLED WITH AS MUCH BATT INSULATION AS POSSIBLE.
- PRIOR TO INSTALLING THE TOP OF THE EQUIPMENT PLATFORM, INSIDE OF THE PLATFORM SHALL BE INSULATED WITH AS MUCH BATT INSULATION AS POSSIBLE.

DRAWINGS AND SPECIFICATIONS ARE TO BE CONSIDERED AS SUPPLEMENTING EACH OTHER. WORK SPECIFIED BUT NOT SHOWN ON DRAWINGS, OR SHOWN ON DRAWINGS BUT NOT SPECIFIED, SHALL BE PERFORMED OR FURNISHED AS THOUGH MENTIONED IN BOTH SPECIFICATIONS AND DRAWINGS. IF NOT OTHERWISE DIRECTED, INSTALLATION OF ALL SYSTEMS AND EQUIPMENT SHALL BE IN ACCORDANCE WITH APPLICABLE CODES AND IN ACCORDANCE WITH MANUFACTURER'S INSTALLATION INSTRUCTIONS. WHERE WORK DESCRIBED IN THE SPECIFICATIONS IS IN CONFLICT WITH THE WORK SHOWN ON THE DRAWINGS, THE CONTRACTOR SHALL SUPPLY THE GREATER QUANTITY, QUALITY AND COST VIA THE BID AND CONTACT THE ENGINEER FOR CLARIFICATION ON DIRECTION PRIOR TO INSTALLATION.

PRIOR TO BID, THE CONTRACTOR SHALL REVIEW THE MECHANICAL, ELECTRICAL AND KITCHEN EQUIPMENT DRAWINGS. THE CONTRACTOR SHALL INCLUDE IN HIS BID ALL RELEVANT WORK IN THE ENTIRE SET OF DOCUMENTS AND REPORT ALL DISCREPANCIES BETWEEN THESE DRAWINGS TO THE ENGINEER PRIOR TO BIDDING FOR CLARIFICATION. IF DISCREPANCIES REMAIN UNRESOLVED DUE TO A SHORT TIME FRAME, THE CONTRACTOR SHALL INCLUDE THE MOST WORK AND THE HIGHER COSTS IN THE BID. SOLUTIONS TO UNREPORTED DISCREPANCIES WILL BE DETERMINED BY THE ARCHITECT/ENGINEER, WITH NO ADDITIONAL COMPENSATION DUE TO THE CONTRACTOR.

KEYED NOTES

- M1 ARROW INDICATES DIRECTION OF EXHAUST FAN HINGE SWING (TYP.)
- M2 6"Ø ALUMINUM EXHAUST DUCT FROM EXHAUST FAN (EF-5). PROVIDE PORTALS PLUS PLASTI-FLASH WITH C-126 CAP (OR EQUAL) FOR ROOF PENETRATION. TERMINATE DUCT A MIN. OF 24" ABOVE FINISHED ROOF WITH GOOSENECK.
- M3 NOT USED
- M4 NOT USED
- M5 NOT USED
- M6 NOT USED
- M7 NOT USED
- M8 NOT USED
- M9 ROOF PIPE PORTAL FOR MAC UNIT
- M10 ROOF PIPE PORTAL FOR CONDENSING UNITS
- M11 ROOF PIPE PORTAL FOR ROOFTOP UNITS (TYP. 3 PLACES)
- M12 GAS PIPING FROM ROOF PORTAL TO ROOFTOP UNIT SHALL BE COATED WITH A CORROSION RESISTANT PAINT (SEE GAS PIPING NOTES)
- M13 GAS PRESSURE REGULATOR AND SHUT-OFF VALVE (TYP.)
- M14 ARROW INDICATES DIRECTION OF AIRFLOW FOR CONDENSING OR ROOFTOP UNIT AIR INTAKE (TYP.)
- M15 REFRIGERANT PIPING SUPPORT AS REQUIRED. PROVIDE ROOFTOP BLOX MODEL RTB-01 (OR EQUAL) AND ALL NECESSARY ACCESSORIES FOR PROPER PIPE AND CONDUIT SUPPORT. PROVIDE GALVANIZED PIPE SHIELD TO PROTECT INSULATION AT ALL SUPPORTS.

- P1 COMBUSTION AIR INTAKE AND EXHAUST VENT FOR SEALED COMBUSTION WATER HEATER (SEE PLUMBING DRAWINGS). PROVIDE PORTALS PLUS PLASTIFLASH WITH C-126 CAP (OR EQUAL) FOR ROOF PENETRATION.
- P2 PLUMBING VENT THROUGH ROOF (SEE PLUMBING DRAWINGS). PROVIDE PORTALS PLUS PLASTI-FLASH WITH C-126 CAP (OR EQUAL) FOR ROOF PENETRATION.
- P3 PRIMARY ROOF DRAIN WITH DOME STRAINER (SEE PLUMBING DRAWINGS)
- P4 OVERFLOW ROOF DRAIN WITH DOME STRAINER (SEE PLUMBING DRAWINGS)
- P5 AREA OF ROOF SERVED BY ROOF DRAIN (TYP.)

PIPE PORTAL SCHEDULE

MANUFACTURER	CURB DIMENSIONS	CURB TYPE	CAP TYPE (QTY)	SERVES
RPS	12"x12"x11"H	RC-2A	N18 (1)	RTU-1 THROUGH RTU-3
RPS	43"x12"x13"H	RC-2A	N18 (3)	CU-4
RPS	27"x12"x13"H	RC-2A	N18 (2)	CU-1 THROUGH CU-3

SEQUENCE OF OPERATION

THERMOSTAT SETTINGS				
MODE	FAN	SETPOINTS		
		COOLING	HEATING	
		OCCUPIED	ON	75°F
UNOCCUPIED	AUTO	90°F	55°F	
HUMIDITY				
HUMIDITY SETPOINT (FOR DEHUMIDIFICATION UNITS ONLY)				60%
DEMAND CONTROL VENTILATION				
CO2 (FOR DCV)		MINIMUM	MAXIMUM	
		400 PPM	1000 PPM	
RTU-1, RTU-2 & RTU-3:				
1. OCCUPIED MODE SHALL BEGIN AS FOLLOWS:				
• RTU-1: 1.5 HOURS BEFORE OPEN				
• RTU-2: 1 HOUR BEFORE OPEN				
• RTU-3: 30 MINUTES BEFORE OPEN				
2. ROOFTOP UNIT FAN SHALL RUN CONTINUOUSLY DURING OCCUPIED MODE				
3. ECONOMIZER SHALL BE OPEN DURING OCCUPIED MODE (OUTDOOR AIR THROUGH ROOFTOP UNITS SERVES AS MAKE-UP AIR FOR THE KITCHEN EXHAUST SYSTEM) – REFER TO E3.2 FOR HOOD/FAN INTERLOCK DETAILS.				
4. UNOCCUPIED MODE SHALL BEGIN ONE (1) HOUR AFTER STORE CLOSES				
5. DURING UNOCCUPIED MODE, ECONOMIZER IS CLOSED AND HEATING, COOLING AND FAN OPERATE IN AUTO MODE (ON DEMAND)				

IF YOU HAVE ANY QUESTIONS REGARDING THE PLANS, PLEASE CALL THE DESIGNER.	DESIGNER: Wendy Wenborg PHONE: 952-540-4047 EMAIL: wwenborg@epinc.com	12/03/20 SERVICE AREA OPTIMIZATION	11/13/20 USD SD SET REVIEW	05/05/20 CIVIL & PLAN REVIEW COMMENTS	07/27/20 PERMIT SET	01/13/20 USD PROGRESS SET REVIEW	BY
emanuelson-podas consulting engineers Emanuelson-Podas, Inc. 7700 Hennepin Avenue, Suite 200 Edina, MN 55439 (952) 930-0050 www.epinc.com							DESCRIPTION
3801.0037							REV
12/03/20							DATE
McDonald's USA, LLC							BY
© 2020 McDonald's USA, LLC. These drawings and specifications are the confidential and proprietary property of McDonald's USA, LLC and shall not be copied or reproduced without written authorization. In the contract documents were prepared by Emanuelson-Podas, Inc. for use on a different site or at a later time. Use of these drawings for reference or example on another project requires the written consent of Emanuelson-Podas, Inc. Use of the contract documents for reuse on another project is not authorized.							REV
2019 STANDARD BUILDING - BB20							DATE
4597FF10-WOOD/WOOD							DATE
WOOD BEARING WALLS W/FIBER CEMENT SIDING & CI							DATE
WOOD ROOF TRUSS FRAMING							DATE
FIBER CEMENT PANEL/BATTEN/ALPOLIC PANEL/BRICK EXT. FINISH							DATE
SITE ID							DATE
015-0071							DATE
605 SOUTH 7TH STREET, KANSAS CITY, KS							DATE
M1.0							DATE
ROOF PLAN							DATE